




O	WORK AS CONSTRUCTED	J.V.	25.02.19
D	NOTATION CHANGE AS PER SWC REQUEST	F.J.	30.01.19
C	START OF L1 AMENDED	F.J.	14.07.18
B	ISSUE FOR APPROVAL	F.J.	17.03.18
A	DRAFT ISSUE FOR TENDER	F.J.	12.03.18
No.	AMENDMENT DESCRIPTION	BY	DATE

FILE LOCATION: PM19848WW-0 DESIGNED: F.J. DRAFTED: J.V. VERIFIED: C.T. REVIEWED: C.T. APPROVED: C.T. ISSUED: 25.02.2019




0	WORK AS CONSTRUCTED	J.V.	25.02.19
D	NOTATION CHANGE AS PER SWC REQUEST	F.J.	30.01.19
C	START OF L1 AMENDED	F.J.	14.07.18
B	ISSUE FOR APPROVAL	F.J.	17.03.18
A	DRAFT ISSUE FOR TENDER	F.J.	12.03.18
No.	AMENDMENT DESCRIPTION	BY	DATE

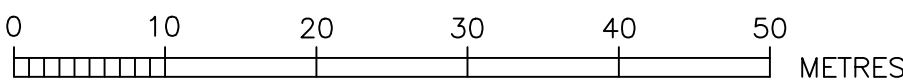


- EASEMENT FOR ACCESS AND MAINTENANCE 0.9 WIDE
- EASEMENT TO DRAIN WATER 0.9 WIDE
- * DRIVEWAY

SEE SHEET '3' FOR CONTINUATION


WORK AS CONSTRUCTED CERTIFICATION		Sydney WATER	
DEVELOPER	WOORONG PARK PTY LTD	Case No. 167855WW SHT 2 OF 9 SHTS.	
W.S.C.	QALCHEK PTY LTD		
CONSTRUCTOR	C.J. DOYLE	FOR DETAILS OF SERVICES SEE SHEET 1	
COMPLETED	08.08.2018		
W.A.C. PREPARED	25.02.2019	FOR DETAILS OF SERVICES SEE SHEET 1	
DESIGNER	QALCHEK PTY LTD		
I CERTIFY THAT THE WORKS HAVE BEEN CONSTRUCTED IN ACCORDANCE WITH THE WORK AS CONSTRUCTED DRAWINGS			

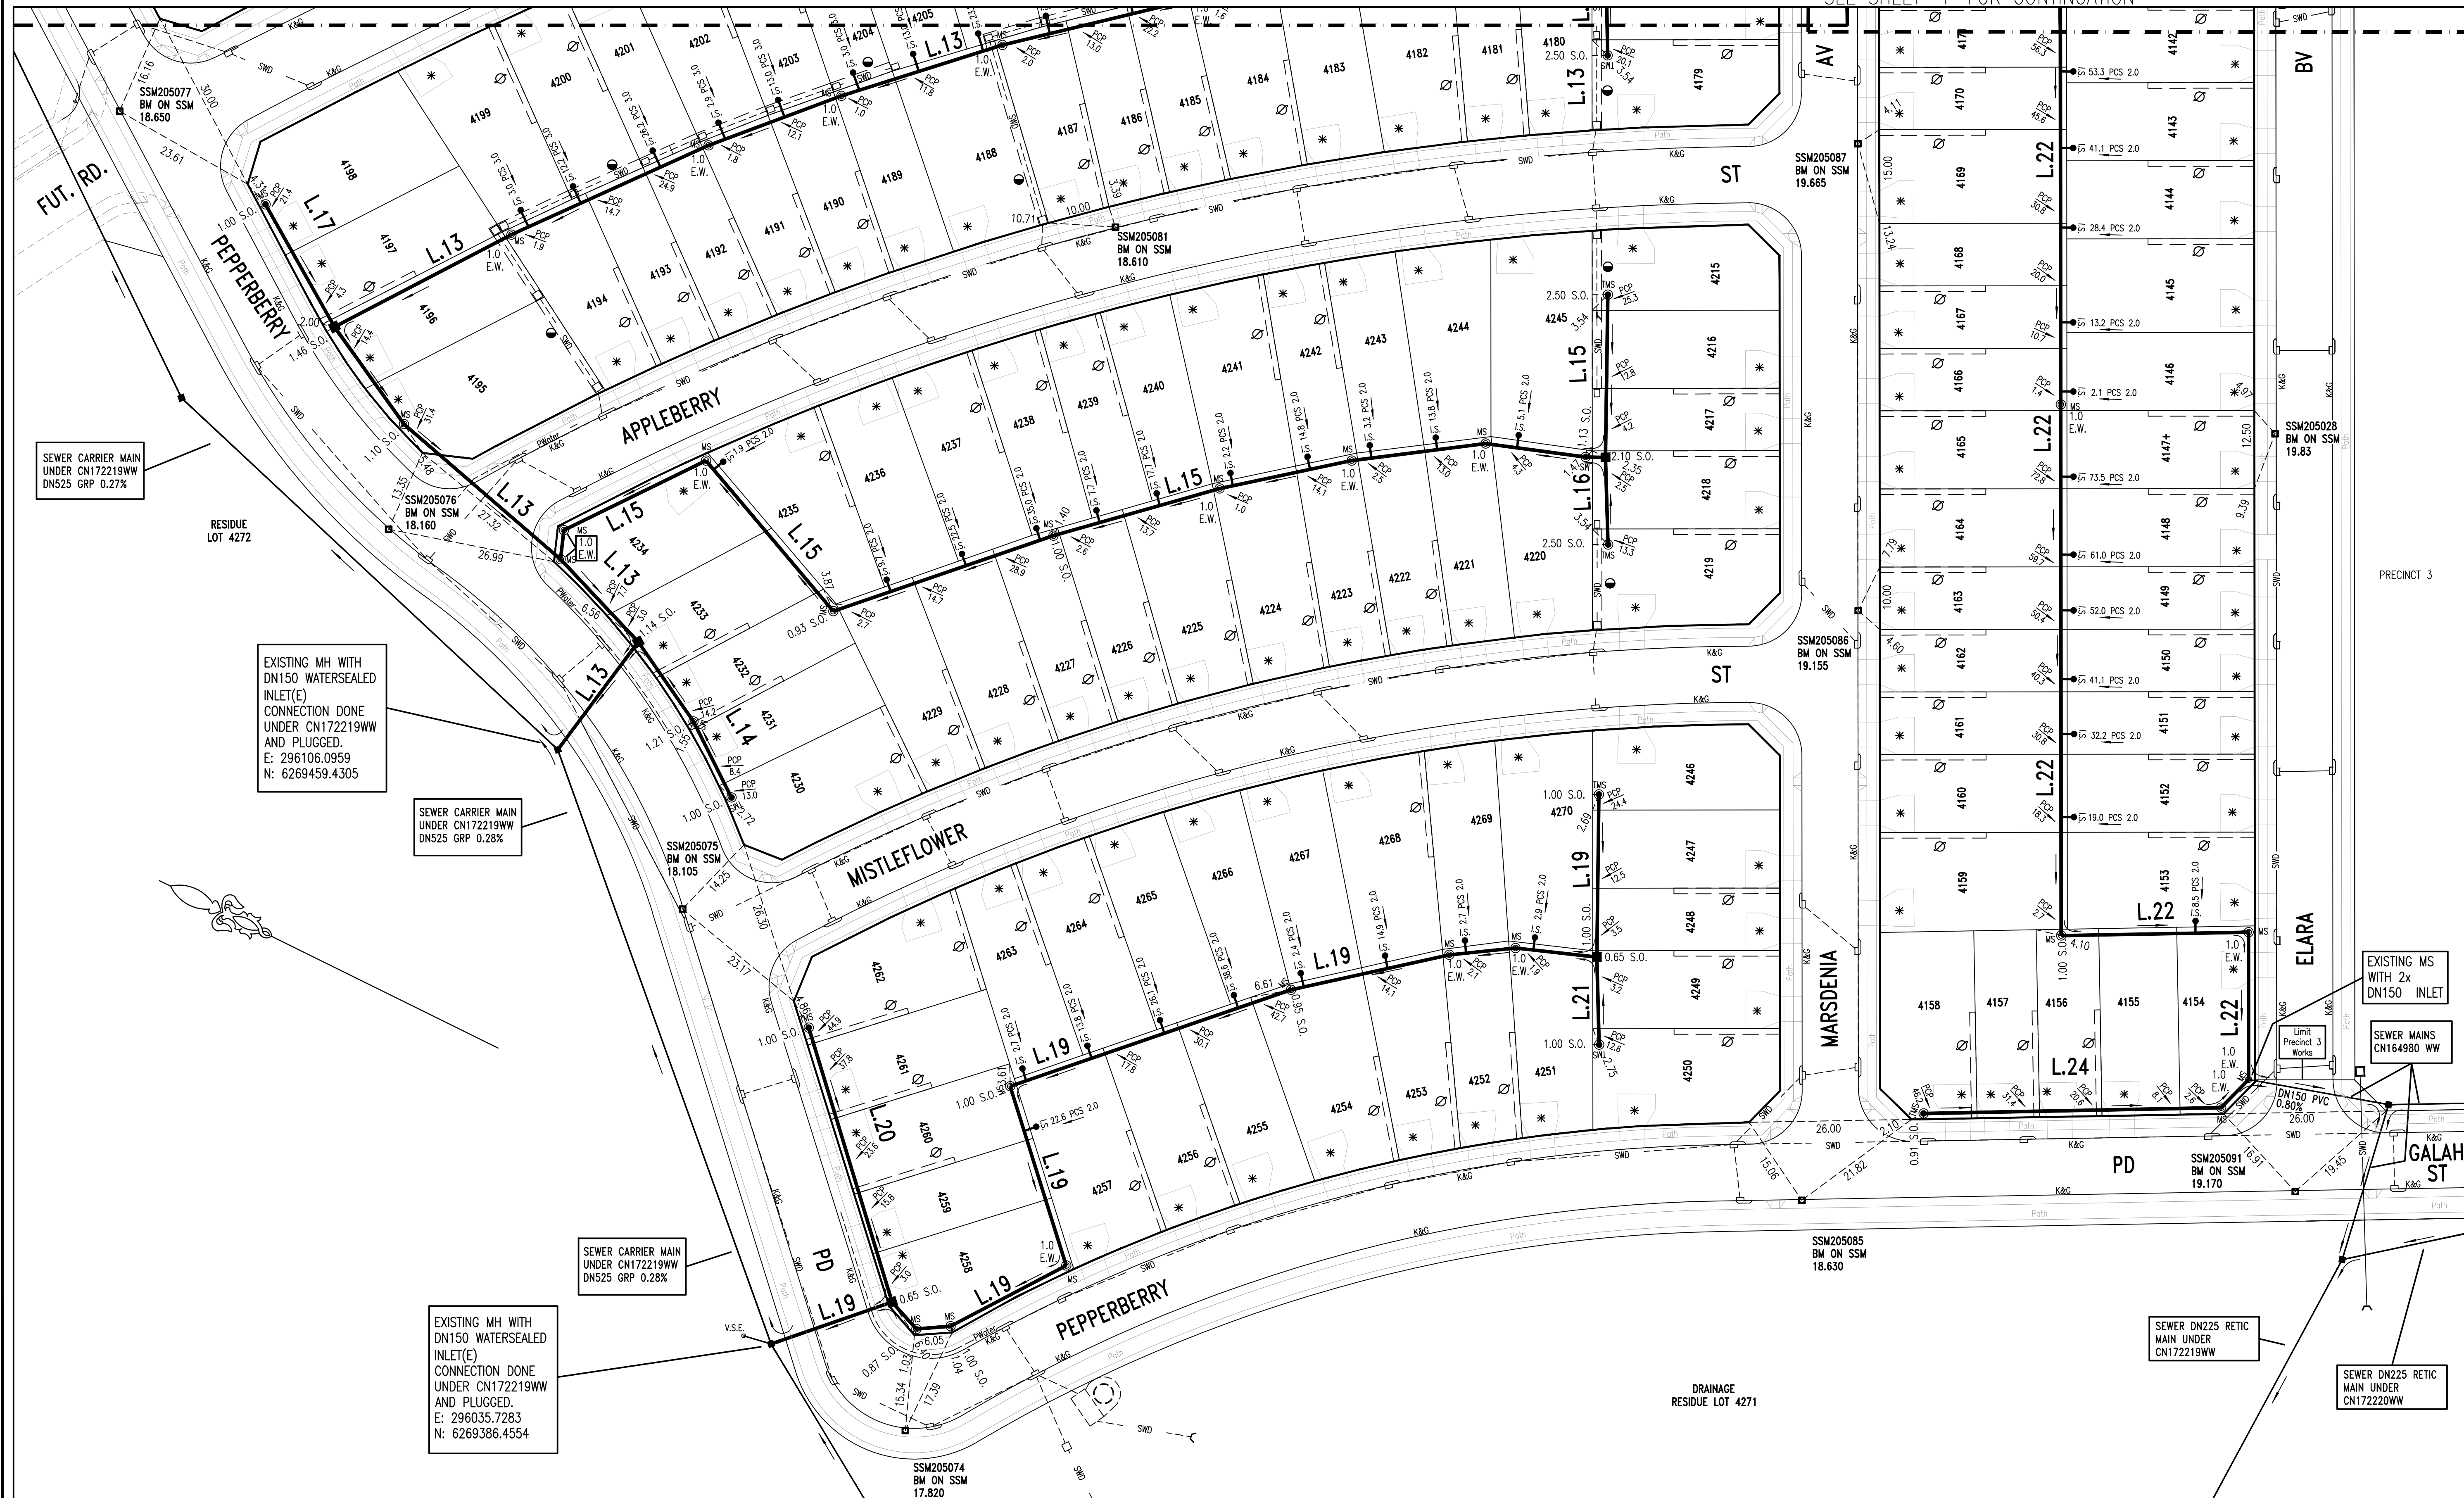



LINE No.	CHAINAGE	TYPE (MH/MS/MC)	DN RISER	CLASS OF COVER	MATERIAL (PVC-U, PE, PP, GRP, CAST IN SITU CONC, PRE-CAST CONC, OTHER - SPECIFY)	COMMENTS (BRAND/DTC No/ISSUE, DATE/NA, OTHER AS REQUIRED)
1	8.22	MH	1050	D	CONCRETE	DTC-2203
1	39.72	MH	1050	B	CONCRETE	DTC-2203
1	50.58	MH	1050	B	CONCRETE	DTC-2203
1	79.79	MH	1050	B	CONCRETE	DTC-2203
1	105.01	MH	1050	B	CONCRETE	DTC-2203
1	109.81	MH	1050	B	CONCRETE	DTC-2203
1	174.36	MH	1050	B	CONCRETE	DTC-2203
1	198.46	MH	1050	B	CONCRETE	DTC-2203
1	204.05	MS	225	B	AS PER WSA-137	AS PER WSA-137
1	232.69	MS	225	B	AS PER WSA-137	AS PER WSA-137
1	258.19	MS	225	B	AS PER WSA-137	AS PER WSA-137
1	377.35	MH	1050	B	CONCRETE	DTC-2203
1	432.33	MH	1050	B	CONCRETE	DTC-2203
1	448.24	MS	225	B	AS PER WSA-137	AS PER WSA-137
2	108.74	MS	225	B	AS PER WSA-137	AS PER WSA-137
2	174.77	MH	1050	B	CONCRETE	DTC-2203
2	178.14	MS	225	B	AS PER WSA-137	AS PER WSA-137
2	193.06	TMS	225	B	AS PER WSA-137	AS PER WSA-137
3	20.15	TMS	225	B	AS PER WSA-137	AS PER WSA-137
4	25.43	MS	225	B	AS PER WSA-137	AS PER WSA-137
4	61.58	MS	225	B	AS PER WSA-137	AS PER WSA-137
4	167.39	MS	225	B	AS PER WSA-137	AS PER WSA-137
4	184.76	MH	1050	B	CONCRETE	DTC-2203
4	200.74	TMS	225	B	AS PER WSA-137	AS PER WSA-137
5	14.23	TMS	225	B	AS PER WSA-137	AS PER WSA-137
6	81.78	MS	225	B	AS PER WSA-137	AS PER WSA-137
6	88.76	MS	300	B	AS PER WSA-137	AS PER WSA-137 (MAXIMUM RISE USED ON HIGH LEVEL CONN. MS's)
6	106.72	MS	225	B	AS PER WSA-137	AS PER WSA-137
6	132.83	MH	1050	B	CONCRETE	DTC-2203
6	158.11	MS	225	B	AS PER WSA-137	AS PER WSA-137
6	181.46	MS	225	B	AS PER WSA-137	AS PER WSA-137
6	217.57	MH	1050	B	CONCRETE	DTC-2203
6	267.30	TMS	225	B	AS PER WSA-137	AS PER WSA-137
7	66.98	MS	225	B	AS PER WSA-137	AS PER WSA-137
7	114.16	TMS	225	B	AS PER WSA-137	AS PER WSA-137
8	5.60	MS	225	B	AS PER WSA-137	AS PER WSA-137
8	60.07	TMS	225	B	AS PER WSA-137	AS PER WSA-137
9	34.16	MS	225	B	AS PER WSA-137	AS PER WSA-137
9	58.82	MS	225	B	AS PER WSA-137	AS PER WSA-137
9	70.95	MS	225	B	AS PER WSA-137	AS PER WSA-137
9	96.21	TMS	225	B	AS PER WSA-137	AS PER WSA-137
10	6.25	MS	225	B	AS PER WSA-137	AS PER WSA-137
10	66.24	TMS	225	B	AS PER WSA-137	AS PER WSA-137
11	28.24	MS	225	B	AS PER WSA-137	AS PER WSA-137
11	56.61	MS	225	B	AS PER WSA-137	AS PER WSA-137
11	124.58	MH	1050	B	CONCRETE	DTC-2203
11	143.17	TMS	225	B	AS PER WSA-137	AS PER WSA-137
12	3.52	TMS	225	B	AS PER WSA-137	AS PER WSA-137
13	21.07	MH	1050	B	CONCRETE	DTC-2203
13	39.24	MS	225	B	AS PER WSA-137	AS PER WSA-137
19	166.48	MS	225	B	AS PER WSA-137	AS PER WSA-137
19	179.60	MH	1050	B	CONCRETE	DTC-2203
19	205.63	TMS	225	B	AS PER WSA-137	AS PER WSA-137
20	45.89	TMS	225	B	AS PER WSA-137	AS PER WSA-137
21	14.04	TMS	225	B	AS PER WSA-137	AS PER WSA-137
22	23.58	MS	225	B	AS PER WSA-137	AS PER WSA-137
22	53.58	MS	225	B	AS PER WSA-137	AS PER WSA-137
22	138.61	MS	225	B	AS PER WSA-137	AS PER WSA-137
22	215.71	MH	1050	B	CONCRETE	DTC-2203
22	232.45	TMS	225	B	AS PER WSA-137	AS PER WSA-137
23	3.52	TMS	225	B	AS PER WSA-137	AS PER WSA-137
24	6.31	MS	225	B	AS PER WSA-137	AS PER WSA-137
24	53.96	TMS	225	B	AS PER WSA-137	AS PER WSA-137

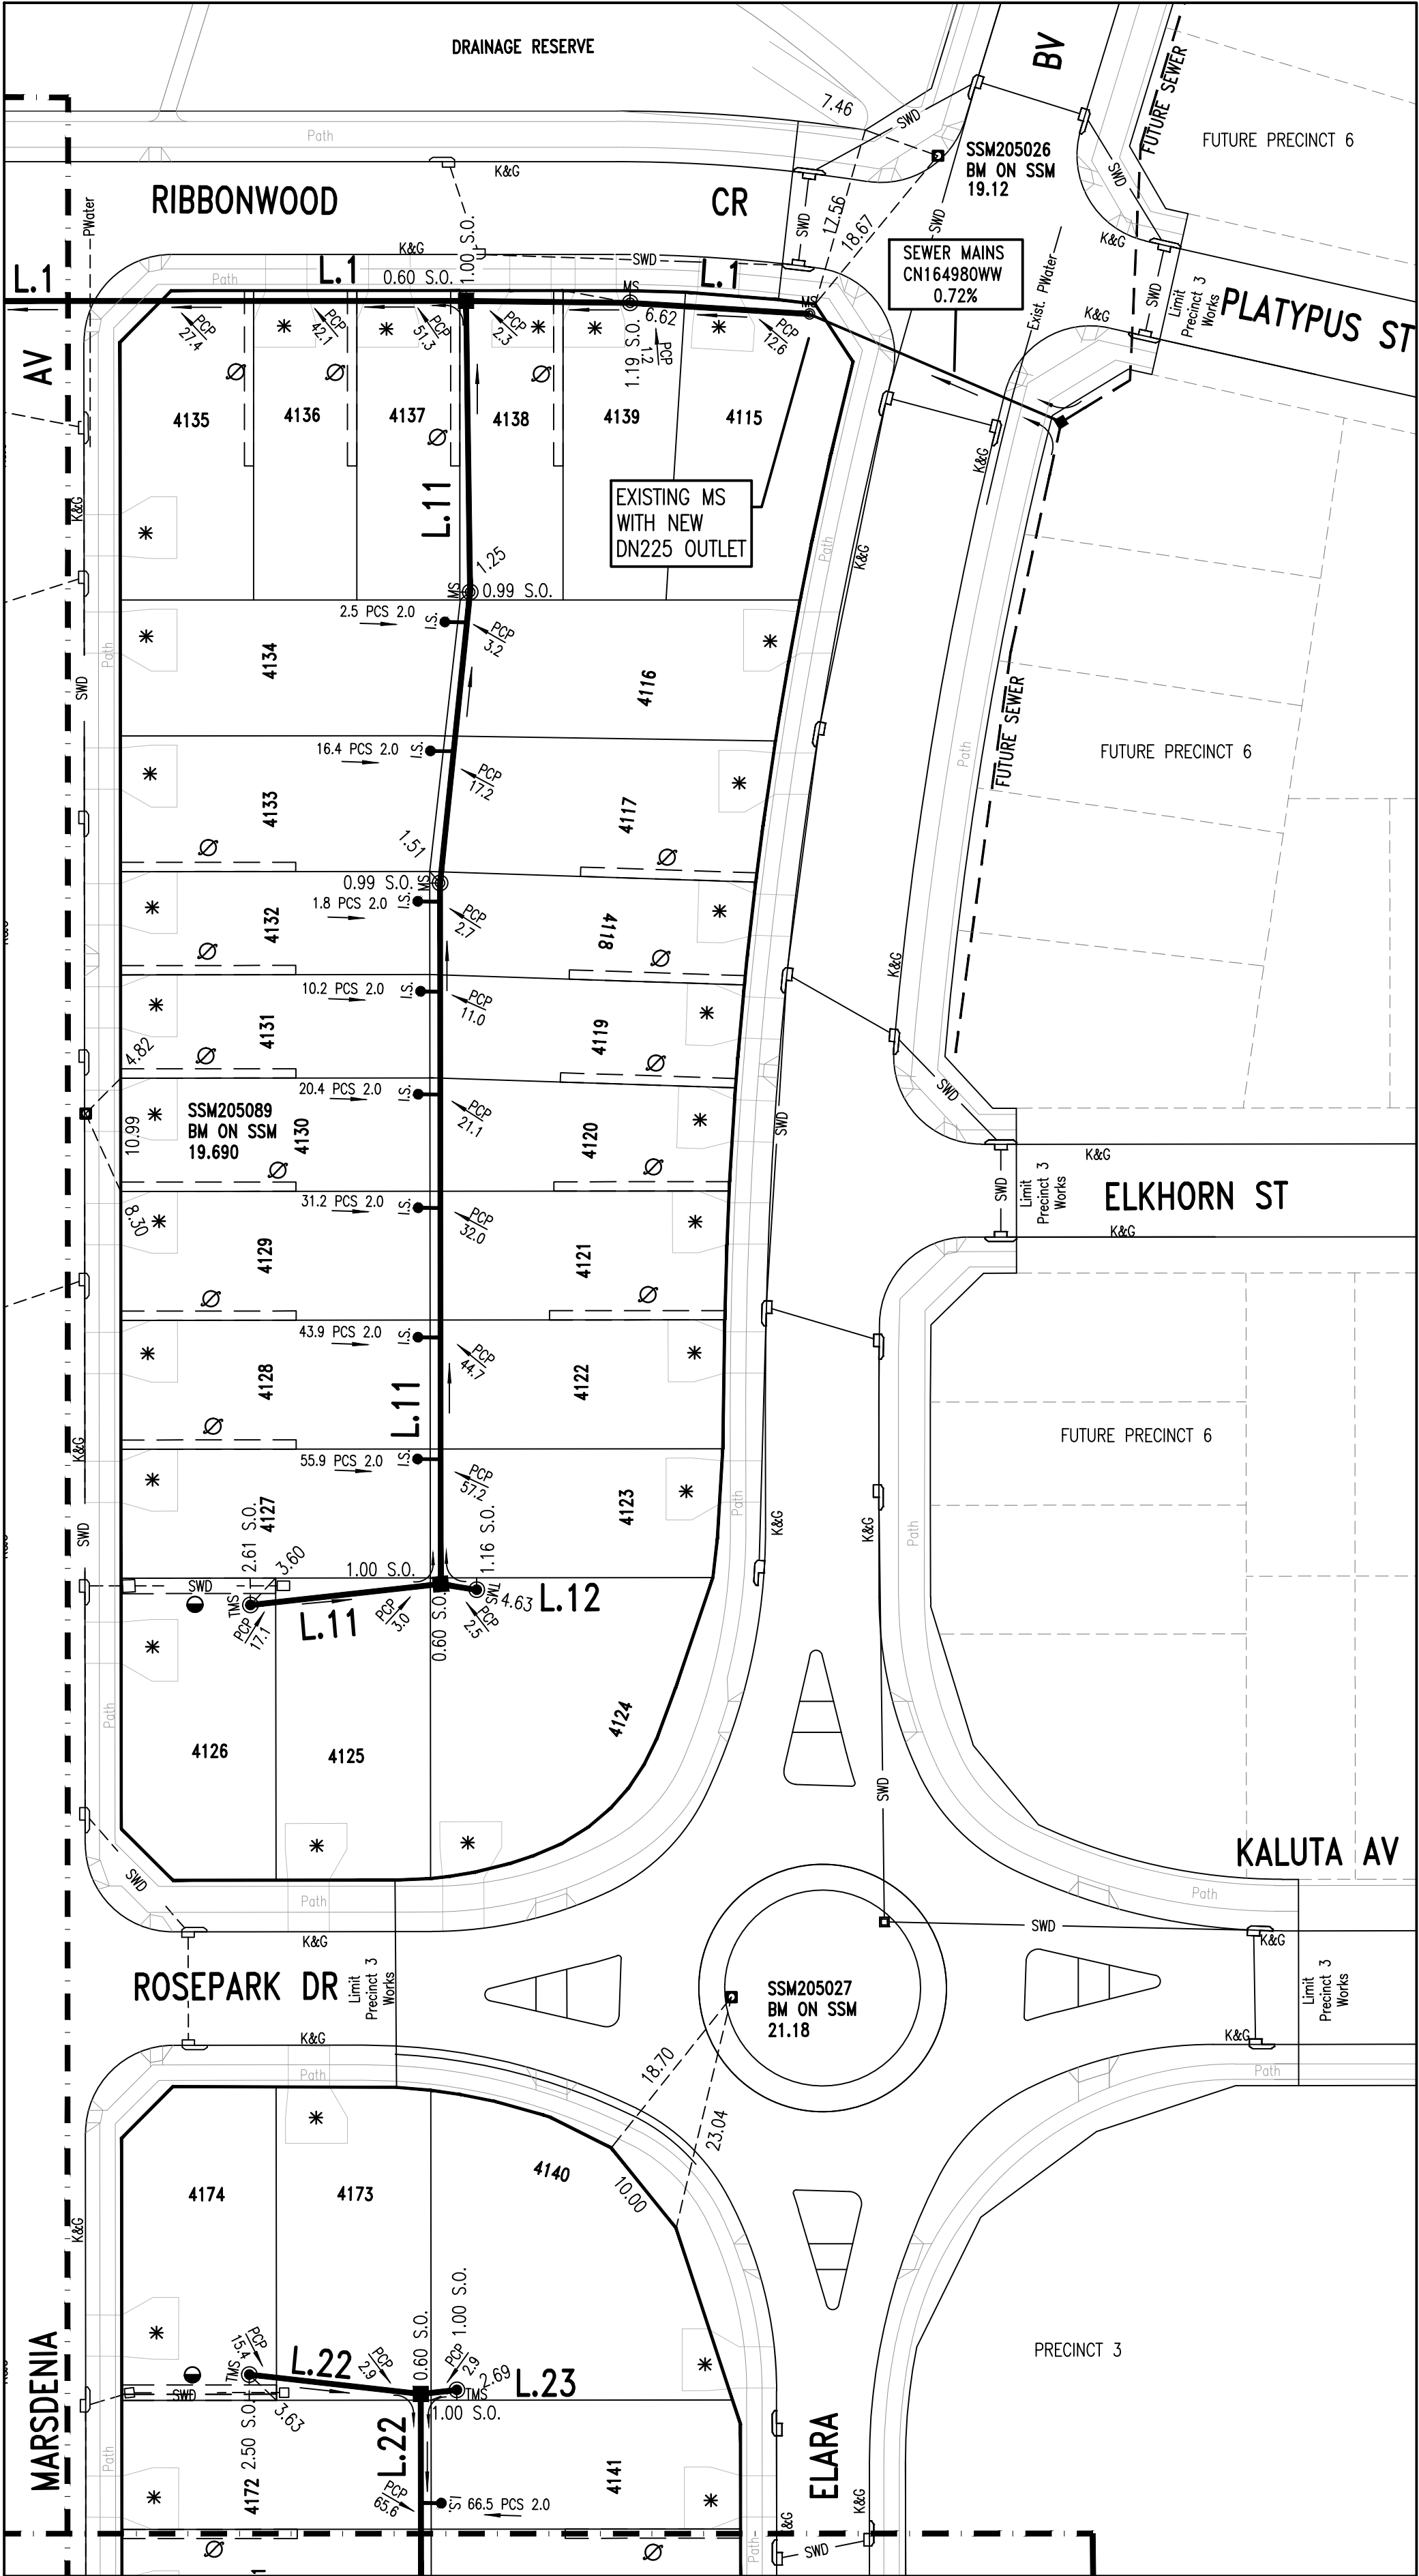

0	WORK AS CONSTRUCTED	J.V.	25.02.19
D	NOTATION CHANGE AS PER SWC REQUEST	F.J.	30.01.19
C	START OF L1 AMENDED	F.J.	14.07.18
B	ISSUE FOR APPROVAL	F.J.	17.03.18
A	DRAFT ISSUE FOR TENDER	F.J.	12.03.18
No.	AMENDMENT DESCRIPTION	BY	DATE

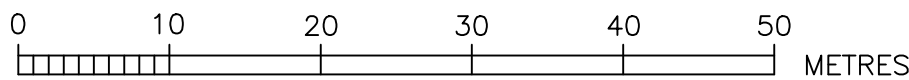








WORK AS CONSTRUCTED CERTIFICATION		Sydney WATER	
DEVELOPER	WOORONG PARK PTY LTD	CONSTRUCTOR	C.J. DOYLE
W.S.C.	QALCHEK PTY LTD	COMPLETED	08.08.2018
W.A.C. PREPARED	25.02.2019	SHOWN	25.02.2019
DESIGNER	QALCHEK PTY LTD	FOR DETAILS OF SERVICES SEE SHEET 1	

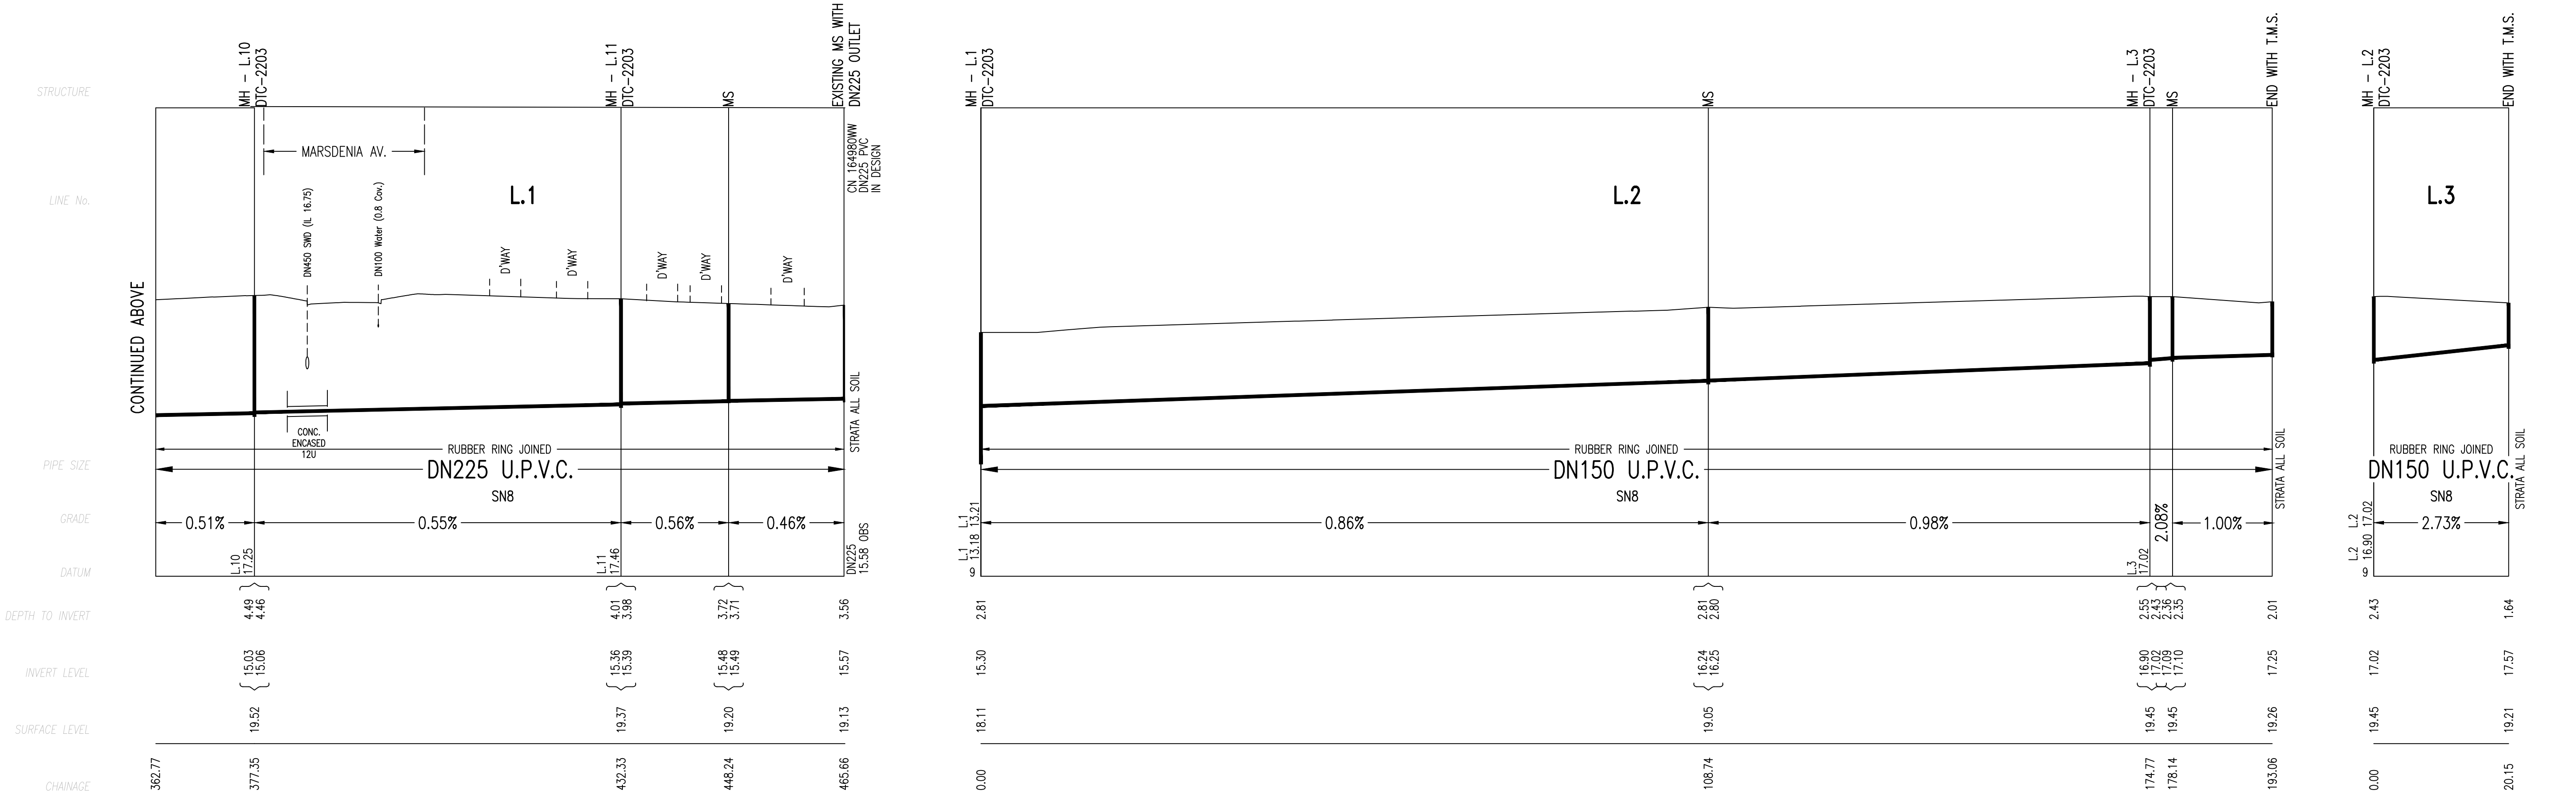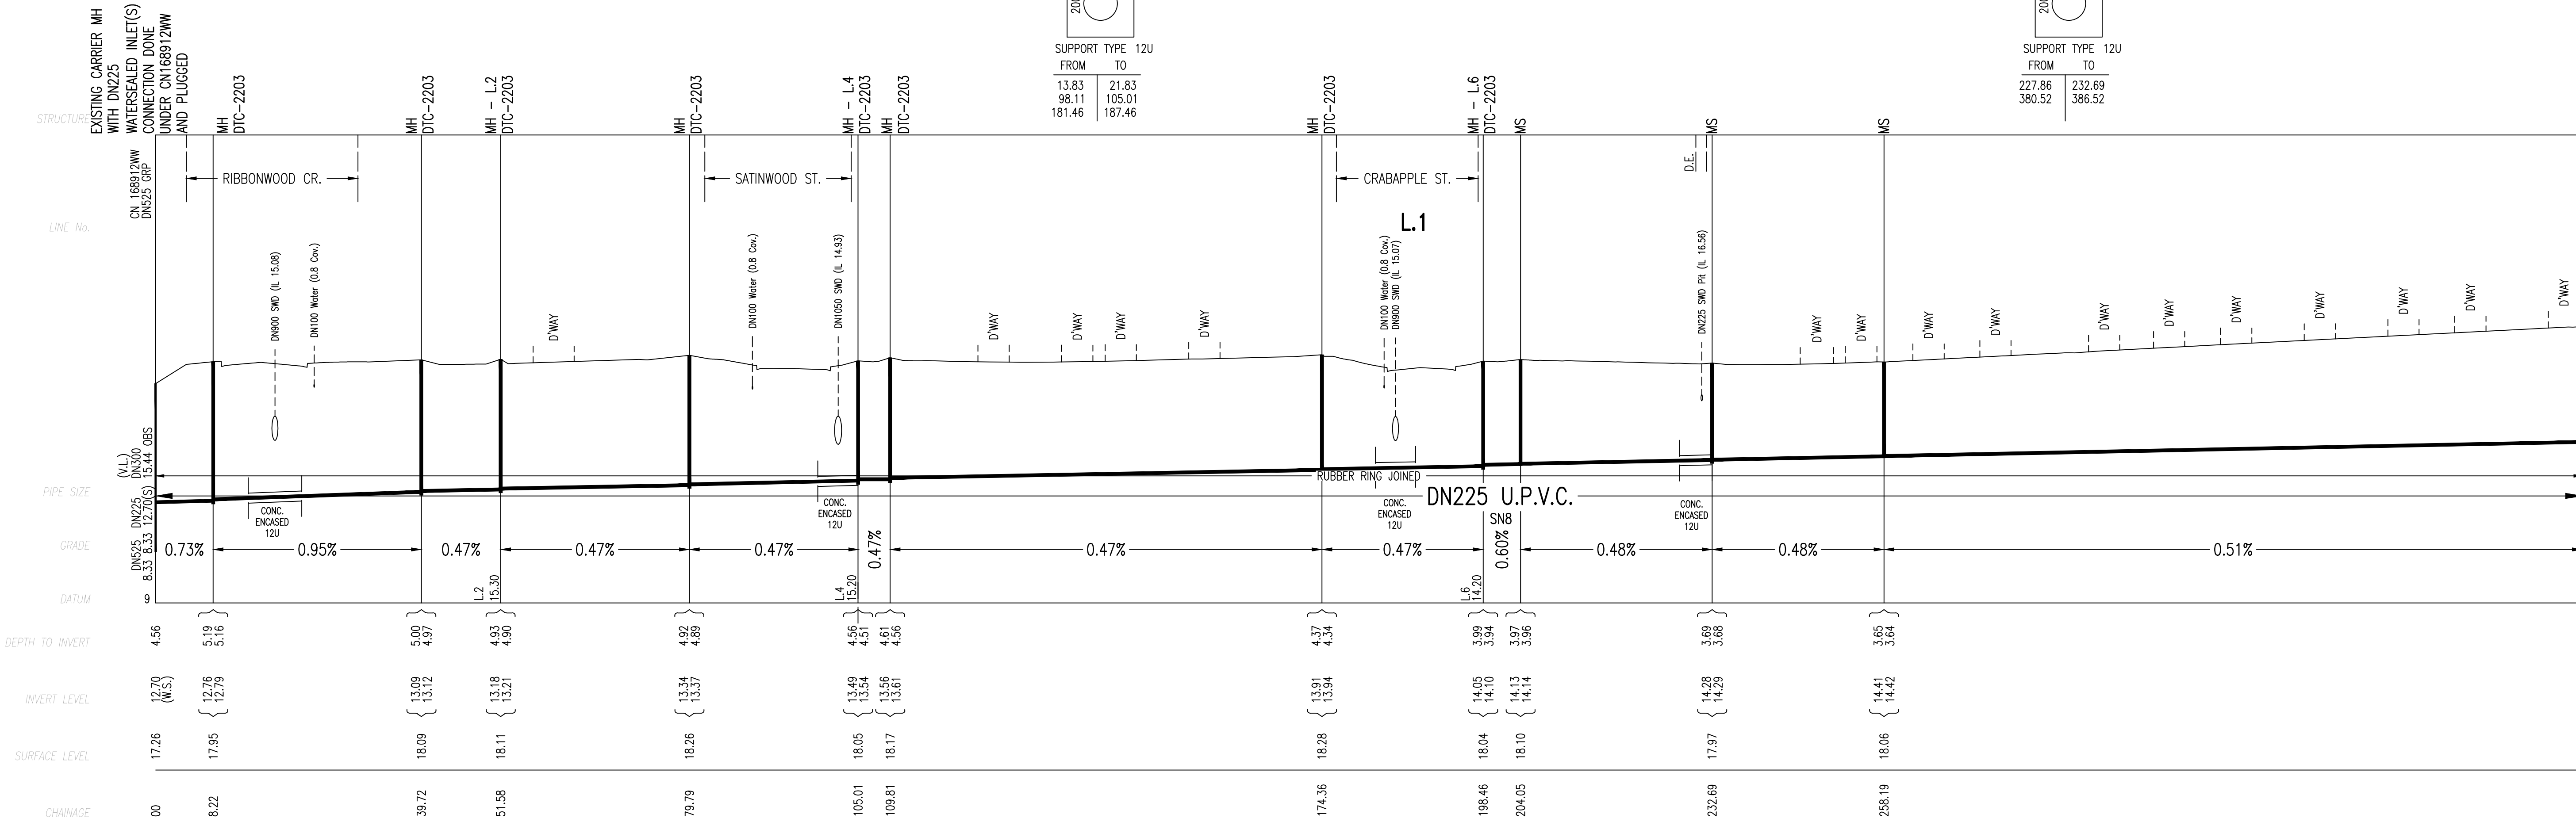

O	WORK AS CONSTRUCTED	J.V.	25.02.19
D	NOTATION CHANGE AS PER SWC REQUEST	F.J.	30.01.19
C	START OF L1 AMENDED	F.J.	14.07.18
B	ISSUE FOR APPROVAL	F.J.	17.03.18
A	DRAFT ISSUE FOR TENDER	F.J.	12.03.18
No.	AMENDMENT DESCRIPTION	BY	DATE



WORK AS CONSTRUCTED CERTIFICATION		<div><div>Sydney WATER</div><div>SYDNEY WATER CORPORATION</div></div>	
DEVELOPER	WOORONG PARK PTY LTD	Case No. 167855WW	SHT 5 OF 9 SHTS.
W.S.C.	QALCHEK PTY LTD		
CONSTRUCTOR	C.J. DOYLE		
COMPLETED	08.08.2018		
W.A.C. PREPARED	25.02.2019		
DESIGNER	QALCHEK PTY LTD	SYDNEY WATER CORPORATION	
I CERTIFY THAT THE WORKS HAVE BEEN CONSTRUCTED IN ACCORDANCE WITH THE WORK AS CONSTRUCTED DRAWINGS		FOR DETAILS OF SERVICES SEE SHEET 1	

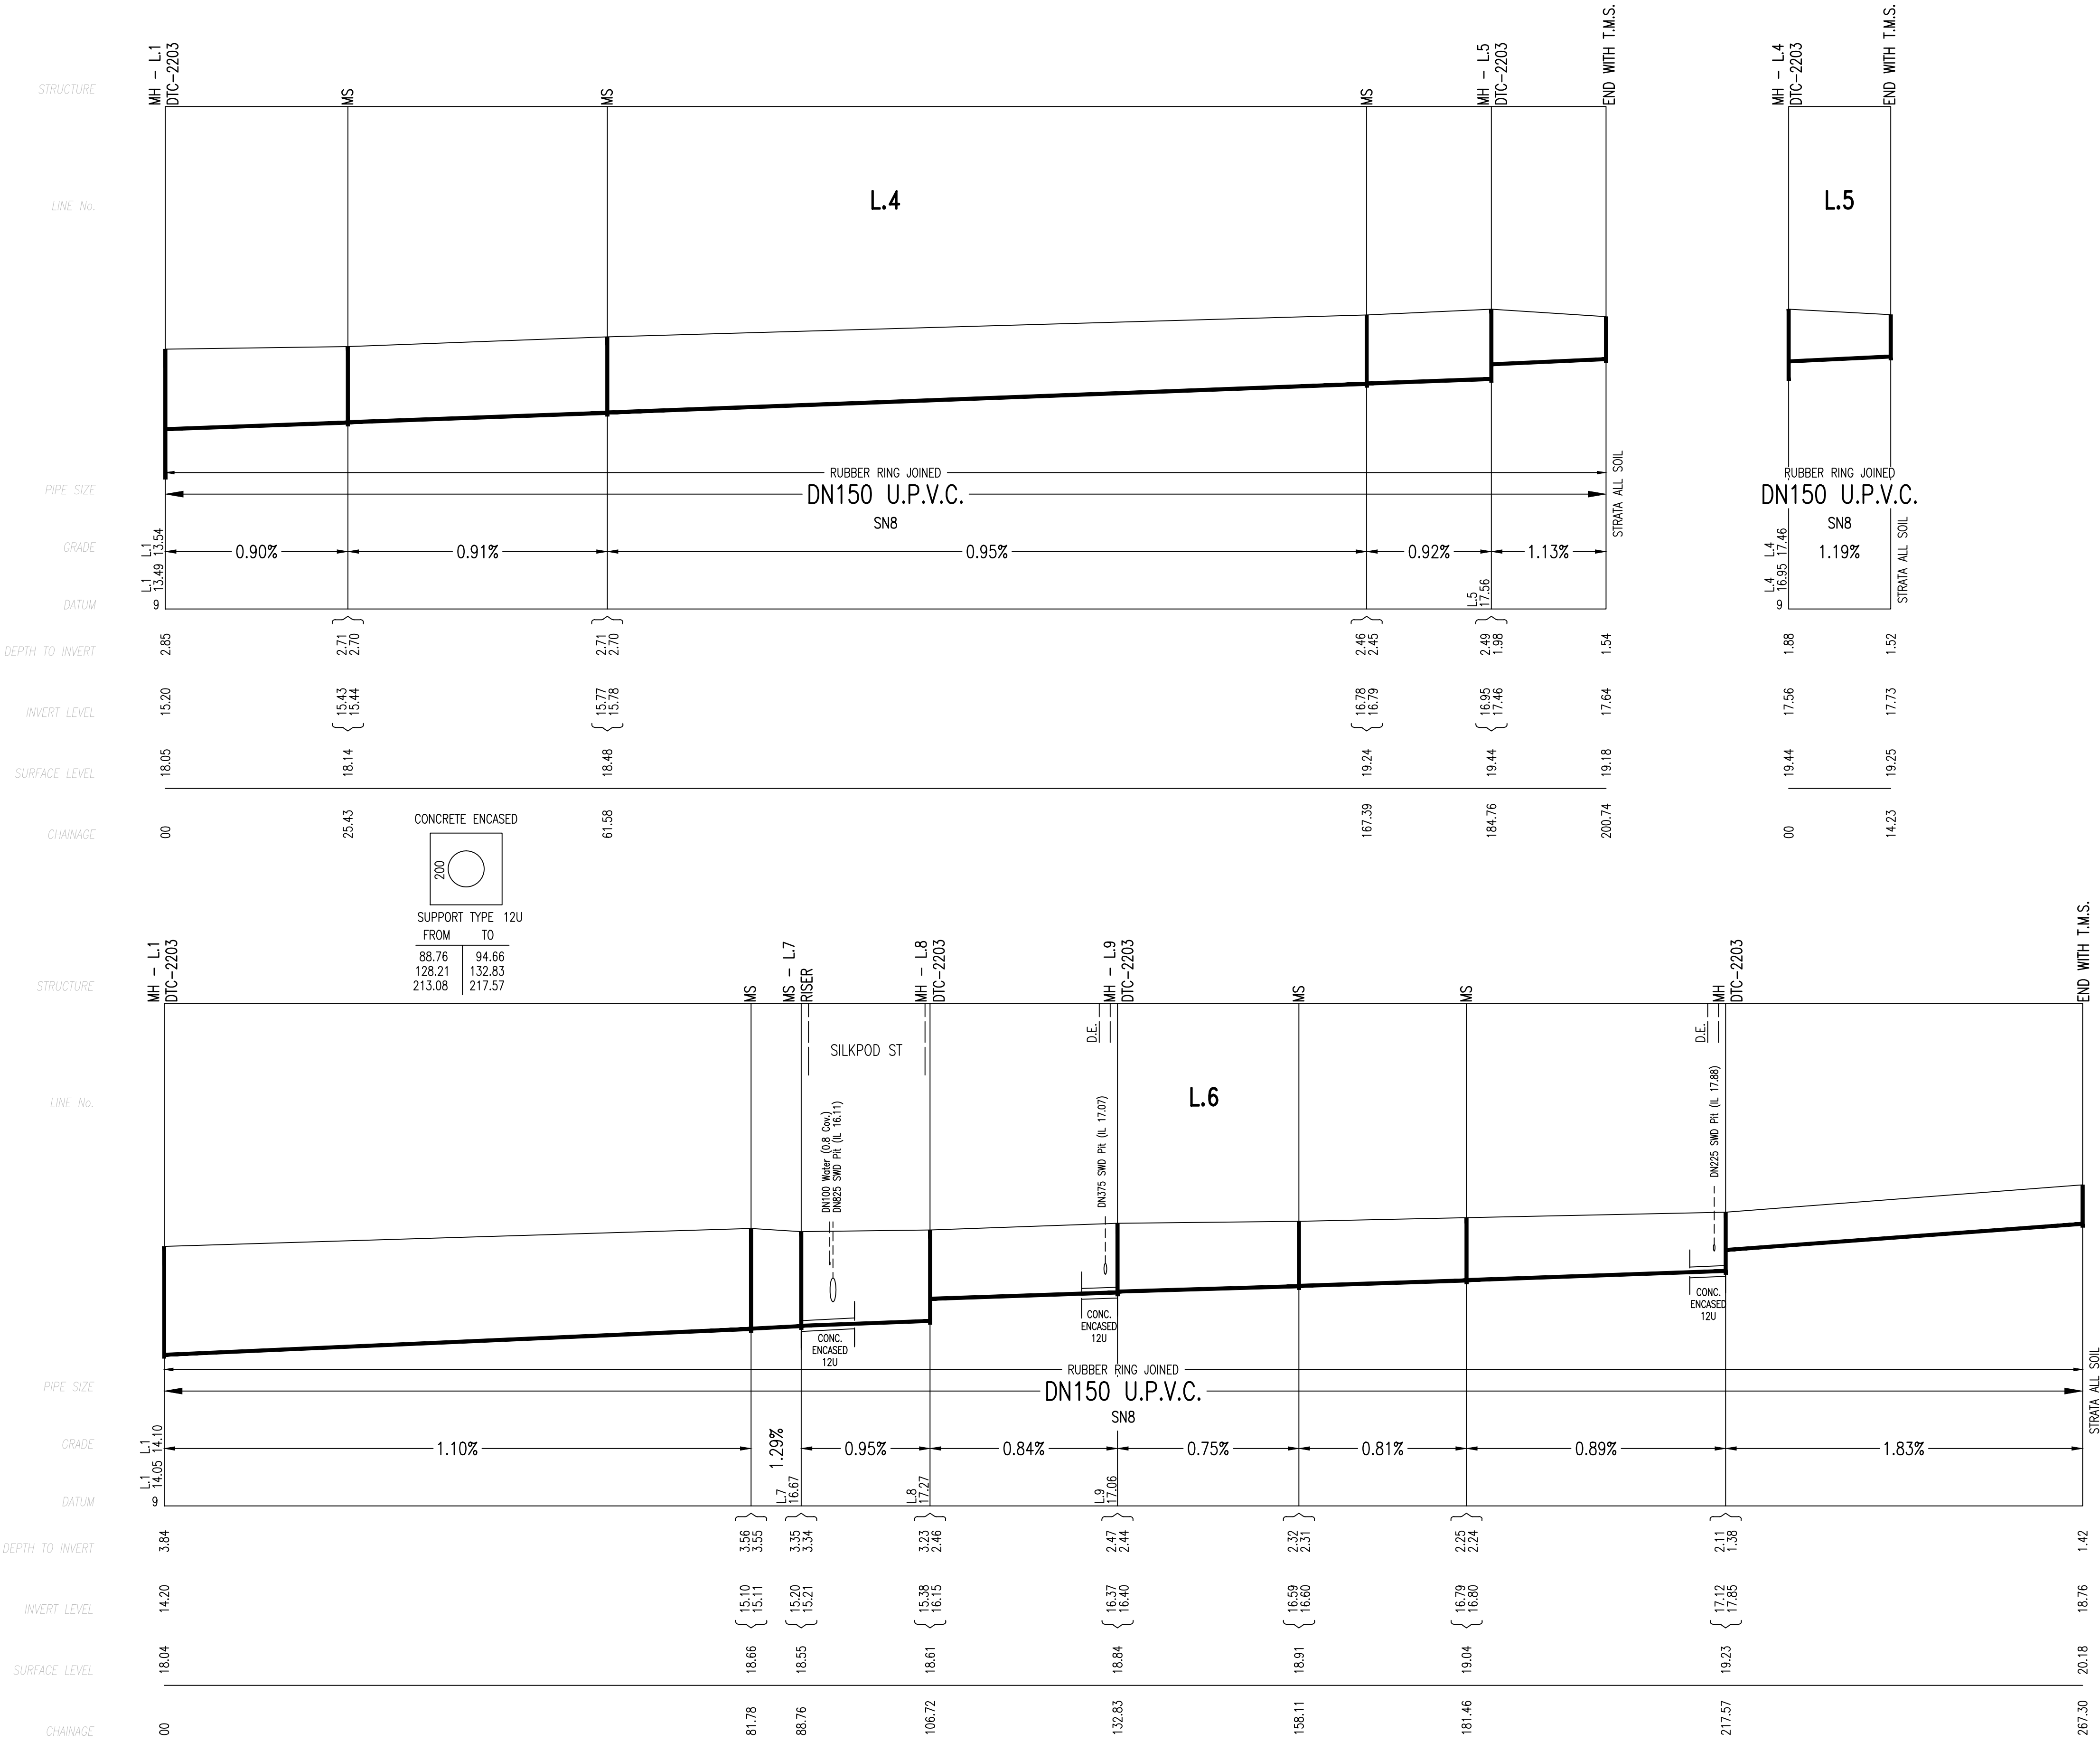

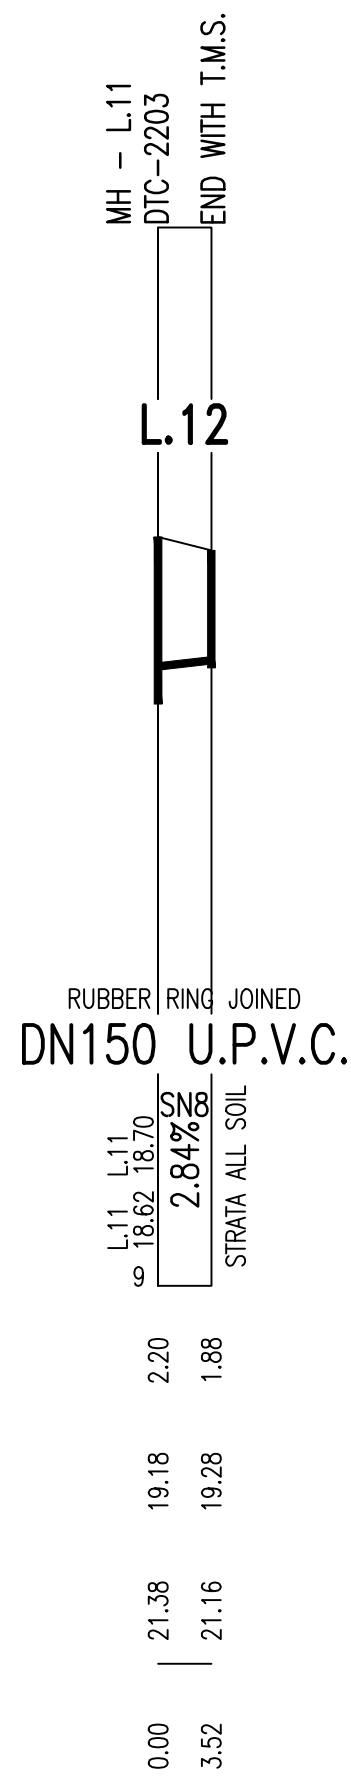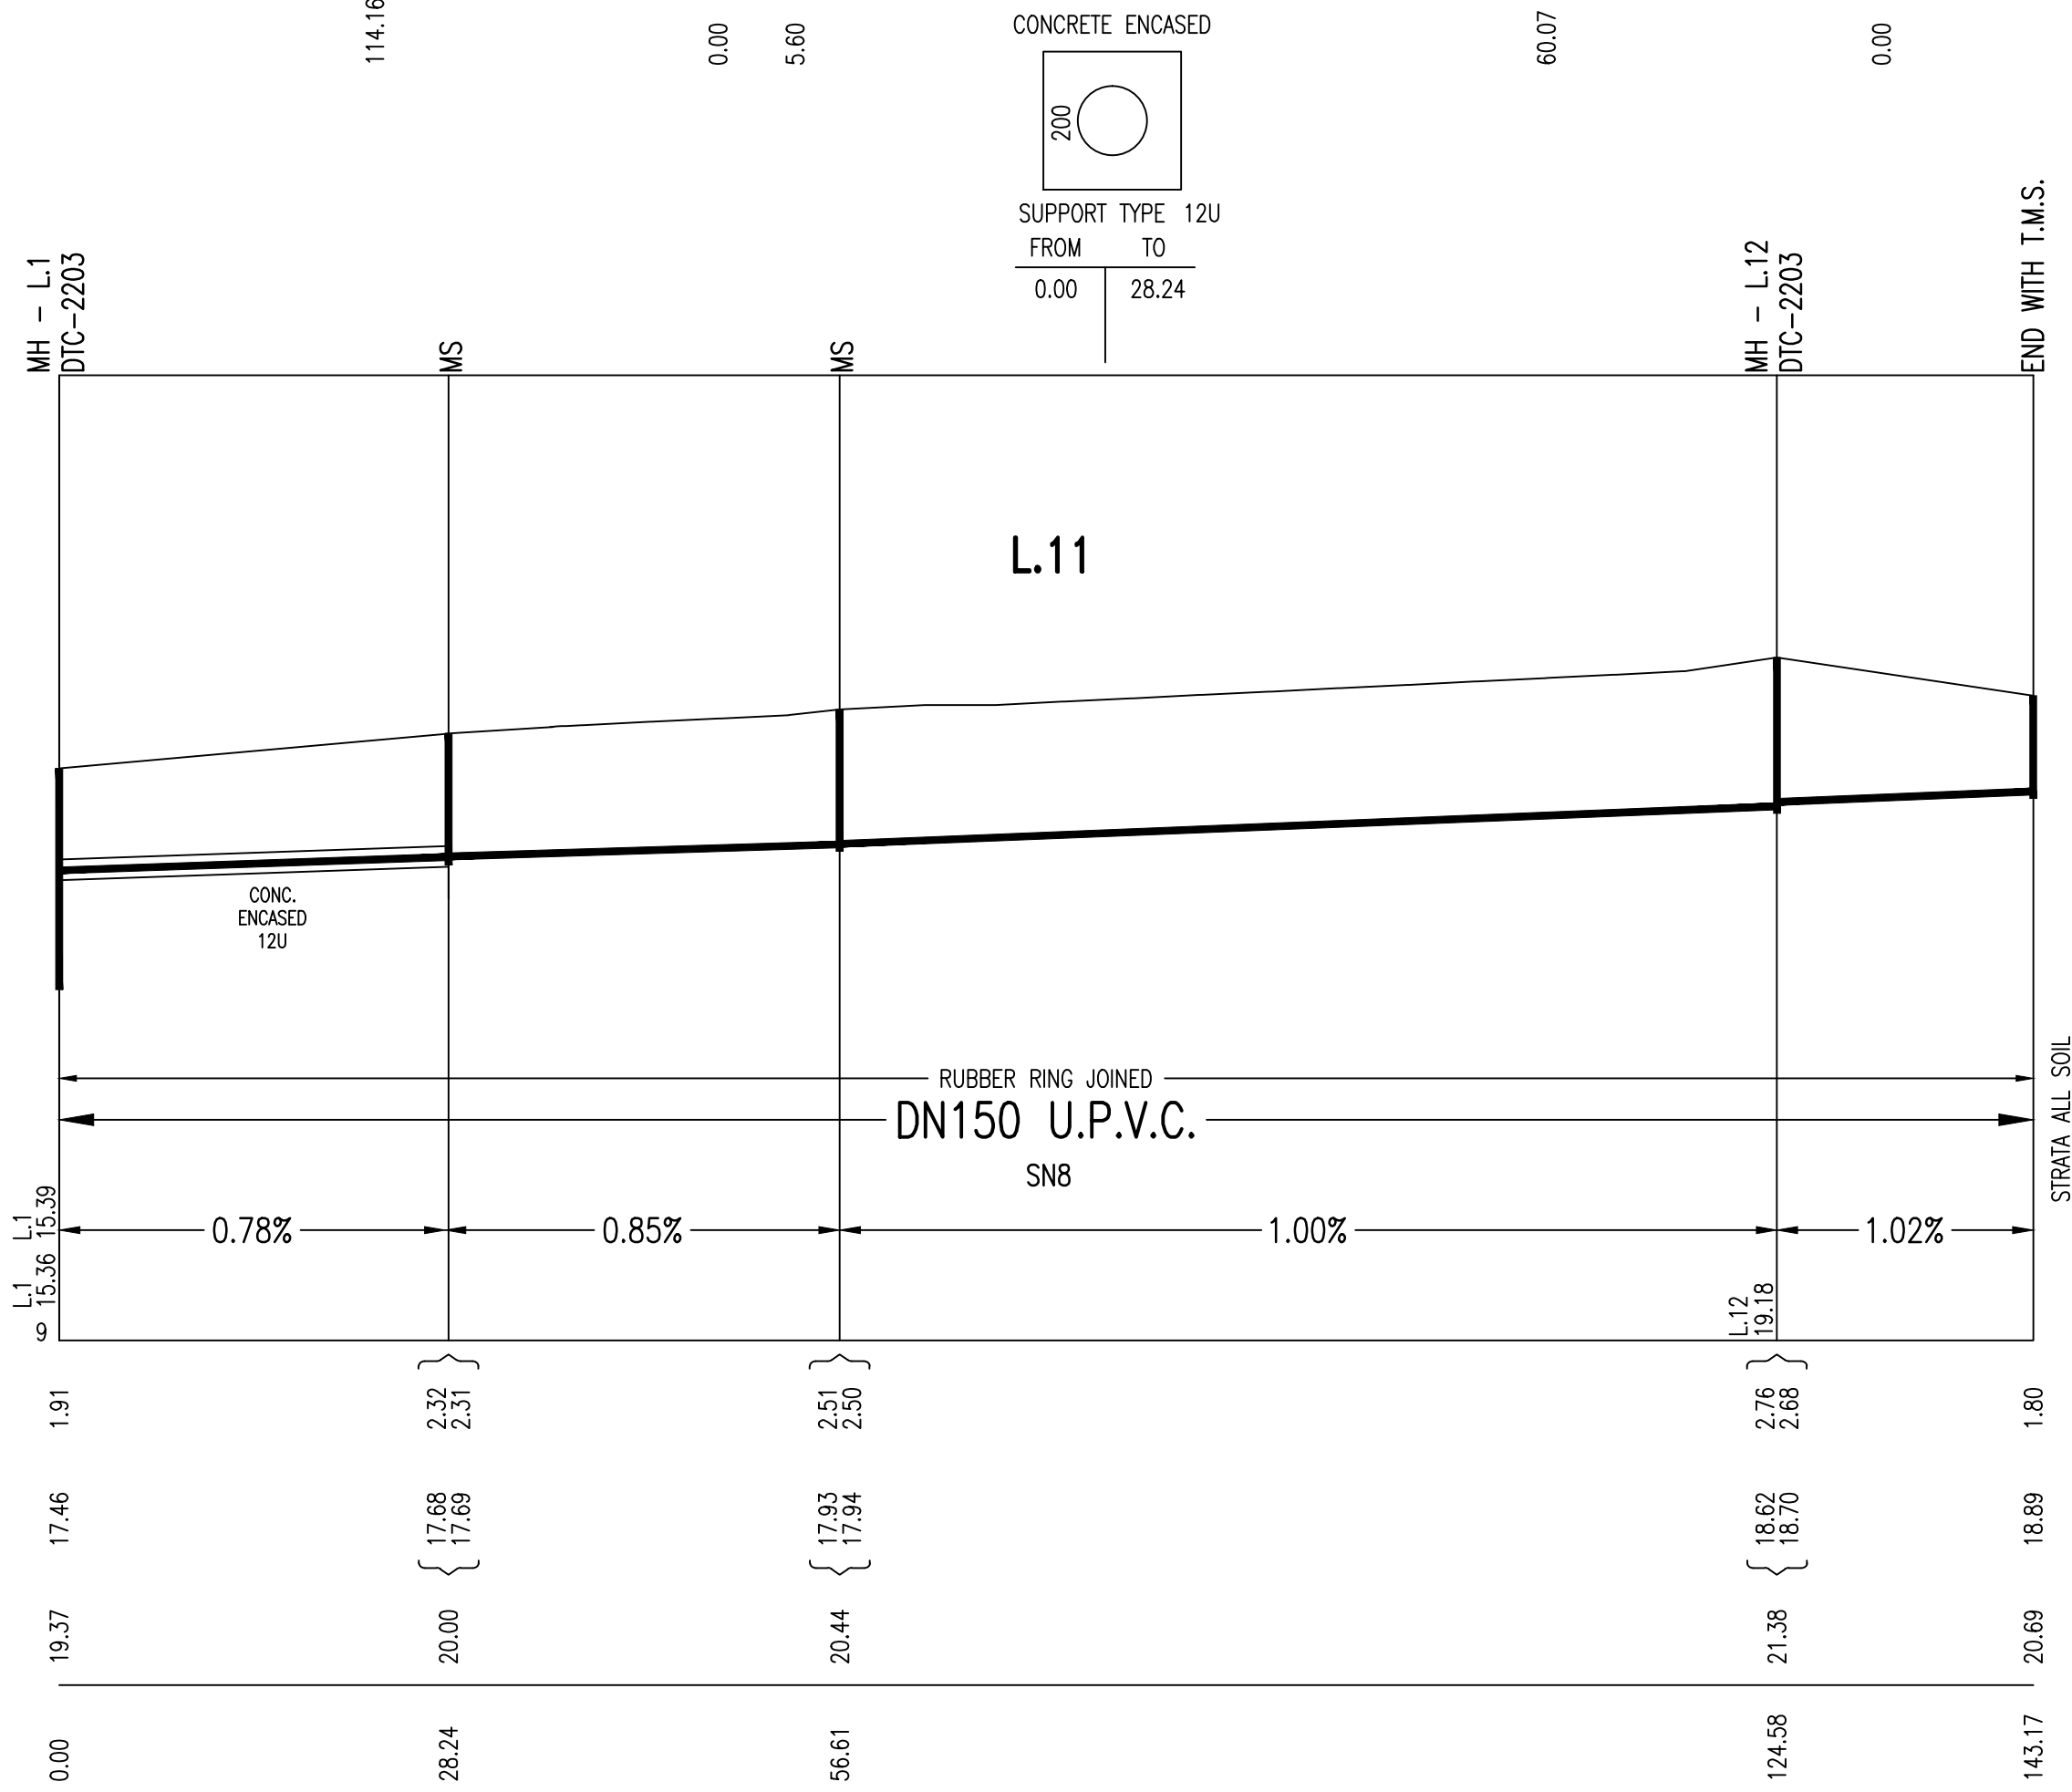
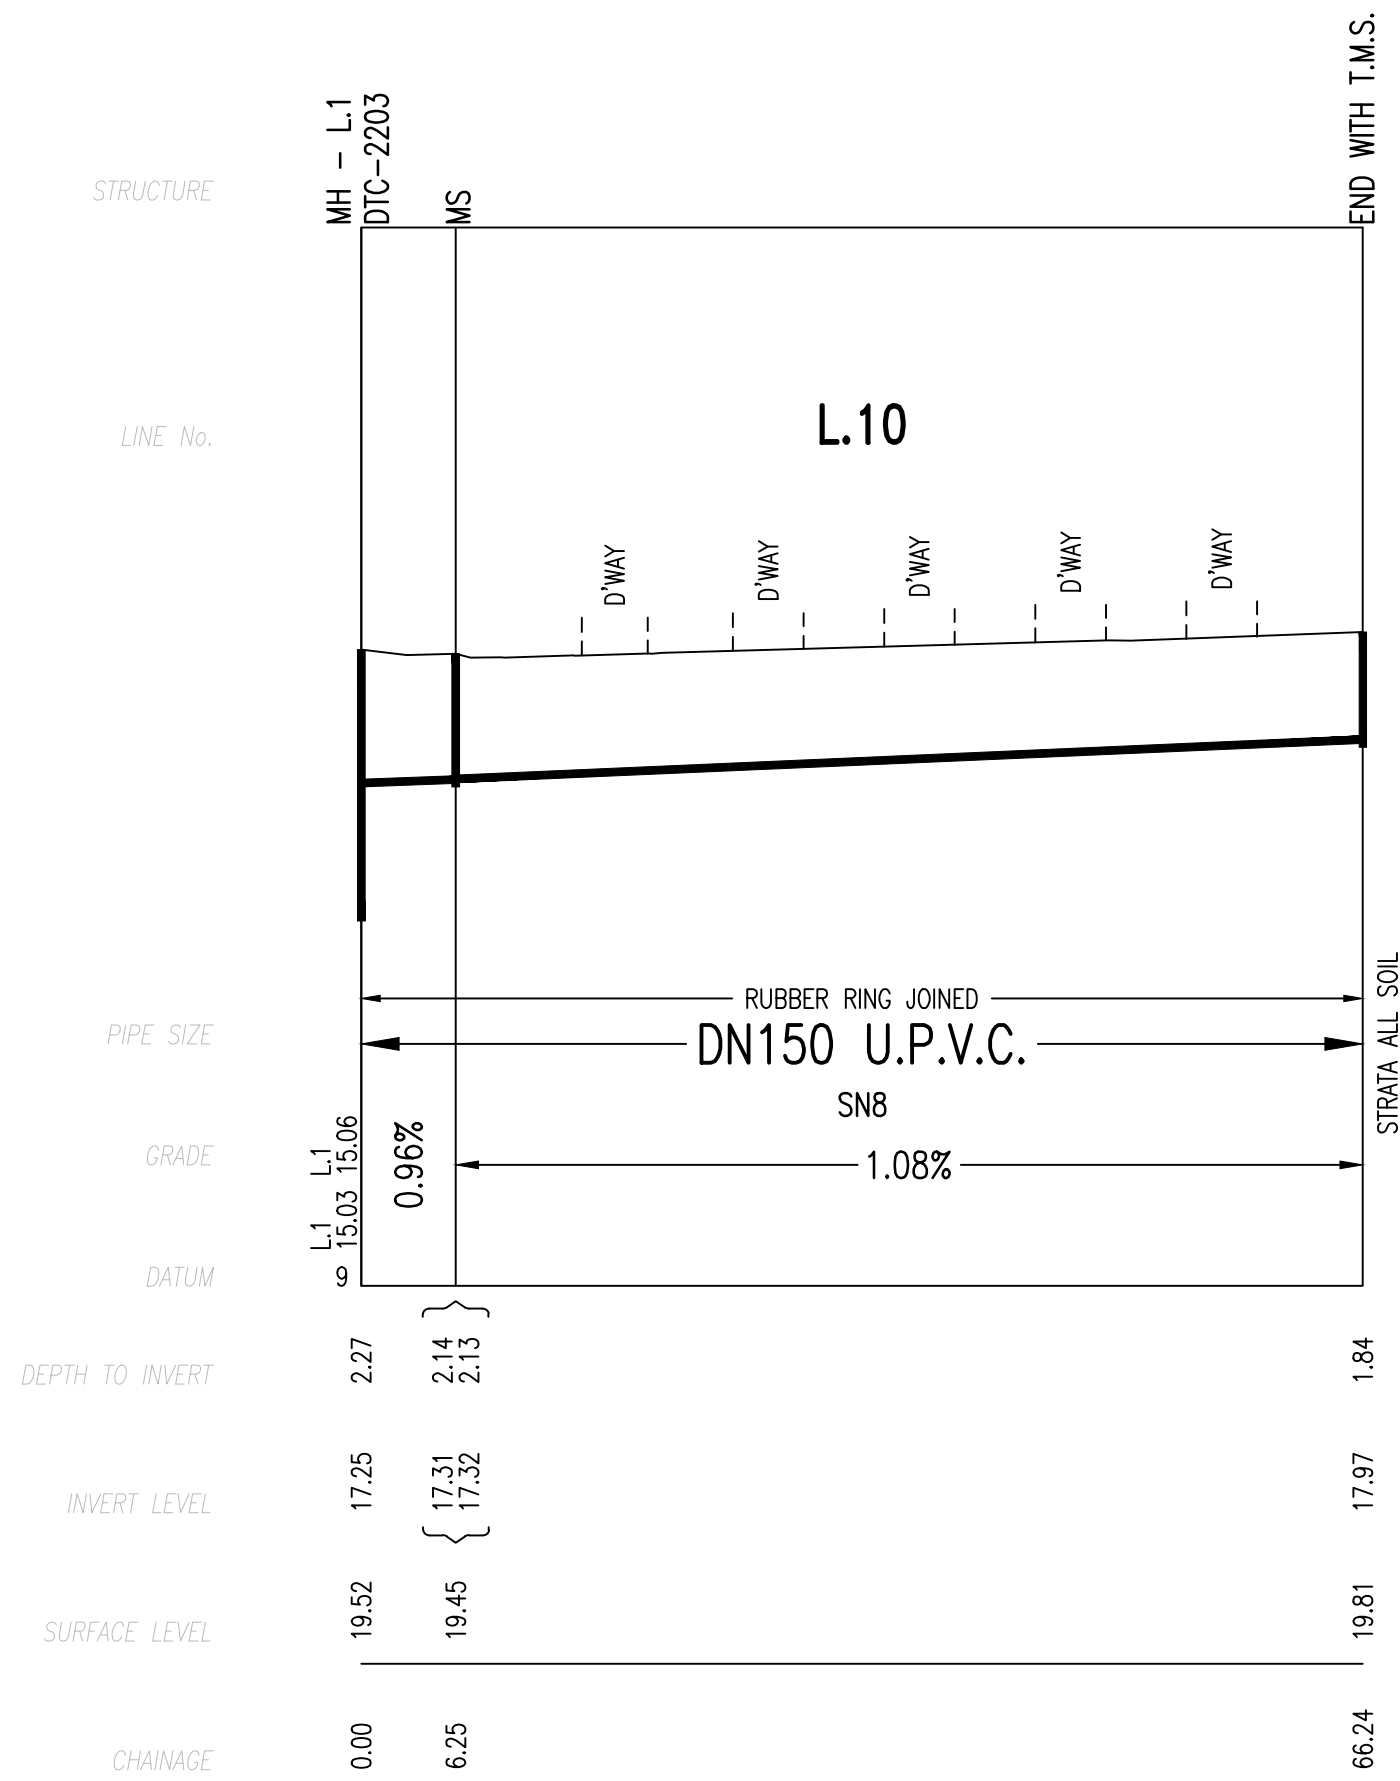
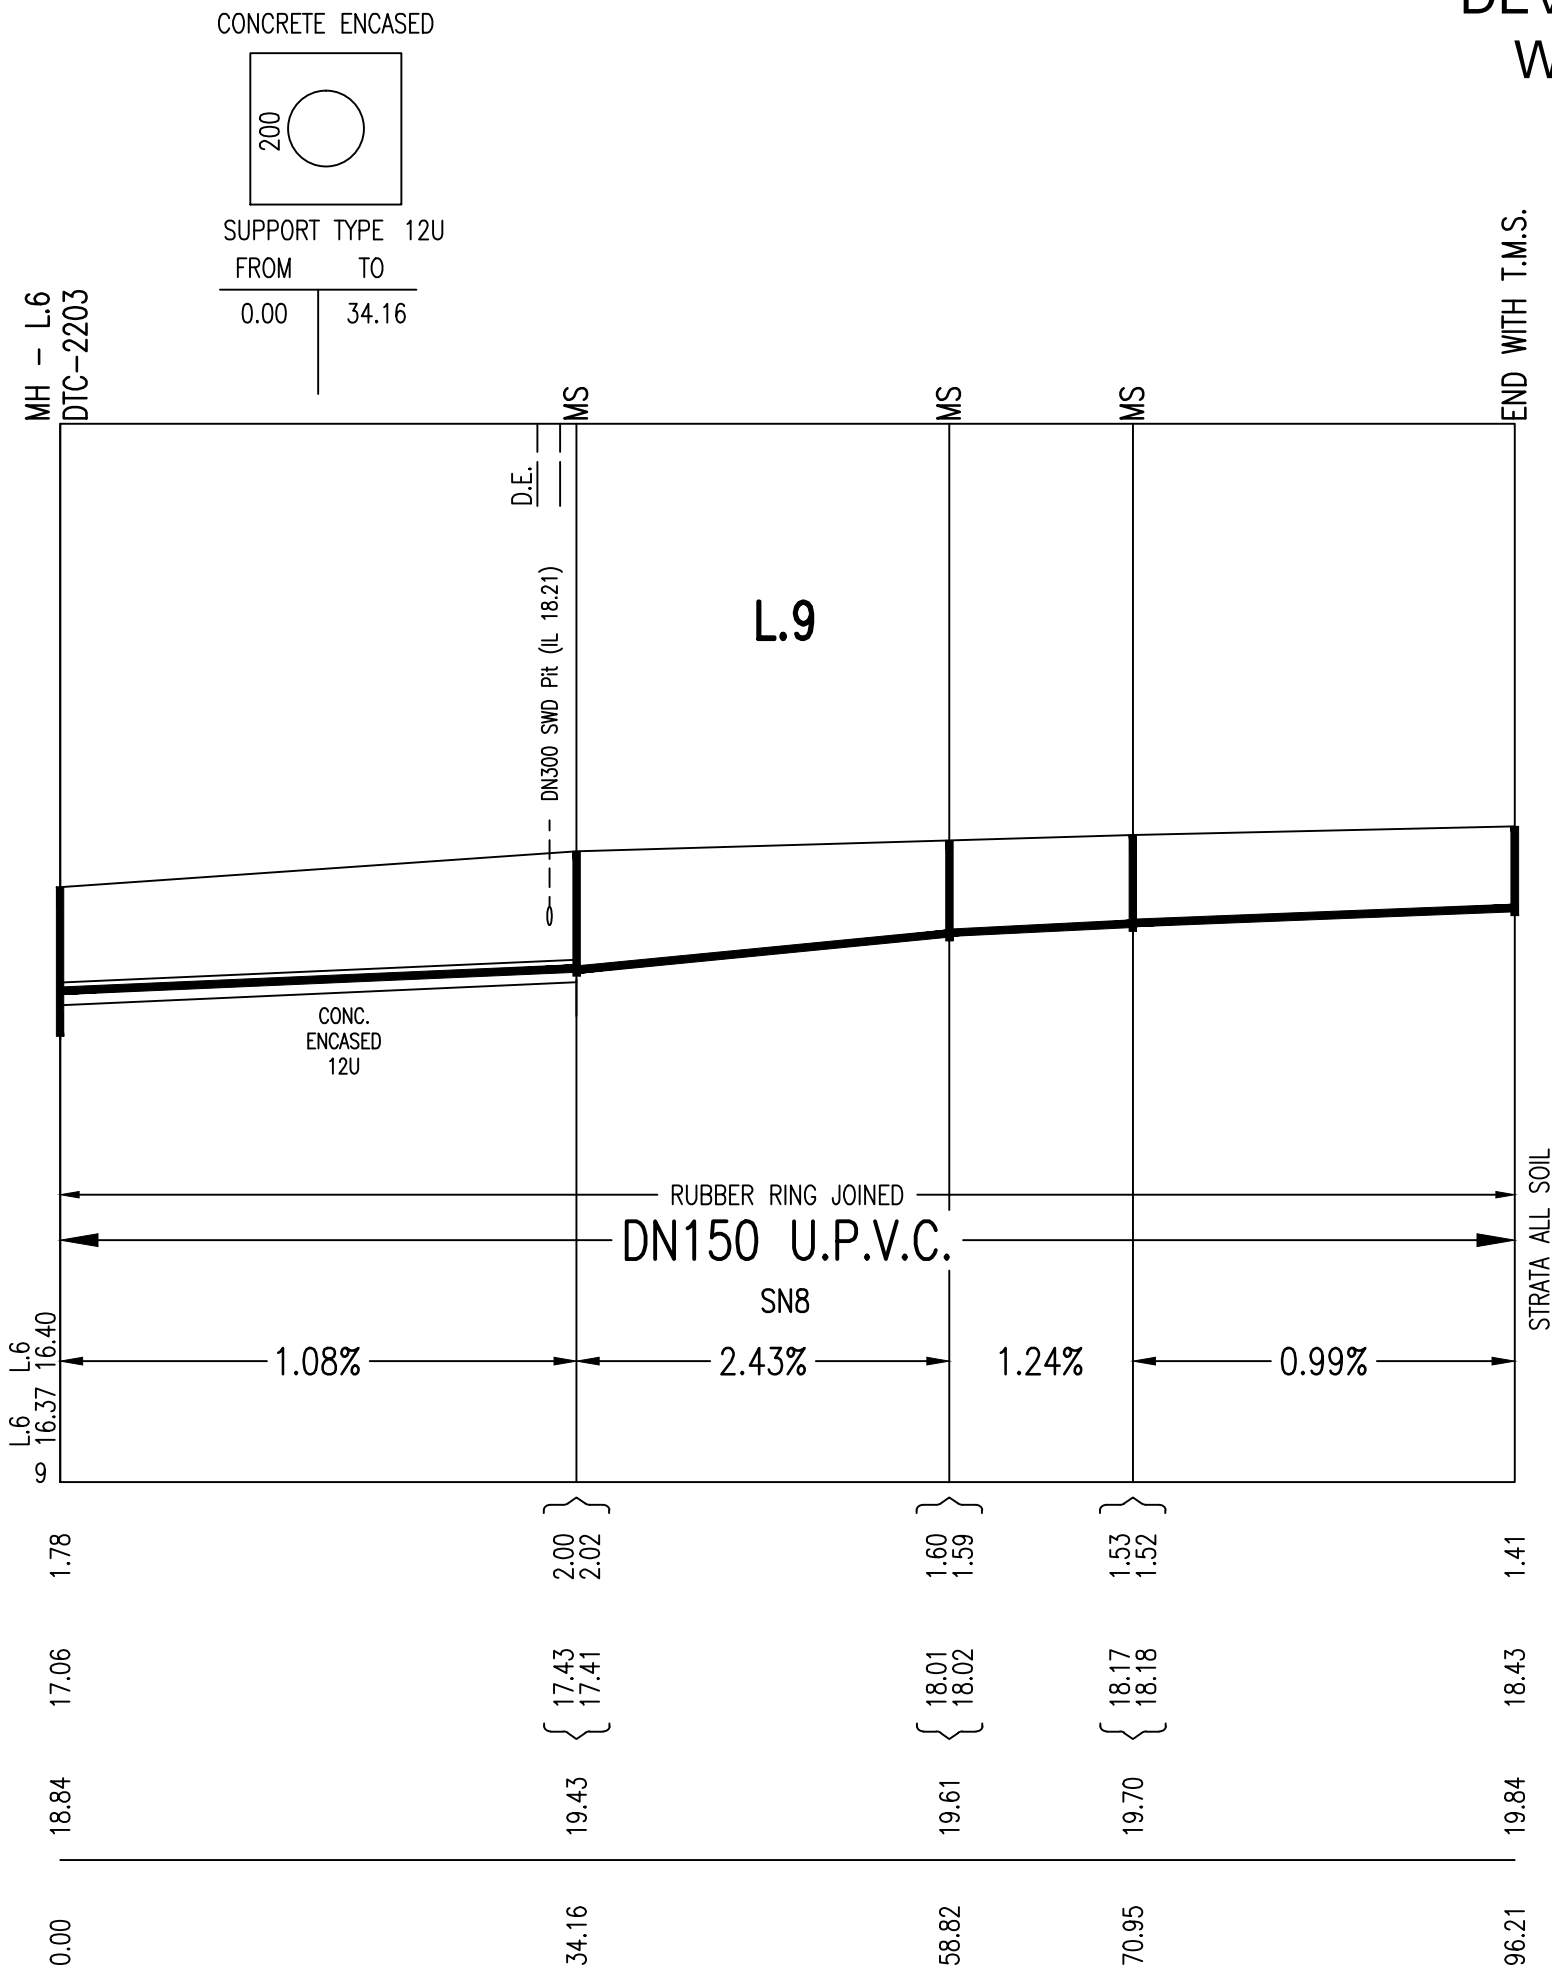
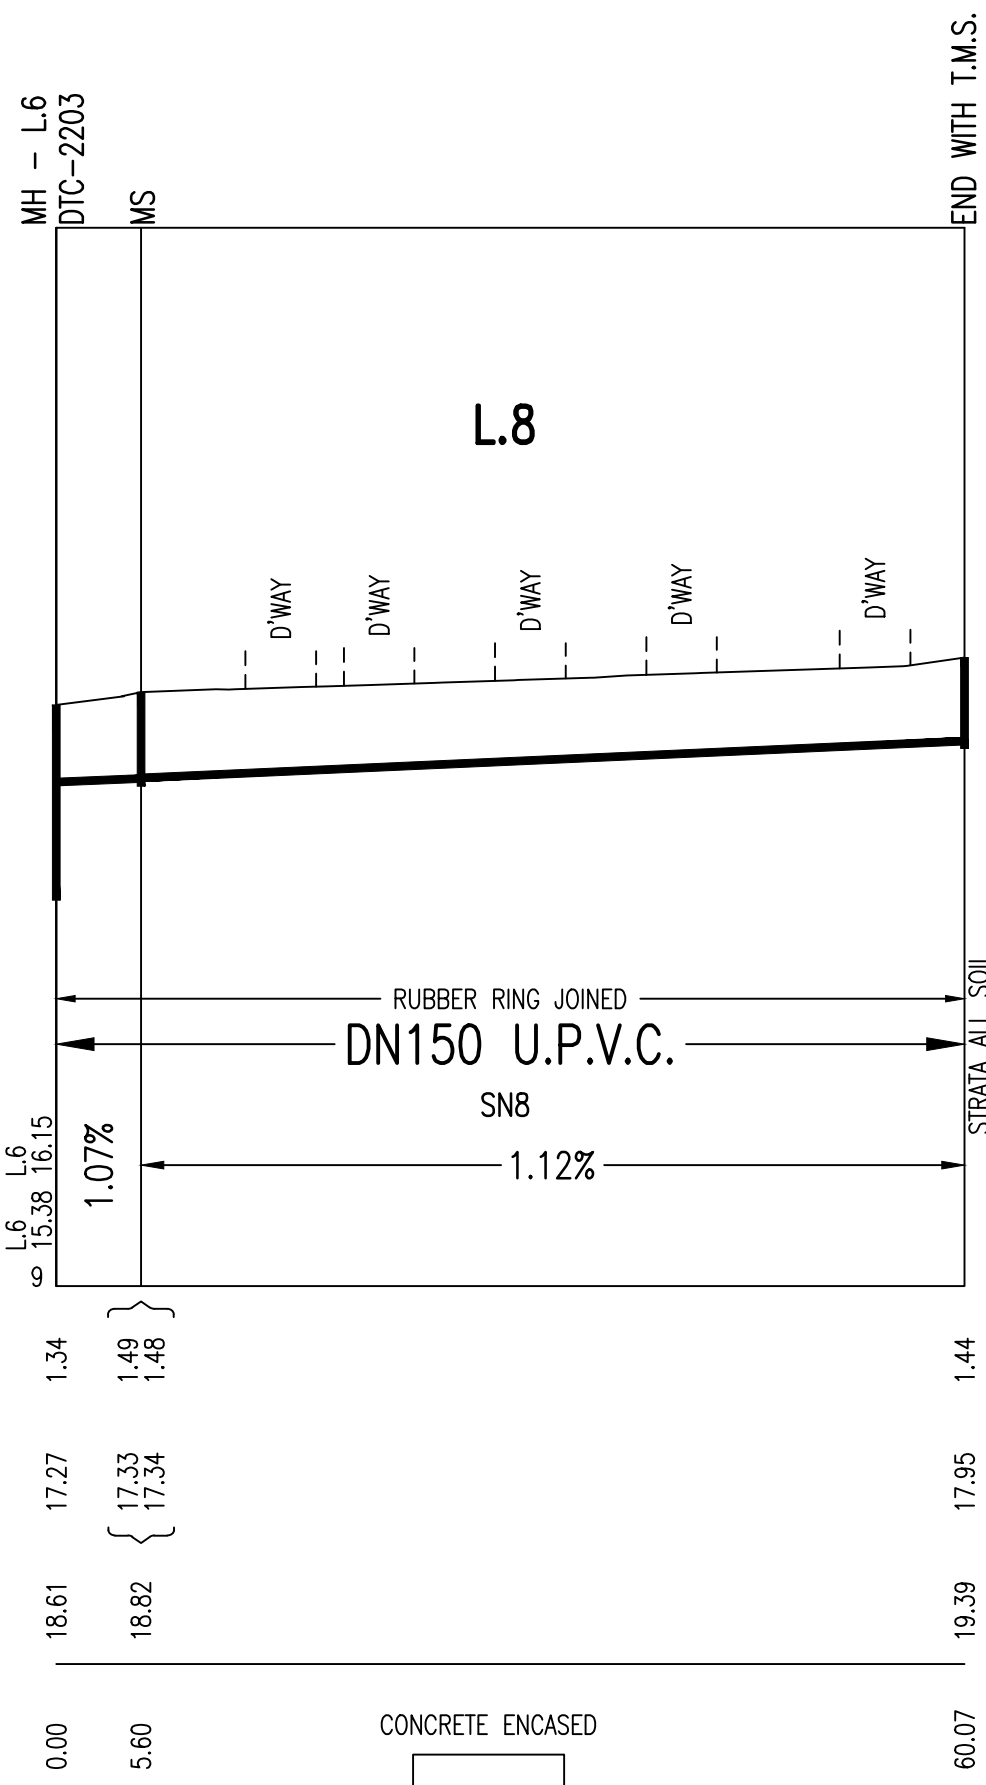
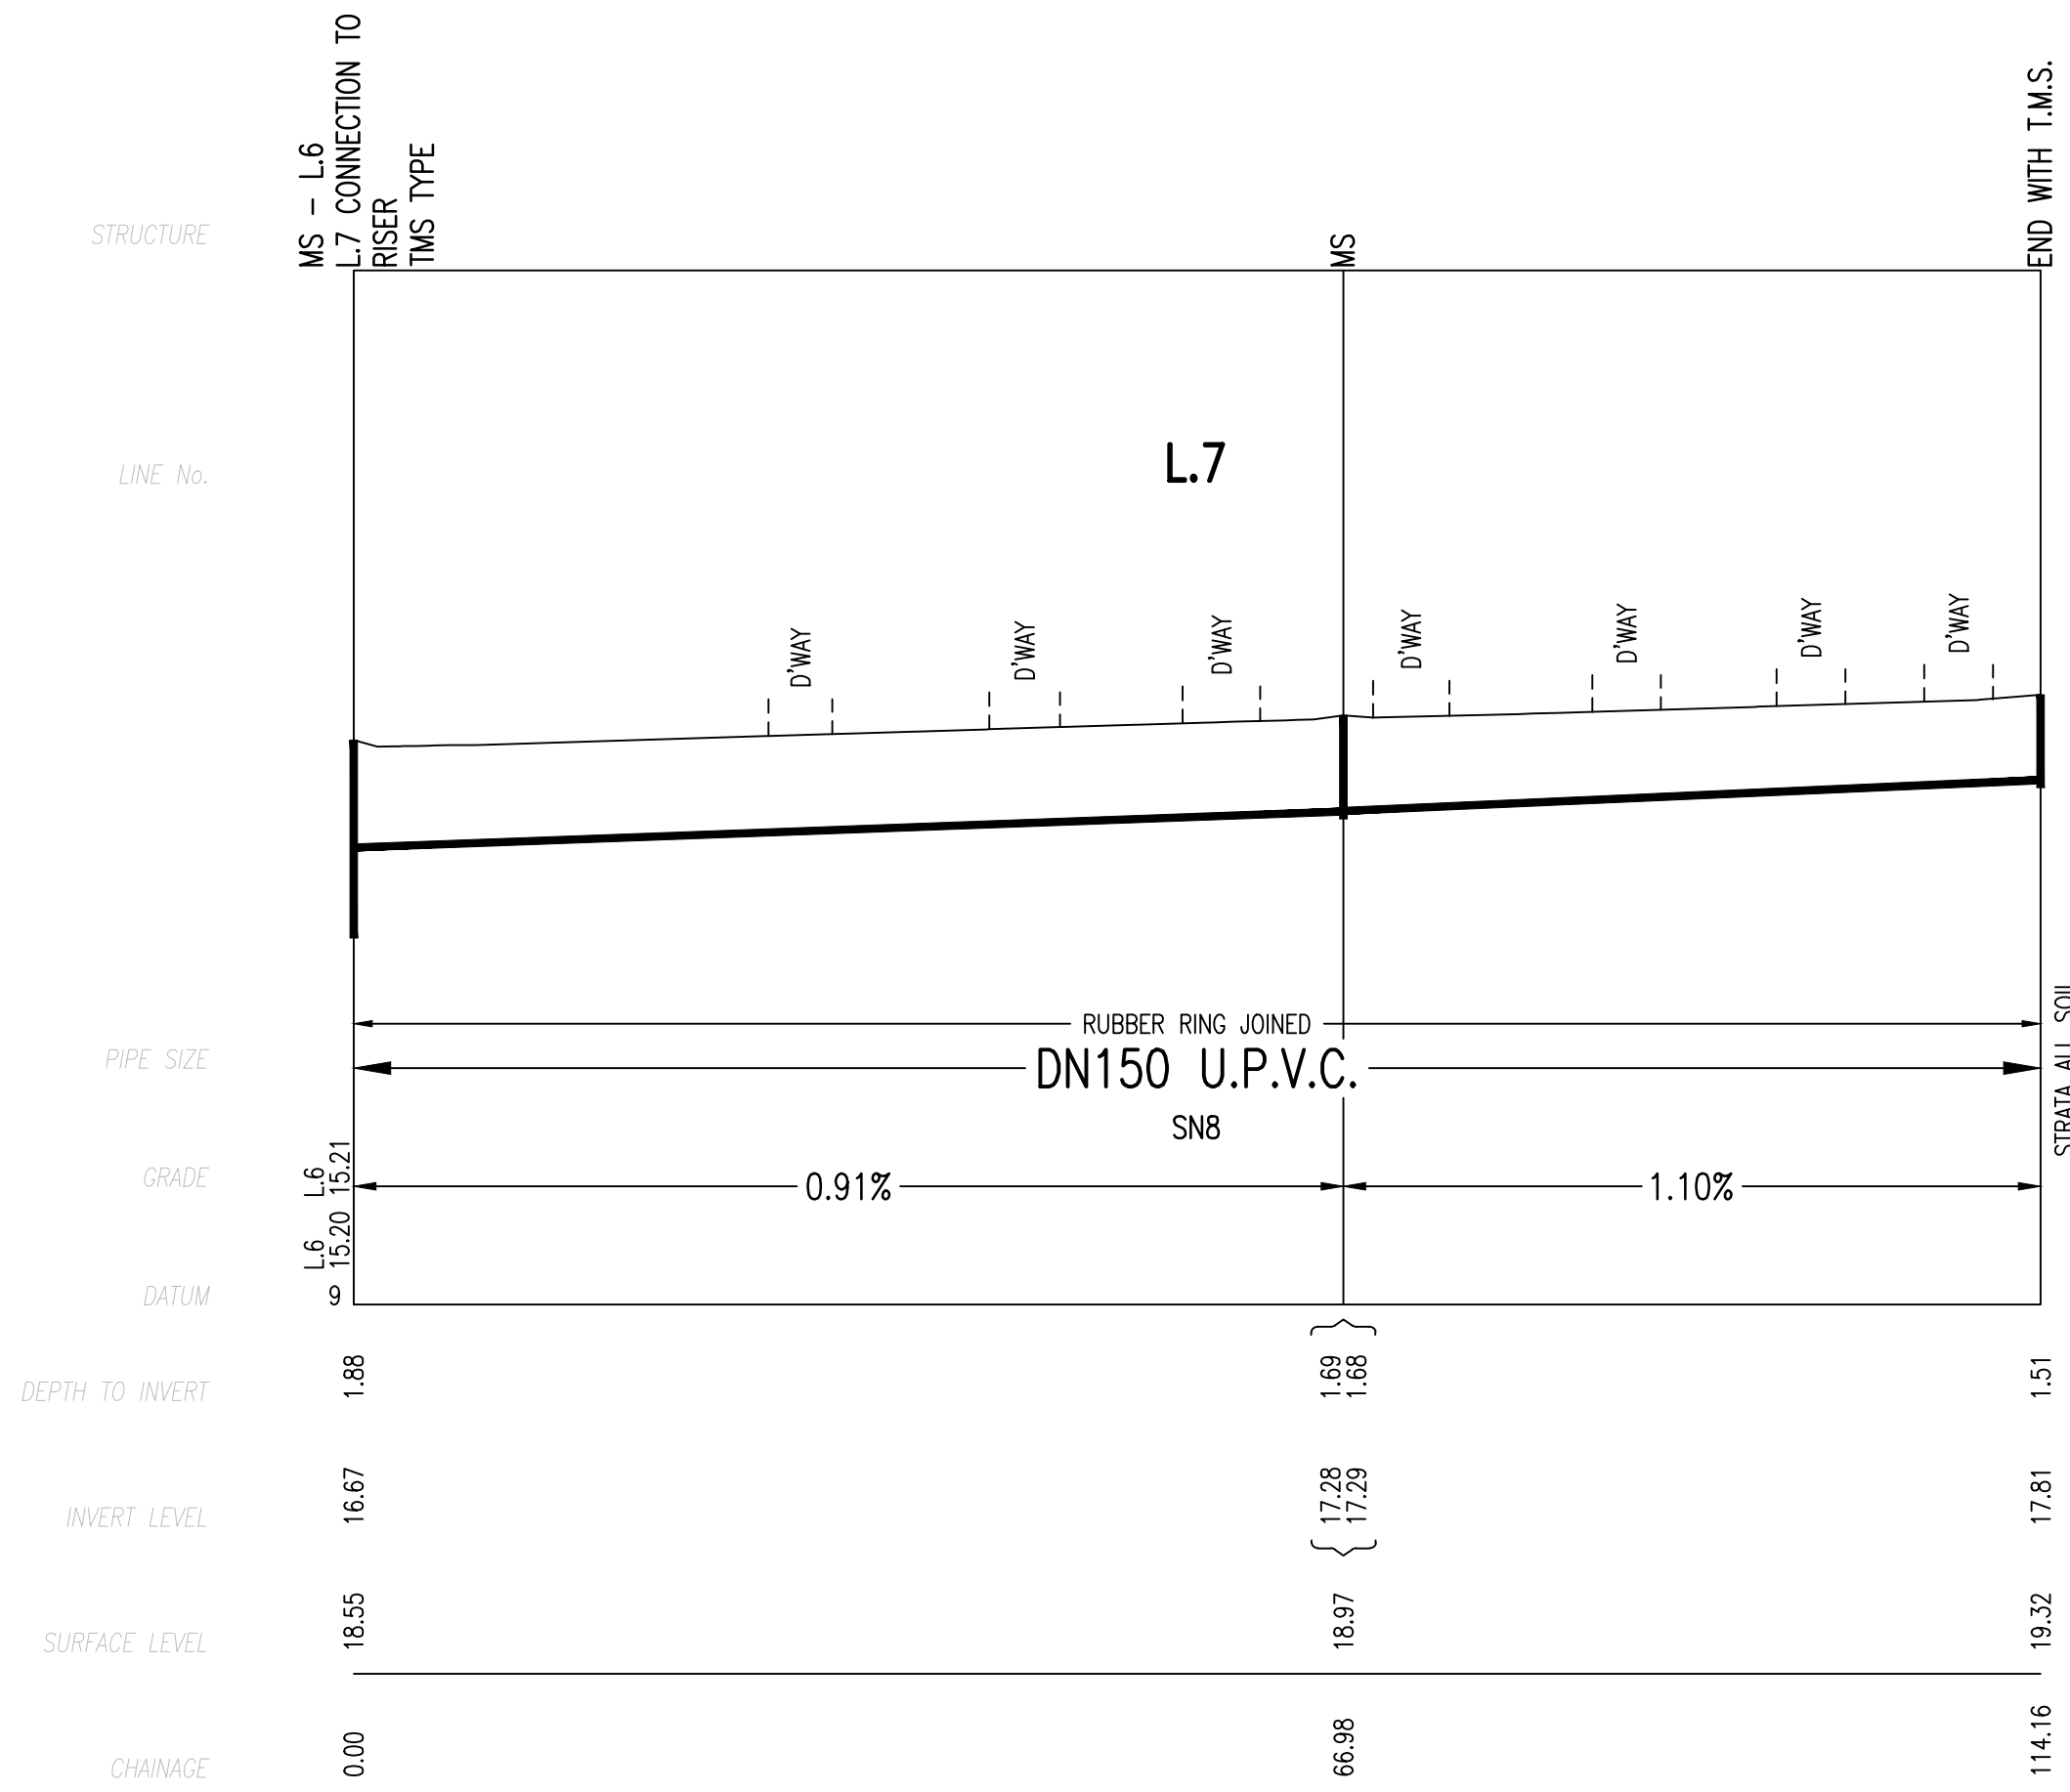


0	WORK AS CONSTRUCTED	J.V.	25.02.19
D	NOTATION CHANGE AS PER SWC REQUEST	F.J.	30.01.19
C	START OF L1 AMENDED	F.J.	14.07.18
B	ISSUE FOR APPROVAL	F.J.	17.03.18
A	DRAFT ISSUE FOR TENDER	F.J.	12.03.18
No.	AMENDMENT DESCRIPTION	BY	DATE

WORK AS CONSTRUCTED CERTIFICATION		SYDNEY WATER CORPORATION	
DEVELOPER	WOORONG PARK PTY LTD	Sydney WATER	
W.S.C.	QALCHEK PTY LTD		
CONSTRUCTOR	C.J. DOYLE	Case No. 167855WW SHT 7 OF 9 SHTS.	
COMPLETED	08.08.2018	SYDNEY WATER CORPORATION	
W.A.C. PREPARED	25.02.2019		
DESIGNER	QALCHEK PTY LTD	FOR DETAILS OF SERVICES SEE SHEET 1	
I CERTIFY THAT THE WORKS HAVE BEEN CONSTRUCTED IN ACCORDANCE WITH THE WORK AS CONSTRUCTED DRAWINGS			

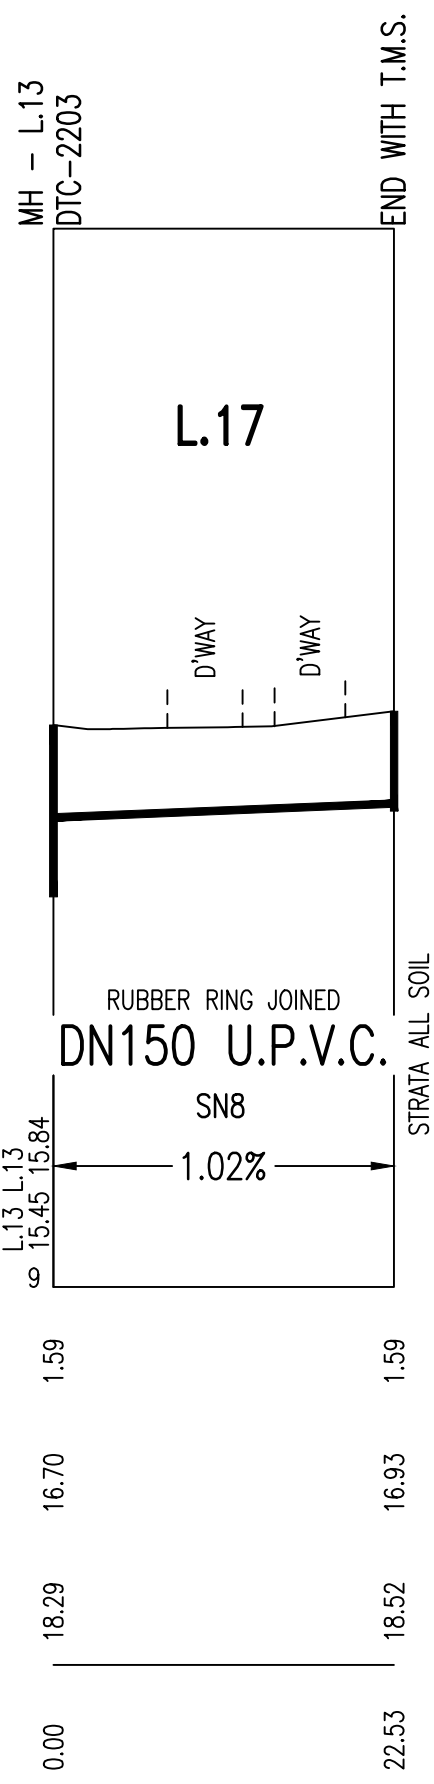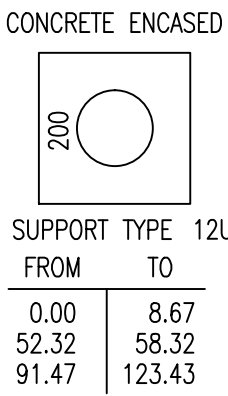

WORK AS CONSTRUCTED CERTIFICATION		Sydney WATER		SYDNEY WATER CORPORATION	
DEVELOPER	WOORONG PARK PTY LTD.	Case No. 167855WWW		SHT 8 OF 9 SHTS.	
W.S.C.	GALCHEK PTY LTD.				
CONSTRUCTOR	C.J. DOYLE				
COMPLETED	08.08.2018				
W.A.C. PREPARED	25.02.2019				
DESIGNER	GALCHEK PTY LTD.	SYDNEY WATER CORPORATION			
I CERTIFY THAT THE WORKS HAVE BEEN CONSTRUCTED IN ACCORDANCE WITH THE WORK AS CONSTRUCTED DRAWINGS		FOR DETAILS OF SERVICES SEE SHEET 1			

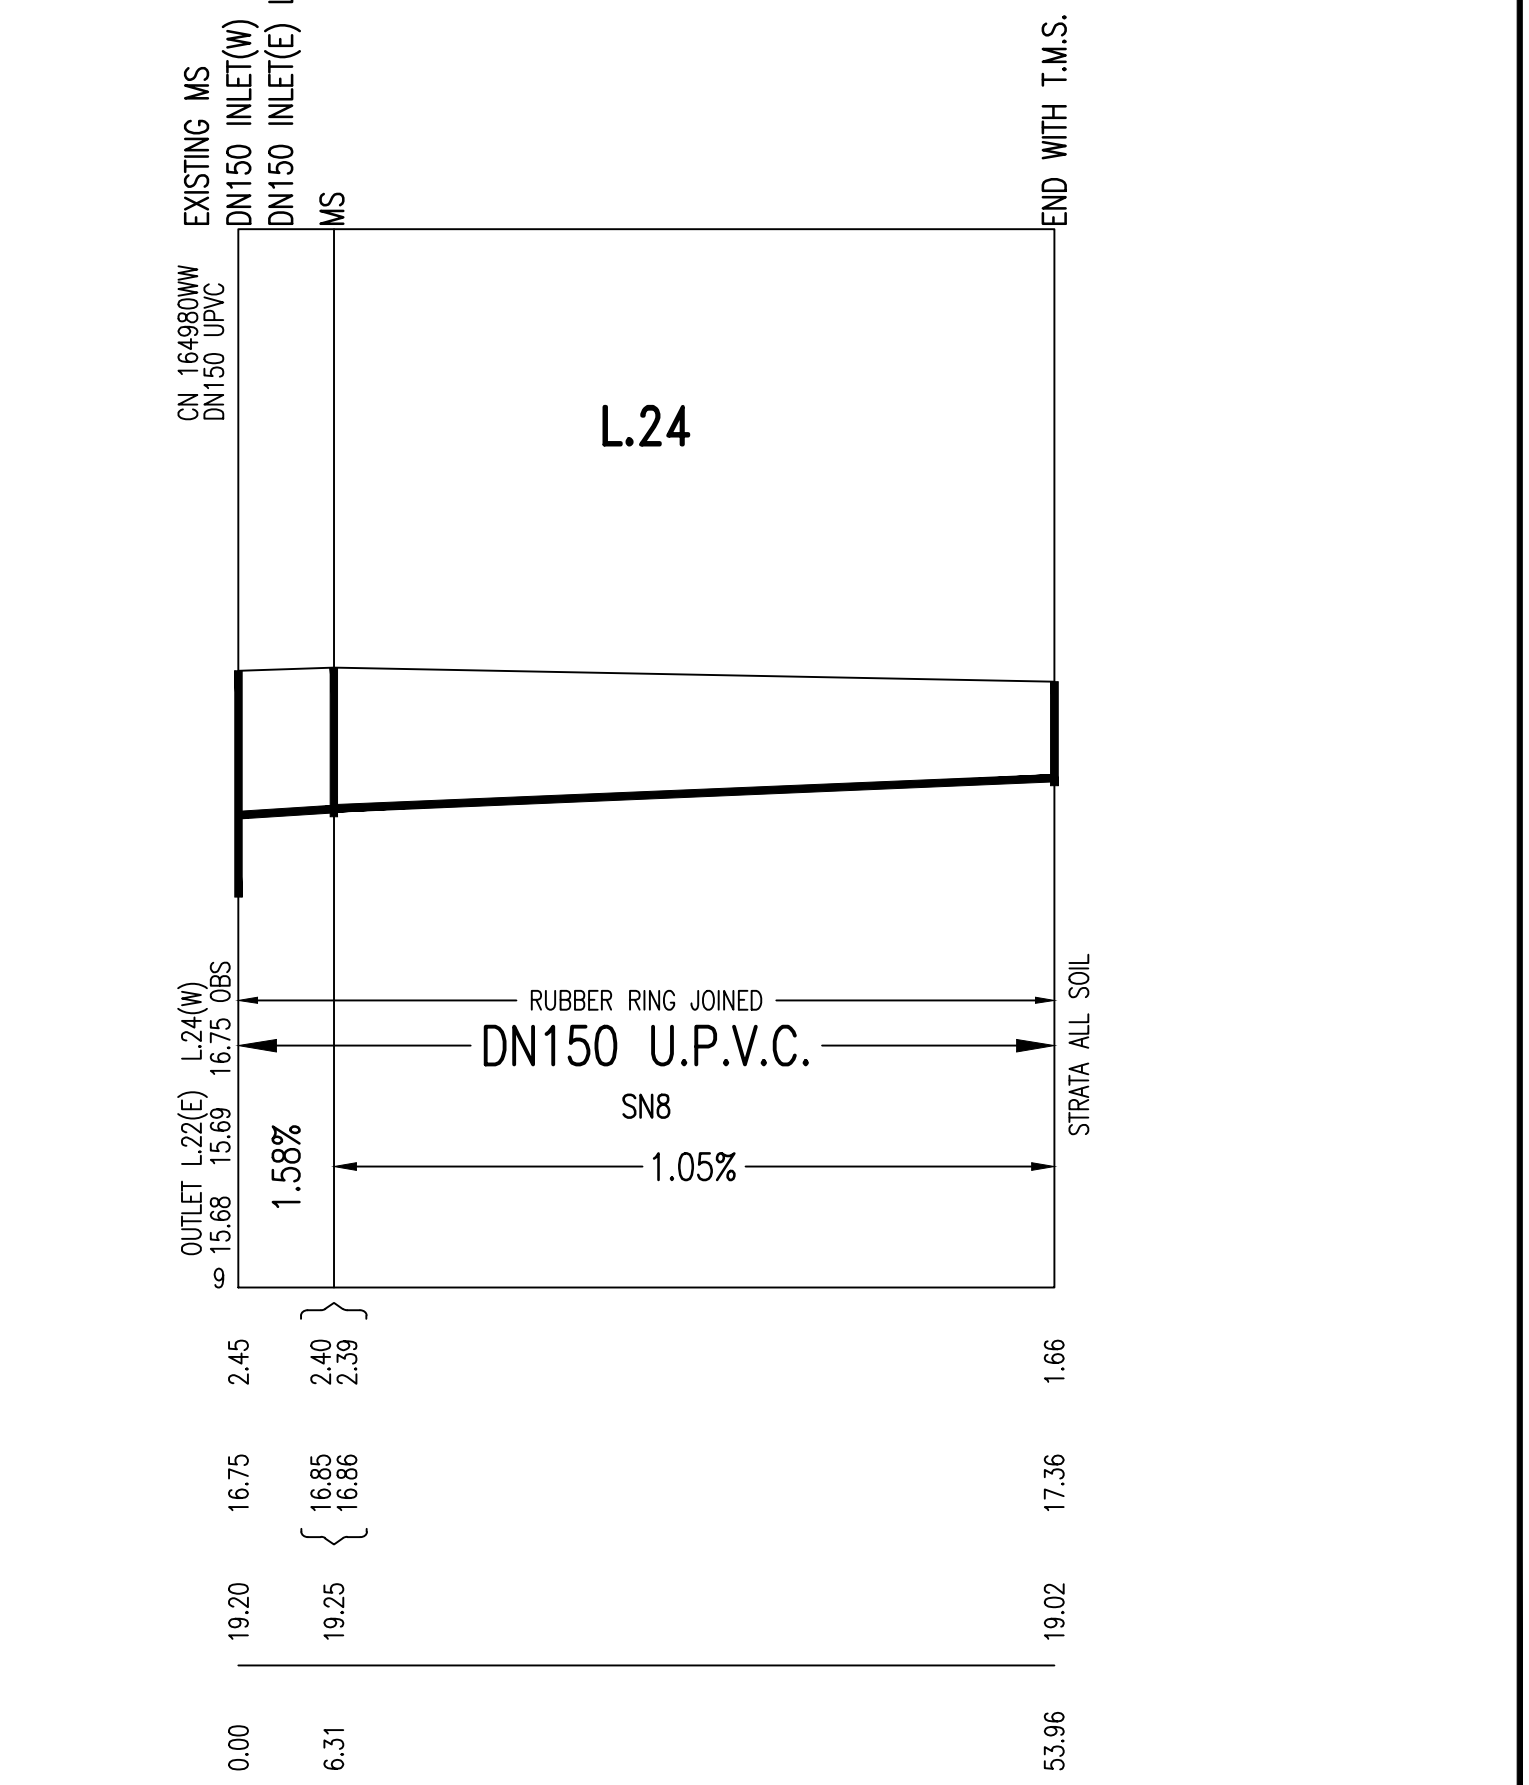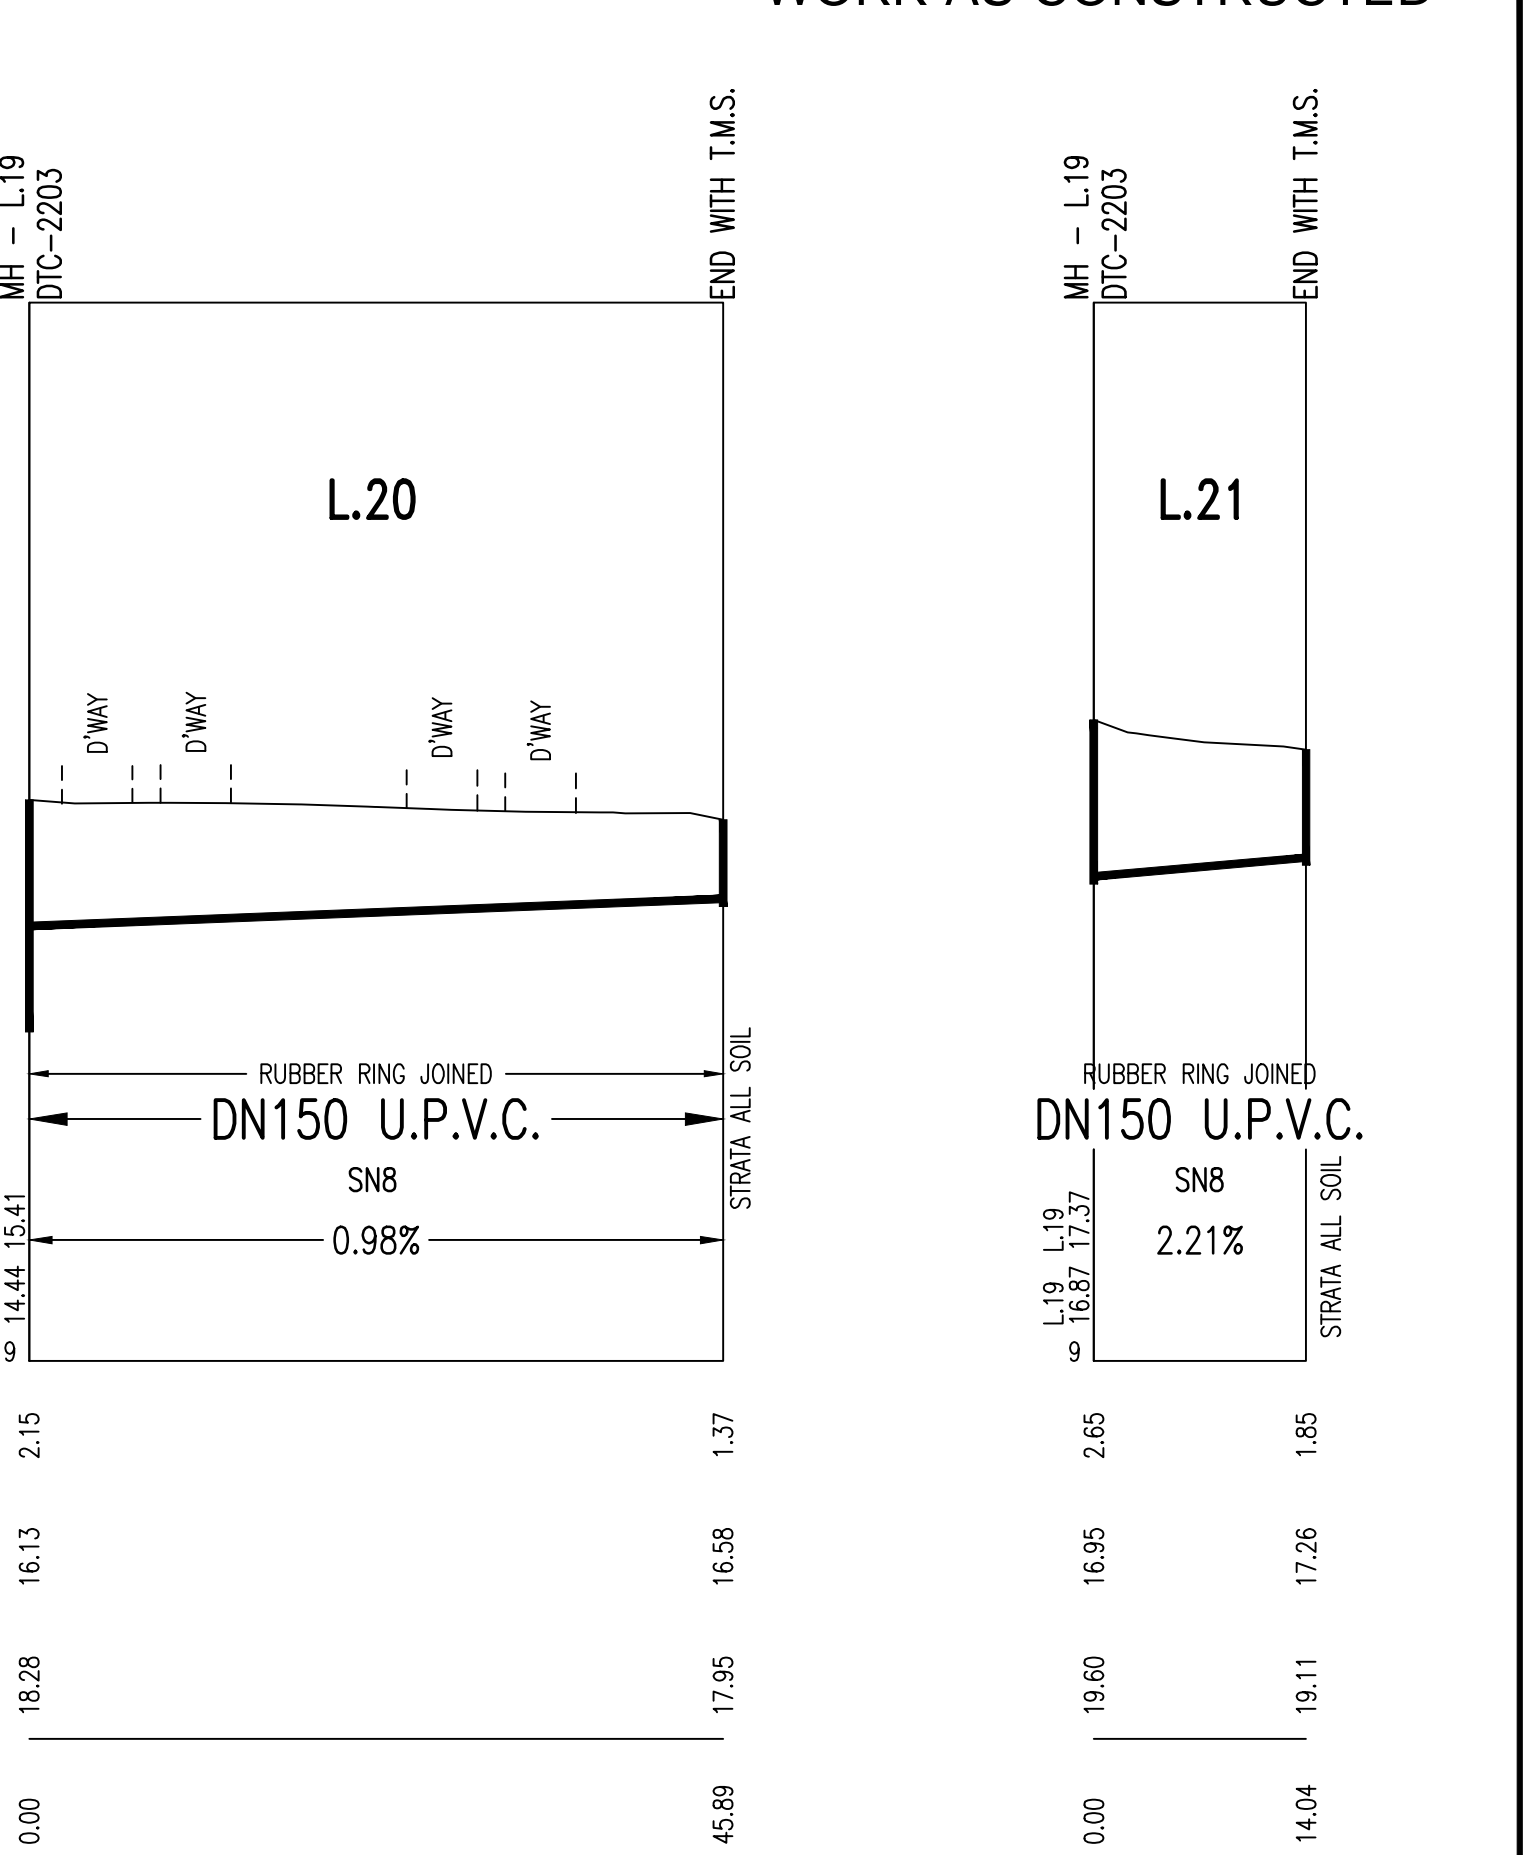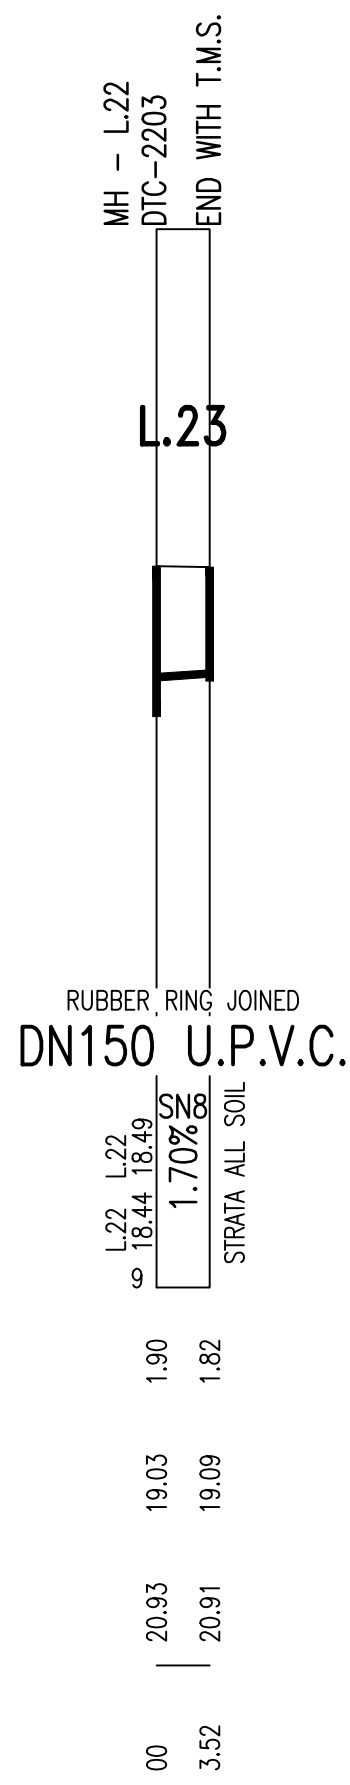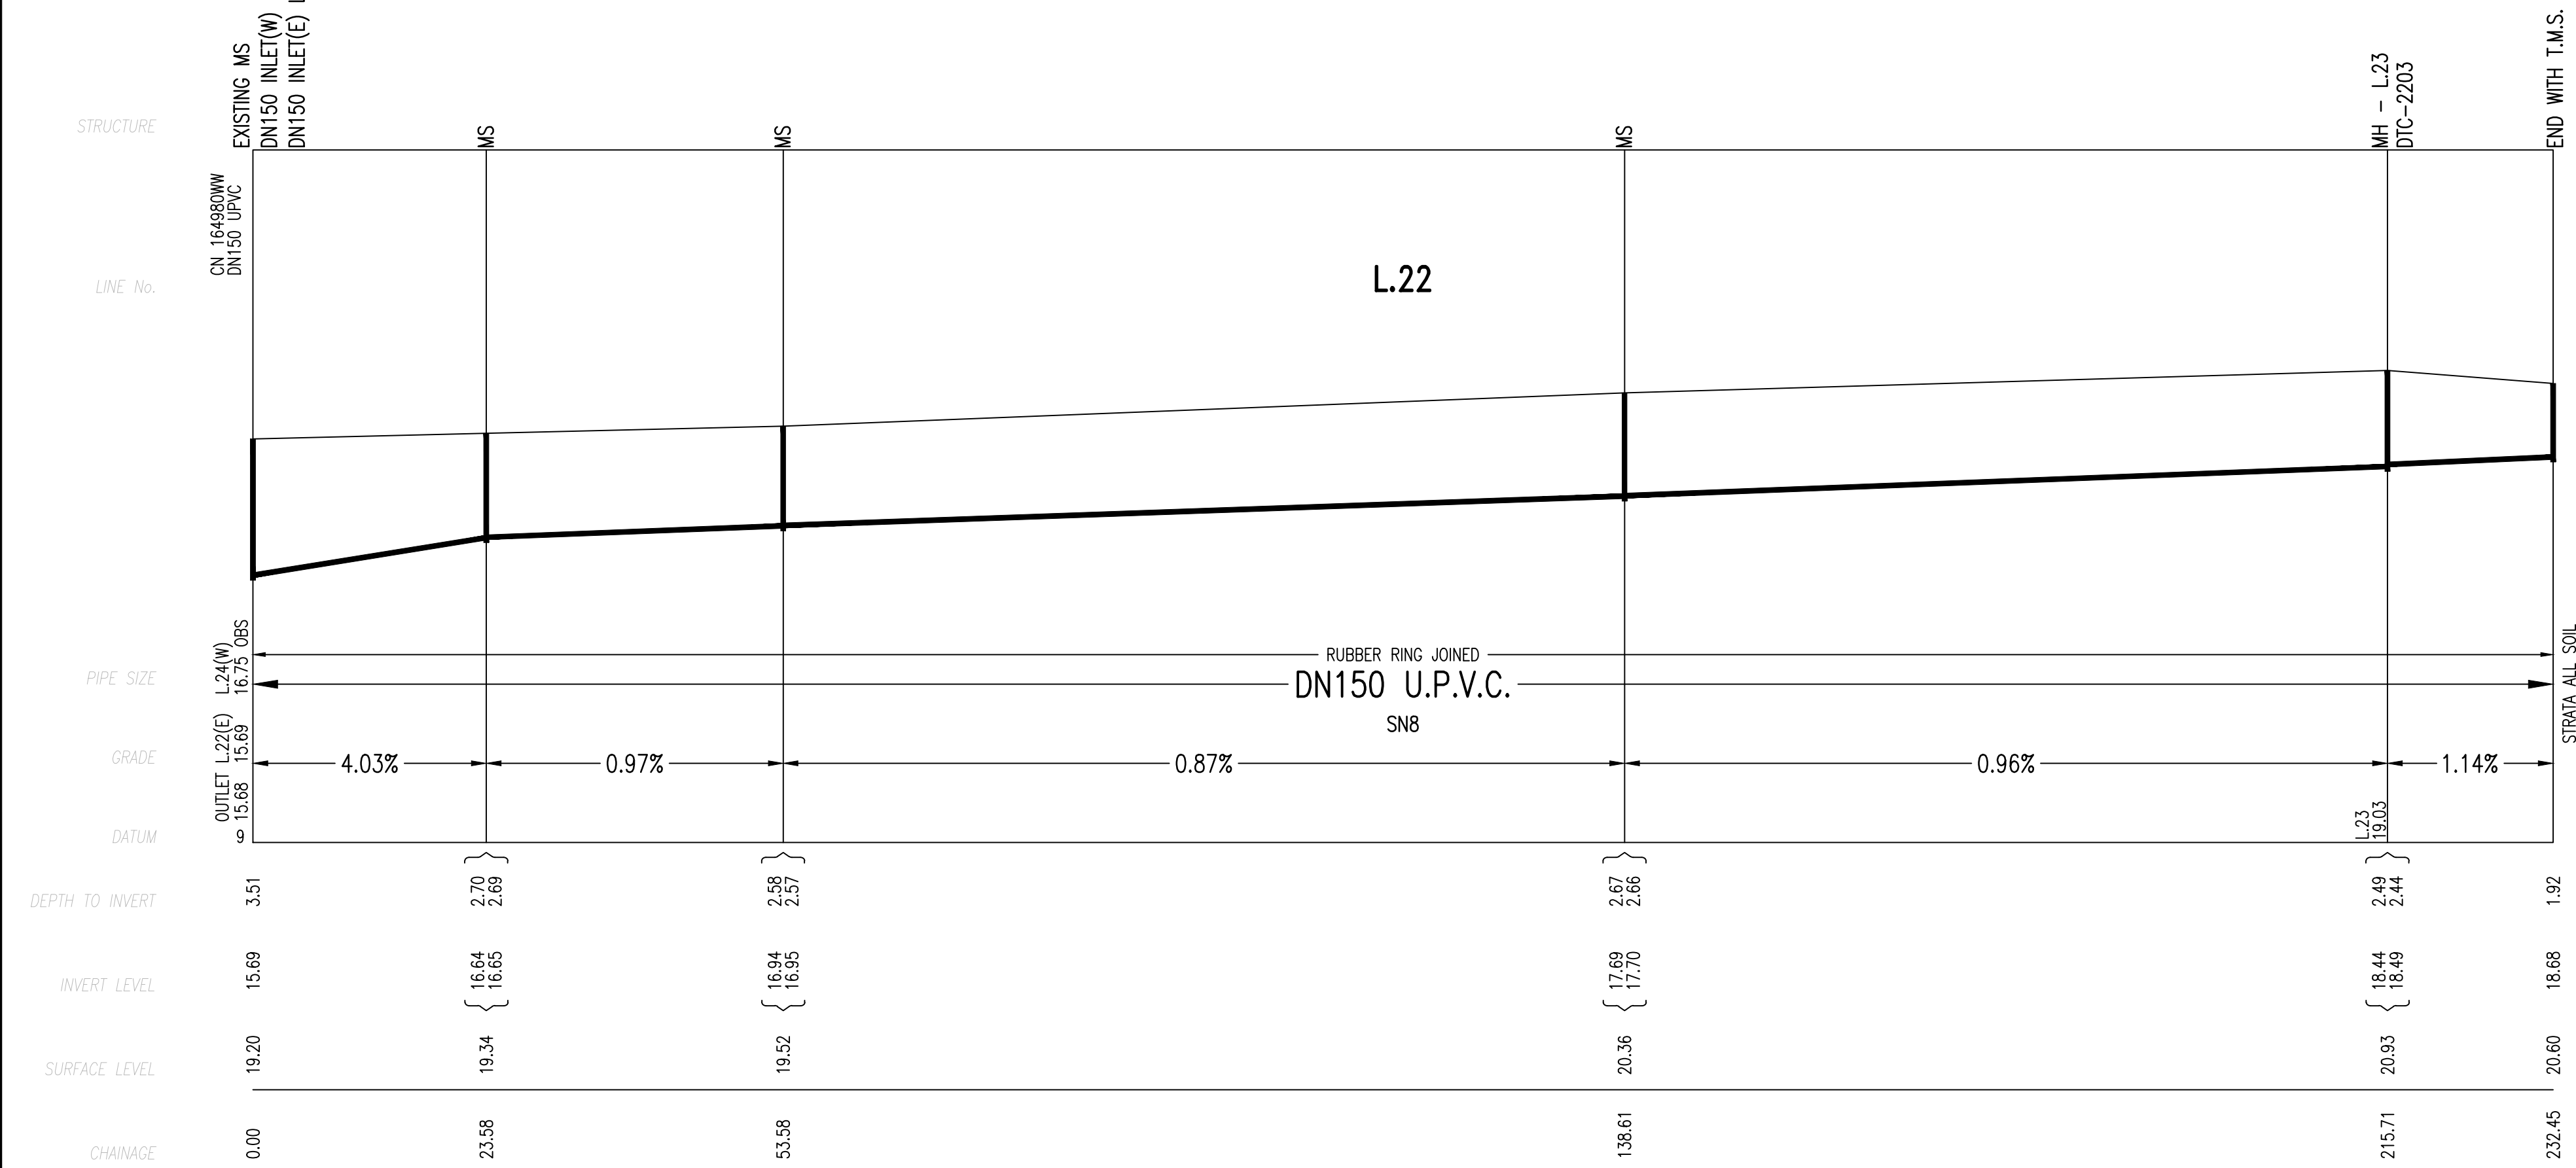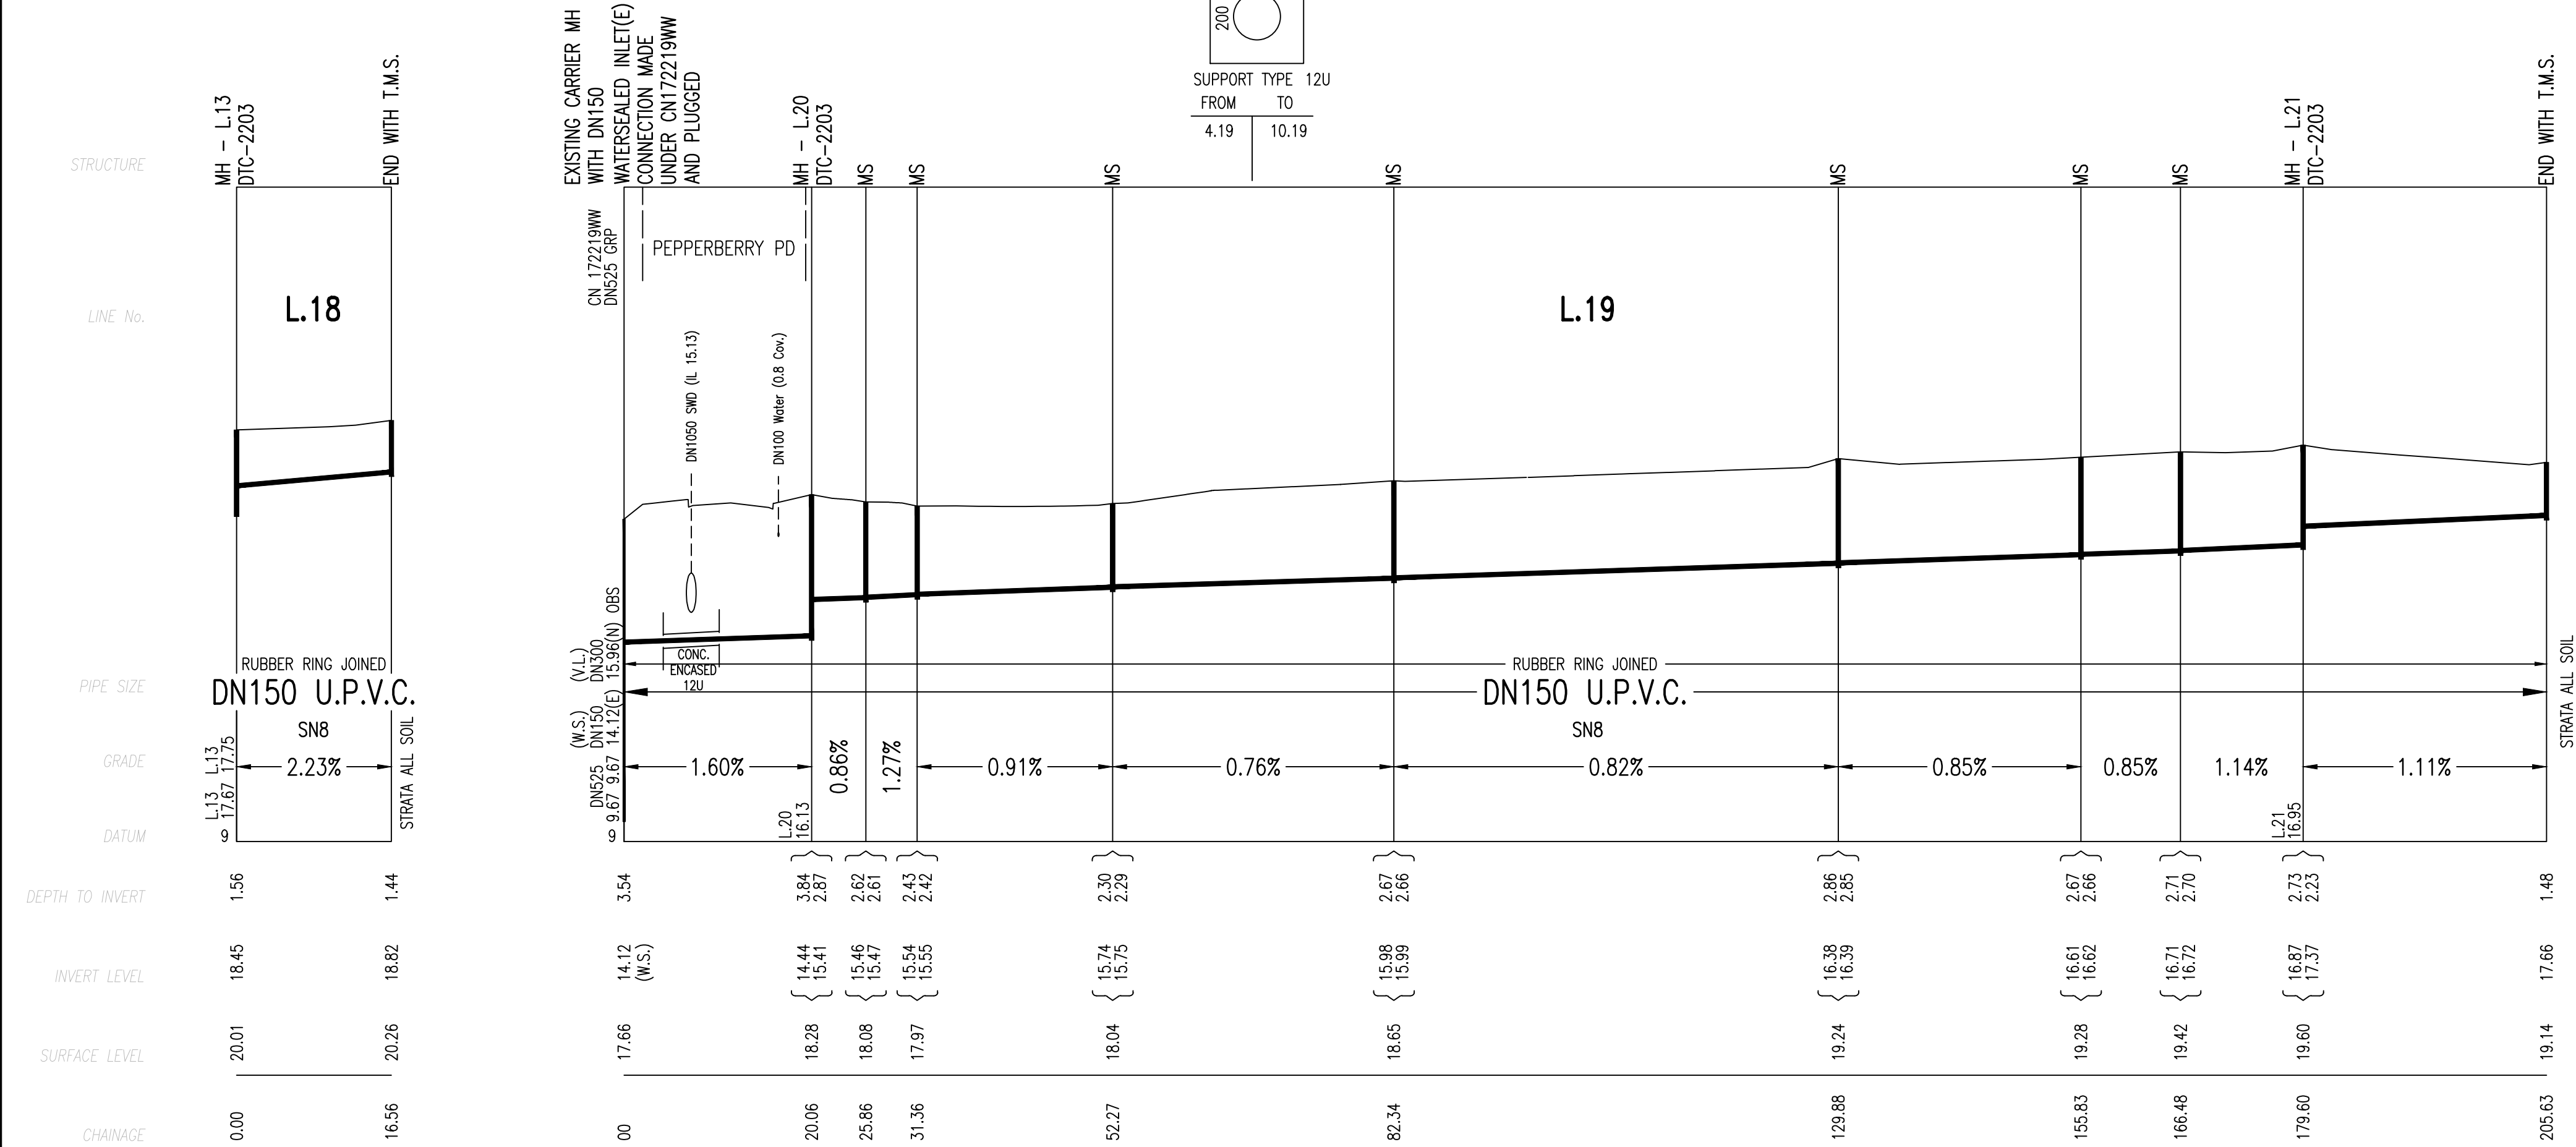

0	WORK AS CONSTRUCTED	J.V.	25.02.19
D	NOTATION CHANGE AS PER SWC REQUEST	F.J.	30.01.19
C	START OF L.1 AMENDED	F.J.	14.07.18
B	ISSUE FOR APPROVAL	F.J.	17.03.18
A	DRAFT ISSUE FOR TENDER	F.J.	12.03.18
No.	AMENDMENT DESCRIPTION	BY	DATE

WORK AS CONSTRUCTED CERTIFICATION		Sydney WATER SYDNEY WATER CORPORATION	
DEVELOPER	WOORONG PARK PTY LTD	CONSTRUCTOR	C.J. DOYLE
W.S.C.	QALCHECK PTY LTD	COMPLETED	08.08.2018
W.A.C. PREPARED	25.02.2019	DESIGNER	QALCHECK PTY LTD
I CERTIFY THAT THE WORKS HAVE BEEN CONSTRUCTED IN ACCORDANCE WITH THE WORK AS CONSTRUCTED DRAWINGS		FOR DETAILS OF SERVICES SEE SHEET 1	