

Site Plan - Overview

Scale 1:2000

DIAL BEFORE YOU DIG

Ref: 3605534	Date: 19 Feb, 2024
--------------	--------------------


DBYD searches indicates the presence of services within the proposed work-site. The Level 1 ASP /Constructor is to confirm the location of "all" services prior to the commencement of works.

Caution

Existing live electrical assets located in this vicinity, appropriate safety precautions must be utilized.

Section 138 Approval

Level 1 Accredited Service Provider is required to gain Section 138 Approval from Local Council prior to the commencement of works.

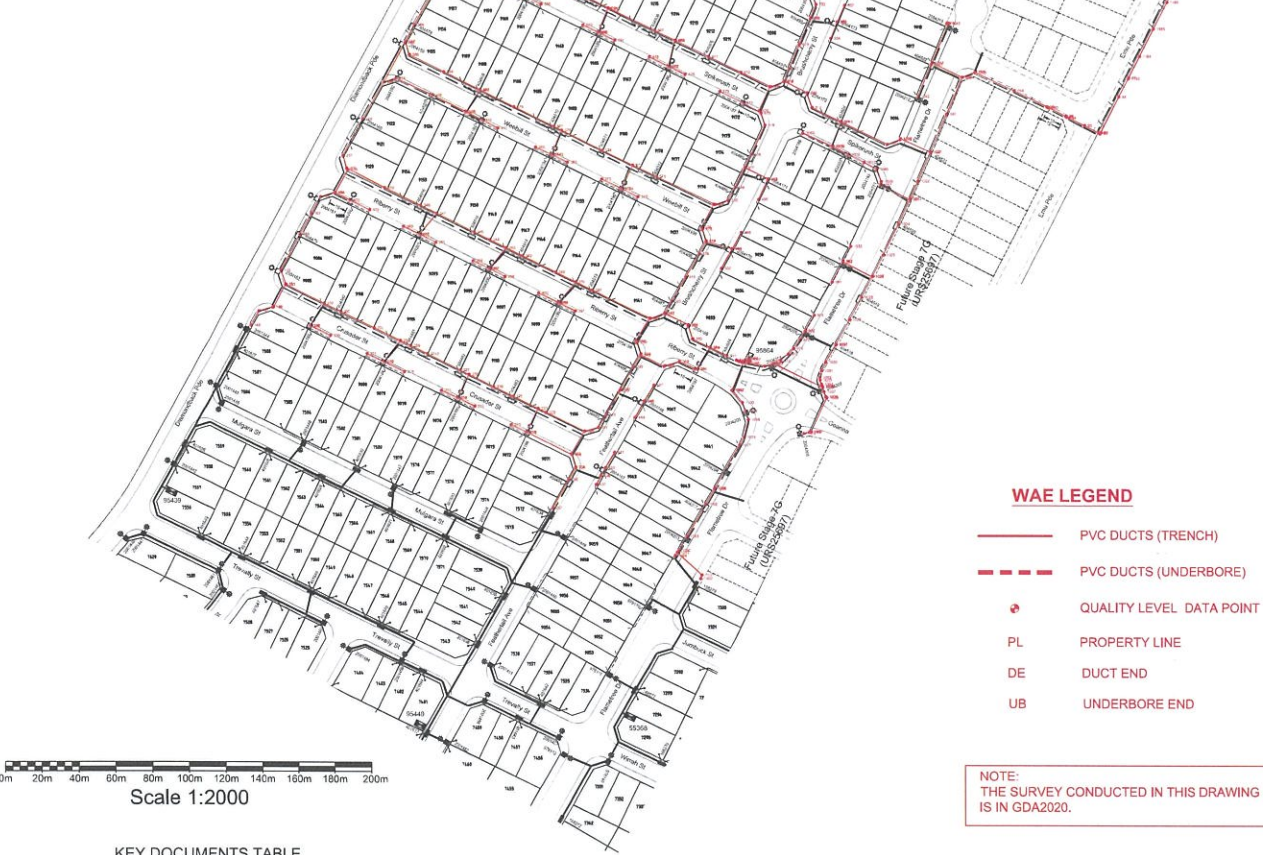

WAE LEGEND

- PVC DUCTS (TRENCH)
- PVC DUCTS (UNDERBORE)
- QUALITY LEVEL DATA POINT
- PL PROPERTY LINE
- DE DUCT END
- UB UNDERBORE END

NOTE: THE SURVEY CONDUCTED IN THIS DRAWING IS IN GDA2020.

WAE NOTES

- ONLY CHANGES MARKED UP IN RED FORM ARE PART OF THIS ASSET RECORDING.
- ALL SURFACE ASSETS WERE RECORDED AT LEVEL QUALITY 'C'.

KEY DOCUMENTS TABLE	
The Certification of this project is supported by the following key documents	
Document Name	Notation Date
Summary Environmental Report - FAT0238 (EM50001)	29 August, 2022
Safe Design Report	29 August, 2022
Equipment to be returned to Endeavour Energy - FPJ4252	29 August, 2022

Funding Arrangements for Scope of Works

ASP Level 1 Electrical Works		Customer
Endeavour Energy Supplied Materials	Customer Funded Non-Contestable Works	Customer Funded
NIL	All works associated with the inspection, testing, switching and the commissioning associated with this project.	Including but not limited to: - Pegging of easements, property boundaries and infrastructure locations. - Registering of Easements. - Provide Site Access. - Own Service and Service connections. - Confirm ground levels.
Endeavour Energy Funded & Constructed	Customer Funded Contestable Works	Existing Duct Usage Charges (excl GST)
Works Required Prior to Completion of Customer Contestable Project	Works Required in Association of Customer Contestable Project	Total Usage \$8264.00 232m of 125mm Duct
NIL	All other works and materials including but not limited to: - Substation establishment & installation. - Excavation & Trenching. - Duct Installation. - Cable Installation (Pulling & Laying). - Cable Joining. - Installation of Earthing. - Removal of Redundant Assets.	
Endeavour Energy Funded & Level 1 ASP Constructed - Reimbursement (excl GST)	Co-ordination Supply Required Date	01/12/2023
Item	Amount	Assets to be Returned to the nearest Endeavour Energy Depot.
3x 500kVA (11000-433V) PMS Trfs	\$37 728.00	RTR HV Switchgear PMS 95440 and PMS 95439
Total EE Capital Contribution (excl. PM & Design)	\$37 728.00	
Total EE Capital Contribution (HV reimbursement)	\$41 388.00	

Pioneer Cost Share Reimbursement SCHEME - Expiry Date : N/A
Pre-Calculated Reimbursement for Customer's Load up to 50kVA

Asset	Asset Cost Estimate (\$)	Unit Quantity	Prospective Proposed Customer Number	Maximum Reimbursement Per Proposed Customer Connected (\$)	Maximum Reimbursement Amount (\$)
HV Mains	N/A	(km)			N/A
LV Mains	N/A	(km)			N/A
Substation	N/A				N/A

Pioneer Cost Share Reimbursement SCHEME - Expiry Date : N/A
Pro-Rata Reimbursement for Customer's Load Over 50kVA

Asset	Asset Cost Estimate (\$)	Unit Quantity	Net Asset Capacity (kVA)	Original Customer Utilisation (kVA)	Maximum Reimbursement Amount (\$)
HV Mains	N/A	(km)			N/A
LV Mains	N/A	(km)			N/A
Substation	N/A				N/A

Streetlight Columns

All streetlight columns are to be installed 350mm from the property boundaries unless otherwise indicated.

Final Ground Level

The constructor is to confirm finished ground level with the developer prior to the commencement of construction.

Existing Conduits

All conduits are to be mandrelled, proven clear, free of foreign material, and deformation prior to the installation of cables.

Streetlight LV Supply

All active conductors extending from LV pillars to service streetlight columns to be fitted with a 10A in line fuse.

Route Lengths

All route lengths are to be confirmed on site by the constructor prior to ordering materials.

Proposed Ducts/Conduits

All Proposed 125mm ducts / conduits are to have a minimum 750mm cover, (in accordance with MDI0028).

Painting of Columns

Local council requires a certificate from the manufacturer supplied confirming the power coated columns are in accordance with the requirements of AS/NZ 4506-2005.

Pollution

Requirements of the environmental protection authority pollution control legislation is to be strictly adhered to.

Breakaway Links

Breakaway links must be used during each cable pull. The link must be of a lesser value than the maximum cable pulling tension (Refer MDI0028).

Pulling Compound

A cable pulling compound with a coefficient of friction less than 0.2 must be used on all cable pulls greater than 25m.

Testing and Commissioning

All required testing in accordance with SDI 120 must be performed in strict accordance with the standard.

Service Ducts

The end of service ducts must not be placed under proposed driveways. (Refer to Developers Representative for details for details)

Service Work

All service works to be carried out by an authorized level 2 ASP in accordance with the New South Wales Service & Installation Rules, Australian Standards and all other relevant standards.

Cable Lengths

Cable Lengths specified on this design have been calculated utilizing 2 dimensional data to align with Endeavour Energy's AVS. The Constructor will need to allow for additional cable to cater for topographic influences as well as cable terminations, cable setting, and vertical indifference.

Design Compliance and Indemnity

This design complies with Endeavour Energy's relevant standards as current at this time & as listed on the Endeavour Energy Accredited Service Provider's Internet site. These standards include, but are not limited to:

- CP: Connection Policy.
- EMS: Environmental Management Standard.
- MCI: Mains Construction Instruction.
- MDI: Mains Design Instruction.
- POI: Protection Design Instruction.
- SDI: Substation Design Instruction.
- SAD: Design Drawing Standard.
- MMI: Mains Maintenance Instruction.
- SMI: Substation Maintenance Instruction.
- LDI: Public Lighting Design Element.

Additionally, where relevant, the design complies with AS/NZS7009 "Overhead Line Design - Detailed Procedures" published by The Australian Standards.

Power Line Design Pty Ltd indemnifies Endeavour Energy for any loss or damage resulting from non-compliance of the design with the above standards.

Signed: Mike Baranowski
Name: Michael J Baranowski
Service Provider Number: 2486 Date: 02-05-2024

WORK COMPLETED / FIELD BOOK

CONSTRUCTED BY C.J. DOYLE CONTRACTING

WORKS COMPLETED CHRIS JOWETT

SIGNATURE C.JOWETT DATE 18/03/2025

INSPECTED BY SAV NIXON

SIGNATURE SAV NIXON DATE 18/03/2025

ASSET RECORDING

I STEVE FRIDAY

OF C.J. DOYLE CONTRACTING

CONTACT No. 8794-1922

HEREBY CERTIFY THAT ASSETS MARKED AS-BUILT ON THIS DRAWING HAVE BEEN RECORDED AS PER ENDEAVOUR ENERGY STANDARD SAD 0004.
SIGNATURE STEVE FRIDAY DATE 18/03/2025

Certified by Endeavour Energy

Amendment: _____

Date Approved: _____

Examiner's Signature: _____

Print Name: _____

This Certification is issued subject to Endeavour Energy's Standard Certification Terms.

Authorisation of Estimate Value of Endeavour Energy Funded Assets

Signed: _____

Print Name: _____

Service Number: _____

Funding Amount: \$ _____

Date: _____

Notes

- This drawing is to be read in conjunction with the relevant Endeavour Energy Network Standards and Connection Policy.
- ENDEAVOUR ENERGY EMERGENCY PHONE No. 131 081.**
- Design certification shall lapse where:
 - (i) notice of intent has not been received within six (6) months of this certification, or
 - (ii) construction has been interrupted for more than six (6) months.where design certification has lapsed the design must be resubmitted for certification by the accredited designer.
- Accredited Service Provider to notify Endeavour Energy asset data customer department daily when cable works is in progress. (ph. 131 081).
- ATTENTION:** Permanent survey marks may exist in this area, these are to be located by a surveyor prior to commencement of work.
- ATTENTION:** All services searches must be checked before construction.
- ATTENTION:** The preparation of this design has been undertaken giving due consideration to the location of existing services. The Constructor is however responsible for the verification of services and permanent survey marks prior to the commencement of construction. No responsibility nor liability will be accepted by the designer for damage to existing services as a result of this design.
- WARNING:** Live Endeavour Energy cables & other services in this area. Please contact "Dial Before You Dig" on telephone: 1100 for searches two days prior to excavation.
- Material Quantities Specified on this Design:** The quantities or dimensions specified on this design are based on design information supplied and site conditions at the time of the design. As quantities and dimensions are subject to change, the Constructor must check all quantities and dimensions on site prior to tendering and prior to construction.
- Reimbursements:** Reimbursements will be paid to the nominated party on the letter of intent after the works have been completed and the letter of acceptance has been issued. The reimbursed amount is shown in the "Funding Arrangements for Scope of Work table". Any disagreement with the amount should be resolved with Endeavour energy prior to the commencement of works.
- Operational Limitations:** Unless approved otherwise, interruption to any customer's supply must be avoided, the following alternatives should be considered:
 - mobile generators and substations.
 - live line work.
 - design alternatives.
 - low voltage parallels.
 - work practices/standards.the cost is to be funded by the customer/developer.
- Environmental Management Plan:** EMP EM50001 is part of this design (refer to EIA for details).
- Pollution Controls:** All the requirements of the Environmental Protection Authority pollution control legislation is to be strictly adhered to.
- Aboriginal Heritage:** If during construction of this project the constructor or developer becomes aware of any previously unidentified Aboriginal Object(s), all work likely to affect the object(s) shall cease immediately, and the Office of Environment & Heritage shall be notified immediately in accordance with section 146 of the National Parks & Wildlife ACT 1974. Works shall not recommence until written authorization from the NSW Office of Environment and Heritage has been issued, in addition to written consent from the local aboriginal land council.
- Heritage:** If during construction of this project the constructor or developer becomes aware of any previously unidentified heritage object(s), all work likely to affect the object(s) shall cease immediately, and the Heritage Council of NSW shall be notified immediately in accordance with Section 146 of the Heritage ACT 1977. Works shall not recommence until written authorization from the heritage council has been issued.
- Telecommunications:** Telecommunications assets are **NOT** effected by the proposed works.
- Existing Assets:** Have all the existing assets been field checked and are accurate at the time of design? **YES**

APPROVAL TO CONNECT TO PUBLIC LIGHTING

Reviewers Name: _____

Date Approved: _____

Reviewers Signature: _____


This Approval is issued subject to Endeavour Energy's General Terms & Conditions for Connection of Public Lighting and is specifically for drawing No. _____ Amendment: _____.

Site Plan - Overview 11kV Fdr Alteration

Not to Scale

Scale 1:2000

Refer to Sheet 12 for Details.

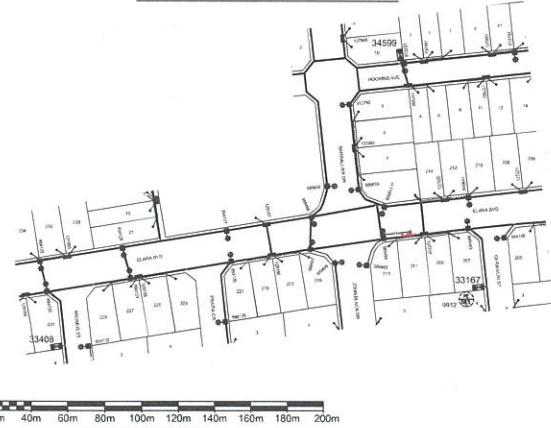

Lighting Equipment & Billing Schedule

State	Luminaire Number	Support Number	Luminaire				Column / Pole				Outreach / Bracket				Uplight Angle	Category	Mounting Height	Column Colour	Charge To	
			Description	Part No.	Rate Code	QTY	Description	Part NO.	Footing Bolt / Foundation	Rate Code	QTY	Description	Part No.	Rate Code						QTY
New	305291 - 305301	2004203 - 2004213	82W StreetLED (Gerard)	PL99G01L80	950	11	8.5m Enlarged Base Column	IE/8.5.EB	Type 2 / Universal (9.0m - 10.5m)	995	11	4.5m Curved Pipe Outreach	IE4.5CPS	991	11	5°	V5	10.5m	Black	Blacktown City Council
New	305243 - 305290	2004155 - 2004202	17W StreetLED (Gerard)	JLB99G00SL17	889	48	4.5m Enlarged Base Column	IE/4.5.EB	Type 2 / Type 2 (<9.0m)	995	48	3.0m Curved Pipe Outreach	IE3.0CPS/25	991	48	5°	PR5	6.5m	Black	Blacktown City Council

Cadastral: © Land and Property Information 2015

powerlinedesign
POWER LINE DESIGN PTY LTD
PO BOX 338 Mittagong NSW 2575
Ph (02) 4872 1920 Fax (02) 4872 1240
Accredited Designer Number 2486 / ABN: 33107 591 948

The preparation of this design has been undertaken giving due consideration to the existing services. The project constructor is wholly responsible for verifying the exact location of existing services and permanent survey marks prior to commencing construction. No responsibility or liability will be accepted by the designer of this project for damage to existing services as a result of this design.

PLD Ref: 3868

THESE DRAWINGS AND THE COPYRIGHT HEREIN IS THE PROPERTY OF ENDEAVOUR ENERGY AND MAY NOT BE COPIED, REPRODUCED, DISTRIBUTED, LOANED OR USED WITHOUT THE WRITTEN CONSENT OF ENDEAVOUR ENERGY

Reference Drawings
527570C URS26188 Duct Trench & Easement

Work Orders
General
Overhead
Underground
Substations

CAMS File No. URS26188
AM Project No.
HV Switching
EE Depot
EE Region
HV OP Diagram
Local Government Area
Kings Park
Northern
Marsden Park
Blacktown City

ORIGINAL SCALE 1:1000
Drawn: Michael J.B
Date: 02-05-2024
Ch'd: Michael J.B

DO NOT SCALE Dimensions in Meters
MGA 56: GDA94
Design: Michael J.B

Off Richmond Road
MARSDEN PARK
URS26188
Subdivision of Lot 3, DP 1230408
Stage 7J
Electrical Reticulation

Endeavour Energy
A1 527571 C
SHEET No 1 OF 15 SHEETS

Site Plan - North

Scale 1:1000

DIAL BEFORE YOU DIG

Ref: 34352730 Date: 06 June, 2023
DBYD searches indicates the presence of services within the proposed work-site. The Level 1 ASP /Constructor is to confirm the location of "all" services prior to the commencement of works.

Caution

Existing live electrical assets located in this vicinity, appropriate safety precautions must be utilized.

Establish Proposed PMS No.95862.
• Transformer: 500kVA (11000/433V).
• HV Switchgear: ABB SafeLink, Type: "CFCC".
• HV Fuses: 12kV, 50Amp (Full Range).
• LV Switchgear: Weber CAT 1, Config: "FFIFF".
• LV Fuses: LV 250A (DIN, size 2).
• Cubicle: Size 14.
• Earthing: Common (refer Earth Design).

Establish Proposed PMS No.95863.
• Transformer: 500kVA (11000/433V).
• HV Switchgear: Siemens SDJH, Type: "RTR".
• HV Fuses: 12kV, 50Amp (Full Range).
• LV Switchgear: Weber CAT 1, Config: "FFIFF".
• LV Fuses: LV 250A (DIN, size 2).
• Cubicle: Size 14.
• Earthing: Common (refer Earth Design).

Establish Proposed PMS No.95864.
• Transformer: 500kVA (11000/433V).
• HV Switchgear: ABB SafeLink, Type: "CFCC".
• HV Fuses: 12kV, 50Amp (Full Range).
• LV Switchgear: Weber CAT 1, Config: "FFIFF".
• LV Fuses: LV 250A (DIN, size 2).
• Cubicle: Size 14.
• Earthing: Common (refer Earth Design).

Underbore Contained within a 3.0m wide easement for Underground Cables (underbore is have a minimum 1.5m cover)

Points 9d - 9f Cable Route Markers
Are to be installed over the top of the new cable route in accordance with the requirements of EE Standards MCI0005 (Section 3.5.2.5).

LEGEND

- Existing Underground Cables.
- Existing Conduits (Ducts).
- Proposed New Conduits (Ducts).
- Street Light Trenching
- Low Voltage Trenching
- High Voltage Trenching
- Lay 40mm P.V.C. Service Conduits
- Existing Service Mains
- Pillar Excavation Location.
- Existing Pillar.
- Proposed Column Excavation location
- 4.5m Enlarged Base Column & 3.0m Curved Pipe Outreach
- Type 2 Ragbolt (Type 2 Footing)
- Colour Powdercoated Black
- Proposed Column Excavation location
- 8.5m Enlarged Base Column & 4.5m Curved Pipe Outreach
- Type 2 Ragbolt (Universal Footing)
- Colour Powdercoated Black
- Existing Column.
- Proposed New Streetlight Lantern.
- Existing Streetlight Lantern.
- Proposed New Padmount Substation.
- Existing Padmount Substation.
- Point Indicator.
- Hatched Lot Loss less than 350m²

Trench Length

High Voltage Trenching	1343m
Underbore	202m
Low Voltage Trenching	1320m
Street Light Trenching	26m
Road Crossing	879m
Total	3770m

Certified by Endeavour Energy

Amendment: _____
Date Approved: _____
Examiner's Signature: _____
Print Name: _____

This Certification is issued subject to Endeavour Energy's Standard Certification Terms.

WORK COMPLETED / FIELD BOOK

CONSTRUCTED BY: C.J. DOYLE CONTRACTING

WORKS COMPLETED: CHRIS JOWETT

SIGNATURE: C.J. DOYLE DATE: 18/03/2025

INSPECTED BY: GAV NIXON

SIGNATURE: _____ DATE: _____

ASSET RECORDING

STEVE FRIDAY


OF: C.J. DOYLE CONTRACTING

CONTACT No: 8784-1922

HEREBY CERTIFY THAT ASSETS MARKED AS-BUILT ON THIS DRAWING HAVE BEEN RECORDED AS PER ENDEAVOUR ENERGY STANDARD SAD 0004.

SIGNATURE: STEVE FRIDAY DATE: 18/03/2025

Scale 1:1000

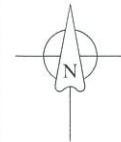

Site Plan - South

Scale 1:1000

DIAL BEFORE YOU DIG

Ref: 34352730 Date: 06 June, 2023

DBVD searches indicate the presence of services within the proposed work-site. The Level 1 ASP /Constructor is to confirm the location of "all" services prior to the commencement of works.

Caution

Existing live electrical assets located in this vicinity, appropriate safety precautions must be utilized.

Final Ground Level

The constructor is to confirm finished ground level with the developer prior to the commencement of construction.

Route Lengths

All route lengths are to be confirmed on site by the constructor prior to ordering materials.

Pollution

Requirements of the environmental protection authority pollution control legislation is to be strictly adhered to.

Existing Conduits

All conduits are to be mandrelled, proven clear, free of foreign material, and deformation prior to the installation of cables.

Proposed Ducts/Conduits

All Proposed 125mm ducts / conduits are to have a minimum 150mm cover. (in accordance with MDI0028)

Breakaway Links

Breakaway links must be used during each cable pull. The link must be of a lesser value than the maximum cable pulling tension (Refer MDI0028).

Pulling Compound

A cable pulling compound with a coefficient of friction less than 0.2 must be used on all cable pulls greater than 25m.

Testing and Commissioning

All required testing in accordance with SDI 120 must be performed in strict accordance with the standard.

Service Ducts

The end of service ducts must not be placed under proposed driveways. (Refer to Developer's Representative for details for details)

Service Work

All service works to be carried out by an authorized level 2 ASP in accordance with the New South Wales Service & Installation Rules, Australian Standards and all other relevant standards.

Cable Lengths

Cable Lengths specified on this design have been calculated utilizing 2 dimensional data to align with Endeavour Energy's AVS. The Constructor will need to allow for additional cable to cater for topographic influences as well as cable terminations, cable setting, and vertical indifference.

Streetlight Columns

All streetlight columns are to be installed 350mm from the property boundaries unless otherwise indicated.

Streetlight LV Supply

All active conductors extending from LV pillars to service streetlight columns to be fitted with a 16A in line fuse.

Painting of Columns

Local council requires a certificate from the manufacturer supplied confirming the power coated columns are in accordance with the requirements of AS/NZ 4506-2005.

Certified by Endeavour Energy

Amendment: _____

Date Approved: _____

Examiner's Signature: _____

Print Name: _____

This Certification is issued subject to Endeavour Energy's Standard Certification Terms.

WORK COMPLETED / FIELD BOOK

CONSTRUCTED BY: C.J. DOYLE CONTRACTING

WORKS COMPLETED: CHRIS JOWETT

SIGNATURE: C.J. DOYLE DATE: 18/03/25

INSPECTED BY: GAV NIXON

SIGNATURE: _____ DATE: _____

ASSET RECORDING

I, STEVE FRIDAY


OF C.J. DOYLE CONTRACTING

CONTACT No: 8784-1922


HEREBY CERTIFY THAT ASSETS MARKED AS-BUILT ON THIS DRAWING HAVE BEEN RECORDED AS PER ENDEAVOUR ENERGY STANDARD SAD 0004.

SIGNATURE: STEVE FRIDAY DATE: 18/03/2025

Duct- End Location Detail

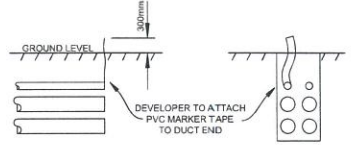


TYPICAL ROAD CROSSING CONFIGURATION

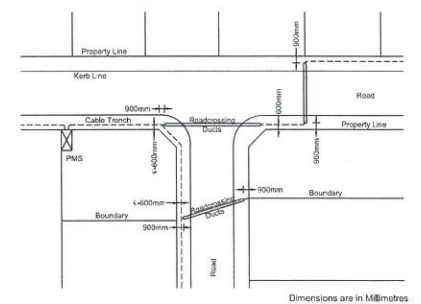

TYPICAL TRENCH CROSS SECTION

(Refer to Technical Bulletin -0105c for further details)

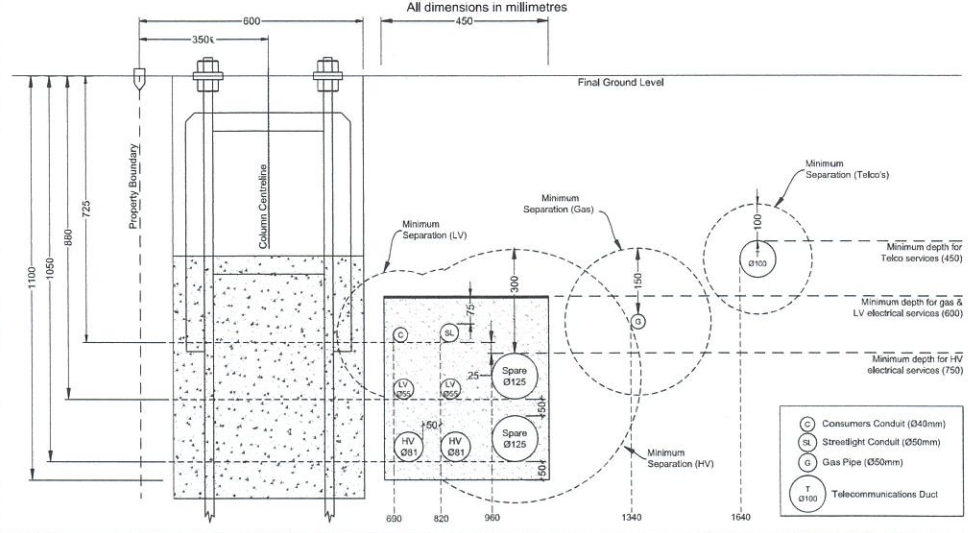


LEGEND

- Existing Underground Cables,
- Existing Conduits (Ducts),
- Proposed New Conduits (Ducts),
- Street Light Trenching
- Low Voltage Trenching
- High Voltage Trenching
- Lay 40mm P.V.C. Service Conduits
- Existing Service Mains
- Pillar Excavation Location,
- Existing Pillar,
- Proposed Column Excavation location
- 4.5m Enlarged Base Column & 3.0m Curved Pipe Outreach
- Type 2 Ragbolt (Type 2 Footing)
- Colour Powdercoated Black
- Proposed Column Excavation location
- 8.5m Enlarged Base Column & 4.5m Curved Pipe Outreach
- Type 2 Ragbolt (Universal Footing)
- Colour Powdercoated Black
- Existing Column,
- Proposed New Streetlight Lantern,
- Existing Streetlight Lantern,
- Proposed New Padmount Substation,
- Existing Padmount Substation,
- Point Indicator,
- Haunched Lot Less than 350m²

Trench Length

High Voltage Trenching	1434m
Underbore	202m
Low Voltage Trenching	1208m
Street Light Trenching	29m
Road Crossing	866m
Total	3736m

Scale 1:1000

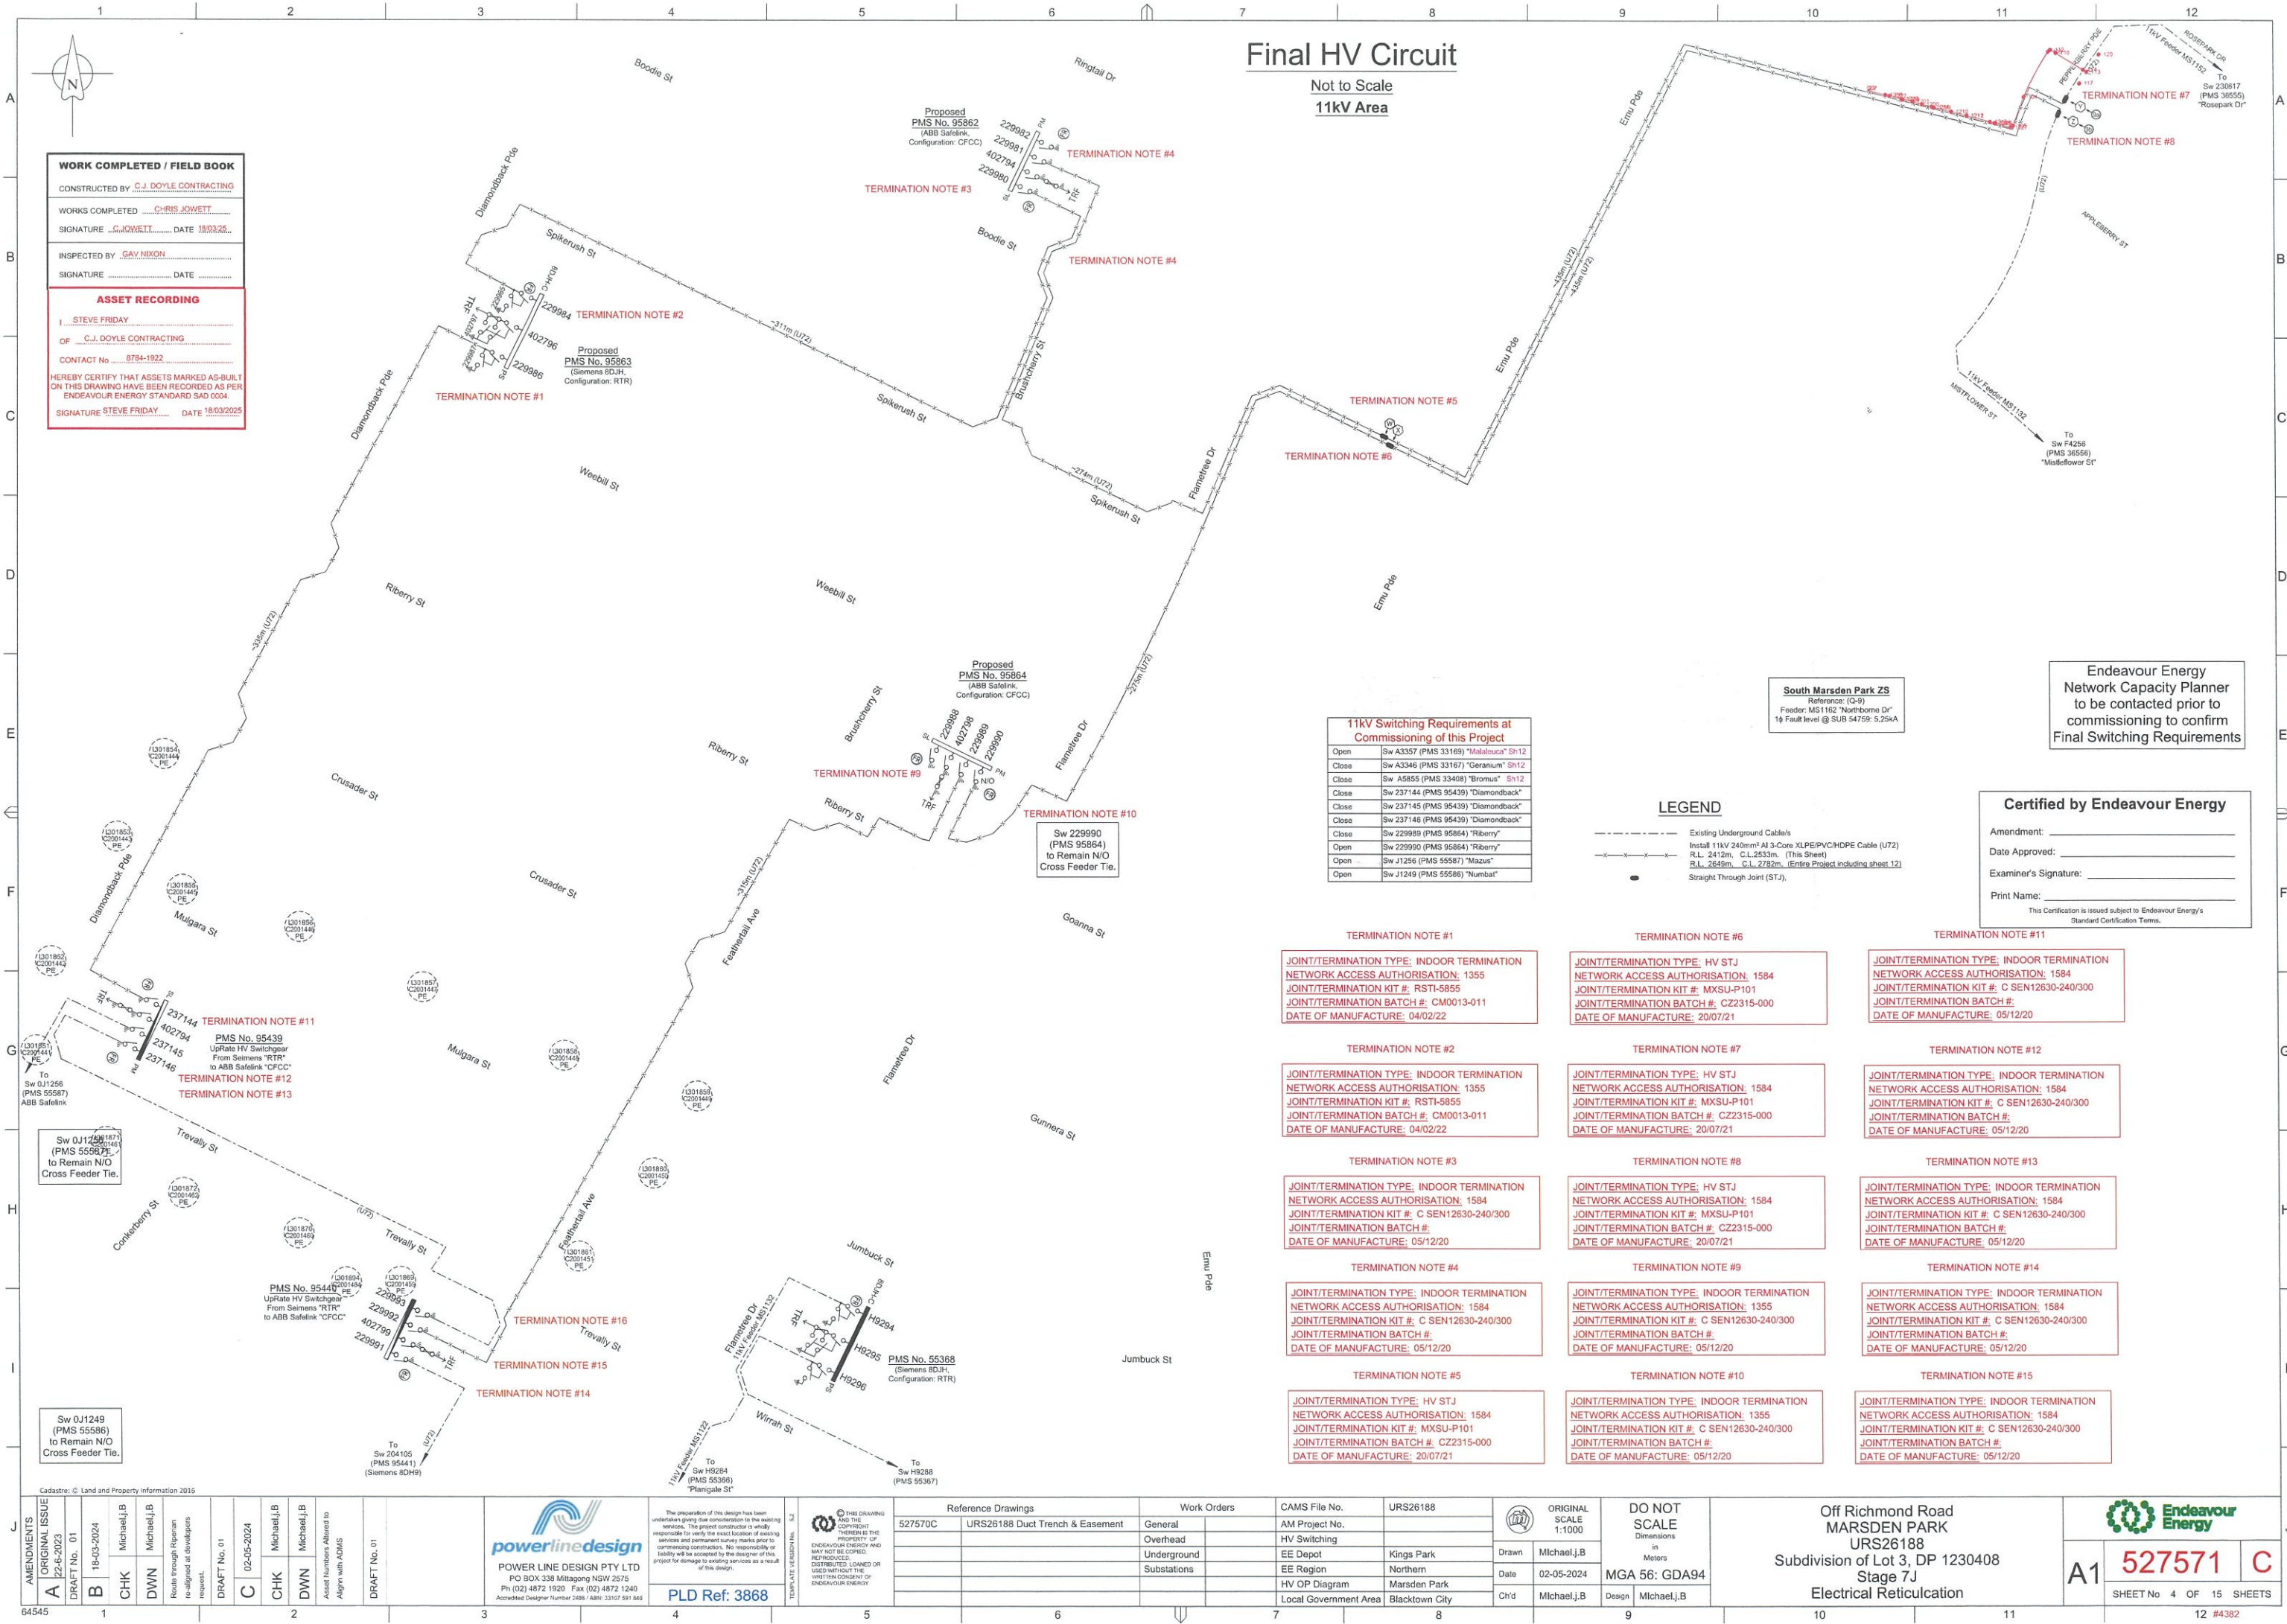

WORK COMPLETED / FIELD BOOK

CONSTRUCTED BY C.J. DOYLE CONTRACTING

WORKS COMPLETED CHRIS JOWETT

SIGNATURE C.J. DOYLE DATE 18/03/25

INSPECTED BY GAV NIXON

SIGNATURE _____ DATE _____

ASSET RECORDING

I STEVE FRIDAY

OF C.J. DOYLE CONTRACTING

CONTACT No 8784-1922

HEREBY CERTIFY THAT ASSETS MARKED AS-BUILT ON THIS DRAWING HAVE BEEN RECORDED AS PER ENDEAVOUR ENERGY STANDARD SAO 004

SIGNATURE STEVE FRIDAY DATE 18/03/2025

11kV Switching Requirements at Commissioning of this Project	
Open	Sw A3357 (PMS 33169) "Malalouca" Sh12
Close	Sw A3346 (PMS 33167) "Ceranum" Sh12
Close	Sw A5855 (PMS 33408) "Bromus" Sh12
Close	Sw 237144 (PMS 95439) "Diamondback"
Close	Sw 237145 (PMS 95439) "Diamondback"
Close	Sw 237146 (PMS 95439) "Diamondback"
Close	Sw 229989 (PMS 95864) "Riberry"
Open	Sw 229990 (PMS 95864) "Riberry"
Open	Sw J1256 (PMS 55587) "Mazus"
Open	Sw J1249 (PMS 55586) "Numbat"

South Marsden Park ZS
Reference: (D-9)
Feeder: MS1162 "Northborne Dr"
1ø Fault level @ SUB 54759: 5.25kA

Endeavour Energy
Network Capacity Planner
to be contacted prior to
commissioning to confirm
Final Switching Requirements

LEGEND

- Existing Underground Cable/s
- Install 11kV 240mm² Al 3-Core XLPE/PVC/HOPE Cable (U72)
- R.L. 2412m, C.L. 2533m. (This Sheet)
- R.L. 2649m, C.L. 2782m. (Entire Project including sheet 12)
- Straight Through Joint (STJ)

Certified by Endeavour Energy

Amendment: _____

Date Approved: _____

Examiner's Signature: _____


Print Name: _____

This Certification is issued subject to Endeavour Energy's Standard Certification Terms.

TERMINATION NOTE #1 JOINT/TERMINATION TYPE: INDOOR TERMINATION NETWORK ACCESS AUTHORISATION: 1355 JOINT/TERMINATION KIT #: RSTI-5855 JOINT/TERMINATION BATCH #: CM0013-011 DATE OF MANUFACTURE: 04/02/22	TERMINATION NOTE #6 JOINT/TERMINATION TYPE: HV STJ NETWORK ACCESS AUTHORISATION: 1584 JOINT/TERMINATION KIT #: MXSU-P101 JOINT/TERMINATION BATCH #: CZ2315-000 DATE OF MANUFACTURE: 20/07/21	TERMINATION NOTE #11 JOINT/TERMINATION TYPE: INDOOR TERMINATION NETWORK ACCESS AUTHORISATION: 1584 JOINT/TERMINATION KIT #: C SEN12630-240/300 JOINT/TERMINATION BATCH #: _____ DATE OF MANUFACTURE: 05/12/20
TERMINATION NOTE #2 JOINT/TERMINATION TYPE: INDOOR TERMINATION NETWORK ACCESS AUTHORISATION: 1355 JOINT/TERMINATION KIT #: RSTI-5855 JOINT/TERMINATION BATCH #: CM0013-011 DATE OF MANUFACTURE: 04/02/22	TERMINATION NOTE #7 JOINT/TERMINATION TYPE: HV STJ NETWORK ACCESS AUTHORISATION: 1584 JOINT/TERMINATION KIT #: MXSU-P101 JOINT/TERMINATION BATCH #: CZ2315-000 DATE OF MANUFACTURE: 20/07/21	TERMINATION NOTE #12 JOINT/TERMINATION TYPE: INDOOR TERMINATION NETWORK ACCESS AUTHORISATION: 1584 JOINT/TERMINATION KIT #: C SEN12630-240/300 JOINT/TERMINATION BATCH #: _____ DATE OF MANUFACTURE: 05/12/20
TERMINATION NOTE #3 JOINT/TERMINATION TYPE: INDOOR TERMINATION NETWORK ACCESS AUTHORISATION: 1584 JOINT/TERMINATION KIT #: C SEN12630-240/300 JOINT/TERMINATION BATCH #: _____ DATE OF MANUFACTURE: 05/12/20	TERMINATION NOTE #8 JOINT/TERMINATION TYPE: HV STJ NETWORK ACCESS AUTHORISATION: 1584 JOINT/TERMINATION KIT #: MXSU-P101 JOINT/TERMINATION BATCH #: CZ2315-000 DATE OF MANUFACTURE: 20/07/21	TERMINATION NOTE #13 JOINT/TERMINATION TYPE: INDOOR TERMINATION NETWORK ACCESS AUTHORISATION: 1584 JOINT/TERMINATION KIT #: C SEN12630-240/300 JOINT/TERMINATION BATCH #: _____ DATE OF MANUFACTURE: 05/12/20
TERMINATION NOTE #4 JOINT/TERMINATION TYPE: INDOOR TERMINATION NETWORK ACCESS AUTHORISATION: 1584 JOINT/TERMINATION KIT #: C SEN12630-240/300 JOINT/TERMINATION BATCH #: _____ DATE OF MANUFACTURE: 05/12/20	TERMINATION NOTE #9 JOINT/TERMINATION TYPE: INDOOR TERMINATION NETWORK ACCESS AUTHORISATION: 1355 JOINT/TERMINATION KIT #: C SEN12630-240/300 JOINT/TERMINATION BATCH #: _____ DATE OF MANUFACTURE: 05/12/20	TERMINATION NOTE #14 JOINT/TERMINATION TYPE: INDOOR TERMINATION NETWORK ACCESS AUTHORISATION: 1584 JOINT/TERMINATION KIT #: C SEN12630-240/300 JOINT/TERMINATION BATCH #: _____ DATE OF MANUFACTURE: 05/12/20
TERMINATION NOTE #5 JOINT/TERMINATION TYPE: HV STJ NETWORK ACCESS AUTHORISATION: 1584 JOINT/TERMINATION KIT #: MXSU-P101 JOINT/TERMINATION BATCH #: CZ2315-000 DATE OF MANUFACTURE: 20/07/21	TERMINATION NOTE #10 JOINT/TERMINATION TYPE: INDOOR TERMINATION NETWORK ACCESS AUTHORISATION: 1355 JOINT/TERMINATION KIT #: C SEN12630-240/300 JOINT/TERMINATION BATCH #: _____ DATE OF MANUFACTURE: 05/12/20	TERMINATION NOTE #15 JOINT/TERMINATION TYPE: INDOOR TERMINATION NETWORK ACCESS AUTHORISATION: 1584 JOINT/TERMINATION KIT #: C SEN12630-240/300 JOINT/TERMINATION BATCH #: _____ DATE OF MANUFACTURE: 05/12/20

AMENDMENTS		ORIGINAL ISSUE		DRAFT No. 01		CHK Michael J.B		DWN Michael J.B		Route through Riparian re-aligned at developers request.		DRAFT No. 01		CHK Michael J.B		DWN Michael J.B		Align with ADMS		DRAFT No. 01		POWER LINE DESIGN PTY LTD PO BOX 338 Mittagong NSW 2575 Ph (02) 4872 1920 Fax (02) 4872 1240 Accredited Designer Number 2486 / ABN: 33107 591 846		PLD Ref: 3868		END USER'S DESIGN AND MAY NOT BE COPIED, REPRODUCED, DISTRIBUTED, LOANED OR USED WITHOUT THE WRITTEN CONSENT OF ENDEAVOUR ENERGY		Reference Drawings		Work Orders		CAMS File No.		URS26188		ORIGINAL SCALE 1:1000		DO NOT SCALE Dimensions in Meters		Off Richmond Road MARSDEN PARK URS26188 Subdivision of Lot 3, DP 1230408 Stage 7J Electrical Reticulation		A1 527571 C		SHEET No 4 OF 15 SHEETS		#4382																																																																																																																																																																																																																																																																																																																																																																																																																																																																																																																																																																																																																																																																																																																																																																																																																																																																																																																																																																																																																																																																																																																																																																																																																																																																																																																																																																																																																																																																																																																																																																																																																																																																																																																																																																																																																																																																																																																																																																																																																																			
64545		1		2		3		1000	

Not to Scale

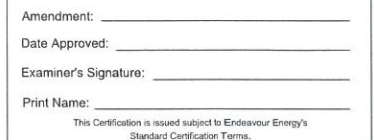

New Labels PM Sub. 95864		
'R' -	Spare	230004
'S' -	Pillar 404518	230005
'T' -	Transformer	402802
'U' -	Pillar 404524	230006
'V' -	Spare	230007
'G' -	Generator Fuse Strip	230008

New Labels	
PM Sub. 95439	
'R' -	Pillar 404479

New Labels	
PM Sub. 95440	
'R' -	Pillar 404484

Voltage Drop Calculations Based on an ADMD of 5kVA/ lot for lots less than 350m², and 6.5kVA/Lot for lots 350m² and greater.

Vd = Voltage drop for normal supply @ 100% ADMD

Emergency / backup voltage drop @ 60% of ADMD

	Source Substation - (Fruze Spira)	Backed Up Substation - (Fruze Spira)
VdE1	PMS 95662 (S)	PMS 95663 (V)
VdE2	PMS 95663 (V)	PMS 95662 (S)
VdE3	PMS 95662 (U)	PMS 95663 (S)
VdE4	PMS 95663 (S)	PMS 95662 (U)
VdE5	PMS 95662 (V)	PMS 95663 (R)
VdE6	PMS 95663 (R)	PMS 95662 (V)
VdE7	PMS 95662 (U)	PMS 95663 (S)
VdE8	PMS 95663 (S)	PMS 95662 (U)
VdE9	PMS 95640 (R)	PMS 95664 (R)
VdE10	PMS 95664 (R)	PMS 95640 (R)
VdE11	PMS 95439 (R)	PMS 95664 (R)
VdE12	PMS 95664 (U)	PMS 95439 (R)
VdE13	PMS 95439 (V)	PMS 95640 (U)
VdE14	PMS 95440 (V)	PMS 95439 (V)

A	ORIGINAL ISSUE 22-6-2024	DRAFT No. 01	Michael JB	Michael JB
B	18-03-2024		CHK	DWN
				Route through Hesperian re-alligned at developers request.
		DRAFT No. 01		
C	02-05-2024		Michael JB	Michael JB
			CHK	DWN

Asset Numbers Allotted to Align with ADMS	DRAFT No. 01	 POWER LINE DESIGN PTY LTD PO BOX 338 Mittagong NSW 2575 Ph (02) 4872 1920 Fax (02) 4872 1240 Accredited Designer Number 2486 ABN: 33107 591 846
--	---------------------	--

The preparation of this design has been undertaken giving due consideration to the existing services. The project constructor is wholly responsible for verifying the exact location of existing services and permanent survey marks prior to commencing construction. No responsibility or liability will be accepted by the designer of this project for damage to existing services as a result of this design.	5.2
PLD Ref: 3868	
TEMPLATE VERSION No.	

 THIS DRAWING
AND THE
COPYRIGHT
THEREIN IS THE
PROPERTY OF
ENDEAVOUR ENERGY AND
MAY NOT BE COPIED,
REPRODUCED,
DISTRIBUTED, LOANED OR
USED WITHOUT THE
WRITTEN CONSENT OF
ENDEAVOUR ENERGY

Reference Drawings	
527570C	URS26188 Duct T

	Work
Trench & Easement	General
	Overhead
	Underground
	Substations

Work Orders	CAMS File No.
	AM Project No.
	HV Switching
	EE Depot
	EE Region
	HV OP Diagram
	Local Government

	URS26188	
	Kings Park	Dr
	Northern	Da
	Marsden Park	
nt Area	Blacktown City	Ch

	ORIGINAL SCALE 1:1000		DO NOT SCALE Dimensions in Meters MGA 56: GDA94
	Drawn by	Michael.j.B	
	Date	02-05-2024	
Designed by	Michael.j.B		

Off Richmond Road
MARSDEN PARK
URS26188
Subdivision of Lot 3, DP 1230408
Stage 7J
Electrical Reticulation

 Endeavour Energy		
A1	527571	C
	SHEET No 5 OF 15 SHEETS	

Duct Breakdown Table								
Route	Configuration	Route Length	Duct Re-Imbursement		Duct Usage Charge			
			No. of 50mm Ducts	Amount (@ \$7/m)	No. of 125mm Ducts	Amount (@ \$27/m)	No. of 50mm Ducts	Amount (@ \$7/m)
1b - 1c	LV Trenching in Cable Allocation	13m	0	\$ 0.00	0	\$ 0.00	0	\$ 0.00
1c - 1d	LV Trenching in Cable Allocation	20m	0	\$ 0.00	0	\$ 0.00	0	\$ 0.00
1d - 1e	LV Trenching in Cable Allocation	10m	0	\$ 0.00	0	\$ 0.00	0	\$ 0.00
1e - 1f	LV Trenching in Cable Allocation	13m	0	\$ 0.00	0	\$ 0.00	0	\$ 0.00
1f - 1g	LV Trenching in Cable Allocation	36m	0	\$ 0.00	0	\$ 0.00	0	\$ 0.00
1g - 1h	LV Trenching in Cable Allocation	14m	0	\$ 0.00	0	\$ 0.00	0	\$ 0.00
1i - 1j	HV Trenching in Cable Allocation	18m	0	\$ 0.00	0	\$ 0.00	0	\$ 0.00
1l-1m	LV Trenching in Cable Allocation	5m	0	\$ 0.00	0	\$ 0.00	0	\$ 0.00
2a - 2b	Install New LV and HV Cables in existing cable Allocation Ducts.	21m	0	\$ 0.00	0	\$ 0.00	0	\$ 0.00
2b- 2c	Install New LV and HV Cables in existing Road Crossing Ducts.	26m	0	\$ 0.00	0	\$ 0.00	0	\$ 0.00
2c - 2d	Install New LV and HV Cables in existing cable Allocation Ducts.	8m	0	\$ 0.00	0	\$ 0.00	0	\$ 0.00
2d - 2e	Install New LV and HV Cables in existing cable Allocation Ducts.	31m	0	\$ 0.00	0	\$ 0.00	0	\$ 0.00
2e - 2f	Install New LV and HV Cables in existing cable Allocation Ducts.	8m	0	\$ 0.00	0	\$ 0.00	0	\$ 0.00
2f - 2g	Install New LV and HV Cables in existing Road Crossing Ducts.	26m	0	\$ 0.00	0	\$ 0.00	0	\$ 0.00
2g - 2h	Install New LV and HV Cables in existing cable Allocation Ducts.	8m	0	\$ 0.00	0	\$ 0.00	0	\$ 0.00
Sub Totals			0	\$ 0	0	\$ 0	0	\$ 0
Column Total			\$ 0		\$ 0			

Duct Breakdown Table - Continued								
Route	Configuration	Route Length	Duct Re-Imbursement		Duct Usage Charge			
			No. of 50mm Ducts	Amount (@ \$7/m)	No. of 125mm Ducts	Amount (@ \$27/m)	No. of 50mm Ducts	Amount (@ \$7/m)
2h - 2i	Install New LV and HV Cables in existing cable Allocation Ducts.	10m	0	\$ 0.00	0	\$ 0.00	0	\$ 0.00
2i - 2j	HV Trenching in Cable Allocation	20m	0	\$ 0.00	0	\$ 0.00	0	\$ 0.00
2j - 2k	HV Trenching in Cable Allocation	8m	0	\$ 0.00	0	\$ 0.00	0	\$ 0.00
2k - 2l	HV Trenching in Cable Allocation	8m	0	\$ 0.00	0	\$ 0.00	0	\$ 0.00
3a - 3b	Install New HV & LV Cable in existing cable Allocation Ducts.	13m	0	\$ 0.00	0	\$ 0.00	0	\$ 0.00
3b - 3c	Install New LV Cable in existing cable Allocation Ducts.	13m	0	\$ 0.00	0	\$ 0.00	0	\$ 0.00
3c - 3d	Install New LV Cable in existing cable Allocation Ducts.	10m	0	\$ 0.00	0	\$ 0.00	0	\$ 0.00
3d - 3e	Install New LV Cable in existing Road Crossing Ducts.	26m	0	\$ 0.00	0	\$ 0.00	0	\$ 0.00
3e - 3f	Install New LV Cable in existing cable Allocation Ducts.	22m	0	\$ 0.00	0	\$ 0.00	0	\$ 0.00
3f - 3g	Install New LV Cable in existing cable Allocation Ducts.	13m	0	\$ 0.00	0	\$ 0.00	0	\$ 0.00
3g - 3h	HV Trenching in Cable Allocation	18m	0	\$ 0.00	0	\$ 0.00	0	\$ 0.00
3i - 3j	HV Trenching in Cable Allocation	8m	0	\$ 0.00	0	\$ 0.00	0	\$ 0.00
3j - 3k	HV Trenching in Cable Allocation	20m	0	\$ 0.00	0	\$ 0.00	0	\$ 0.00
3k - 3l	HV Trenching in Cable Allocation	20m	0	\$ 0.00	0	\$ 0.00	0	\$ 0.00
3l - 3m	HV Trenching in Cable Allocation	8m	0	\$ 0.00	0	\$ 0.00	0	\$ 0.00
Sub Totals			0	\$ 0	0	\$ 0	0	\$ 0
Column Total			\$ 0		\$ 0			

Duct Breakdown Table - Continued								
Route	Configuration	Route Length	Duct Re-Imbursement		Duct Usage Charge			
			No. of 50mm Ducts	Amount (@ \$7/m)	No. of 125mm Ducts	Amount (@ \$27/m)	No. of 50mm Ducts	Amount (@ \$7/m)
3m - 3n	LV Trenching in Cable Allocation	10m	0	\$ 0.00	0	\$ 0.00	0	\$ 0.00
3n - 3o	LV Trenching in Cable Allocation	8m	0	\$ 0.00	0	\$ 0.00	0	\$ 0.00
3o - 3p	HV Trenching in Cable Allocation	8m	0	\$ 0.00	0	\$ 0.00	0	\$ 0.00
3p - 3q	HV Trenching in Cable Allocation	15m	0	\$ 0.00	0	\$ 0.00	0	\$ 0.00
3q - 3r	HV Trenching in Cable Allocation	15m	0	\$ 0.00	0	\$ 0.00	0	\$ 0.00
3r - 3s	HV Trenching in Cable Allocation	19m	0	\$ 0.00	0	\$ 0.00	0	\$ 0.00
3s - 3t	LV Trenching in Cable Allocation	26m	0	\$ 0.00	0	\$ 0.00	0	\$ 0.00
3t - 3u	LV Trenching in Cable Allocation	15m	0	\$ 0.00	0	\$ 0.00	0	\$ 0.00
3u - 3v	LV Trenching in Cable Allocation	28m	0	\$ 0.00	0	\$ 0.00	0	\$ 0.00
3v - 3w	LV Trenching in Cable Allocation	5m	0	\$ 0.00	0	\$ 0.00	0	\$ 0.00
3w - 3x	LV Trenching in Cable Allocation	30m	0	\$ 0.00	0	\$ 0.00	0	\$ 0.00
3x - 3y	LV Trenching in Cable Allocation	8m	0	\$ 0.00	0	\$ 0.00	0	\$ 0.00
3y - 3z	LV Trenching in Cable Allocation	37m	0	\$ 0.00	0	\$ 0.00	0	\$ 0.00
3z - 3A	LV Trenching in Cable Allocation	10m	0	\$ 0.00	0	\$ 0.00	0	\$ 0.00
3A - 3B	LV Trenching in Cable Allocation	2m	0	\$ 0.00	0	\$ 0.00	0	\$ 0.00
3B - 3C	LV Trenching in Cable Allocation	10m	0	\$ 0.00	0	\$ 0.00	0	\$ 0.00
3C - 3D	LV Trenching in Cable Allocation	2m	0	\$ 0.00	0	\$ 0.00	0	\$ 0.00
3D - 3E	LV Trenching in Cable Allocation	2m	0	\$ 0.00	0	\$ 0.00	0	\$ 0.00
3E - 3I	LV Trenching in Cable Allocation	2m	0	\$ 0.00	0	\$ 0.00	0	\$ 0.00
Sub Totals			0	\$ 0	0	\$ 0	0	\$ 0
Column Total			\$ 0		\$ 0			

Certified by Endeavour Energy

Amendment: _____
Date Approved: _____
Examiner's Signature: _____
Print Name: _____
This Certification is issued subject to Endeavour Energy's Standard Certification Terms.

WORK COMPLETED / FIELD BOOK
CONSTRUCTED BY C.J. DOYLE CONTRACTING
WORKS COMPLETED CHRIS JOWETT
SIGNATURE C. JOWETT DATE 18/03/25
INSPECTED BY GAV NIXON
SIGNATURE _____ DATE _____

ASSET RECORDING
I STEVE FRIDAY
OF C.J. DOYLE CONTRACTING
CONTACT No 8754-1922
HEREBY CERTIFY THAT ASSETS MARKED AS-BUILT ON THIS DRAWING HAVE BEEN RECORDED AS PER ENDEAVOUR ENERGY STANDARD SAD 0004.
SIGNATURE STEVE FRIDAY DATE 18/03/2025

Conduit / Cable Legend

- LV LV Cable - Direct Buried.
- HV HV Cable - Direct Buried.
- 50mm Duct - Spare.
- 50mm Duct - with Existing Cable.
- 50mm Duct - with New SIL Cable.
- 125mm Duct - with Existing Cable.
- 125mm Duct - with New Cable.
- 125mm Duct - Spare.

Cadastre: © Land and Property Information 2015

AMENDMENTS	ORIGINAL ISSUE	DRAFT No. 01	CHK Michael J.B	DWN Michael J.B	Route through Riparian re-aligned at developers request.	DRAFT No. 01	CHK Michael J.B	DWN Michael J.B	Align with ADAMS	DRAFT No. 01
A	22-6-2023									
B	18-03-2024									

powerlinedesign
POWER LINE DESIGN PTY LTD
PO BOX 338 Mittagong NSW 2575
Ph (02) 4872 1920 Fax (02) 4872 1240
Accredited Designer Number 25861 ABN: 33107 521 846

The preparation of this design has been undertaken using data contribution to the existing services. The project contractor is wholly responsible for verifying the exact location of existing services and permanent survey marks prior to commencing construction. No responsibility or liability will be accepted by the designer of this project for damage to existing services as a result of this design.

PLD Ref: 3868

THIS DRAWING IS THE PROPERTY OF ENDEAVOUR ENERGY AND MAY NOT BE COPIED, REPRODUCED, DISTRIBUTED, LOANED OR USED WITHOUT THE WRITTEN CONSENT OF ENDEAVOUR ENERGY

Reference Drawings		Work Orders		CAMS File No.	URS26188
527570C	URS26188 Duct Trench & Easement	General		AM Project No.	
		Overhead		HV Switching	
		Underground		EE Depot	Kings Park
		Substations		EE Region	Northern
				HV OP Diagram	Marsden Park
				Local Government Area	Blacktown City

Drawn	Michael J.B	Original Scale	1:1000	DO NOT SCALE	Dimensions in Meters
Date	02-05-2024	MGA 56: GDA94			
Ch'd	Michael J.B	Design	Michael J.B		

Drawn	Michael J.B	Original Scale	1:1000	DO NOT SCALE	Dimensions in Meters
Date	02-05-2024	MGA 56: GDA94			
Ch'd	Michael J.B	Design	Michael J.B		

Off Richmond Road
MARSDEN PARK
URS26188
Subdivision of Lot 3, DP 1230408
Stage 7J
Electrical Reticulation

Endeavour Energy
A1 **527571** C
SHEET No 7 OF 15 SHEETS

A
B
C
D
E
F
G
H
I

Duct Breakdown Table - Continued									
Route	Configuration	Route Length	Duct Re-Imbursement			Duct Usage Charge			
			No. of 50mm Ducts	Amount (@ \$7/m)	No. of 125mm Ducts	Amount (@ \$27/m)	No. of 50mm Ducts	Amount (@ \$7/m)	No. of 125mm Ducts
4a - 4b	LV Trenching in Cable Allocation	45m	0	\$ 0.00	0	\$ 0.00	0	\$ 0.00	0
4b - 4c	LV Trenching in Cable Allocation	5m	0	\$ 0.00	0	\$ 0.00	0	\$ 0.00	0
4c - 4d	LV Trenching in Cable Allocation	28m	0	\$ 0.00	0	\$ 0.00	0	\$ 0.00	0
4d - 4e	LV Trenching in Cable Allocation	20m	0	\$ 0.00	0	\$ 0.00	0	\$ 0.00	0
4e - 4f	LV Trenching in Cable Allocation	10m	0	\$ 0.00	0	\$ 0.00	0	\$ 0.00	0
4f - 4g	LV Trenching in Cable Allocation	35m	0	\$ 0.00	0	\$ 0.00	0	\$ 0.00	0
4g - 4h	LV Trenching in Cable Allocation	10m	0	\$ 0.00	0	\$ 0.00	0	\$ 0.00	0
4h - 4i	LV Trenching in Cable Allocation	36m	0	\$ 0.00	0	\$ 0.00	0	\$ 0.00	0
4i - 4j	LV Trenching in Cable Allocation	8m	0	\$ 0.00	0	\$ 0.00	0	\$ 0.00	0
4j - 4k	LV Trenching in Cable Allocation	8m	0	\$ 0.00	0	\$ 0.00	0	\$ 0.00	0
4k - 4l	LV Trenching in Cable Allocation	30m	0	\$ 0.00	0	\$ 0.00	0	\$ 0.00	0
4l - 4m	LV Trenching in Cable Allocation	8m	0	\$ 0.00	0	\$ 0.00	0	\$ 0.00	0
4m - 4n	LV Trenching in Cable Allocation	8m	0	\$ 0.00	0	\$ 0.00	0	\$ 0.00	0
4q - 4s	LV Trenching in Cable Allocation	30m	0	\$ 0.00	0	\$ 0.00	0	\$ 0.00	0
4s - 4t	LV Trenching in Cable Allocation	21m	0	\$ 0.00	0	\$ 0.00	0	\$ 0.00	0
Sub Totals			0	\$ 0	0	\$ 0	0	\$ 0	0
Column Total			\$ 0			\$ 0			

Duct Breakdown Table - Continued									
Route	Configuration	Route Length	Duct Re-Imbursement			Duct Usage Charge			
			No. of 50mm Ducts	Amount (@ \$7/m)	No. of 125mm Ducts	Amount (@ \$27/m)	No. of 50mm Ducts	Amount (@ \$7/m)	No. of 125mm Ducts
4t - 4u	LV Trenching in Cable Allocation	8m	0	\$ 0.00	0	\$ 0.00	0	\$ 0.00	0
4u - 4v	HV Trenching in Cable Allocation	22m	0	\$ 0.00	0	\$ 0.00	0	\$ 0.00	0
4v - 4a	HV Trenching in Cable Allocation	31m	0	\$ 0.00	0	\$ 0.00	0	\$ 0.00	0
5a - 5b	LV Trenching in Cable Allocation	51m	0	\$ 0.00	0	\$ 0.00	0	\$ 0.00	0
5b - 5c	LV Trenching in Cable Allocation	45m	0	\$ 0.00	0	\$ 0.00	0	\$ 0.00	0
5c - 5d	LV Trenching in Cable Allocation	5m	0	\$ 0.00	0	\$ 0.00	0	\$ 0.00	0
5d - 5e	LV Trenching in Cable Allocation	25m	0	\$ 0.00	0	\$ 0.00	0	\$ 0.00	0
5e - 5f	LV Trenching in Cable Allocation	18m	0	\$ 0.00	0	\$ 0.00	0	\$ 0.00	0
5f - 5g	LV Trenching in Cable Allocation	15m	0	\$ 0.00	0	\$ 0.00	0	\$ 0.00	0
5g - 5h	LV Trenching in Cable Allocation	35m	0	\$ 0.00	0	\$ 0.00	0	\$ 0.00	0
5h - 5i	LV Trenching in Cable Allocation	16m	0	\$ 0.00	0	\$ 0.00	0	\$ 0.00	0
5i - 5j	LV Trenching in Cable Allocation	10m	0	\$ 0.00	0	\$ 0.00	0	\$ 0.00	0
5j - 5k	LV Trenching in Cable Allocation	10m	0	\$ 0.00	0	\$ 0.00	0	\$ 0.00	0
5k - 5l	LV Trenching in Cable Allocation	26m	0	\$ 0.00	0	\$ 0.00	0	\$ 0.00	0
5l - 5m	LV Trenching in Cable Allocation	10m	0	\$ 0.00	0	\$ 0.00	0	\$ 0.00	0
Sub Totals			0	\$ 0	0	\$ 0	0	\$ 0	0
Column Total			\$ 0			\$ 0			

Duct Breakdown Table - Continued									
Route	Configuration	Route Length	Duct Re-Imbursement			Duct Usage Charge			
			No. of 50mm Ducts	Amount (@ \$7/m)	No. of 125mm Ducts	Amount (@ \$27/m)	No. of 50mm Ducts	Amount (@ \$7/m)	No. of 125mm Ducts
5q - 5r	HV Trenching in Cable Allocation	8m	0	\$ 0.00	0	\$ 0.00	0	\$ 0.00	0
5r - 5s	HV Trenching in Cable Allocation	7m	0	\$ 0.00	0	\$ 0.00	0	\$ 0.00	0
5s - 5t	HV Trenching in Cable Allocation	28m	0	\$ 0.00	0	\$ 0.00	0	\$ 0.00	0
5t - 5a	HV Trenching in Cable Allocation	10m	0	\$ 0.00	0	\$ 0.00	0	\$ 0.00	0
6a - 6b	HV Trenching in Cable Allocation	35m	0	\$ 0.00	0	\$ 0.00	0	\$ 0.00	0
6b - 6c	HV Trenching in Cable Allocation	33m	0	\$ 0.00	0	\$ 0.00	0	\$ 0.00	0
6c - 6d	HV Trenching in Cable Allocation	15m	0	\$ 0.00	0	\$ 0.00	0	\$ 0.00	0
6d - 6e	HV Trenching in Cable Allocation	28m	0	\$ 0.00	0	\$ 0.00	0	\$ 0.00	0
6e - 6f	HV Trenching in Cable Allocation	13m	0	\$ 0.00	0	\$ 0.00	0	\$ 0.00	0
6f - 6g	HV Trenching in Cable Allocation	20m	0	\$ 0.00	0	\$ 0.00	0	\$ 0.00	0
6g - 6h	HV Trenching in Cable Allocation	39m	0	\$ 0.00	0	\$ 0.00	0	\$ 0.00	0
6h - 6i	HV Trenching in Cable Allocation	8m	0	\$ 0.00	0	\$ 0.00	0	\$ 0.00	0
6i - 6j	HV Trenching in Cable Allocation	8m	0	\$ 0.00	0	\$ 0.00	0	\$ 0.00	0
6j - 6k	HV Trenching in Cable Allocation	30m	0	\$ 0.00	0	\$ 0.00	0	\$ 0.00	0
6k - 6l	HV Trenching in Cable Allocation	16m	0	\$ 0.00	0	\$ 0.00	0	\$ 0.00	0
Sub Totals			0	\$ 0	0	\$ 0	0	\$ 0	0
Column Total			\$ 0			\$ 0			

Certified by Endeavour Energy
Amendment: _____
Date Approved: _____
Examiner's Signature: _____
Print Name: _____
This Certification is issued subject to Endeavour Energy's Standard Certification Terms.

WORK COMPLETED / FIELD BOOK
CONSTRUCTED BY C.J. DOYLE CONTRACTING
WORKS COMPLETED CHRIS JOWETT
SIGNATURE C. JOWETT DATE 18/03/25
INSPECTED BY GAV NIXON
SIGNATURE _____ DATE _____
ASSET RECORDING
I STEVE FRIDAY
OF C.J. DOYLE CONTRACTING
CONTACT No 8784-1922
HEREBY CERTIFY THAT ASSETS MARKED AS-BUILT ON THIS DRAWING HAVE BEEN RECORDED AS PER ENDEAVOUR ENERGY STANDARD SAD 0004.
SIGNATURE STEVE FRIDAY DATE 18/03/2025

Conduit / Cable Legend
LV LV Cable - Direct Buried.
HV HV Cable - Direct Buried.
50mm Duct - Spare.
50mm Duct - with Existing Cable.
50mm Duct - with New SL Cable.
125mm Duct - with Existing Cable.
125mm Duct - with New Cable.
125mm Duct - Spare.

Duct Breakdown Table - Continued									
Route	Configuration	Route Length	Duct Re-Imbursement			Duct Usage Charge			
			No. of 50mm Ducts	Amount (@ \$7/m)	No. of 125mm Ducts	Amount (@ \$27/m)	No. of 50mm Ducts	Amount (@ \$7/m)	No. of 125mm Ducts
6p - 6q	LV Trenching in Cable Allocation	31m	0	\$ 0.00	0	\$ 0.00	0	\$ 0.00	0
6q - 6r	LV Trenching in Cable Allocation	13m	0	\$ 0.00	0	\$ 0.00	0	\$ 0.00	0
6r - 6a	LV Trenching in Cable Allocation	18m	0	\$ 0.00	0	\$ 0.00	0	\$ 0.00	0
7a - 7b	LV Trenching in Cable Allocation	36m	0	\$ 0.00	0	\$ 0.00	0	\$ 0.00	0
7b - 7c	LV Trenching in Cable Allocation	30m	0	\$ 0.00	0	\$ 0.00	0	\$ 0.00	0
7c - 7d	LV Trenching in Cable Allocation	13m	0	\$ 0.00	0	\$ 0.00	0	\$ 0.00	0
7d - 7e	LV Trenching in Cable Allocation	23m	0	\$ 0.00	0	\$ 0.00	0	\$ 0.00	0
7e - 7f	LV Trenching in Cable Allocation	25m	0	\$ 0.00	0	\$ 0.00	0	\$ 0.00	0
7f - 7g	LV Trenching in Cable Allocation	15m	0	\$ 0.00	0	\$ 0.00	0	\$ 0.00	0
7g - 7h	LV Trenching in Cable Allocation	27m	0	\$ 0.00	0	\$ 0.00	0	\$ 0.00	0
7h - 7i	HV Trenching in Cable Allocation	15m	0	\$ 0.00	0	\$ 0.00	0	\$ 0.00	0
7i - 7j	HV Trenching in Cable Allocation	2m	0	\$ 0.00	0	\$ 0.00	0	\$ 0.00	0
7j - 7k	HV Trenching in Cable Allocation	30m	0	\$ 0.00	0	\$ 0.00	0	\$ 0.00	0
7k - 7l	HV Trenching in Cable Allocation	16m	0	\$ 0.00	0	\$ 0.00	0	\$ 0.00	0
7l - 7m	HV Trenching in Cable Allocation	26m	0	\$ 0.00	0	\$ 0.00	0	\$ 0.00	0
Sub Totals			0	\$ 0	0	\$ 0	0	\$ 0	0
Column Total			\$ 0			\$ 0			

Duct Breakdown Table - Continued									
Route	Configuration	Route Length	Duct Re-Imbursement			Duct Usage Charge			
			No. of 50mm Ducts	Amount (@ \$7/m)	No. of 125mm Ducts	Amount (@ \$27/m)	No. of 50mm Ducts	Amount (@ \$7/m)	No. of 125mm Ducts
7m - 7n	HV Trenching in Cable Allocation	39m	0	\$ 0.00	0	\$ 0.00	0	\$ 0.00	0
7n - 7o	HV Trenching in Cable Allocation	27m	0	\$ 0.00	0	\$ 0.00	0	\$ 0.00	0
7o - 7p	HV Trenching in Cable Allocation	19m	0	\$ 0.00	0	\$ 0.00	0	\$ 0.00	0
7p - 7q	HV Trenching in Cable Allocation	30m	0	\$ 0.00	0	\$ 0.00	0	\$ 0.00	0
7q - 7r	HV Trenching in Cable Allocation	10m	0	\$ 0.00	0	\$ 0.00	0	\$ 0.00	0
7r - 7s	LV Trenching in Cable Allocation	17m	0	\$ 0.00	0	\$ 0.00	0	\$ 0.00	0
7s - 7t	LV Trenching in Cable Allocation	37m	0	\$ 0.00	0	\$ 0.00	0	\$ 0.00	0
7t - 7u	LV Trenching in Cable Allocation	9m	0	\$ 0.00	0	\$ 0.00	0	\$ 0.00	0
7u - 7a	LV Trenching in Cable Allocation	8m	0	\$ 0.00	0	\$ 0.00	0	\$ 0.00	0
8a - 8b	LV Trenching in Cable Allocation	15m	0	\$ 0.00	0	\$ 0.00	0	\$ 0.00	0
8d - 8e	LV Trenching in Cable Allocation	30m	0	\$ 0.00	0	\$ 0.00	0	\$ 0.00	0
8g - 8h	LV Trenching in Cable Allocation	16m	0	\$ 0.00	0	\$ 0.00	0	\$ 0.00	0
8h - 8i	LV Trenching in Cable Allocation	27m	0	\$ 0.00	0	\$ 0.00	0	\$ 0.00	0
8k - 8l	HV Trenching in Cable Allocation	25m	0	\$ 0.00	0	\$ 0.00	0	\$ 0.00	0
8l - 8m	HV Trenching in Cable Allocation	36m	0	\$ 0.00	0	\$ 0.00	0	\$ 0.00	0
Sub Totals			0	\$ 0	0	\$ 0	0	\$ 0	0
Column Total			\$ 0			\$ 0			

Duct Breakdown Table - Continued									
Route	Configuration	Route Length	Duct Re-Imbursement			Duct Usage Charge			
			No. of 50mm Ducts	Amount (@ \$7/m)	No. of 125mm Ducts	Amount (@ \$27/m)	No. of 50mm Ducts	Amount (@ \$7/m)	No. of 125mm Ducts
8n - 8o	LV Trenching in Cable Allocation	20m	0	\$ 0.00	0	\$ 0.00	0	\$ 0.00	0
8o - 8p	LV Trenching in Cable Allocation	23m	0	\$ 0.00	0	\$ 0.00	0	\$ 0.00	0
9a - 9	Existing Trench	2m	0	\$ 0.00	0	\$ 0.00	0	\$ 0.00	0
9 - 9b	Existing Trench	2m	0	\$ 0.00	0	\$ 0.00	0	\$ 0.00	0
9c - 9d	New Underboard Easement	17m	0	\$ 0.00	0	\$ 0.00	0	\$ 0.00	0
9d - 9e	New Underboard Easement	202m	0	\$ 0.00	0	\$ 0.00	0	\$ 0.00	0
9e - 9f	HV Trenching in Cable Allocation	181m	0	\$ 0.00	0	\$ 0.00	0	\$ 0.00	0
9f - 9g	HV Trenching in Road Crossing	22m	0	\$ 0.00	0	\$ 0.00	0	\$ 0.00	0
9g - 9h	HV Trenching in Future Allocation	54m	0	\$ 0.00	0	\$ 0.00	0	\$ 0.00	0
9h - 9i	HV Trenching in Cable Allocation	8m	0	\$ 0.00	0	\$ 0.00	0	\$ 0.00	0
9i - 9j	HV Trenching in Cable Allocation	44m	0	\$ 0.00	0	\$ 0.00	0	\$ 0.00	0
9j - 9k	HV Trenching in Cable Allocation	27m	0	\$ 0.00	0	\$ 0.00	0	\$ 0.00	0
9k - 9l	HV Trenching in Cable Allocation	15m	0	\$ 0.00	0	\$ 0.00	0	\$ 0.00	0
9l - 9m	HV Trenching in Cable Allocation	33m	0	\$ 0.00	0	\$ 0.00	0	\$ 0.00	0
9m - 9n	HV Trenching in Cable Allocation	13m	0	\$ 0.00	0	\$ 0.00	0	\$ 0.00	0
Sub Totals			0	\$ 0	0	\$ 0	0	\$ 0	0
Column Total			\$ 0			\$ 0			

Certified by Endeavour Energy

Amendment: _____
Date Approved: _____
Examiner's Signature: _____
Print Name: _____
This Certification is issued subject to Endeavour Energy's Standard Certification Terms.

WORK COMPLETED / FIELD BOOK

CONSTRUCTED BY C.J. DOYLE CONTRACTING

WORKS COMPLETED CHRIS JOWETT

SIGNATURE C.JOWETT DATE 18/03/25

INSPECTED BY GAV NIXON

SIGNATURE DATE

ASSET RECORDING

I STEVE FRIDAY

OF C.J. DOYLE CONTRACTING

CONTACT No. 9784-1922

HEREBY CERTIFY THAT ASSETS MARKED AS-BUILT ON THIS DRAWING HAVE BEEN RECORDED AS PER ENDEAVOUR ENERGY STANDARD SA0 0004.

SIGNATURE STEVE FRIDAY DATE 18/03/2025

Conduit / Cable Legend

- LV LV Cable - Direct Buried.
- HV HV Cable - Direct Buried.
- 50mm Duct - Spare.
- 50mm Duct - with Existing Cable.
- 50mm Duct - with New SL Cable.
- 125mm Duct - with Existing Cable.
- 125mm Duct - with New Cable.
- 125mm Duct - Spare.

Cadastral: © Land and Property Information 2015

AMENDMENTS	ORIGINAL ISSUE	DRAFT No. 01	CHK Michael.J.B	DWN Michael.J.B	Route through Riparian realigned at developers request.	DRAFT No. 01	CHK Michael.J.B	DWN Michael.J.B	Asset Numbers Aligned to Align with ADMS	DRAFT No. 01
A	22-6-2023	B	18-03-2024	C	02-05-2024	C	02-05-2024	C	02-05-2024	C

powerlinedesign
POWER LINE DESIGN PTY LTD
PO BOX 338 Mittagong NSW 2575
Ph (02) 4872 1920 Fax (02) 4872 1240
Accredited Designer Number 2480 ABN 32107 591 846

The preparation of this design has been undertaken giving due consideration to the existing services. The project contributor is wholly responsible for verifying the exact location of existing services and performing survey marks prior to commencing construction. No responsibility or liability will be accepted by the designer of this project for damage to existing services as a result of this design.

PLD Ref: 3868

THIS DRAWING AND THE COPYRIGHT THEREIN IS THE PROPERTY OF ENDEAVOUR ENERGY AND MAY NOT BE COPIED, REPRODUCED, DISTRIBUTED, LOANED OR USED WITHOUT THE WRITTEN CONSENT OF ENDEAVOUR ENERGY

Reference Drawings		Work Orders		CAMS File No.	
527570C	URS26188 Duct Trench & Easement	General	AM Project No.	URS26188	
		Overhead	HV Switching		
		Underground	EE Depot	Kings Park	
		Substations	EE Region	Northern	
			HV OP Diagram	Marsden Park	
			Local Government Area	Blacktown City	

Drawn	Michael.J.B	ORIGINAL SCALE 1:1000
Date	02-05-2024	DO NOT SCALE Dimensions in Meters
Ch'd	Michael.J.B	MGA 56: GDA94
Design	Michael.J.B	

Off Richmond Road
MARSDEN PARK
URS26188
Subdivision of Lot 3, DP 1230408
Stage 7J
Electrical Reticulation

Endeavour Energy
A1 527571 C
SHEET No 9 OF 15 SHEETS

Site Plan - 11kV Fdr Alteration

Not to Scale
Scale 1:1000

Disconnect HV Cable from
Sw C3477 (PMS 34599)

LEGEND

- Existing Underground Cables,
- Existing Conduits (Ducts),
- Existing Service Mains
- Existing Pillar,
- Existing Column,
- Existing Streetlight Lantern,
- Existing Padmount Substation,
- Point Indicator,

Scale 1:1000



Final HV Circuit - 11kV Fdr Alteration

Not to Scale
11kV Area

LEGEND

- Existing Underground Cables
- Install 11kV 240mm² Al 3-Core XLPE/PVC/HDPE Cable (U72)
R.L. 237m, C.L. 249m. (This Sheet Only)
R.L. 2649m, C.L. 2782m. (Entire Project including sheet 4)
- Straight Through Joint (STJ),
- End Cap (E.C.),

Install new 11kV Cable from PMS 33408 to Point A.
Locate existing HV Cable extending from PMS 34599 and PMS 33167 at Point A.
Cut 11kV cable at Point A.
Install STJ at point A between new cable and section of cable extending to PMS 33167.

TERMINATION NOTE #18

JOINT/TERMINATION TYPE: HV STJ
NETWORK ACCESS AUTHORIZATION: 1584
JOINT/TERMINATION KIT #: NKSU-P101
JOINT/TERMINATION BATCH #: CZ2315-000
DATE OF MANUFACTURE: 20/07/21

TERMINATION NOTE #17

JOINT/TERMINATION TYPE: INDOOR TERMINATION
NETWORK ACCESS AUTHORIZATION: 1584
JOINT/TERMINATION KIT #: C SEN12630-240/300
JOINT/TERMINATION BATCH #: C22315-000
DATE OF MANUFACTURE: 05/12/20

Terminate 11kV Cable at
Sw A5855 (PMS 33408)

PMS 34599
C3475 C3476 C3477 C3478
C3471 C3472 C3473 C3474

Disconnect HV Cable from
Sw C3477 (PMS 34599)

To Sw C3483
(PMS 34600)
"Westway Ave"

To Sw C3353
(PMS 33168)
"Lotus St"

To Sw C3353
(PMS 33168)
"Lotus St"

Duct Breakdown Table

Route	Configuration	Route Length	Duct Re-Imbursement			Duct Usage Charge		
			No. of 50mm Ducts	Amount (@ \$7/m)	Amount (@ \$27/m)	No. of 125mm Ducts	Amount (@ \$7/m)	Amount (@ \$27/m)
a → b	Existing Footpath Ducts	15m	0	\$ 0.00	\$ 0.00	0	\$ 0.00	\$ 405.00
b → c	Existing Road Crossing	42	0	\$ 0.00	\$ 0.00	0	\$ 0.00	\$ 1134.00
c → d	Existing Footpath Ducts	21m	0	\$ 0.00	\$ 0.00	0	\$ 0.00	\$ 567.00
d → e	Existing Footpath Ducts	23m	0	\$ 0.00	\$ 0.00	0	\$ 0.00	\$ 621.00
e → f	Existing Road Crossing	24m	0	\$ 0.00	\$ 0.00	0	\$ 0.00	\$ 648.00
f → g	Existing Footpath Ducts	25m	0	\$ 0.00	\$ 0.00	0	\$ 0.00	\$ 675.00
g → h	Existing Footpath Ducts	25m	0	\$ 0.00	\$ 0.00	0	\$ 0.00	\$ 675.00
h → i	Existing Road Crossing	24m	0	\$ 0.00	\$ 0.00	0	\$ 0.00	\$ 648.00
i → j	Existing Footpath Ducts	33m	0	\$ 0.00	\$ 0.00	0	\$ 0.00	\$ 891.00
Sub Totals			0	\$ 0.00	\$ 0.00	#	###	\$ 6264
Column Total			\$ 0.00			\$ 6 264.00		
Project Total			\$ 0.00			\$ 6 264.00		

Certified by Endeavour Energy

Amendment: _____
Date Approved: _____
Examiner's Signature: _____
Print Name: _____
This Certification is issued subject to Endeavour Energy's Standard Certification Terms.

Conduit / Cable Legend

- LV Cable - Direct Buried,
- HV Cable - Direct Buried,
- 50mm Duct - Spare,
- 50mm Duct - with Existing Cable,
- 50mm Duct - with New SL Cable,
- 125mm Duct - with Existing Cable,
- 125mm Duct - with New Cable,
- 125mm Duct - Spare,

11kV Switching Requirements at Commissioning of this Project

Open	Sw A3357 (PMS 33169) "Malaleuca" Sh12
Close	Sw A3346 (PMS 33167) "Geranium" Sh12
Close	Sw A5855 (PMS 33408) "Bromus" Sh12
Close	Sw 237144 (PMS 95439) "Diamondback"
Close	Sw 237145 (PMS 95439) "Diamondback"
Close	Sw 237146 (PMS 95439) "Diamondback"
Close	Sw 229989 (PMS 95864) "Riberry"
Open	Sw 229990 (PMS 95864) "Riberry"
Open	Sw J1256 (PMS 55587) "Mazda"
Open	Sw J1249 (PMS 55586) "Numbat"

WORK COMPLETED / FIELD BOOK

CONSTRUCTED BY: C.J. DOYLE CONTRACTING
WORKS COMPLETED: CHRIS JOWETT
SIGNATURE: C.J. JOWETT DATE: 18/03/25
INSPECTED BY: GAV NIXON
SIGNATURE: GAV NIXON DATE: _____

ASSET RECORDING

I, STEVE FRIDAY
OF C.J. DOYLE CONTRACTING
CONTACT No: 8784-1922
HEREBY CERTIFY THAT ASSETS MARKED AS-BUILT ON THIS DRAWING HAVE BEEN RECORDED AS PER ENDEAVOUR ENERGY STANDARD SAD 0004.
SIGNATURE STEVE FRIDAY DATE: 18/03/2025

powerlinedesign
POWER LINE DESIGN PTY LTD
PO BOX 338 Mittagong NSW 2575
Ph (02) 4872 1920 Fax (02) 4872 1240
Accredited Designer Number 2486 / ABN: 33107 591 846

The preparation of this design has been undertaken giving due consideration to the existing services. The project contractor is wholly responsible for verifying the exact location of existing services and permanent survey marks prior to commencing construction. No responsibility or liability will be accepted by the designer of this project for damage to existing services as a result of this design.

PLD Ref: 3868

Reference Drawings
527570C URS26188 Duct Trench & Easement

Work Orders
General
Overhead
Underground
Substations

CAMS File No.
URS26188

AM Project No.
HV Switching
EE Depot
EE Region
HV OP Diagram
Local Government Area

Drawn
Date
Ch'd

Michael J.B
02-05-2024
Michael J.B

Design
Michael J.B

ORIGINAL SCALE 1:1000
DO NOT SCALE Dimensions in Meters
MGA 56: GDA94

Off Richmond Road
MARSDEN PARK
URS26188
Subdivision of Lot 3, DP 1230408
Stage 7J
Electrical Reticulation


A1 527571 C

SHEET No 12 OF 15 SHEETS

12 #4382

WAE SURVEY COORDINATE TABLE - GDA2020									
NODE ID #	QUALITY LEVEL	ASSET TYPE	PROPERTY LINE	COVER	NOTES	EASTING	NORTHING	REDUCED/SURFACE LEVEL	
72	A	STJ HV	0.79	-0.75		297109.29	6269426.95	25.88	
73	A	DUCT END	0.82	-0.75		297110.83	6269427.17	25.9	
74	A	DUCT END	0.86	-0.75		297106.89	6269426.77	26.13	
87	A	ROUTE	0.83	-0.75		295862.42	6269425.31	16.74	
88	A	ROUTE	0.98	-0.75		295856.05	6269414.93	16.88	
89	A	ROUTE	0.9	-0.75		295847.1	6269395.54	16.91	
90	A	DUCT CROSSING	N/A	N/A		295846.73	6269394.83	17.02	
91	A	CONCRETE	N/A	-0.75		295845.71	6269395.39	17.13	
92	A	CONCRETE	N/A	-0.75		295838.11	6269396.25	17.1	
93	A	DUCT CROSSING/ROUTE	N/A	N/A		295838.2	6269399.23	17.04	
94	A	CONCRETE	N/A	-0.75		295829.6	6269403.34	17.17	
95	A	DUCT CROSSING	N/A	N/A		295828.26	6269404.01	17.11	
96	A	DUCT END	0.95	-0.75		295827.76	6269404.43	17.12	
97	A	ROUTE	0.88	-0.75		295817.24	6269409.5	17.32	
99	A	STJ HV	0.73	-0.75		295817.92	6269409	17.05	
100	A	STJ HV	0.87	-0.75		295818.32	6269408.97	17.05	
104	A	ROUTE	0.6	-0.75		296127.63	6269517.28	17.09	
105	A	ROUTE	0.62	-0.75		296123.52	6269506.73	17.17	
106	A	DUCT END	0.63	-0.75		296136.81	6269533.8	17.01	
110	A	UNDERBORE END	N/A	-0.75		296139.6	6269533.37	17.03	
112	A	DUCT CROSSING	N/A	N/A		296137.6	6269534.49	16.92	
113	A	DUCT CROSSING	N/A	N/A		296151	6269526.35	16.61	
114	A	UNDERBORE END	N/A	-0.75		296149.72	6269527.21	16.7	
117	A	STJ HV	0.77	-0.75		296148.33	6269522.16	16.98	
120	A	STJ HV	0.89	-0.75		296155.57	6269532.75	16.97	
146	A	DUCT END	0.96	-0.75		295381.98	6269289.39	16.98	
147	A	SPRAY ROUTE	0.94	-0.75		295386.33	6269297.13	17.16	
148	A	SPRAY ROUTE	0.86	-0.75		295393.87	6269299.4	16.83	
150	A	DUCT CROSSING	N/A	N/A		295394.41	6269299.25	16.55	
151	A	DUCT CROSSING	N/A	N/A		295401.12	6269311.83	16.62	
155	A	SPRAY ROUTE	0.82	-0.75		295398.6	6269313.24	16.95	
157	A	ROUTE	0.93	-0.75		295415.3	6269350.39	17.15	
186	A	SPRAY ROUTE	0.9	-0.75		295420.4	6269359.49	17.08	
188	A	DUCT CROSSING	N/A	N/A		295428.4	6269361.69	16.6	
203	A	DUCT CROSSING	N/A	N/A		295557.9	6269219.77	17.9	
204	A	DUCT CROSSING	N/A	N/A		295560.25	6269212.27	18.24	
205	A	SPRAY ROUTE	0.82	-0.75		295560.22	6269212.49	18.43	
206	A	ROUTE	0.82	-0.75		295556.36	6269205.71	18.59	
207	A	DUCT END	0.89	-0.75		295547.56	6269190.2	18.75	
208	A	DUCT CROSSING	N/A	N/A		295533.57	6269231.59	17.98	
209	A	ROUTE	0.82	-0.75		295533.66	6269231.45	17.87	
210	A	ROUTE	0.65	-0.75		295524.89	6269235.58	18.04	
213	A	ROUTE	0.78	-0.75		295504.66	6269245.57	17.91	
214	A	DUCT CROSSING	N/A	N/A		295495.47	6269250.16	17.49	
215	A	ROUTE	0.59	-0.75		295486.5	6269254.19	17.75	
218	A	ROUTE	0.81	-0.75		295466.27	6269264.23	17.72	
219	A	ROUTE	0.74	-0.75		295455.05	6269269.64	17.28	
220	A	DUCT CROSSING	N/A	N/A		295455.17	6269269.73	17.28	
221	A	ROUTE	0.69	-0.75		295445.85	6269274	17.54	
226	A	DUCT CROSSING	N/A	N/A		295414.82	6269289.31	16.85	
228	A	DUCT CROSSING	N/A	N/A		295422.41	6269301.45	16.73	
230	A	ROUTE	0.95	-0.75		295431.44	6269296.98	17.11	
232	A	ROUTE	0.93	-0.75		295449.72	6269288.12	17.26	
234	A	DUCT CROSSING	N/A	N/A		295464.01	6269281.24	17.09	
235	A	ROUTE	0.92	-0.75		295469.53	6269278.51	17.37	
238	A	DUCT CROSSING	N/A	N/A		295501.84	6269282.93	17.5	
239	A	ROUTE	0.98	-0.75		295515.22	6269256.24	17.85	
241	A	DUCT CROSSING	N/A	N/A		295565.01	6269232.07	17.93	
243	A	ROUTE	0.97	-0.75		295576.9	6269241.1	18.94	
245	A	DUCT CROSSING	N/A	N/A		295584.41	6269254.33	19.17	
248	A	DUCT CROSSING	N/A	N/A		295595.59	6269273.67	19.85	
249	A	DUCT CROSSING	N/A	N/A		295593.15	6269281.49	20.13	
250	A	SPRAY ROUTE	0.82	-0.75		295593.77	6269280.68	20.06	
252	A	DUCT CROSSING	N/A	N/A		295550.94	6269302.11	19.3	
260	A	ROUTE	0.74	-0.75		295465.73	6269343.4	17.78	
262	A	DUCT CROSSING	N/A	N/A		295474.58	6269339.21	17.68	
263	A	ROUTE	0.77	-0.75		295483.29	6269334.83	18.35	
266	A	ROUTE	0.71	-0.75		295503.81	6269324.81	18.75	
267	A	ROUTE	0.85	-0.75		295512.68	6269320.65	18.75	
268	A	ROUTE	0.8	-0.75		295521.44	6269316.33	19.22	
293	A	DUCT CROSSING	N/A	N/A		295608.63	6269296.42	19.84	
294	A	DUCT CROSSING	N/A	N/A		295600.41	6269293.86	20.23	
297	A	ROUTE	0.92	-0.75		295569.38	6269308.91	19.89	
316	A	DUCT CROSSING	N/A	N/A		295435.31	6269374.19	16.55	
317	A	SPRAY ROUTE	0.92	-0.75		295432.61	6269381.95	17.14	
318	A	ROUTE	0.98	-0.75		295443.35	6269401.83	17.04	
319	A	SPRAY ROUTE	0.98	-0.75		295454.86	6269422.07	16.79	
320	A	DUCT CROSSING	N/A	N/A		295455.06	6269422.15	16.57	
322	A	ROUTE	0.97	-0.75		295443.88	6269242.3	18.08	
323	A	DUCT CROSSING	N/A	N/A		295539.67	6269244.44	17.82	
325	A	ROUTE	0.92	-0.75		295525.89	6269251.1	17.91	
327	A	ROUTE	0.96	-0.75		295496.76	6269265.23	17.64	
328	A	ROUTE	0.72	-0.75		295495.14	6269250.12	17.39	
330	A	ROUTE	0.81	-0.75		295425.91	6269283.85	17.27	
332	A	ROUTE	0.86	-0.75		295415.07	6269289.16	16.72	
334	A	DUCT END	0.98	-0.75		295401.33	6269311.65	16.65	
334	A	ROUTE	0.98	-0.75		295409.11	6269339.15	17.07	
337	A	DUCT CROSSING	N/A	N/A		295512.97	6269320.57	18.82	
338	A	DUCT CROSSING	N/A	N/A		295560.16	6269313.48	19.58	
340	A	ROUTE	0.95	-0.75		295549.15	6269318.74	19.54	
342	A	ROUTE	0.86	-0.75		295531.07	6269327.6	19.14	
343	A	DUCT CROSSING	N/A	N/A		295521.96	6269332.03	18.69	
344	A	ROUTE	0.9	-0.75		295513.06	6269336.32	18.87	
345	A	ROUTE	0.89	-0.75		295504.32	6269340.58	18.54	
347	A	DUCT CROSSING	N/A	N/A		295483.74	6269350.58	17.83	
348	A	ROUTE	0.85	-0.75		295474.97	6269354.95	17.82	
350	A	ROUTE	0.9	-0.75		295455.38	6269364.37	17.41	
354	A	SPRAY ROUTE	0.84	-0.75		295461.5	6269424.08	17.03	
363	A	ROUTE	0.81	-0.75		295555.62	6269378.69	18.31	
364</									

	1	2	3	4	5	6	7	8	9	10	11	12
A	886	A	DUCT END	0.99	-0.75	295677.51	6269577.64	18.43				
	892	A	DUCT CROSSING	N/A	-0.75	295771.3	6269425.25	19.83				
	893	A	DUCT CROSSING	N/A	-0.75	295778.48	6269428.39	19.14				
	894	A	ROUTE	0.82	-0.75	295799.44	6269418.09	18.28				
	897	A	ROUTE	0.99	-0.75	295762.85	6269405.4	20.37				
	899	A	DUCT CROSSING	N/A	-0.75	295754.16	6269384.54	20.03				
	901	A	DUCT CROSSING	N/A	-0.75	295742.71	6269358.75	20.24				
	967	A	ROUTE @ SUB	INSIDE EASEMENT	-0.75	295654	6269271.99	20.79				
	969	A	ROUTE	0.82	-0.75	295663.13	6269267.8	20.84				
	970	A	ROUTE	0.89	-0.75	295667.47	6269269.14	20.76				
	971	A	DUCT CROSSING	N/A	-0.75	295667.87	6269269.25	20.65				
	972	C	ROUTE	0.81	-0.75	295671.82	6269270.68	20.88				
	973	A	ROUTE	1	-0.75	295675.92	6269274.41	20.85				
	974	A	ROUTE	0.98	-0.75	295678.82	6269277.46	20.71				
	975	A	ROUTE	0.96	-0.75	295682.35	6269282.22	20.57				
	976	A	DUCT END	0.99	-0.75	295685.02	6269286.65	20.5				
	977	A	DUCT CROSSING	N/A	-0.75	295685.39	6269287.43	20.55				
	978	A	ROUTE	0.89	-0.75	295690.05	6269295.64	20.63				
	981	A	ROUTE	0.83	-0.75	295699.86	6269313.63	20.58				
	982	A	ROUTE	0.85	-0.75	295705.91	6269325.16	20.41				
	983	A	DUCT CROSSING	N/A	-0.75	295705.75	6269324.73	20.42				
	1009	A	DUCT END	0.81	-0.75	295700.33	6269387.54	19.77				
	1010	A	DUCT CROSSING	N/A	-0.75	295699.8	6269387.89	19.59				
	1012	A	DUCT END	0.86	-0.75	295708.74	6269383.24	19.88				
	1013	A	ROUTE	0.81	-0.75	295717.5	6269378.97	20.06				
	1016	A	DUCT CROSSING	N/A	-0.75	295704.93	6269400.98	19.46				
	1018	A	SPLAY ROUTE	0.87	-0.75	295730.25	6269388.82	20.25				
	1019	A	DUCT END	0.98	-0.75	295737.36	6269391.48	20.45				
	1020	A	DUCT CROSSING	N/A	-0.75	295737.53	6269391.94	20.26				
	1021	A	DUCT END	1	-0.75	295754.13	6269384.86	20.25				
	1022	A	ROUTE	0.99	-0.75	295747.22	6269368.87	20.46				
	1023	A	ROUTE	0.98	-0.75	295742.86	6269359.26	20.46				
	1024	A	ROUTE	1	-0.75	295736.34	6269345.4	20.58				
	1025	A	ROUTE	0.82	-0.75	295728.01	6269328.57	20.53				
	1026	A	DUCT CROSSING	N/A	-0.75	295721.81	6269316.72	20.42				
	1027	A	ROUTE	0.82	-0.75	295722.09	6269316.92	20.44				
	1028	A	DUCT END	0.98	-0.75	295716.05	6269305.38	20.49				
	1029	A	ROUTE	0.95	-0.75	295709.41	6269293.3	20.58				
	1031	A	DUCT CROSSING	N/A	-0.75	295701.76	6269279.37	20.47				
	1032	A	DUCT END	0.97	-0.75	295701.94	6269279.86	20.57				
	1035	A	DUCT CROSSING	N/A	-0.75	295694.76	6269256.36	20.91				
	1036	A	DUCT END	1	-0.75	295694.44	6269256.95	20.61				
	1037	A	ROUTE	0.99	-0.75	295695.48	6269253.98	20.65				
	1038	A	DUCT END	0.92	-0.75	295696.51	6269251.2	20.38				
	1039	A	DUCT CROSSING	N/A	-0.75	295696.96	6269250.61	20.34				
	1042	A	DUCT END	0.89	-0.75	295747.29	6269415.07	20.52				
	1043	A	ROUTE	0.89	-0.75	295754.43	6269432.1	20.3				
	1044	A	DUCT CROSSING	N/A	-0.75	295754.93	6269433.26	20.11				
	1045	A	DUCT END	0.98	-0.75	295764.05	6269454.74	20.29				
	1050	A	ROUTE	1	-0.75	295696.32	6269270.1	20.71				
	1051	A	ROUTE	0.99	-0.75	295694.1	6269265.37	20.79				
	1052	A	ROUTE	0.93	-0.75	295693.12	6269261.63	20.93				
	1053	A	ROUTE	0.95	-0.75	295693.31	6269260.29	20.95				
	1054	A	ROUTE	1	-0.75	295694.05	6269258.02	20.82				
	1055	A	ROUTE	0.88	-0.75	295710.1	6269333.2	20.51				
	1057	A	DUCT CROSSING	N/A	-0.75	295726.33	6269366.71	20.2				
	1059	A	SPLAY ROUTE	0.81	-0.75	295726.91	6269368.56	20.42				
	1060	A	SPLAY ROUTE	0.82	-0.75	295724.44	6269375.23	20.11				
	1063	A	ROUTE	0.49	-0.75	295683.85	6269394.93	19.5				
	1064	A	SPLAY ROUTE	0.82	-0.75	295771.44	6269425.34	20.24				
	1065	A	DUCT END	0.92	-0.75	295778.07	6269428.14	19.73				
	1067	A	DUCT CROSSING	N/A	-0.75	295688.4	6269232.13	20.34				
	1068	A	ROUTE	0.88	-0.75	295687.59	6269232.02	20.34				
	1069	A	ROUTE	0.55	-0.75	295684.4	6269231.12	20.73				
	1070	A	DUCT CROSSING	N/A	-0.75	295645.1	6269254.66	20.37				
	1075	A	SPLAY ROUTE	0.87	-0.75	295651.7	6269228.96	20.95				
	1077	A	ROUTE	0.88	-0.75	295649.18	6269224.57	20.93				
	1078	A	DUCT CROSSING	N/A	-0.75	295635.73	6269201.18	20.49				
	1083	A	DUCT CROSSING	N/A	-0.75	295615.46	6269166.04	20.78				
	1084	A	ROUTE	0.74	-0.75	295614.23	6269164.17	20.7				
	1096	A	EARTH STAKE	0.63	-0.75	295649.21	6269270.63	21.15				
	1087	A	EARTH STAKE	INSIDE EASEMENT	-0.75	295654.46	6269271.55	20.96				
	1088	A	DUCT END	0.99	-0.75	295653.67	6269269.44	20.78				
	1090	A	DUCT END	0.96	-0.75	295616.25	6269167.21	20.92				
	1091	A	ROUTE	0.98	-0.75	295620.71	6269174.92	20.7				
	1092	A	DUCT END	0.9	-0.75	295630.69	6269192.36	20.67				
	1095	A	ROUTE	0.91	-0.75	295635.48	6269200.69	20.52				
	1097	A	DUCT END	0.98	-0.75	295645.34	6269254.59	20.64				
	1098	A	SPLAY ROUTE	0.83	-0.75	295654.03	6269238.62	20.96				
	1099	A	ROUTE	0.96	-0.75	295652.54	6269243.39	20.89				
	1100	A	SPLAY ROUTE	0.82	-0.75	295650.76	6269247.85	20.89				
	1101	A	DUCT CROSSING	N/A	-0.75	295628.74	6269153.81	20.53				
	1102	A	EXISTING DUCT END	N/A	-0.75	295628.11	6269151.91	20.48				
	1142	C	ROUTE	0.81	-0.75	295478.77	6269274.06	17.5				
	1143	C	ROUTE	0.7	-0.75	295547	6269382.79	18.01				
	1144	C	ROUTE	0.8	-0.75	295585.3	6269364.27	18.53				
	1155	A	ROUTE	INSIDE EASEMENT	-0.75	296057.99	6269522.76	12.08				
	1156	A	ROUTE	INSIDE EASEMENT	-0.75	296046.25	6269525.88	12.26				
	1157	A	ROUTE	INSIDE EASEMENT	-0.75	296035.62	6269528.64	12.46				
	1158	A	ROUTE	INSIDE EASEMENT	-0.75	296023.46	6269531.74	12.45				
	1159	A	ROUTE	INSIDE EASEMENT	-0.75	296011.69	6269534.82	12.3				
	1183	A	ROUTE	0.83	-0.75	295862.15	6269424.79	16.7				
	1184	A	ROUTE	0.85	-0.75	295868.35	6269436.96	16.83				
	1185	A	ROUTE	0.87	-0.75	295875.99	6269451.94	16.83				
	1186	A	ROUTE	0.87	-0.75	295883.4	6269466.42	16.77				
	1187	A	ROUTE	0.98	-0.75	295895.11	6269489.52	16.9				
	1189	A	ROUTE	0.91	-0.75	295903.79	6269506.34	17.14				
	1190	A	ROUTE	INSIDE EASEMENT	-0.75	296001.61	6269537.36	12.34				
	1195	A	ROUTE	0.97	-0.75	295924.82	6269547.43	17.82				
	1198	C	ROUTE	0.98	-0.75	295914.6	6269527.54	17.28				
	1199	A	ROUTE	INSIDE EASEMENT	-0.75	296094.1	6269513.41	10.93				
	1200	A	ROUTE	INSIDE EASEMENT	-0.75	296089.67	6269514.62	10.18				
	1201	A	ROUTE	INSIDE EASEMENT	-0.75	296085.13	6269515.7	10.53				
	1202	A	ROUTE	INSIDE EASEMENT	-0.75	296082.1	6269516.66	10.98				
	1206	A	ROUTE	INSIDE EASEMENT	-0.75	296056.94	6269523	12.04				
	1207	A	ROUTE	INSIDE EASEMENT	-0.75	296066.98	6269520.47	11.9				
	1208	A	ROUTE	INSIDE EASEMENT	-0.75	296076.27	6269518.1	11.38				
	1209	A	CONCRETE	INSIDE EASEMENT	-0.75	296082.53	6269516.38	11.02				
	1210	A	ROUTE	INSIDE EASEMENT	-0.75	296100.52	6269511.92	11.74				
	1211	A	ROUTE	INSIDE EASEMENT	-0.75	296106.17	6269510.47	12.82				
	1212	A	ROUTE	INSIDE EASEMENT	-0.75	296106.24	6269510.43	12.8				
	1213	A	ROUTE	INSIDE EASEMENT	-0.75	296114.98	6269508.18	15.19				
	1214	A	CONCRETE	INSIDE EASEMENT	-0.75	296093.45	6269513.63	11.02				
	1215	A	ROUTE	0.87	-0.75	295929.41	6269556.05	17.8				
	1215	A	ROUTE	INSIDE EASEMENT	-0.75	295938.87	6269553.6	15.55				
	1217	A	ROUTE	INSIDE EASEMENT	-0.75	295949.39	6269550.89	13.06				
	1218	A	ROUTE	INSIDE EASEMENT	-0.75	295957.55	6269548.82	11.69				
	1219	A	ROUTE	INSIDE EASEMENT	-0.75	295972.29	6269544.96	11.6				
	1220	A	ROUTE	INSIDE EASEMENT	-0.75	295985.93	6269541.41	12.19				
	1222	A	CONCRETE	INSIDE EASEMENT	-0.75	296077.76	6269517.77	11.41				
	1223	A	CONCRETE	INSIDE EASEMENT	-0.75	296066.31	6269520.71	12.08				
	1224	A	CONCRETE	INSIDE EASEMENT	-0.75	296057.16	6269523	12.23				

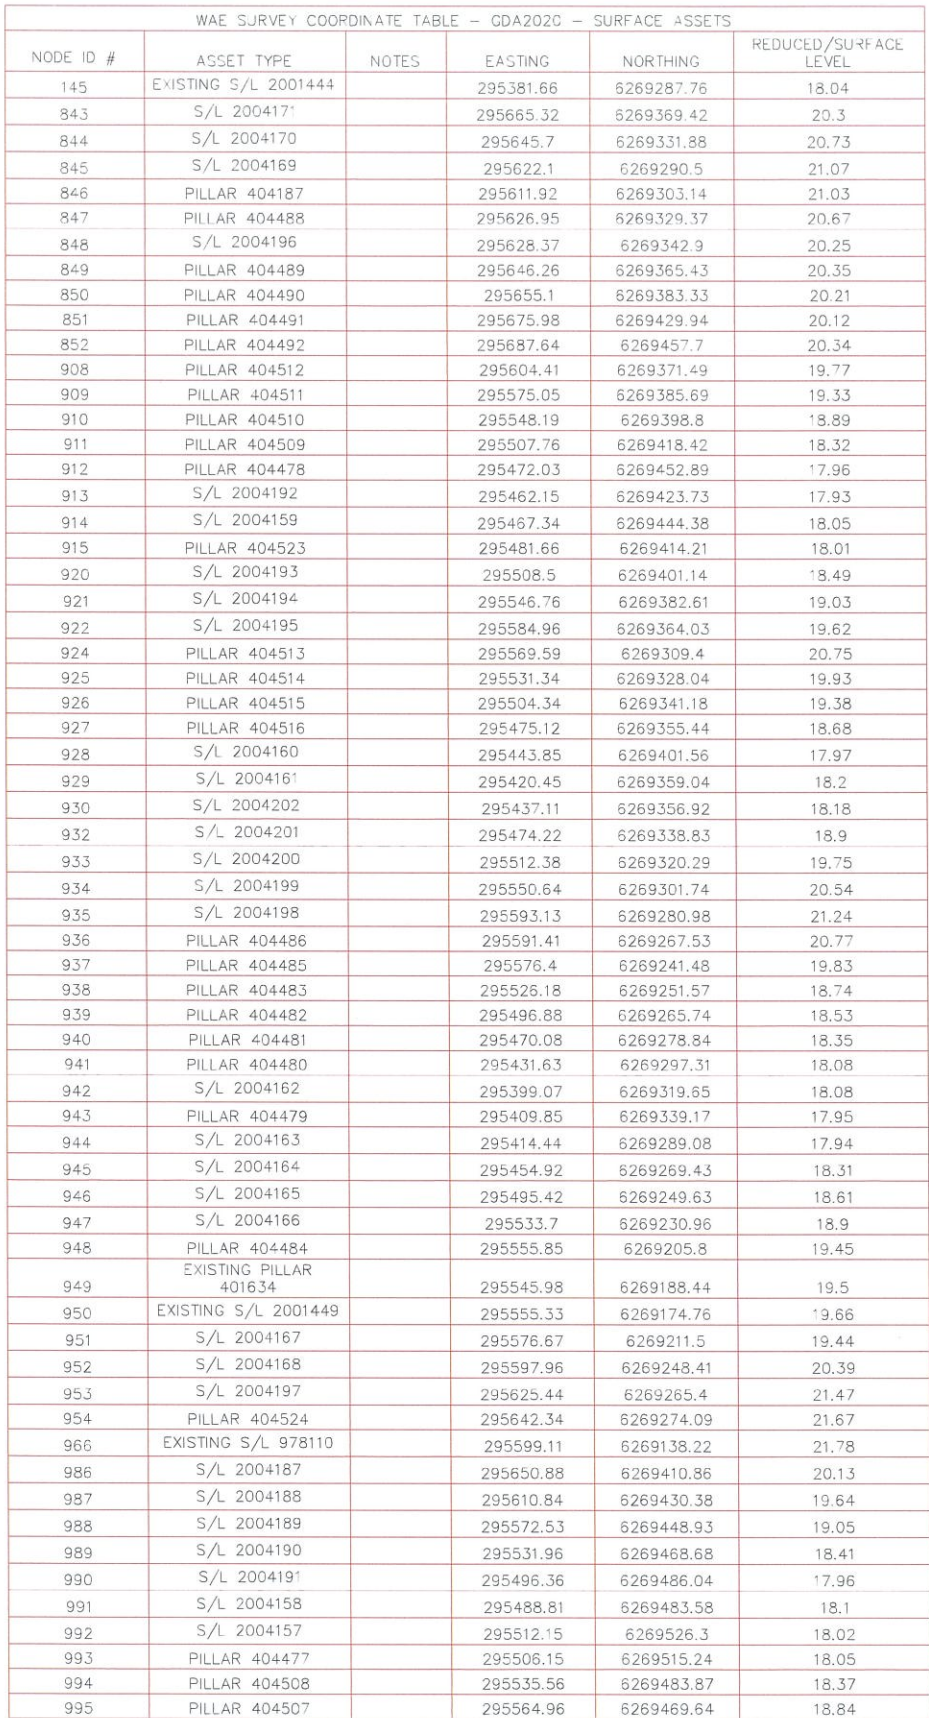

996	PILLAR 404506	295603.09	6269451.07	19.42
997	PILLAR 404505	295632.24	6269436.79	19.86
998	S/L 2004184	295687.82	6269471.92	20.11
999	S/L 2004183	295647.71	6269491.36	19.59
1000	S/L 2004182	295607.13	6269511.13	19.03
1001	S/L 2004181	295569.01	6269529.73	18.54
1002	S/L 2004180	295531.24	6269548	18.13
1003	S/L 2004156	295540.4	6269568.02	18.28
1004	PILLAR 404499	295574.88	6269543.75	18.51
1005	PILLAR 404500	295601.93	6269530.58	18.87
1006	PILLAR 404501	295633.34	6269515.36	19.29
1007	PILLAR 404502	295669.22	6269497.83	19.75
1103	EXISTING PILLAR 168278	295627.2	6269148.9	21.82
1104	S/L 2004176	295701.03	6269561.34	20.09
1105	S/L 2004177	295678	6269578.47	19.22
1106	S/L 2004178	295648.16	6269587.06	19.05
1107	S/L 2004179	295609.85	6269605.69	18.14
1108	PILLAR 404476	295546.76	6269574.75	18.19
1109	S/L 2004155	295573.81	6269600.79	18
1110	PILLAR 404198	295599.2	6269593.86	18.07
1111	PILLAR 404497	295626.21	6269580.81	18.71
1112	PILLAR 404196	295666.79	6269560.99	19.48
1113	PILLAR 404195	295693.83	6269547.9	20.07
1114	S/L 2004175	295736.1	6269533.71	20.99
1115	PILLAR 404194	295715.19	6269523.31	20.76
1116	PILLAR 404193	295703.57	6269495.52	20.6
1117	S/L 2004174	295719.72	6269494.58	20.64
1118	S/L 2004173	295703.17	6269455.34	20.33
1119	S/L 2004172	295686.77	6269416.49	20.16
1120	S/L 2004186	295683.41	6269395.04	20.53
1121	PILLAR 404504	295705.13	6269401.43	20.69
1122	PILLAR 404503	295708.43	6269382.83	20.79
1123	S/L 2004185	295723.73	6269375.29	21
1124	S/L 2004211	295726.45	6269368.2	21.33
1126	S/L 2004210	295705.27	6269324.89	21.54
1127	PILLAR 404519	295716.67	6269305.22	21.5
1128	PILLAR 404520	295737.03	6269345.33	21.59
1129	PILLAR 404521	295754.52	6269384.05	21.37
1130	S/L 2004212	295746.89	6269415.42	21.46
1131	S/L 2004213	295763.22	6269454.47	21.37
1132	PILLAR 404522	295754.6	6269433.76	21.3
1133	PILLAR 404518	295702.08	6269278.98	21.69
1134	S/L 2004207	295695.33	6269256.29	22.13
1135	S/L 2004206	295683.35	6269230.81	22.09
1136	S/L 2004208	295667.33	6269269.61	22.04
1137	S/L 2004205	295651.98	6269243.2	21.85
1138	S/L 2004204	295641.3	6269211.87	21.67
1139	PILLAR 404517	295630.09	6269192.44	21.67
1140	S/L 2004203	295620.09	6269175.03	21.78
1141	S/L 2004209	295684.87	6269287.6	21.73

WORK COMPLETED / FIELD BOOK	
CONSTRUCTED BY	<u>C.J. DOYLE CONTRACTING</u>
WORK'S COMPLETED	<u>CHRIS JOWETT</u>
SIGNATURE	<u>C. JOWETT</u> DATE <u>18/03/25</u>
INSPECTED BY	<u>GAV NIXON</u>
SIGNATURE	 DATE
ASSET RECORDING	
OF	<u>STEVE FRIDAY</u>
CONTRACTING	<u>C. J. DOYLE CONTRACTING</u>
CONTACT No	<u>8734-1922</u>
HEREBY CERTIFY THAT ASSETS MARKED AS-BUILT ON THIS DRAWING HAVE BEEN RECORDED AS PER ENDEAVOUR ENERGY STANDARD SMD 004	
SIGNATURE	<u>STEVE FRIDAY</u> DATE <u>18/03/2025</u>