


These plans are referred to in certificate no. 16635 approved by:
Christopher Louis Wahbe
 Registered Certifier
 Registration No: BDC 3015
 Categories: Certifier - Subdivision
Land Development Certificates
 www.LDC.com.au

I hereby certify that engineering works shown on this plan have been constructed generally in accordance with Construction Certificate 16635 issued by Land Development Certificates

Signature: 
PETER ROBERT WARWICK
 Registered Land Surveyor
VINCE MORGAN SURVEYORS PTY LTD
 DATE 20/12/2022 REF 20260-7


LEGEND

- CATCHMENT BOUNDARY: - - - - -
- EXISTING CATCHMENT BOUNDARY: - - - - -
- FLOW DIRECTION ARROW: →
- EXISTING CONTOURS: — 47.0 —
- DESIGN CONTOURS: - · - · - 47.0 - · - · -
- DRAINAGE LINE & PIT: — [Symbol] —
- EXISTING DRAINAGE LINE & PIT: - - - [Symbol] - - -
- FUTURE DRAINAGE LINE & PIT: - - - [Symbol] - - -



SYSTEM "C" CATCHMENT BOUNDARIES/LABELS ADDED

REFER TO DRAWING CC5403 FOR CONTINUATION

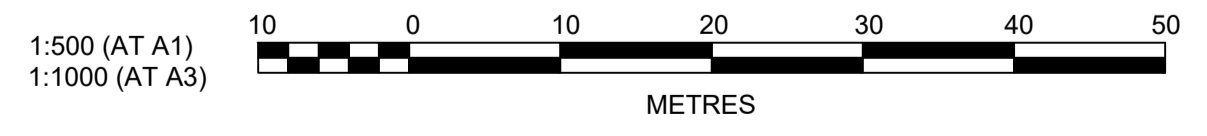

Plotted: 14 September, 2021 12:49:17 PM File Name: J:\985D\CC - Construction Certificate Approval Plans\PK12 WESTERN PRECINCTS15 - Preprint\7B\985-12-CC5404.dwg

AMENDMENT	DES	DRN	CKD	APR	DATE
B	DG	VS	MP	MS	14/09/21
A	DG	VS	MP	PJM	12/08/21

J. WYNDHAM PRINCE
 CONSULTING CIVIL INFRASTRUCTURE ENGINEERS & PROJECT MANAGERS
 PO Box 4366 PENRITH WESTFIELD NSW 2750
 P 02 4720 3300 W www.jwprince.com.au E jwp@jwprince.com.au

CLIENT:  **WINTAN PROPERTY GROUP**

STATUS: **ISSUE FOR CONSTRUCTION APPROVAL**
 THIS DRAWING MUST NOT BE USED FOR CONSTRUCTION UNLESS SIGNED AS PART OF AN APPROVED CONSTRUCTION CERTIFICATE.

NEWPARK PRECINCT 7, STAGE 7B
 CATCHMENT PLAN SHEET 4
 AZIMUTH: M.G.A.94 DATUM: A.H.D. ORIGIN: SSM 1112 PLAN No: 985-12-CC5404

PROJECT No: **9985-12**
 SHEET No: **CC5404**
 B

PIT SCHEDULE					
PIT NAME (-)	SURFACE FITTING TYPE AND SIZE (-)	PIT EASTING (m)	PIT NORTHING (m)	PIT DEPTH (m)	COMMENTS
A04/5	1.8 m lintel	295107.04	6268940.56	1.64	PIT CONSTRUCTION ONLY
A04/6	1.8 m lintel	295098.73	6268949.84	1.74	PIT CONSTRUCTION ONLY
A04/7	2.4 m lintel sag	295095.23	6268969.42	1.82	
A04/8	1.8 m lintel	295081.04	6268975.92	2.22	
A04/8A	Headwall	295050.23	6268964.14		TEMPORARY HEADWALL
A04/9	1.8 m lintel	295040.85	6268960.23	2.43	FUTURE PIT
A37/1	2.4 m lintel sag	295103.63	6268972.65	1.41	
B02/1	1.8 m lintel	295406.65	6269063.33	1.45	
B02/2	2.4 m lintel sag	295400.3	6269051.27	1.57	
B02/3	2.4 m lintel sag	295392.26	6269055.33	1.72	
B02/4	1.8 m lintel	295380.22	6269029.14	2.2	
B02/5	1.8 m lintel	295365.92	6269023.7	2.01	
B02/6	1.8 m lintel	295343.8	6269031.98	1.99	
B02/7	1.8 m lintel	295322.41	6269039.99	1.99	
B02/8	2.4 m lintel sag	295297.76	6269050.29	1.99	SPECIAL PIT CC5550
B02/9	2.4 m lintel sag	295285.75	6269048.69	2.08	SPECIAL PIT CC5550
B02/10	1.8 m lintel	295271.72	6269051.71	2.37	SPECIAL PIT CC5550
B02/11	2.4 m lintel sag	295258.01	6269045.46	2.42	SPECIAL PIT CC5550
B02/12	1.8 m lintel	295213.67	6269027.95	2.75	SPECIAL PIT CC5550
B02/13	1.8 m lintel	295204.66	6269034.08	2.85	SPECIAL PIT CC5551
B02/14	1.8 m lintel	295171.93	6269021.24	2.83	SPECIAL PIT CC5551
B02/15	1.8 m lintel	295158.16	6269028.08	2.63	SPECIAL PIT CC5552
B02/16	1.8 m lintel	295150.77	6269046.9	2.61	SPECIAL PIT CC5552
B02/17	2.4 m lintel sag	295143.37	6269065.77	2.67	SPECIAL PIT CC5553
B02/18	1.8 m lintel	295148.89	6269078.8	2.87	SPECIAL PIT CC5553
B02/19	1.8 m lintel	295173.26	6269088.36	3.26	SPECIAL PIT CC5554
B03/17	1.8 m lintel	295246.61	6268913.72	2.64	SPECIAL PIT CC5554
B03/18	1.8 m lintel	295252.53	6268953.85	2.61	SPECIAL PIT CC5555
B03/19	2.4 m lintel	295244.16	6268963.03	2.64	SPECIAL PIT CC5555
B03/20	1.8 m lintel	295239.84	6268989.5	2.55	SPECIAL PIT CC5555
B03/21	2.4 m lintel sag	295227.4	6269021.34	2.49	SPECIAL PIT CC5556
B04/1	1.8 m lintel	295463.65	6268933.28	1.82	
B04/2	1.8 m lintel	295445.9	6268935.9	1.9	
B04/3	1.8 m lintel	295415.74	6268940.37	2.02	
B04/4	1.8 m lintel	295366.94	6268947.58	2.2	
B04/5	1.8 m lintel	295314.09	6268955.4	2.01	
B04/6	2.4 m lintel sag	295263.94	6268962.82	1.56	
B04/7	2.4 m lintel sag	295261.44	6268972.29	1.75	SPECIAL PIT CC5556
B04/8	1.8 m lintel	295250.71	6268984.56	2.04	SPECIAL PIT CC5556
B05/1	1.8 m lintel	295446.27	6268977.66	1.38	
B05/2	1.8 m lintel	295456.55	6269004.17	1.51	
B05/3	2.4 m lintel	295472.92	6269036.3	1.66	
B05/4	2.4 m lintel	295489.44	6269065.01	1.79	
B05/5	2.4 m lintel sag	295497.37	6269078.79	1.89	
B05/6	2.4 m lintel sag	295489.88	6269083.82	2.17	SPECIAL PIT CC5556
B05/7	1.8 m lintel	295485.34	6269098.58	2.49	SPECIAL PIT CC5557
B05/8	1.8 m lintel	295484.24	6269109.12	2.72	SPECIAL PIT CC5557
B05/9	1.8 m lintel	295470.3	6269115.9	2.77	
B05/10	1.8 m lintel	295450.91	6269125.32	2.87	
B05/11	1.8 m lintel	295422.04	6269139.36	2.99	
B05/12	1.8 m lintel	295401.25	6269149.46	3.11	
B05/13	1.8 m lintel	295392.25	6269143.83	3.34	
B05/14	1.8 m lintel	295363.57	6269157.77	3.28	SPECIAL PIT CC5557
B05/15	2.4 m lintel sag	295326.62	6269175.74	2.34	SPECIAL PIT CC5557
B08/1	1.8 m lintel	295527.13	6269130.51	1.47	SPECIAL PIT CC5558
B08/2	1.8 m lintel	295525.88	6269146.38	1.59	SPECIAL PIT CC5558
B08/3	1.8 m lintel	295520.85	6269160.26	1.52	SPECIAL PIT CC5558
B08/4	1.8 m lintel	295497.78	6269171.47	1.59	
B08/5	1.8 m lintel	295469.31	6269185.31	1.66	
B08/6	2.4 m lintel	295439.86	6269199.63	1.74	
B08/7	2.4 m lintel	295410.57	6269213.87	1.82	
B08/8	1.8 m lintel	295388.31	6269224.69	1.89	
B08/9	2.4 m lintel sag	295363.45	6269236.77	1.85	SPECIAL PIT CC5558
B08/10	1.8 m lintel	295348.53	6269231.71	2.15	SPECIAL PIT CC5558
B08/11	2.4 m lintel sag	295340.08	6269216.06	2.21	SPECIAL PIT CC5558
B08/12	1.8 m lintel	295329.38	6269196.77	2.48	SPECIAL PIT CC5559
B08/13	1.8 m lintel	295312.08	6269172.21	2.75	SPECIAL PIT CC5559
B08/14	1.8 m lintel	295290.22	6269149.17	2.66	SPECIAL PIT CC5559
B08/15	2.4 m lintel sag	295280.52	6269140.88	2.62	SPECIAL PIT CC5560
B08/16	1.8 m lintel	295265.37	6269129.77	2.84	SPECIAL PIT CC5560
B08/17	2.4 m lintel sag	295217.02	6269105.53	3.05	SPECIAL PIT CC5560
B08/18	1.8 m lintel	295182.65	6269092.05	3.42	SPECIAL PIT CC5561
B08/19	1.8 m lintel	295174.96	6269098.7	3.48	SPLITTER/SPECIAL PIT CC5561
B08/20	NODE	295172.76	6269104.3	3.64	FUTURE GPT INLET
B08/21	GPT	295174.34	6269106.63	3.61	FUTURE GPT VORTEX
B08/22	NODE	295171.61	6269107.23	3.58	FUTURE GPT OUTLET
B08/23	JP SEALED 900 x 900	295170.05	6269111.23	2.99	SPLITTER PIT - TEMPORARY HEADWALL
B10/1	1.8 m lintel	295330.51	6269102.02	1.45	
B10/2	1.8 m lintel	295334.29	6269093.34	1.62	
B10/3	2.4 m lintel sag	295317.87	6269080	1.73	
B10/4	1.8 m lintel	295299.61	6269067.33	2.17	
B11/1	2.4 m lintel sag	295364.54	6269280.29	1.44	
B11/2	2.4 m lintel sag	295372.46	6269276.01	1.58	
B19/14	2.4 m lintel sag	295161.28	6268995.47	1.75	LINTEL CONSTRUCTION ONLY
B19/15	2.4 m lintel sag	295169.66	6268998.74	1.98	LINTEL CONSTRUCTION ONLY
B19/16	1.8 m lintel	295175.17	6269012.85	2.38	
B20/1	2.4 m lintel sag	295135.48	6269061.23	1.44	
B26/1	2.4 m lintel	295430.02	6268893.54	1.45	
B26/2	1.8 m lintel	295420.6	6268888	1.68	SPECIAL PIT CC5562
B31/1	1.8 m lintel	295448.88	6268944.56	1.45	
B32/1	1.8 m lintel	295377.03	6268955.19	1.46	

PIT SCHEDULE					
PIT NAME (-)	SURFACE FITTING TYPE AND SIZE (-)	PIT EASTING (m)	PIT NORTHING (m)	PIT DEPTH (m)	COMMENTS
B37/1	2.4 m lintel	295237.64	6268914.58	1.44	
B39/1	1.8 m lintel	295142.41	6269043.58	1.45	
B43/1	2.4 m lintel sag	295312.3	6269087.07	1.43	
B44/1	2.4 m lintel sag	295274.96	6269147.96	1.43	
B45/1	2.4 m lintel sag	295332.16	6269220.34	1.44	
B46/1	2.4 m lintel sag	295254.68	6269053.82	1.44	
B48/1	1.8 m lintel	295269.73	6269060.76	1.45	
B49/1	1.8 m lintel	29518.33	6269092.55	1.45	
B49/2	1.8 m lintel	295512.78	6269085.24	1.65	
B50/1	1.8 m lintel	295447.97	6269116.74	1.45	
B51/1	2.4 m lintel sag	295213.73	6269113.91	1.44	
B55/1	2.4 m lintel sag	295333.28	6269182.5	1.45	
B56/1	1.8 m lintel	295463.56	6269038.07	1.45	
B58/1	1.8 m lintel	295374.67	6268986.72	1.47	
B58/2	2.4 m lintel sag	295378.6	6268999.21	1.5	
B58/3	1.8 m lintel	295370.25	6269002.61	1.72	
B58/4	1.8 m lintel	295362.77	6269015.27	1.7	
B59/1	1.8 m lintel	295343.19	6269022.6	1.45	
B60/1	1.8 m lintel	295321.71	6269030.65	1.45	
B61/1	1.8 m lintel	295147.11	6269001.84	1.45	
B61/2	1.8 m lintel	295144.62	6269010.53	1.67	
B61/3	1.8 m lintel	295149.76	6269024.83	1.54	
B67/1	1.8 m lintel	295506.32	6269177.33	1.46	
B68/1	2.4 m lintel	295475.98	6269192.08	1.44	
B69/1	1.8 m lintel	295448.71	6269205.33	1.46	
B70/1	2.4 m lintel	295417.52	6269220.49	1.45	
B71/1	1.8 m lintel	295395.15	6269231.37	1.45	
B72/1	2.4 m lintel sag	295375.87	6269138.66	1.44	
B72/2	2.4 m lintel sag	295367.81	6269142.9	1.68	SPECIAL PIT CC5562
B73/1	1.8 m lintel	295424.51	6269094.53	1.63	
B73/2	2.4 m lintel sag	295433.86	6269110.78	1.74	
B73/3	2.4 m lintel sag	295425.79	6269114.8	1.98	SPECIAL PIT CC5562
B73/4	1.8 m lintel	295421.83	6269129.45	2.36	SPECIAL PIT CC5562
B75/1	1.8 m lintel	295243.4	6269005.19	1.52	
B75/2	2.4 m lintel sag	295235.87	6269024.39	1.64	
B76/1	2.4 m lintel	295374.37	6269162.53	1.46	
B77/1	2.4 m lintel sag	295368.41	6269244.37	1.44	
B78/1	2.4 m lintel sag	295144.23	6269086.64	1.44	
B99/1	NODE	295173.49	6269098.19	3.62	SPLITTER PIT INTERNAL WEIR
B99/2	JP SEALED 900 x 900	295163.73	6269101.5	3.56	
B99/2	JP SEALED 900 x 900	295163.73	6269101.5	3.56	TEMPORARY HEADWALL
C01/1	1.8 m lintel	295542.61	6269157.41	1.52	
C01/2	1.8 m lintel	295553.93	6269177.09	1.62	
C01/3	2.4 m lintel sag	295569.59	6269204.31	1.78	TEMPORARY HEADWALL
BAB/1	IAD 600x900			0.75	
BAB/2	IAD 600x900			0.82	
BAB/3	IAD 600x900			0.89	
BAB/4	IAD 600x900			0.97	
BAB/5	IAD 600x900			1	
BAB/6	IAD 600x900			1.04	
BAB/7	IAD 900x900			1.54	
BAC/1	IAD 600x900			0.77	
BAC/2	IAD 600x900			0.77	
BAC/3	IAD 600x900			0.77	
BAC/4	IAD 600x900			0.84	
BAC/5	IAD 900x900			1.54	
BE/1	IAD 600x900			0.76	
BE/2	IAD 600x900			0.84	
BE/3	IAD 600x900			0.86	
BE/4	IAD 600x900			0.89	
BE/5	IAD 600x900			0.93	
BE/6	IAD 900x900			1.54	
BJ/1	IAD 600x900			0.75	
BJ/2	IAD 600x900			0.87	
BJ/3	IAD 600x900			0.99	
BJ/4	IAD 600x900			1.1	
BJ/5	IAD 600x900			1.28	
BJ/6	IAD 600x900			1.44	
BJ/7	IAD 900x900			1.61	
BJ/8	IAD 900x900			1.8	
BJ/9	IAD 900x900			2.01	
BK/1	IAD 600x900			0.76	
BK/2	IAD 600x900			0.77	
BK/3	IAD 600x900			0.84	
BK/4	IAD 900x900			1.54	
BL/1	IAD 600x900			0.75	
BL/2	IAD 600x900			0.9	
BL/3	IAD 600x900			1.01	
BL/4	IAD 600x900			1.09	
BL/5	IAD 600x900			1.16	
BL/6	IAD 600x900			1.25	
BL/7	IAD 600x900			1.43	
BL/8	IAD 900x900			1.48	
BL/9	IAD 600x900			1.27	
BL/10	IAD 900x900			1.54	
BM/1	IAD 600x900			0.76	
BM/2	IAD 600x900			0.77	
BM/3	IAD 600x900			0.85	
BM/4	IAD 900x900			1.54	
BN/1	IAD 600x900			0.76	
BN/2	IAD 600x900			0.84	

PIT SCHEDULE					
PIT NAME (-)	SURFACE FITTING TYPE AND SIZE (-)	PIT EASTING (m)	PIT NORTHING (m)	PIT DEPTH (m)	COMMENTS
BN/3	IAD 600x900			0.94	
BN/4	IAD 600x900			1.01	
BN/5	IAD 600x900			1.15	
BN/6	IAD 600x900			1.32	
BN/7	IAD 900x				

I hereby certify that engineering works shown on this plan have been constructed generally in accordance with Construction Certificate 16635 issued by Land Development Certificates

Signature.....
PETER ROBERT WARWICK
 Registered Land Surveyor
VINCE MORGAN SURVEYORS PTY LTD

DATE 20/12/2022 REF 20260-737/1

DESIGN STORM 10% AEP HYDROLOGIC RESULTS

PIT NAME	PIT TYPE	CATCHMENT AREA (Ha)	PERCENT IMPERVIOUS (%)	Tc IMP (min)	Tc PERV (min)	CRITICAL STORM (min)	APPROACH FLOW (L/s)	CAPTURED FLOW (L/s)	UNCAPTURED FLOW (L/s)	GRATE DEPTH (mm)	ROAD GRADE (%)	ROAD CROSSFALL (%)	BYPASS PIT	FLOW AT BYPASS PIT (L/s)	FLOW WIDTH AT BYPASS PIT (m)	VxD AT BYPASS PIT (m/s^2)	COMMENTS
A04/6	1.8 m lintel	0.029	95	5	5	15	10	10	0	61	1.1	3	A04/7	18	1.18	0.04	
A04/7	2.4 m lintel sag	0.071	85	5	5	18	18	18	0	31	0.7	2.9	A04/8	0	1.12	0	
A04/8	1.8 m lintel	0.004	95	5	5	5	1	1	0	60	0.2	4	A04/9	13	1.27	0.03	
A04/9	1.8 m lintel	0.035	95	5	5	25	13	13	0	64	0.7	3	A65/1	27	1.57	0.05	
A04/9	2.4 m lintel sag	0.16	85	5	5	15	63	63	0	66	0.5	3	A04/7	0			
B02/1	1.8 m lintel	0.082	85	5	5	25	27	26	1	99	1	3	B02/2	60	2.43	0.06	
B02/2	2.4 m lintel sag	0.16	85	5	5	15	60	60	0	76	0.1	3	B58/2	0	0	0	
B02/3	2.4 m lintel sag	0.2	85	5	5	5	25	25	0	37	0.5	3	B02/4	0	0.42	0	
B02/4	1.8 m lintel	0				15	0	0	0	36	0.5	3	B02/5	6	1.83	0.01	
B02/5	1.8 m lintel	0.017	95	5	5	25	6	6	0	81	0.9	3	B02/6	37	1.83	0.05	
B02/6	1.8 m lintel	0.1	85	5	5	15	37	33	4	78	0.7	3	B02/7	33	1.74	0.05	
B02/7	1.8 m lintel	0.079	85	5	5	15	33	30	3	72	0.7	3	B02/8	25	1.54	0.04	
B02/8	2.4 m lintel sag	0.121	85	5	5	15	45	45	0	60	0.4	2.8	B02/9	0			SPECIAL PIT
B02/9	2.4 m lintel sag	0.166	85	5	5	5	52	52	0	57	0.7	3	B02/10	0	1.93	0	SPECIAL PIT
B02/10	1.8 m lintel	0.005	95	5	5	15	1	1	0	86	1	3	B02/11	41	2	0.05	SPECIAL PIT
B02/11	2.4 m lintel sag	0.111	85	5	5	15	38	38	0	57	0.1	3	B75/2	0	0	0	SPECIAL PIT
B02/12	1.8 m lintel	0				25	0	0	0	77	0.7	4.3	B19/16	35	1.7	0.05	SPECIAL PIT
B02/13	1.8 m lintel	0.078	85	5	5	25	7	7	0	82	0.7	3	B02/14	39	1.87	0.06	SPECIAL PIT
B02/14	1.8 m lintel	0.111	85	5	5	15	39	35	5	39	0.7	3	B02/15	7	0.84	0.03	SPECIAL PIT
B02/15	1.8 m lintel	0.018	95	5	5	15	7	7	0	51	0.9	3	B02/16	8	1.51	0.02	SPECIAL PIT
B02/16	1.8 m lintel	0.058	85	5	5	15	8	8	0	72	0.7	3	B02/17	19	1.46	0.04	SPECIAL PIT
B02/17	2.4 m lintel sag	0.076	85	5	5	15	19	19	0	41	0.3	1.8	B02/18	0	0	0	SPECIAL PIT
B02/18	1.8 m lintel	0.076	85	5	5	15	18	17	1	46	0.5	2.7	B78/1	1	0.28	0	SPECIAL PIT
B02/19	1.8 m lintel	0.035	95	5	5	15	13	13	0	64	0.6	3	B02/18	18	1.26	0.04	SPECIAL PIT
B03/15	1.8 m lintel	0.005	95	5	5	15	1	1	0	79	0.7	3	B03/16	37	1.75	0.05	
B03/16	1.8 m lintel	0.101	85	5	5	15	34	32	2	57	0.7	3	B65/1	19	1.19	0.05	
B03/17	1.8 m lintel	0.004	95	5	5	15	1	1	0	79	0.7	3	B03/18	37	1.74	0.05	SPECIAL PIT
B03/18	1.8 m lintel	0.101	85	5	5	15	33	32	2	51	0.7	3	B04/6	11	0.82	0.03	SPECIAL PIT
B03/19	2.4 m lintel	0.156	85	5	5	15	58	53	5	83	0.7	3	B03/20	41	2.05	0.05	SPECIAL PIT
B03/20	1.8 m lintel	0.101	85	5	5	15	41	36	5	88	0.7	3	B03/21	44	2.05	0.06	SPECIAL PIT
B03/21	2.4 m lintel sag	0.134	85	5	5	5	50	50	0	54	0.4	2	B02/12	0	1.37	0.01	SPECIAL PIT
B04/1	1.8 m lintel	0.04	95	5	5	15	15	15	0	44	0.7	3	B04/2	5	1.85	0.01	
B04/2	1.8 m lintel	0.015	95	5	5	15	5	5	0	82	0.7	3	B26/1	53	2.17	0.06	
B04/3	1.8 m lintel	0.003	95	5	5	15	1	1	0	61	0.7	3	B04/4	14	1.17	0.03	
B04/4	1.8 m lintel	0.039	95	5	5	15	14	14	0	56	0.7	3	B04/5	15	1.16	0.04	
B04/5	1.8 m lintel	0.042	95	5	5	15	15	15	0	61	2.7	3	B04/6	28	1.16	0.07	
B04/6	2.4 m lintel sag	0.102	85	5	5	5	39	39	0	51	1.5	3.4	B04/7	0			
B04/7	2.4 m lintel sag	0.132	85	5	5	5	46	46	0	53	0.8	2.8	B04/8	0	1.34	0	SPECIAL PIT
B04/8	1.8 m lintel	0.006	95	5	5	15	1	1	0	74	0.7	3	B75/1	28	1.59	0.05	SPECIAL PIT
B05/1	1.8 m lintel	0.036	95	5	5	15	14	14	0	77	0.7	3	B05/2	31	2.01	0.04	
B05/2	1.8 m lintel	0.085	85	5	5	25	31	29	2	87	0.7	3	B05/3	47	2.01	0.06	
B05/3	2.4 m lintel	0.123	85	5	5	25	47	45	2	86	0.7	3	B05/4	46	2	0.06	
B05/4	2.4 m lintel	0.12	85	5	5	25	46	45	1	61	0.7	3	B05/5	14	1.17	0.03	
B05/5	2.4 m lintel sag	0.079	85	5	5	5	30	30	0	44	1.3	2.9	B05/6	0			
B05/6	2.4 m lintel sag	0.059	95	5	5	5	31	31	0	42	0.4	2.3	B05/7	0	0.49	1.46	SPECIAL PIT
B05/7	1.8 m lintel	0.005	95	5	5	15	0	0	0	41	0.7	3.7	B50/1	5	0.73	0.02	SPECIAL PIT
B05/8	1.8 m lintel	0.01	95	5	5	15	4	4	0	63	1.1	3	B05/9	18	1.58	0.03	SPECIAL PIT
B05/9	1.8 m lintel	0.047	85	5	5	25	18	18	0	74	0.7	3	B05/10	27	1.95	0.04	
B05/10	1.8 m lintel	0.073	85	5	5	25	27	26	1	85	0.7	3	B05/11	43	1.95	0.06	
B05/11	1.8 m lintel	0.115	85	5	5	15	43	40	4	77	0.7	3	B05/12	31	1.92	0.04	
B05/12	1.8 m lintel	0.074	85	5	5	25	31	28	2	84	0.7	3	B76/1	44	1.92	0.06	
B05/13	1.8 m lintel	0.082	85	5	5	25	30	29	1	66	0.7	3	B72/1	30	1.31	0.06	
B05/14	1.8 m lintel	0.007	95	5	5	25	3	3	0	69	1.7	3	B05/15	45	1.43	0.09	SPECIAL PIT
B05/15	2.4 m lintel sag	0.121	85	5	5	15	45	45	0	56	1.6	2.8	B55/1	0	0	0	SPECIAL PIT
B08/1	1.8 m lintel	0.041	95	5	5	5	15	15	0	0	0.7	3	LOST	0	0	0	SPECIAL PIT
B08/2	1.8 m lintel	0.138	85	5	5	15	51	46	5	48	0.7	3	B08/3	13	1.36	0.03	SPECIAL PIT
B08/3	1.8 m lintel	0.02	95	5	5	15	13	13	0	67	1.1	3	B08/4	21	1.81	0.03	SPECIAL PIT
B08/4	1.8 m lintel	0.058	85	5	5	25	21	21	0	80	0.9	3	B08/5	40	1.94	0.05	
B08/5	1.8 m lintel	0.108	85	5	5	25	40	35	5	84	0.9	3	B08/6	47	1.94	0.06	
B08/6	2.4 m lintel	0.115	85	5	5	25	47	45	2	83	0.9	3	B08/7	45	1.9	0.06	
B08/7	2.4 m lintel	0.116	85	5	5	15	45	44	1	74	0.9	3	B08/8	31	1.6	0.05	
B08/8	1.8 m lintel	0.082	85	5	5	15	31	29	1	69	0.9	3	B08/9	23	1.42	0.04	
B08/9	2.4 m lintel sag	0.113	85	5	5	15	40	40	0	55	0.5	2.7	B77/1	0			SPECIAL PIT
B08/10	1.8 m lintel	0.003	95	5	5	25	1	1	0	64	0.7	3.5	B08/9	19	1.25	0.04	SPECIAL PIT
B08/11	2.4 m lintel sag	0.149	85	5	5	5	53	53	0	57	0.2	3	B08/10	0	1.15	0	SPECIAL PIT
B08/12	1.8 m lintel	0.007	95	5	5	25	1	1	0	94	0.7	3.9	B08/11	55	2.26	0.06	SPECIAL PIT
B08/13	1.8 m lintel	0.005	95	5	5	15	2	2	0	77	0.7	3	B08/14	30	1.68	0.05	SPECIAL PIT
B08/14	1.8 m lintel	0.082	85	5	5	25	30	29	1	73	0.7	3	B08/15	28	1.55	0.05	SPECIAL PIT
B08/15	2.4 m lintel sag	0.169	85	5	5	5	63	63	0	62	0.6	3.9	B44/1	0			SPECIAL PIT
B08/16	1.8 m lintel	0.075	85	5	5	25	7	7	0	78	1	3	B08/15	35	1.74	0.05	SPECIAL PIT
B08/17	2.4 m lintel sag	0.227	85	5	5	15	85	85	0	83	0.1	3	B08/16	0	0	0	SPECIAL PIT
B08/18	1.8 m lintel	0				25	0	0	0	108	-0.2	3	B08/17	47			SPECIAL PIT
B08/19	1.8 m lintel	0.002	95	5	5	5	5	5	0	0	0.7	3	B99/1	0	0.27	0.03	SPLITTER/SPECIAL PIT
B08/20	NODE																GPT INLET
B08/21	GPT																GPT VORTEX
B08/22	NODE																GPT OUTLET
B08/23	JP SEALED 900 x 900																SPLITTER PIT
B08/24	JP SEALED 900 x 900																
B10/1	1.8 m lintel	0.09	85	5	5	25	12	12	0	98	1	3	B43/1	73	2.38	0.08	
B10/2	1.8 m lintel	0.111	85	5	5	25	14	14	0	87	1	3	B10/3	48	2.02	0.06	
B10/3	2.4 m lintel sag	0.133	85	5	5	5	51	51	0	56	0.6	3.8	B10/4	0	1.39	0.01	

DRAINAGE TABLE UPDATED

These plans are referred to in certificate no. 16635 approved by:
Christopher Louis Wahbe
 Registered Certifier
 Registration No: BDC 3015
 Categories: Certifier - Subdivision
Land Development Certificates
 www.LDC.com.au

Plotfile: 14 September, 2021 12:50:02 PM File Name: J:\9985D\CC - Construction Certificate Approval Plans\PK12 WESTERN PRECINCTS 5 - Precinct 7\B0985-12-CC5411.dwg

B	DRAINAGE TABLE UPDATED	DG	VS	MP	MS	14/09/21
A	ISSUE FOR APPROVAL	DG	VS	MP	PJM	12/08/21
	AMENDMENT	DES	DRN	CKD	APR	DATE

J. WYNDHAM PRINCE
 CONSULTING CIVIL INFRASTRUCTURE ENGINEERS & PROJECT MANAGERS
 PO Box 4366 PENRITH WESTFIELD NSW 2750
 P 02 4720 3300 W www.jwprince.com.au E jwp@jwprince.com.au

CLIENT:
WINTEN PROPERTY GROUP

STATUS:
ISSUE FOR CONSTRUCTION APPROVAL
 THIS DRAWING MUST NOT BE USED FOR CONSTRUCTION UNLESS SIGNED AS PART OF AN APPROVED CONSTRUCTION CERTIFICATE.

Plotfile: 14 September, 2021 12:50:20 PM File Name: J:\9985D\CC - Construction Certificate Approval Plans\PK12 WESTERN PRECINCTS\5 - Precinct 7\B9985-12-CC5412.dwg

DESIGN STORM 10% AEP HYDROLOGIC RESULTS																	
PIT NAME	PIT TYPE	CATCHMENT AREA (Ha)	PERCENT IMPERVIOUS (%)	Tc IMP (min)	Tc PERV (min)	CRITICAL STORM (min)	APPROACH FLOW (L/s)	CAPTURED FLOW (L/s)	UNCAPTURED FLOW (L/s)	GRATE DEPTH (mm)	ROAD GRADE (%)	ROAD CROSSFALL (%)	BYPASS PIT (-)	FLOW AT BYPASS PIT (L/s)	FLOW WIDTH AT BYPASS PIT (m)	VxD AT BYPASS PIT (m/s ²)	COMMENTS
B10/4	1.8 m lintel	0.003	95	5	5	15	1	1	0	68	0.7	2.9	B02/8	22	1.39	0.04	
B11/1	2.4 m lintel sag	0.035	95	5	5	5	4	4	0	11	0.1	3	LOST	0			
B11/2	2.4 m lintel sag	0.113	85	5	5	5	21	21	0	34	0.1	3	B11/1	0	0	0	
B19/12	2.4 m lintel	0.05	85	5	5	25	20	20	0	60	1.7	3	B19/13	21	1.3	0.04	
B19/13	1.8 m lintel	0.057	85	5	5	15	21	21	0	65	1.7	3	B19/14	28	1.3	0.06	
B19/14	2.4 m lintel sag	0.128	85	5	5	15	51	51	0	59	0.8	3.1	B19/15	0			
B19/15	2.4 m lintel sag	0.124	85	5	5	5	43	43	0	53	0.8	4	B02/15	0	0	0	
B19/16	1.8 m lintel	0.094	85	5	5	15	29	28	1	58	0.7	3	B19/15	15	1.06	0.04	
B20/1	2.4 m lintel sag	0.078	85	5	5	15	29	29	0	47	0.9	2.9	B02/17	0			
B26/1	2.4 m lintel	0.143	85	5	5	15	53	51	2	91	0.7	3	B06/2	52	2.17	0.06	
B26/2	1.8 m lintel	0.049	95	5	5	15	18	18	0	38	0.7	3	B06/5	7	0.76	0.03	SPECIAL PIT
B31/1	1.8 m lintel	0.046	95	5	5	15	18	18	0	53	0.7	3	B05/1	14	1.69	0.02	
B32/1	1.8 m lintel	0.039	95	5	5	15	15	15	0	45	0.7	3	B58/1	13	0.63	0.05	
B37/1	2.4 m lintel	0.108	85	5	5	15	44	42	2	92	0.7	3	B03/19	58	2.2	0.07	
B39/1	1.8 m lintel	0.057	85	5	5	15	21	21	0	63	0.8	3	B20/1	16	1.23	0.04	
B43/1	2.4 m lintel sag	0.201	85	5	5	25	73	73	0	74	0.7	3.9	B48/1	0	0	0	
B44/1	2.4 m lintel sag	0.045	95	5	5	5	7	6	0	15	0.6	3.8	LOST	0			
B45/1	2.4 m lintel sag	0.032	95	5	5	5	12	12	0	32	0.2	3	B11/1	0	0	0	
B46/1	2.4 m lintel sag	0.182	85	5	5	15	66	66	0	75	0.1	3	B02/13	0	0	0	
B48/1	1.8 m lintel	0.049	85	5	5	25	5	5	0	99	1	3	B46/1	66	2.43	0.07	
B49/1	1.8 m lintel	0.048	95	5	5	15	18	18	0	54	1.8	3	B08/1	15	0.91	0.04	
B49/2	1.8 m lintel	0.062	85	5	5	15	23	22	0	50	1.8	3	B05/5	16	0.79	0.05	
B50/1	1.8 m lintel	0.033	95	5	5	15	5	5	0	48	0.7	3	B73/2	12	0.73	0.04	
B51/1	2.4 m lintel sag	0.031	95	5	5	25	12	12	0	33	0.1	3	B44/1	0	0	0	
B55/1	2.4 m lintel sag	0.119	85	5	5	5	43	43	0	51	1.7	2.6	B08/12	0	2.26	0.01	
B56/1	1.8 m lintel	0.081	95	5	5	25	31	29	2	70	0.7	3	B05/6	21	1.47	0.04	
B58/1	1.8 m lintel	0.036	95	5	5	5	13	13	0	41	2.3	3	B58/2	6	0.5	0.03	
B58/2	2.4 m lintel sag	0.124	85	5	5	5	17	17	0	32	0.2	3	B58/3	0	0	0	
B58/3	1.8 m lintel	0.042	95	5	5	5	13	13	0	39	0.7	3.3	B58/4	6	0.7	0.02	
B58/4	1.8 m lintel	0.019	95	5	5	15	6	6	0	47	0.9	3	B59/1	6	1.67	0.01	
B59/1	1.8 m lintel	0.017	95	5	5	15	6	6	0	76	0.7	3	B60/1	30	2.09	0.04	
B60/1	1.8 m lintel	0.083	85	5	5	25	30	28	2	89	0.7	3	B02/9	49	2.09	0.06	
B61/1	1.8 m lintel	0.105	85	5	5	15	40	37	3	66	1.3	3	B19/14	23	1.33	0.05	
B61/2	1.8 m lintel	0.049	95	5	5	15	18	18	0	38	1	3	B61/3	6	1.41	0.01	
B61/3	1.8 m lintel	0.017	95	5	5	15	6	6	0	69	0.9	3	B39/1	21	1.41	0.04	
B65/1	2.4 m lintel sag	0.144	85	5	5	15	55	55	0	62	0.8	2.8	B06/11	0			
B66/1	1.8 m lintel	0.117	85	5	5	15	44	40	4	66	1.5	3	B19/15	28	1.32	0.06	
B67/1	1.8 m lintel	0.066	85	5	5	25	25	24	1	83	0.9	3	B68/1	44	1.88	0.06	
B68/1	2.4 m lintel	0.115	85	5	5	25	44	42	2	81	0.9	3	B69/1	41	1.96	0.05	
B69/1	1.8 m lintel	0.107	85	5	5	15	41	38	3	85	0.9	3	B70/1	49	1.96	0.07	
B70/1	2.4 m lintel	0.124	85	5	5	15	49	47	2	75	0.9	3	B71/1	32	1.69	0.05	
B71/1	1.8 m lintel	0.082	85	5	5	25	32	30	1	77	0.9	3	B77/1	34	1.69	0.05	
B72/1	2.4 m lintel sag	0.079	85	5	5	15	30	30	0	59	0.6	3	B10/2	0	0	0	
B72/2	2.4 m lintel sag	0.065	85	5	5	25	25	25	0	53	0.4	3	B10/1	0	0	0	SPECIAL PIT
B73/1	1.8 m lintel	0.039	85	5	5	15	5	5	0	81	0.7	3	B02/1	30	2.43	0.03	
B73/2	2.4 m lintel sag	0.034	85	5	5	15	15	15	0	37	0.7	2.8	B73/1	0	1.81	0	
B73/3	2.4 m lintel sag	0.112	85	5	5	25	43	43	0	77	0.4	2.7	B02/3	0	0	0	SPECIAL PIT
B73/4	1.8 m lintel	0.003	95	5	5	15	1	1	0	78	0.7	3.9	B05/13	30	1.73	0.05	SPECIAL PIT
B75/1	1.8 m lintel	0.077	85	5	5	15	27	25	1	56	0.7	3	B75/2	10	0.98	0.03	
B75/2	2.4 m lintel sag	0.067	85	5	5	15	10	20	0	32	0.5	2.9	B03/21	0	7.12	0.08	
B76/1	2.4 m lintel	0.113	85	5	5	15	44	41	3	67	1.2	3	B55/1	39	1.35	0.08	
B77/1	2.4 m lintel sag	0.118	85	5	5	25	34	34	0	57	0.5	2.6	B11/2	0	0	0	
B78/1	2.4 m lintel sag	0.03	95	5	5	5	6	6	0	15	0.1	3	LOST	0	0	0	
B99/1	NODE									24	0.2	3		5	0.27	0.01	SPLITTER PIT INTERNAL WEIR
B99/2	JP SEALED 900 x 900									0							
C01/1	1.8 m lintel	0.107	85	5	5	15	40	35	5	84	0.7	3	C01/2	34	2.23	0.04	
C01/2	1.8 m lintel	0.08	85	5	5	25	34	32	2	92	0.7	3	C01/3	44	2.15	0.05	
C01/3	2.4 m lintel sag	0.222	85	5	5	5	86	86	0	77	0.2	3	C01/4	0			
C01/4	1.8 m lintel	0.096	95	5	5	5	29	28	1	47	1.2	3	C01/5	8	0.9	0.02	
C01/5	1.8 m lintel	0.019	95	5	5	15	8	8	0	53	1.1	3	C01/6	7	2.15	0.01	

△ DRAINAGE TABLE UPDATED

I hereby certify that engineering works shown on this plan have been constructed generally in accordance with Construction Certificate 16635 issued by Land Development Certificates

Signature: *[Signature]*
PETER ROBERT WARWICK
 Registered Land Surveyor
VINCE MORGAN SURVEYORS PTY LTD

DATE 20/12/2022 REF 20260-7

LDC These plans are referred to in certificate no. **16635** approved by:

Christopher Louis Wahbe
 Registered Certifier
 Registration No: BDC 3015
 Categories: Certifier – Subdivision

Land Development Certificates
www.LDC.com.au

B	DRAINAGE TABLE UPDATED	DG	VS	MP	MS	14/09/21
A	ISSUE FOR APPROVAL	DG	VS	MP	PJM	12/08/21
	AMENDMENT	DES	DRN	CKD	APR	DATE

J. WYNDHAM PRINCE
 CONSULTING CIVIL INFRASTRUCTURE ENGINEERS & PROJECT MANAGERS

PO Box 4366 PENRITH WESTFIELD NSW 2750
 P 02 4720 3300 W www.jwprince.com.au E jwp@jwprince.com.au

CLIENT:

WINTEN PROPERTY GROUP

STATUS: **ISSUE FOR CONSTRUCTION APPROVAL**

THIS DRAWING MUST NOT BE USED FOR CONSTRUCTION UNLESS SIGNED AS PART OF AN APPROVED CONSTRUCTION CERTIFICATE.

NEWPARK PRECINCT 7, STAGE 7B DRAINAGE CALCULATIONS SHEET 2

AZIMUTH: M.G.A.94 DATUM: A.H.D. ORIGIN: SSM 1112 PLAN No: 9985-12-CC5412

PROJECT No: **9985-12**
 SHEET No: **CC5412**

DESIGN STORM 10% AEP HYDRAULIC RESULTS																					
PIPE NAME	PIPE DIAMETER	PIPE TYPE	PIPE LENGTH	PIPE GRADE	CRITICAL STORM	PEAK FLOW	CAPACITY RATIO	PEAK VELOCITY	PIPE U/S IL	PIPE D/S IL	PIPE D/S DROP	U/S PIT Ku	D/S PIT Kw	PIT LOSS (Ku.V/head)	WSE LOSS (Kw.V/head)	U/S PIPE HGL	D/S PIPE HGL	HGL GRADE	MINIMUM COVER	MINIMUM FREEBOARD	COMMENTS
(-)	(mm)	(-)	(m)	(%)	(min)	(L/s)	(-)	(m/s)	(m)	(m)	(m)	(-)	(-)	(m)	(m)	(m)	(m)	(%)	(m)	(m)	
A04/6 to A04/7	450	RRJ2	19.89	1	20	304	0.98	1.91	17.239	17.04	0.05	1.09	1.22	0.19	0.19	18.17	18.011	0.8	1.39	0.674	
A04/7 to A04/8	525	RRJ2	15.6	1	15	384	0.82	1.92	16.99	16.834	0.05	1.08	1.13	0.17	0.18	17.893	17.812	0.52	1.46	0.82	
A04/8 to A04/9	600	RRJ2	43.15	1	20	358	0.54	2.11	16.784	16.353	0.05	0.37	0.39	0.1	0.03	17.786	17.675	0.26	1.57	1.191	
A37/1 to A04/7	375	RRJ2	9	2	15	66	0.25	1.13	17.366	17.186	0.196	4.5	4.5	0.17	0.08	18.012	18.008	0.04	1.1	0.752	
B02/1 to B02/2	375	RRJ2	13.62	1	5	26	0.13	0.6	17.834	17.698	0.05	4.5	4.5	0.09	0.01	18.359	18.358	0.01	1.1	0.919	
B02/2 to B02/3	375	RRJ2	9	1	15	110	0.58	1.08	17.648	17.558	0.05	5.6	5.62	0.21	0.22	18.28	18.272	0.09	1.24	0.864	
B02/3 to B02/4	375	RRJ2	28.83	1	20	124	0.65	1.44	17.508	17.219	0.05	2.13	2.6	0.18	0.17	18.209	18.144	0.23	1.31	0.95	
B02/4 to B02/5	375	RRJ2	15.29	1	20	113	0.6	1.15	17.169	17.016	0.05	0.58	0.58	0.07	0.03	18.125	18.09	0.23	1.73	1.22	
B02/5 to B02/6	450	RRJ2	23.62	0.5	10	193	0.88	1.26	16.966	16.848	0.03	1.4	1.49	0.1	0.11	18.036	17.976	0.25	1.48	0.883	
B02/6 to B02/7	525	RRJ2	22.84	0.5	20	276	0.84	1.42	16.818	16.704	0.05	2.14	0.82	0.06	0.06	17.95	17.902	0.21	1.39	0.833	
B02/7 to B02/8	525	RRJ2	26.71	0.5	20	314	0.95	1.6	16.654	16.521	0.05	0.67	0.63	0.06	0.06	17.873	17.795	0.29	1.54	0.746	
B02/8 to B02/9	600	RRJ2	12.12	0.8	20	351	0.59	1.48	16.471	16.374	0.05	8.25	0.87	0.09	0.06	17.768	17.745	0.19	1.41	0.669	
B02/9 to B02/10	600	RRJ2	14.35	0.5	20	387	0.82	1.51	16.324	16.252	0.058	0.79	0.79	0.07	0.07	17.708	17.675	0.23	1.62	0.662	
B02/10 to B02/11	750	RRJ2	15.07	0.5	20	506	0.59	1.63	16.194	16.119	0.05	0.37	0.38	0.05	0.03	17.657	17.637	0.13	1.56	0.886	
B02/11 to B02/12	750	RRJ2	47.67	0.5	5	578	0.68	1.76	16.069	15.831	0.05	1.67	0.77	0.1	0.06	17.604	17.514	0.19	1.62	0.853	
B02/12 to B02/13	(2x)1200	RRJ2	10.9	0.5	25	3416	0.57	1.79	15.781	15.726	0.05	0.26	0.25	0.04	0.03	17.485	17.467	0.17	1.52	1.012	
B02/13 to B02/14	(2x)1200	RRJ2	35.16	0.5	25	3421	0.57	1.62	15.676	15.5	0.05	1.04	1.07	0.14	0.12	17.349	17.291	0.16	1.52	1.063	
B02/14 to B02/15	(2x)1200	RRJ2	15.38	0.5	25	3971	0.66	1.84	15.45	15.373	0.05	0.75	0.74	0.11	0.11	17.18	17.145	0.23	1.47	0.992	
B02/15 to B02/16	(2x)1200	RRJ2	20.22	0.5	25	4010	0.67	1.97	15.323	15.222	0.03	0.58	0.56	0.1	0.09	17.056	17.01	0.23	1.32	0.805	
B02/16 to B02/17	(2x)1200	RRJ2	20.27	0.5	25	4070	0.68	1.91	15.192	15.091	0.05	0.22	0.22	0.04	0.04	16.974	16.927	0.23	1.33	0.795	
B02/17 to B02/18	(2x)1200	RRJ2	14.15	0.5	25	4109	0.69	1.82	15.041	14.97	0.05	0.67	0.61	0.1	0.1	16.824	16.791	0.23	1.56	0.789	
B02/18 to B02/19	(2x)1200	RRJ2	26.18	0.5	25	4124	0.69	1.82	14.92	14.789	0.05	0.73	0.64	0.11	0.11	16.683	16.621	0.24	1.6	0.999	
B02/19 to B02/19	(2x)1200	RRJ2	10.48	1	25	4130	0.49	1.83	14.739	14.634	0.084	1.17	1.23	0.19	0.2	16.429	16.404	0.24	2.04	1.377	
B03/15 to B03/16	1050	RRJ2	40.53	0.6	25	1834	0.8	2.42	16.948	16.704	0.03	0.28	0.26	0.08	0.06	18.458	18.303	0.38	1.48	1.068	
B03/16 to B03/17	1050	RRJ2	30.6	0.6	25	1886	0.82	2.24	16.674	16.491	0.043	0.29	0.27	0.07	0.06	18.245	18.121	0.41	1.48	0.996	
B03/17 to B03/18	1350	RRJ2	40.57	0.5	25	2515	0.62	2	16.448	16.245	0.05	0.25	0.23	0.06	0.04	18.086	18.009	0.19	1.14	0.963	
B03/18 to B03/19	1350	RRJ2	12.42	0.5	25	2534	0.62	1.87	16.195	16.133	0.03	0.86	0.89	0.14	0.14	17.876	17.852	0.19	1.23	0.792	
B03/19 to B03/20	1350	RRJ2	26.82	0.3	25	2566	0.81	2.02	16.103	16.022	0.03	0.5	0.5	0.1	0.08	17.776	17.723	0.2	1.25	0.889	
B03/20 to B03/21	1350	RRJ2	34.19	0.3	25	2799	0.88	2.36	15.992	15.89	0.03	0.3	0.3	0.07	0.05	17.67	17.589	0.24	1.04	0.818	
B03/21 to B02/12	(2x)1200	RRJ2	15.24	0.3	25	2890	0.62	1.48	15.86	15.814	0.034	0.7	0.66	0.07	0.05	17.536	17.518	0.12	1.38	0.76	
B04/1 to B04/2	375	RRJ2	17.94	1	25	107	0.56	1.34	19.627	19.447	0.03	1.78	2.03	0.12	0.1	19.797	19.667	0.72	1.4	1.525	
B04/2 to B04/3	375	RRJ2	30.49	1	25	129	0.68	1.74	19.417	19.113	0.03	0.39	0.39	0.04	0.03	19.622	19.339	0.93	1.48	1.65	
B04/3 to B04/4	375	RRJ2	49.33	1	25	129	0.68	1.74	19.083	18.589	0.03	0.24	0.24	0.02	0.02	19.291	18.844	0.91	1.6	1.795	
B04/4 to B04/5	375	RRJ2	53.43	1	25	160	0.84	1.82	18.559	18.025	0.03	0.6	0.58	0.05	0.06	18.798	18.419	0.71	1.6	1.914	
B04/5 to B04/6	375	RRJ2	50.69	1.84	15	164	0.64	2.04	17.995	17.064	0.05	0.56	0.56	0.06	0.06	18.376	18.053	0.64	1.12	1.587	
B04/6 to B04/7	450	RRJ2	9.79	2	20	182	0.42	1.49	17.014	16.819	0.05	1.54	1.86	0.15	0.12	17.973	17.94	0.34	1.13	0.525	
B04/7 to B04/8	450	RRJ2	16.3	1	5	214	0.69	1.69	16.769	16.606	0.05	4.57	1.14	0.12	0.1	17.879	17.805	0.45	1.44	0.578	
B04/8 to B03/20	450	RRJ2	11.94	2	25	212	0.48	2.27	16.556	16.317	0.324	0.31	0.31	0.11	0.03	17.778	17.723	0.46	1.6	0.791	
B05/1 to B05/2	375	RRJ2	28.43	1	25	72	0.38	1.34	19.297	19.013	0.05	1.91	2.2	0.12	0.05	19.499	19.501	-0.01	1.11	1.141	
B05/2 to B05/3	375	RRJ2	36.07	1	20	90	0.47	1.3	18.963	18.602	0.05	1.59	1.38	0.12	0.05	19.477	19.434	0.12	1.24	0.97	
B05/3 to B05/4	375	RRJ2	33.13	1	20	137	0.72	1.33	18.552	18.221	0.03	1.6	1.47	0.14	0.1	19.381	19.264	0.35	1.24	0.781	
B05/4 to B05/5	450	RRJ2	15.89	1	15	280	0.91	1.76	18.191	18.032	0.05	1.44	1.55	0.21	0.22	19.128	19.042	0.54	1.29	0.719	
B05/5 to B05/6	525	RRJ2	9.02	2	15	307	0.47	1.52	17.982	17.801	0.05	1.99	2.52	0.2	0.26	18.918	18.89	0.31	1.4	0.833	
B05/6 to B05/7	525	RRJ2	15.44	1	20	335	0.72	1.85	17.751	17.597	0.05	0.84	0.84	0.12	0.1	18.837	18.786	0.33	1.79	1.027	
B05/7 to B05/8	525	RRJ2	10.6	2	20	350	0.53	2.3	17.547	17.335	0.05	0.33	0.36	0.16	0.04	18.76	18.717	0.41	1.98	1.254	
B05/8 to B05/9	525	RRJ2	15.5	1	20	344	0.74	1.78	17.285	17.13	0.03	1.15	1.21	0.15	0.16	18.625	18.561	0.41	2.14	1.286	
B05/9 to B05/10	525	RRJ2	21.56	1	45	366	0.79	2.07	17.1	16.884	0.03	0.37	0.41	0.1	0.05	18.534	18.439	0.44	2.2	1.311	
B05/10 to B05/11	600	RRJ2	32.11	1	25	351	0.53	1.72	16.854	16.533	0.03	0.48	0.52	0.13	0.03	18.417	18.338	0.25	2.21	1.282	
B05/11 to B05/12	600	RRJ2	23.12	1	25	540	0.81	1.94	16.503	16.272	0.05	0.71	0.76	0.12	0.12	18.269	18.123	0.63	2.34	1.159	
B05/12 to B05/13	600	RRJ2	10.62	2	25	558	0.59	1.97	16.222	16.01	0.05	1.22	1.29	0.21	0.22	17.941	17.87	0.67	2.52	1.211	
B05/13 to B05/14	600	RRJ2	31.89	0.7	25	576	1.03	2.04	15.96	15.737	0.03	1.22	1.31	0.22	0.23	17.678	17.455	0.7	2.63	1.425	
B05/14 to B05/15	675	RRJ2	41.08	0.65	25	663	0.9	1.85	15.707	15.44	0.05	0.99	0.41	0.09	0.06	17.407	17.191	0.53	1.59	1.536	
B05/15 to B08/13	675	RRJ2	14.96	0.65	25	730	0.99	2.04	15.39	15.292	0.068	0.84	0.84	0.17	0.17	17.045	16.949	0.64	1.81	0.543	
B08/1 to B08/2	375	RRJ2	15.92	1	25	75	0.4	1.15	18.244	18.085	0.05	1.13	1.13	0.09	0.03	18.359	18.336	0.14	1.1	1.267	
B08/2 to B08/3	375	RRJ2	14.76	1.42	25	128	0.56	1.57	18.035	17.825	0.18	1.95	1.75	0.16	0.11	18.258	18.25	0.05	1.12	1.286	
B08/3 to B08/4	375	RRJ2	25.65	1	15	131	0.69	1.48	17.644	17.388	0.03	0.93	0.92	0.12	0.07	18.215	18.147	0.27	1.1	0.915	
B08/4 to B08/5	375	RRJ2	31.66	1	20	166	0.87	1.67	17.358	17.041	0.03	0.77	0.72	0.1	0.08	18.111	17.971	0.44	1.17	0.799	
B08/5 to B08/6	450	RRJ2	32.75	1	20	224	0.73	1.64	17.011	16.684	0.03	0.93									

DESIGN STORM 10% AEP HYDRAULIC RESULTS																					
PIPE NAME	PIPE DIAMETER (mm)	PIPE TYPE	PIPE LENGTH (m)	PIPE GRADE (%)	CRITICAL STORM (min)	PEAK FLOW (L/s)	CAPACITY RATIO (-)	PEAK VELOCITY (m/s)	PIPE U/S IL (m)	PIPE D/S IL (m)	PIPE D/S DROP (m)	U/S PIT (-)	D/S PIT (-)	PIT LOSS (Ku.V/head)	WSE LOSS (Kw.V/head)	U/S PIPE HGL (m)	D/S PIPE HGL (m)	HGL GRADE (%)	MINIMUM COVER (m)	MINIMUM FREEBOARD (m)	COMMENTS
B11/1 to B11/2	375	RRJ2	9	1	15	-94	-0.49	0.92	16.263	16.173	0.05	4.5	4.5	0.07	0.01	17.179	17.176	0.03	1.1	0.523	
B11/2 to B08/10	375	RRJ2	50.35	0.75	15	-111	-0.68	1.01	16.123	15.746	0.042	2.16	2.48	0.17	0.07	17.173	17.154	0.04	1.17	0.525	
B19/12 to B19/13	525	RRJ2	22.17	1.13	15	467	0.94	2.23	17.309	17.058	0.148	0.49	0.41	0.1	0.09	18.03	17.856	0.79	1.1	0.844	
B19/13 to B19/14	600	RRJ2	27.03	1.58	20	483	0.58	2.44	16.911	16.484	0.146	0.48	0.46	0.15	0.06	17.807	17.683	0.46	1.1	0.697	
B19/14 to B19/15	675	RRJ2	9	2	20	522	0.41	1.57	16.339	16.159	0.05	2.05	2.56	0.23	0.28	17.512	17.487	0.28	1.1	0.403	
B19/15 to B19/16	675	RRJ2	15.14	1	20	557	0.61	1.98	16.109	15.957	0.05	0.96	0.98	0.14	0.12	17.4	17.351	0.32	1.44	0.598	
B19/16 to B02/14	750	RRJ2	9	2	5	555	0.33	2.3	15.907	15.727	0.277	0.63	0.61	0.25	0.04	17.313	17.296	0.19	1.64	0.932	
B20/1 to B02/17	375	RRJ2	9.1	2	20	-50	-0.19	0.98	16.239	16.057	1.016	4.5	4.5	0.13	0.02	16.928	16.927	0.01	1.1	0.747	
B26/1 to B26/2	375	RRJ2	10.93	2	25	50	0.19	1.12	19.177	18.959	0.05	4.5	4.5	0.16	0.05	19.392	19.4	-0.07	1.1	1.204	
B26/2 to B06/5	375	RRJ2	14.9	1	15	73	0.38	1.3	18.909	18.76	0.492	1.4	1.24	0.1	0.03	19.392	19.385	0.05	1.15	1.186	
B31/1 to B04/2	375	RRJ2	9.16	2	25	18	0.07	0.98	19.88	19.697	0.279	4.5	4.5	0.07	0.01	19.905	19.762	1.56	1.1	1.35	
B32/1 to B04/4	375	RRJ2	12.63	2	15	14	0.05	1.01	19.357	19.105	0.545	4.5	4.5	0.05	0	19.386	19.164	1.76	1.1	1.382	
B37/1 to B03/17	375	RRJ2	9.01	2	15	41	0.15	1.13	17.649	17.469	1.021	4.5	4.5	0.16	0.03	18.122	18.121	0.01	1.1	0.953	
B39/1 to B02/16	375	RRJ2	9	2	20	97	0.36	1.56	16.358	16.178	0.986	1.44	1.38	0.14	0.04	17.018	17.01	0.09	1.1	0.771	
B43/1 to B10/3	375	RRJ2	9	2	15	83	0.31	1.21	17.133	16.953	0.117	4.5	4.5	0.19	0.13	17.803	17.797	0.07	1.1	0.691	
B44/1 to B08/15	375	RRJ2	9	2	15	-62	-0.23	0.78	16.224	16.044	1.014	2.09	2.66	0.27	0.04	16.824	16.824	0	1.1	0.827	
B45/1 to B08/11	375	RRJ2	9	2	15	-45	-0.17	0.99	16.36	16.18	0.595	4.5	4.5	0.14	0.02	17.077	17.076	0.01	1.1	0.718	
B46/1 to B02/11	375	RRJ2	9	2	15	86	0.32	1.28	17.051	16.871	0.803	4.5	4.5	0.2	0.14	17.646	17.641	0.06	1.1	0.774	
B48/1 to B02/10	375	RRJ2	9.27	2	20	-25	-0.09	0.76	17.132	16.947	0.753	4.5	4.5	0.13	0.01	17.679	17.679	0	1.1	0.904	
B49/1 to B49/2	375	RRJ2	9.18	2	15	18	0.07	0.94	19.118	18.935	0.05	4.5	4.5	0.08	0.01	19.14	19.024	1.26	1.1	1.355	
B49/2 to B05/7	375	RRJ2	30.51	1.18	25	42	0.2	1.25	18.885	18.524	0.977	3.52	3.28	0.07	0.02	18.958	18.786	0.56	1.1	1.515	
B50/1 to B05/10	375	RRJ2	9.07	2	25	11	0.04	0.76	18.281	18.099	1.245	4.5	4.5	0.08	0	18.439	18.439	0	1.1	1.287	
B51/1 to B08/17	375	RRJ2	9	2	15	25	0.09	1	16.362	16.182	1.43	4.5	4.5	0.1	0.01	16.618	16.619	-0.01	1.1	1.174	
B55/1 to B05/15	375	RRJ2	9.5	2	15	-48	-0.18	1.13	16.344	16.154	0.765	4.5	4.5	0.15	0.04	17.193	17.191	0.02	1.1	0.579	
B56/1 to B05/3	375	RRJ2	9.53	1.8	25	31	0.12	0.94	18.785	18.613	0.061	4.5	4.5	0.12	0.02	19.435	19.434	0.01	1.1	0.796	
B58/1 to B58/2	375	RRJ2	13.09	1	25	68	0.36	1.14	17.883	17.752	0.05	2.15	2.63	0.1	0.05	18.169	18.169	0	1.1	1.167	
B58/2 to B58/3	375	RRJ2	9.02	2	25	85	0.31	1.35	17.702	17.522	0.05	2.1	2.53	0.15	0.07	18.147	18.141	0.07	1.16	1.034	
B58/3 to B58/4	375	RRJ2	14.71	1	15	98	0.52	1.43	17.472	17.325	0.05	1.08	0.96	0.09	0.04	18.129	18.115	0.1	1.42	1.047	
B58/4 to B02/5	375	RRJ2	9	2	20	85	0.32	1.5	17.275	17.095	0.128	1.02	1.04	0.13	0.03	18.1	18.09	0.11	1.35	0.858	
B59/1 to B02/6	375	RRJ2	9.4	2	25	77	0.29	1.66	17.376	17.188	0.369	0.79	0.63	0.09	0.01	17.979	17.976	0.03	1.1	0.844	
B60/1 to B02/7	375	RRJ2	9.37	2	25	29	0.11	1.05	17.215	17.028	0.374	4.5	4.5	0.12	0.02	17.903	17.902	0.01	1.1	0.757	
B61/1 to B61/2	375	RRJ2	9.04	2	15	36	0.13	1.04	16.847	16.666	0.05	4.5	4.5	0.14	0.02	17.164	17.164	0	1.1	1.122	
B61/2 to B61/3	375	RRJ2	15.2	1	15	60	0.32	1.2	16.616	16.464	0.05	1.81	1.82	0.12	0.02	17.157	17.154	0.02	1.26	1.122	
B61/3 to B02/15	375	RRJ2	9	2	15	80	0.3	1.5	16.414	16.234	0.911	1.19	1.12	0.11	0.03	17.148	17.146	0.02	1.19	0.797	
B65/1 to B06/11	375	RRJ2	9	2	20	58	0.22	1.19	17.485	17.305	0.699	4.5	4.5	0.18	0.06	18.226	18.223	0.03	1.1	0.669	
B66/1 to B19/13	375	RRJ2	9.03	1.5	15	38	0.16	0.89	17.096	16.961	0.05	4.5	4.5	0.12	0.03	17.858	17.856	0.02	1.1	0.671	
B67/1 to B08/4	375	RRJ2	10.35	1.2	25	23	0.11	0.75	17.532	17.408	0.05	4.5	4.5	0.1	0.01	18.118	18.12	-0.02	1.1	0.867	
B68/1 to B08/5	375	RRJ2	9.5	2	15	39	0.14	0.91	17.257	17.067	0.056	4.5	4.5	0.14	0.03	17.96	17.958	0.02	1.1	0.728	
B69/1 to B08/6	375	RRJ2	10.53	2	20	33	0.12	0.98	16.985	16.774	0.12	4.5	4.5	0.14	0.02	17.811	17.809	0.02	1.1	0.62	
B70/1 to B08/7	375	RRJ2	9.61	2	20	41	0.15	1.09	16.701	16.509	0.211	4.5	4.5	0.16	0.03	17.567	17.565	0.02	1.1	0.56	
B71/1 to B08/8	375	RRJ2	9.56	2	15	-51	-0.19	1	16.482	16.29	0.27	4.5	4.5	0.11	0.03	17.422	17.421	0.01	1.1	0.505	
B72/1 to B72/2	375	RRJ2	9.11	2	25	56	0.21	0.93	17.432	17.249	0.05	4.5	4.5	0.16	0.06	17.496	17.529	-0.36	1.1	1.217	
B72/2 to B05/14	375	RRJ2	15.47	1	25	101	0.53	1.31	17.199	17.045	1.338	4.11	3.28	0.14	0.1	17.467	17.455	0.08	1.46	1.351	
B73/1 to B73/2	375	RRJ2	18.74	1	20	133	0.7	1.3	17.801	17.614	0.05	2.01	2.5	0.14	0.17	18.714	18.65	0.34	1.21	0.632	
B73/2 to B73/3	375	RRJ2	9.02	2	20	151	0.56	1.37	17.564	17.384	0.05	2.07	2.54	0.19	0.22	18.543	18.502	0.45	1.4	0.655	
B73/3 to B73/4	450	RRJ2	15.18	1	15	240	0.78	1.64	17.334	17.182	0.05	8.35	2.14	0.2	0.2	18.434	18.387	0.31	1.68	0.81	
B73/4 to B05/11	450	RRJ2	9.91	2	45	274	0.63	2.47	17.132	16.934	0.43	0.27	0.27	0.11	0.04	18.37	18.338	0.32	1.93	1.105	
B75/1 to B75/2	375	RRJ2	20.62	1	15	86	0.45	1.23	16.928	16.722	0.05	1.98	2.33	0.16	0.07	17.654	17.637	0.08	1.1	0.764	
B75/2 to B03/21	375	RRJ2	9	2	20	97	0.36	1.48	16.672	16.492	0.632	2.14	2.61	0.16	0.1	17.6	17.589	0.12	1.3	0.67	
B76/1 to B05/14	375	RRJ2	11.81	2	25	41	0.15	1.19	17.646	17.41	1.703	4.5	4.5	0.13	0.03	17.68	17.508	1.46	1.1	1.298	
B77/1 to B08/9	375	RRJ2	9.07	2	15	-106	-0.39	1.1	16.246	16.064	0.232	4.5	4.5	0.16	0.11	17.239	17.236	0.03	1.1	0.422	
B78/1 to B02/18	375	RRJ2	9.12	2	20	-40	-0.15	0.78	16.361	16.179	1.259	4.5	4.5	0.09	0.01	16.795	16.794	0.01	1.1	1.004	
B99/1 to B99/2	1200	RRJ2	10.3	1	25	2554	0.6	3.13	14.55	14.447	0.05	0	0	0	0	15.223	15.409	-1.81	2.25	2.948	GPT BYPASS CHAMBER
C01/1 to C01/2	375	RRJ2	22.7	1	20	33	0.17	0.96	17.978	17.751	0.03	4.5	4.5	0.13	0.02	18.343	18.339	0.02	1.1	1.389	
C01/2 to C01/3	375	RRJ2	31.4	1	25	71	0.38	0.73	17.721	17.407	0.05	3	3	0.16	0.06	18.311	18.291	0.06	1.2	1.325	
C01/3 to C01/4	525	RRJ2	9	1	25	336	0.72	1.55	17.357	17.267	0.05	2.11	2.56	0.23	0.28	18.091	18.053	0.42	1.29	1.18	
C01/4 to C01/5	525	RRJ2	14.41	1	20	358	0.77	1.82	17.217	17.073	0.05	0.82	0.81	0.11	0.11	17.969	17.899	0.49	1.39	1.432	

Δ DRAINAGE TABLE UPDATED

I hereby certify that engineering works shown on this plan have been constructed generally in accordance with Construction Certificate 16635 issued by Land Development Certificates

Signature: *PR*
PETER ROBERT WARWICK
Registered Land Surveyor
VINCE MORGAN SURVEYORS PTY LTD

DATE 20/12/2022 REF 20260-7

These plans are referred to in certificate no. **16635** approved by:

LDC
Christopher Louis Wahbe
Registered Certifier
Registration No: BDC 3015
Categories: Certifier – Subdivision

Land Development Certificates
www.LDC.com.au

Plotfile: 14 September, 2021 12:51:00 PM File Name: J:\9985D\CC - Construction Certificate Approval Plans\PK12 WESTERN PRECINCTS IS - Precinct 7B\9985-12-CC5414.dwg

B	DRAINAGE TABLE UPDATED	DG	VS	MP	MS	14/09/21
---	------------------------	----	----	----	----	----------

DESIGN STORM 5% AEP HYDROLOGIC RESULTS																	
PIT NAME (-)	PIT TYPE (-)	CATCHMENT AREA (Ha)	PERCENT IMPERVIOUS (%)	Tc IMP (min)	Tc PERV (min)	CRITICAL STORM (min)	APPROACH FLOW (L/s)	CAPTURED FLOW (L/s)	UNCAPTURED FLOW (L/s)	GRATE DEPTH (mm)	ROAD GRADE (%)	ROAD CROSSFALL (%)	BYPASS PIT (-)	FLOW AT BYPASS PIT (L/s)	FLOW WIDTH AT BYPASS PIT (m)	VxD AT BYPASS PIT (m/s^2)	COMMENTS (-)
BAB/1	IAD 600x900	0.034	80	5	5	15	15	15									
BAB/2	IAD 600x900	0.027	80	5	5	15	12	12									
BAB/3	IAD 600x900	0.027	80	5	5	15	12	12									
BAB/4	IAD 600x900	0.027	80	5	5	15	12	12									
BAB/5	IAD 600x900	0.027	80	5	5	15	12	12									
BAB/6	IAD 600x900	0.034	80	5	5	15	15	15									
BAB/7	IAD 900x900		0			5	0	0									
BAC/1	IAD 600x900	0.036	80	5	5	25	16	16									
BAC/2	IAD 600x900	0.03	80	5	5	15	13	13									
BAC/3	IAD 600x900	0.031	80	5	5	25	14	14									
BAC/4	IAD 600x900	0.032	80	5	5	15	14	14									
BAC/5	IAD 900x900	0.039	80	5	5	15	17	17									
BE/1	IAD 600x900	0.036	80	5	5	15	16	16									
BE/2	IAD 600x900	0.039	80	5	5	15	17	17									
BE/3	IAD 600x900	0.041	80	5	5	15	18	18									
BE/4	IAD 600x900	0.044	80	5	5	15	19	19									
BE/5	IAD 600x900		0			5	0	0									
BE/6	IAD 900x900		0			5	0	0									
BJ/1	IAD 600x900	0.028	80	5	5	15	12	12									
BJ/2	IAD 600x900	0.027	80	5	5	15	12	12									
BJ/3	IAD 600x900	0.028	80	5	5	15	12	12									
BJ/4	IAD 600x900	0.034	80	5	5	15	15	15									
BJ/5	IAD 600x900	0.034	80	5	5	15	15	15									
BJ/6	IAD 600x900	0.028	80	5	5	15	12	12									
BJ/7	IAD 900x900	0.028	80	5	5	15	12	12									
BJ/8	IAD 900x900	0.028	80	5	5	15	12	12									
BJ/9	IAD 900x900	0.034	80	5	5	15	15	15									
BK/1	IAD 600x900	0.042	80	5	5	15	18	18									
BK/2	IAD 600x900	0.034	80	5	5	15	15	15									
BK/3	IAD 600x900	0.034	80	5	5	15	15	15									
BK/4	IAD 900x900	0.04	80	5	5	15	17	17									
BL/1	IAD 600x900	0.032	80	5	5	15	14	14									
BL/2	IAD 600x900	0.032	80	5	5	15	14	14									
BL/3	IAD 600x900	0.032	80	5	5	15	14	14									
BL/4	IAD 600x900	0.032	80	5	5	15	14	14									
BL/5	IAD 600x900	0.032	80	5	5	15	14	14									
BL/6	IAD 600x900	0.032	80	5	5	15	14	14									
BL/7	IAD 600x900	0.032	80	5	5	15	14	14									
BL/8	IAD 900x900	0.034	80	5	5	15	15	15									
BL/9	IAD 600x900	0.027	80	5	5	15	12	12									
BL/10	IAD 900x900		0			5	0	0									
BM/1	IAD 600x900	0.04	80	5	5	25	18	18									
BM/2	IAD 600x900	0.034	80	5	5	15	15	15									
BM/3	IAD 600x900	0.034	80	5	5	15	15	15									
BM/4	IAD 900x900	0.041	80	5	5	15	18	18									
BN/1	IAD 600x900	0.032	80	5	5	15	14	14									
BN/2	IAD 600x900	0.032	80	5	5	15	14	14									
BN/3	IAD 600x900	0.032	80	5	5	15	14	14									
BN/4	IAD 600x900	0.032	80	5	5	15	14	14									
BN/5	IAD 600x900	0.032	80	5	5	15	14	14									
BN/6	IAD 600x900	0.032	80	5	5	15	14	14									
BN/7	IAD 900x900	0.032	80	5	5	15	14	14									
BN/8	IAD 900x900	0.032	80	5	5	15	14	14									
BN/9	IAD 900x900	0.032	80	5	5	15	14	14									
BN/10	IAD 900x900	0.034	80	5	5	15	15	15									
BN/11	IAD 900x900	0.027	80	5	5	15	12	12									
BN/12	IAD 900x900	0.045	80	5	5	25	20	20									
BO/1	IAD 600x900	0.042	80	5	5	15	18	18									
BP/1	IAD 600x900	0.041	80	5	5	15	18	18									
BP/2	IAD 600x900	0.033	80	5	5	15	14	14									
BP/3	IAD 600x900	0.033	80	5	5	15	14	14									
BP/4	IAD 900x900	0.044	80	5	5	15	19	19									
BR/1	IAD 600x900	0.034	80	5	5	15	15	15									
BR/2	IAD 600x900	0.034	80	5	5	15	15	15									
BR/3	IAD 600x900	0.028	80	5	5	15	12	12									
BR/4	IAD 600x900	0.028	80	5	5	15	12	12									
BR/5	IAD 600x900	0.027	80	5	5	15	12	12									
BR/6	IAD 600x900	0.034	80	5	5	15	15	15									
BR/7	IAD 600x900	0.028	80	5	5	15	12	12									
BR/8	IAD 600x900	0.028	80	5	5	15	12	12									
BR/9	IAD 600x900	0.028	80	5	5	15	12	12									
BR/10	IAD 600x900	0.034	80	5	5	15	15	15									
BR/11	IAD 600x900		0			5	0	0									
BR/12	IAD 900x900		0			5	0	0									
BS/1	IAD 600x900	0.043	80	5	5	15	19	19									
BS/2	IAD 600x900	0.037	80	5	5	15	16	16									
BS/3	IAD 600x900	0.038	80	5	5	25	17	17									
BS/4	IAD 900x900	0.046	80	5	5	15	20	20									
BU/1	IAD 600x900	0.042	80	5	5	15	18	18									

I hereby certify that engineering works shown on this plan have been constructed generally in accordance with Construction Certificate 16635 issued by Land Development Certificates

Signature.....*PR*.....
PETER ROBERT WARWICK
Registered Land Surveyor
VINCE MORGAN SURVEYORS PTY LTD

DATE 20/12/2022 REF 20260-7

DRAINAGE TABLE UPDATED

These plans are referred to in certificate no. 16635 approved by:
Christopher Louis Wahbe
Registered Certifier
Registration No: BDC 3015
Categories: Certifier – Subdivision
Land Development Certificates
www.LDC.com.au

Plotfile: 14 September, 2021 12:51:17 PM File Name: J:\9985ED\CC - Construction Certificate Approval Plans\PK12 WESTERN PRECINCTS\5 - Precinct 7\B9985-12-CC5415.dwg

B	DRAINAGE TABLE UPDATED	DG	VS	MP	MS	14/09/21
A	ISSUE FOR APPROVAL	DG	VS	MP	PJM	12/08/21
	AMENDMENT	DES	DRN	CKD	APR	DATE

J. WYNDHAM PRINCE
CONSULTING CIVIL INFRASTRUCTURE ENGINEERS & PROJECT MANAGERS

PO Box 4366 PENRITH WESTFIELD NSW 2750
P 02 4720 3300 W www.jwprince.com.au E jwp@jwprince.com.au

CLIENT:

WINTEN PROPERTY GROUP

STATUS:

ISSUE FOR CONSTRUCTION APPROVAL

THIS DRAWING MUST NOT BE USED FOR CONSTRUCTION UNLESS SIGNED AS PART OF AN APPROVED CONSTRUCTION CERTIFICATE.

NEWPARK PRECINCT 7, STAGE 7B DRAINAGE CALCULATIONS SHEET 5

PROJECT No: **9985-12**
SHEET No: **CC5415**

AZIMUTH: M.G.A.94 DATUM: A.H.D. ORIGIN: SSM 1112 PLAN No: **9985-12-CC5415**


B

DESIGN STORM 5% AEP HYDRAULIC RESULTS																						
PIPE NAME	PIPE DIAMETER (mm)	PIPE TYPE	PIPE LENGTH (m)	PIPE GRADE (%)	CRITICAL STORM (min)	PEAK FLOW (L/s)	CAPACITY RATIO	PEAK VELOCITY (m/s)	PIPE U/S IL (m)	PIPE D/S IL (m)	PIPE D/S DROP (m)	U/S PIT (Ku.V/head)	D/S PIT (Kw)	PIT LOSS (m)	WSE LOSS (Kw.V/head)	U/S PIPE HGL (m)	D/S PIPE HGL (m)	HGL GRADE (%)	MINIMUM COVER (m)	MINIMUM FREEBOARD (m)	COMMENTS	
BAB/1 to BAB/2	150	uPVC	10	1	25	14	0.7	0.78	17.993	17.893	0.03	4.44	4.44	0.1	0.1	18.395	18.347	0.48	0.6	0.272		
BAB/2 to BAB/3	150	uPVC	10	1	25	25	1.27	1.42	17.863	17.763	0.03	2.22	1.67	0.09	0.12	18.284	18.081	2.03	0.67	0.34		
BAB/3 to BAB/4	225	uPVC	10	1	25	36	0.62	1.2	17.733	17.633	0.03	1.07	2.21	0.05	0.03	18.081	18.044	0.37	0.66	0.545		
BAB/4 to BAB/5	225	uPVC	10	1	25	47	0.81	1.19	17.603	17.503	0.03	1.22	1.14	0.07	0.06	17.983	17.919	0.64	0.73	0.525		
BAB/5 to BAB/6	225	uPVC	12.5	1	25	58	1	1.46	17.473	17.348	0.03	1.07	0.92	0.08	0.08	17.841	17.717	0.99	0.73	0.554		
BAB/6 to BAB/7	225	uPVC	14.85	1.03	25	72	1.21	1.82	17.318	17.165	0.737	0.96	0.89	0.1	0.12	17.636	17.375	1.76	0.6	0.64		
BAB/7 to B39/1	375	RRJ2	4.45	1.89	15	73	0.28	1.25	16.428	16.344	0.122	2.09	3.24	0.12	0.07	17.203	17.199	0.09	1.1	0.743		
BAC/1 to BAC/2	150	uPVC	10	3.35	25	15	0.41	1.1	20.822	20.487	0.033	5.84	5.52	0.12	0.17	20.938	20.848	0.9	0.6	0.543		
BAC/2 to BAC/3	150	uPVC	10	3.35	15	27	0.75	1.54	20.454	20.119	0.033	2.29	2.27	0.09	0.15	20.783	20.522	2.61	0.6	0.374		
BAC/3 to BAC/4	150	uPVC	10	3.35	25	40	1.1	2.25	20.086	19.751	0.108	1.34	0.94	0.07	0.23	20.468	19.901	5.67	0.6	0.332		
BAC/4 to BAC/5	225	uPVC	12.35	3.42	25	53	0.49	2.7	19.642	19.22	0.742	7.19	3.39	0.01	0	19.753	19.331	3.42	0.6	0.733		
BAC/5 to B08/1	375	RRJ2	4.72	1.93	25	70	0.26	1.27	18.478	18.387	0.143	2.19	3.12	0.1	0.06	18.68	18.691	-0.23	1.1	1.293		
BE/1 to BE/2	150	uPVC	12.66	1	25	16	0.79	0.88	19.17	19.044	0.086	6.34	5.02	0.11	0.14	19.401	19.301	0.79	0.6	0.432		
BE/2 to BE/3	225	uPVC	12.66	1.04	30	35	0.59	1.12	18.958	18.826	0.03	5.51	4.37	0.12	0.06	19.252	19.216	0.28	0.6	0.498		
BE/3 to BE/4	225	uPVC	12.66	1	25	49	0.84	1.24	18.796	18.67	0.03	1.74	1.46	0.09	0.09	19.126	19.036	0.71	0.63	0.443		
BE/4 to BE/5	225	uPVC	17.47	1	25	67	1.15	1.71	18.64	18.465	0.05	1.4	1.12	0.1	0.14	18.949	18.672	1.59	0.66	0.493		
BE/5 to BE/6	225	uPVC	21	2.28	25	67	0.76	2.17	18.415	17.935	0.73	0.5	0.5	0.04	0.07	18.552	18.082	2.24	0.6	0.748		
BE/6 to B75/1	375	RRJ2	4.46	1.88	15	70	0.27	1.25	17.205	17.121	0.193	2.09	3.24	0.11	0.07	17.964	17.962	0.04	1.1	0.762		
BJ/1 to BJ/2	150	uPVC	10	1	15	11	0.57	0.65	20.865	20.765	0.03	6.8	6.8	0.1	0.1	21.307	21.278	0.29	0.6	0.251		
BJ/2 to BJ/3	150	uPVC	10	1	15	22	1.13	1.26	20.735	20.635	0.03	3.06	2.7	0.1	0.12	21.211	21.066	1.45	0.72	0.326		
BJ/3 to BJ/4	225	uPVC	12.5	1	25	33	0.57	1.16	20.605	20.48	0.03	2.91	6.34	0.09	0.04	21.066	21.028	0.3	0.76	0.525		
BJ/4 to BJ/5	225	uPVC	12.5	1	25	47	0.8	1.17	20.45	20.325	0.03	1.54	1.38	0.08	0.06	20.966	20.888	0.62	0.88	0.525		
BJ/5 to BJ/6	225	uPVC	10	1	25	60	1.03	1.51	20.295	20.195	0.03	1.01	1.01	0.09	0.09	20.806	20.7	1.06	1.05	0.682		
BJ/6 to BJ/7	225	uPVC	9.85	1	25	71	1.21	1.78	20.165	20.066	0.03	0.71	0.71	0.09	0.09	20.613	20.465	1.5	1.21	0.904		
BJ/7 to BJ/8	225	uPVC	10	1	25	82	1.4	2.06	20.036	19.936	0.03	0.8	0.8	0.1	0.12	20.378	20.152	2.26	1.39	1.185		
BJ/8 to BJ/9	300	uPVC	13.44	1	25	92	0.73	1.94	19.906	19.772	0.05	8.83	5.19	0.03	0	20.098	19.963	1	1.51	1.613		
BJ/9 to B04/1	375	RRJ2	4.47	1	25	106	0.56	1.54	19.722	19.677	0.05	9.41	0.21	0.04	0.01	19.92	19.957	-0.83	1.55	1.806		
BK/1 to BK/2	150	uPVC	12.5	2.07	15	17	0.61	0.98	20.992	20.733	0.03	5.43	4.35	0.11	0.14	21.267	21.124	1.14	0.6	0.399		
BK/2 to BK/3	150	uPVC	12.5	1.8	15	31	1.18	1.78	20.703	20.478	0.092	2.28	1.31	0.07	0.19	21.068	20.627	3.53	0.6	0.354		
BK/3 to BK/4	225	uPVC	12.99	1.79	25	48	0.62	2.04	20.385	20.152	0.721	0.47	0.47	0.03	0.02	20.518	20.28	1.83	0.6	0.697		
BK/4 to B05/1	375	RRJ2	4.47	1.89	15	64	0.24	1.2	19.431	19.347	0.05	2.2	3.11	0.09	0.05	20	20	0	1.1	0.955		
BL/1 to BL/2	150	uPVC	12.37	1	5	13	0.66	0.81	20.772	20.649	0.05	7.42	6.35	0.12	0.14	21.253	21.206	0.38	0.6	0.208		
BL/2 to BL/3	225	uPVC	12.37	1	5	32	0.55	1.09	20.599	20.475	0.05	8.92	7.08	0.12	0.05	21.189	21.167	0.18	0.67	0.29		
BL/3 to BL/4	225	uPVC	12.36	1	25	39	0.66	1.11	20.425	20.301	0.05	1.56	3.43	0.09	0.05	21.125	21.074	0.41	0.78	0.268		
BL/4 to BL/5	225	uPVC	11.81	1	25	51	0.88	1.29	20.251	20.133	0.03	1.28	1.42	0.08	0.06	21.017	20.931	0.73	0.86	0.272		
BL/5 to BL/6	225	uPVC	11.81	1	25	64	1.09	1.6	20.103	19.985	0.05	1.13	0.86	0.08	0.08	20.856	20.723	1.13	0.93	0.327		
BL/6 to BL/7	225	uPVC	10.93	1	25	76	1.31	1.92	19.935	19.826	0.05	0.7	0.7	0.09	0.1	20.641	20.451	1.74	1.02	0.465		
BL/7 to BL/8	225	uPVC	1.35	1	25	89	1.53	2.24	19.776	19.762	0.05	0.64	0.64	0.13	0.13	20.319	20.289	2.22	1.2	0.752		
BL/8 to BL/9	300	uPVC	10.15	1	25	118	0.94	1.66	19.712	19.611	0.03	1.95	2.34	0.22	0.29	20.067	19.968	0.98	0.95	0.907		
BL/9 to BL/10	300	uPVC	17.65	1.02	25	134	1.06	1.93	19.581	19.401	0.659	0.62	0.56	0.1	0.1	19.916	19.799	0.66	0.6	0.882		
BL/10 to B05/4	375	RRJ2	4.53	1.63	25	124	0.51	1.35	18.742	18.668	0.477	2.09	2.71	0.13	0.16	19.724	19.714	0.22	1.1	0.483		
BM/1 to BM/2	150	uPVC	12.5	1.77	15	17	0.64	0.96	19.928	19.707	0.03	5.01	4.96	0.11	0.16	20.146	20.005	1.13	0.6	0.45		
BM/2 to BM/3	150	uPVC	12.5	3.08	25	31	0.9	1.91	19.677	19.292	0.112	1.93	1.78	0.07	0.19	19.95	19.403	4.38	0.6	0.446		
BM/3 to BM/4	225	uPVC	13.56	2.61	25	47	0.5	2.35	19.18	18.825	0.723	0.46	0.45	0.03	0.02	19.289	18.937	2.6	0.6	0.73		
BM/4 to B58/1	375	RRJ2	4.25	1.76	25	64	0.25	1.2	18.102	18.027	0.144	2.2	3.11	0.09	0.05	18.569	18.569	0	1.1	1.062		
BN/1 to BN/2	150	uPVC	12.05	1	15	14	0.73	0.88	19.619	19.498	0.05	7.39	6.46	0.12	0.15	20.008	19.978	0.25	0.6	0.312		
BN/2 to BN/3	225	uPVC	12.05	1	15	41	0.71	1.26	19.448	19.328	0.05	9.03	6.5	0.12	0.06	19.967	19.954	0.11	0.61	0.313		
BN/3 to BN/4	225	uPVC	12.05	1	20	41	0.7	1.15	19.278	19.157	0.05	1.63	1.42	0.08	0.07	19.928	19.898	0.25	0.71	0.261		
BN/4 to BN/5	225	uPVC	12.05	1	20	53	0.91	1.39	19.107	18.987	0.05	1.15	1.15	0.1	0.1	19.863	19.813	0.42	0.78	0.221		
BN/5 to BN/6	300	uPVC	12.05	1	5	60	0.48	1.65	18.937	18.816	0.05	6.01	0.97	0.03	0.01	19.813	19.796	0.14	0.84	0.271		
BN/6 to BN/7	300	uPVC	11.62	1	5	67	0.54	1.31	18.766	18.65	0.03	0.89	0.95	0.08	0.04	19.778	19.756	0.19	1.02	0.293		
BN/7 to BN/8	300	uPVC	11.61	1	5	76	0.61	1.37	18.62	18.504	0.05	0.82	0.83	0.08	0.04	19.735	19.705	0.26	1.15	0.315		
BN/8 to BN/9	300	uPVC	10.73	1	20	85	0.68	1.23	18.454	18.347	0.05	0.86	0.75	0.07	0.05	19.68	19.645	0.33	1.25	0.306		
BN/9 to BN/10	300	uPVC	1.5	1	20	94	0.75	1.33	18.297	18.282	0.05	0.69	0.69	0.05	0.05	19.615	19.609	0.4	1.31	0.276		
BN/10 to BN/11	300	uPVC	10	1	15	120	0.96	1.7	18.232	18.132	0.03	1.9	2.22	0.22	0.28	19.451	19.39	0.61	1.38	0.309		
BN/11 to BN/12	300	uPVC	17.8	1	5	130	1.04	1.88	18.102	17.924	0.03	0.51	0.51	0.09	0.09	19.351	19.227	0.7	1.41	0.426		
BN/12 to B73/1	375	RRJ2	4.26	1	20	152	0.8	1.69	17.894	17.851	0.05	7.79	0.44	0.04	0	19.227	19.212	0.35	1.36	0.485		
BO/1 to BN/10	150	uPVC	12.35	1.05	25	19	0.92	1.1	19.303	19.173	0.942	6.46	4.25	0.12	0.18	19.647	19.609	0.31	0.6	0.339		
BP/1 to BP/2	150	uPVC	11.11	1.92	25	18	0.65	1.01	19.519	19.306	0.05	6.24	6.23	0.12	0.18	19.767	19.62	1.32	0.6	0.414		
BP/2 to BP/3	150	uPVC	11.02	2.57	25	32	1.02	1.88	19.256	18.973	0.104	2.19	1.72	0.08	0.2	19.56	19.123	3.97	0.6	0.426		
BP/3 to BP																						

These plans are referred to in certificate no. 16635 approved by:
Christopher Louis Wahbe
Registered Certifier
Registration No: BDC 3015
Categories: Certifier – Subdivision

Land Development Certificates
www.LDC.com.au

I hereby certify that engineering works shown on this plan have been constructed generally in accordance with Construction Certificate 16635 issued by Land Development Certificates

Signature: 
PETER ROBERT WARWICK
Registered Land Surveyor
VINCE MORGAN SURVEYORS PTY LTD
DATE 20/12/2022 REF 20260-7

DESIGN STORM 1% AEP HYDROLOGIC RESULTS

PIT NAME (-)	PIT TYPE (-)	CATCHMENT AREA (Ha)	PERCENT IMPERVIOUS (%)	Tc IMP (min)	Tc PERV (min)	CRITICAL STORM (min)	APPROACH FLOW (L/s)	CAPTURED FLOW (L/s)	UNCAPTURED FLOW (L/s)	GRATE DEPTH (mm)	ROAD GRADE (%)	ROAD CROSSFALL (%)	BYPASS PIT (-)	FLOW AT BYPASS PIT (L/s)	FLOW WIDTH AT BYPASS PIT (m)	VxD AT BYPASS PIT (m/s^2)	COMMENTS (-)
A04/6	1.8 m lintel	0.029	95	5	5	15	29	22	7	71	1.1	3	A04/7	29	1.5	0.05	
A04/7	2.4 m lintel sag	0.071	85	5	5	10	31	31	0	62	0.7	2.9	A04/8	0	1.3	0	
A04/8	1.8 m lintel	0.004	95	5	5	15	1	1	0	67	0.2	4	A04/9	18	1.56	0.03	
A04/9	1.8 m lintel	0.035	95	5	5	15	18	15	4	73	0.7	3	A65/1	42	5.47	0.03	
A37/1	2.4 m lintel sag	0.16	85	5	5	15	142	107	10	145	0.5	3	A04/7	45			
B02/1	1.8 m lintel	0.082	85	5	5	15	59	35	19	124	1	3	B02/2	113	5.73	0.06	
B02/2	2.4 m lintel sag	0.16	85	5	5	15	113	113	0	192	0.1	3	B58/2	6	1.21	0.02	
B02/3	2.4 m lintel sag	0.2	85	5	5	10	36	34	0	74	0.5	3	B02/4	0	0.51	0	
B02/4	1.8 m lintel	0	0	0	0	15	0	0	0	42	0.5	3	B02/5	9	2.15	0.01	
B02/5	1.8 m lintel	0.017	95	5	5	15	8	7	2	91	0.9	3	B02/6	54	2.23	0.06	
B02/6	1.8 m lintel	0.1	85	5	5	15	54	36	19	93	0.7	3	B02/7	60	2.39	0.07	
B02/7	1.8 m lintel	0.079	85	5	5	15	60	38	21	98	0.7	3	B02/8	70	4.08	0.05	
B02/8	2.4 m lintel sag	0.121	85	5	5	15	88	88	0	148	0.4	2.8	B02/9	81			SPECIAL PIT
B02/9	2.4 m lintel sag	0.166	85	5	5	10	129	119	0	136	0.7	3	B02/10	0	2.23	0.01	SPECIAL PIT
B02/10	1.8 m lintel	0.005	95	5	5	15	1	1	0	96	1	3	B02/11	59	2.56	0.05	SPECIAL PIT
B02/11	2.4 m lintel sag	0.111	85	5	5	15	54	54	0	103	0.1	3	B75/2	0	0	0	SPECIAL PIT
B02/12	1.8 m lintel	0	0	0	0	15	0	0	0	85	0.7	4.3	B19/16	50	1.97	0.05	SPECIAL PIT
B02/13	1.8 m lintel	0.078	85	5	5	15	10	8	2	93	0.7	3	B02/14	59	2.21	0.07	SPECIAL PIT
B02/14	1.8 m lintel	0.111	85	5	5	15	59	38	21	62	0.7	3	B02/15	24	1.34	0.05	SPECIAL PIT
B02/15	1.8 m lintel	0.018	95	5	5	15	24	19	5	66	0.9	3	B02/16	19	1.81	0.04	SPECIAL PIT
B02/16	1.8 m lintel	0.058	85	5	5	15	19	15	4	80	0.7	3	B02/17	29	1.77	0.04	SPECIAL PIT
B02/17	2.4 m lintel sag	0.076	85	5	5	15	29	29	0	74	0.3	1.8	B02/18	0	0	0	SPECIAL PIT
B02/18	1.8 m lintel	0.076	85	5	5	10	29	20	9	83	0.5	2.7	B78/1	9	0.97	0.01	SPECIAL PIT
B02/19	1.8 m lintel	0.035	85	5	5	15	19	15	4	74	0.6	3	B02/18	29	1.88	0.05	SPECIAL PIT
B03/15	1.8 m lintel	0.005	95	5	5	15	1	1	0	87	0.7	3	B03/16	53	2.02	0.06	
B03/16	1.8 m lintel	0.101	85	5	5	15	47	34	13	70	0.7	3	B65/1	38	5.89	0.03	
B03/17	1.8 m lintel	0.004	95	5	5	15	1	1	0	87	0.7	3	B03/18	53	2.02	0.06	SPECIAL PIT
B03/18	1.8 m lintel	0.101	85	5	5	15	47	34	13	67	0.7	3	B04/6	26	3.43	0.03	SPECIAL PIT
B03/19	2.4 m lintel	0.156	85	5	5	15	113	69	44	106	0.7	3	B03/20	94	2.8	0.08	SPECIAL PIT
B03/20	1.8 m lintel	0.101	85	5	5	15	94	54	41	110	0.7	3	B03/21	94	3.19	0.08	SPECIAL PIT
B03/21	2.4 m lintel sag	0.134	85	5	5	10	102	100	0	122	0.4	2	B02/12	0	1.56	0.01	SPECIAL PIT
B04/1	1.8 m lintel	0.04	95	5	5	15	21	17	4	58	0.7	3	B04/2	12	2.17	0.01	
B04/2	1.8 m lintel	0.015	95	5	5	15	12	9	2	91	0.7	3	B26/1	77	2.72	0.07	
B04/3	1.8 m lintel	0.003	95	5	5	15	2	1	0	68	0.7	3	B04/4	21	1.4	0.04	
B04/4	1.8 m lintel	0.039	95	5	5	15	21	16	4	65	0.7	3	B04/5	25	1.46	0.05	
B04/5	1.8 m lintel	0.042	95	5	5	15	25	20	5	70	2.7	3	B04/6	45	3.43	0.06	
B04/6	2.4 m lintel sag	0.102	85	5	5	15	71	62	118	129	1.5	3.4	B04/7	121			
B04/7	2.4 m lintel sag	0.132	85	5	5	15	155	140	1	150	0.8	2.8	B04/8	2	1.6	0	SPECIAL PIT
B04/8	1.8 m lintel	0.006	95	5	5	15	2	2	0	82	0.7	3	B75/1	41	1.85	0.05	SPECIAL PIT
B05/1	1.8 m lintel	0.036	95	5	5	15	25	19	6	88	0.7	3	B05/2	50	2.51	0.05	
B05/2	1.8 m lintel	0.085	85	5	5	15	50	34	16	102	0.7	3	B05/3	80	2.65	0.08	
B05/3	2.4 m lintel	0.123	85	5	5	15	80	54	27	106	0.7	3	B05/4	91	3.64	0.09	
B05/4	2.4 m lintel	0.12	85	5	5	15	91	63	182	135	0.7	3	B05/5	202	5.68	0.1	
B05/5	2.4 m lintel sag	0.079	85	5	5	15	221	192	0	190	1.3	2.9	B05/6	28			
B05/6	2.4 m lintel sag	0.059	95	5	5	10	438	54	0	84	0.4	2.3	B05/7	0	0.5	2.36	SPECIAL PIT
B05/7	1.8 m lintel	0.005	95	5	5	15	0	0	0	41	0.7	3.7	B50/1	555	0.97	0.02	SPECIAL PIT
B05/8	1.8 m lintel	0.01	95	5	5	15	5	4	1	71	1.1	3	B05/9	26	1.97	0.03	SPECIAL PIT
B05/9	1.8 m lintel	0.047	85	5	5	15	26	20	6	85	0.7	3	B05/10	44	2.4	0.05	
B05/10	1.8 m lintel	0.073	85	5	5	15	44	32	12	98	0.7	3	B05/11	72	2.4	0.08	
B05/11	1.8 m lintel	0.115	85	5	5	15	72	48	24	94	0.7	3	B05/12	62	2.47	0.06	
B05/12	1.8 m lintel	0.074	85	5	5	15	62	39	22	100	0.7	3	B76/1	81	2.47	0.08	
B05/13	1.8 m lintel	0.082	85	5	5	15	43	32	12	77	0.7	3	B72/1	53	2.94	0.05	
B05/14	1.8 m lintel	0.007	95	5	5	15	4	3	1	77	1.7	3	B05/15	65	2.65	0.08	SPECIAL PIT
B05/15	2.4 m lintel sag	0.121	85	5	5	15	72	72	0	106	1.6	2.8	B55/1	0	11.99	0	SPECIAL PIT
B08/1	1.8 m lintel	0.041	95	5	5	10	27	21	6	32	0.7	3	LOST	20	1.26	0.04	SPECIAL PIT
B08/2	1.8 m lintel	0.138	85	5	5	15	73	49	24	65	0.7	3	B08/3	35	1.78	0.05	SPECIAL PIT
B08/3	1.8 m lintel	0.02	95	5	5	15	35	26	8	79	1.1	3	B08/4	39	2.23	0.04	SPECIAL PIT
B08/4	1.8 m lintel	0.058	85	5	5	15	39	29	10	93	0.9	3	B08/5	66	2.47	0.07	
B08/5	1.8 m lintel	0.108	85	5	5	15	66	41	25	100	0.9	3	B08/6	85	2.84	0.09	
B08/6	2.4 m lintel	0.115	85	5	5	15	85	56	28	112	0.9	3	B08/7	121	2.84	0.11	
B08/7	2.4 m lintel	0.116	85	5	5	15	121	62	26	106	0.9	3	B08/8	102	3.15	0.08	
B08/8	1.8 m lintel	0.082	85	5	5	15	102	46	103	121	0.9	3	B08/9	154	5.86	0.08	
B08/9	2.4 m lintel sag	0.113	85	5	5	15	215	214	0	198	0.5	2.7	B77/1	0			SPECIAL PIT
B08/10	1.8 m lintel	0.003	95	5	5	15	1	1	0	71	0.7	3.5	B08/9	27	5.86	0.03	SPECIAL PIT
B08/11	2.4 m lintel sag	0.149	85	5	5	10	75	75	0	103	0.2	3	B08/10	0	1.34	0.01	SPECIAL PIT
B08/12	1.8 m lintel	0.007	95	5	5	15	2	1	0	104	0.7	3.9	B08/11	79	2.59	0.07	SPECIAL PIT
B08/13	1.8 m lintel	0.005	95	5	5	15	3	2	1	85	0.7	3	B08/14	44	1.99	0.06	SPECIAL PIT
B08/14	1.8 m lintel	0.082	85	5	5	15	44	32	12	86	0.7	3	B08/15	49	3.22	0.05	SPECIAL PIT
B08/15	2.4 m lintel sag	0.169	85	5	5	10	101	101	0	123	0.6	3.9	B44/1	0			SPECIAL PIT
B08/16	1.8 m lintel	0.075	85	5	5	15	10	8	2	88	1	3	B08/15	52	3.22	0.04	SPECIAL PIT
B08/17	2.4 m lintel sag	0.227	85	5	5	15	121	121	0	154	0.1	3	B08/16	0	2.05	0	SPECIAL PIT
B08/18	1.8 m lintel	0	0	0	0	15	0	0	0	121	-0.2	3	B08/17	66			SPECIAL PIT
B08/19	1.8 m lintel	0.002	95	5	5	10	6	5	1	164	0.7	3	B99/1	1	0.3	0.03	SPLITTER/SPECIAL PIT
B08/20	NODE	0	0	0	0	10	0	0	0	0							GPT INLET
B08/21	GPT	0	0	0	0	10	0	0	0	0							GPT VORTEX
B08/22	NODE	0	0	0	0	10	0	0	0	0							GPT OUTLET
B08/23	JP SEALED 900 x 900	0	0	0	0	10	0	0	0	0							SPLITTER PIT
B08/24	JP SEALED 900 x 900	0	0	0	0	10	0	0	0	0							
B10/1	1.8 m lintel	0.09	85	5	5	15	16	13	3	109	1	3	B43/1	107	5.34	0.07	
B10/2	1.8 m lintel	0.111	85	5	5	15	21	16	4	98	1	3	B10/3	72	2.58	0.07	
B10/3	2.4 m lintel sag	0.133	85	5	5	15	76	76	0	104	0.6	3.8	B10/4	0	1.63	0.01	

 DRAINAGE TABLE UPDATED

Plotfile: 14 September, 2021 12:51:55 PM File Name: J:\9985ED\CC - Construction Certificate Approval Plans\PK12 WESTERN PRECINCTS\5 - Precinct 7\9985-12-CC5417.dwg

B	DRAINAGE TABLE UPDATED	DG	VS	MP	MS	14/09/21
A	ISSUE FOR APPROVAL	DG	VS	MP	PJM	12/08/21
	AMENDMENT	DES	DRN	CKD	APR	DATE

Plotfile: 14 September, 2021 12:52:14 PM File Name: J:\9985D\CC - Construction Certificate Approval Plans\PK12 WESTERN PRECINCTS5 - Precinct 7\9985-12-CC5418.dwg

DESIGN STORM 1% AEP HYDROLOGIC RESULTS																	
PIT NAME (-)	PIT TYPE (-)	CATCHMENT AREA (Ha)	PERCENT IMPERVIOUS (%)	Tc IMP (min)	Tc PERV (min)	CRITICAL STORM (min)	APPROACH FLOW (L/s)	CAPTURED FLOW (L/s)	UNCAPTURED FLOW (L/s)	GRATE DEPTH (mm)	ROAD GRADE (%)	ROAD CROSSFALL (%)	BYPASS PIT (-)	FLOW AT BYPASS PIT (L/s)	FLOW WIDTH AT BYPASS PIT (m)	VxD AT BYPASS PIT (m/s ²)	COMMENTS (-)
B10/4	1.8 m lintel	0.003	95	5	5	15	1	1	0	75	0.7	2.9	B02/8	32	2.66	0.03	
B11/1	2.4 m lintel sag	0.035	95	5	5	10	6	6	0	22	0.1	3	LOST	0			
B11/2	2.4 m lintel sag	0.113	85	5	5	15	30	30	0	61	0.1	3	B11/1	0	0	0	
B19/12	2.4 m lintel	0.05	85	5	5	15	54	39	15	75	1.7	3	B19/13	45	1.75	0.07	
B19/13	1.8 m lintel	0.057	85	5	5	15	45	30	14	79	1.7	3	B19/14	53	5.57	0.04	
B19/14	2.4 m lintel sag	0.128	85	5	5	15	99	99	0	186	0.8	3.1	B19/15	104			
B19/15	2.4 m lintel sag	0.124	85	5	5	15	151	141	0	151	0.8	4	B02/15	0	0	0	
B19/16	1.8 m lintel	0.094	85	5	5	15	41	30	11	71	0.7	3	B19/15	31	4.32	0.03	
B20/1	2.4 m lintel sag	0.078	85	5	5	15	50	50	0	91	0.9	2.9	B02/17	0			
B26/1	2.4 m lintel	0.143	85	5	5	15	77	56	21	108	0.7	3	B06/2	91	5.57	0.06	
B26/2	1.8 m lintel	0.049	95	5	5	15	26	20	6	53	0.7	3	B06/5	17	1.41	0.04	SPECIAL PIT
B31/1	1.8 m lintel	0.046	95	5	5	15	25	20	5	64	0.7	3	B05/1	25	2.06	0.03	
B32/1	1.8 m lintel	0.039	95	5	5	15	21	16	4	55	0.7	3	B58/1	23	0.98	0.06	
B37/1	2.4 m lintel	0.108	85	5	5	15	94	61	33	112	0.7	3	B03/19	113	2.87	0.1	
B39/1	1.8 m lintel	0.057	85	5	5	15	33	24	9	77	0.8	3	B20/1	31	2.15	0.04	
B43/1	2.4 m lintel sag	0.201	85	5	5	15	107	107	0	177	0.7	3.9	B48/1	0	0	0	
B44/1	2.4 m lintel sag	0.045	95	5	5	10	9	9	0	30	0.6	3.8	LOST	0	0	0	
B45/1	2.4 m lintel sag	0.032	95	5	5	15	17	17	0	58	0.2	3	B11/1	0	0	0	
B46/1	2.4 m lintel sag	0.182	85	5	5	15	95	95	0	140	0.1	3	B02/13	0	0	0	
B48/1	1.8 m lintel	0.049	85	5	5	15	7	6	1	110	1	3	B46/1	95	3.79	0.06	
B49/1	1.8 m lintel	0.048	95	5	5	15	25	20	5	64	1.8	3	B08/1	27	1.25	0.06	
B49/2	1.8 m lintel	0.062	85	5	5	15	33	25	8	60	1.8	3	B05/5	30	5.68	0.04	
B50/1	1.8 m lintel	0.033	95	5	5	15	5	4	1	55	0.7	3	B73/2	19	5.03	0.04	
B51/1	2.4 m lintel sag	0.031	95	5	5	15	17	17	0	60	0.1	3	B44/1	0	0	0	
B55/1	2.4 m lintel sag	0.119	85	5	5	10	87	77	7	104	1.7	2.6	B08/12	9	2.6	0.01	
B56/1	1.8 m lintel	0.081	95	5	5	15	44	30	79	86	0.7	3	B05/6	42	1.99	0.06	
B58/1	1.8 m lintel	0.036	95	5	5	15	23	18	5	56	2.3	3	B58/2	13	1.21	0.03	
B58/2	2.4 m lintel sag	0.124	85	5	5	10	29	29	0	62	0.2	3	B58/3	0	0	0	
B58/3	1.8 m lintel	0.042	95	5	5	15	18	14	4	53	0.7	3.3	B58/4	12	1.85	0.03	
B58/4	1.8 m lintel	0.019	95	5	5	15	12	9	38	82	0.9	3	B59/1	38	1.99	0.05	
B59/1	1.8 m lintel	0.017	95	5	5	15	38	29	10	86	0.7	3	B60/1	46	2.58	0.04	
B60/1	1.8 m lintel	0.083	85	5	5	15	46	31	15	104	0.7	3	B02/9	82	3.65	0.08	
B61/1	1.8 m lintel	0.105	85	5	5	15	57	39	18	81	1.3	3	B19/14	46	5.53	0.04	
B61/2	1.8 m lintel	0.049	95	5	5	15	26	20	6	53	1	3	B61/3	14	1.73	0.02	
B61/3	1.8 m lintel	0.017	95	5	5	15	14	12	3	78	0.9	3	B39/1	33	1.73	0.05	
B65/1	2.4 m lintel sag	0.144	85	5	5	15	108	108	0	199	0.8	2.8	B06/11	34			
B66/1	1.8 m lintel	0.117	85	5	5	15	77	49	28	83	1.5	3	B19/15	61	4.32	0.06	
B67/1	1.8 m lintel	0.066	85	5	5	15	36	26	10	95	0.9	3	B68/1	71	2.38	0.08	
B68/1	2.4 m lintel	0.115	85	5	5	15	71	49	22	98	0.9	3	B69/1	77	2.53	0.08	
B69/1	1.8 m lintel	0.107	85	5	5	15	77	51	27	102	0.9	3	B70/1	90	2.53	0.09	
B70/1	2.4 m lintel	0.124	85	5	5	15	90	63	27	98	0.9	3	B71/1	78	2.41	0.08	
B71/1	1.8 m lintel	0.082	85	5	5	15	78	48	23	99	0.9	3	B77/1	79	5.73	0.06	
B72/1	2.4 m lintel sag	0.079	85	5	5	15	53	53	0	114	0.6	3	B10/2	0	0	0	
B72/2	2.4 m lintel sag	0.065	85	5	5	15	35	35	0	95	0.4	3	B10/1	0	0	0	SPECIAL PIT
B73/1	1.8 m lintel	0.039	85	5	5	15	7	5	42	101	0.7	3	B02/1	66	3.33	0.05	
B73/2	2.4 m lintel sag	0.034	85	5	5	15	23	23	0	164	0.7	2.8	B73/1	0	2.5	0.01	
B73/3	2.4 m lintel sag	0.112	85	5	5	15	60	60	0	144	0.4	2.7	B02/3	0	0	0	SPECIAL PIT
B73/4	1.8 m lintel	0.003	95	5	5	15	2	2	0	87	0.7	3.9	B05/13	43	2.02	0.06	SPECIAL PIT
B75/1	1.8 m lintel	0.077	85	5	5	15	38	27	11	71	0.7	3	B75/2	23	1.5	0.04	
B75/2	2.4 m lintel sag	0.067	85	5	5	15	23	23	0	68	0.5	2.9	B03/21	0	7.12	0.08	
B76/1	2.4 m lintel	0.113	85	5	5	15	81	52	28	82	1.2	3	B55/1	80	2.59	0.1	
B77/1	2.4 m lintel sag	0.118	85	5	5	15	79	79	0	192	0.5	2.6	B11/2	45	0	0	
B78/1	2.4 m lintel sag	0.03	95	5	5	10	17	16	0	43	0.1	3	LOST	0	0	0	
B99/1	NODE		0			15	1	0	0	27	0.2	3	B78/1	8	0.48	0.01	SPLITTER PIT INTERNAL WEIR
B99/2	JP SEALED 900 x 900		0			10	0	0	0	0							
C01/1	1.8 m lintel	0.107	85	5	5	15	57	37	20	100	0.7	3	C01/2	61	2.8	0.05	
C01/2	1.8 m lintel	0.08	85	5	5	15	61	42	19	109	0.7	3	C01/3	78	5.67	0.05	
C01/3	2.4 m lintel sag	0.222	85	5	5	15	157	155	0	191	0.2	3	C01/4	92			
C01/4	1.8 m lintel	0.096	95	5	5	15	117	67	50	85	1.2	3	C01/5	52	2.79	0.05	
C01/5	1.8 m lintel	0.019	95	5	5	15	52	16	60	109	1.1	3	C01/6	83	2.79	0.07	

B DRAINAGE TABLE UPDATED

I hereby certify that engineering works shown on this plan have been constructed generally in accordance with Construction Certificate 16635 issued by Land Development Certificates

Signature: 
PETER ROBERT WARWICK
Registered Land Surveyor
VINCE MORGAN SURVEYORS PTY LTD

DATE 20/12/2022 REF 20260-7

These plans are referred to in certificate no. 16635 approved by:
 **Christopher Louis Wahbe**
Registered Certifier
Registration No: BDC 3015
Categories: Certifier - Subdivision
Land Development Certificates
www.LDC.com.au

B	DRAINAGE TABLE UPDATED	DG	VS	MP	MS	14/09/21
A	ISSUE FOR APPROVAL	DG	VS	MP	PJM	12/08/21
	AMENDMENT	DES	DRN	CKD	APR	DATE

J. WYNDHAM PRINCE
CONSULTING CIVIL INFRASTRUCTURE ENGINEERS & PROJECT MANAGERS

PO Box 4366 PENRITH WESTFIELD NSW 2750
P 02 4720 3300 W www.jwprince.com.au E jwp@jwprince.com.au

CLIENT:  **WINTER PROPERTY GROUP**

STATUS: **ISSUE FOR CONSTRUCTION APPROVAL**

THIS DRAWING MUST NOT BE USED FOR CONSTRUCTION UNLESS SIGNED AS PART OF AN APPROVED CONSTRUCTION CERTIFICATE.

NEWPARK PRECINCT 7, STAGE 7B DRAINAGE CALCULATIONS SHEET 8

AZIMUTH: M.G.A.94 DATUM: A.H.D. ORIGIN: SSM 1112 PLAN No: 9985-12-CC5418

PROJECT No: **9985-12**
SHEET No: **CC5418**

Plotfile: 14 September, 2021 12:52:33 PM File Name: J:\9985D\CC - Construction Certificate Approval Plans\K12 WESTERN PRECINCTS 5 - Precinct 7\B0985-12-CC5419.dwg

DESIGN STORM 1% AEP HYDRAULIC RESULTS																					
PIPE NAME	PIPE DIAMETER (mm)	PIPE TYPE	PIPE LENGTH (m)	PIPE GRADE (%)	CRITICAL STORM (min)	PEAK FLOW (L/s)	CAPACITY RATIO (-)	PEAK VELOCITY (m/s)	PIPE U/S IL (m)	PIPE D/S IL (m)	PIPE D/S DROP (m)	U/S PIT (-)	D/S PIT (-)	PIT LOSS (Ku.V/head)	WSE LOSS (m)	U/S PIPE HGL (m)	D/S PIPE HGL (m)	HGL GRADE (%)	MINIMUM COVER (m)	MINIMUM FREEBOARD (m)	COMMENTS
A04/6 to A04/7	450	RRJ2	19.89	1	10	334	1.08	2.1	17.239	17.04	0.05	1.2	1.26	0.22	0.23	18.899	18.789	0.55	1.39	-0.073	
A04/7 to A04/8	525	RRJ2	15.6	1	10	447	0.96	2.13	16.99	16.834	0.05	1.15	1.2	0.25	0.26	18.619	18.515	0.67	1.46	0.042	
A04/8 to A04/9	600	RRJ2	43.15	1	20	394	0.59	2.14	16.784	16.353	0.05	0.38	0.39	0.1	0.04	18.481	18.338	0.33	1.57	0.488	
A37/1 to A04/7	375	RRJ2	9	2	15	107	0.4	1.15	17.366	17.186	0.196	4.5	4.5	0.22	0.22	18.816	18.798	0.2	1.1	-0.145	
B02/1 to B02/2	375	RRJ2	13.62	1	20	35	0.18	0.52	17.834	17.698	0.05	4.5	4.5	0.08	0.02	19.409	19.414	-0.04	1.1	-0.124	
B02/2 to B02/3	375	RRJ2	9	1	25	139	0.73	1.26	17.648	17.558	0.05	5.35	5.34	0.27	0.28	19.322	19.296	0.29	1.24	-0.192	
B02/3 to B02/4	375	RRJ2	28.83	1	10	134	0.71	1.45	17.508	17.219	0.05	2.15	2.6	0.18	0.19	19.215	19.111	0.36	1.31	-0.074	
B02/4 to B02/5	375	RRJ2	15.29	1	20	138	0.73	1.25	17.169	17.016	0.05	0.58	0.58	0.07	0.05	19.079	19.057	0.14	1.73	0.254	
B02/5 to B02/6	450	RRJ2	23.62	0.5	20	234	1.07	1.47	16.966	16.848	0.03	1.37	1.45	0.11	0.11	19.01	18.888	0.52	1.48	-0.084	
B02/6 to B02/7	525	RRJ2	22.84	0.5	20	290	0.88	1.36	16.818	16.704	0.05	0.78	0.82	0.06	0.06	18.85	18.745	0.46	1.39	-0.088	
B02/7 to B02/8	525	RRJ2	26.71	0.5	25	331	1	1.53	16.654	16.521	0.05	0.64	0.66	0.07	0.07	18.708	18.612	0.36	1.54	-0.098	
B02/8 to B02/9	600	RRJ2	12.12	0.8	20	394	0.66	1.39	16.471	16.374	0.05	6.98	1.15	0.1	0.1	18.538	18.515	0.19	1.41	-0.148	
B02/9 to B02/10	600	RRJ2	14.35	0.5	25	460	0.98	1.63	16.324	16.252	0.058	0.93	0.93	0.12	0.12	18.423	18.385	0.26	1.62	-0.136	
B02/10 to B02/11	750	RRJ2	15.07	0.5	25	617	0.72	1.54	16.194	16.119	0.05	0.37	0.38	0.04	0.04	18.356	18.324	0.21	1.56	0.177	
B02/11 to B02/12	750	RRJ2	47.67	0.5	25	713	0.84	1.78	16.069	15.831	0.05	0.78	0.84	0.11	0.09	18.253	18.098	0.33	1.62	0.166	
B02/12 to B02/13	(2x)1200	RRJ2	10.9	0.5	20	4033	0.68	1.82	15.781	15.726	0.05	0.27	0.25	0.04	0.04	18.058	18.033	0.23	1.52	0.428	
B02/13 to B02/14	(2x)1200	RRJ2	35.16	0.5	20	4039	0.68	1.79	15.676	15.5	0.05	1.04	1.01	0.15	0.16	17.88	17.8	0.23	1.52	0.497	
B02/14 to B02/15	(2x)1200	RRJ2	15.38	0.5	25	4695	0.79	2.08	15.45	15.373	0.05	0.69	0.7	0.15	0.15	17.649	17.602	0.31	1.47	0.484	
B02/15 to B02/16	(2x)1200	RRJ2	20.22	0.5	25	4744	0.79	2.1	15.323	15.222	0.03	0.57	0.57	0.13	0.13	17.474	17.41	0.32	1.32	0.349	
B02/16 to B02/17	(2x)1200	RRJ2	20.27	0.5	25	4839	0.81	2.14	15.192	15.091	0.05	0.22	0.22	0.05	0.05	17.359	17.292	0.33	1.33	0.395	
B02/17 to B02/18	(2x)1200	RRJ2	14.15	0.5	25	4904	0.82	2.17	15.041	14.97	0.05	0.62	0.62	0.15	0.15	17.145	17.097	0.34	1.56	0.424	
B02/18 to B02/19	(2x)1200	RRJ2	26.18	0.5	25	4931	0.83	2.18	14.92	14.789	0.05	0.64	0.64	0.16	0.16	16.943	16.853	0.34	1.6	0.693	
B02/19 to B02/20	(2x)1200	RRJ2	10.48	1	25	4940	0.58	2.18	14.739	14.634	0.084	1.1	1.14	0.26	0.27	16.593	16.557	0.34	2.04	1.144	
B03/15 to B03/16	1050	RRJ2	40.53	0.6	20	2054	0.9	2.43	16.948	16.704	0.03	0.31	0.26	0.09	0.07	19.292	19.1	0.47	1.48	0.217	
B03/16 to B03/17	1050	RRJ2	30.6	0.6	20	2113	0.92	2.44	16.674	16.491	0.043	0.28	0.27	0.07	0.07	19.03	18.876	0.5	1.48	0.198	
B03/17 to B03/18	1350	RRJ2	40.57	0.5	20	2903	0.71	2.03	16.448	16.245	0.05	0.25	0.23	0.07	0.05	18.831	18.734	0.24	1.14	0.208	
B03/18 to B03/19	1350	RRJ2	12.42	0.5	20	2920	0.71	2.04	16.195	16.133	0.03	0.86	0.88	0.17	0.17	18.572	18.541	0.25	1.23	0.067	
B03/19 to B03/20	1350	RRJ2	26.82	0.3	20	2953	0.93	2.06	16.103	16.022	0.03	0.51	0.51	0.1	0.1	18.442	18.374	0.25	1.25	0.2	
B03/20 to B03/21	1350	RRJ2	34.19	0.3	20	3218	1.02	2.35	15.992	15.89	0.03	0.31	0.31	0.09	0.07	18.305	18.205	0.29	1.04	0.167	
B03/21 to B02/12	(2x)1200	RRJ2	15.24	0.3	20	3336	0.72	1.48	15.86	15.814	0.034	0.78	0.78	0.08	0.08	18.13	18.107	0.15	1.38	0.144	
B04/1 to B04/2	375	RRJ2	17.94	1	15	148	0.78	1.45	19.627	19.447	0.03	1.74	1.98	0.16	0.18	20.004	19.939	0.36	1.4	1.341	
B04/2 to B04/3	375	RRJ2	30.49	1	15	177	0.93	1.8	19.417	19.113	0.03	0.44	0.43	0.07	0.05	19.909	19.766	0.47	1.48	1.378	
B04/3 to B04/4	375	RRJ2	49.33	1	15	167	0.88	1.82	19.083	18.589	0.03	0.24	0.23	0.03	0.03	19.75	19.515	0.48	1.6	1.339	
B04/4 to B04/5	375	RRJ2	53.43	1	20	192	1.01	1.84	18.559	18.025	0.03	0.66	0.57	0.06	0.09	19.476	19.134	0.64	1.6	1.244	
B04/5 to B04/6	375	RRJ2	50.69	1.84	10	183	0.71	1.98	17.995	17.064	0.05	0.71	0.6	0.07	0.08	19.096	18.707	0.77	1.12	0.871	
B04/6 to B04/7	450	RRJ2	9.79	2	10	218	0.5	1.42	17.014	16.819	0.05	1.71	1.92	0.16	0.17	18.673	18.667	0.06	1.13	-0.129	
B04/7 to B04/8	450	RRJ2	16.3	1	20	276	0.89	1.74	16.769	16.606	0.05	1.45	1.45	0.18	0.18	18.51	18.451	0.36	1.44	-0.15	
B04/8 to B03/20	450	RRJ2	11.94	2	20	282	0.65	2.29	16.556	16.317	0.324	0.3	0.3	0.11	0.05	18.426	18.374	0.44	1.6	0.145	
B05/1 to B05/2	375	RRJ2	28.43	1	20	92	0.49	1.39	19.297	19.013	0.05	1.93	2.19	0.14	0.08	20.515	20.471	0.15	1.11	0.124	
B05/2 to B05/3	375	RRJ2	36.07	1	10	108	0.57	1.37	18.963	18.602	0.05	1.56	1.56	0.12	0.06	20.437	20.32	0.32	1.24	-0.096	
B05/3 to B05/4	375	RRJ2	33.13	1	15	136	0.71	1.38	18.552	18.221	0.03	1.72	1.71	0.14	0.1	20.254	20.118	0.41	1.24	-0.106	
B05/4 to B05/5	450	RRJ2	15.89	1	10	291	0.94	1.83	18.191	18.032	0.05	1.62	1.78	0.25	0.27	20.076	20.065	0.07	1.29	-0.135	
B05/5 to B05/6	525	RRJ2	9.02	2	10	341	0.52	1.58	17.982	17.801	0.05	2.03	2.53	0.25	0.3	19.9	19.878	0.24	1.4	-0.19	
B05/6 to B05/7	525	RRJ2	15.44	1	10	386	0.83	1.88	17.751	17.597	0.05	0.94	0.94	0.15	0.15	19.797	19.733	0.41	1.79	0.039	
B05/7 to B05/8	525	RRJ2	10.6	2	10	385	0.58	2.39	17.547	17.335	0.05	0.31	0.42	0.16	0.05	19.701	19.648	0.5	1.98	0.307	
B05/8 to B05/9	525	RRJ2	15.5	1	10	387	0.83	1.86	17.285	17.13	0.03	1.15	1.21	0.19	0.2	19.537	19.459	0.5	2.14	0.355	
B05/9 to B05/10	525	RRJ2	21.56	1	10	399	0.86	2.07	17.1	16.884	0.03	0.36	0.36	0.1	0.06	19.425	19.308	0.54	2.2	0.413	
B05/10 to B05/11	600	RRJ2	32.11	1	20	412	0.62	1.67	16.854	16.533	0.03	0.51	0.55	0.14	0.04	19.28	19.182	0.31	2.21	0.414	
B05/11 to B05/12	600	RRJ2	23.12	1	20	612	0.92	2.16	16.503	16.272	0.05	0.79	0.79	0.15	0.15	19.101	18.931	0.74	2.34	0.315	
B05/12 to B05/13	600	RRJ2	10.62	2	20	630	0.67	2.23	16.222	16.01	0.05	1.18	1.24	0.24	0.25	18.71	18.625	0.8	2.52	0.404	
B05/13 to B05/14	600	RRJ2	31.89	0.7	20	647	1.16	2.29	15.96	15.737	0.03	0.95	0.97	0.25	0.26	18.393	18.122	0.85	2.63	0.67	
B05/14 to B05/15	675	RRJ2	41.08	0.65	25	774	1.05	2.16	15.707	15.44	0.05	1.17	0.51	0.09	0.09	18.044	17.777	0.65	1.59	0.869	
B05/15 to B08/13	675	RRJ2	14.96	0.65	25	891	1.21	2.49	15.39	15.292	0.068	0.86	0.84	0.24	0.25	17.537	17.372	1.1	1.81	-0.101	
B08/1 to B08/2	375	RRJ2	15.92	1	20	102	0.53	1.21	18.244	18.085	0.05	1.13	1.13	0.1	0.05	19.34	19.311	0.18	1.1	0.353	
B08/2 to B08/3	375	RRJ2	14.76	1.42	20	146	0.65	1.62	18.035	17.825	0.18	1.59	1.95	0.16	0.13	19.262	19.211	0.35	1.12	0.311	
B08/3 to B08/4	375	RRJ2	25.65	1	10	148	0.78	1.49	17.644	17.388	0.03	1.14	1.14	0.13	0.1	19.153	19.033	0.47	1.1	-0.074	
B08/4 to B08/5	375	RRJ2	31.66	1	10	173	0.91	1.68	17.358	17.041	0.03	0.8	0.76	0.1	0.09	18.979	18.765	0.68	1.17	-0.089	
B08/5 to B08/6	450	RRJ2	32.75	1	10	229	0.74	1.66	17.011	16.684	0.03	0.98	1.18								

Plotfile: 14 September, 2021 12:52:50 PM File Name: J:\9985D\CC - Construction Certificate Approval Plans\PK12 WESTERN PRECINCTS5 - Precinct 7\B0985-12-CC5420.dwg

DESIGN STORM 1% AEP HYDRAULIC RESULTS																					
PIPE NAME (-)	PIPE DIAMETER (mm)	PIPE TYPE	PIPE LENGTH (m)	PIPE GRADE (%)	CRITICAL STORM (min)	PEAK FLOW (L/s)	CAPACITY RATIO (-)	PEAK VELOCITY (m/s)	PIPE U/S IL (m)	PIPE D/S IL (m)	PIPE D/S DROP (m)	U/S PIT (-)	D/S PIT Kw	PIT LOSS (Ku.V/head) (m)	WSE LOSS (Kw.V/head) (m)	U/S PIPE HGL (m)	D/S PIPE HGL (m)	HGL GRADE (%)	MINIMUM COVER	MINIMUM FREEBOARD (m)	COMMENTS
B10/3 to B10/4	450	RRJ2	22.22	1	10	194	0.63	1.54	16.836	16.614	0.05	1.99	2.34	0.19	0.18	18.561	18.507	0.24	1.25	-0.099	
B10/4 to B02/10	450	RRJ2	31.97	1	25	159	0.51	1.29	16.564	16.244	0.05	0.24	0.24	0.04	0.01	18.497	18.418	0.25	1.68	0.222	
B11/1 to B11/2	375	RRJ2	9	1	20	-112	-0.59	1.04	16.263	16.173	0.05	4.5	4.5	0.07	0.01	17.722	17.732	-0.11	1.1	-0.021	
B11/2 to B08/10	375	RRJ2	50.35	0.75	20	-120	-0.73	1.09	16.123	15.746	0.042	2.21	1.89	0.14	0.08	17.723	17.675	0.1	1.17	-0.057	
B19/12 to B19/13	525	RRJ2	22.17	1.13	20	513	1.03	2.41	17.309	17.058	0.148	0.53	0.53	0.15	0.15	18.728	18.501	1.02	1.1	0.119	
B19/13 to B19/14	600	RRJ2	27.03	1.58	25	527	0.63	2.38	16.911	16.484	0.146	0.51	0.5	0.17	0.08	18.436	18.271	0.61	1.1	0.052	
B19/14 to B19/15	675	RRJ2	9	2	10	589	0.46	1.65	16.339	16.159	0.05	2.06	2.57	0.28	0.34	18.123	18.1	0.26	1.1	-0.186	
B19/15 to B19/16	675	RRJ2	15.14	1	10	665	0.73	2.05	16.109	15.957	0.05	1.12	1.12	0.19	0.2	17.948	17.879	0.46	1.44	-0.151	
B19/16 to B02/14	750	RRJ2	9	2	25	657	0.38	2.29	15.907	15.727	0.277	0.59	0.59	0.25	0.06	17.83	17.811	0.21	1.64	0.405	
B20/1 to B02/17	375	RRJ2	9.1	2	10	-94	-0.35	1.03	16.239	16.057	1.016	4.5	4.5	0.23	0.08	17.299	17.298	0.01	1.1	0.377	
B26/1 to B26/2	375	RRJ2	10.93	2	20	55	0.2	1.14	19.177	18.959	0.05	4.5	4.5	0.18	0.06	20.232	20.226	0.05	1.1	0.36	
B26/2 to B06/5	375	RRJ2	14.9	1	10	76	0.4	1.29	18.909	18.76	0.492	1.19	1.19	0.11	0.03	20.214	20.201	0.09	1.15	0.36	
B31/1 to B04/2	375	RRJ2	9.16	2	15	19	0.07	1	19.88	19.697	0.279	4.5	4.5	0.08	0.01	19.905	19.939	-0.37	1.1	1.344	
B32/1 to B04/4	375	RRJ2	12.63	2	25	18	0.07	1.03	19.357	19.105	0.545	4.5	4.5	0.08	0.01	19.509	19.515	-0.05	1.1	1.3	
B37/1 to B03/17	375	RRJ2	9.01	2	20	61	0.23	1.19	17.649	17.469	1.021	4.5	4.5	0.2	0.07	18.877	18.876	0.01	1.1	0.176	
B39/1 to B02/16	375	RRJ2	9	2	10	152	0.57	1.65	16.358	16.178	0.986	1.29	1.13	0.16	0.08	17.434	17.417	0.19	1.1	0.348	
B43/1 to B10/3	375	RRJ2	9	2	25	118	0.44	1.22	17.133	16.953	0.117	4.5	4.5	0.26	0.26	18.631	18.627	0.04	1.1	-0.177	
B44/1 to B08/15	375	RRJ2	9	2	10	-87	-0.32	0.93	16.224	16.044	1.014	4.5	4.5	0.35	0.08	17.19	17.186	0.04	1.1	0.461	
B45/1 to B08/11	375	RRJ2	9	2	10	-69	-0.26	1.04	16.36	16.18	0.595	4.5	4.5	0.16	0.05	17.565	17.564	0.01	1.1	0.225	
B46/1 to B02/11	375	RRJ2	9	2	20	114	0.42	1.29	17.051	16.871	0.803	4.5	4.5	0.24	0.25	18.371	18.348	0.26	1.1	-0.13	
B48/1 to B02/10	375	RRJ2	9.27	2	10	-56	-0.21	0.78	17.132	16.947	0.753	4.5	2.09	0.27	0.03	18.419	18.418	0.01	1.1	0.165	
B49/1 to B49/2	375	RRJ2	9.18	2	15	-22	-0.08	0.99	19.118	18.935	0.05	4.5	4.5	0.09	0.01	19.748	19.747	0.01	1.1	0.82	
B49/2 to B05/7	375	RRJ2	30.51	1.18	15	55	0.27	1.27	18.885	18.524	0.977	7	3.33	0.12	0.03	19.74	19.733	0.02	1.1	0.792	
B50/1 to B05/10	375	RRJ2	9.07	2	15	-41	-0.15	0.73	18.281	18.099	1.245	4.5	4.5	0.16	0.02	19.308	19.308	0	1.1	0.421	
B51/1 to B08/17	375	RRJ2	9	2	10	30	0.11	1.05	16.362	16.182	1.43	4.5	4.5	0.12	0.02	16.895	16.889	0.07	1.1	0.898	
B55/1 to B05/15	375	RRJ2	9.5	2	15	-85	-0.32	1.18	16.344	16.154	0.765	4.5	4.5	0.18	0.11	17.766	17.777	-0.12	1.1	-0.102	
B56/1 to B05/3	375	RRJ2	9.53	1.8	10	32	0.13	0.92	18.785	18.613	0.061	4.5	4.5	0.12	0.02	20.319	20.32	-0.01	1.1	-0.086	
B58/1 to B58/2	375	RRJ2	13.09	1	20	92	0.49	1.16	17.883	17.752	0.05	2.15	2.63	0.11	0.09	19.191	19.178	0.1	1.1	0.14	
B58/2 to B58/3	375	RRJ2	9.02	2	10	110	0.41	1.38	17.702	17.522	0.05	2.11	2.54	0.16	0.13	19.133	19.115	0.2	1.16	0.024	
B58/3 to B58/4	375	RRJ2	14.71	1	10	121	0.64	1.49	17.472	17.325	0.05	0.93	1.08	0.09	0.05	19.09	19.055	0.24	1.42	0.073	
B58/4 to B02/5	375	RRJ2	9	2	10	98	0.36	1.52	17.275	17.095	0.128	1.05	1.07	0.13	0.04	19.036	19.057	-0.23	1.35	-0.082	
B59/1 to B02/6	375	RRJ2	9.4	2	10	100	0.37	1.77	17.376	17.188	0.369	0.69	1.09	0.11	0.02	18.897	18.888	0.1	1.1	-0.081	
B60/1 to B02/7	375	RRJ2	9.37	2	20	32	0.12	1.05	17.215	17.028	0.374	4.5	4.5	0.12	0.02	18.755	18.745	0.11	1.1	-0.099	
B61/1 to B61/2	375	RRJ2	9.04	2	20	40	0.15	1.03	16.847	16.666	0.05	4.5	4.5	0.15	0.03	17.638	17.637	0.01	1.1	0.646	
B61/2 to B61/3	375	RRJ2	15.2	1	20	67	0.35	1.2	16.616	16.464	0.05	1.82	3.88	0.13	0.03	17.629	17.623	0.04	1.26	0.65	
B61/3 to B02/15	375	RRJ2	9	2	10	114	0.42	1.49	16.414	16.234	0.911	1.36	1.39	0.14	0.06	17.615	17.609	0.07	1.19	0.327	
B65/1 to B06/11	375	RRJ2	9	2	20	111	0.41	1.28	17.485	17.305	0.699	4.5	4.5	0.23	0.23	19.068	19.066	0.02	1.1	-0.199	
B66/1 to B19/13	375	RRJ2	9.03	1.5	10	-51	-0.22	0.91	17.096	16.961	0.05	4.5	4.5	0.12	0.04	18.503	18.501	0.02	1.1	0.014	
B67/1 to B08/4	375	RRJ2	10.35	1.2	10	27	0.13	0.74	17.532	17.408	0.05	4.5	4.5	0.09	0.01	19.024	19.009	0.14	1.1	-0.086	
B68/1 to B08/5	375	RRJ2	9.5	2	25	50	0.19	0.93	17.257	17.067	0.056	4.5	4.5	0.15	0.05	18.77	18.761	0.09	1.1	-0.094	
B69/1 to B08/6	375	RRJ2	10.53	2	25	47	0.17	1.01	16.985	16.774	0.12	4.5	4.5	0.15	0.04	18.515	18.505	0.09	1.1	-0.101	
B70/1 to B08/7	375	RRJ2	9.61	2	15	53	0.2	1.1	16.701	16.509	0.211	4.5	4.5	0.17	0.05	18.214	18.221	-0.07	1.1	-0.098	
B71/1 to B08/8	375	RRJ2	9.56	2	25	49	0.18	1.04	16.482	16.29	0.27	4.5	4.5	0.13	0.04	18.016	18.025	-0.09	1.1	-0.099	
B72/1 to B72/2	375	RRJ2	9.11	2	20	85	0.32	0.95	17.432	17.249	0.05	4.5	4.5	0.16	0.14	18.255	18.244	0.12	1.1	0.531	
B72/2 to B05/14	375	RRJ2	15.47	1	20	148	0.78	1.46	17.199	17.045	1.338	2.59	3.58	0.19	0.19	18.172	18.122	0.32	1.46	0.636	
B73/1 to B73/2	375	RRJ2	18.74	1	10	148	0.78	1.34	17.801	17.614	0.05	2.01	2.49	0.16	0.17	19.498	19.47	0.15	1.21	-0.101	
B73/2 to B73/3	375	RRJ2	9.02	2	10	168	0.63	1.53	17.564	17.384	0.05	2.07	2.53	0.21	0.23	19.377	19.358	0.21	1.4	-0.164	
B73/3 to B73/4	450	RRJ2	15.18	1	10	283	0.92	1.85	17.334	17.182	0.05	2.38	2.39	0.26	0.27	19.272	19.229	0.28	1.68	-0.124	
B73/4 to B05/11	450	RRJ2	9.91	2	10	328	0.75	2.48	17.132	16.934	0.43	0.27	0.27	0.13	0.06	19.213	19.182	0.31	1.93	0.263	
B75/1 to B75/2	375	RRJ2	20.62	1	20	104	0.54	1.23	16.928	16.722	0.05	1.92	2.21	0.16	0.1	18.337	18.299	0.18	1.1	0.07	
B75/2 to B03/21	375	RRJ2	9	2	10	126	0.47	1.56	16.672	16.492	0.632	2.17	2.62	0.17	0.17	18.225	18.205	0.22	1.3	0.008	
B76/1 to B05/14	375	RRJ2	11.81	2	15	54	0.2	1.24	17.646	17.41	1.703	4.5	4.5	0.17	0.06	18.128	18.122	0.05	1.1	0.948	
B77/1 to B08/9	375	RRJ2	9.07	2	25	-95	-0.35	1.13	16.246	16.064	0.232	4.5	4.5	0.17	0.16	17.864	17.862	0.02	1.1	-0.192	
B78/1 to B02/18	375	RRJ2	9.12	2	10	-83	-0.31	0.88	16.361	16.179	1.259	4.5	4.5	0.14	0.03	17.119	17.11	0.1	1.1	0.678	
B99/1 to B99/2	1200	RRJ2	10.3	1	25	3612	0.86	3.59	14.55	14.447	0.05	0	0	0	0	16.396	16.364	0.31	2.25	1.776	GPT BYPASS CHAMBER
C01/1 to C01/2	375	RRJ2	22.7	1	15	38	0.2	0.93	17.978	17.751	0.03	4.5	4.5	0.13	0.03	19.437	19.443	-0.03	1.1	0.473	
C01/2 to C01/3	375	RRJ2	31.4	1	15	83	0.44	0.86	17.721	17.407	0.05	3	3	0.17	0.09	19.428	19.333	0.3	1.2	0.324	
C01/3 to C01/4	525	RRJ2	9	1	10	391	0.84	1.81	17.357	17.267	0.05	2.06	2.49	0.26	0.32	19.169	19.139	0.33	1.29	0.165	
C01/4 to C01/5	525	RRJ2	14.41	1	10	406	0.87	1.88	17.217	17.073	0.05	0.93	0.93	0.12	0.12	19.025	18.953	0.5			


NOTE:
 - - - 1% AEP HGL PROVIDED FOR INFORMATION ONLY.
 - - - 5% AEP HGL

I hereby certify that engineering works shown on this plan have been constructed generally in accordance with Construction Certificate 16635 issued by Land Development Certificates

Signature: *[Signature]*
PETER ROBERT WARWICK
 Registered Land Surveyor
VINCE MORGAN SURVEYORS PTY LTD

DATE 20/12/2022 REF 20260-7

These plans are referred to in certificate no. 16635 approved by:
Christopher Louis Wahbe
 Registered Certifier
 Registration No: BDC 3015
 Categories: Certifier - Subdivision
Land Development Certificates
 www.LDC.com.au

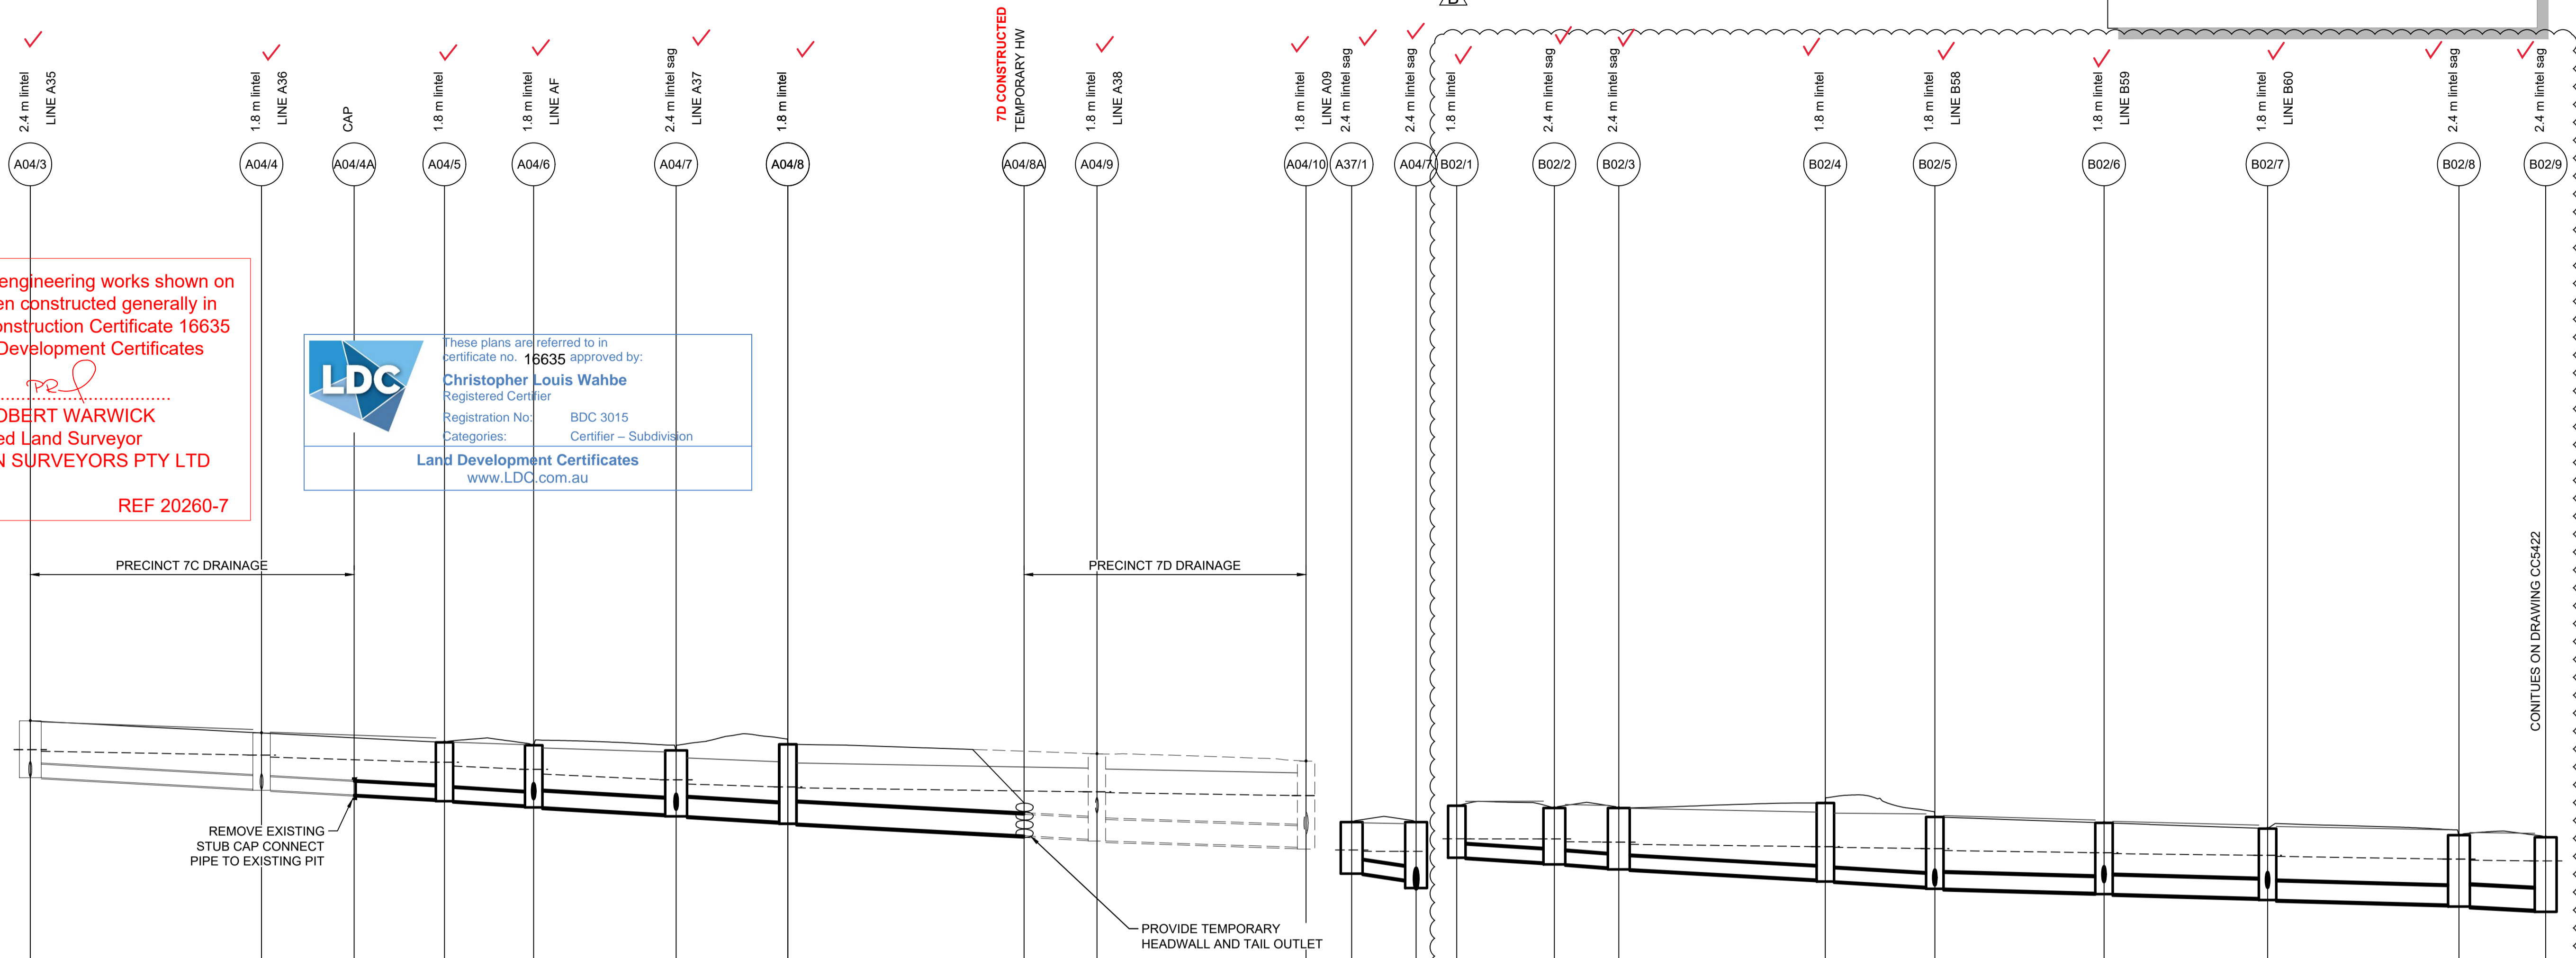


DATUM (m)	10.00								12.00																			
PEAK FLOW (L/s)	130	157	177	304	384	358	357	64	26	110	124	113	193	276	314	351												
PIPE SIZE (mm)	375	375	375	450	525	600	600	375	375	375	375	450	525	525	600	600												
PIPE CLASS	RRJ2	RRJ2	RRJ2	RRJ2	RRJ2	RRJ2	RRJ2	RRJ2	RRJ2	RRJ2	RRJ2	RRJ2	RRJ2	RRJ2	RRJ2	RRJ2												
PIPE GRADE (%)	1.0	1.0	1.0 1.5	1.0 0.9	1.0 0.95	1.0 1.1	0.6	2.0 1.1	1.0 1.2	1.0 1.3	1.0 1.1	1.0 0.8	0.5 0.5	0.5 0.6	0.5 0.6	0.8 1.2												
PIPE COVER MINIMUM	1.16	1.18	1.28	1.39	1.46	1.57	1.77	1.10	1.10	1.24	1.31	1.73	1.48	1.39	1.54	1.41												
FULL PIPE VELOCITY (m/s)	1.39	1.50	1.60	1.91	1.92	2.11	1.56	1.14	0.60	1.08	1.44	1.15	1.26	1.42	1.60	1.48												
HGL GRADE (%)	0.33	0.56	0.73	0.8	0.52	0.26	0.28	0.04	0.01	0.09	0.23	0.23	0.25	0.21	0.29	0.19												
NOTE: 10% AEP VALUES SHOWN																												
WAE																												
HYDRAULIC GRADE LINE	18.855	18.808	18.702	18.645	18.501	18.385	18.304	18.17	18.011	17.893	17.812	17.766	17.57	17.536	18.015	18.359	18.358	18.28	18.144	18.125	18.09	18.036	17.976	17.95	17.902	17.873	17.745	
INVERT LEVEL	18.103	18.072	17.749	17.719	17.589	17.50	17.463	17.413	17.42	17.24	17.269	18.17	17.01	17.04	18.81	18.808	18.99	18.854	18.784	17.96	16.454	16.28	16.353	16.303	16.25	16.127	16.077	17.536
DESIGN SURFACE LEVEL	19.656	19.656	19.318	19.318	19.183	19.04	19.055	19.055	17.42	18.93	18.976	18.17	18.81	18.808	18.99	18.854	19.003	19.003	18.784	17.96	18.809	18.71	18.71	18.71	18.71	18.71	18.71	18.408

LINE A04

LINE A37

LINE B02

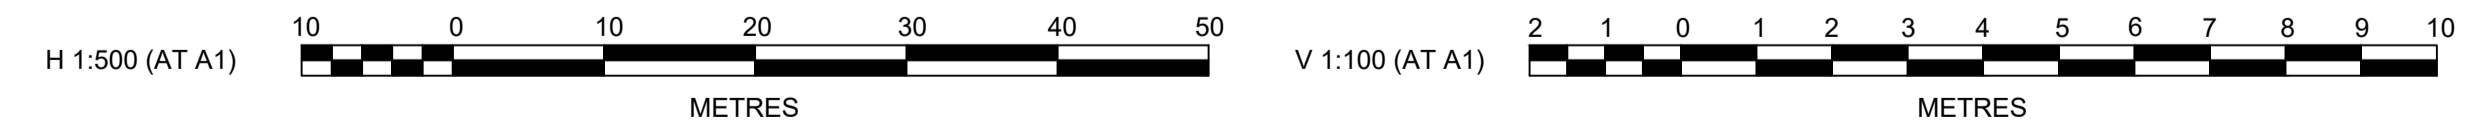

Plotfile: 14 September, 2021 12:53:04 PM File Name: J:\9985\DC - Construction Certificate Approval Plans\PK12 WESTERN PRECINCTS\5 - Precinct 7\9985-12-CC5421.dwg

DES	DRN	CKD	APR	DATE		
B	DRAINAGE LONG SECTION B02 UPDATED	DG	VS	MP	MS	14/09/21
A	ISSUE FOR APPROVAL	DG	VS	MP	PJM	12/08/21
	AMENDMENT	DES	DRN	CKD	APR	DATE

J. WYNDHAM PRINCE
 CONSULTING CIVIL INFRASTRUCTURE ENGINEERS & PROJECT MANAGERS

PO Box 4366 PENRITH WESTFIELD NSW 2750
 P 02 4720 3300 W www.jwprince.com.au E jwp@jwprince.com.au

CLIENT:

W WINTEN PROPERTY GROUP

STATUS: **ISSUE FOR CONSTRUCTION APPROVAL**

THIS DRAWING MUST NOT BE USED FOR CONSTRUCTION UNLESS SIGNED AS PART OF AN APPROVED CONSTRUCTION CERTIFICATE.

NEWPARK PRECINCT 7, STAGE 7B
 LONGITUDINAL DRAINAGE SHEET 1

PROJECT No: **9985-12**
 SHEET No: **CC5421**

AZIMUTH: M.G.A.94 DATUM: A.H.D. ORIGIN: SSM 1112 PLAN No: **9985-12-CC5421**

B

B

NOTE:
- - - 1% AEP HGL PROVIDED FOR INFORMATION ONLY.
- - - 5% AEP HGL


I hereby certify that engineering works shown on this plan have been constructed generally in accordance with Construction Certificate 16635 issued by Land Development Certificates

Signature: *[Signature]*
PETER ROBERT WARWICK
Registered Land Surveyor
VINCE MORGAN SURVEYORS PTY LTD

DATE 20/12/2022 REF 20260-7

These plans are referred to in certificate no. 16635 approved by:
Christopher Louis Wahbe
Registered Certifier
Registration No: BDC 3015
Categories: Certifier - Subdivision

Land Development Certificates
www.LDC.com.au

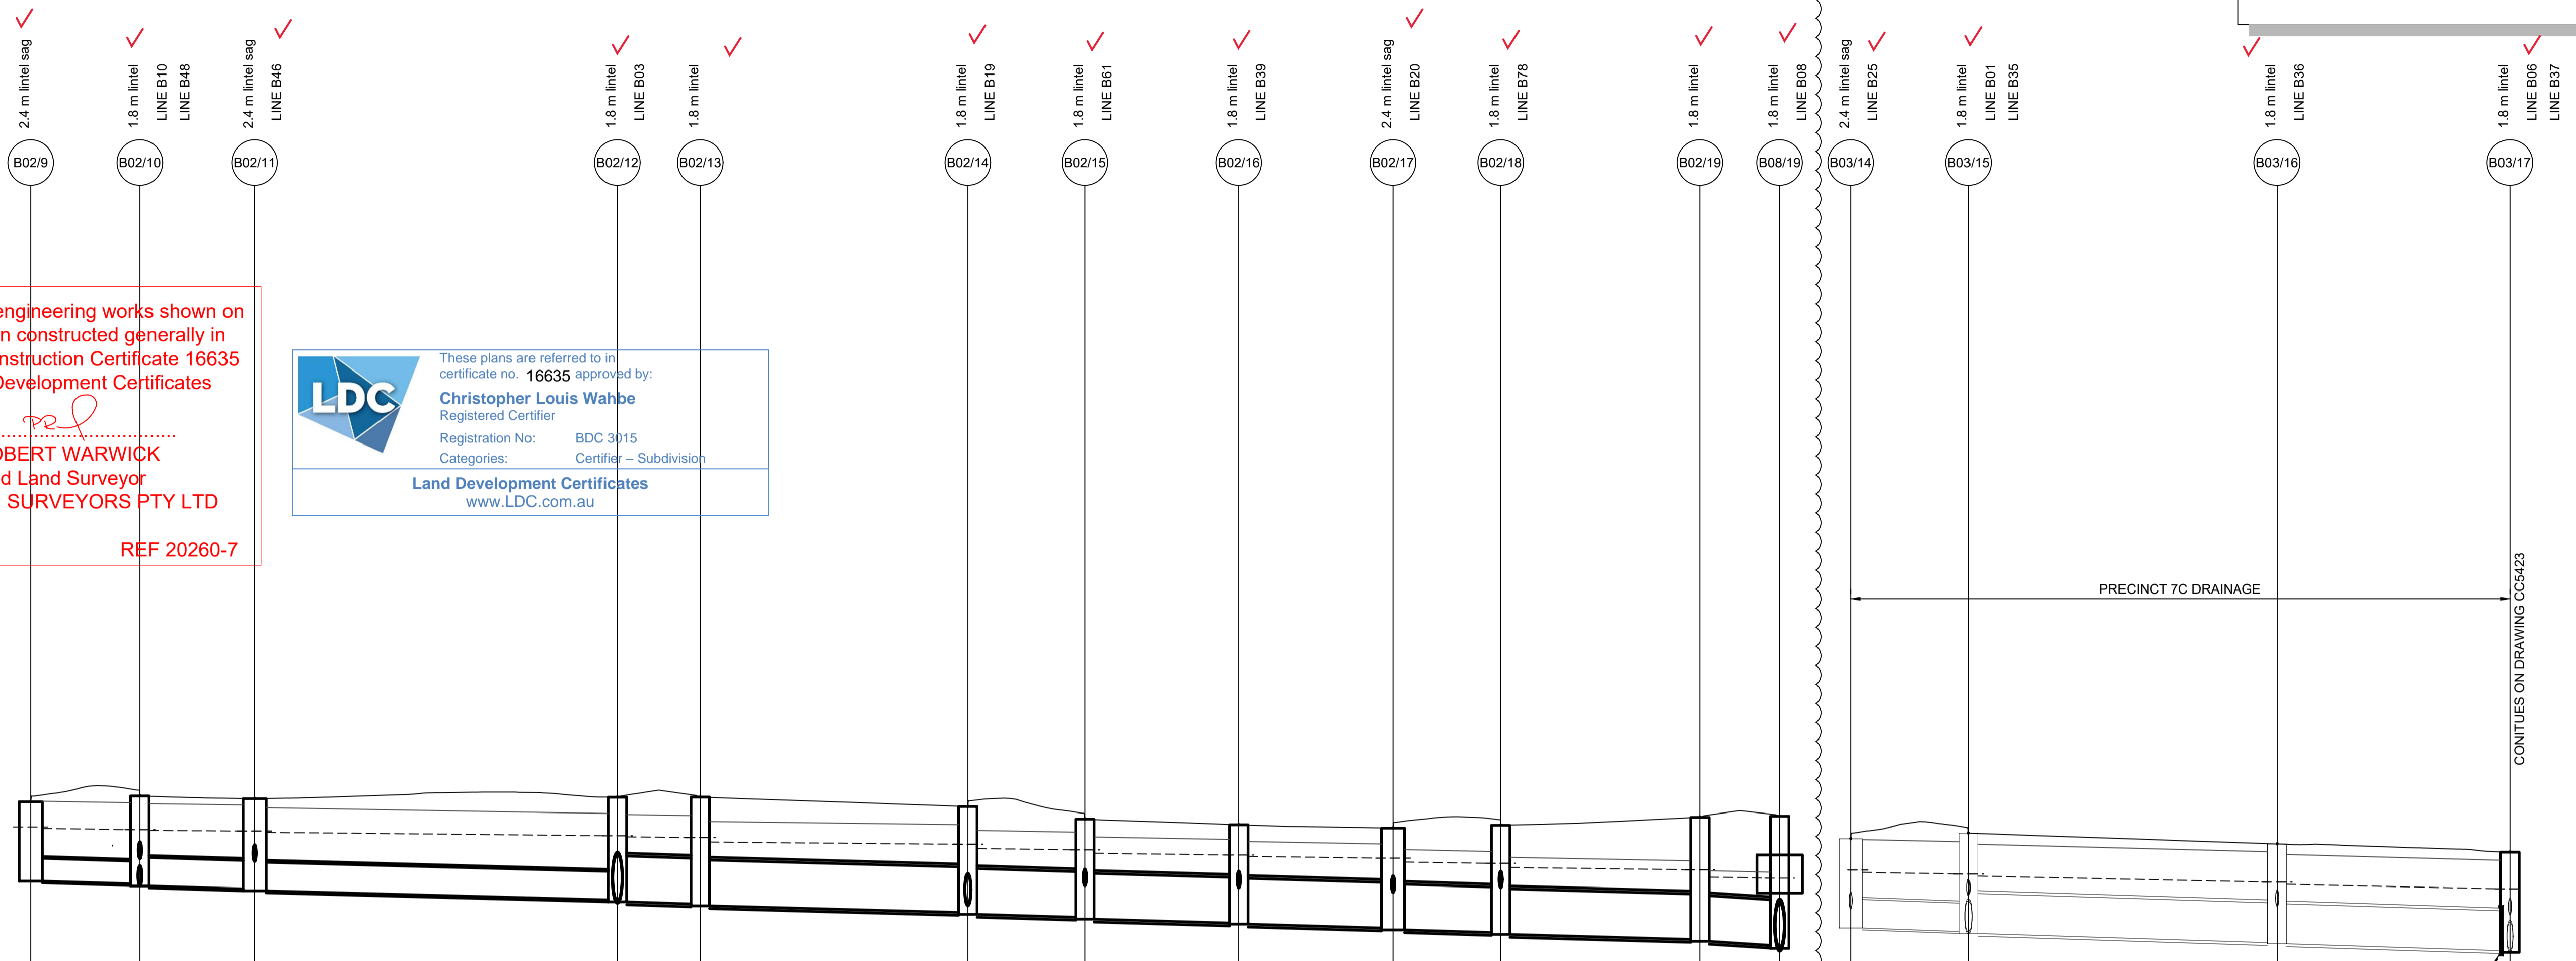


DATUM (m)	10.00										
PEAK FLOW (L/s)	387	506	578	3416	3421	3971	4010	4070	4109	4124	4130
PIPE SIZE (mm)	600 ✓	750 ✓	750 ✓	(2x)1200 ✓	(2x)1200 ✓	(2x)1200 ✓	(2x)1200 ✓	(2x)1200 ✓	(2x)1200 ✓	(2x)1200 ✓	(2x)1200 ✓
PIPE CLASS	RRJ2	RRJ2	RRJ2	RRJ2	RRJ2	RRJ2	RRJ2	RRJ2	RRJ2	RRJ2	RRJ2
PIPE GRADE (%)	0.5 0.6	0.5 0.6	0.5 0.5	0.5 ✓	0.5 0.5	0.5 0.7	0.5 0.5	0.5 0.8	0.5 0.5	0.5 0.7	1.0 0.5
PIPE COVER MINIMUM	1.62	1.56	1.62	1.52	1.52	1.47	1.32	1.33	1.56	1.60	2.04
FULL PIPE VELOCITY (m/s)	1.51	1.63	1.76	1.79	1.62	1.84	1.97	1.91	1.82	1.82	1.83
HGL GRADE (%)	0.23	0.13	0.19	0.17	0.16	0.23	0.23	0.23	0.23	0.24	0.24
NOTE: 10% AEP VALUES SHOWN											
WAE											
HYDRAULIC GRADE LINE	17.745	17.708		17.514	17.465	17.291	17.18	16.927	16.824	16.791	16.683
INVERT LEVEL	16.34 16.374 16.324 16.30	16.21 16.252 16.194 16.18	16.12 16.119 16.069 16.06	15.93 15.831 15.781 15.78	15.72 15.726 15.676 15.68	15.49 15.5 15.45 15.47	15.38 15.373 15.323 15.32	15.23 15.222 15.192 15.22	15.09 15.091 15.041 15.01	14.75 14.789 14.739 14.67	14.62 14.634 14.551 14.57
DESIGN SURFACE LEVEL	18.408 18.40	18.55 18.591	18.48 18.49	18.50 18.526	18.52 18.53	18.27 18.284	17.83 17.951	17.79 17.805	17.70 17.716	17.99 17.997	18.02 18.027
ROAD CHAINAGE	12.51	329.14	314.31	266.76	260.62	225.46	336.56	356.79	377.06	685.81	691.17
PIPE CHAINAGE	152.037	166.369	181.459	229.126	240.025	275.181	290.565	310.78	331.049	345.099	381.856

DATUM (m)	12.00		
PEAK FLOW (L/s)	684	1835	1887
PIPE SIZE (mm)	750	1050	1050
PIPE CLASS	RRJ2	RRJ2	RRJ2
PIPE GRADE (%)	0.6	0.6	0.6
PIPE COVER MINIMUM	1.73	1.48	1.48
FULL PIPE VELOCITY (m/s)	1.55	2.42	2.24
HGL GRADE (%)	0.26	0.38	0.41
NOTE: 10% AEP VALUES SHOWN			
WAE			
HYDRAULIC GRADE LINE	18.516	18.563	18.512
INVERT LEVEL	17.141 17.091	16.998 16.948	16.704 16.674
DESIGN SURFACE LEVEL	19.434	19.592	19.298
ROAD CHAINAGE	15.63	86.26	126.79
PIPE CHAINAGE	276.889	292.171	332.7

LINE B02

LINE B03

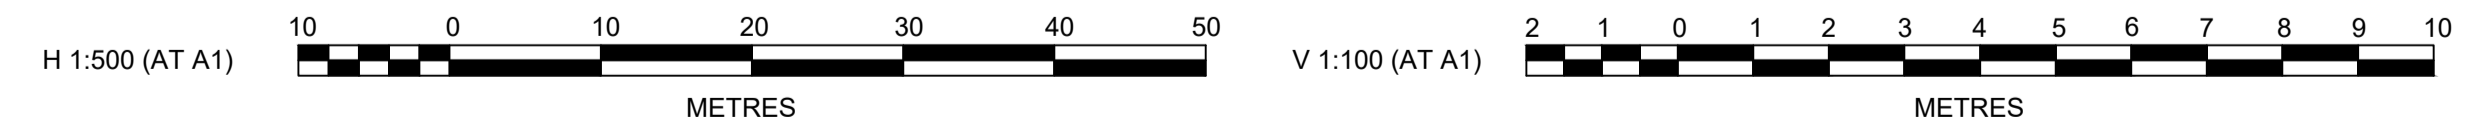

Plotted: 14 September, 2021 12:53:18 PM File Name: J:\9985\18 PM - Construction Certificate Approval Plans\PK12 WESTERN PRECINCTS\5 - Precinct 7\9985-12-CC5422.dwg

B	DRAINAGE LONG SECTION B02 UPDATED	DG	VS	MP	MS	14/09/21
A	ISSUE FOR APPROVAL	DG	VS	MP	PJM	12/08/21
	AMENDMENT	DES	DRN	CKD	APR	DATE

J. WYNDHAM PRINCE
CONSULTING CIVIL INFRASTRUCTURE ENGINEERS & PROJECT MANAGERS

PO Box 4366 PENRITH WESTFIELD NSW 2750
P 02 4720 3300 W www.jwprince.com.au E jwp@jwprince.com.au

CLIENT:

WINTER PROPERTY GROUP

STATUS: **ISSUE FOR CONSTRUCTION APPROVAL**

THIS DRAWING MUST NOT BE USED FOR CONSTRUCTION UNLESS SIGNED AS PART OF AN APPROVED CONSTRUCTION CERTIFICATE.

NEWPARK
PRECINCT 7, STAGE 7B
LONGITUDINAL DRAINAGE SHEET 2


PROJECT No: **9985-12**
SHEET No: **CC5422**

AZIMUTH: M.G.A.94 DATUM: A.H.D. ORIGIN: SSM 1112 PLAN No: **9985-12-CC5422**

B


NOTE:
 - - - - 1% AEP HGL PROVIDED FOR INFORMATION ONLY.
 - - - - 5% AEP HGL

I hereby certify that engineering works shown on this plan have been constructed generally in accordance with Construction Certificate 16635 issued by Land Development Certificates

Signature: 
 PETER ROBERT WARWICK
 Registered Land Surveyor
 VINCE MORGAN SURVEYORS PTY LTD

DATE 20/12/2022 REF 20260-7

LDC These plans are referred to in certificate no. 16635 approved by:
Christopher Louis Wahbe
 Registered Certifier
 Registration No: BDC 3015
 Categories: Certifier - Subdivision
 Land Development Certificates
 www.LDC.com.au

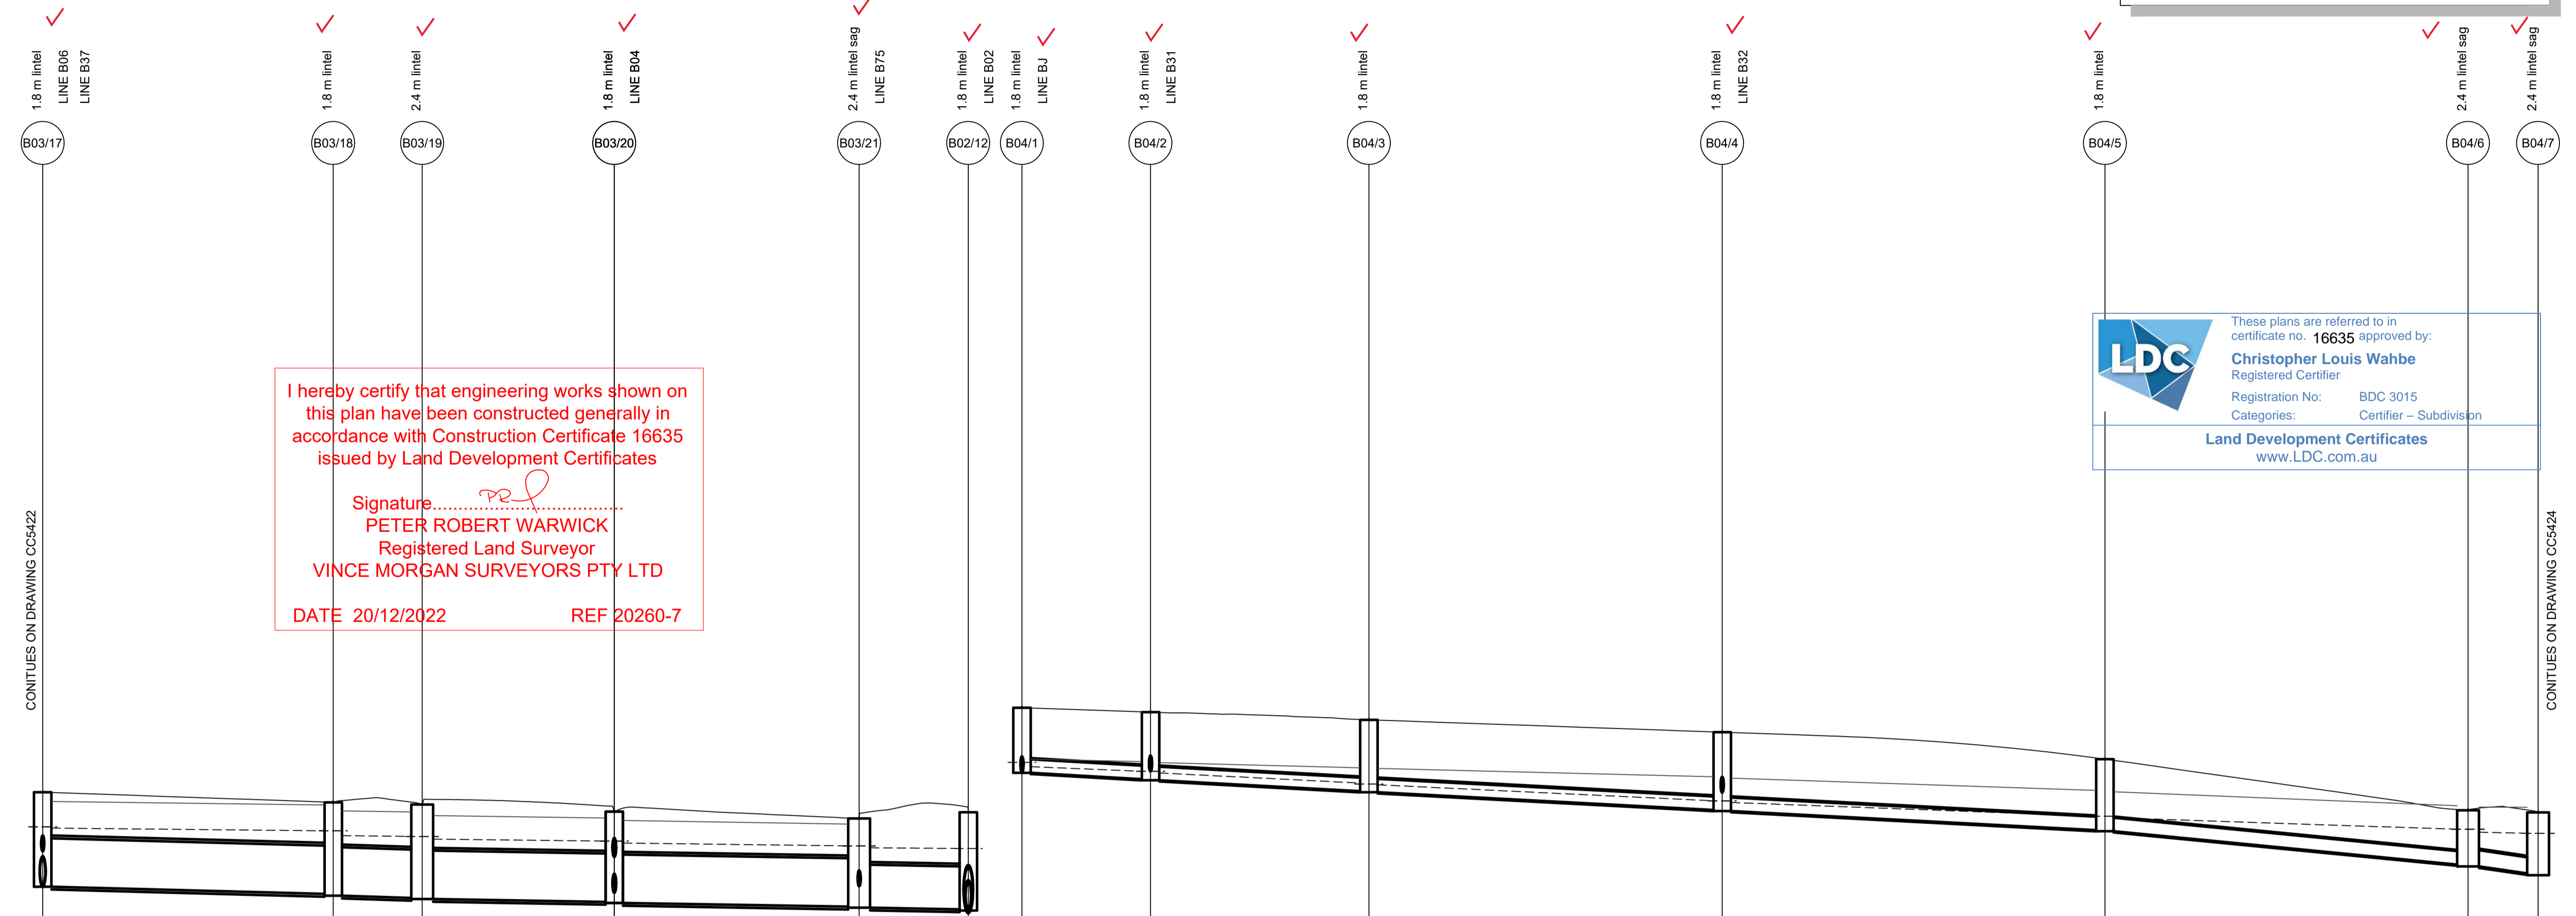


	18.118	18.083	18.006	17.873	17.849	17.773	17.719	17.666	17.586	17.532	17.514	17.468
DATUM (m)	12.00											
PEAK FLOW (L/s)	2516	2535	2567	2800	2891							
PIPE SIZE (mm)	1350 ✓	1350 ✓	1350 ✓	1350 ✓	(2x)1200 ✓							
PIPE CLASS	RRJ2	RRJ2	RRJ2	RRJ2	RRJ2							
PIPE GRADE (%)	0.5 0.5	0.5 0.5	0.3 0.3	0.3 0.2	0.3 0.5							
PIPE COVER MINIMUM	1.14	1.23	1.25	1.04	1.38							
FULL PIPE VELOCITY (m/s)	2.00	1.87	2.02	2.36	1.48							
HGL GRADE (%)	0.19	0.19	0.2	0.23	0.12							

NOTE: 10% AEP VALUES SHOWN

	19.797	19.627	19.537	19.505	19.339	19.291	18.844	18.798	18.414	18.371	18.05	17.989	17.937	17.876
DATUM (m)	12.00													
PEAK FLOW (L/s)	107	129	129	160	164	182								
PIPE SIZE (mm)	375 ✓	375 ✓	375 ✓	375 ✓	375 ✓	450 ✓								
PIPE CLASS	RRJ2	RRJ2	RRJ2	RRJ2	RRJ2	RRJ2								
PIPE GRADE (%)	1.01.3	1.0 1.2	1.0 1.0	1.0 1.0	1.8 1.8	2.0 2.0								
PIPE COVER MINIMUM	1.40	1.48	1.60	1.60	1.12	1.13								
FULL PIPE VELOCITY (m/s)	1.34	1.74	1.74	1.82	2.04	1.49								
HGL GRADE (%)	0.72	0.93	0.91	0.72	0.63	0.33								

LINE B03

LINE B04

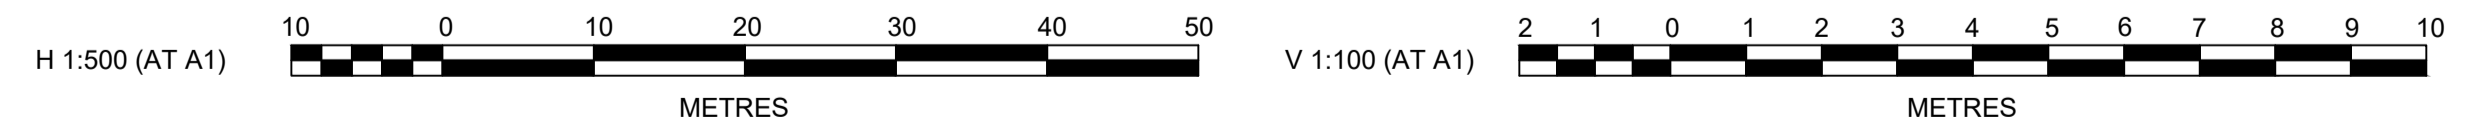

Plotfile: 14 September, 2021 12:53:32 PM File Name: J:\9985DCC - Construction Certificate Approval Plans\PK12 WESTERN PRECINCTS\5 - Preprint\7B\9985-12-CC5423.dwg

A	ISSUE FOR APPROVAL	DG	VS	MP	PJM	12/08/21								
	AMENDMENT	DES	DRN	CKD	APR	DATE								

J. WYNDHAM PRINCE
 CONSULTING CIVIL INFRASTRUCTURE ENGINEERS & PROJECT MANAGERS

PO Box 4366 PENRITH WESTFIELD NSW 2750
 P 02 4720 3300 W www.jwprince.com.au E jwp@jwprince.com.au

CLIENT:



WINTER PROPERTY GROUP

STATUS: **ISSUE FOR CONSTRUCTION APPROVAL**

THIS DRAWING MUST NOT BE USED FOR CONSTRUCTION UNLESS SIGNED AS PART OF AN APPROVED CONSTRUCTION CERTIFICATE.


NEWPARK PRECINCT 7, STAGE 7B
 LONGITUDINAL DRAINAGE SHEET 3

PROJECT No: **9985-12**
 SHEET No: **CC5423**

AZIMUTH: M.G.A.94 DATUM: A.H.D. ORIGIN: SSM 1112 PLAN No: **9985-12-CC5423**

A

NOTE:
 - - - 1% AEP HGL PROVIDED FOR INFORMATION ONLY.
 - - - 5% AEP HGL

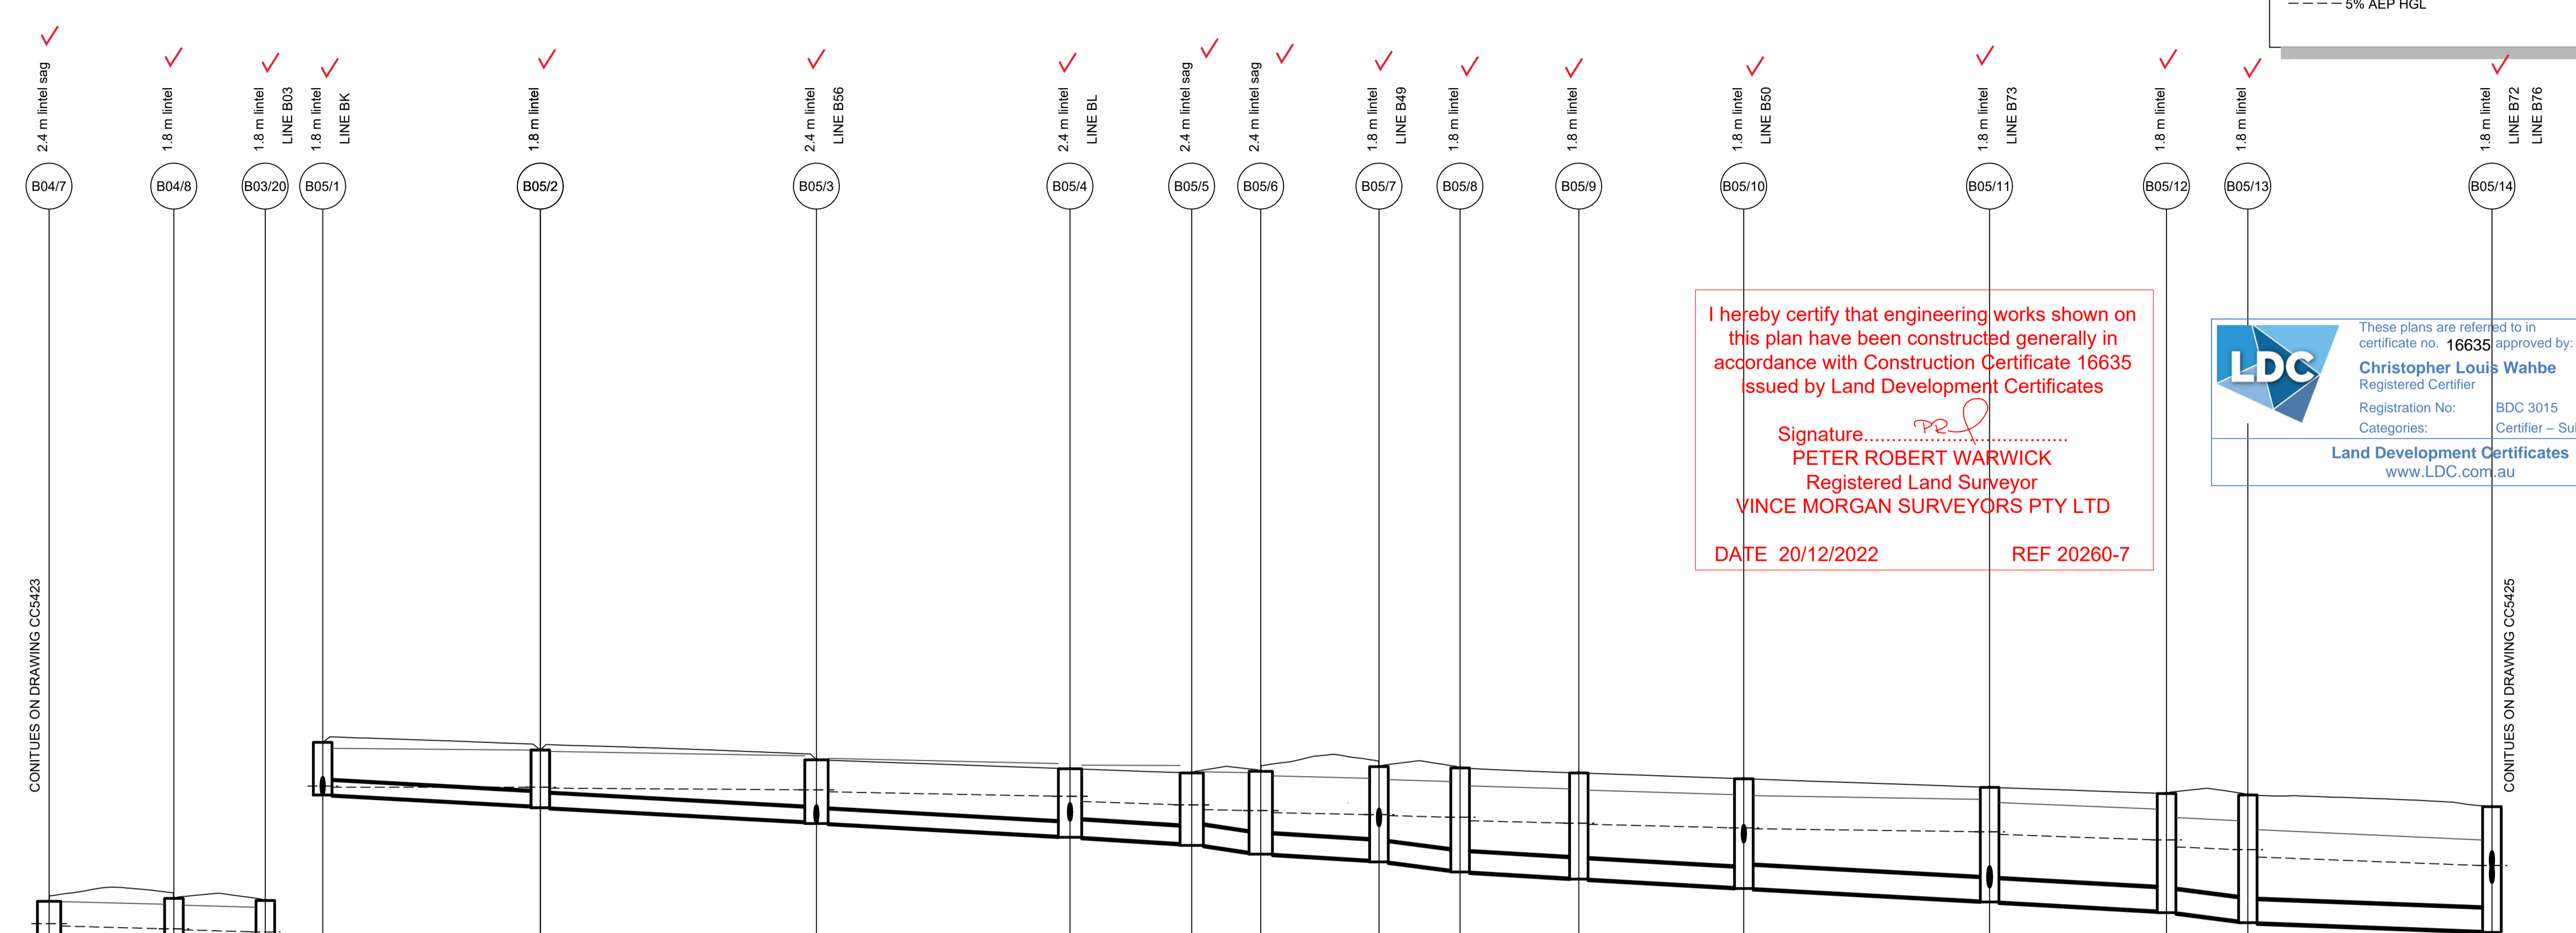

I hereby certify that engineering works shown on this plan have been constructed generally in accordance with Construction Certificate 16635 issued by Land Development Certificates

Signature: *Peter Robert Warwick*
PETER ROBERT WARWICK
 Registered Land Surveyor
VINCE MORGAN SURVEYORS PTY LTD

DATE 20/12/2022 REF 20260-7

LDC These plans are referred to in certificate no. 16635 approved by:
Christopher Louis Wahbe
 Registered Certifier
 Registration No: BDC 3015
 Categories: Certifier - Subdivision
Land Development Certificates
 www.LDC.com.au

DATUM (m)	12.00
PEAK FLOW (L/s)	214
PIPE SIZE (mm)	450
PIPE CLASS	RRJ2
PIPE GRADE (%)	1.0
PIPE COVER MINIMUM	1.44
FULL PIPE VELOCITY (m/s)	1.69
HGL GRADE (%)	0.46

NOTE: 10% AEP VALUES SHOWN

WAE	
HYDRAULIC GRADE LINE	17.937
INVERT LEVEL	16.81
DESIGN SURFACE LEVEL	18.52
ROAD CHAINAGE	12.42
PIPE CHAINAGE	211.676


DATUM (m)	10.00
PEAK FLOW (L/s)	72
PIPE SIZE (mm)	375
PIPE CLASS	RRJ2
PIPE GRADE (%)	1.0
PIPE COVER MINIMUM	1.11
FULL PIPE VELOCITY (m/s)	1.34
HGL GRADE (%)	-0.01

NOTE: 10% AEP VALUES SHOWN

WAE	
HYDRAULIC GRADE LINE	19.499
INVERT LEVEL	19.297
DESIGN SURFACE LEVEL	20.673
ROAD CHAINAGE	251.46
PIPE CHAINAGE	0

SEWER LEAD IN MAIN 5250
 INV RL 11.99

SEWER LEAD IN MAIN 5250
 INV RL 12.25

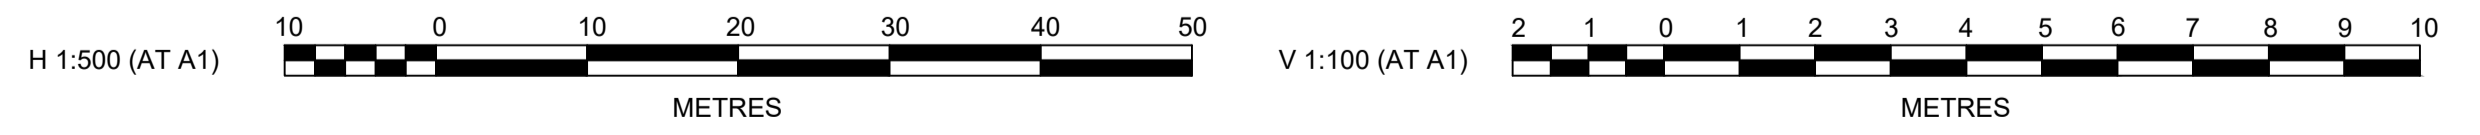

Plotted: 14 September, 2021 12:53:48 PM File Name: J:\9985D\CC - Construction Certificate Approval Plans\PK12 WESTERN PRECINCTS 5 - Preprint\7B\9985-12-CC5424.dwg

A	ISSUE FOR APPROVAL	DG	VS	MP	PJM	12/08/21
	AMENDMENT	DES	DRN	CKD	APR	DATE

J. WYNDHAM PRINCE
 CONSULTING CIVIL INFRASTRUCTURE ENGINEERS & PROJECT MANAGERS

PO Box 4366 PENRITH WESTFIELD NSW 2750
 P 02 4720 3300 W www.jwprince.com.au E jwp@jwprince.com.au

CLIENT:

WINTEN PROPERTY GROUP

STATUS: **ISSUE FOR CONSTRUCTION APPROVAL**

THIS DRAWING MUST NOT BE USED FOR CONSTRUCTION UNLESS SIGNED AS PART OF AN APPROVED CONSTRUCTION CERTIFICATE.


NEWPARK PRECINCT 7, STAGE 7B
 LONGITUDINAL DRAINAGE SHEET 4

AZIMUTH: M.G.A.94 DATUM: A.H.D. ORIGIN: SSM 1112 PLAN No: 9985-12-CC5424

PROJECT No: **9985-12**
 SHEET No: **CC5424**

Plotfile: 14 September, 2021 12:54:08 PM File Name: J:\9985D\CC - Construction Certificate Approval Plans\PK12 WESTERN PRECINCTS\5 - Preprint\7B\9985-12-CC5425.dwg

NOTE:
 - - - 1% AEP HGL PROVIDED FOR INFORMATION ONLY.
 - - - 5% AEP HGL

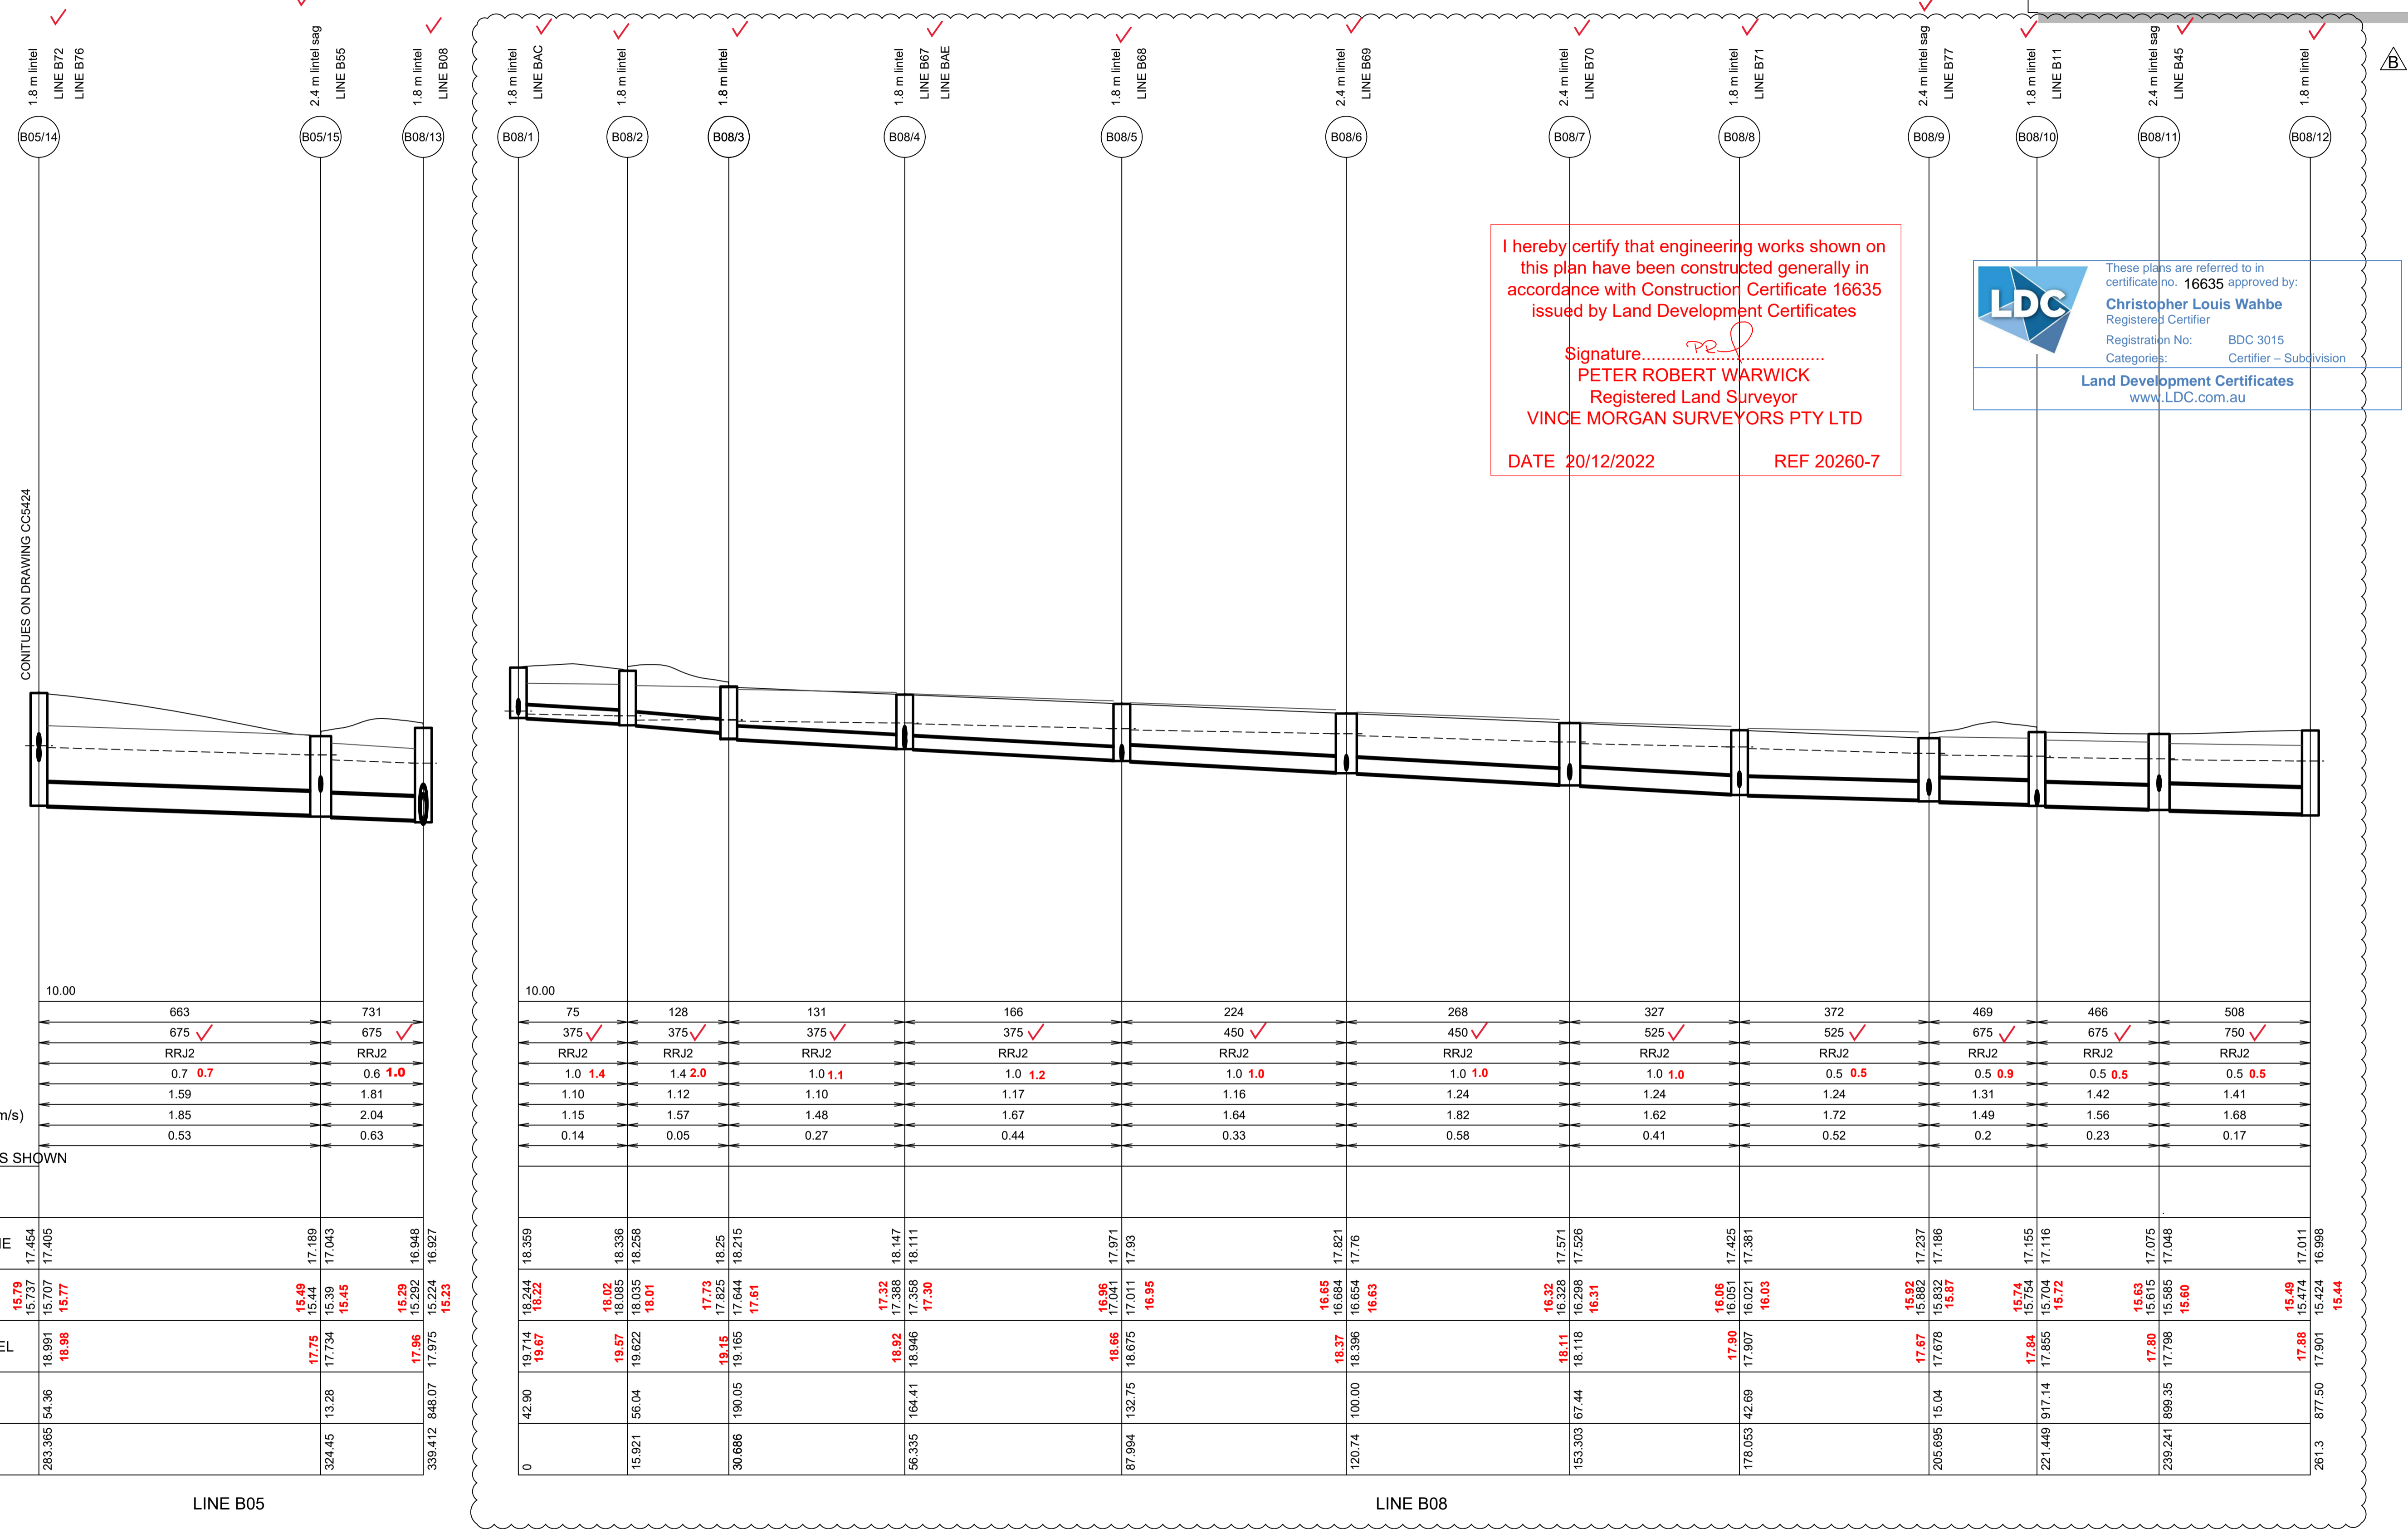

I hereby certify that engineering works shown on this plan have been constructed generally in accordance with Construction Certificate 16635 issued by Land Development Certificates


Signature: *[Signature]*
PETER ROBERT WARWICK
 Registered Land Surveyor
 VINCE MORGAN SURVEYORS PTY LTD

DATE 20/12/2022 REF 20260-7

LDC These plans are referred to in certificate no. 16635 approved by:
Christopher Louis Wahbe
 Registered Certifier
 Registration No: BDC 3015
 Categories: Certifier - Subdivision
Land Development Certificates
 www.LDC.com.au

DATUM (m)	10.00
PEAK FLOW (L/s)	663
PIPE SIZE (mm)	675 ✓
PIPE CLASS	RRJ2
PIPE GRADE (%)	0.7 0.7
PIPE COVER MINIMUM	1.59
FULL PIPE VELOCITY (m/s)	1.85
HGL GRADE (%)	0.53
NOTE: 10% AEP VALUES SHOWN	
WAE	
HYDRAULIC GRADE LINE	17.454 17.405
INVERT LEVEL	15.79 15.737 15.707 15.77
DESIGN SURFACE LEVEL	18.991 18.98 17.75 17.734 15.39 15.45
ROAD CHAINAGE	54.36
PIPE CHAINAGE	283.365 324.45 339.412

DATUM (m)	10.00
PEAK FLOW (L/s)	75 128 131 166 224 268 327 372 469 466 508
PIPE SIZE (mm)	375 ✓ 375 ✓ 375 ✓ 375 ✓ 450 ✓ 450 ✓ 525 ✓ 525 ✓ 675 ✓ 675 ✓ 750 ✓
PIPE CLASS	RRJ2 RRJ2 RRJ2 RRJ2 RRJ2 RRJ2 RRJ2 RRJ2 RRJ2 RRJ2 RRJ2
PIPE GRADE (%)	1.0 1.4 1.4 2.0 1.0 1.1 1.0 1.2 1.0 1.0 1.0 1.0 0.5 0.5 0.5 0.9 0.5 0.5 0.5 0.5
PIPE COVER MINIMUM	1.10 1.12 1.10 1.16 1.24 1.24 1.24 1.24 1.31 1.42 1.41
FULL PIPE VELOCITY (m/s)	1.15 1.57 1.48 1.67 1.64 1.82 1.62 1.72 1.49 1.56 1.68
HGL GRADE (%)	0.14 0.05 0.27 0.44 0.33 0.58 0.41 0.52 0.2 0.23 0.17
WAE	
HYDRAULIC GRADE LINE	18.359 18.244 18.22 18.02 18.336 18.085 18.035 18.258 18.01 17.73 17.825 18.25 18.215 17.61 17.32 17.388 18.147 17.96 17.041 17.93 16.65 16.684 17.821 17.76 16.65 16.654 16.63 16.32 16.328 17.571 16.298 17.526 16.31 16.06 16.051 17.425 17.381 15.92 15.882 17.237 17.186 15.74 17.155 15.704 17.116 15.72 15.63 15.615 17.075 17.048 15.60 15.49 15.474 17.011 15.44
DESIGN SURFACE LEVEL	19.714 19.67 19.57 19.622 18.946 18.92 18.92 18.675 18.66 18.675 18.37 18.396 18.11 18.118 17.90 17.907 17.67 17.678 17.84 17.855 17.80 17.80 17.798 17.798 17.88 17.88
ROAD CHAINAGE	42.80 190.05 164.41 132.75 100.00 67.44 42.69 15.04 917.14 899.35 877.50
PIPE CHAINAGE	0 15.921 30.686 56.335 87.994 120.74 153.303 178.053 205.695 221.449 239.241 281.3

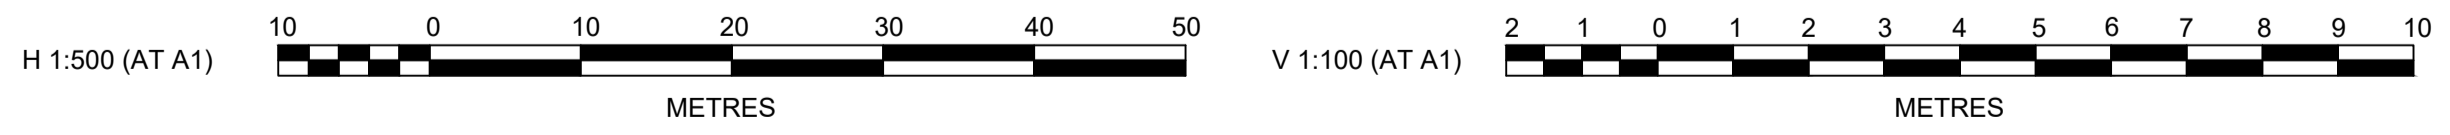

DES	DRN	CKD	APR	DATE
DG	VS	MP	MS	14/09/21
DG	VS	MP	PJM	12/08/21
AMENDMENT				

J. WYNDHAM PRINCE
 CONSULTING CIVIL INFRASTRUCTURE ENGINEERS & PROJECT MANAGERS

PO Box 4366 PENRITH WESTFIELD NSW 2750
 P 02 4720 3300 W www.jwprince.com.au E jwp@jwprince.com.au

CLIENT: **WINTEN PROPERTY GROUP**

STATUS: **ISSUE FOR CONSTRUCTION APPROVAL**

THIS DRAWING MUST NOT BE USED FOR CONSTRUCTION UNLESS SIGNED AS PART OF AN APPROVED CONSTRUCTION CERTIFICATE.

NEWPARK PRECINCT 7, STAGE 7B
 LONGITUDINAL DRAINAGE SHEET 5

PROJECT No: **9985-12**
 SHEET No: **CC5425**

AZIMUTH: M.G.A.94 DATUM: A.H.D. ORIGIN: SSM 1112 PLAN No: **9985-12-CC5425**

B


I hereby certify that engineering works shown on this plan have been constructed generally in accordance with Construction Certificate 16635 issued by Land Development Certificates

Signature: *[Signature]*
PETER ROBERT WARWICK
 Registered Land Surveyor
 VINCE MORGAN SURVEYORS PTY LTD

DATE 20/12/2022 REF 20260-7


NOTE:
 - - - 1% AEP HGL PROVIDED FOR INFORMATION ONLY.
 - - - 5% AEP HGL

These plans are referred to in certificate no. 16635 approved by:
Christopher Louis Wahbe
 Registered Certifier
 Registration No: BDC 3015
 Categories: Certifier - Subdivision
 Land Development Certificates
 www.LDC.com.au

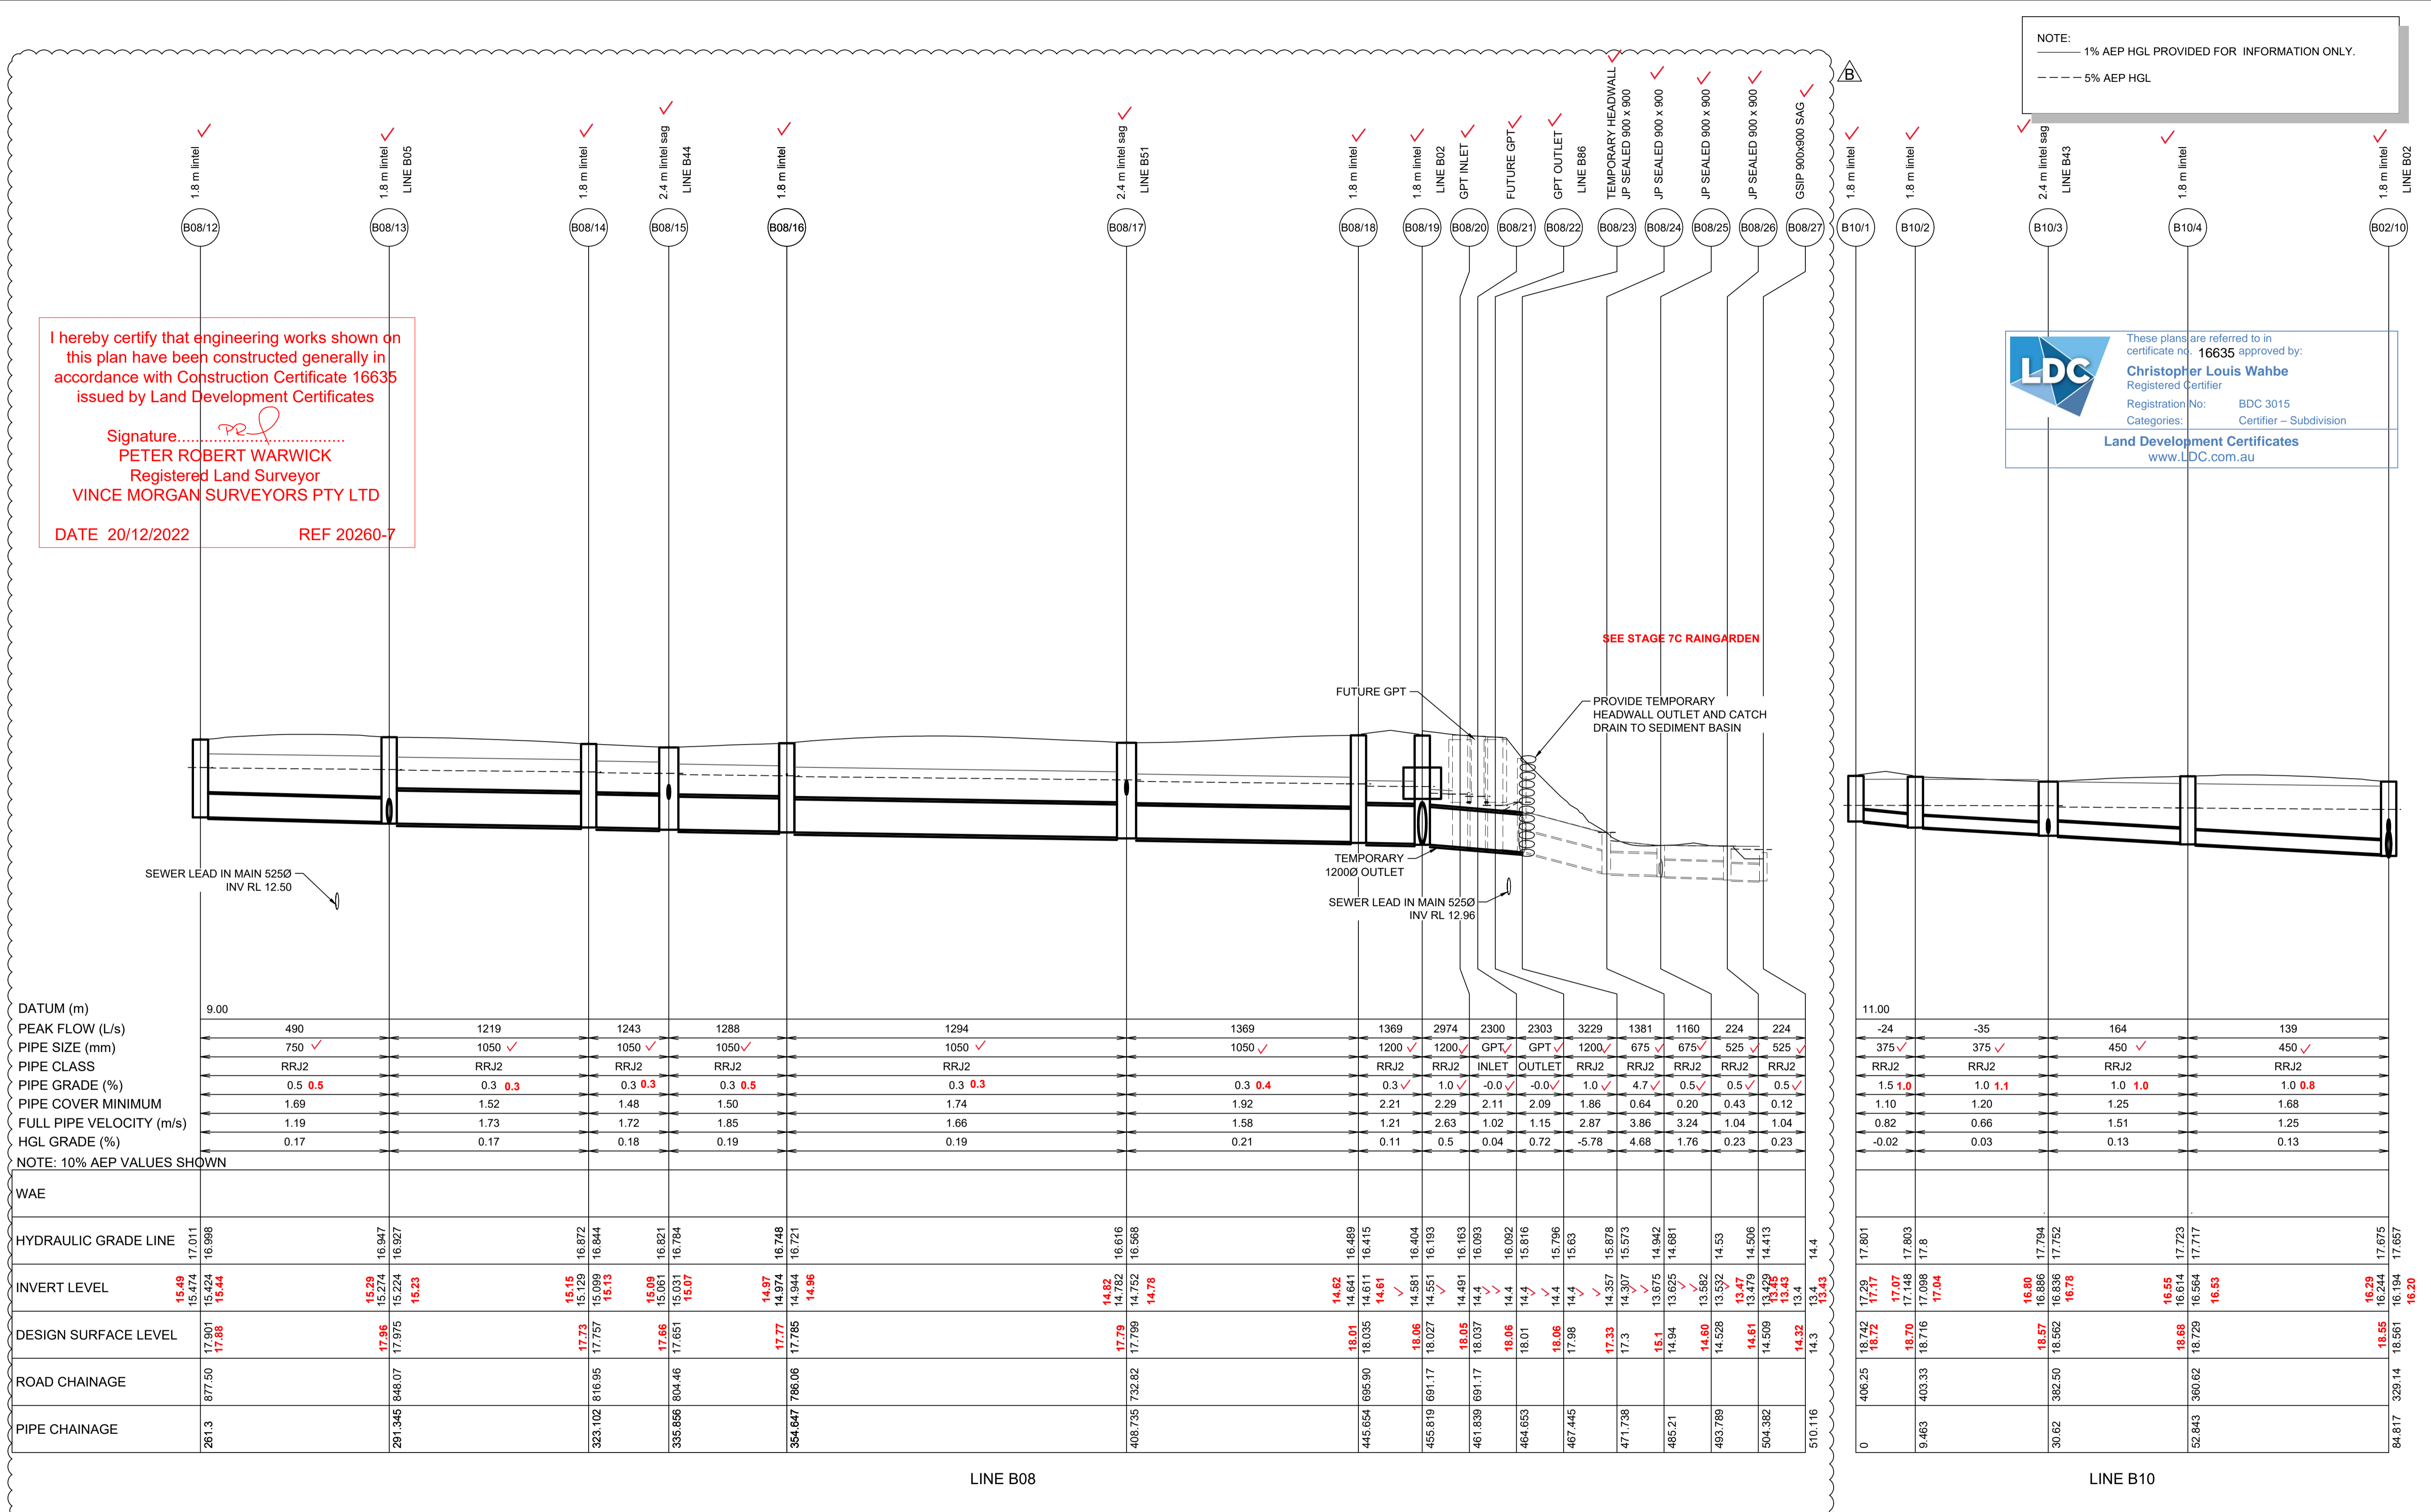

DATE	DESCRIPTION	DESIGNER	DRAWN	CHECKED	APPROVED
14/09/21	DRAINAGE LONG SECTION B08 UPDATED	DG	VS	MP	MS
12/08/21	ISSUE FOR APPROVAL	DG	VS	MP	PJM


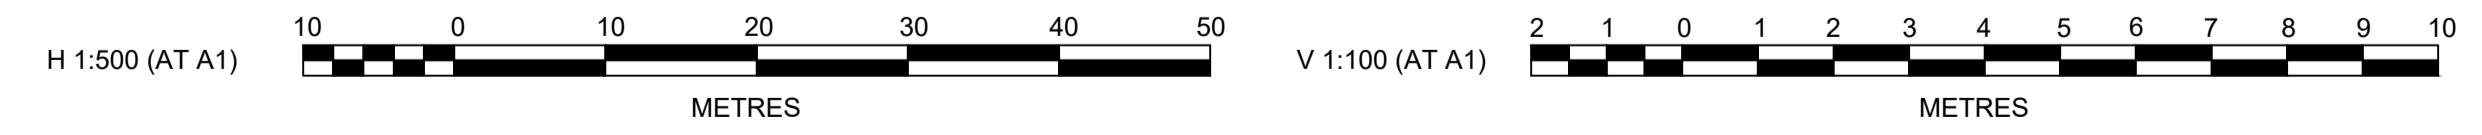

J. WYNDHAM PRINCE
 CONSULTING CIVIL INFRASTRUCTURE ENGINEERS & PROJECT MANAGERS



STATUS: **ISSUE FOR CONSTRUCTION APPROVAL**

THIS DRAWING MUST NOT BE USED FOR CONSTRUCTION UNLESS SIGNED AS PART OF AN APPROVED CONSTRUCTION CERTIFICATE.

NEWPARK PRECINCT 7, STAGE 7B
 LONGITUDINAL DRAINAGE SHEET 6


PROJECT No: **9985-12**
 SHEET No: **CC5426**

AZIMUTH: M.G.A.94 DATUM: A.H.D. ORIGIN: SSM 1112 PLAN No: **9985-12-CC5426**

Plotfile: 14 September, 2021 12:54:22 PM File Name: J:\9985ED\CC - Construction Certificate Approval Plans\PK12 WESTERN PRECINCTS\5 - Preprint\7B\9985-12-CC5426.dwg

Plotfile: 14 September, 2021 12:54:52 PM File Name: J:\9985DCC - Construction Certificate Approval Plans\PK12 WESTERN PRECINCTS5 - Preprint\7B\9985-12-CC5428.dwg

NOTE:
 - - - 1% AEP HGL PROVIDED FOR INFORMATION ONLY.
 - - - 5% AEP HGL

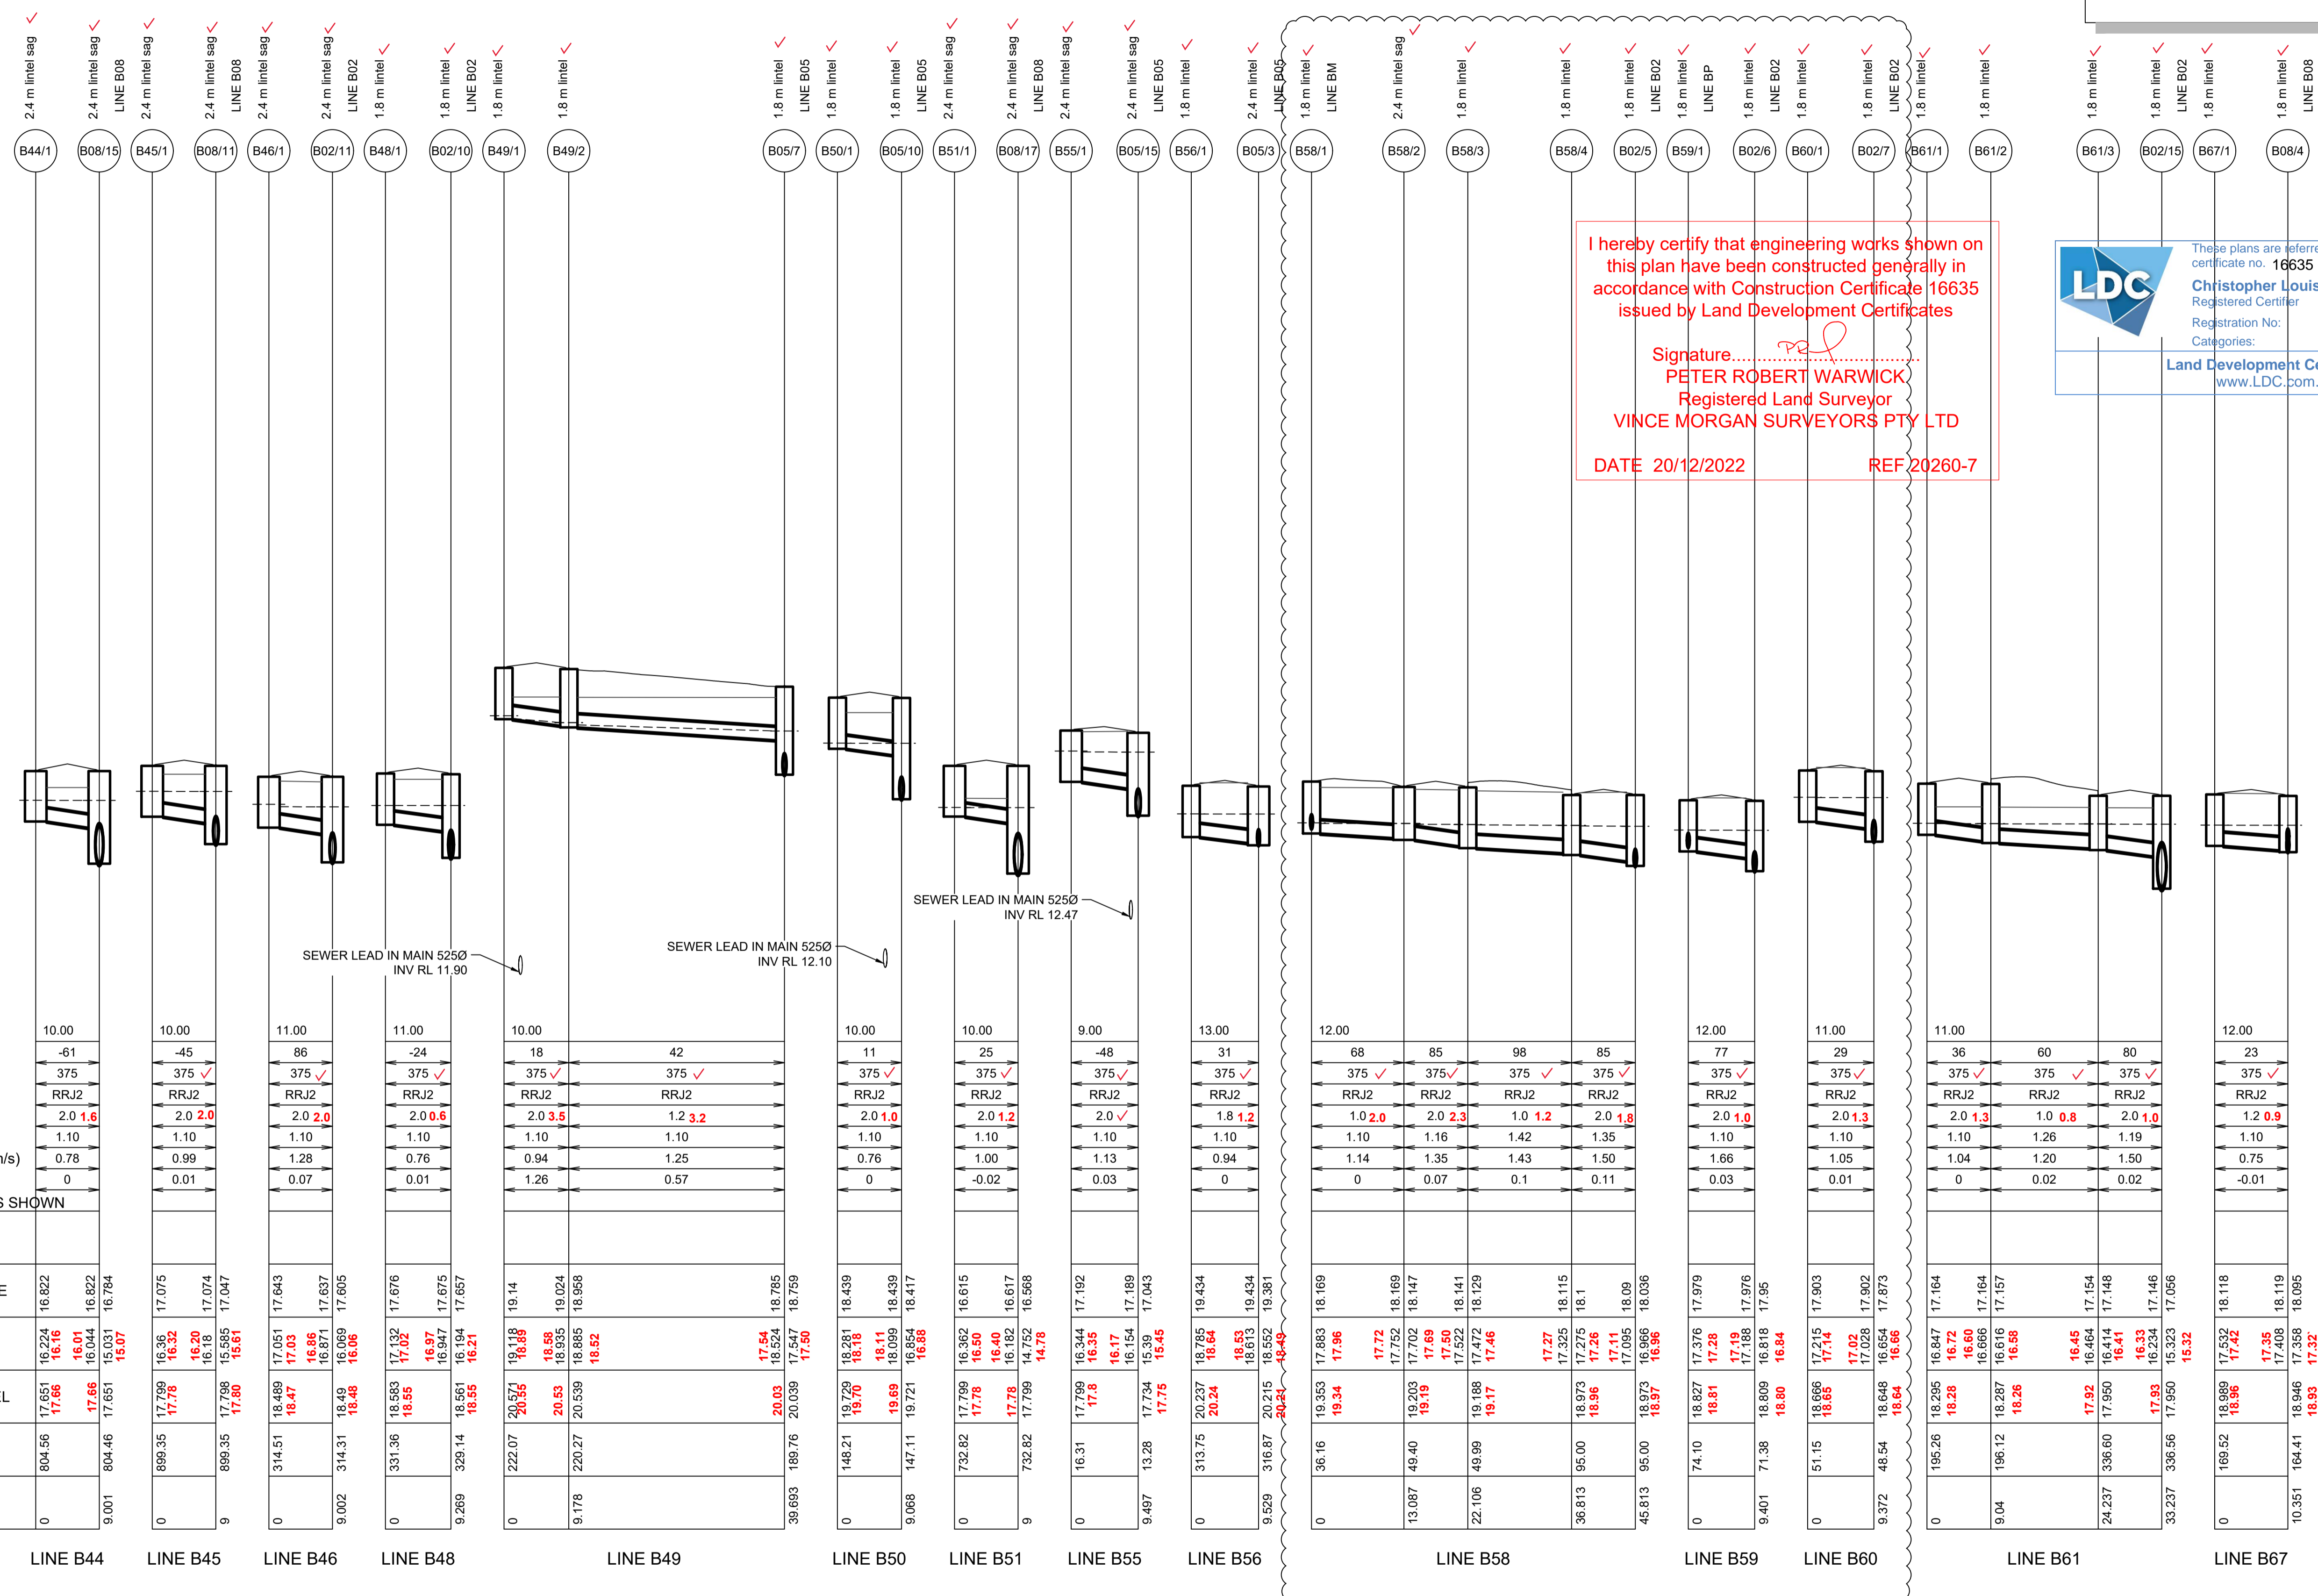

I hereby certify that engineering works shown on this plan have been constructed generally in accordance with Construction Certificate 16635 issued by Land Development Certificates

Signature: *[Signature]*
PETER ROBERT WARWICK
 Registered Land Surveyor
VINCE MORGAN SURVEYORS PTY LTD
 DATE 20/12/2022 REF 20260-7


These plans are referred to in certificate no. 16635 approved by:
Christopher Louis Wahbe
 Registered Certifier
 Registration No: BDC 3015
 Categories: Certifier - Subdivision
Land Development Certificates
 www.LDC.com.au

DATUM (m)	10.00
PEAK FLOW (L/s)	-61
PIPE SIZE (mm)	375
PIPE CLASS	RRJ2
PIPE GRADE (%)	2.0 1.6
PIPE COVER MINIMUM	1.10
FULL PIPE VELOCITY (m/s)	0.78
HGL GRADE (%)	0

NOTE: 10% AEP VALUES SHOWN

WAE

ROAD CHAINAGE	804.56		
PIPE CHAINAGE	0		

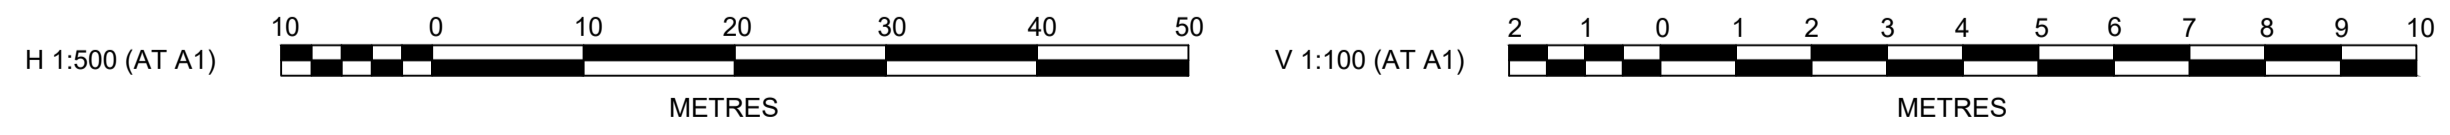

B	DRAINAGE LONG SECTIONS B58, B59 & B60 UPDATED	DG	VS	MP	MS	14/09/21
A	ISSUE FOR APPROVAL	DG	VS	MP	PJM	12/08/21
	AMENDMENT	DES	DRN	CKD	APR	DATE

J. WYNDHAM PRINCE
 CONSULTING CIVIL INFRASTRUCTURE ENGINEERS & PROJECT MANAGERS

PO Box 4366 PENRITH WESTFIELD NSW 2750
 P 02 4720 3300 W www.jwprince.com.au E jwp@jwprince.com.au

CLIENT: **WINTREN PROPERTY GROUP**

STATUS: **ISSUE FOR CONSTRUCTION APPROVAL**


THIS DRAWING MUST NOT BE USED FOR CONSTRUCTION UNLESS SIGNED AS PART OF AN APPROVED CONSTRUCTION CERTIFICATE.

NEWPARK PRECINCT 7, STAGE 7B
 LONGITUDINAL DRAINAGE SHEET 8

AZIMUTH: M.G.A.94 DATUM: A.H.D. ORIGIN: SSM 1112 PLAN No: 9985-12-CC5428

PROJECT No: **9985-12**
 SHEET No: **CC5428**

NOTE:
 ——— 1% AEP HGL PROVIDED FOR INFORMATION ONLY.
 - - - - 5% AEP HGL

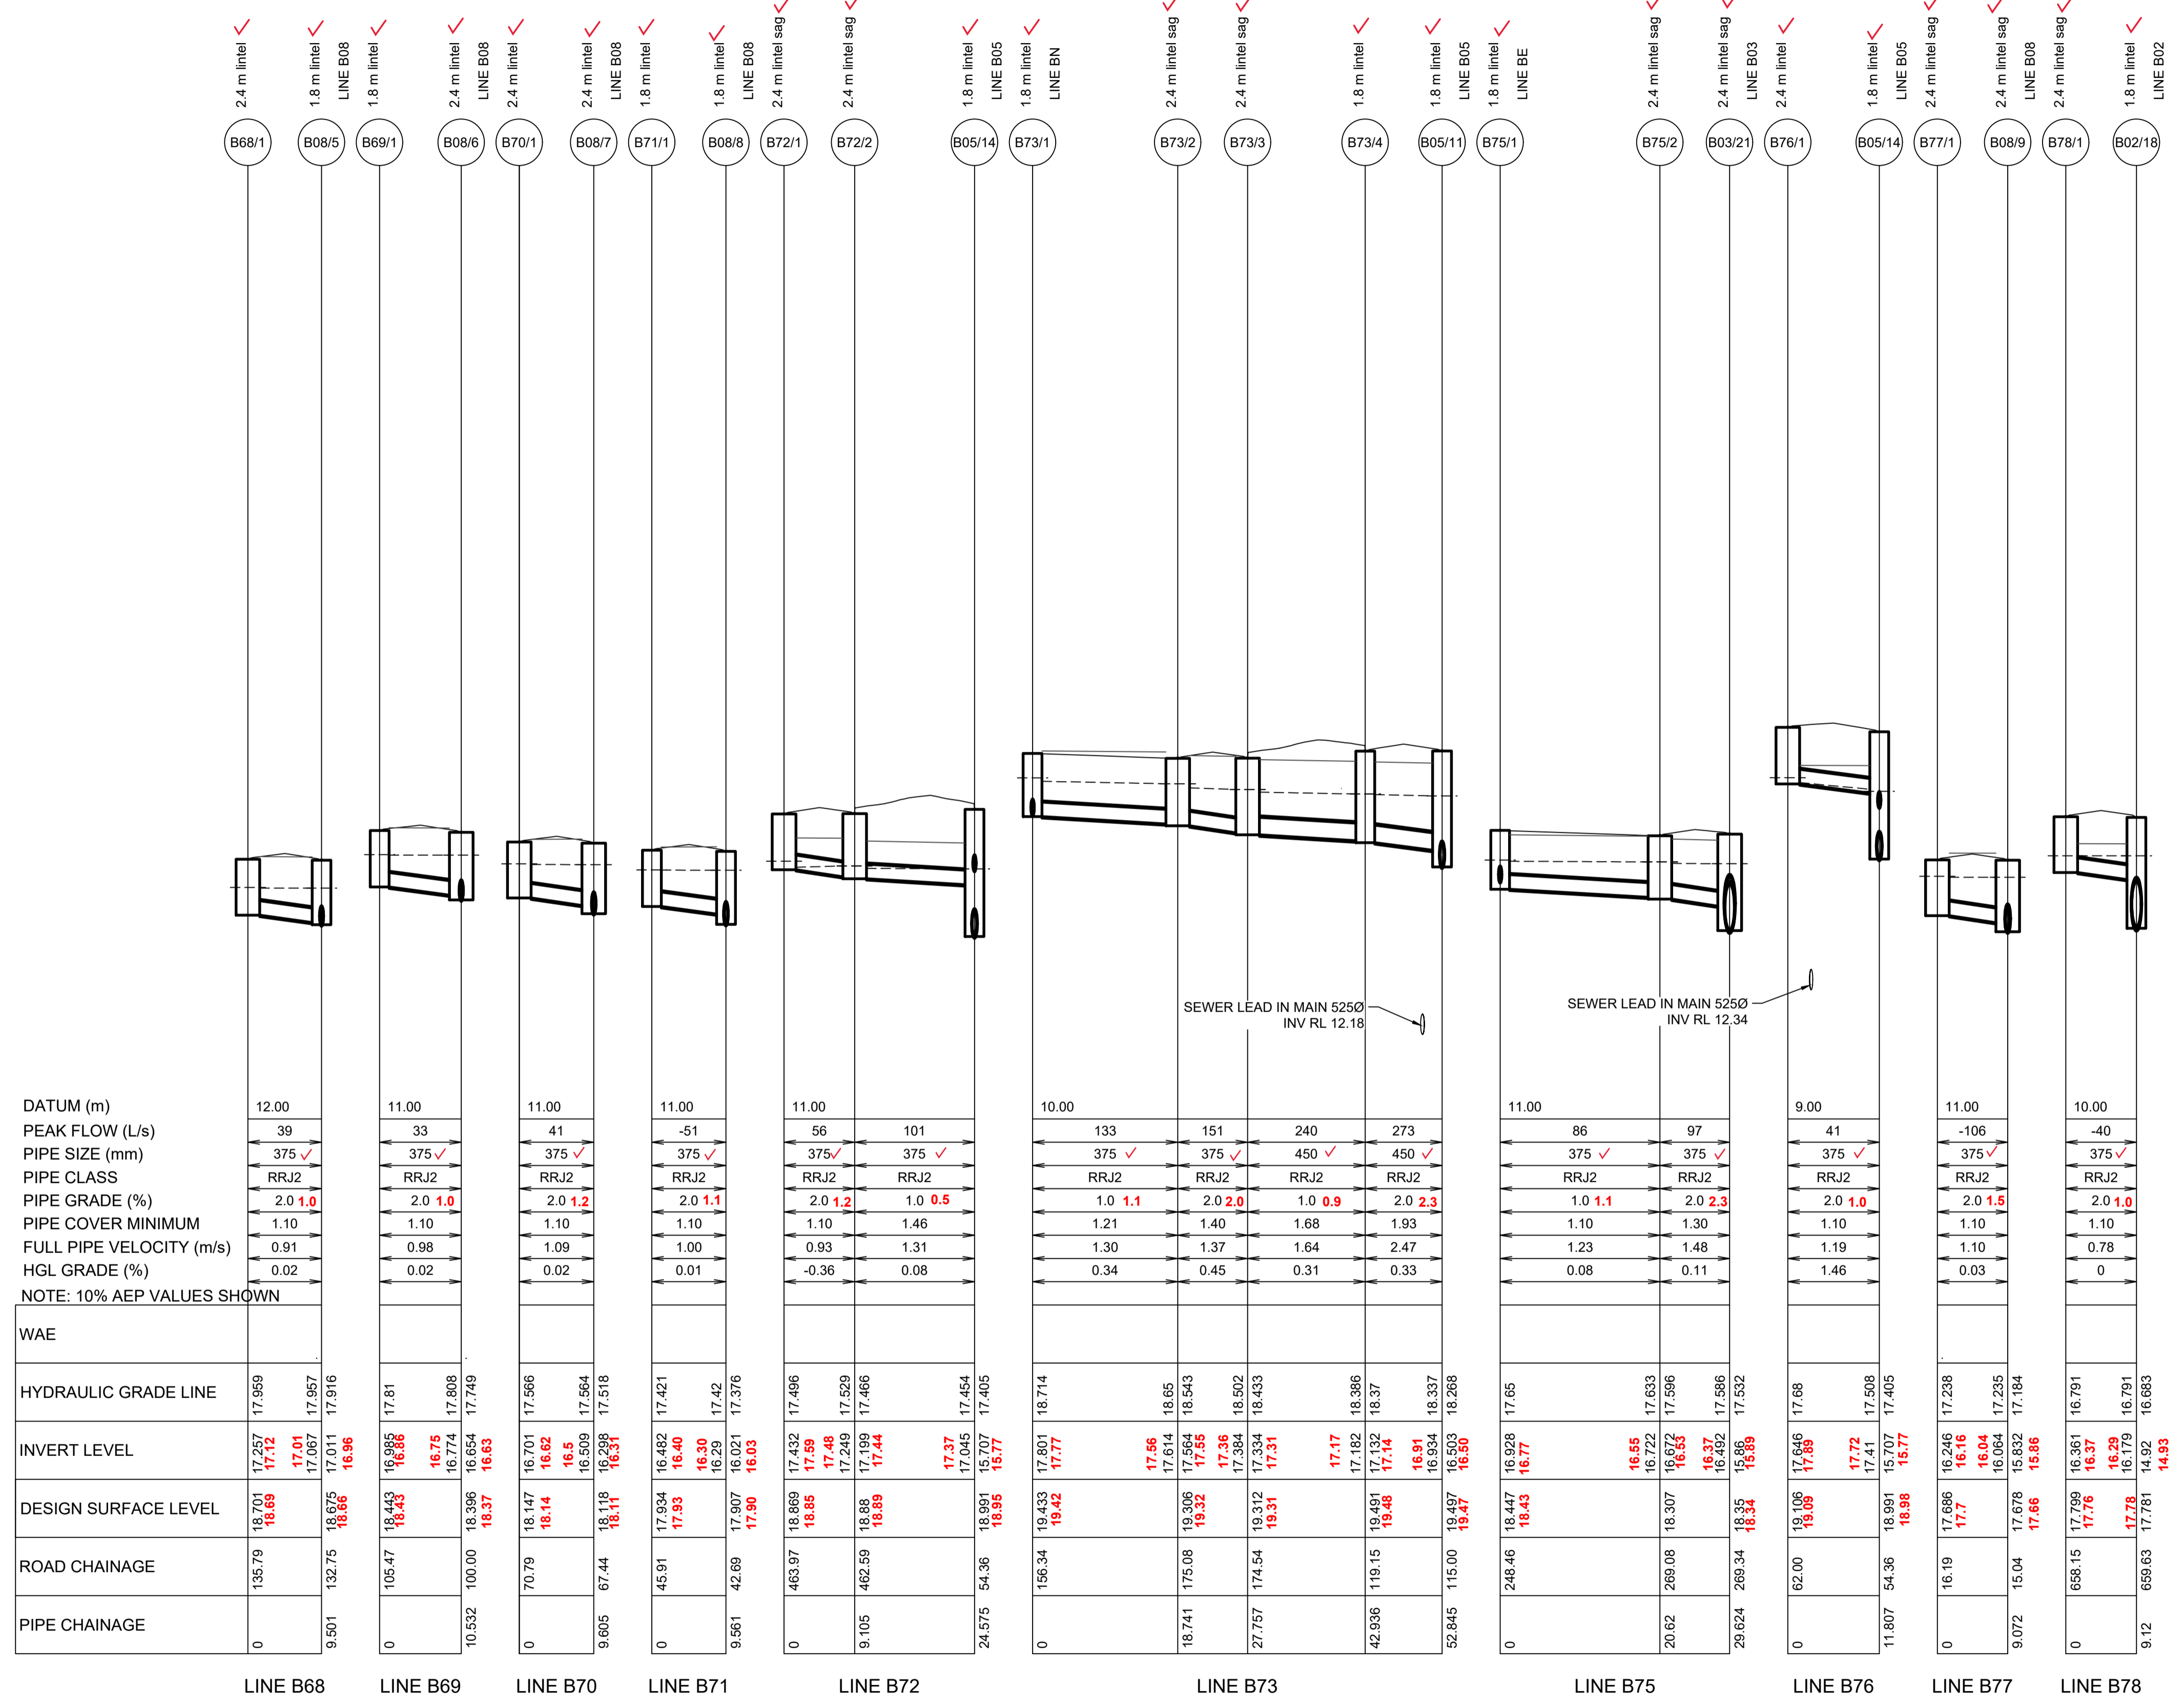


I hereby certify that engineering works shown on this plan have been constructed generally in accordance with Construction Certificate 16635 issued by Land Development Certificates

Signature: *[Signature]*
PETER ROBERT WARWICK
 Registered Land Surveyor
VINCE MORGAN SURVEYORS PTY LTD

DATE 20/12/2022 REF 20260-7

These plans are referred to in certificate no. 16635 approved by:
Christopher Louis Wahbe
 Registered Certifier
 Registration No: BDC 3015
 Categories: Certifier - Subdivision
Land Development Certificates
 www.LDC.com.au

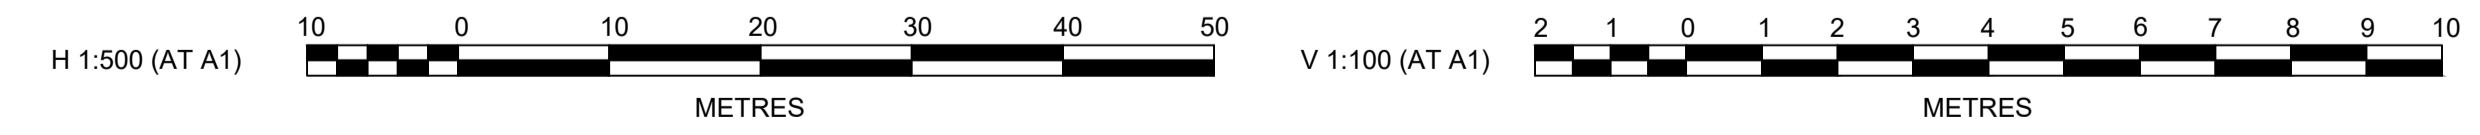

Plotted: 14 September, 2021 12:55:08 PM File Name: J:\9985DCC - Construction Certificate Approval Plans\PK12 WESTERN PRECINCTS5 - Preprint\7B\9985-12-CC5429.dwg

A	ISSUE FOR APPROVAL	DG	VS	MP	PJM	12/08/21
	AMENDMENT	DES	DRN	CKD	APR	DATE

J. WYNDHAM PRINCE
 CONSULTING CIVIL INFRASTRUCTURE ENGINEERS & PROJECT MANAGERS

PO Box 4366 PENRITH WESTFIELD NSW 2750
 P 02 4720 3300 W www.jwprince.com.au E jwp@jwprince.com.au

CLIENT: **WINTEN PROPERTY GROUP**

STATUS: **ISSUE FOR CONSTRUCTION APPROVAL**


THIS DRAWING MUST NOT BE USED FOR CONSTRUCTION UNLESS SIGNED AS PART OF AN APPROVED CONSTRUCTION CERTIFICATE.

NEWPARK PRECINCT 7, STAGE 7B
 LONGITUDINAL DRAINAGE SHEET 9

AZIMUTH: M.G.A.94 DATUM: A.H.D. ORIGIN: SSM 1112 PLAN No: 9985-12-CC5429

PROJECT No: **9985-12**
 SHEET No: **CC5429**

NOTE:
 - - - - - 5% AEP HGL

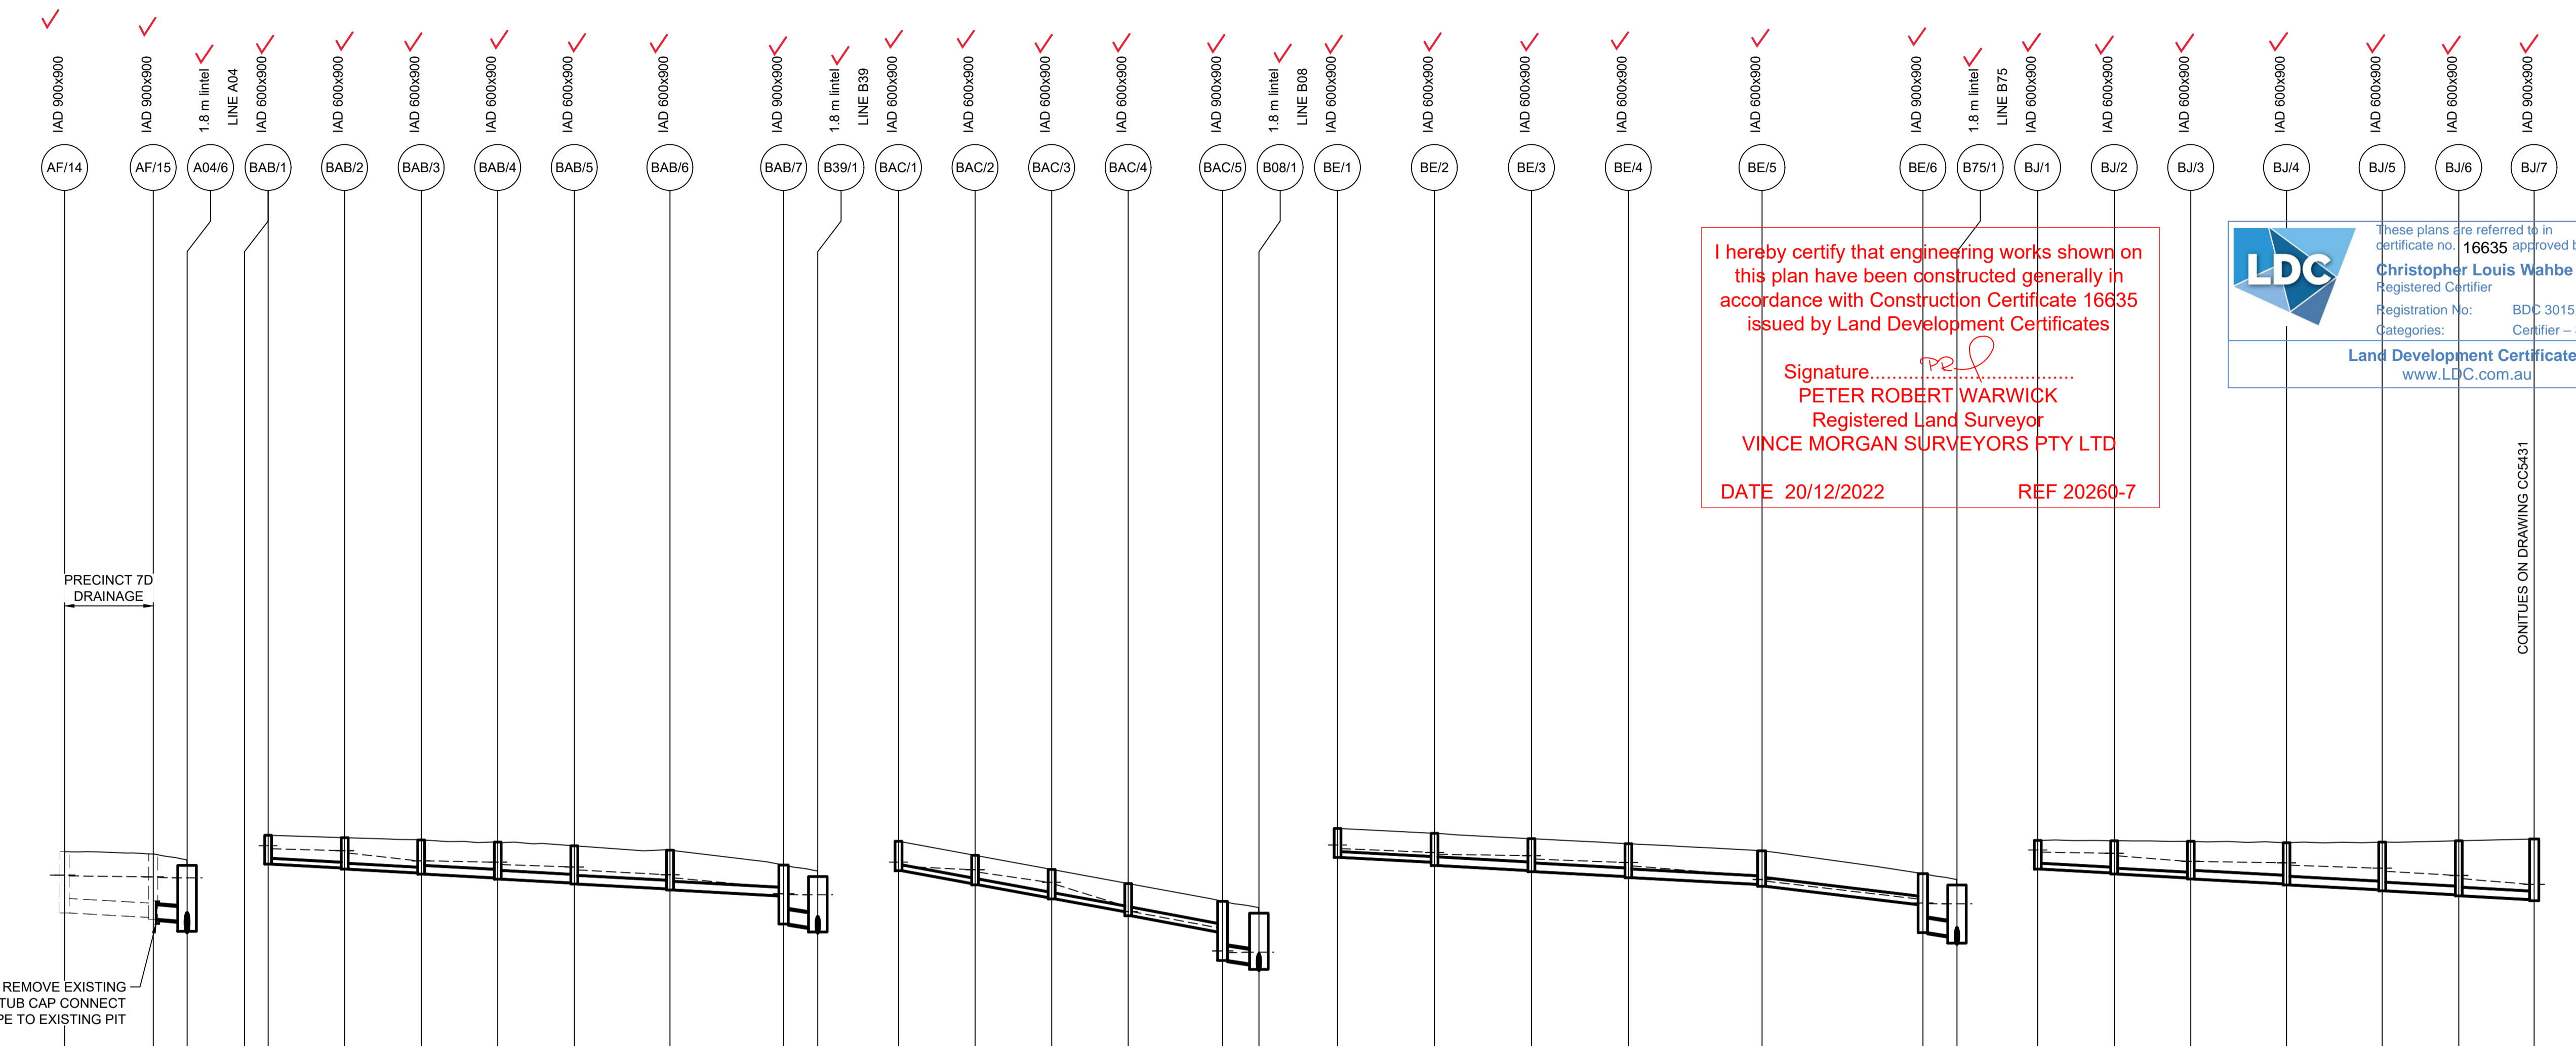

I hereby certify that engineering works shown on this plan have been constructed generally in accordance with Construction Certificate 16635 issued by Land Development Certificates

Signature: *[Signature]*
 PETER ROBERT WARWICK
 Registered Land Surveyor
 VINCE MORGAN SURVEYORS PTY LTD

DATE 20/12/2022 REF 20260-7

LDC These plans are referred to in certificate no. 16635 approved by:
Christopher Louis Wahbe
 Registered Certifier
 Registration No: BDC 3015
 Categories: Certifier - Subdivision
Land Development Certificates
 www.LDC.com.au

DATUM (m)	
PEAK FLOW (L/s)	144 143
PIPE SIZE (mm)	375 ✓ 375 ✓
PIPE CLASS	uPVC RRRJ2
PIPE GRADE (%)	1.0 1.0 0.9
PIPE COVER MINIMUM	1.22 1.24
FULL PIPE VELOCITY (m/s)	1.66 1.55
HGL GRADE (%)	0.23 0.34

NOTE: 5% AEP VALUES SHOWN

WAE	
HYDRAULIC GRADE LINE	18.748 18.705 18.687 18.666 18.648 18.633 18.487
INVERT LEVEL	17.748 18.05 17.893 18.347 18.284 17.508 17.19
DESIGN SURFACE LEVEL	19.32 19.957 19.22 18.961 18.933 17.239 18.487
ROAD CHAINAGE	
PIPE CHAINAGE	128.483 140.085 170.80 144.483 172.16 18.961 18.933 17.239 18.487





LINE AF


LINE BAB

LINE BAC

LINE BE

LINE BJ

LINE BAE REMOVED

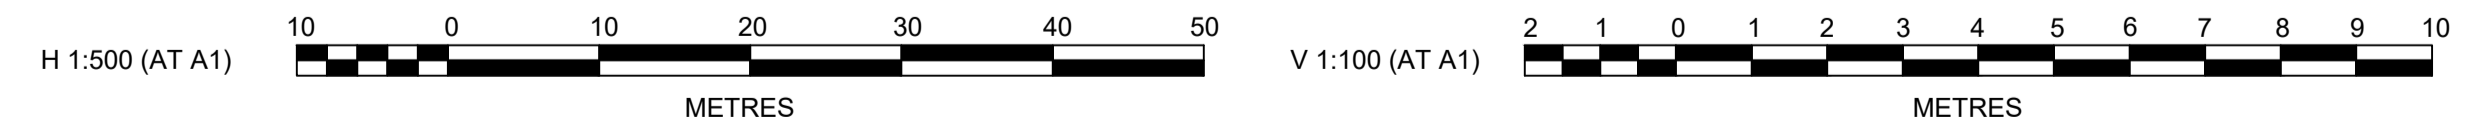

Plotfile: 14 September, 2021 12:55:39 PM File Name: J:\9985D\CC - Construction Certificate Approval Plans\PK12 WESTERN PRECINCTSIS - Precinct 7B\9985-12-CC5431.dwg

B	DRAINAGE LONG SECTION BAE REMOVED	DG	VS	MP	MS	14/09/21
A	ISSUE FOR APPROVAL	DG	VS	MP	PJM	12/08/21
	AMENDMENT	DES	DRN	CKD	APR	DATE

J. WYNDHAM PRINCE
 CONSULTING CIVIL INFRASTRUCTURE ENGINEERS & PROJECT MANAGERS

PO Box 4366 PENRITH WESTFIELD NSW 2750
 P 02 4720 3300 W www.jwprince.com.au E jwp@jwprince.com.au

CLIENT: **WINTEN PROPERTY GROUP**

STATUS: **ISSUE FOR CONSTRUCTION APPROVAL**

THIS DRAWING MUST NOT BE USED FOR CONSTRUCTION UNLESS SIGNED AS PART OF AN APPROVED CONSTRUCTION CERTIFICATE.

NEWPARK PRECINCT 7, STAGE 7B
 LONGITUDINAL DRAINAGE SHEET 11


PROJECT No: **9985-12**
 SHEET No: **CC5431**

AZIMUTH: M.G.A.94 DATUM: A.H.D. ORIGIN: SSM 1112 PLAN No: **9985-12-CC5431**

CONTINUES ON DRAWING CC5431

B

NOTE:
- - - - 5% AEP HGL

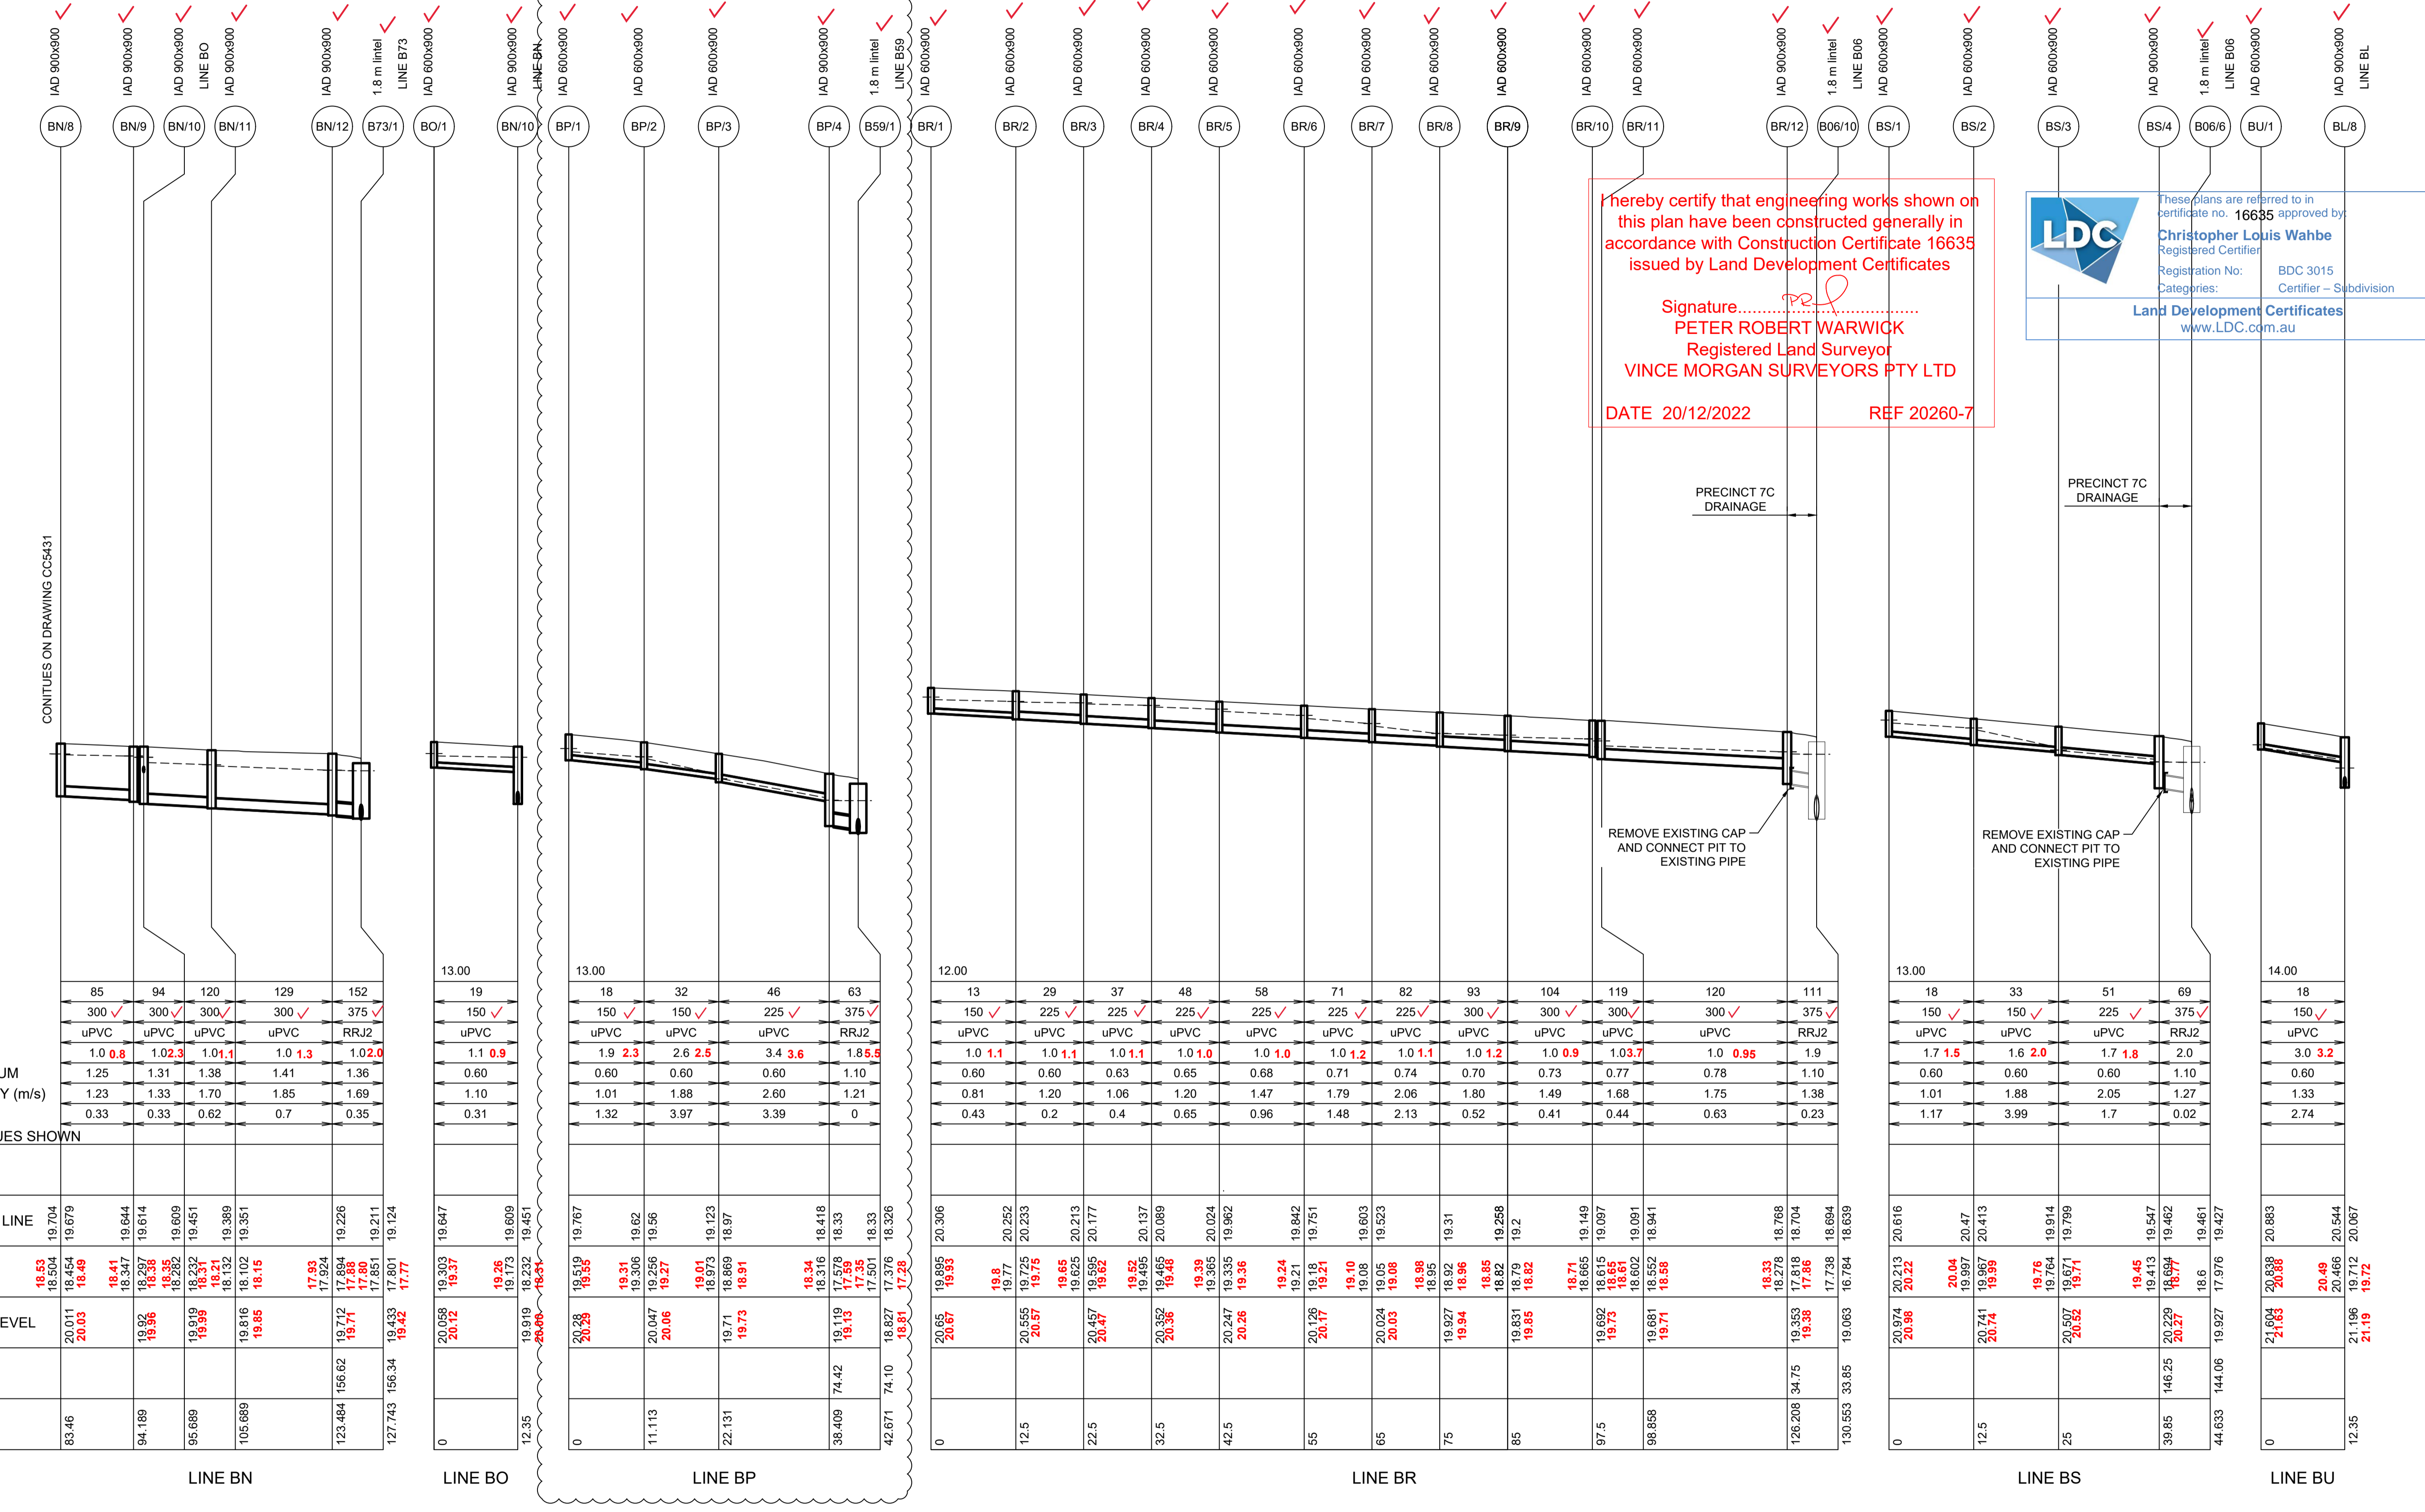

I hereby certify that engineering works shown on this plan have been constructed generally in accordance with Construction Certificate 16635 issued by Land Development Certificates

Signature: *[Signature]*
PETER ROBERT WARWICK
 Registered Land Surveyor
VINCE MORGAN SURVEYORS PTY LTD

DATE 20/12/2022 REF 20260-7

LDC These plans are referred to in certificate no. 16635 approved by
Christopher Louis Wahbe
 Registered Certifier
 Registration No: BDC 3015
 Categories: Certifier - Subdivision
Land Development Certificates
 www.LDC.com.au

LINE BN	LINE BO	LINE BP	LINE BR	LINE BS	LINE BU
85	19	18	13	18	18
300	150	150	150	150	150
uPVC	uPVC	uPVC	uPVC	uPVC	uPVC
1.0	1.1	1.9	1.0	1.7	3.0
1.25	0.60	0.60	0.60	0.60	0.60
1.23	1.10	1.01	0.81	1.01	1.33
0.33	0.31	1.32	0.43	1.17	2.74

Plotfile: 14 September, 2021 12:56:11 PM File Name: J:\9985D\CC - Construction Certificate Approval Plans\PK12 WESTERN PRECINCTS\5 - Precinct 7\9985-12-CC5433.dwg

AMENDMENT	DES	DRN	CKD	APR	DATE
B DRAINAGE LONG SECTION BP UPDATED	DG	VS	MP	MS	14/09/21
A ISSUE FOR APPROVAL	DG	VS	MP	PJM	12/08/21

J. WYNDHAM PRINCE
 CONSULTING CIVIL INFRASTRUCTURE ENGINEERS & PROJECT MANAGERS

PO Box 4366 PENRITH WESTFIELD NSW 2750
 P 02 4720 3300 W www.jwprince.com.au E jwp@jwprince.com.au

CLIENT:
WINTEN PROPERTY GROUP

STATUS:
ISSUE FOR CONSTRUCTION APPROVAL

THIS DRAWING MUST NOT BE USED FOR CONSTRUCTION UNLESS SIGNED AS PART OF AN APPROVED CONSTRUCTION CERTIFICATE.


NEWPARK PRECINCT 7, STAGE 7B
 LONGITUDINAL DRAINAGE SHEET 13

AZIMUTH: M.G.A.94 DATUM: A.H.D. ORIGIN: SSM 1112 PLAN No: 9985-12-CC5433

PROJECT No:
9985-12

SHEET No:
CC5433

B

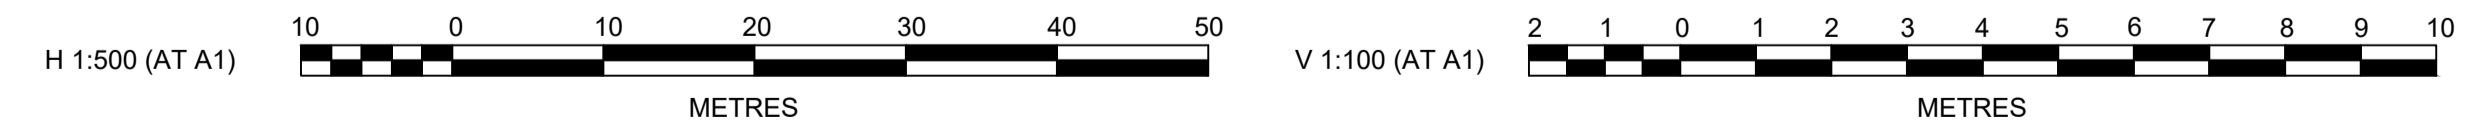


TAILOUT NOT CONSTRUCTED


I hereby certify that engineering works shown on this plan have been constructed generally in accordance with Construction Certificate 16635 issued by Land Development Certificates

Signature: *[Signature]*
PETER ROBERT WARWICK
 Registered Land Surveyor
VINCE MORGAN SURVEYORS PTY LTD


DATE 20/12/2022 REF 20260-7

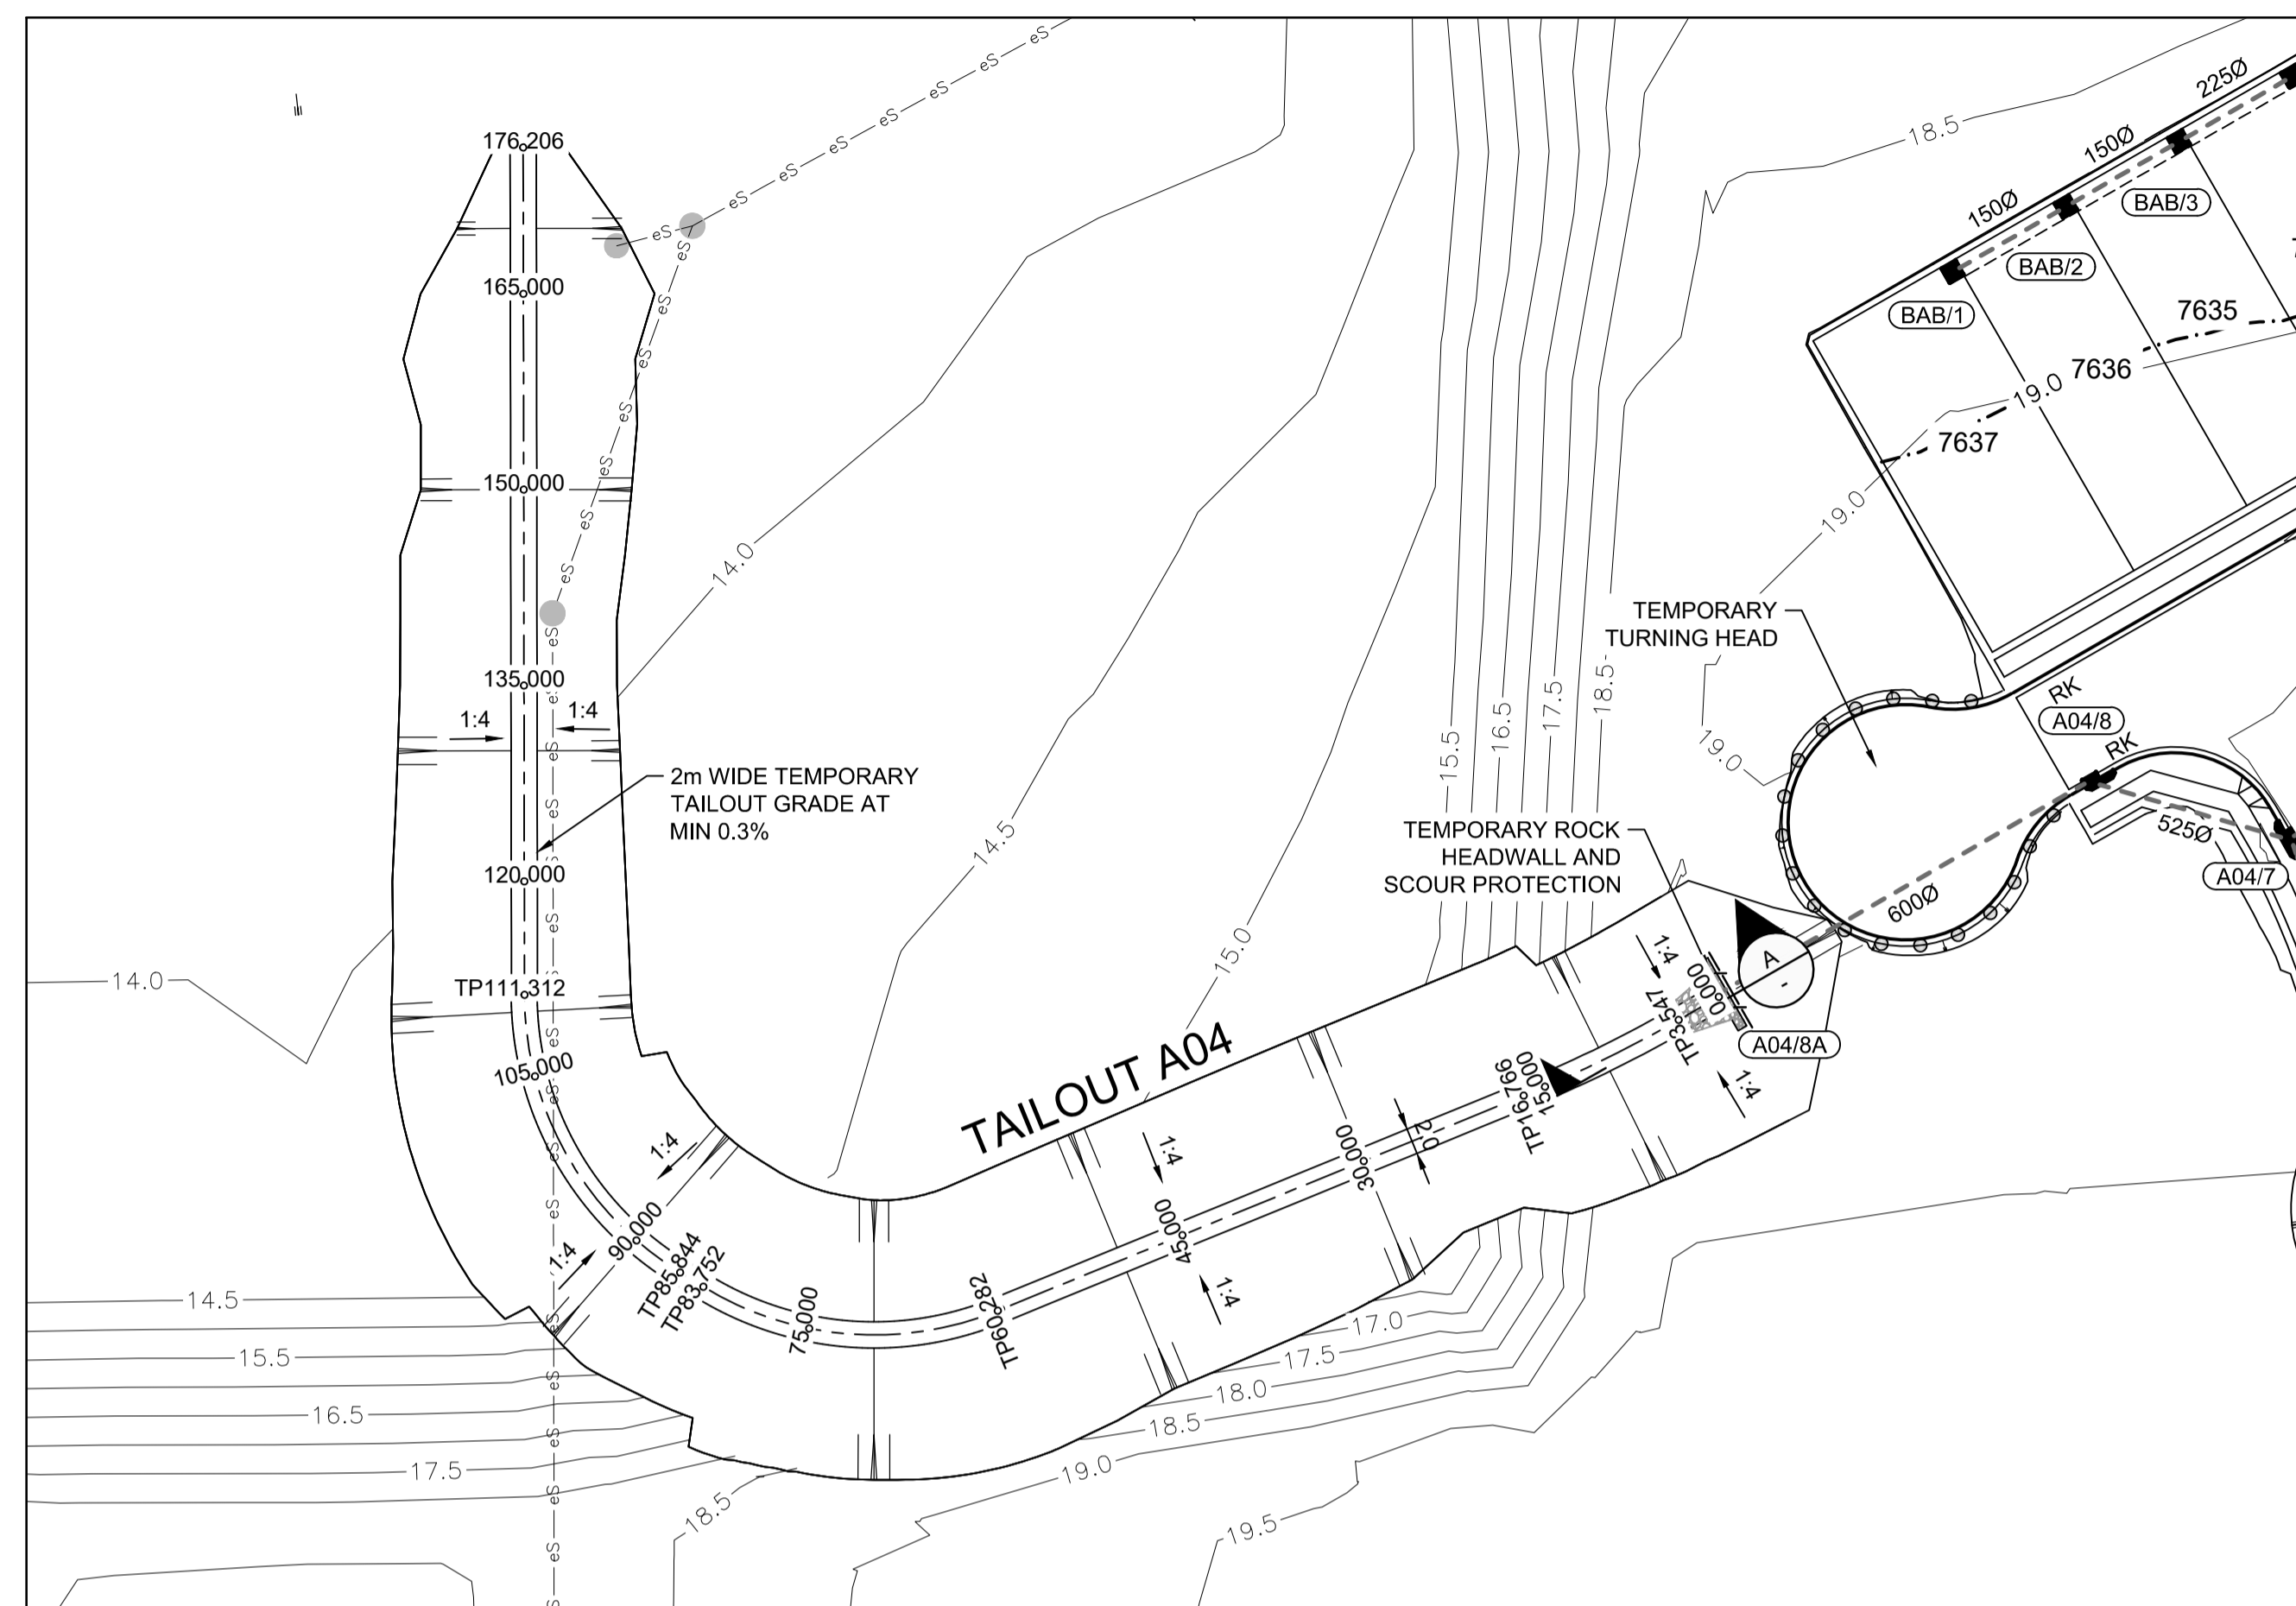

PLAN
SCALE 1:500

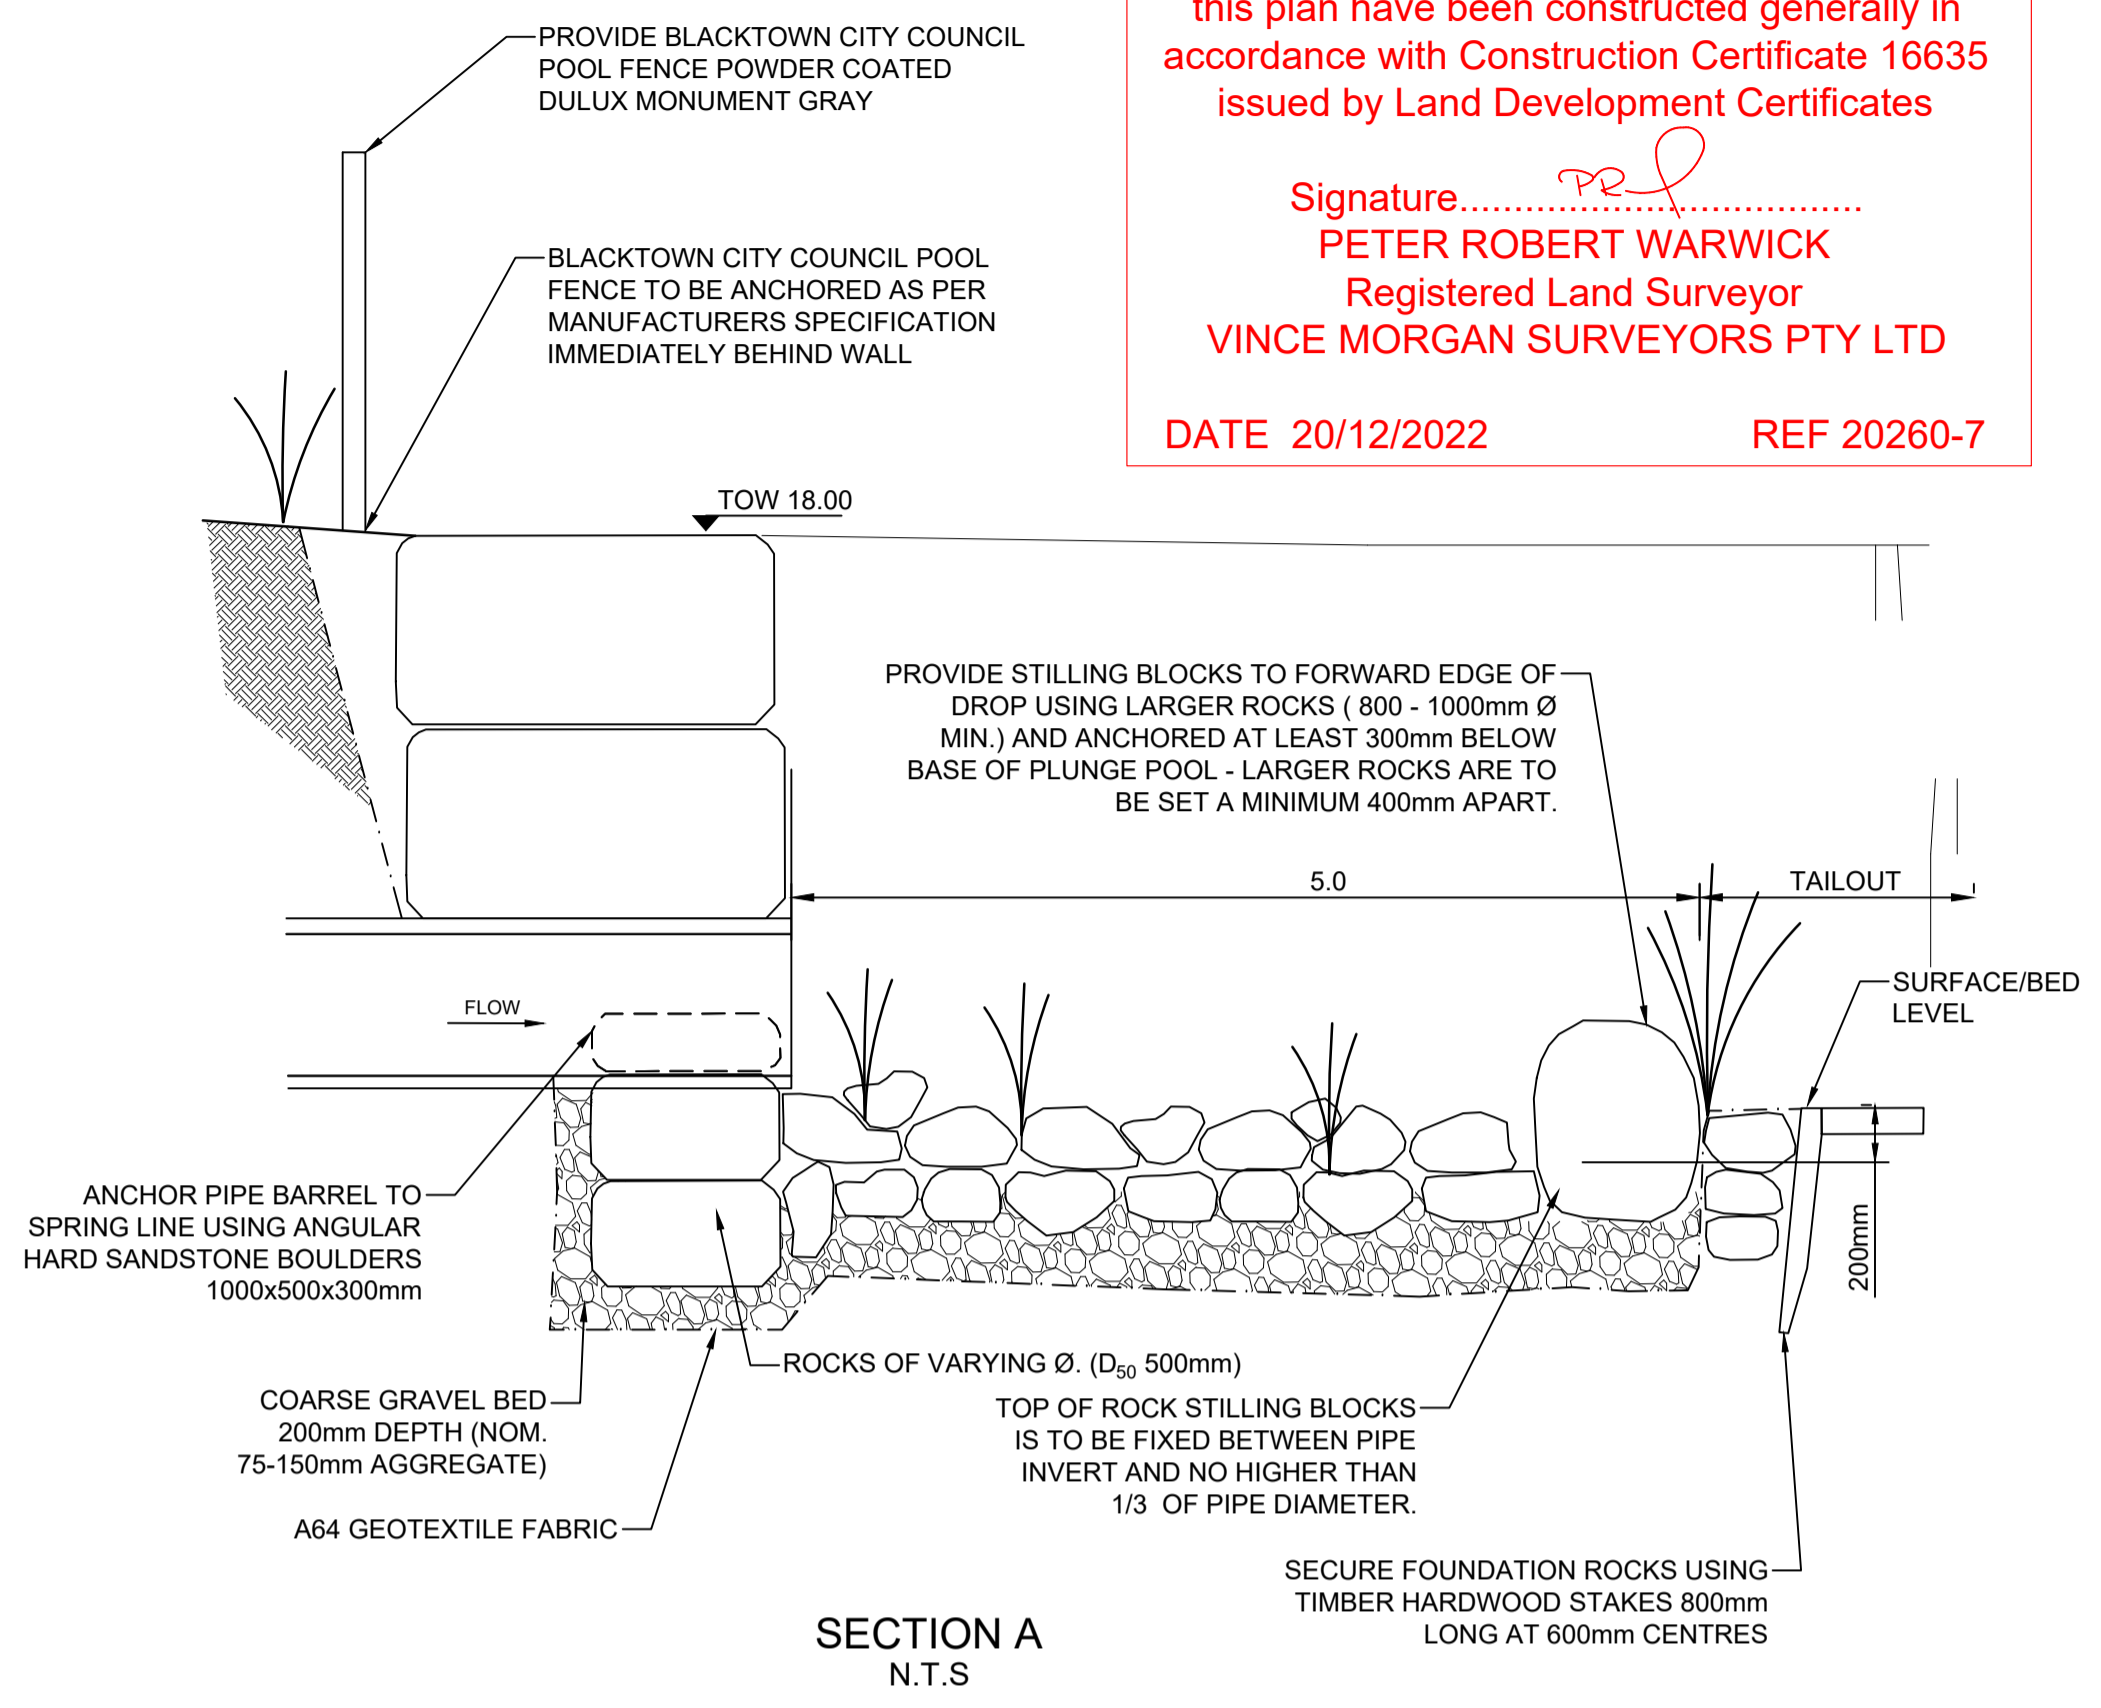


SECTION A
N.T.S.

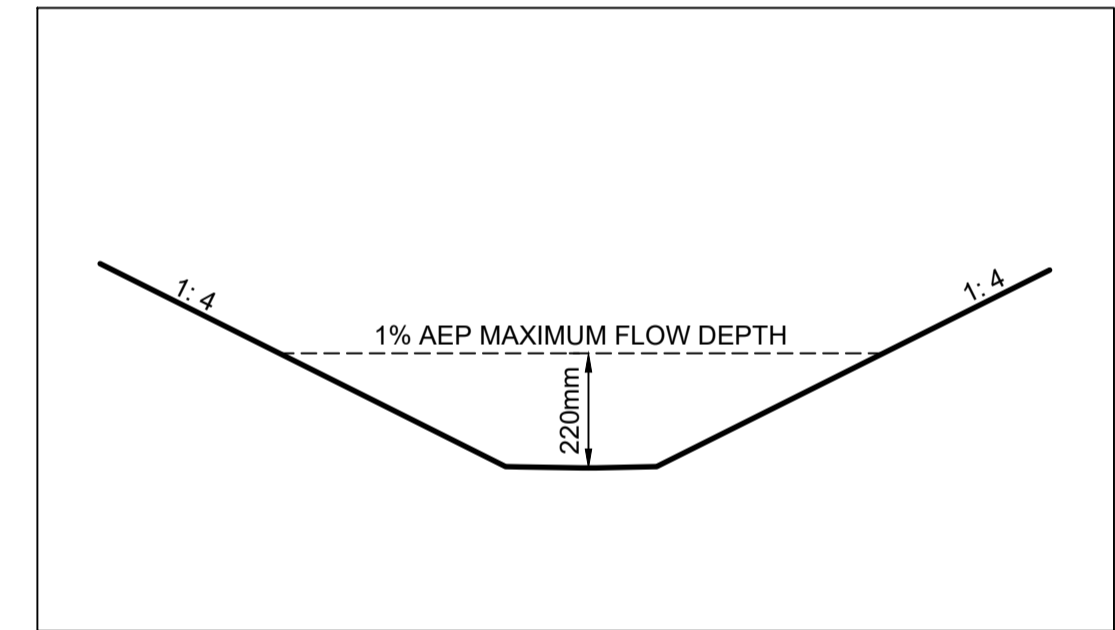

TYPICAL TAILOUT SECTION
N.T.S.


These plans are referred to in certificate no. 16635 approved by:
Christopher Louis Wahbe
 Registered Certifier
 Registration No: BDC 3015
 Categories: Certifier - Subdivision
Land Development Certificates
 www.LDC.com.au

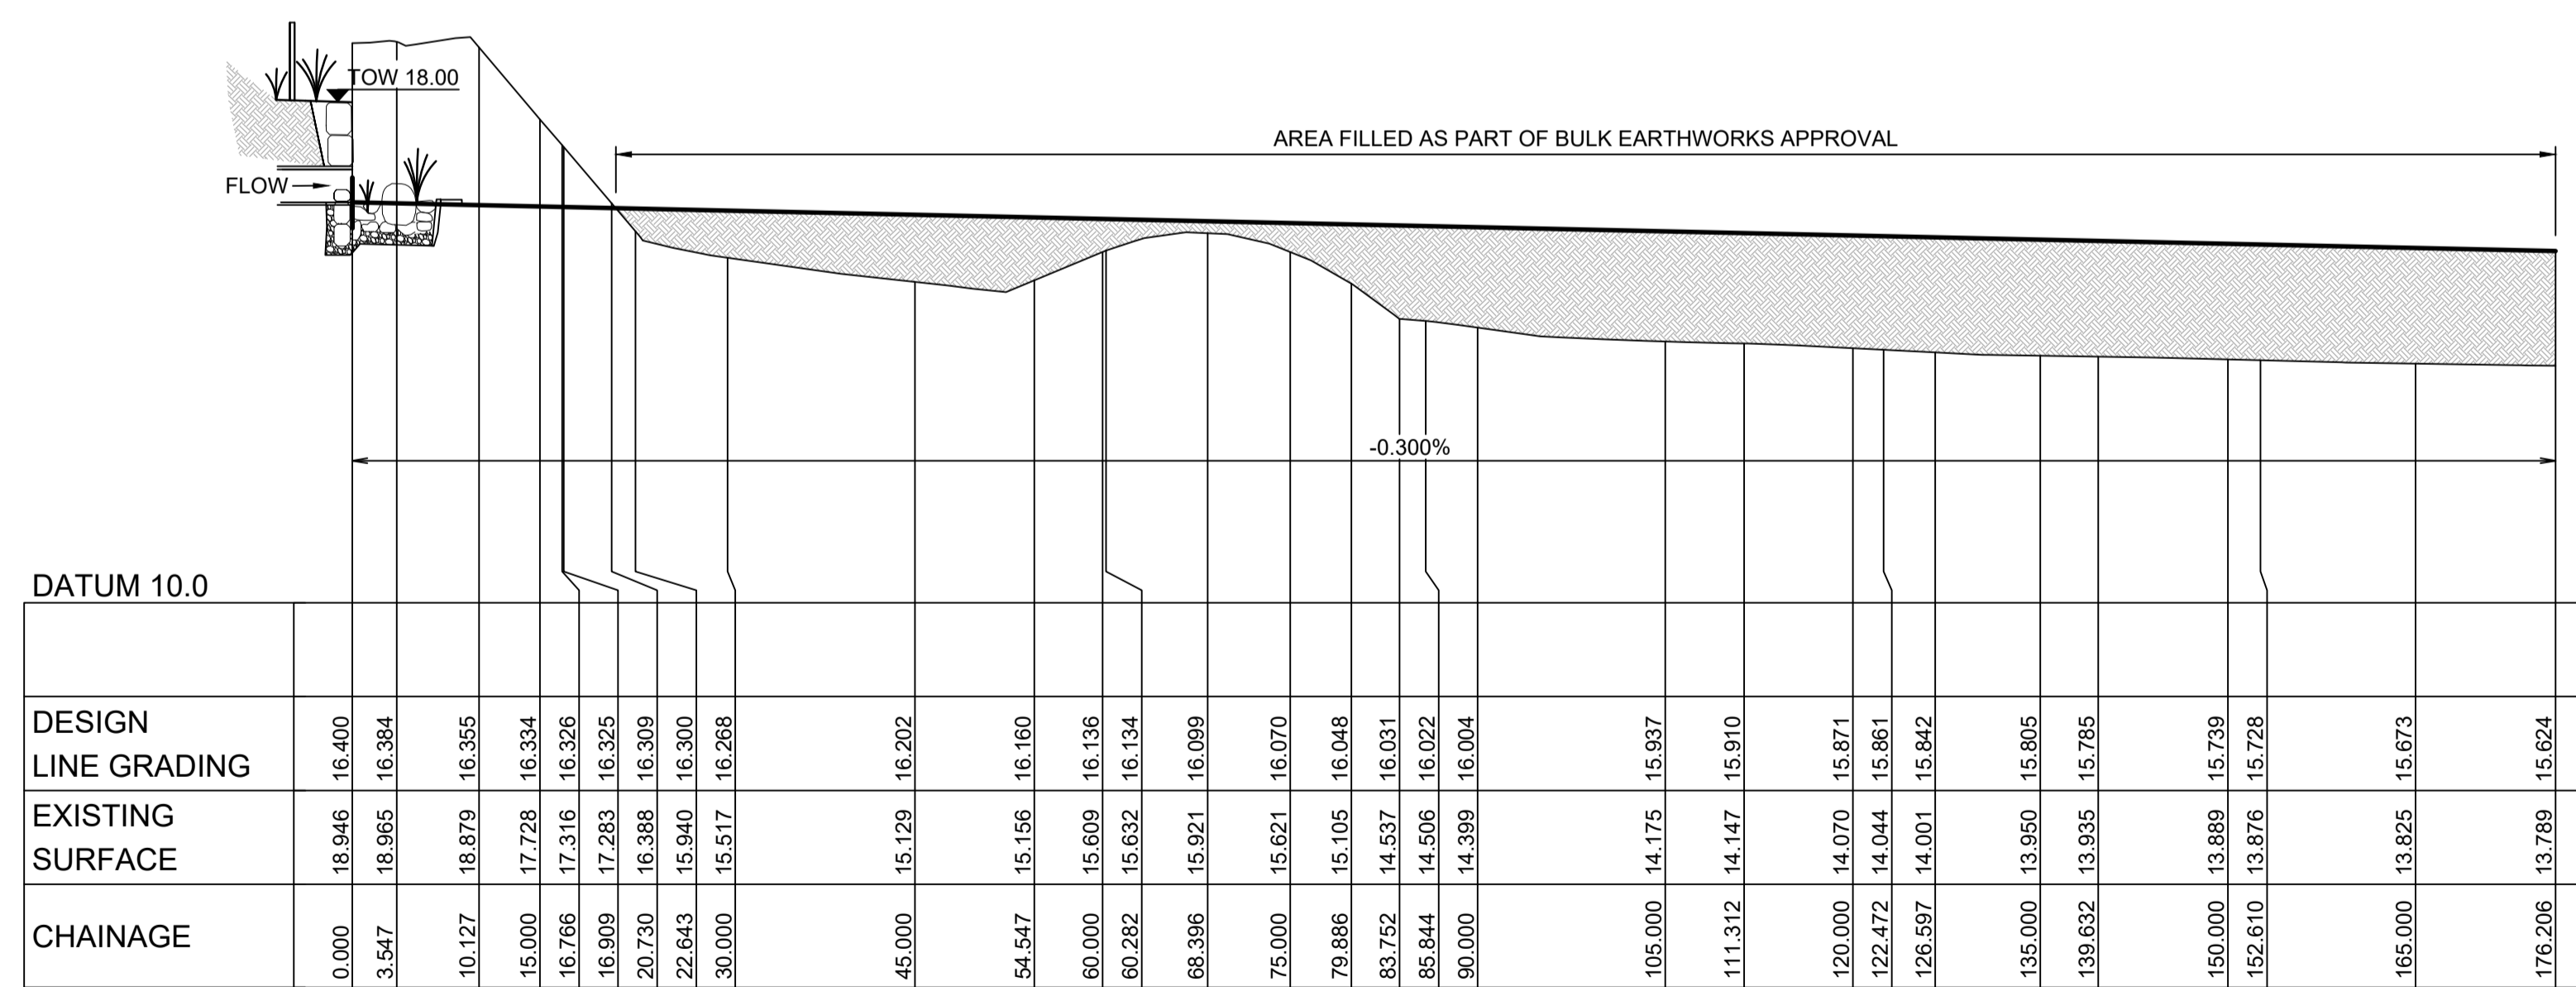

LONGITUDINAL SECTION TAILOUT A04
HORIZONTAL SCALE 1:500
VERTICAL SCALE 1:100

DATUM 10.0		CHAINAGE	EASTING	NORTHING	BEARING	RAD/SPIRAL	A LENGTH
DESIGN LINE GRADING		0.000					
EXISTING SURFACE		0.000	18.946	16.400			
		3.547	18.965	16.384			
		10.127	18.879	16.355			
		15.000	17.728	16.334			
		16.766	17.316	16.326			
		16.909	17.283	16.325			
		20.730	16.388	16.309			
		22.643	15.940	16.300			
		30.000	15.517	16.268			
		45.000	15.129	16.202			
		54.547	15.156	16.160			
		60.000	15.609	16.136			
		60.282	15.632	16.134			
		68.396	15.921	16.099			
		75.000	15.621	16.070			
		79.886	15.105	16.048			
		83.752	14.537	16.031			
		85.844	14.506	16.022			
		90.000	14.399	16.004			
		105.000	14.175	15.937			
		111.312	14.147	15.910			
		120.000	14.070	15.871			
		122.472	14.044	15.861			
		126.597	14.001	15.842			
		135.000	13.950	15.805			
		139.632	13.935	15.785			
		150.000	13.889	15.739			
		152.610	13.876	15.728			
		165.000	13.825	15.672			
		176.206	13.789	15.624			

TAILOUT A04						
CHAINAGE	EASTING	NORTHING	BEARING	RAD/SPIRAL	A LENGTH	
0	295050.32	6268963.93	248°40'51.79"			
3.55	295047.01	6268962.64	248°40'51.79"			
10.16	295040.85	6268960.23		100	13.22	
16.77	295034.42	6268958.66	256°15'17.87"			
60.28	294992.15	6268948.32	256°15'17.87"			
72.02	294979.83	6268945.31		25	23.47	
83.75	294970.12	6268953.47	310°02'43.35"			
85.84	294968.52	6268954.81	310°02'43.35"			
98.58	294957.83	6268963.8		25	25.47	
111.31	294959.87	6268977.61	8°24'49.73"			
176.21	294969.37	6269041.8	8°24'49.73"			

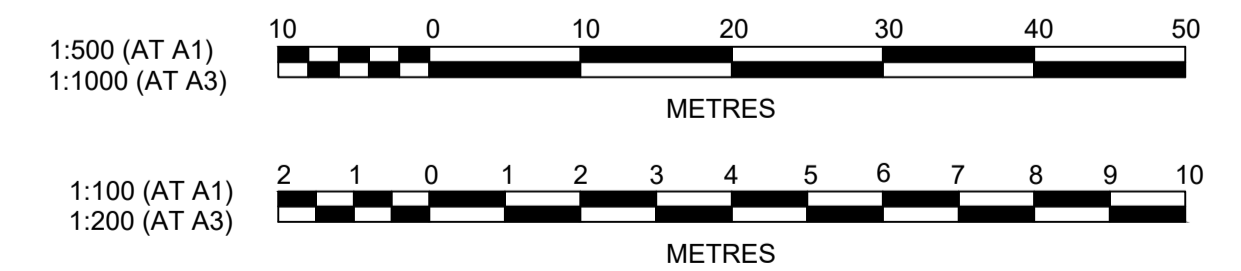

J. WYNDHAM PRINCE
 CONSULTING CIVIL INFRASTRUCTURE ENGINEERS & PROJECT MANAGERS
 PO Box 4366 PENRITH WESTFIELD NSW 2750
 P 02 4720 3300 W www.jwprince.com.au E jwp@jwprince.com.au



ISSUE FOR CONSTRUCTION APPROVAL
 THIS DRAWING MUST NOT BE USED FOR CONSTRUCTION UNLESS SIGNED AS PART OF AN APPROVED CONSTRUCTION CERTIFICATE.


NEWPARK PRECINCT 7, STAGE 7B TAILOUT A04 PLAN

PROJECT No: **9985-12**
 SHEET No: **CC5500**


AZIMUTH: M.G.A.94 DATUM: A.H.D. ORIGIN: SSM 1112 PLAN No: **9985-12-CC5500**

Plotfile: 14 September, 2021 12:57:47 PM File Name: J:\9985ED\CC - Construction Certificate Approval Plans\PK12 WESTERN PRECINCTS15 - Preprint\7B\9985-12-CC5500.dwg

NO.	DESCRIPTION	DATE	BY	CHECKED	APPROVED
A	ISSUE FOR APPROVAL	12/08/21	PJM	VS	DG
	AMENDMENT				

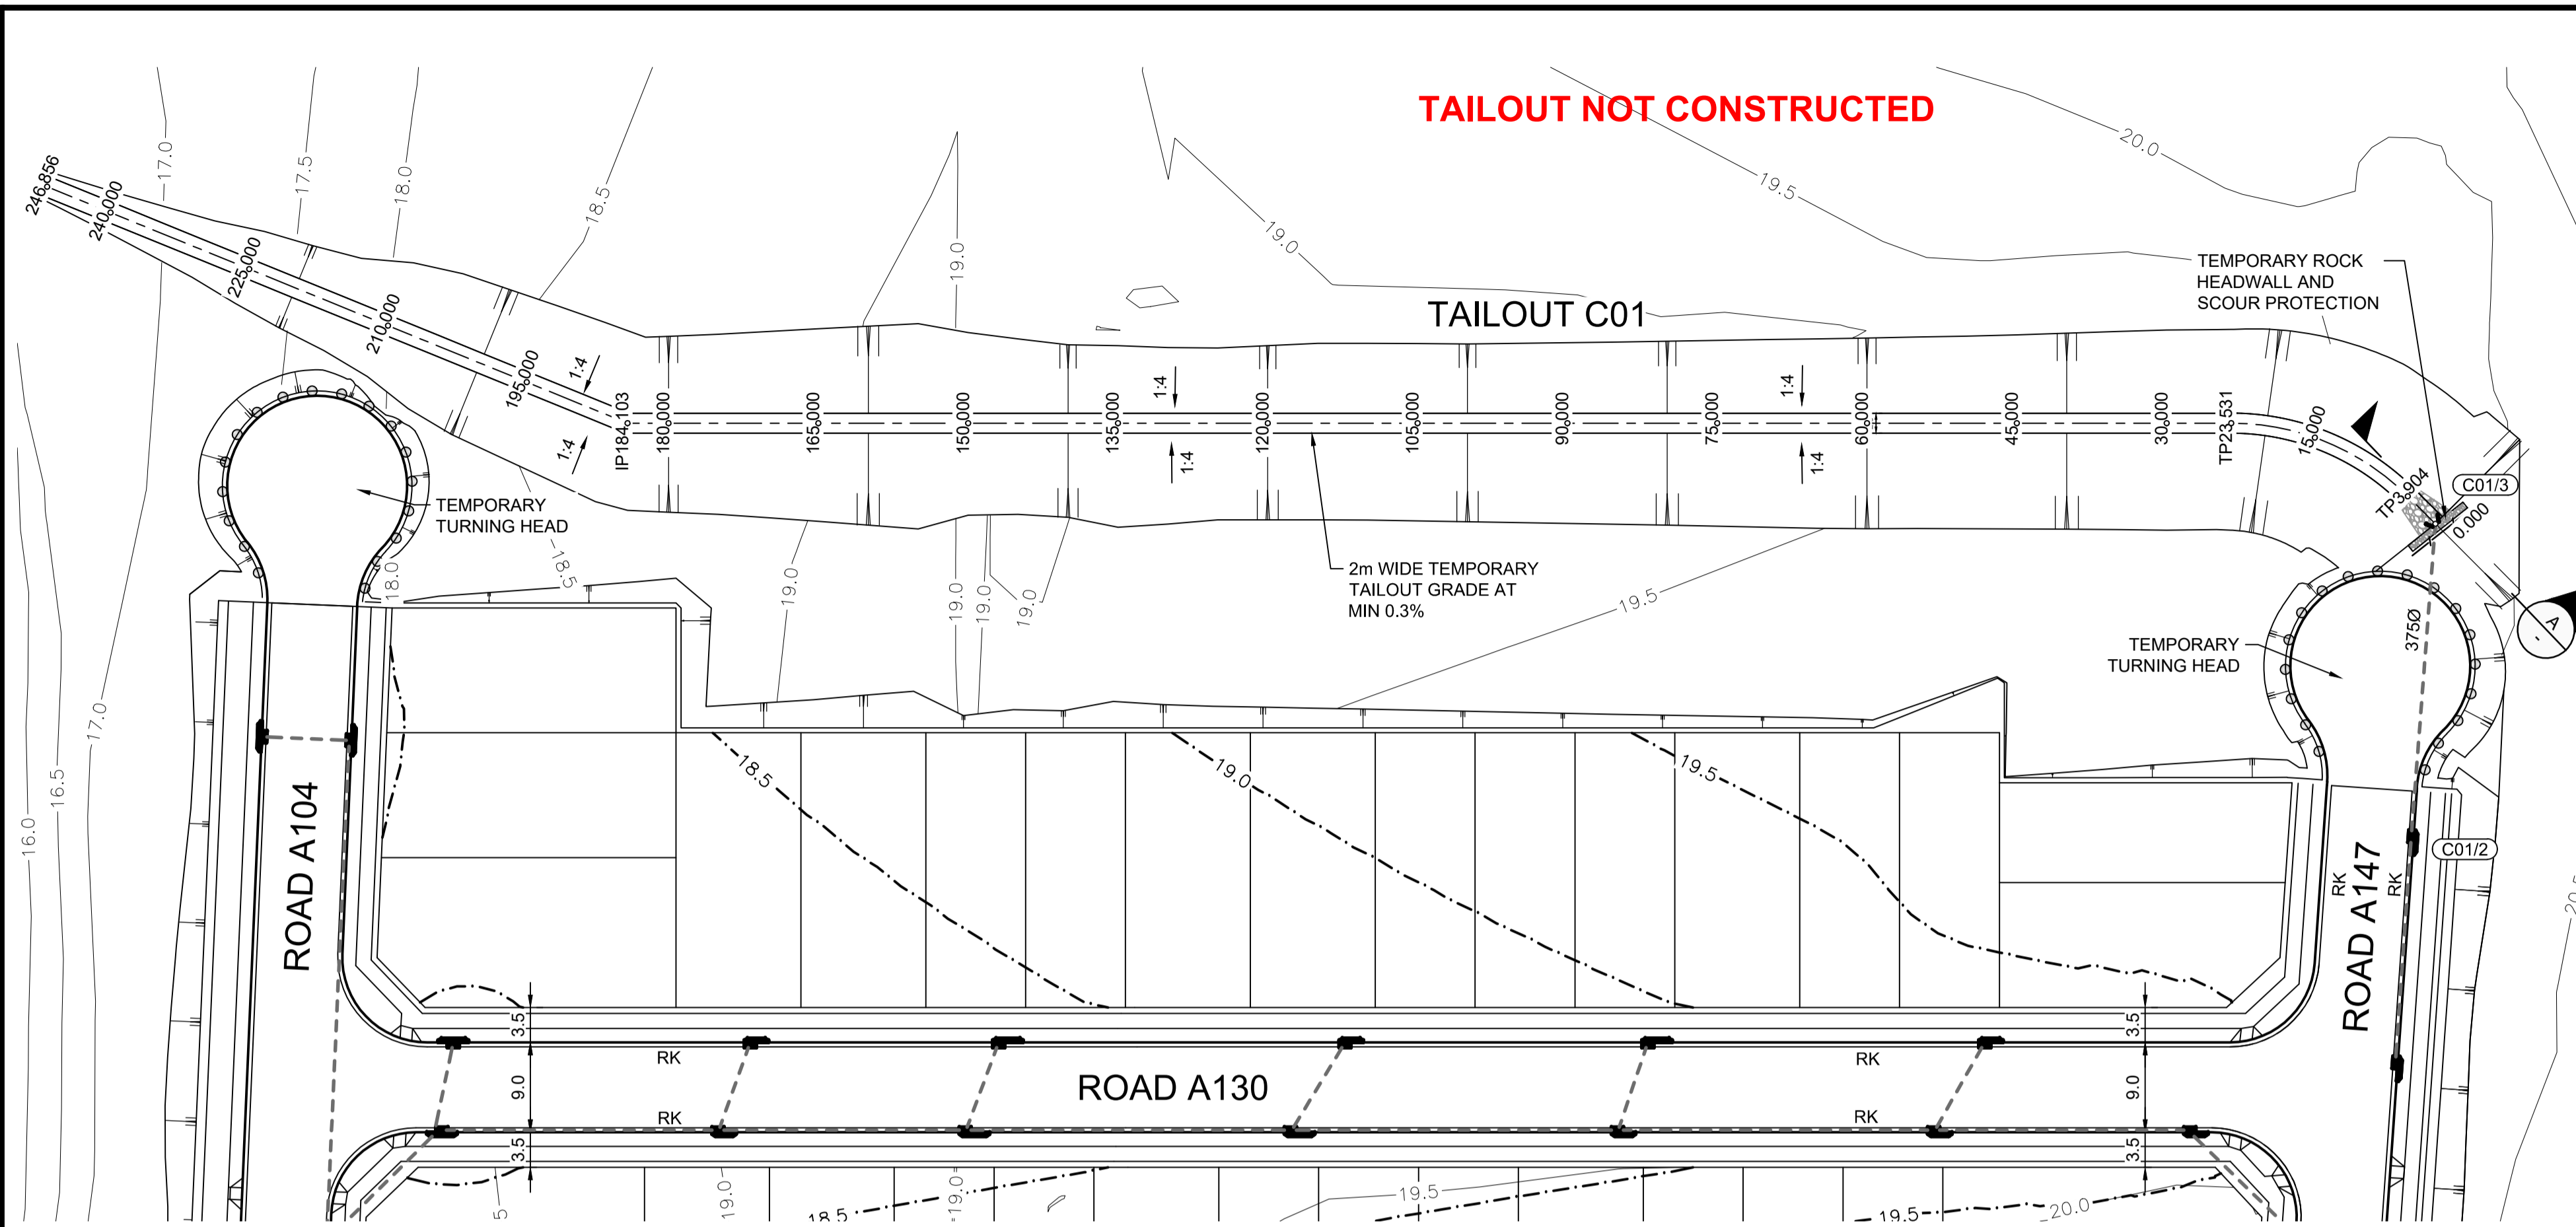

PLAN
SCALE 1:500

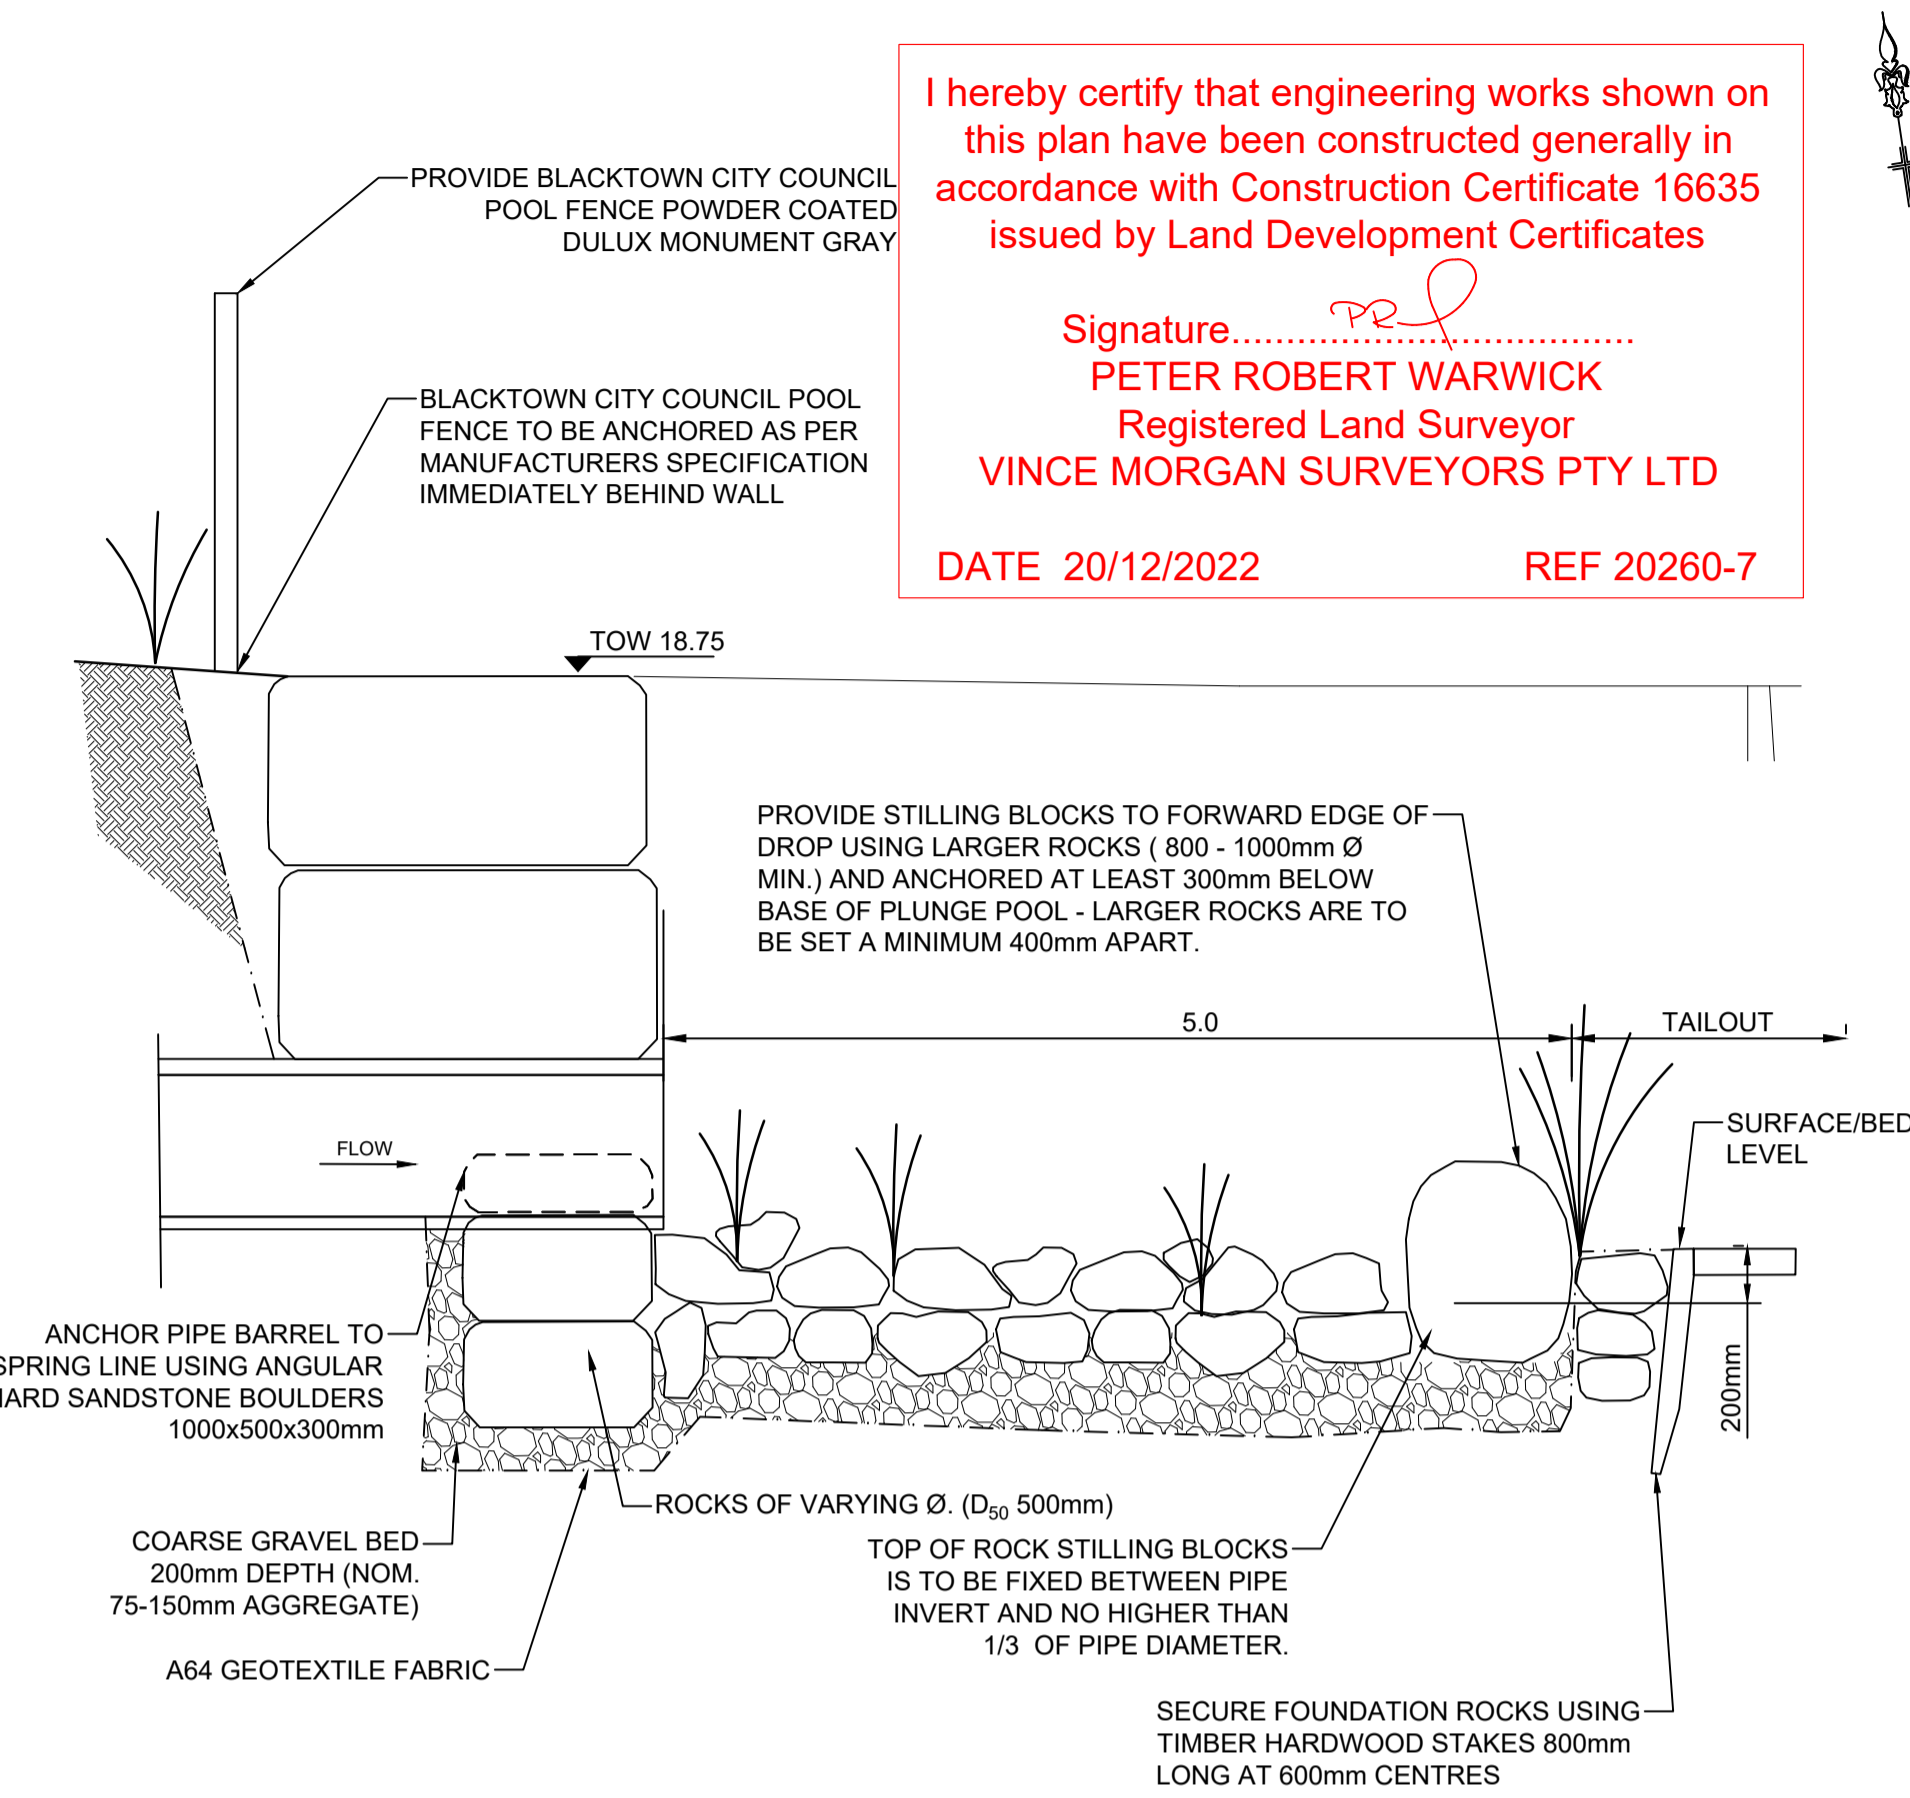

I hereby certify that engineering works shown on this plan have been constructed generally in accordance with Construction Certificate 16635 issued by Land Development Certificates

Signature.....
PETER ROBERT WARWICK
 Registered Land Surveyor
VINCE MORGAN SURVEYORS PTY LTD

DATE 20/12/2022 REF 20260-7


SECTION A
N.T.S

These plans are referred to in certificate no. 16635 approved by:

LDC Christopher Louis Wahbe
 Registered Certifier

Registration No: BDC 3015
 Categories: Certifier - Subdivision

Land Development Certificates
 www.LDC.com.au

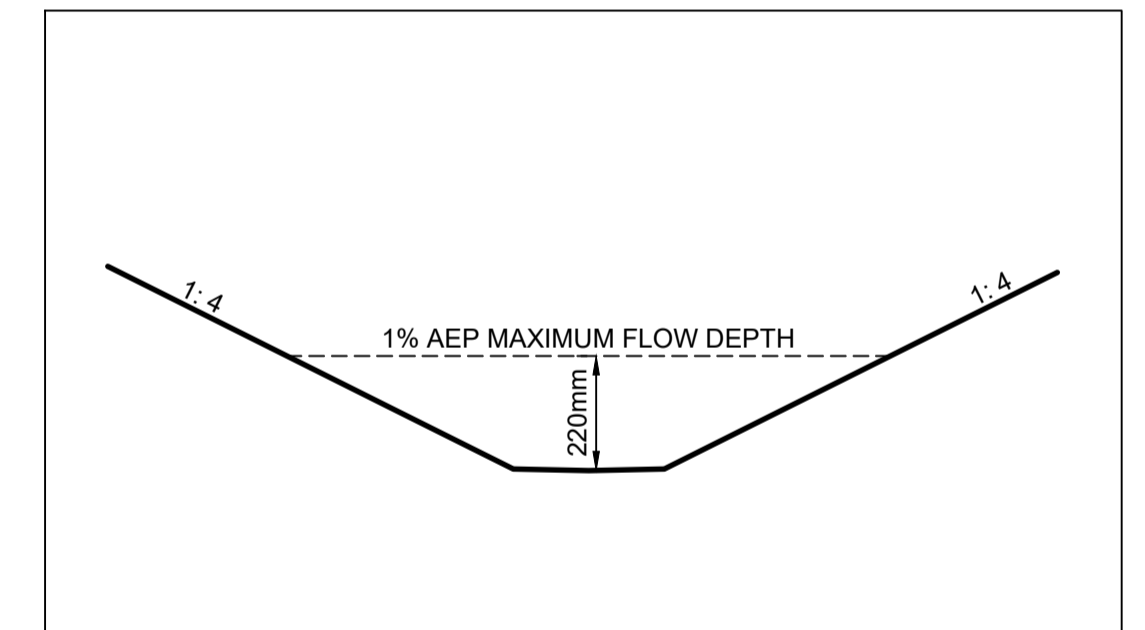


TYPICAL TAILOUT SECTION
N.T.S

CHAINAGE	EASTING	NORTHING	BEARING	RAD/SPIRAL	A.LENGTH
0.000	295569.59	6269204.31	340°54'29.02"		
3.94	295568.31	6269207.99	340°54'29.02"		
13.72	295564.93	6269217.78		-25	19.63
23.53	295555.62	6269222.3	295°55'30.18"		
184.1	295411.21	6269292.5			
246.86	295369.29	6269339.21	318°05'34.21"		

CHAINAGE	DESIGN LINE GRADING	EXISTING SURFACE
0.000	19.557	17.300
3.904	19.538	17.288
10.127	19.495	17.270
15.000	19.380	17.255
16.909	19.362	17.249
20.730	19.335	17.238
22.643	19.316	17.232
23.531	19.309	17.229
30.000	19.262	17.210
45.000	19.242	17.165
54.547	19.082	17.136
60.000	18.984	17.120
68.996	18.935	17.095
75.000	18.896	17.075
79.686	18.888	17.060
90.000	18.904	17.030
105.000	18.703	16.885
120.000	18.602	16.940
122.472	18.587	16.933
126.597	18.547	16.920
135.000	18.592	16.895
139.632	18.688	16.881
150.000	18.696	16.850
152.610	19.281	16.842
165.000	18.956	16.805
180.000	18.722	16.760
195.000	18.534	16.715
197.632	18.501	16.707
210.000	17.984	16.670
210.632	17.940	16.668
223.632	17.420	16.629
225.000	17.352	16.625
240.000	16.639	16.580
246.856	16.673	16.559

LONGITUDINAL SECTION TAILOUT C01
 HORIZONTAL SCALE 1:500
 VERTICAL SCALE 1:100

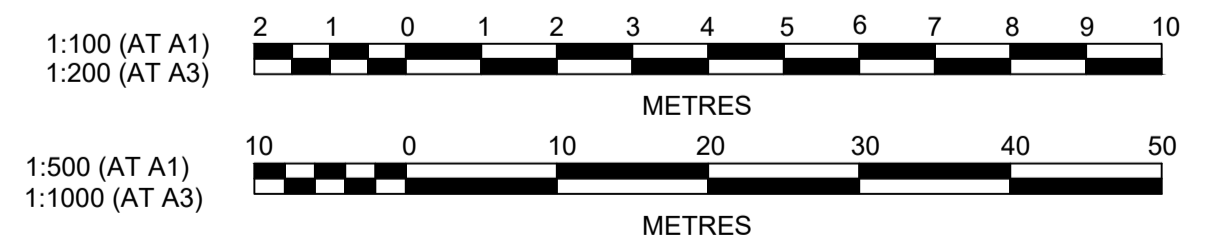

Plotted: 14 September, 2021 12:59:55 PM File Name: J:\985D\CC - Construction Certificate Approval Plans\PK12 WESTERN PRECINCTS IS - Preprint\7B\985-12-CC5501.dwg

NO.	DESCRIPTION	DESIGNER	CHECKED	DATE
A	ISSUE FOR APPROVAL	DG	VS	MP
	AMENDMENT	DES	DRN	CKD
			APR	PJM
				12/08/21

J. WYNDHAM PRINCE
 CONSULTING CIVIL INFRASTRUCTURE ENGINEERS & PROJECT MANAGERS

PO Box 4366 PENRITH WESTFIELD NSW 2750
 P 02 4720 3300 W www.jwprince.com.au E jwp@jwprince.com.au

CLIENT:

W WINTEN PROPERTY GROUP

STATUS:

ISSUE FOR CONSTRUCTION APPROVAL


THIS DRAWING MUST NOT BE USED FOR CONSTRUCTION UNLESS SIGNED AS PART OF AN APPROVED CONSTRUCTION CERTIFICATE.

NEWPARK PRECINCT 7, STAGE 7B TAILOUT C01 PLAN


PROJECT No: **9985-12**
 SHEET No: **CC5501**

AZIMUTH: M.G.A.94 DATUM: A.H.D. ORIGIN: SSM 1112 PLAN No: **9985-12-CC5501**


A

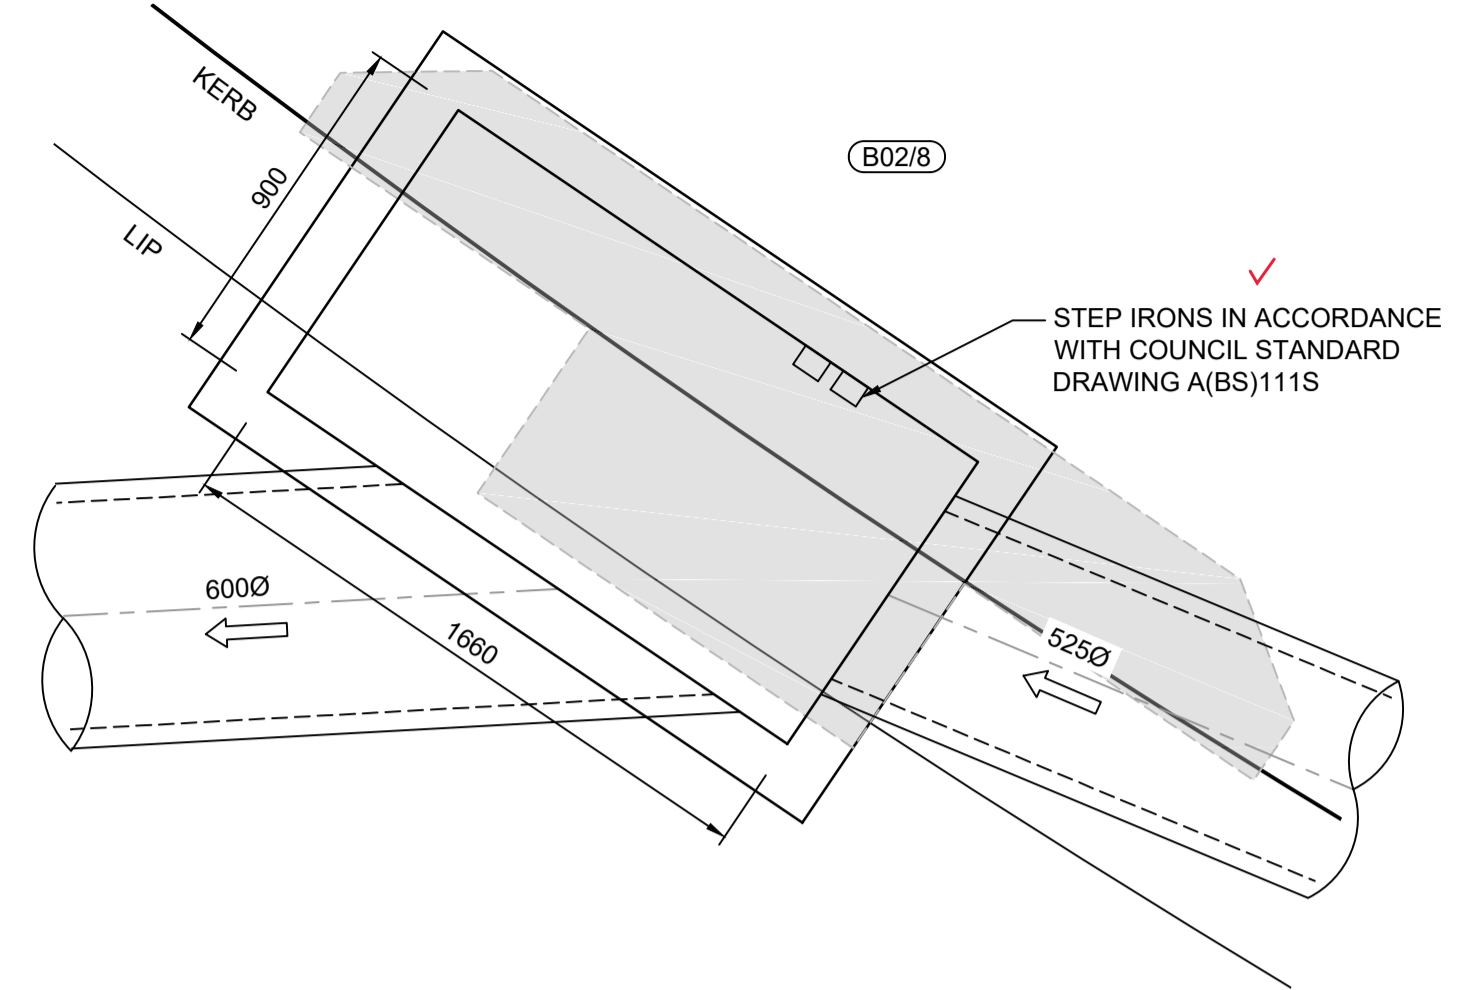


SPECIAL PIT - B02/8
SCALE 1:20

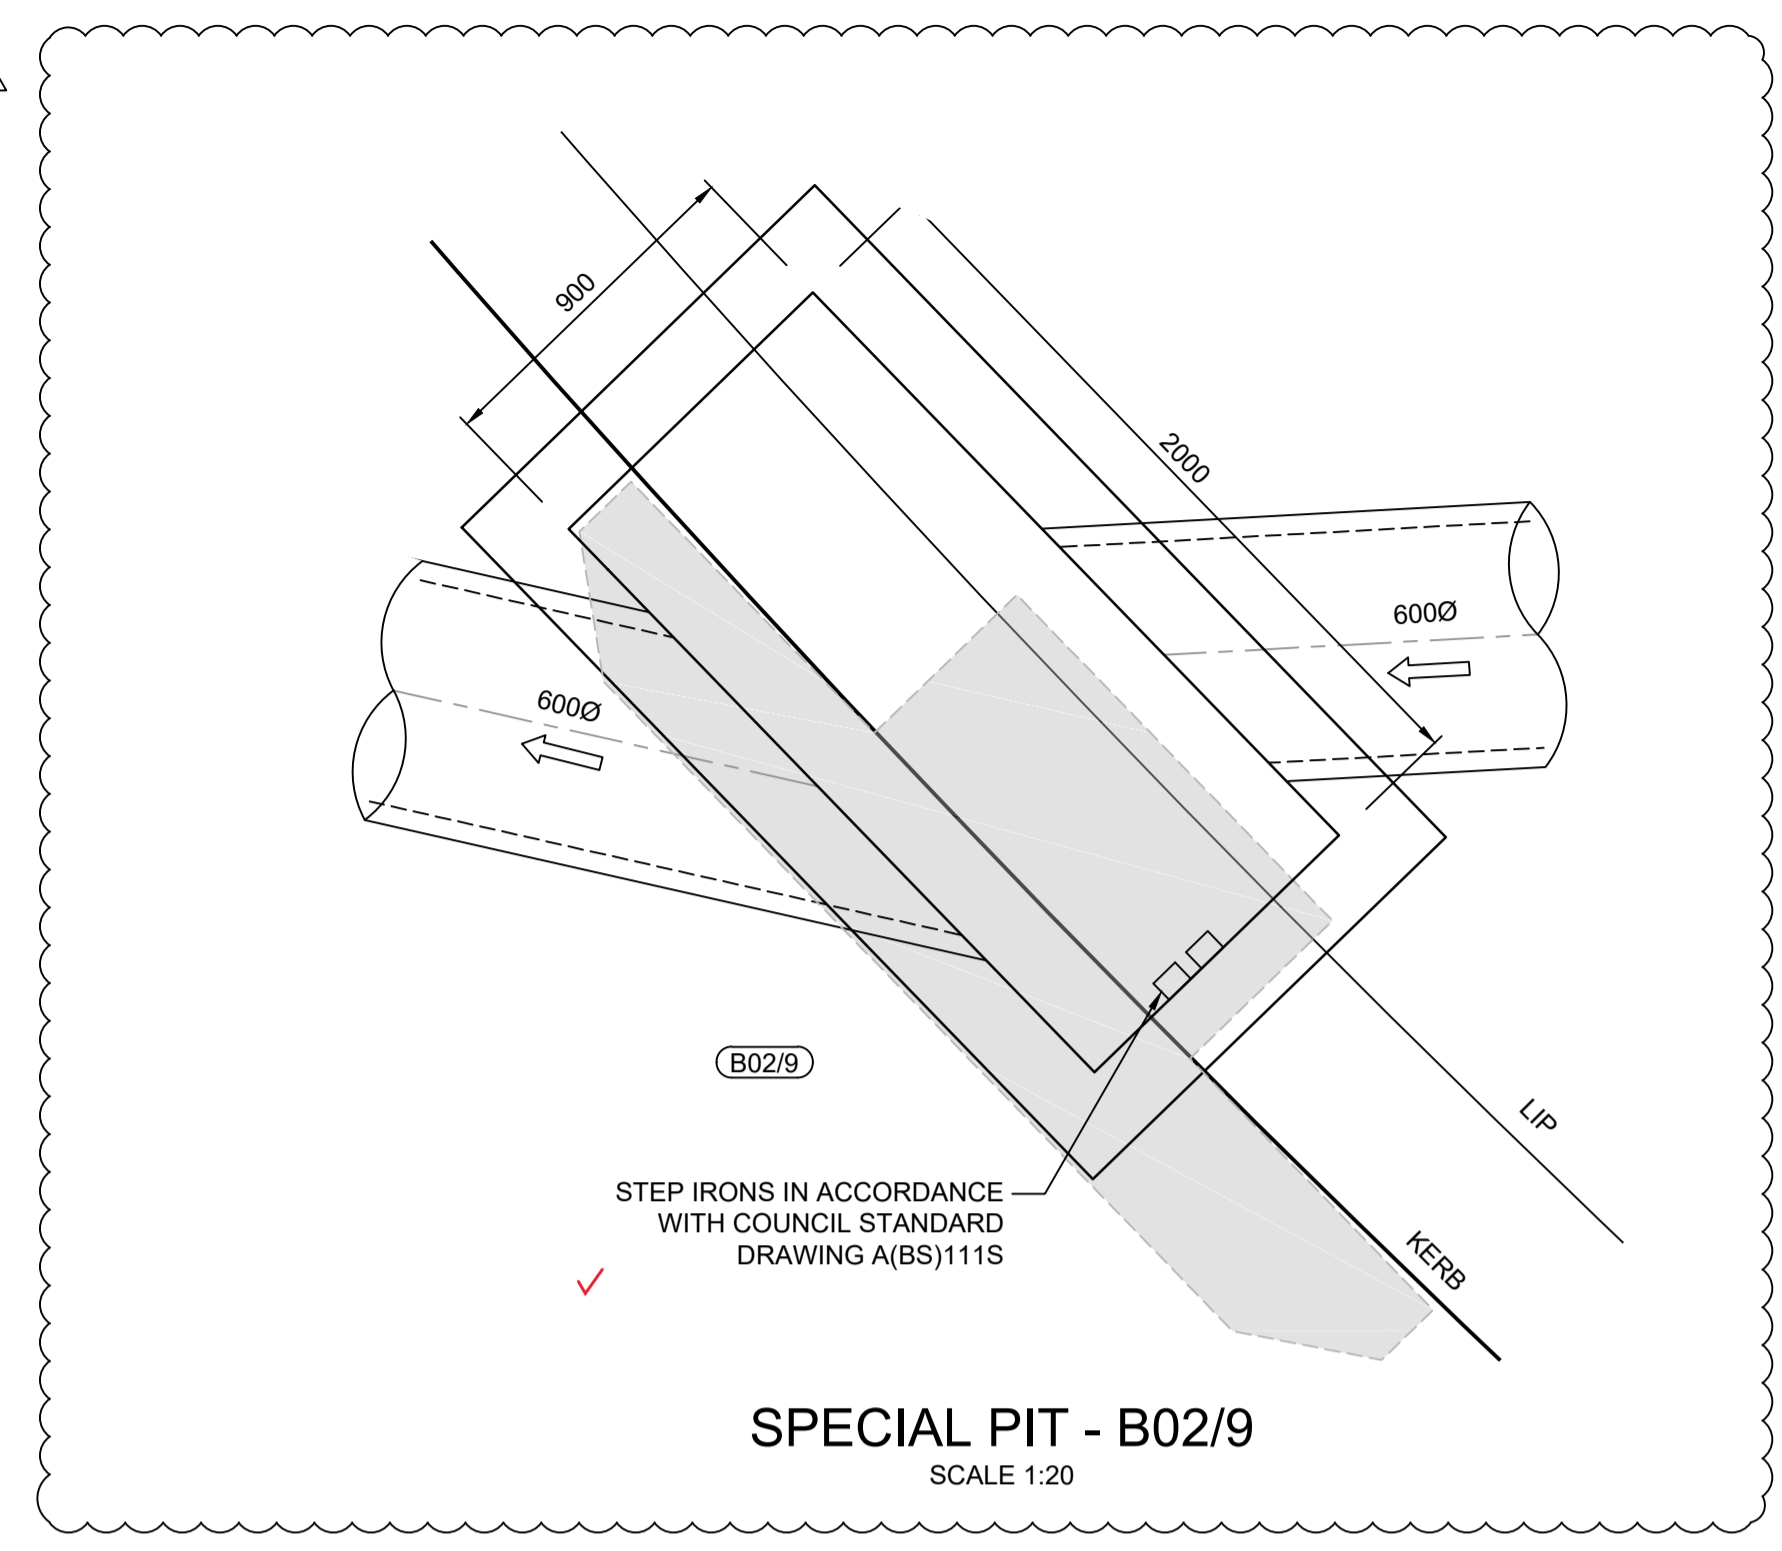


SPECIAL PIT - B02/9
SCALE 1:20

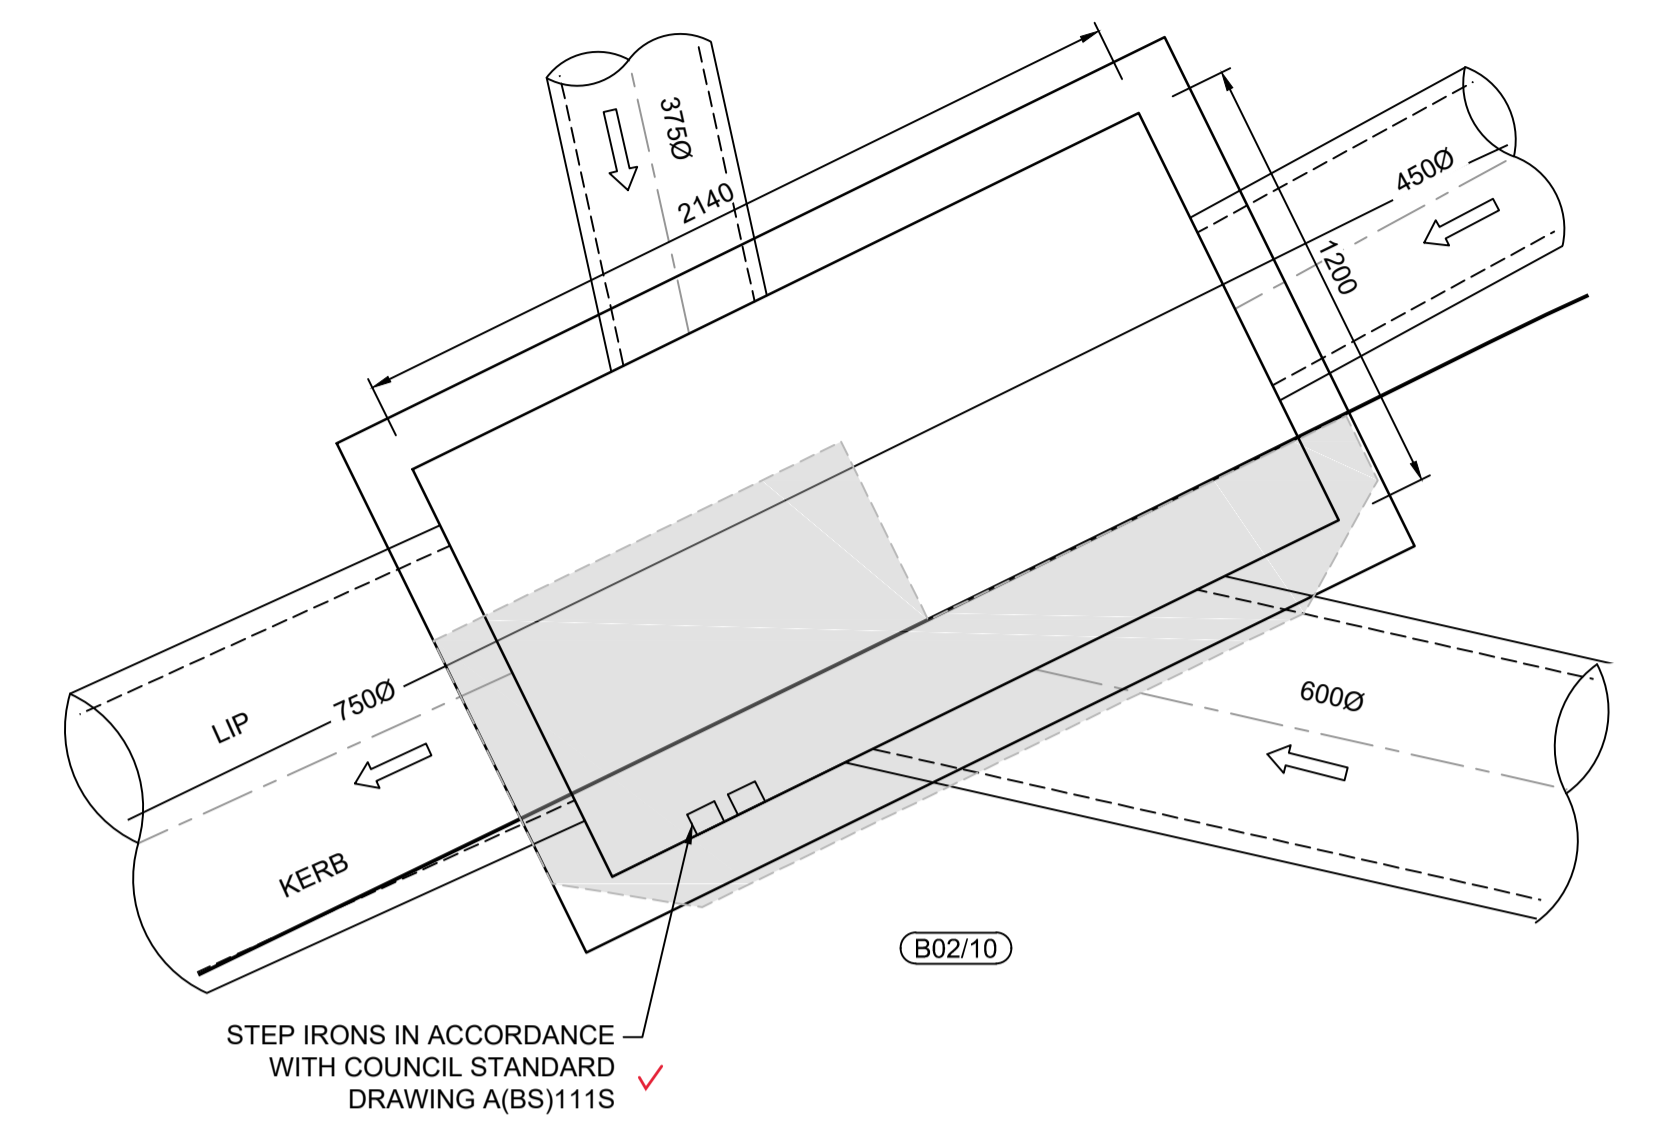

SPECIAL PIT - B02/10
SCALE 1:20

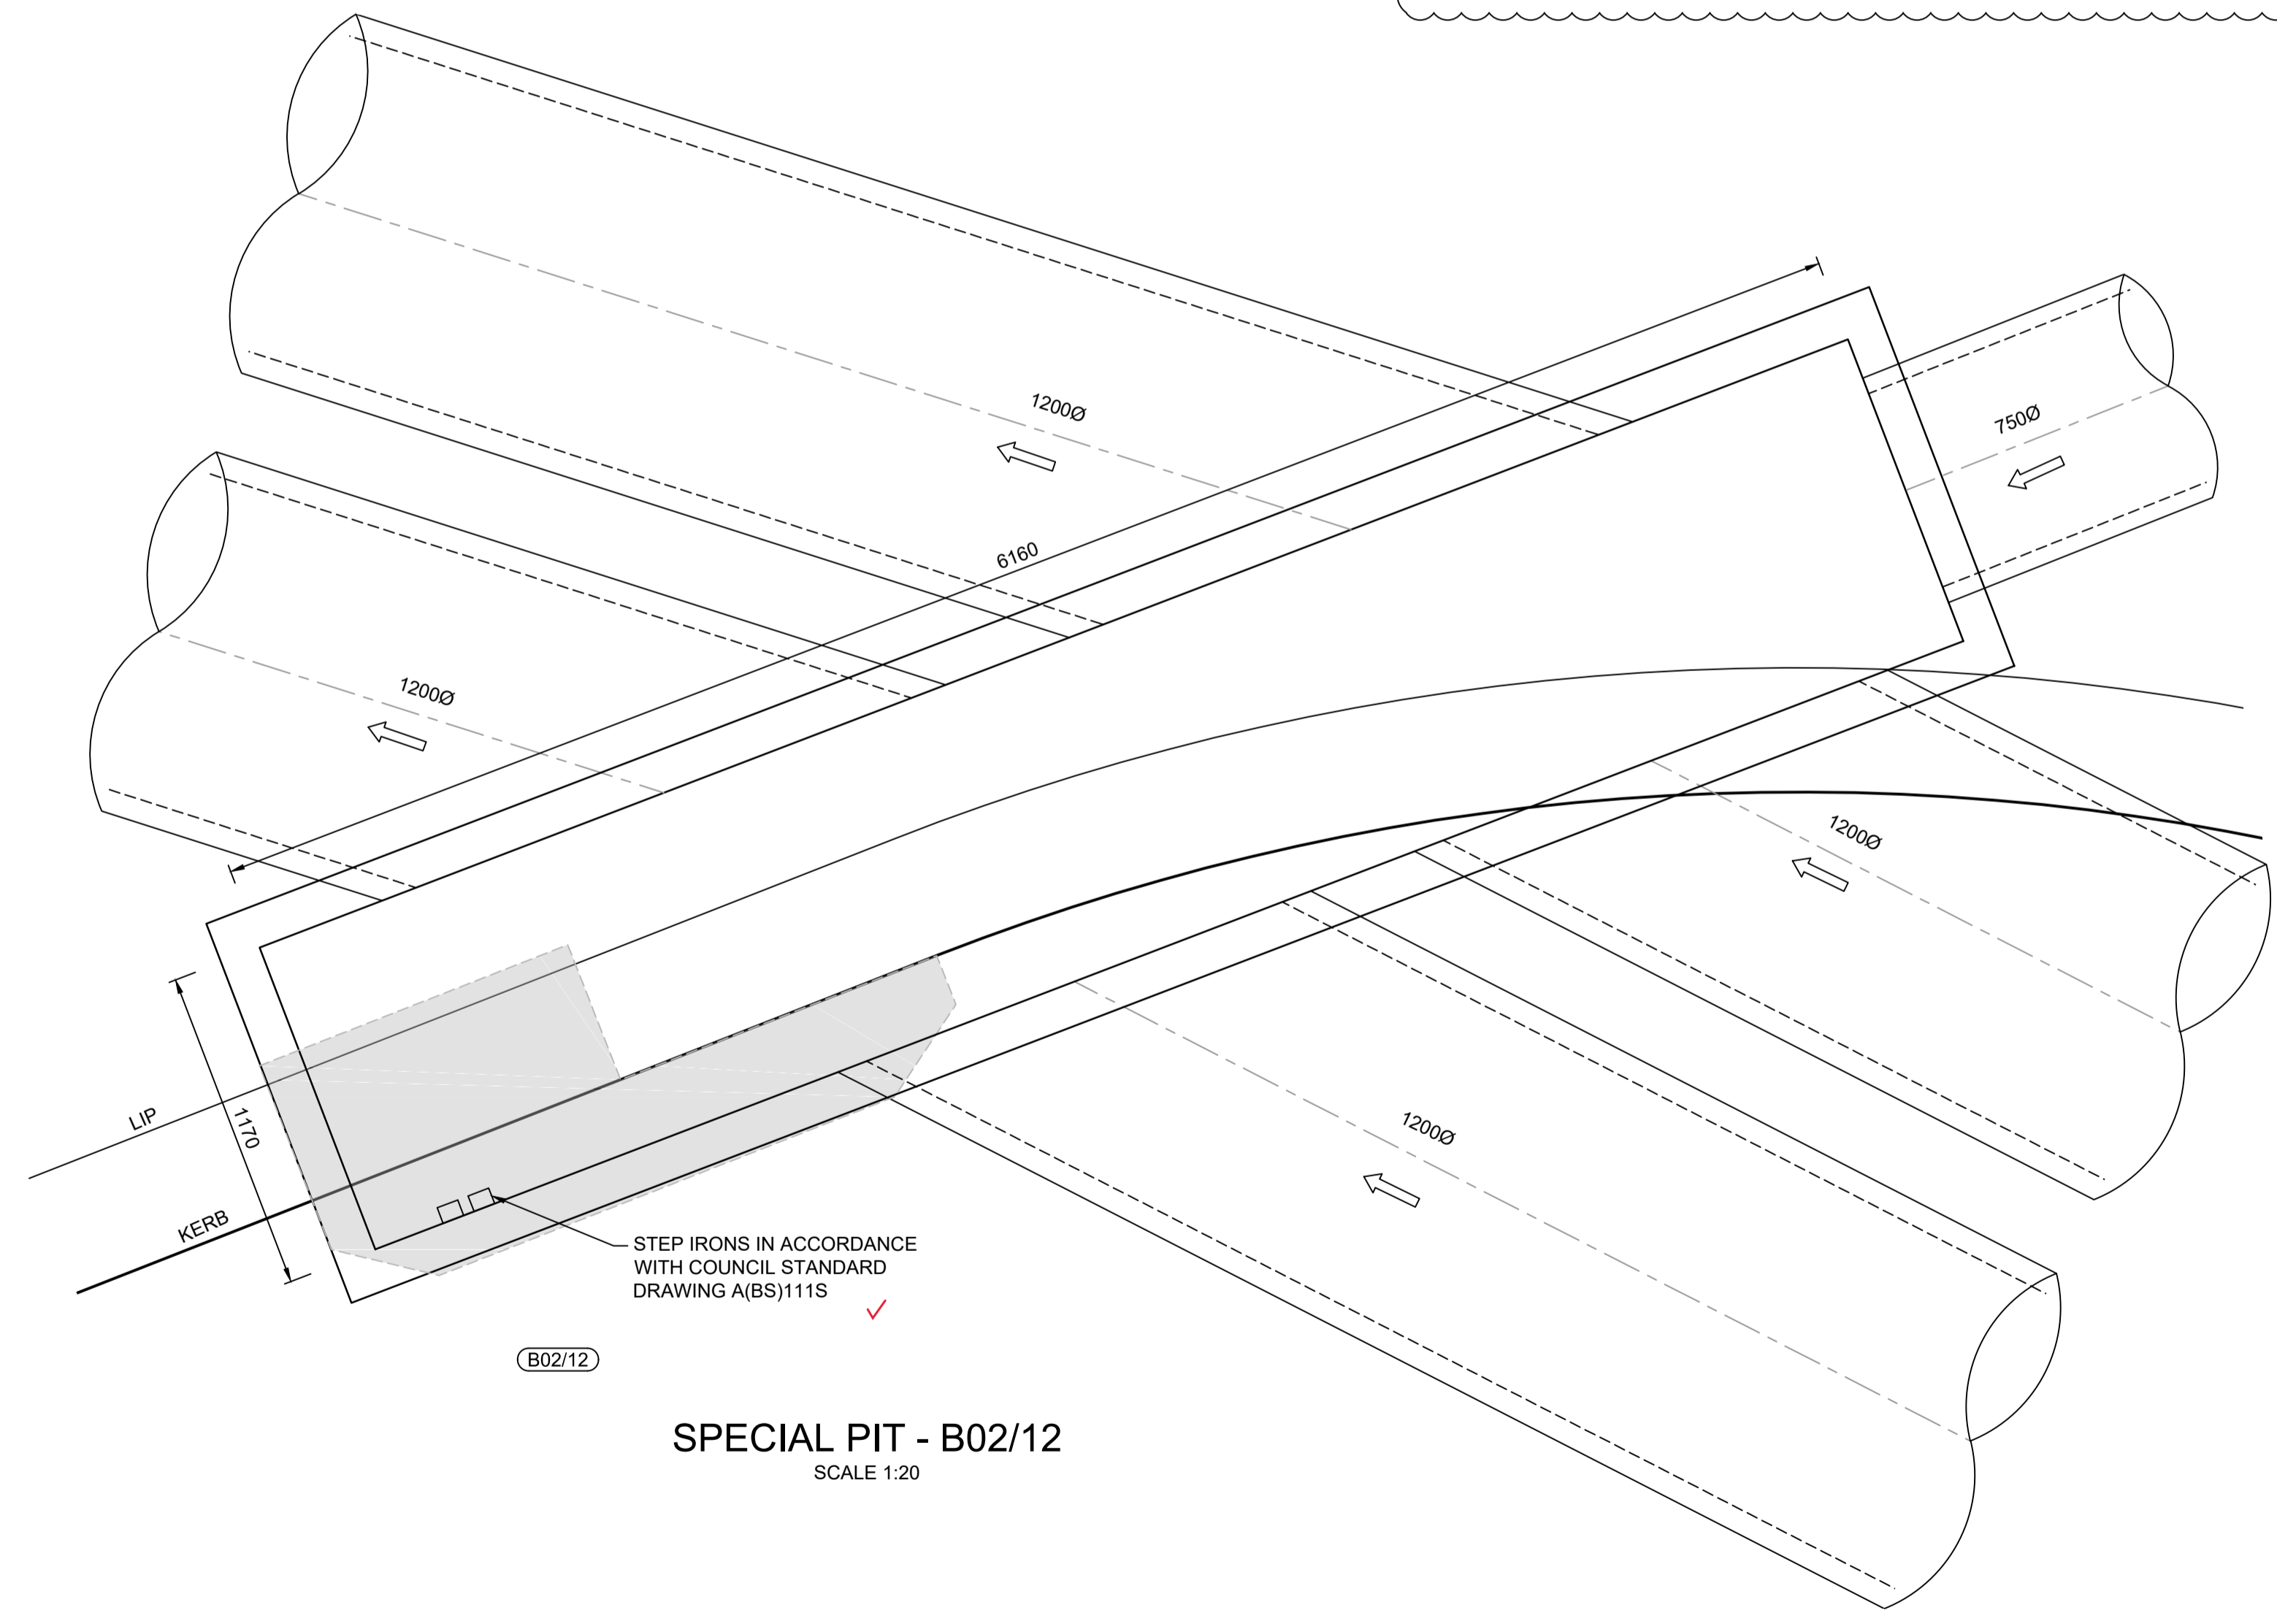

SPECIAL PIT - B02/12
SCALE 1:20

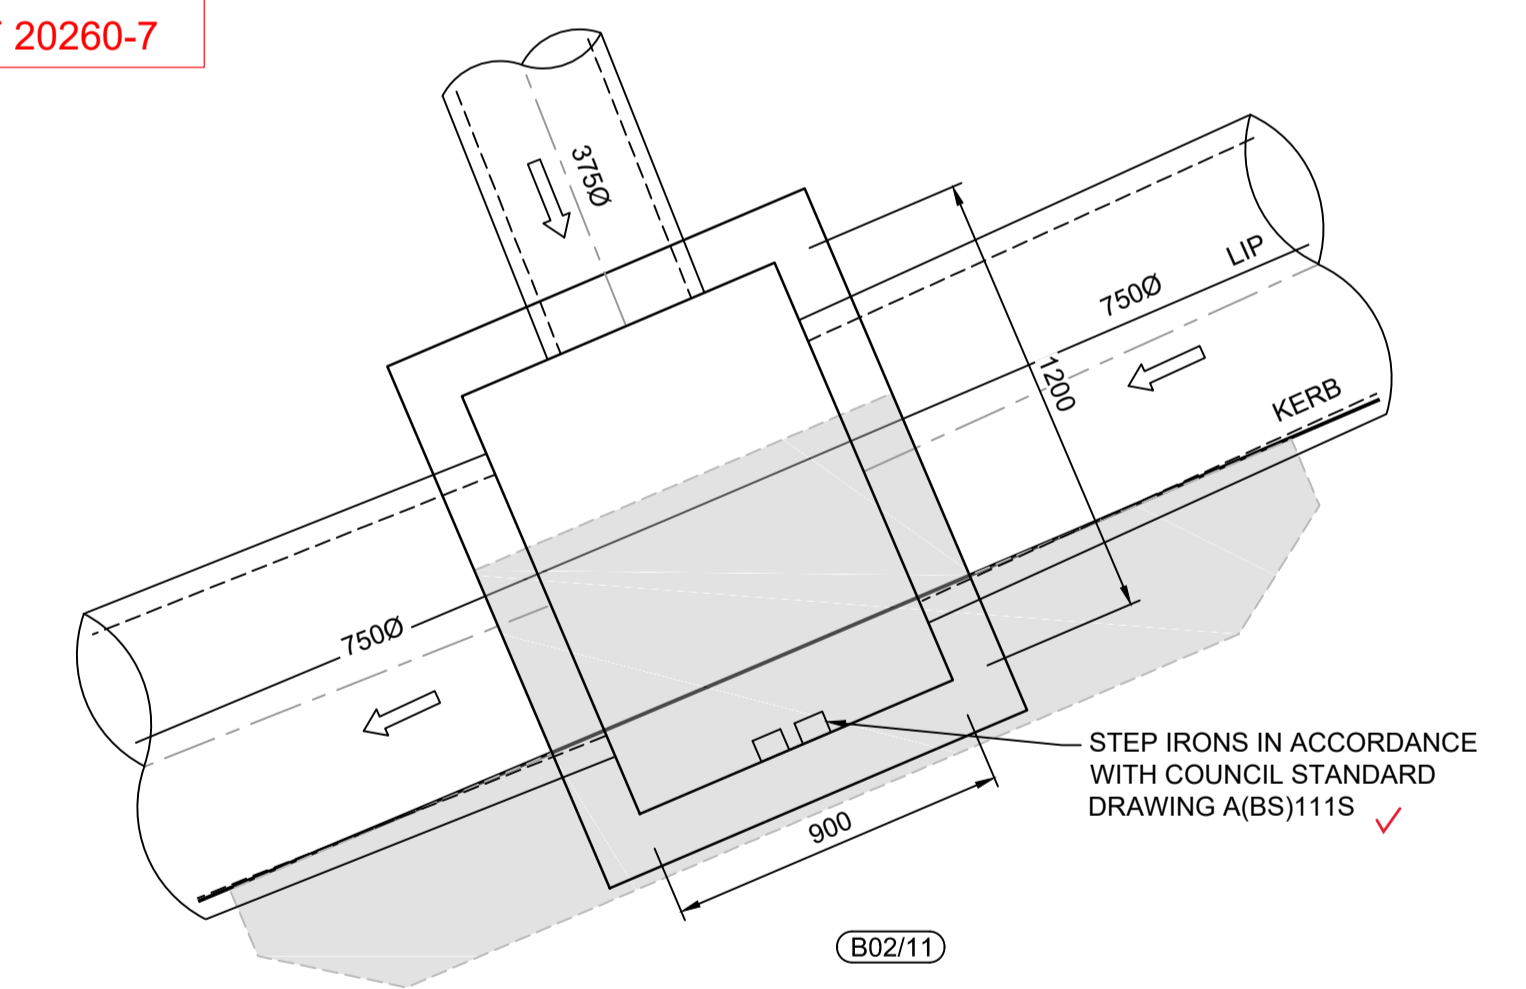

SPECIAL PIT - B02/11
SCALE 1:20

I hereby certify that engineering works shown on this plan have been constructed generally in accordance with Construction Certificate 16635 issued by Land Development Certificates

Signature: *PR*
PETER ROBERT WARWICK
 Registered Land Surveyor
 VINCE MORGAN SURVEYORS PTY LTD

DATE 20/12/2022 REF 20260-7

These plans are referred to in certificate no. 16635 approved by:

LDC Christopher Louis Wahbe
 Registered Certifier
 Registration No: BDC 3015
 Categories: Certifier - Subdivision
 Land Development Certificates
 www.LDC.com.au

NOTES:
 ALL PITS TO BE BENCHMARKED TO DIRECT WATER FLOW



Plotted: 14 September, 2021 1:01:11 PM File Name: J:\9985DCC - Construction Certificate Approval Plans\PK12 WESTERN PRECINCTS\6 - Precinct 7\9985-12-CC5550.dwg

DES	DRN	CKD	APR	DATE
DG	JM	MP	MS	14/09/21
DG	JM	MP	PJM	12/08/21
AMENDMENT				

J. WYNDHAM PRINCE
 CONSULTING CIVIL INFRASTRUCTURE ENGINEERS & PROJECT MANAGERS

PO Box 4366 PENRITH WESTFIELD NSW 2750
 P 02 4720 3300 W www.jwprince.com.au E jwp@jwprince.com.au

CLIENT:

W WINTEN PROPERTY GROUP

STATUS: **ISSUE FOR CONSTRUCTION APPROVAL**

THIS DRAWING MUST NOT BE USED FOR CONSTRUCTION UNLESS SIGNED AS PART OF AN APPROVED CONSTRUCTION CERTIFICATE.


NEWPARK PRECINCT 7, STAGE 7B
 SPECIAL PIT DETAILS
 SHEET 1

AZIMUTH: M.G.A.94 DATUM: A.H.D. ORIGIN: SSM 1112 PLAN No: 9985-12-CC5550


PROJECT No: **9985-12**
 SHEET No: **CC5550**

B

Plotfile: 14 September, 2021 1:02:14 PM File Name: J:\9985\DDC - Construction Certificate Approval Plans\K12 WESTERN PRECINCTS\6 - Precinct 7\9985-12-CC5551.dwg

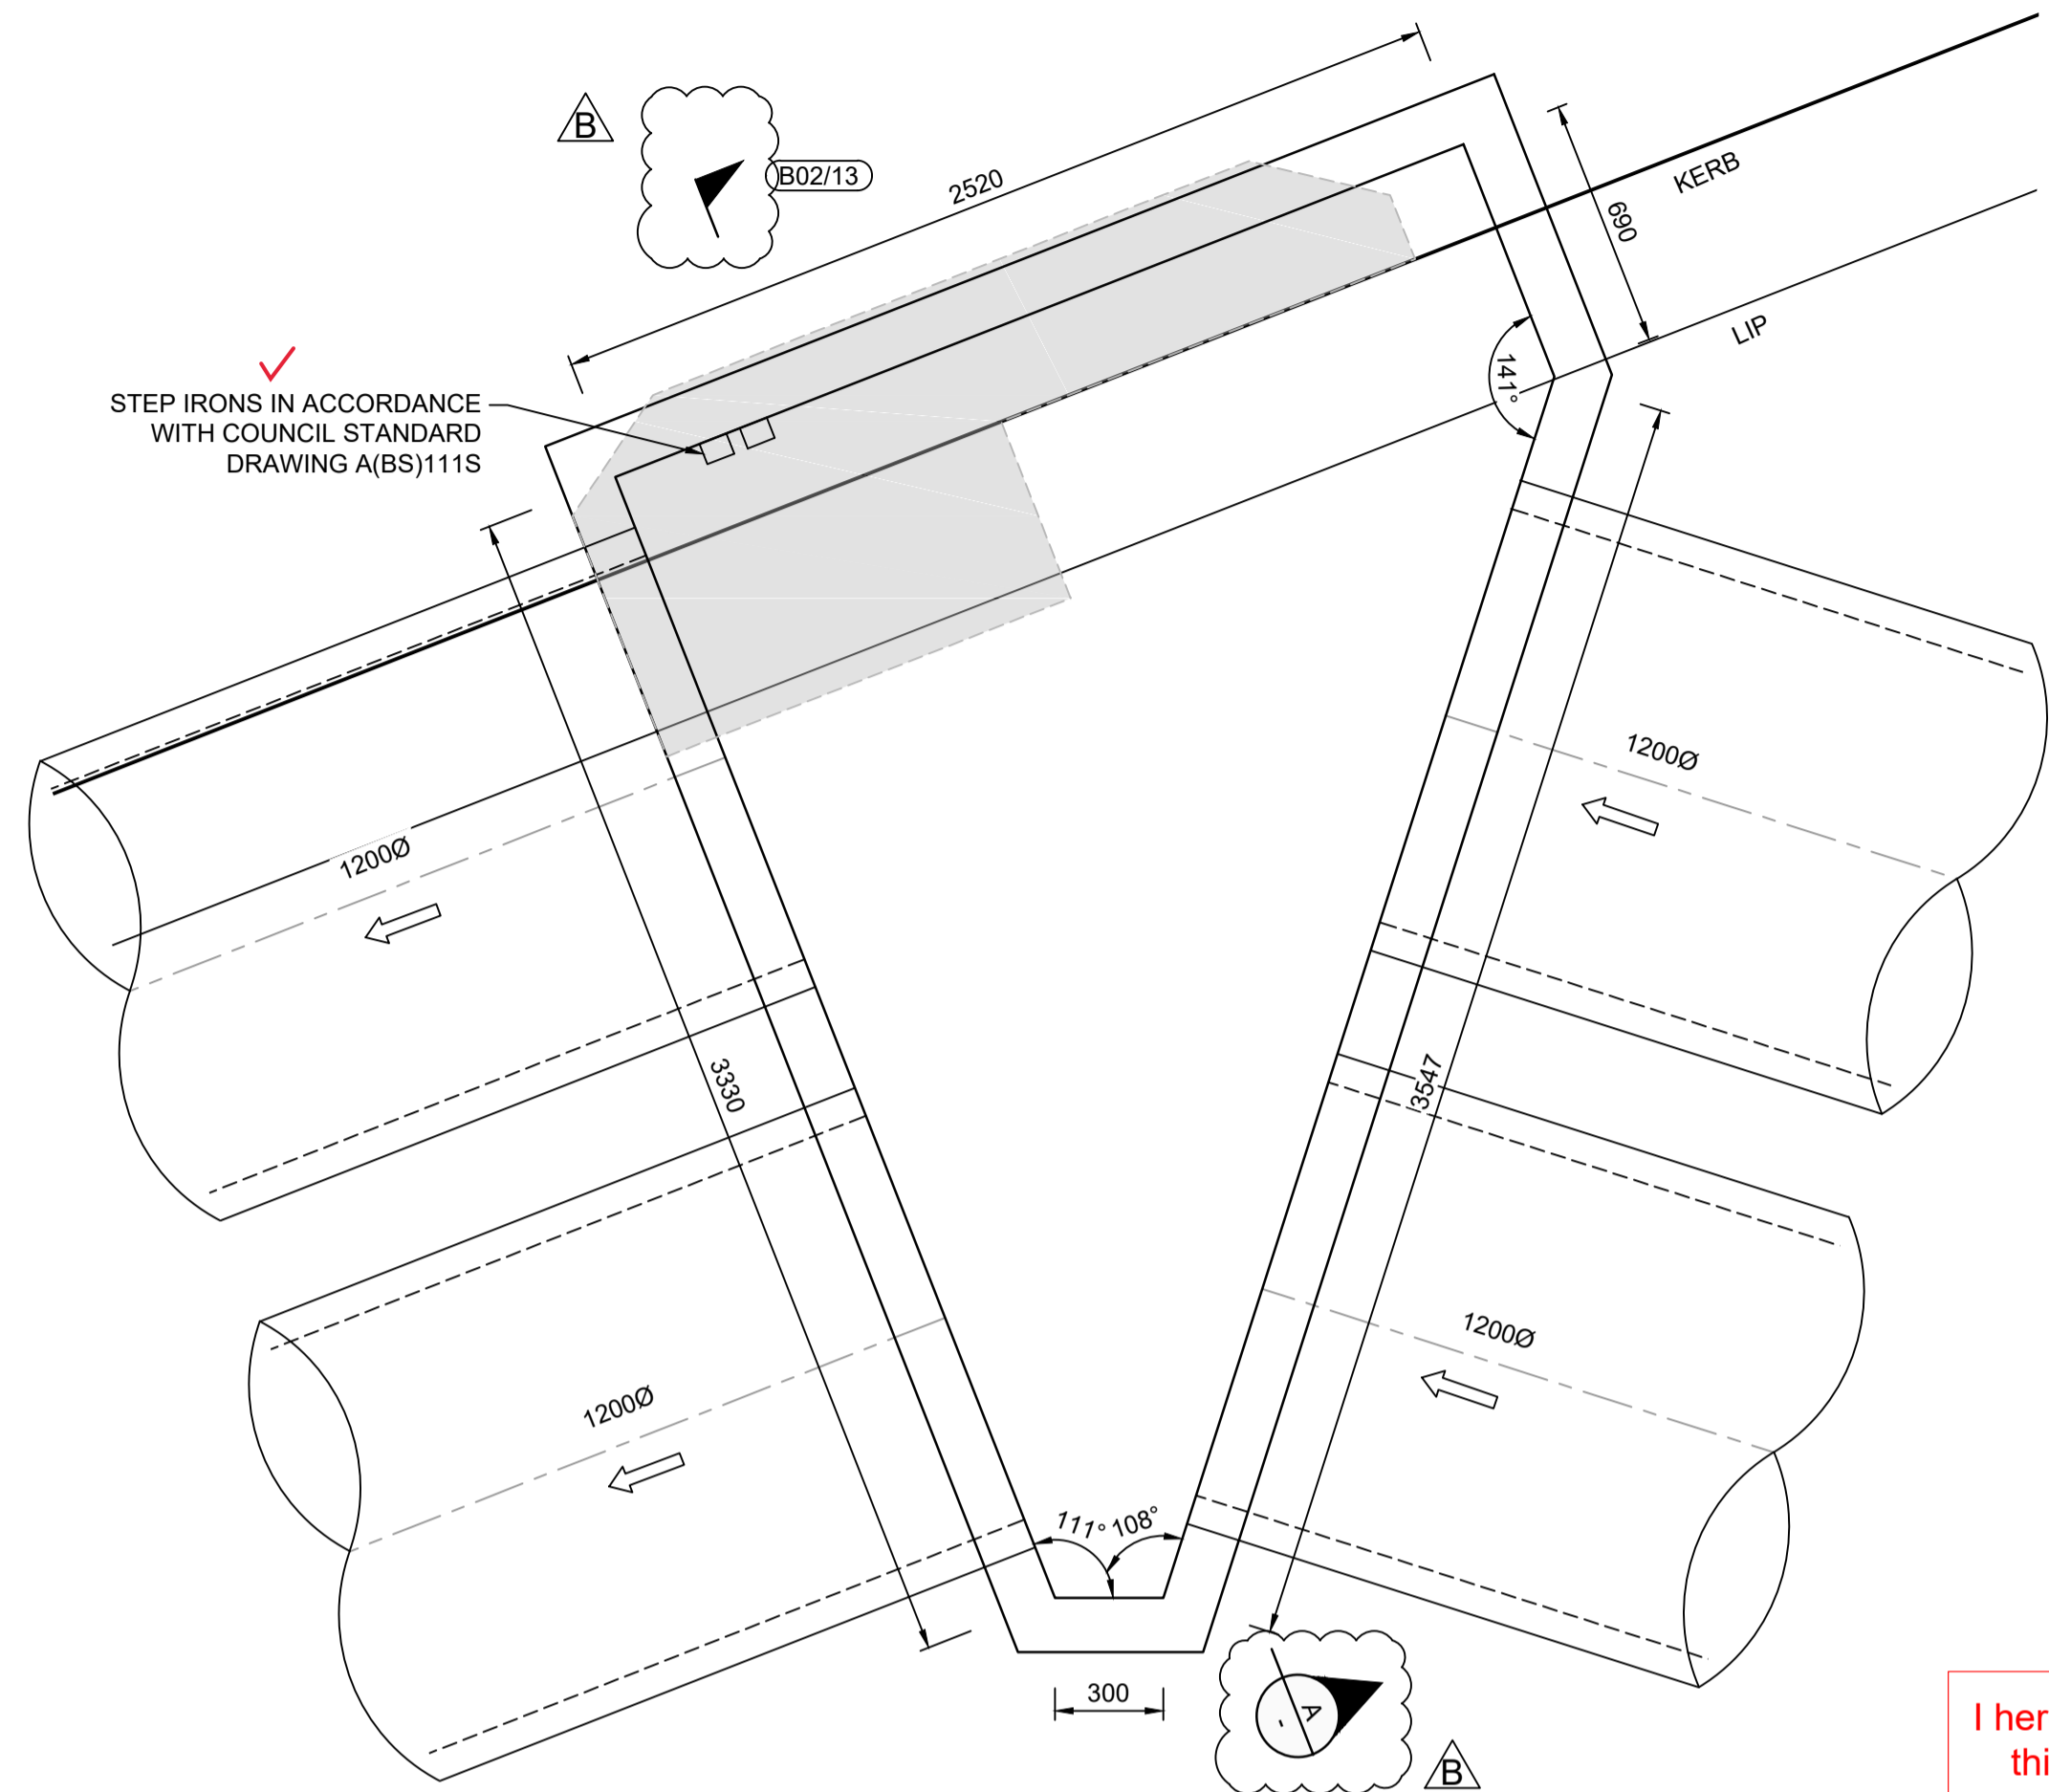

SPECIAL PIT - B02/13
SCALE 1:20

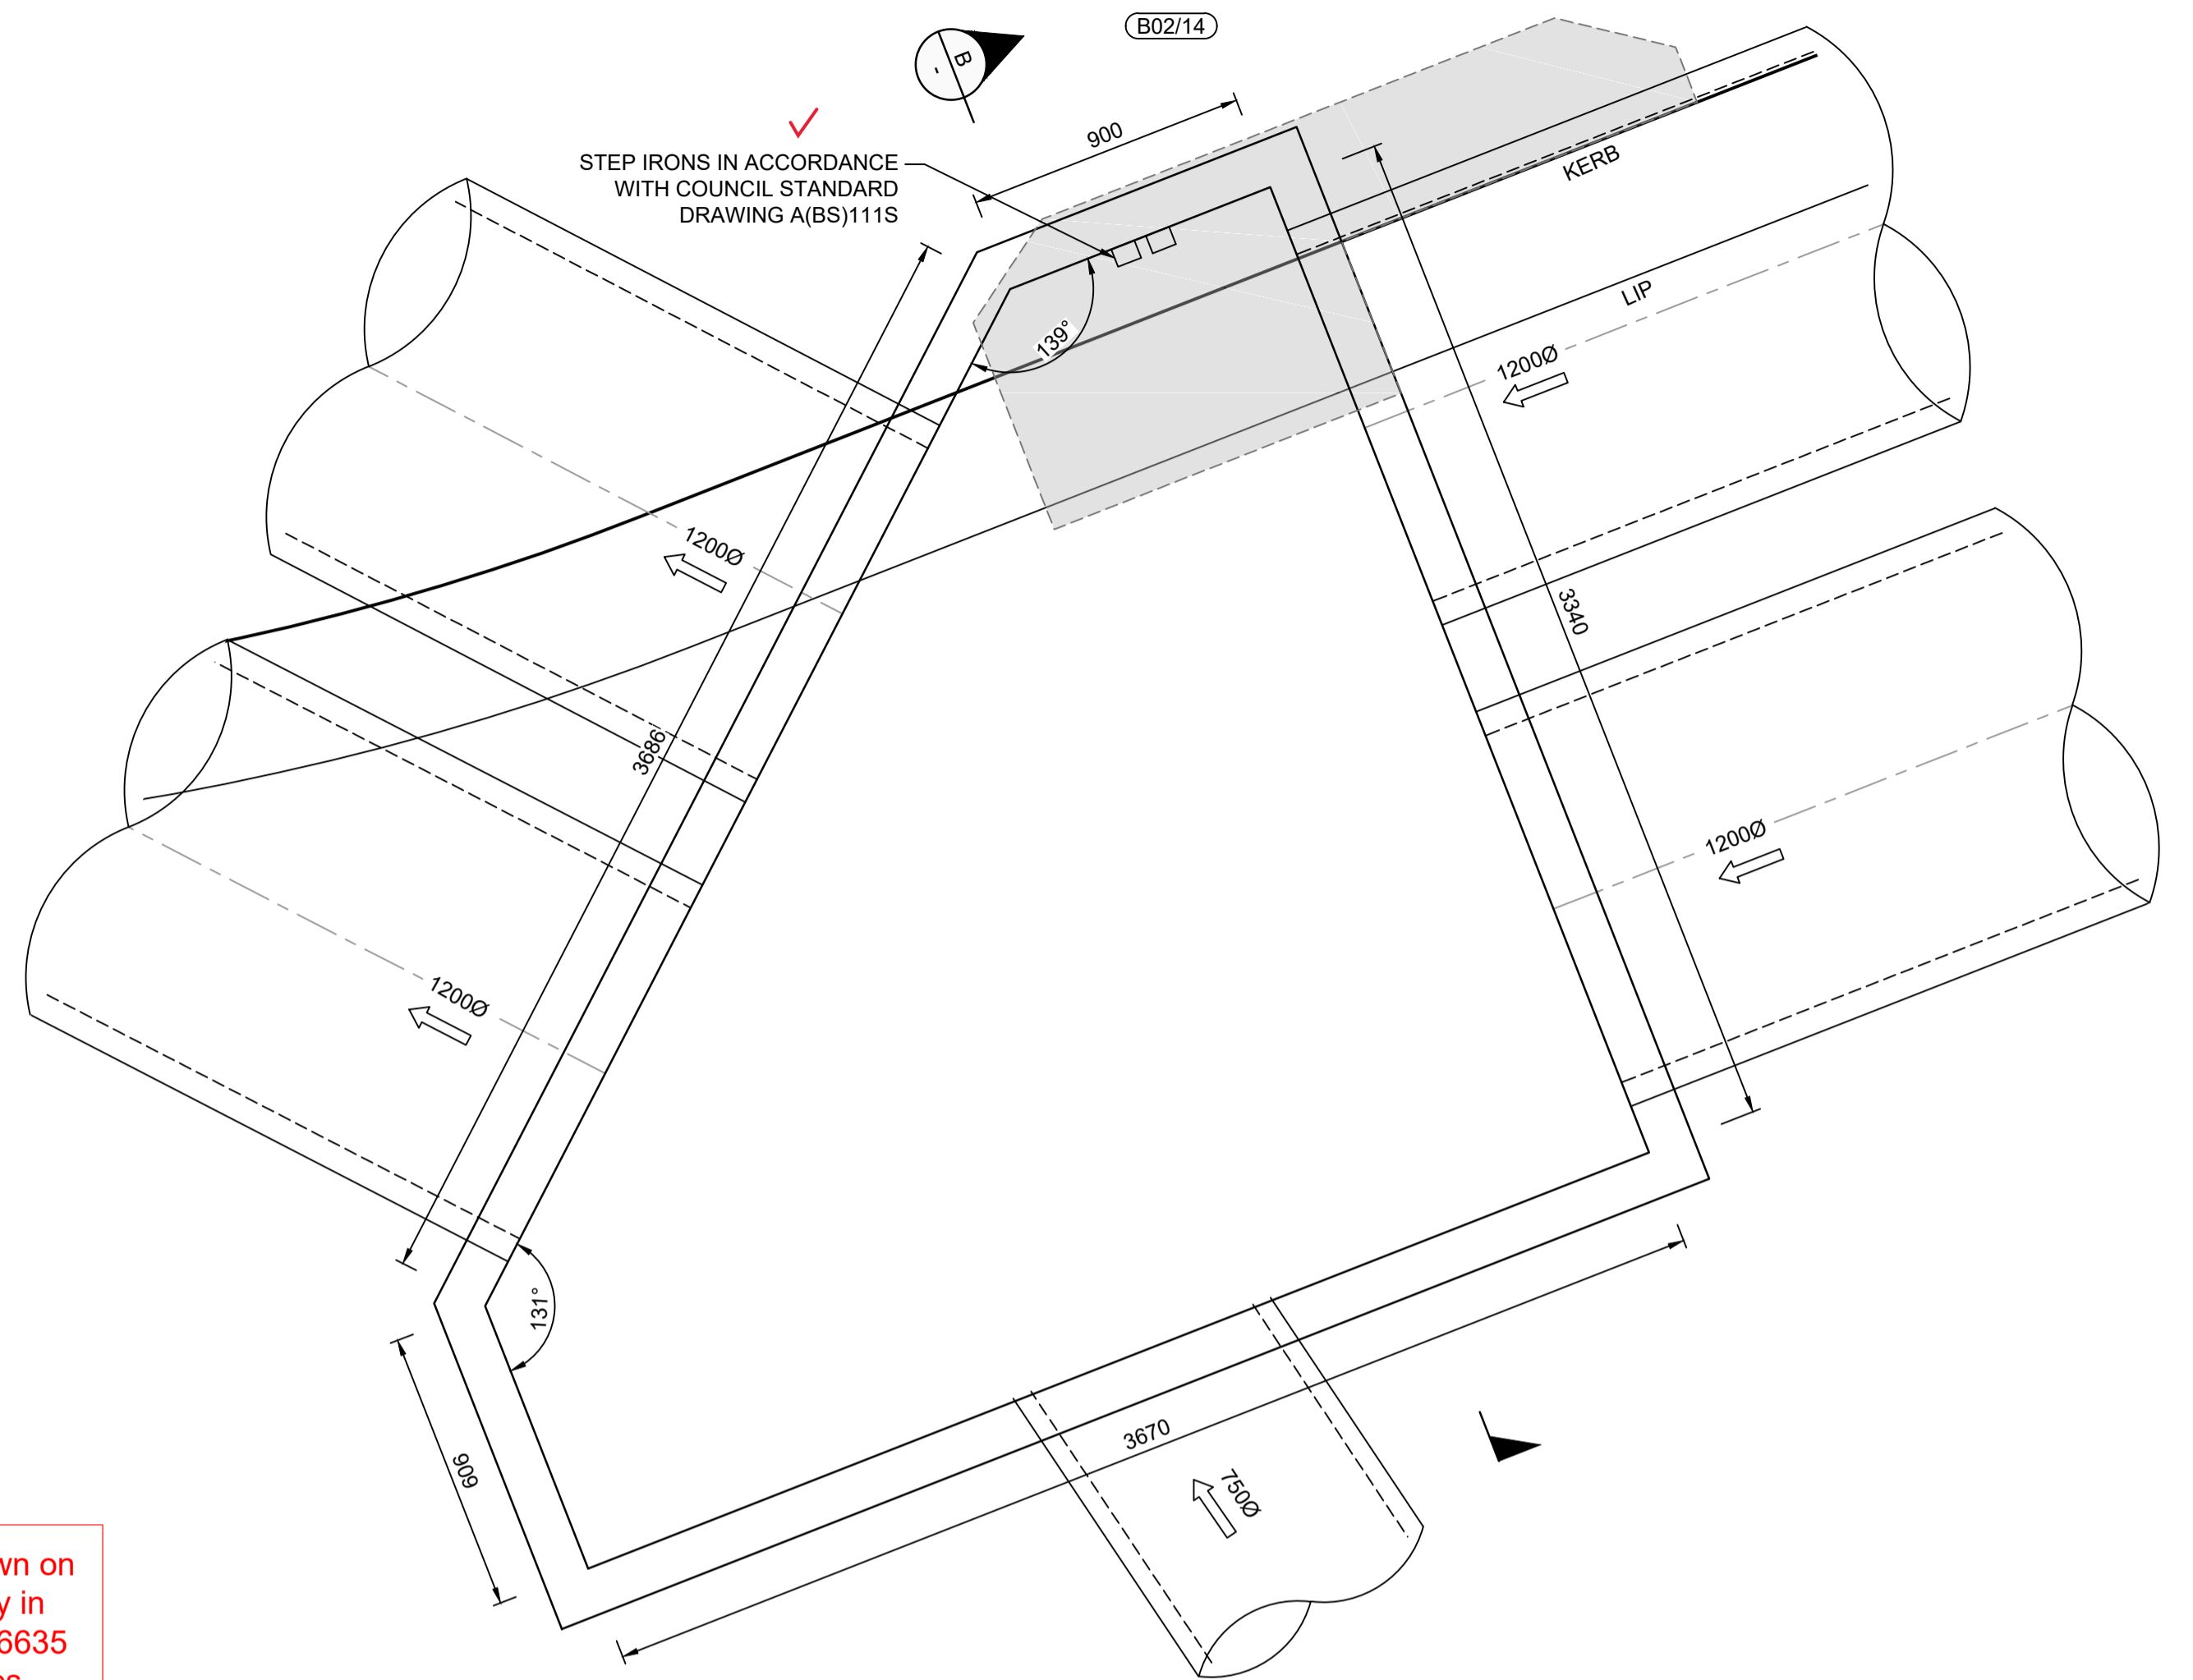

SPECIAL PIT - B02/14
SCALE 1:20

I hereby certify that engineering works shown on this plan have been constructed generally in accordance with Construction Certificate 16635 issued by Land Development Certificates


Signature.....
PETER ROBERT WARWICK
 Registered Land Surveyor
VINCE MORGAN SURVEYORS PTY LTD

DATE 20/12/2022 REF 20260-7


These plans are referred to in certificate no. 16635 approved by:

LDC **Christopher Louis Wahbe**
 Registered Certifier
 Registration No: BDC 3015
 Categories: Certifier - Subdivision

Land Development Certificates
www.LDC.com.au

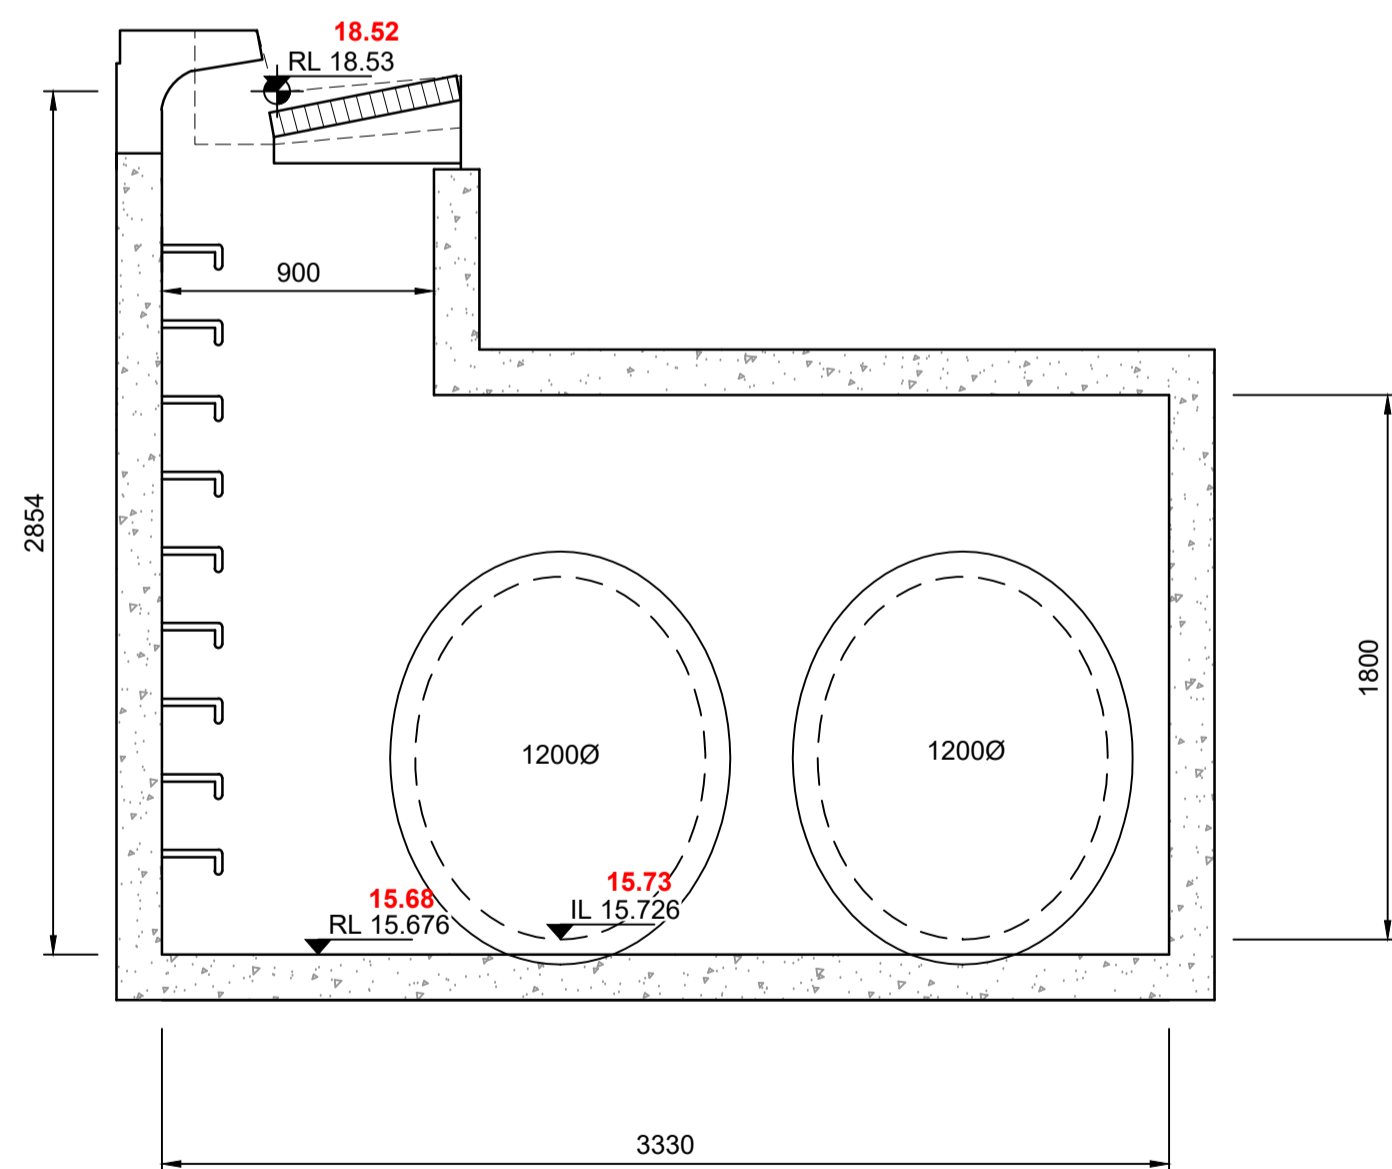


SECTION A
SCALE 1:25

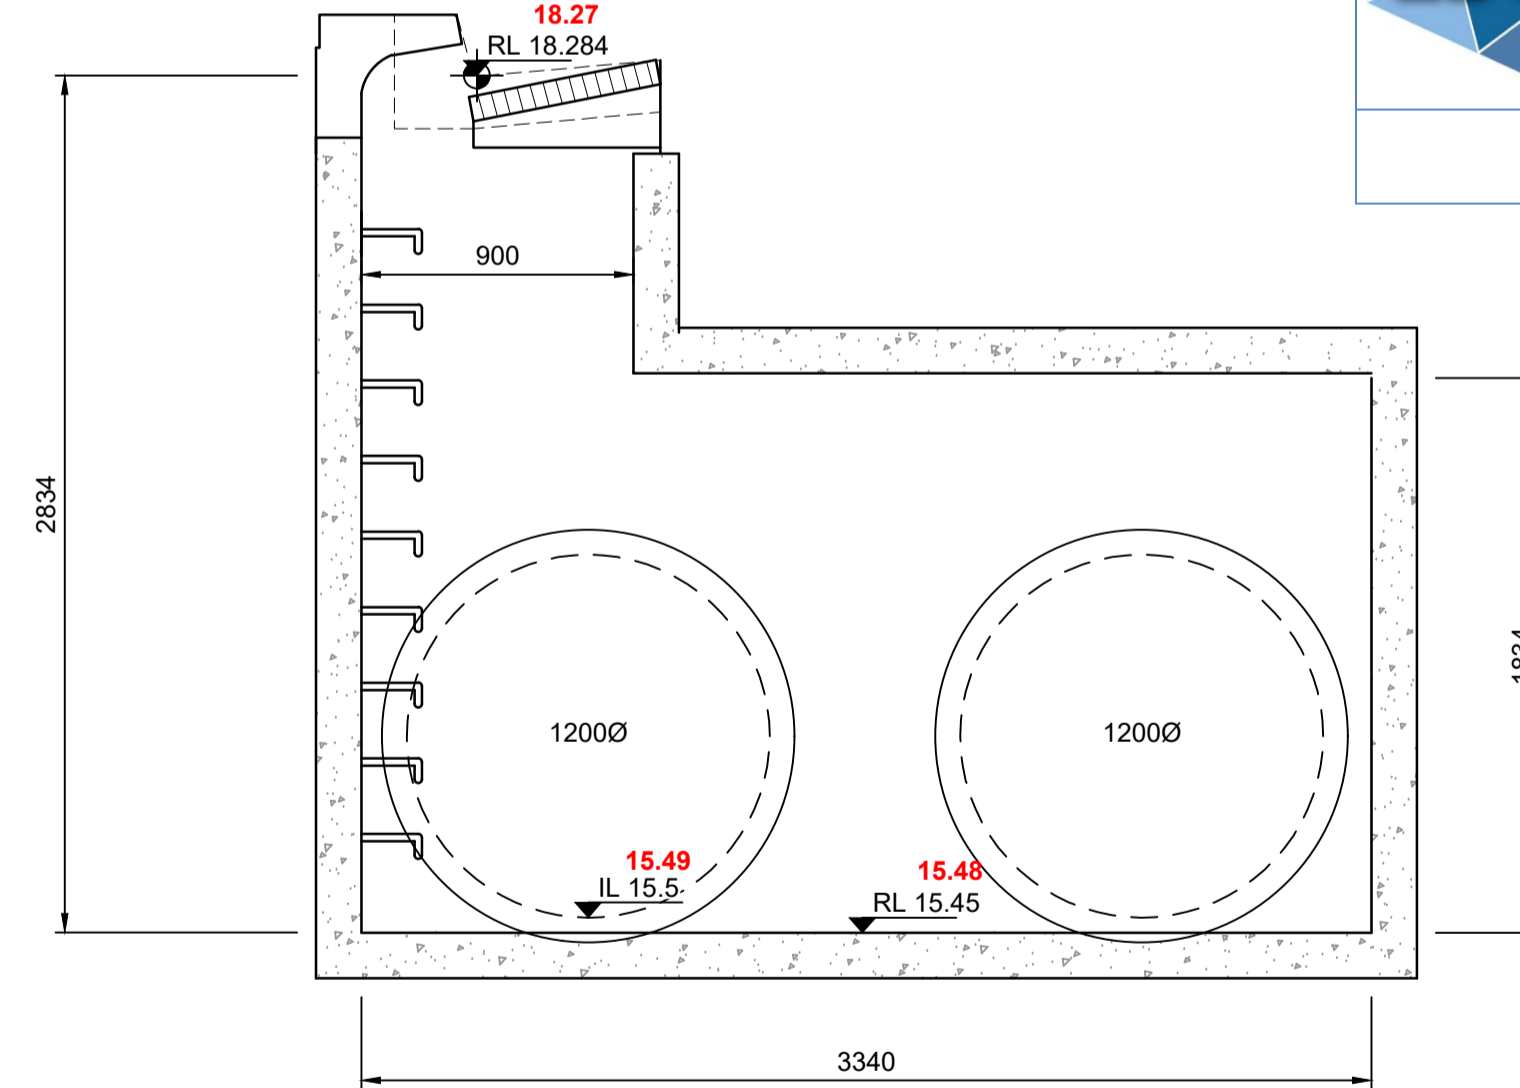

SECTION B
SCALE 1:25

NOTES:
ALL PITS TO BE BENCHMARKED TO DIRECT WATER FLOW

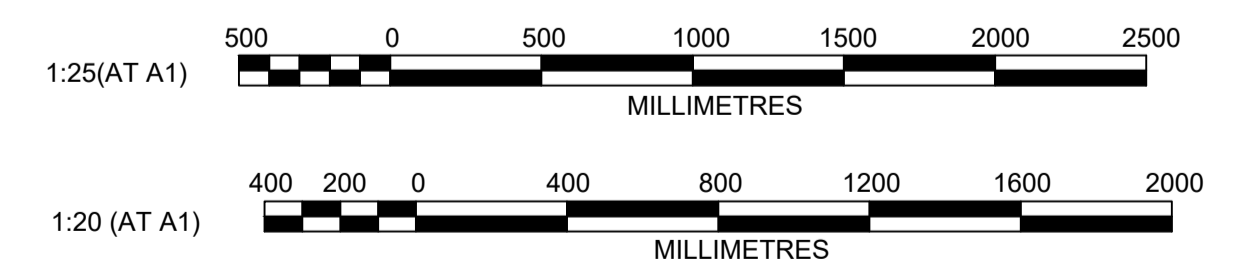

REVISION	DESCRIPTION	DES	DRN	CKD	APR	DATE
B	SECTION MARKER UPDATED	DG	JM	MP	MS	14/09/21
A	ISSUE FOR APPROVAL	DG	JM	MP	PJM	12/08/21
	AMENDMENT	DES	DRN	CKD	APR	DATE

J. WYNDHAM PRINCE
 CONSULTING CIVIL INFRASTRUCTURE ENGINEERS & PROJECT MANAGERS

PO Box 4366 PENRITH WESTFIELD NSW 2750
 P 02 4720 3300 W www.jwprince.com.au E jwp@jwprince.com.au

CLIENT:

W **WINTEN PROPERTY GROUP**

STATUS: **ISSUE FOR CONSTRUCTION APPROVAL**


THIS DRAWING MUST NOT BE USED FOR CONSTRUCTION UNLESS SIGNED AS PART OF AN APPROVED CONSTRUCTION CERTIFICATE.

NEWPARK PRECINCT 7, STAGE 7B
 SPECIAL PIT DETAILS
 SHEET 2


AZIMUTH: M.G.A.94 DATUM: A.H.D. ORIGIN: SSM 1112 PLAN No: 9985-12-CC5551

PROJECT No: **9985-12**
 SHEET No: **CC5551**

Plotted: 14 September, 2021 1:03:17 PM File Name: J:\985BDC - Construction Certificate Approval Plans\PK12 WESTERN PRECINCTS\6 - Precinct 7\985-12-CC5552.dwg

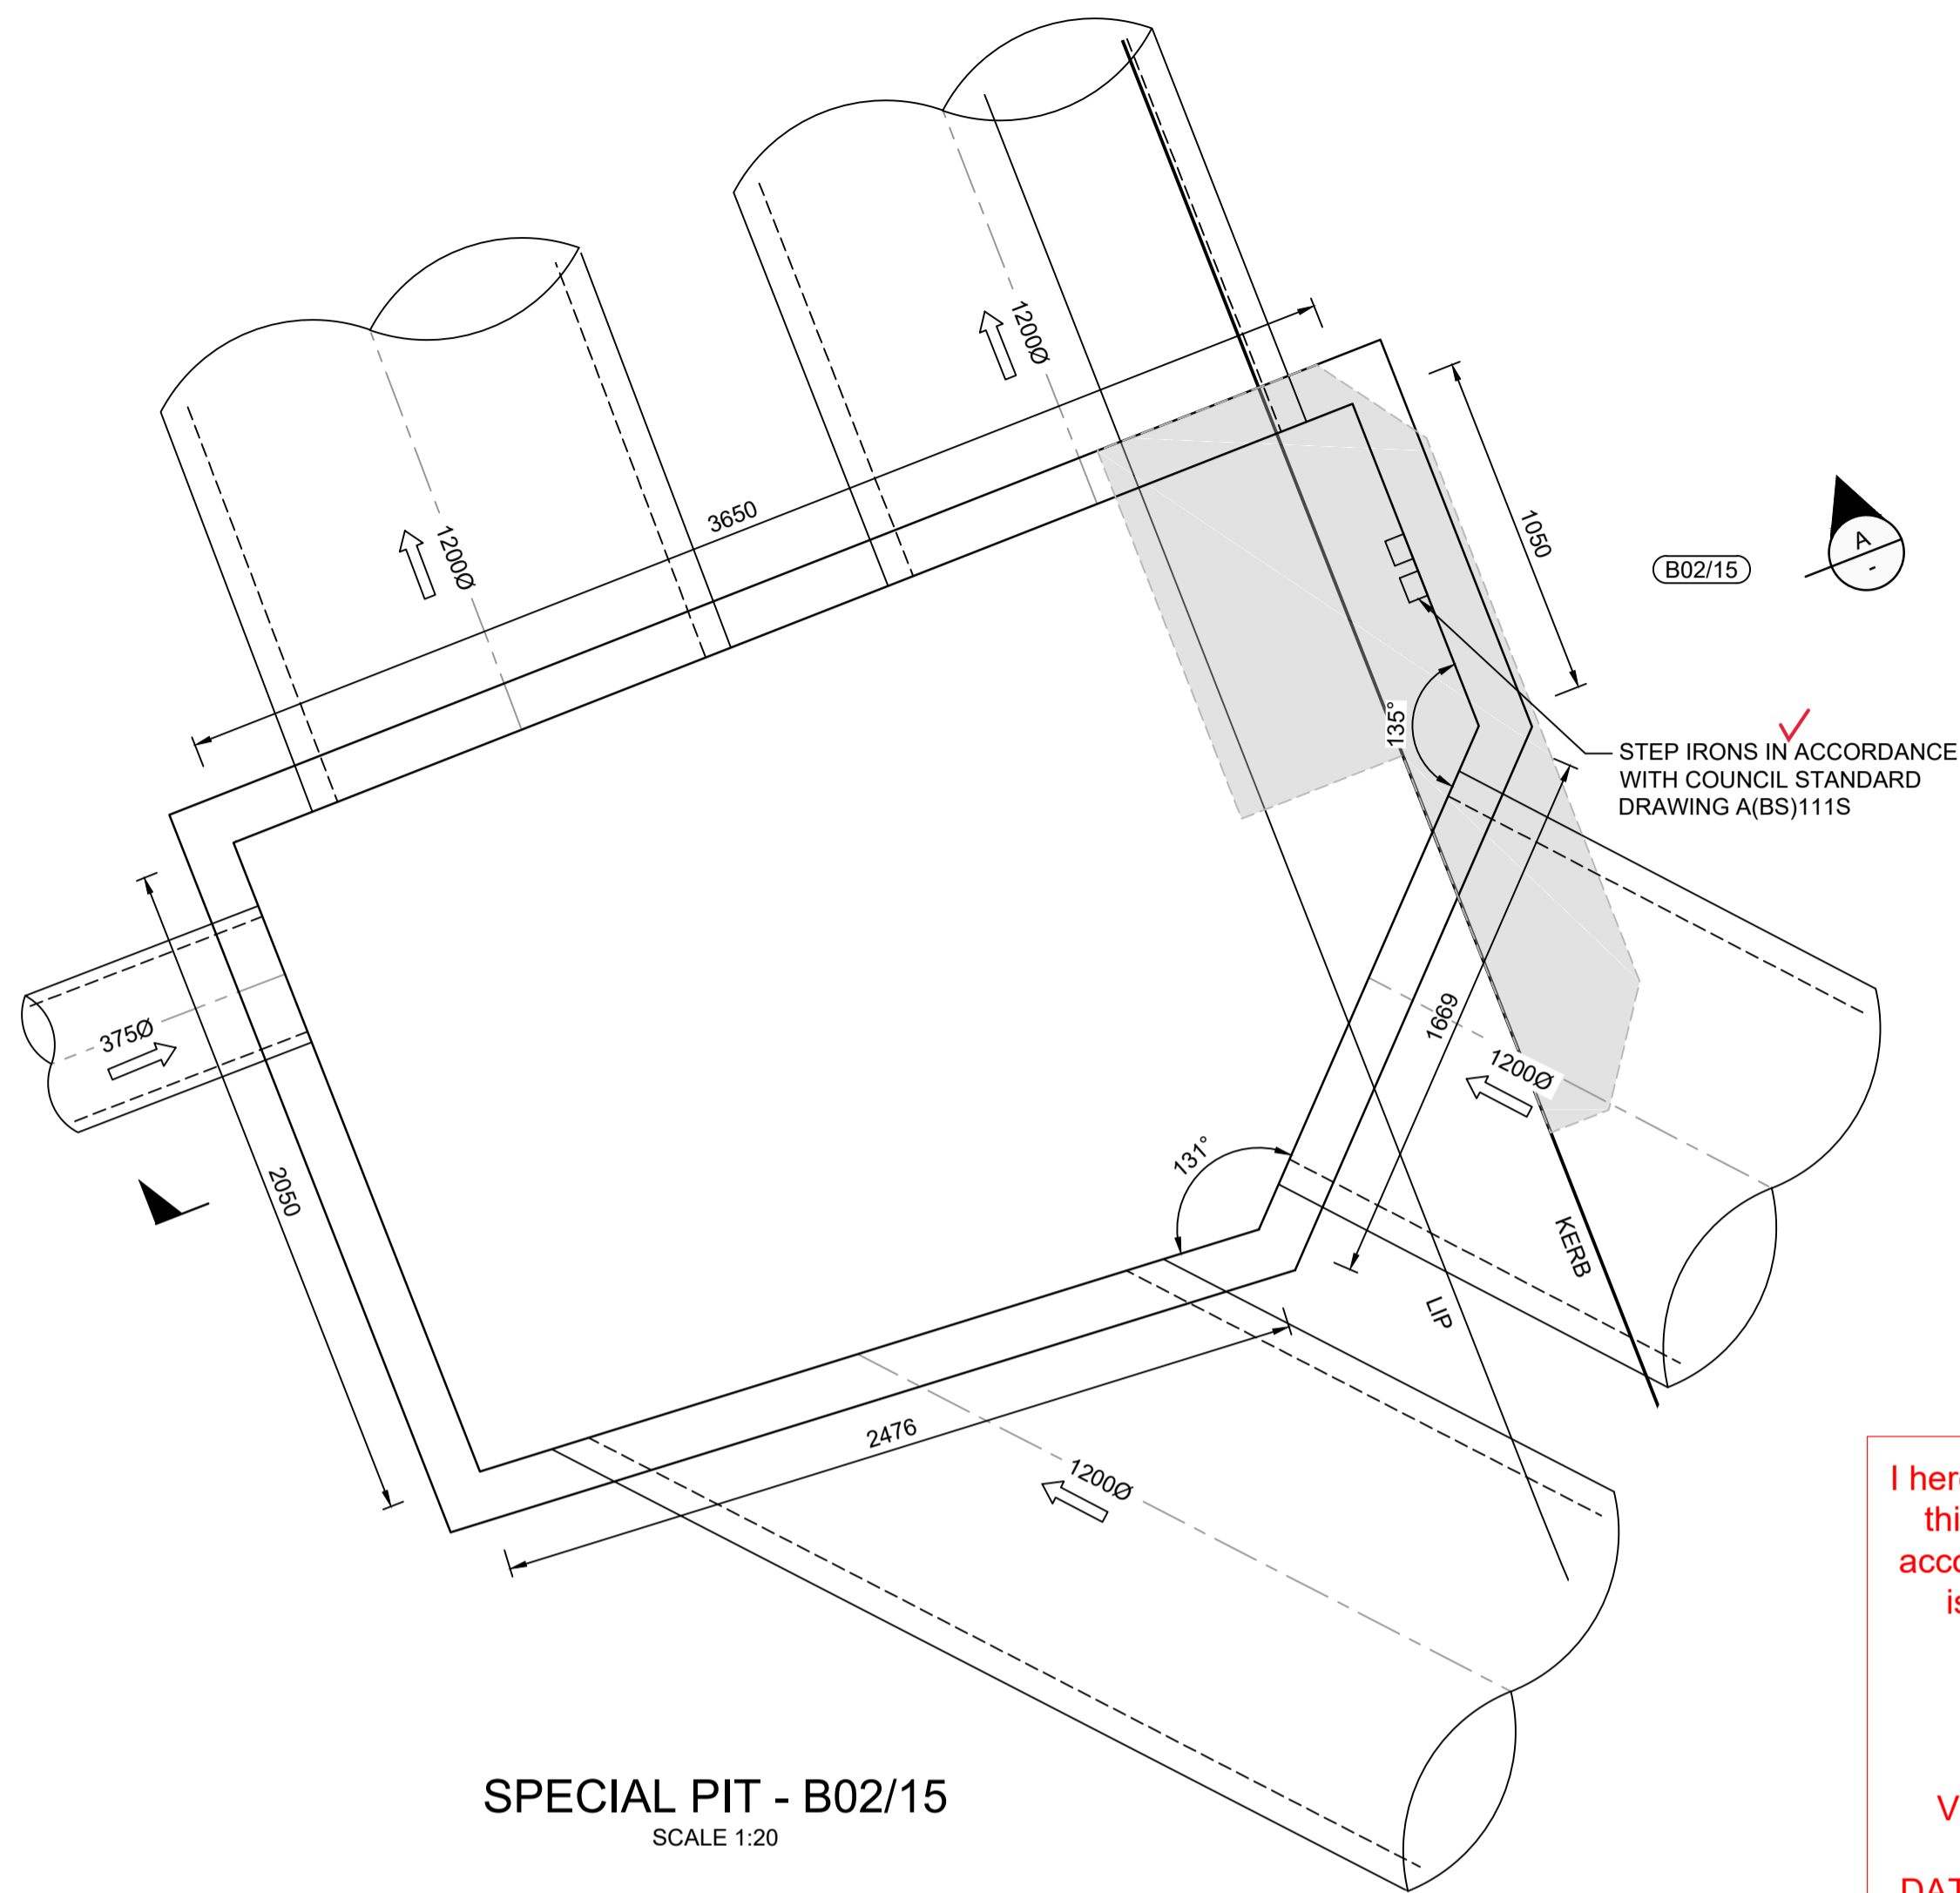

SPECIAL PIT - B02/15
SCALE 1:20

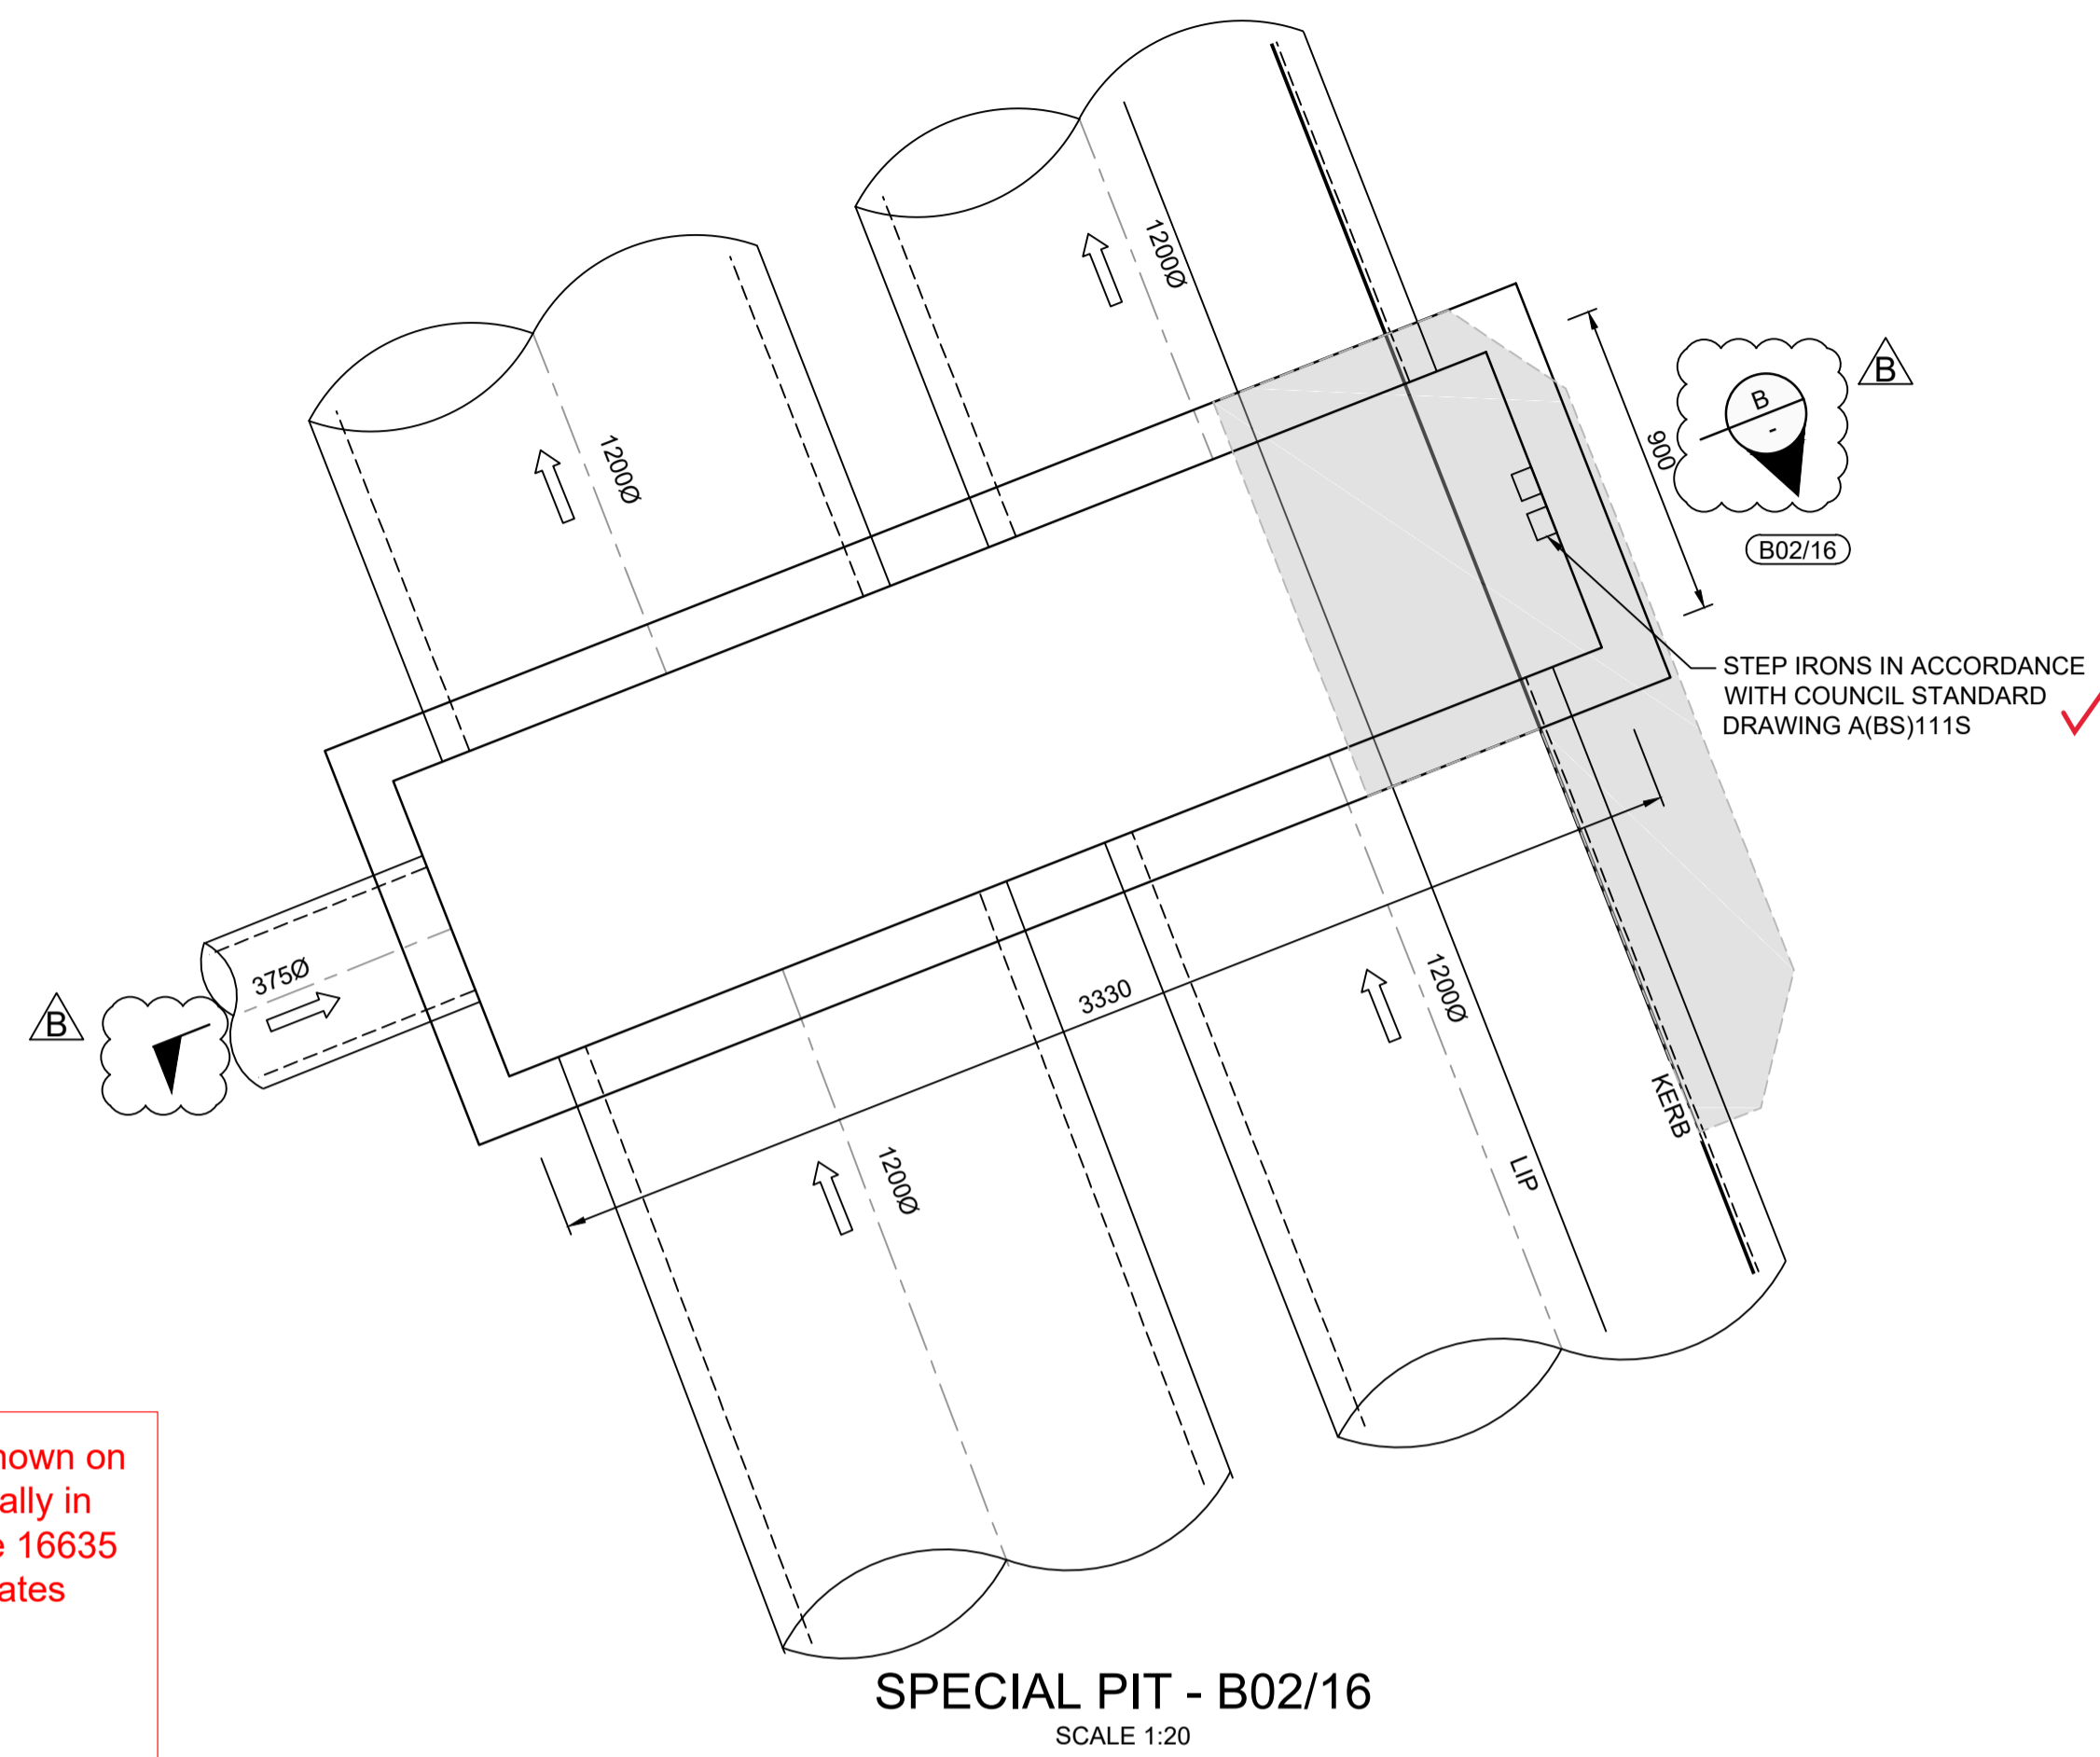


SPECIAL PIT - B02/16
SCALE 1:20

I hereby certify that engineering works shown on this plan have been constructed generally in accordance with Construction Certificate 16635 issued by Land Development Certificates


 Signature.....*PR*.....
PETER ROBERT WARWICK
 Registered Land Surveyor
VINCE MORGAN SURVEYORS PTY LTD

 DATE 20/12/2022 REF 20260-7


These plans are referred to in certificate no. **16635** approved by:
Christopher Louis Wahbe
 Registered Certifier
 Registration No: BDC 3015
 Categories: Certifier - Subdivision
Land Development Certificates
www.LDC.com.au

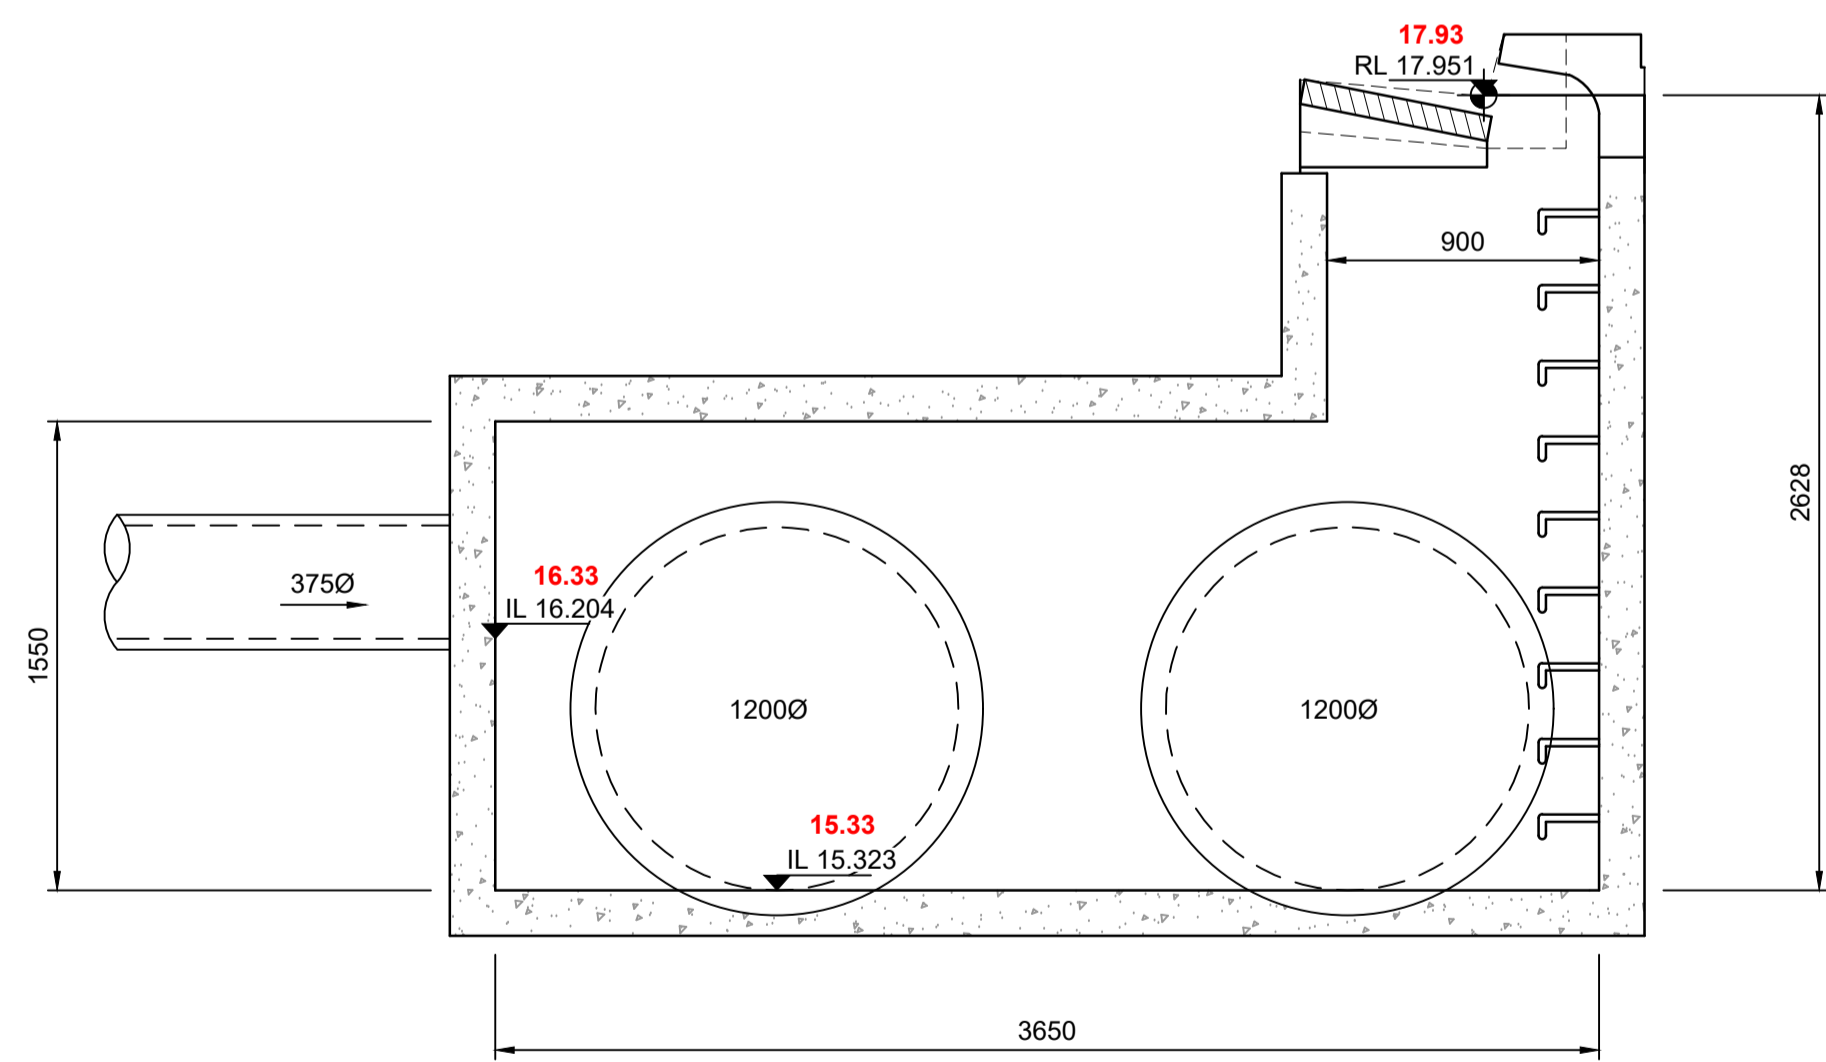

SECTION A
SCALE 1:25

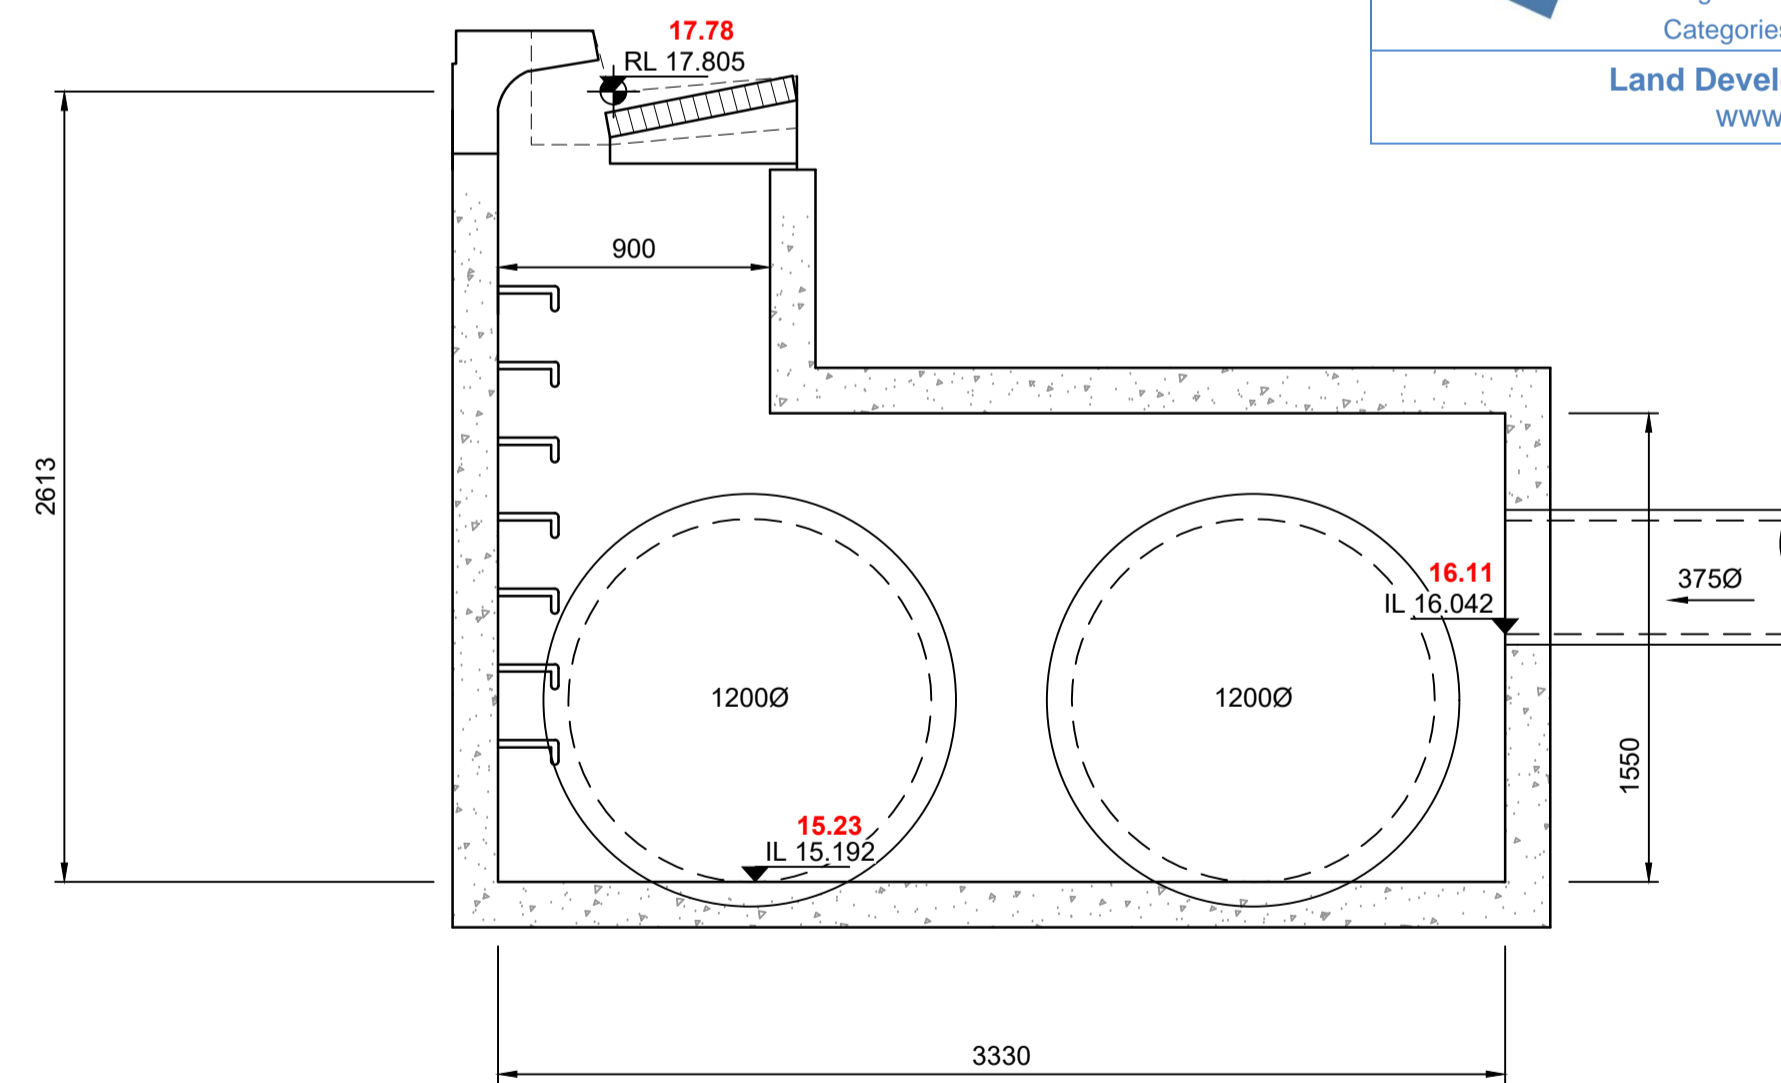

SECTION B
SCALE 1:25

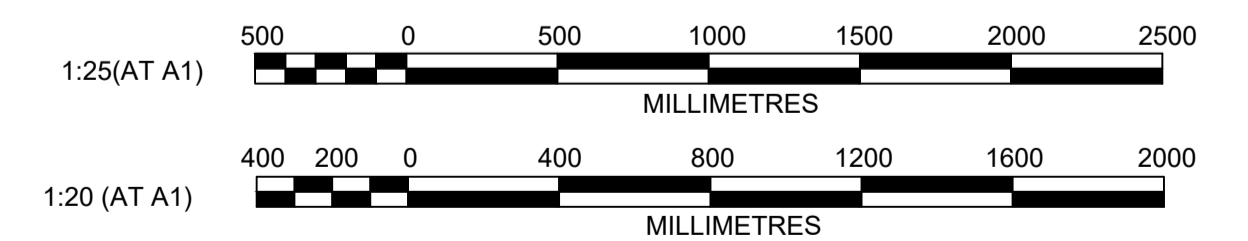

NO.	DESCRIPTION	DES	DRN	CKD	APR	DATE
B	SECTION MARKER UPDATED	DG	JM	MP	MS	14/09/21
A	ISSUE FOR APPROVAL	DG	JM	MP	PJM	12/08/21
	AMENDMENT					

J. WYNDHAM PRINCE
CONSULTING CIVIL INFRASTRUCTURE ENGINEERS & PROJECT MANAGERS

PO Box 4366 PENRITH WESTFIELD NSW 2750
P 02 4720 3300 W www.jwprince.com.au E jwp@jwprince.com.au

CLIENT:

WINTAN PROPERTY GROUP

STATUS: **ISSUE FOR CONSTRUCTION APPROVAL**

THIS DRAWING MUST NOT BE USED FOR CONSTRUCTION UNLESS SIGNED AS PART OF AN APPROVED CONSTRUCTION CERTIFICATE.


NEWPARK PRECINCT 7, STAGE 7B
SPECIAL PIT DETAILS
SHEET 3

AZIMUTH: M.G.A.94 DATUM: A.H.D. ORIGIN: SSM 1112 PLAN No: **9985-12-CC5552**


PROJECT No: **9985-12**
SHEET No: **CC5552**

B

Plotted: 14 September, 2021 1:04:25 PM File Name: J:\9985DCC - Construction Certificate Approval Plans\PK12 WESTERN PRECINCTS15 - Precinct 7\9985-12-CC5553.dwg

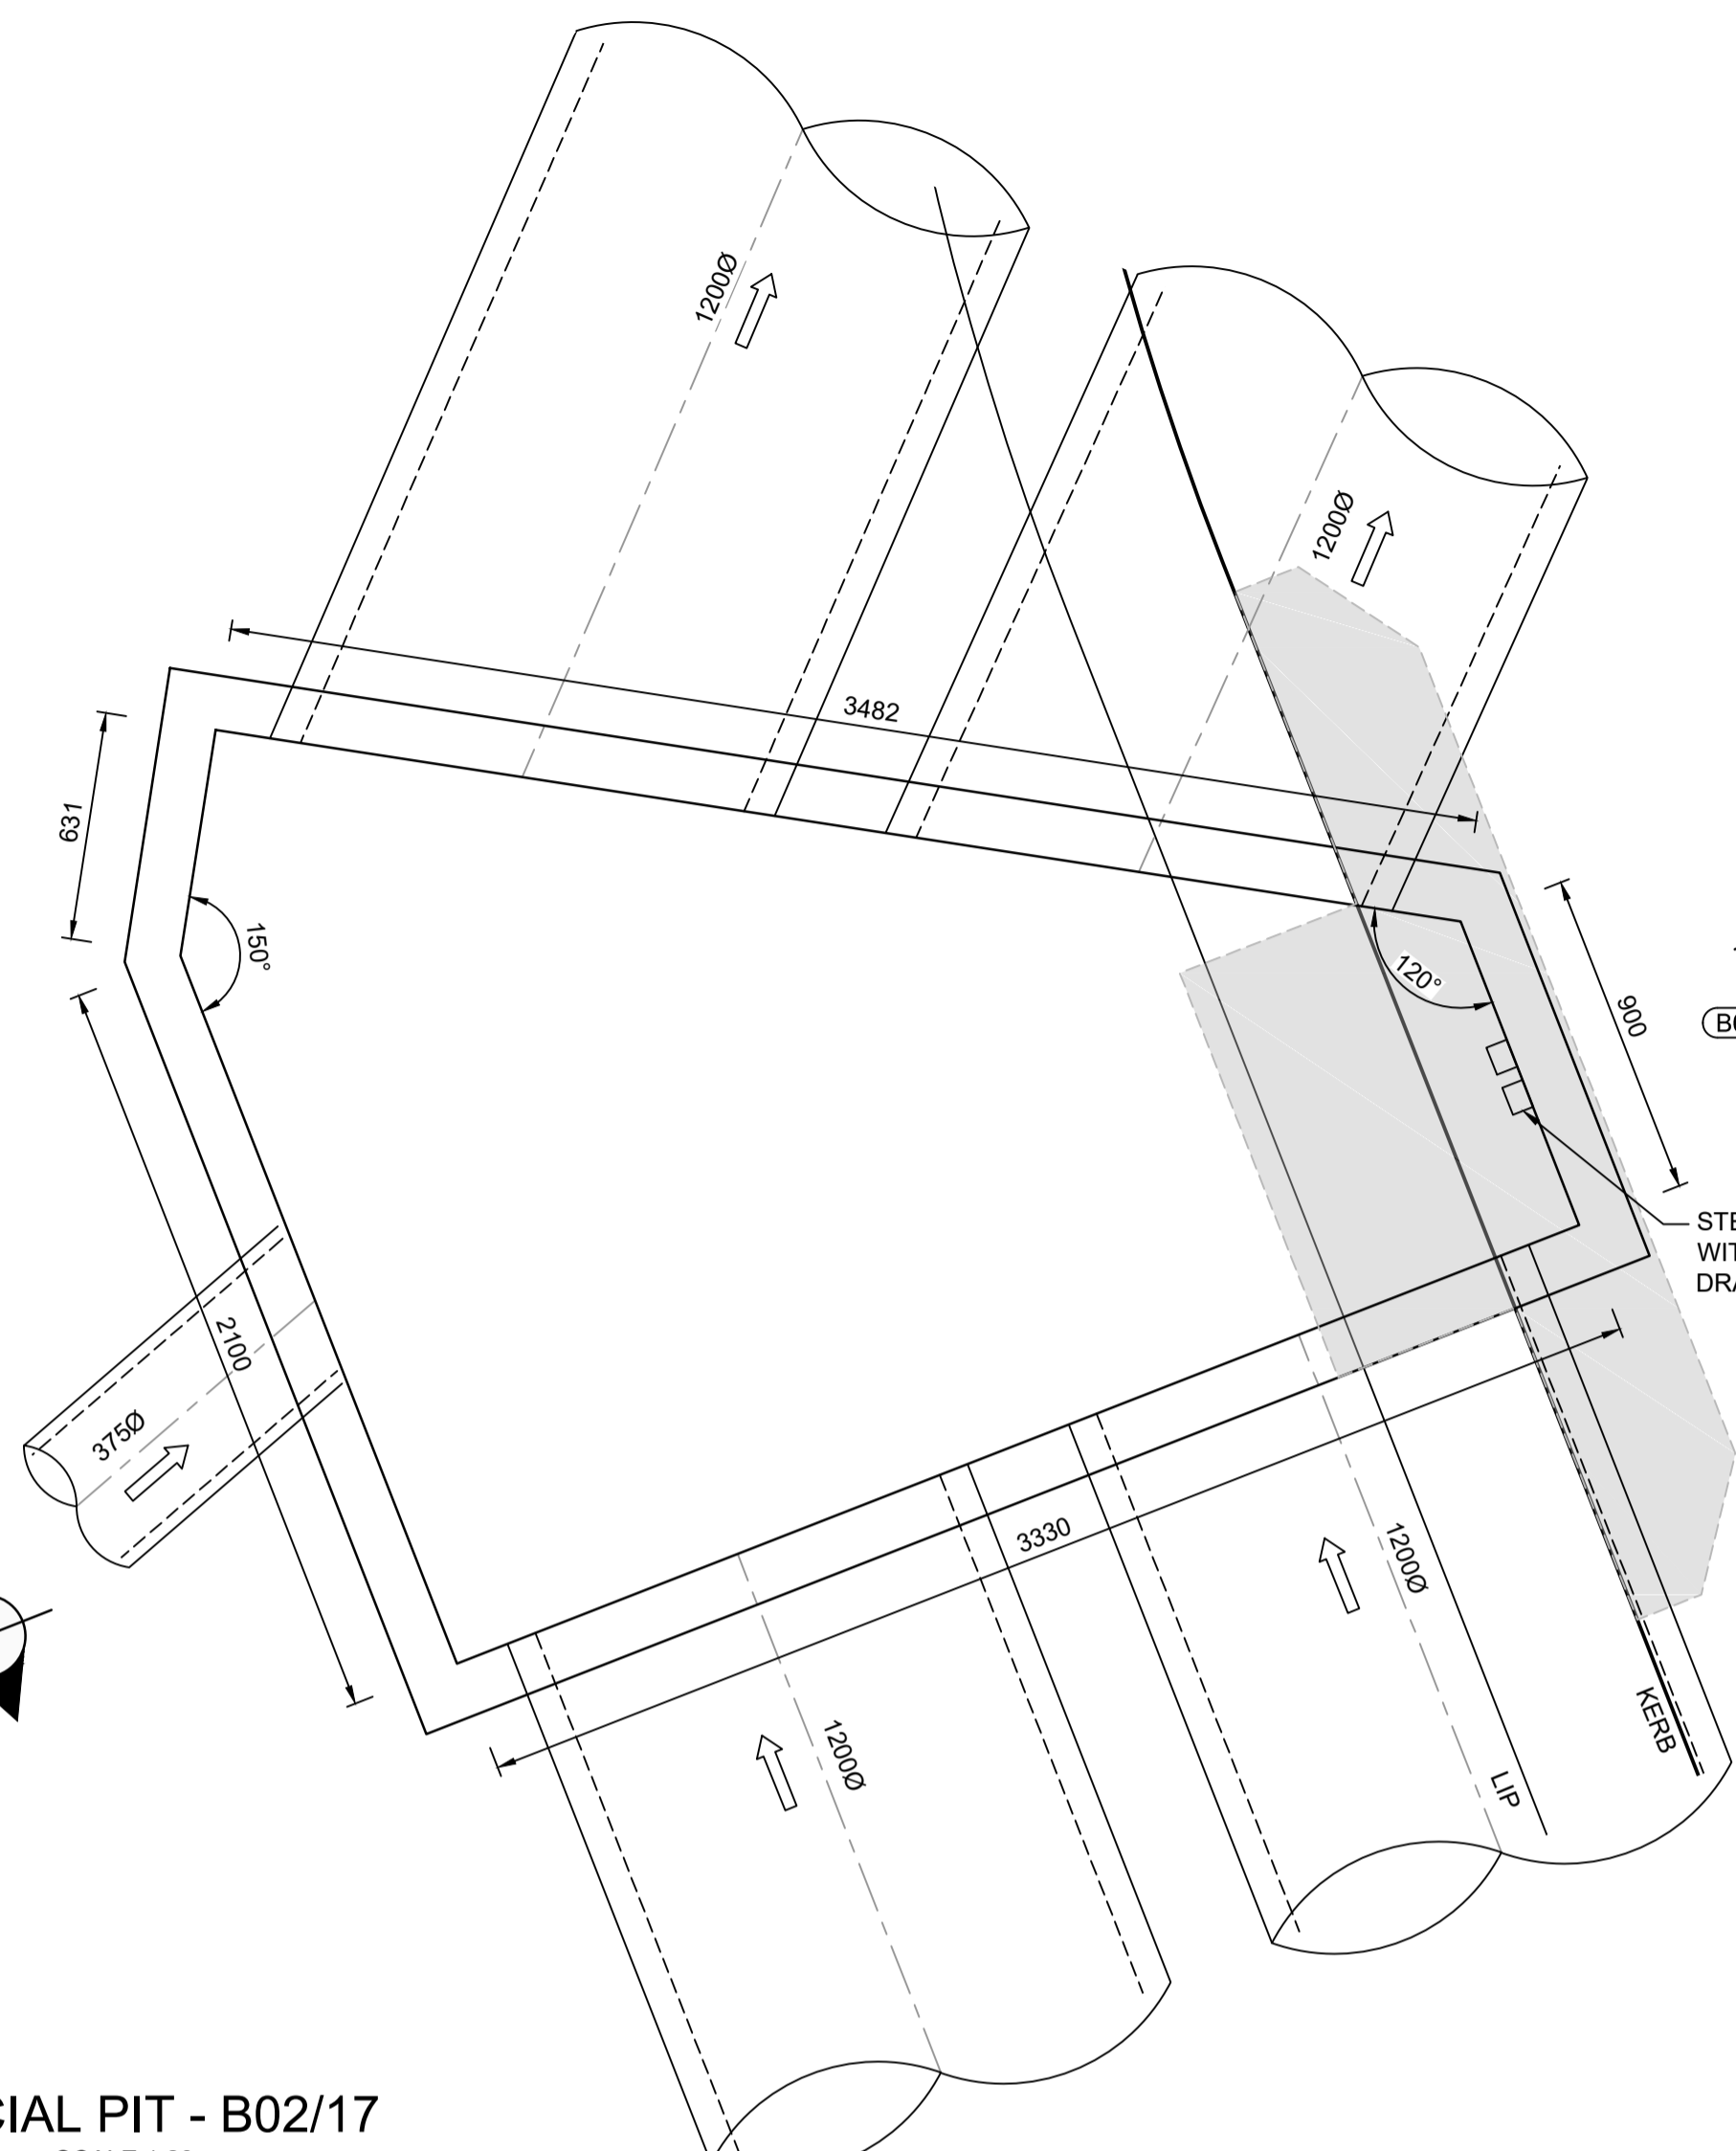

SPECIAL PIT - B02/17
SCALE 1:20

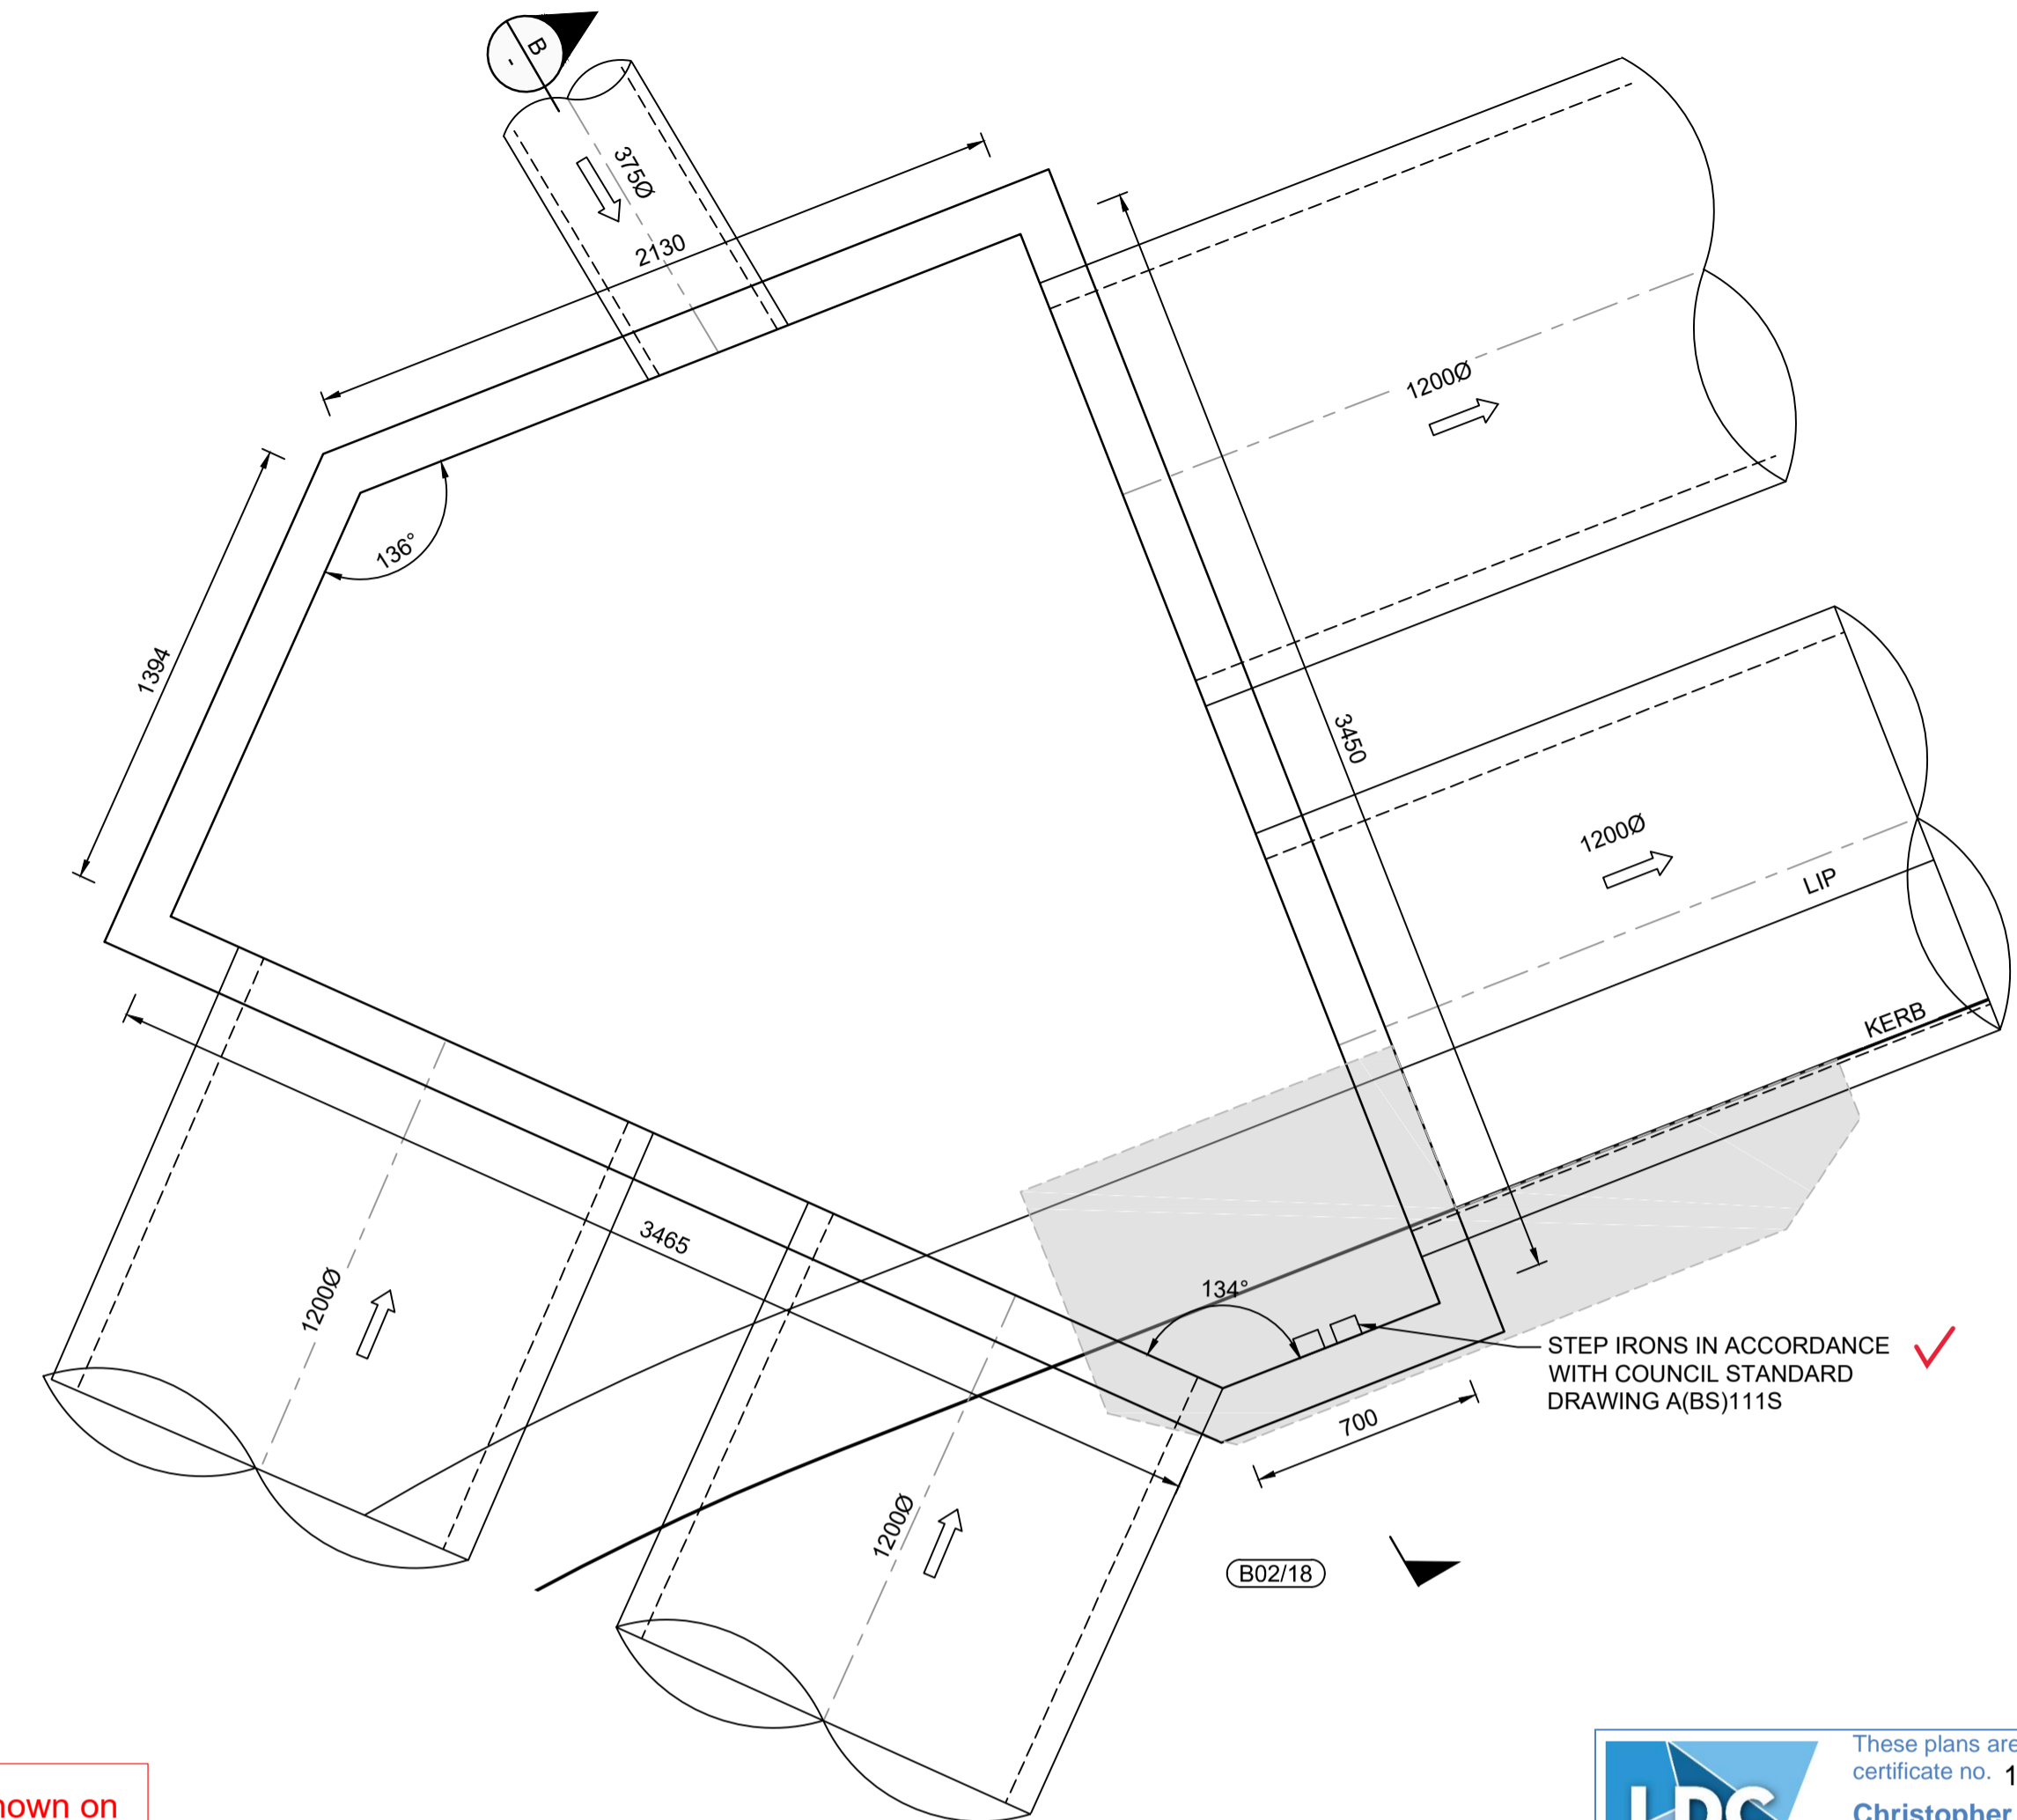

SPECIAL PIT - B02/18
SCALE 1:20

STEP IRONS IN ACCORDANCE WITH COUNCIL STANDARD DRAWING A(BS)111S ✓


STEP IRONS IN ACCORDANCE WITH COUNCIL STANDARD DRAWING A(BS)111S ✓

I hereby certify that engineering works shown on this plan have been constructed generally in accordance with Construction Certificate 16635 issued by Land Development Certificates


Signature: *[Signature]*
PETER ROBERT WARWICK
Registered Land Surveyor
VINCE MORGAN SURVEYORS PTY LTD

DATE 20/12/2022 REF 20260-7


LDC These plans are referred to in certificate no. 16635 approved by:
Christopher Louis Wahbe
Registered Certifier
Registration No: BDC 3015
Categories: Certifier - Subdivision
Land Development Certificates
www.LDC.com.au

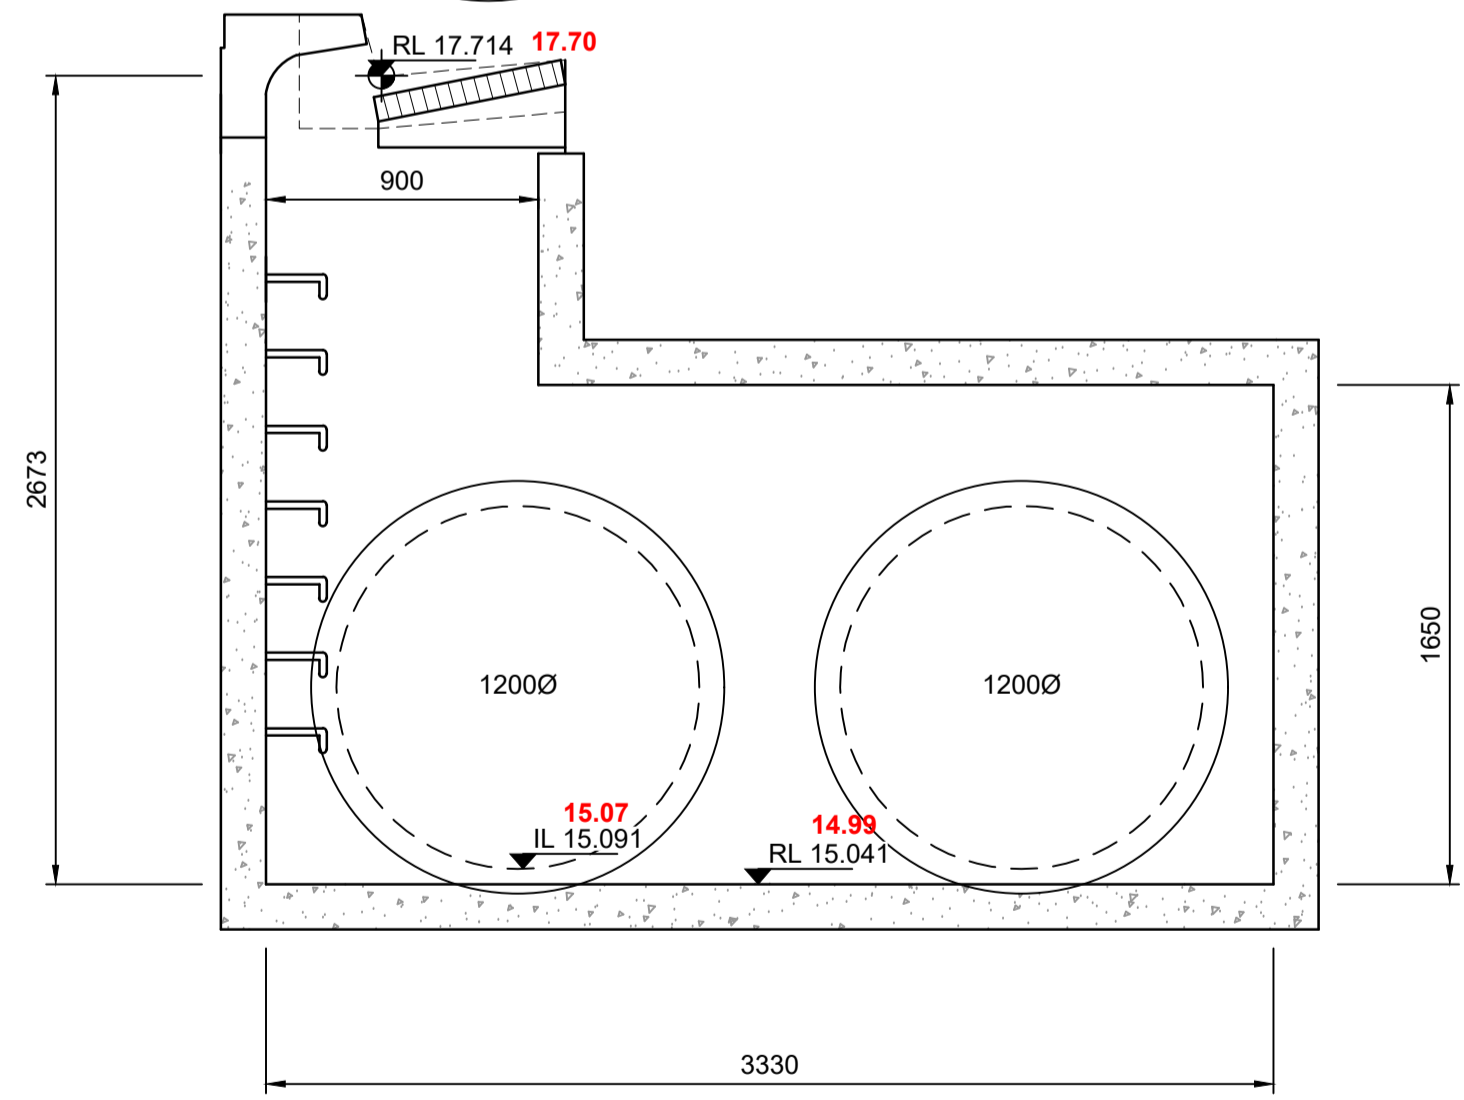

SECTION A
SCALE 1:25

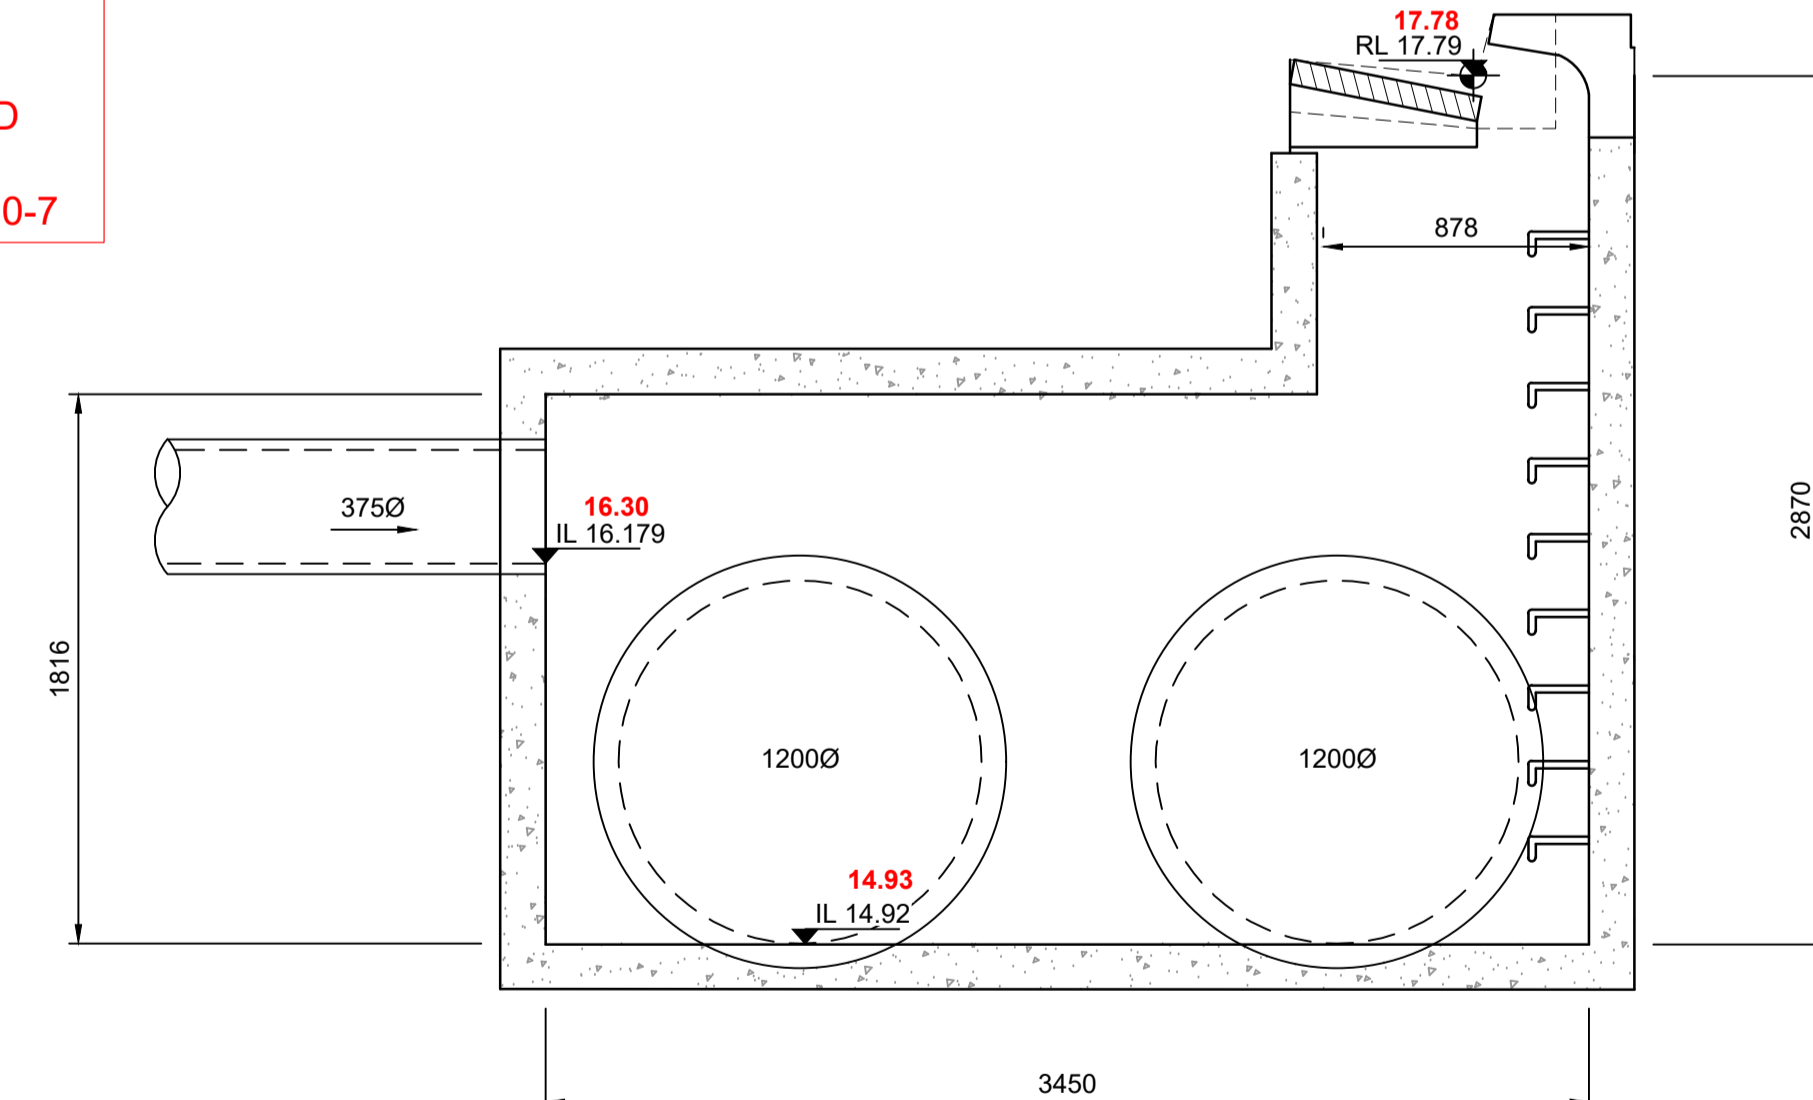

SECTION B
SCALE 1:25

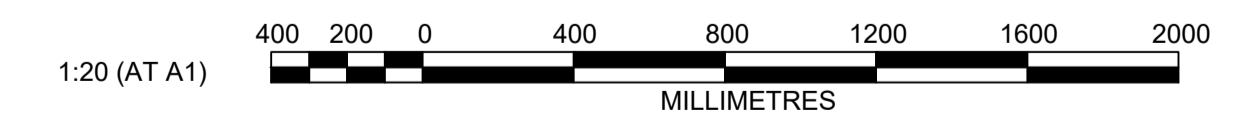

NO.	DESCRIPTION	DES	DRN	CKD	APR	DATE
A	ISSUE FOR APPROVAL	DG	JM	MP	PJM	12/08/21
	AMENDMENT					





J. WYNDHAM PRINCE
CONSULTING CIVIL INFRASTRUCTURE ENGINEERS & PROJECT MANAGERS
PO Box 4366 PENRITH WESTFIELD NSW 2750
P 02 4720 3300 W www.jwprince.com.au E jwp@jwprince.com.au

CLIENT: **WINTEN PROPERTY GROUP**

STATUS: **ISSUE FOR CONSTRUCTION APPROVAL**
THIS DRAWING MUST NOT BE USED FOR CONSTRUCTION UNLESS SIGNED AS PART OF AN APPROVED CONSTRUCTION CERTIFICATE.

NEWPARK PRECINCT 7, STAGE 7B
SPECIAL PIT DETAILS
SHEET 4

PROJECT No: **9985-12**
SHEET No: **CC5553**
AZIMUTH: M.G.A.94 DATUM: A.H.D. ORIGIN: SSM 1112 PLAN No: 9985-12-CC5553

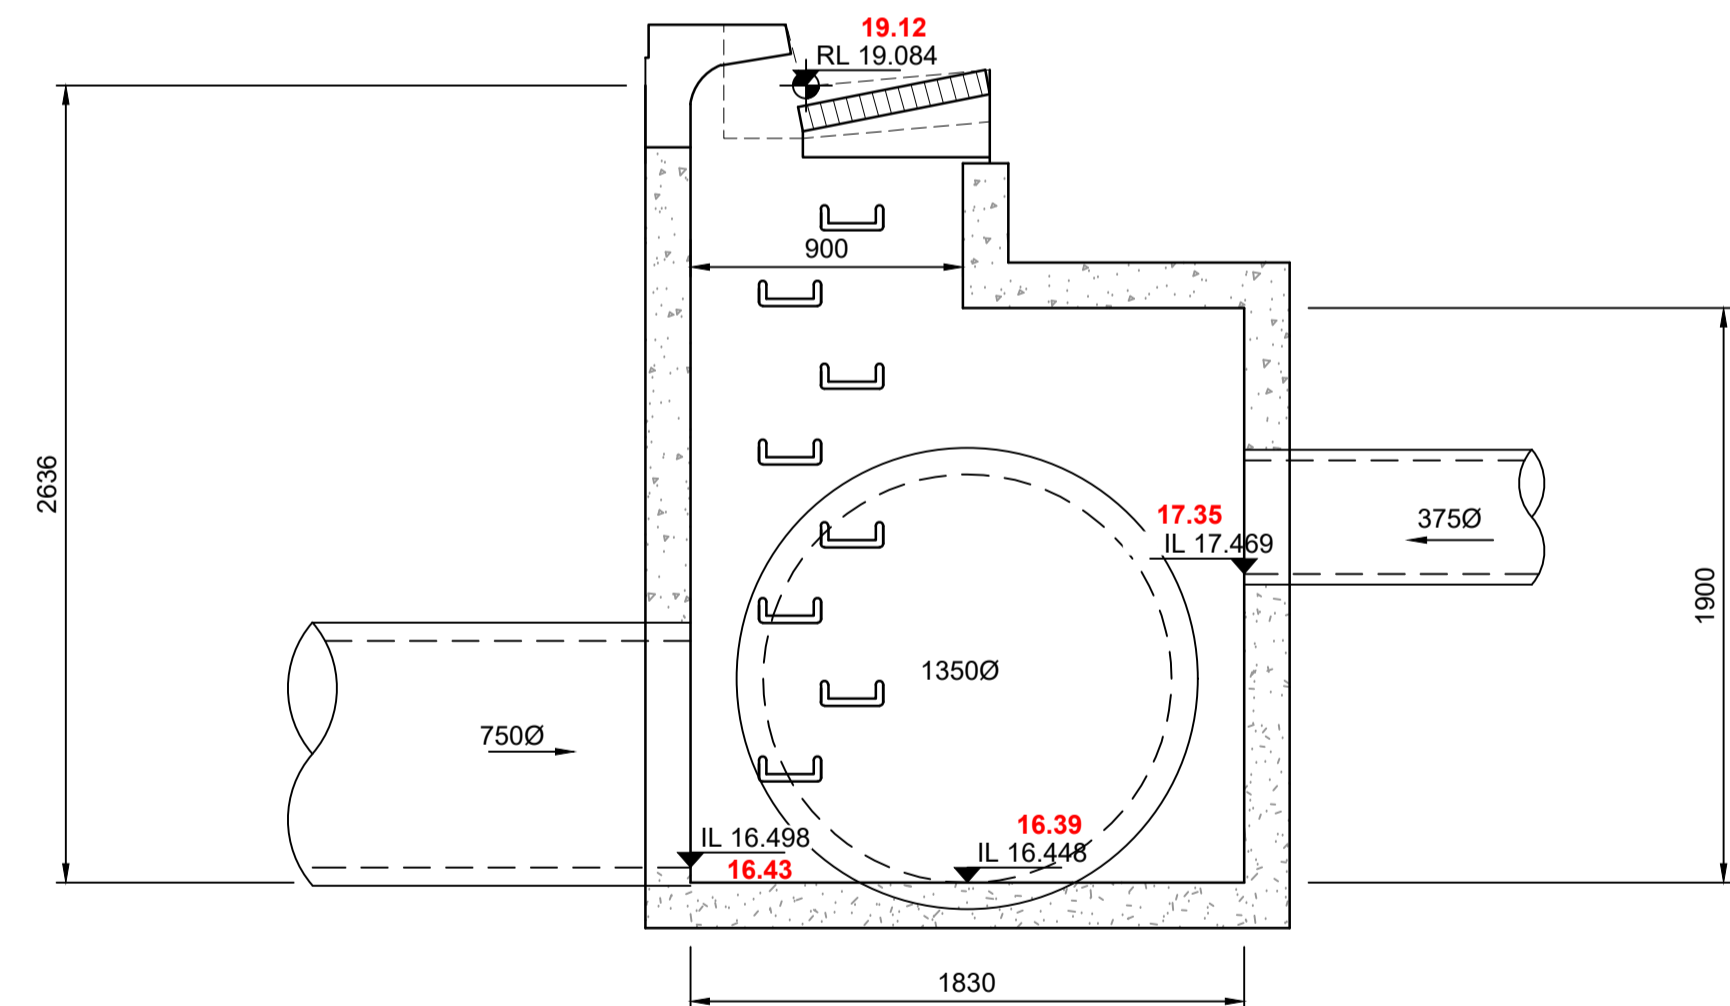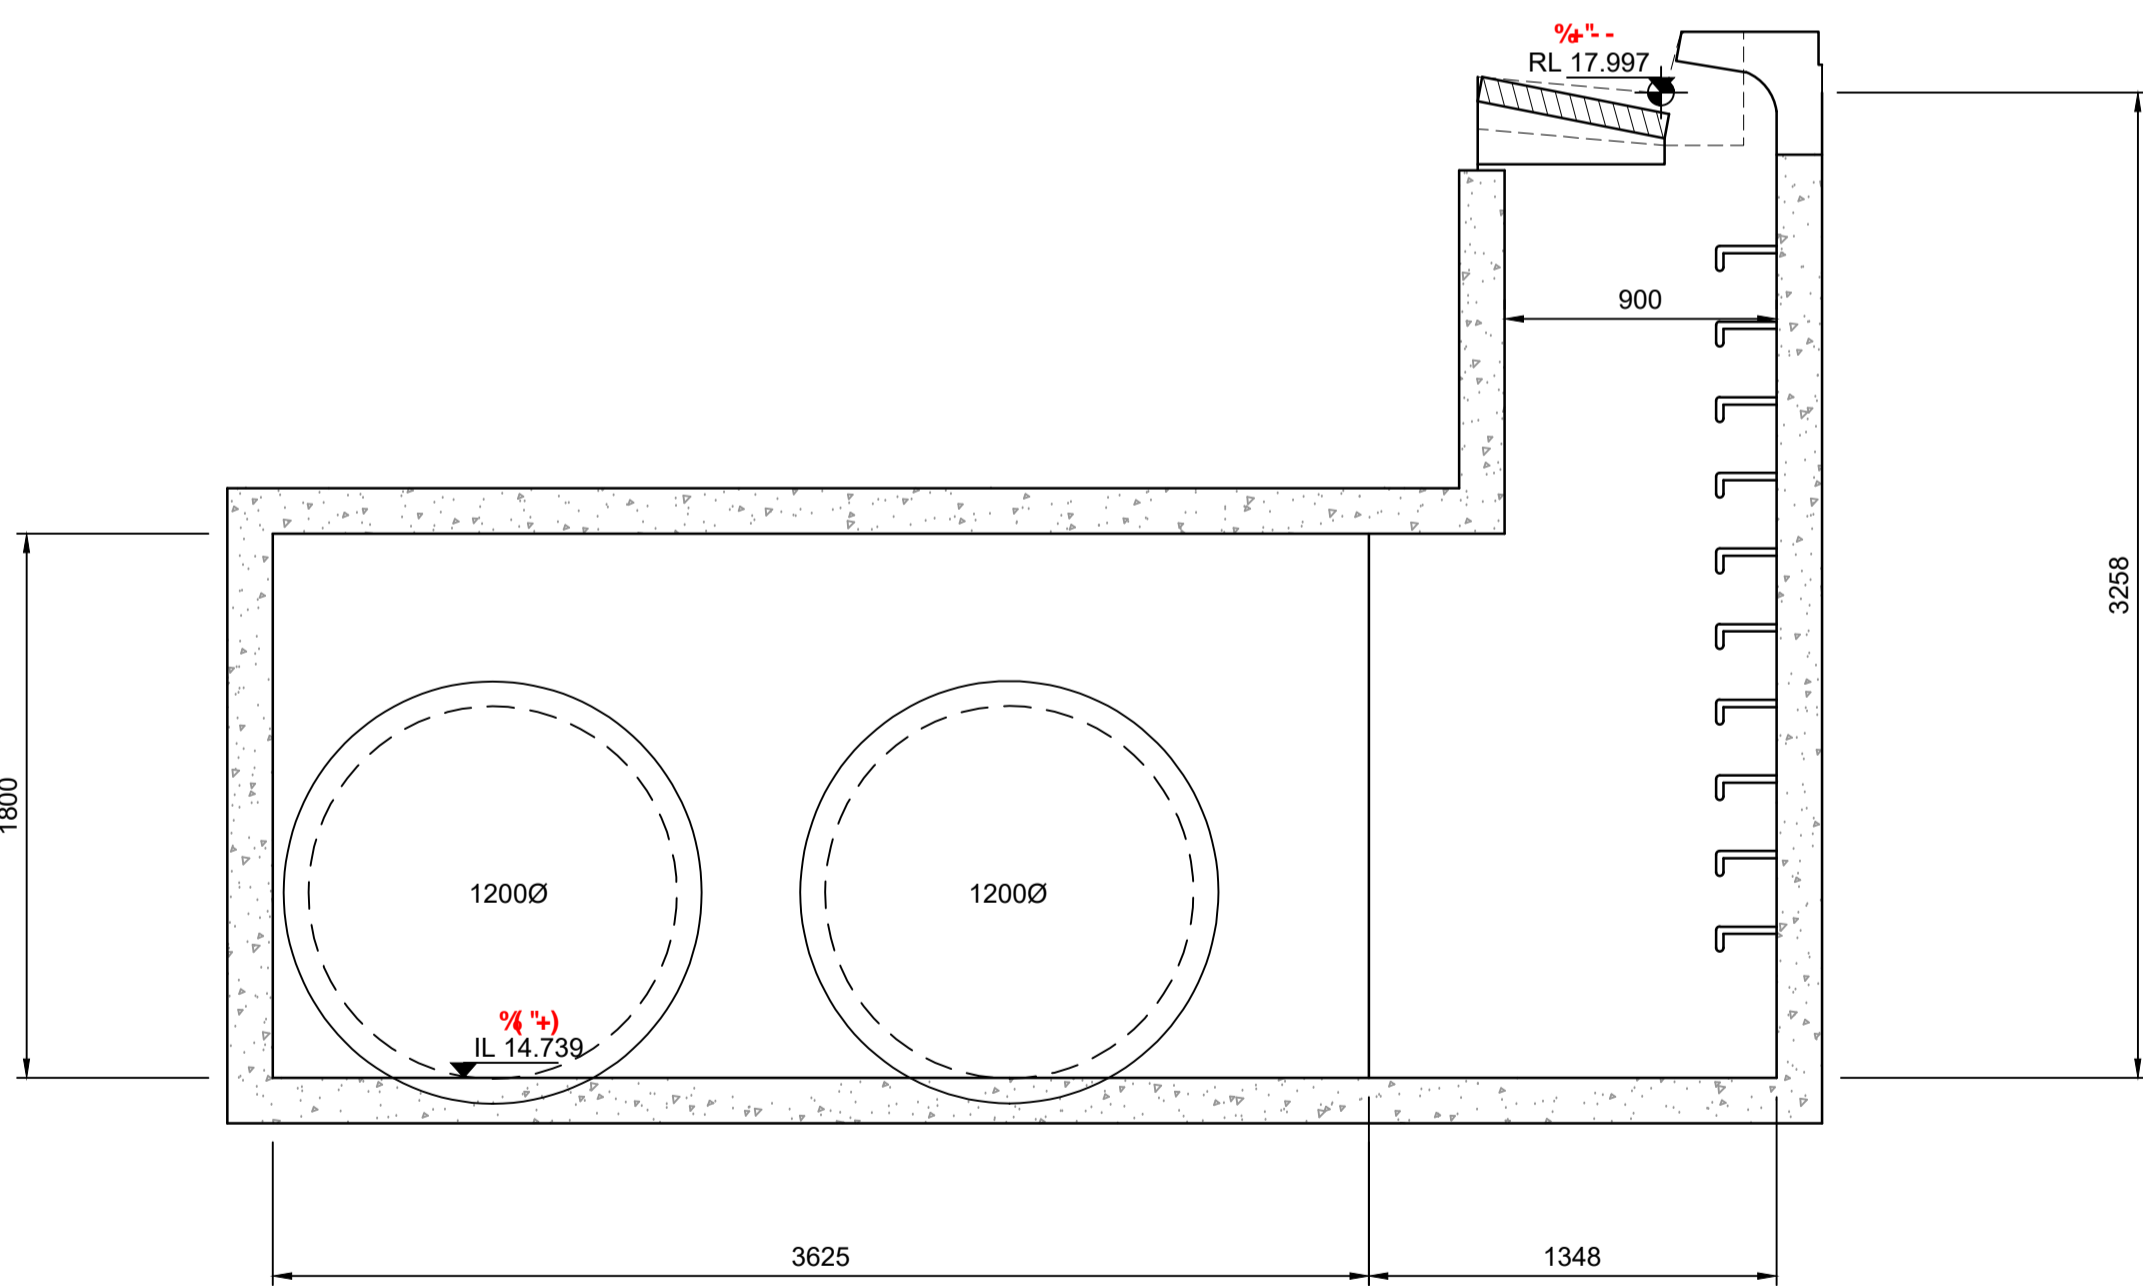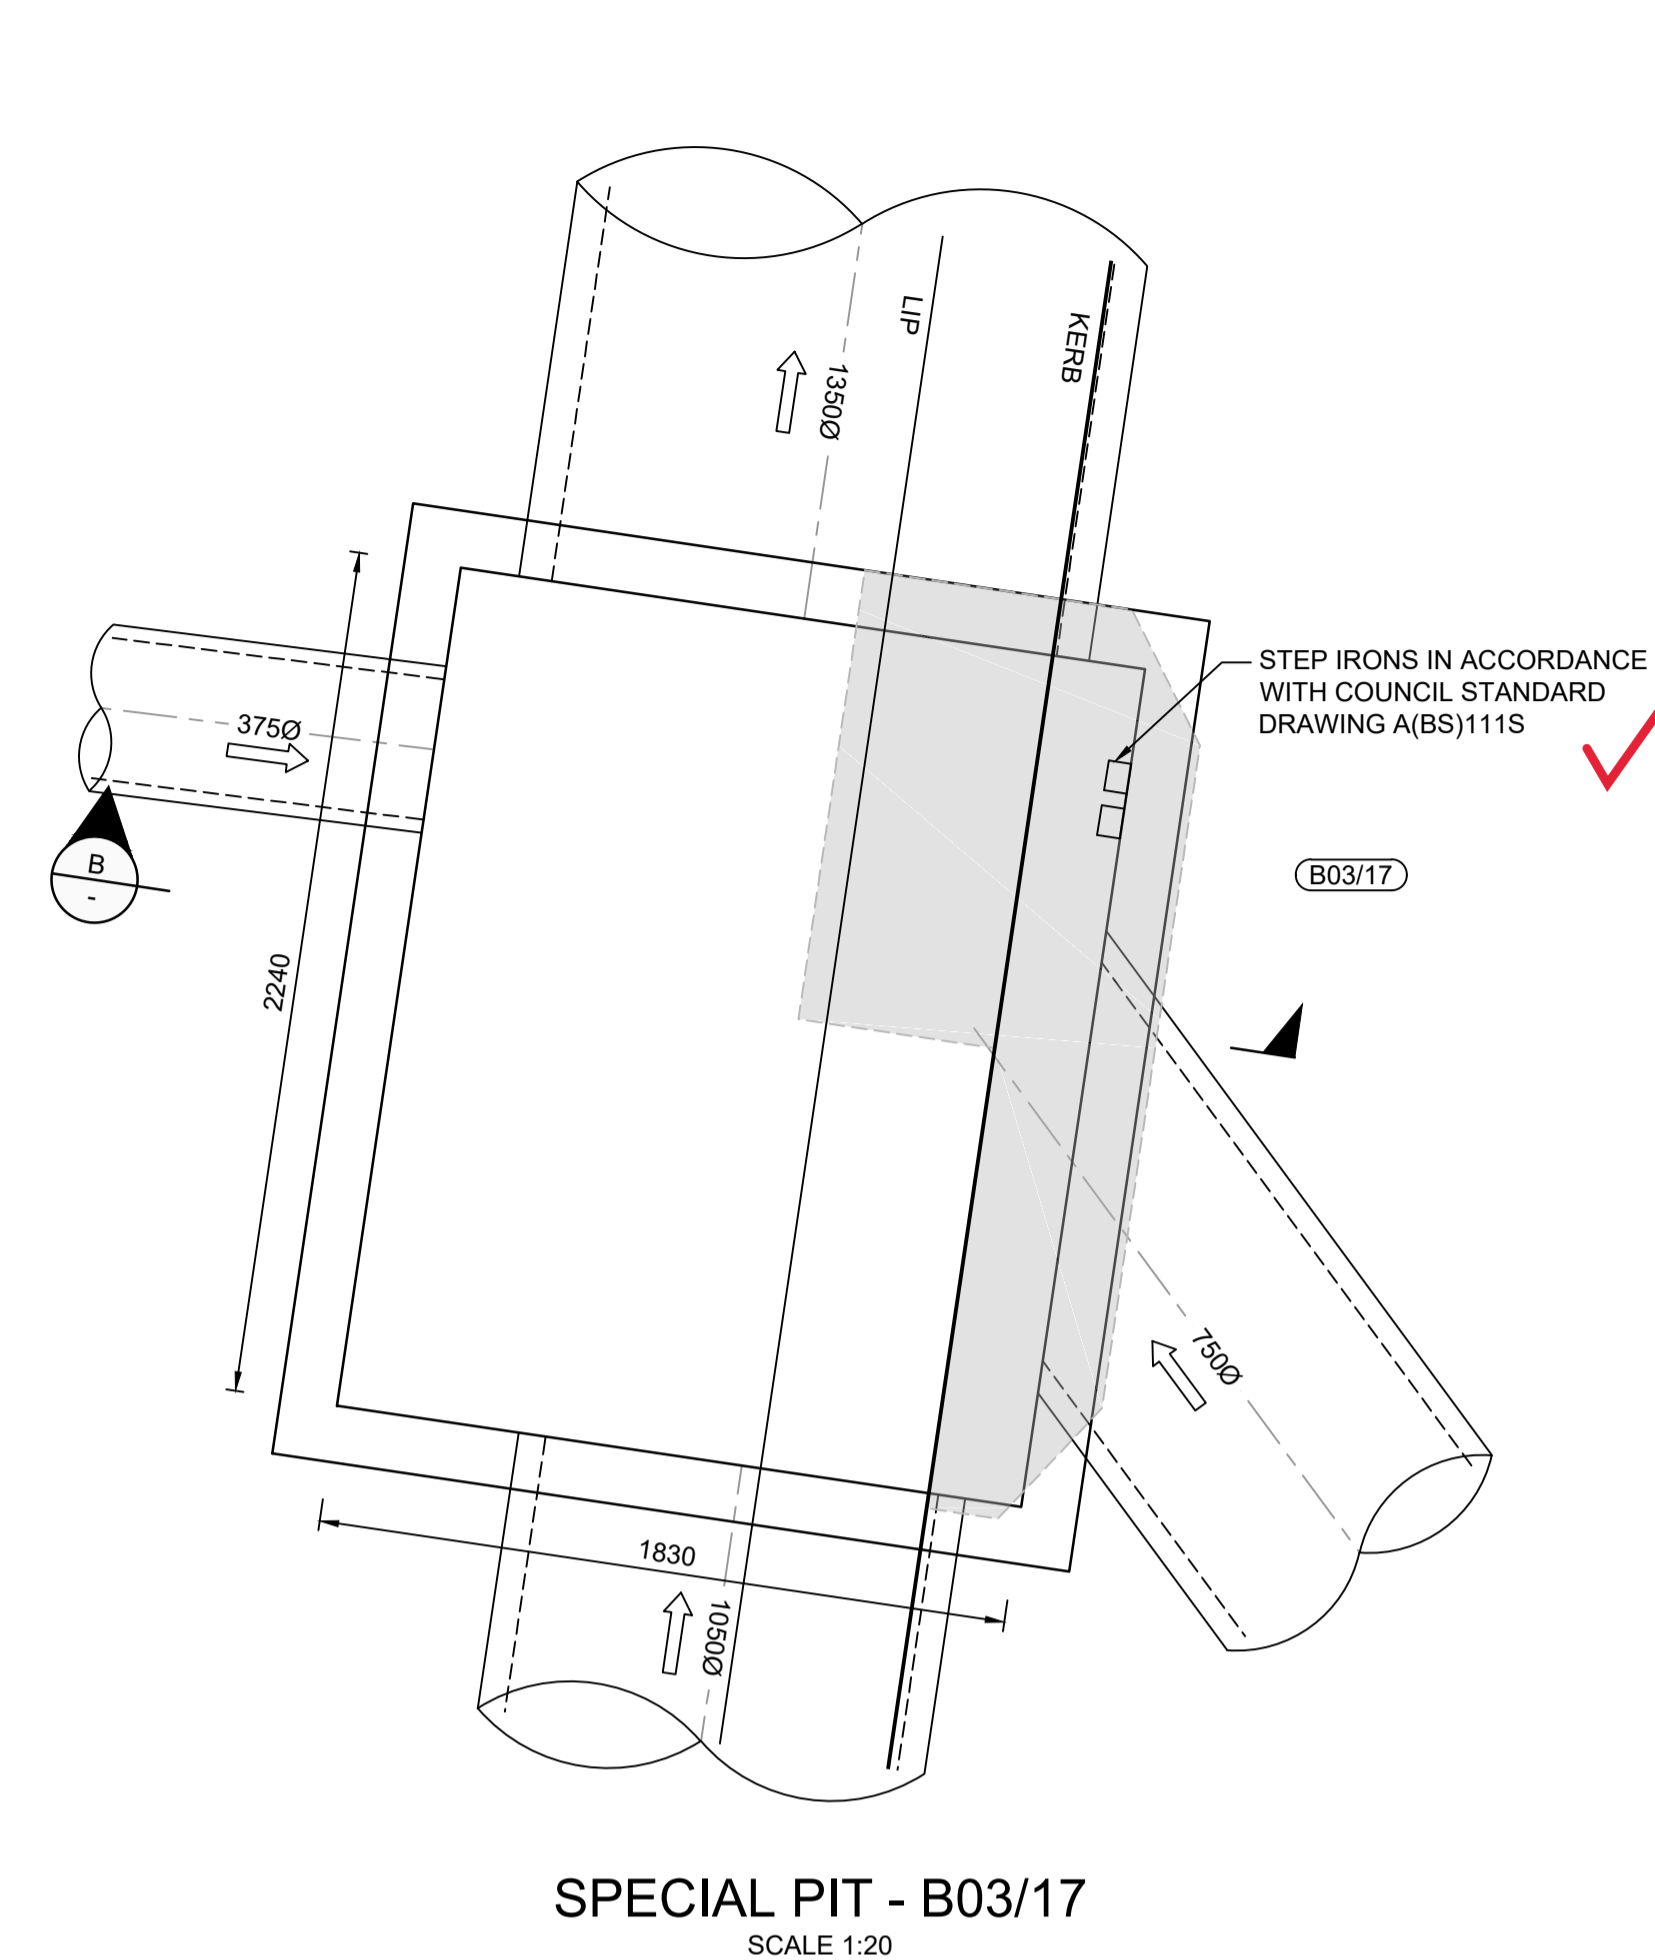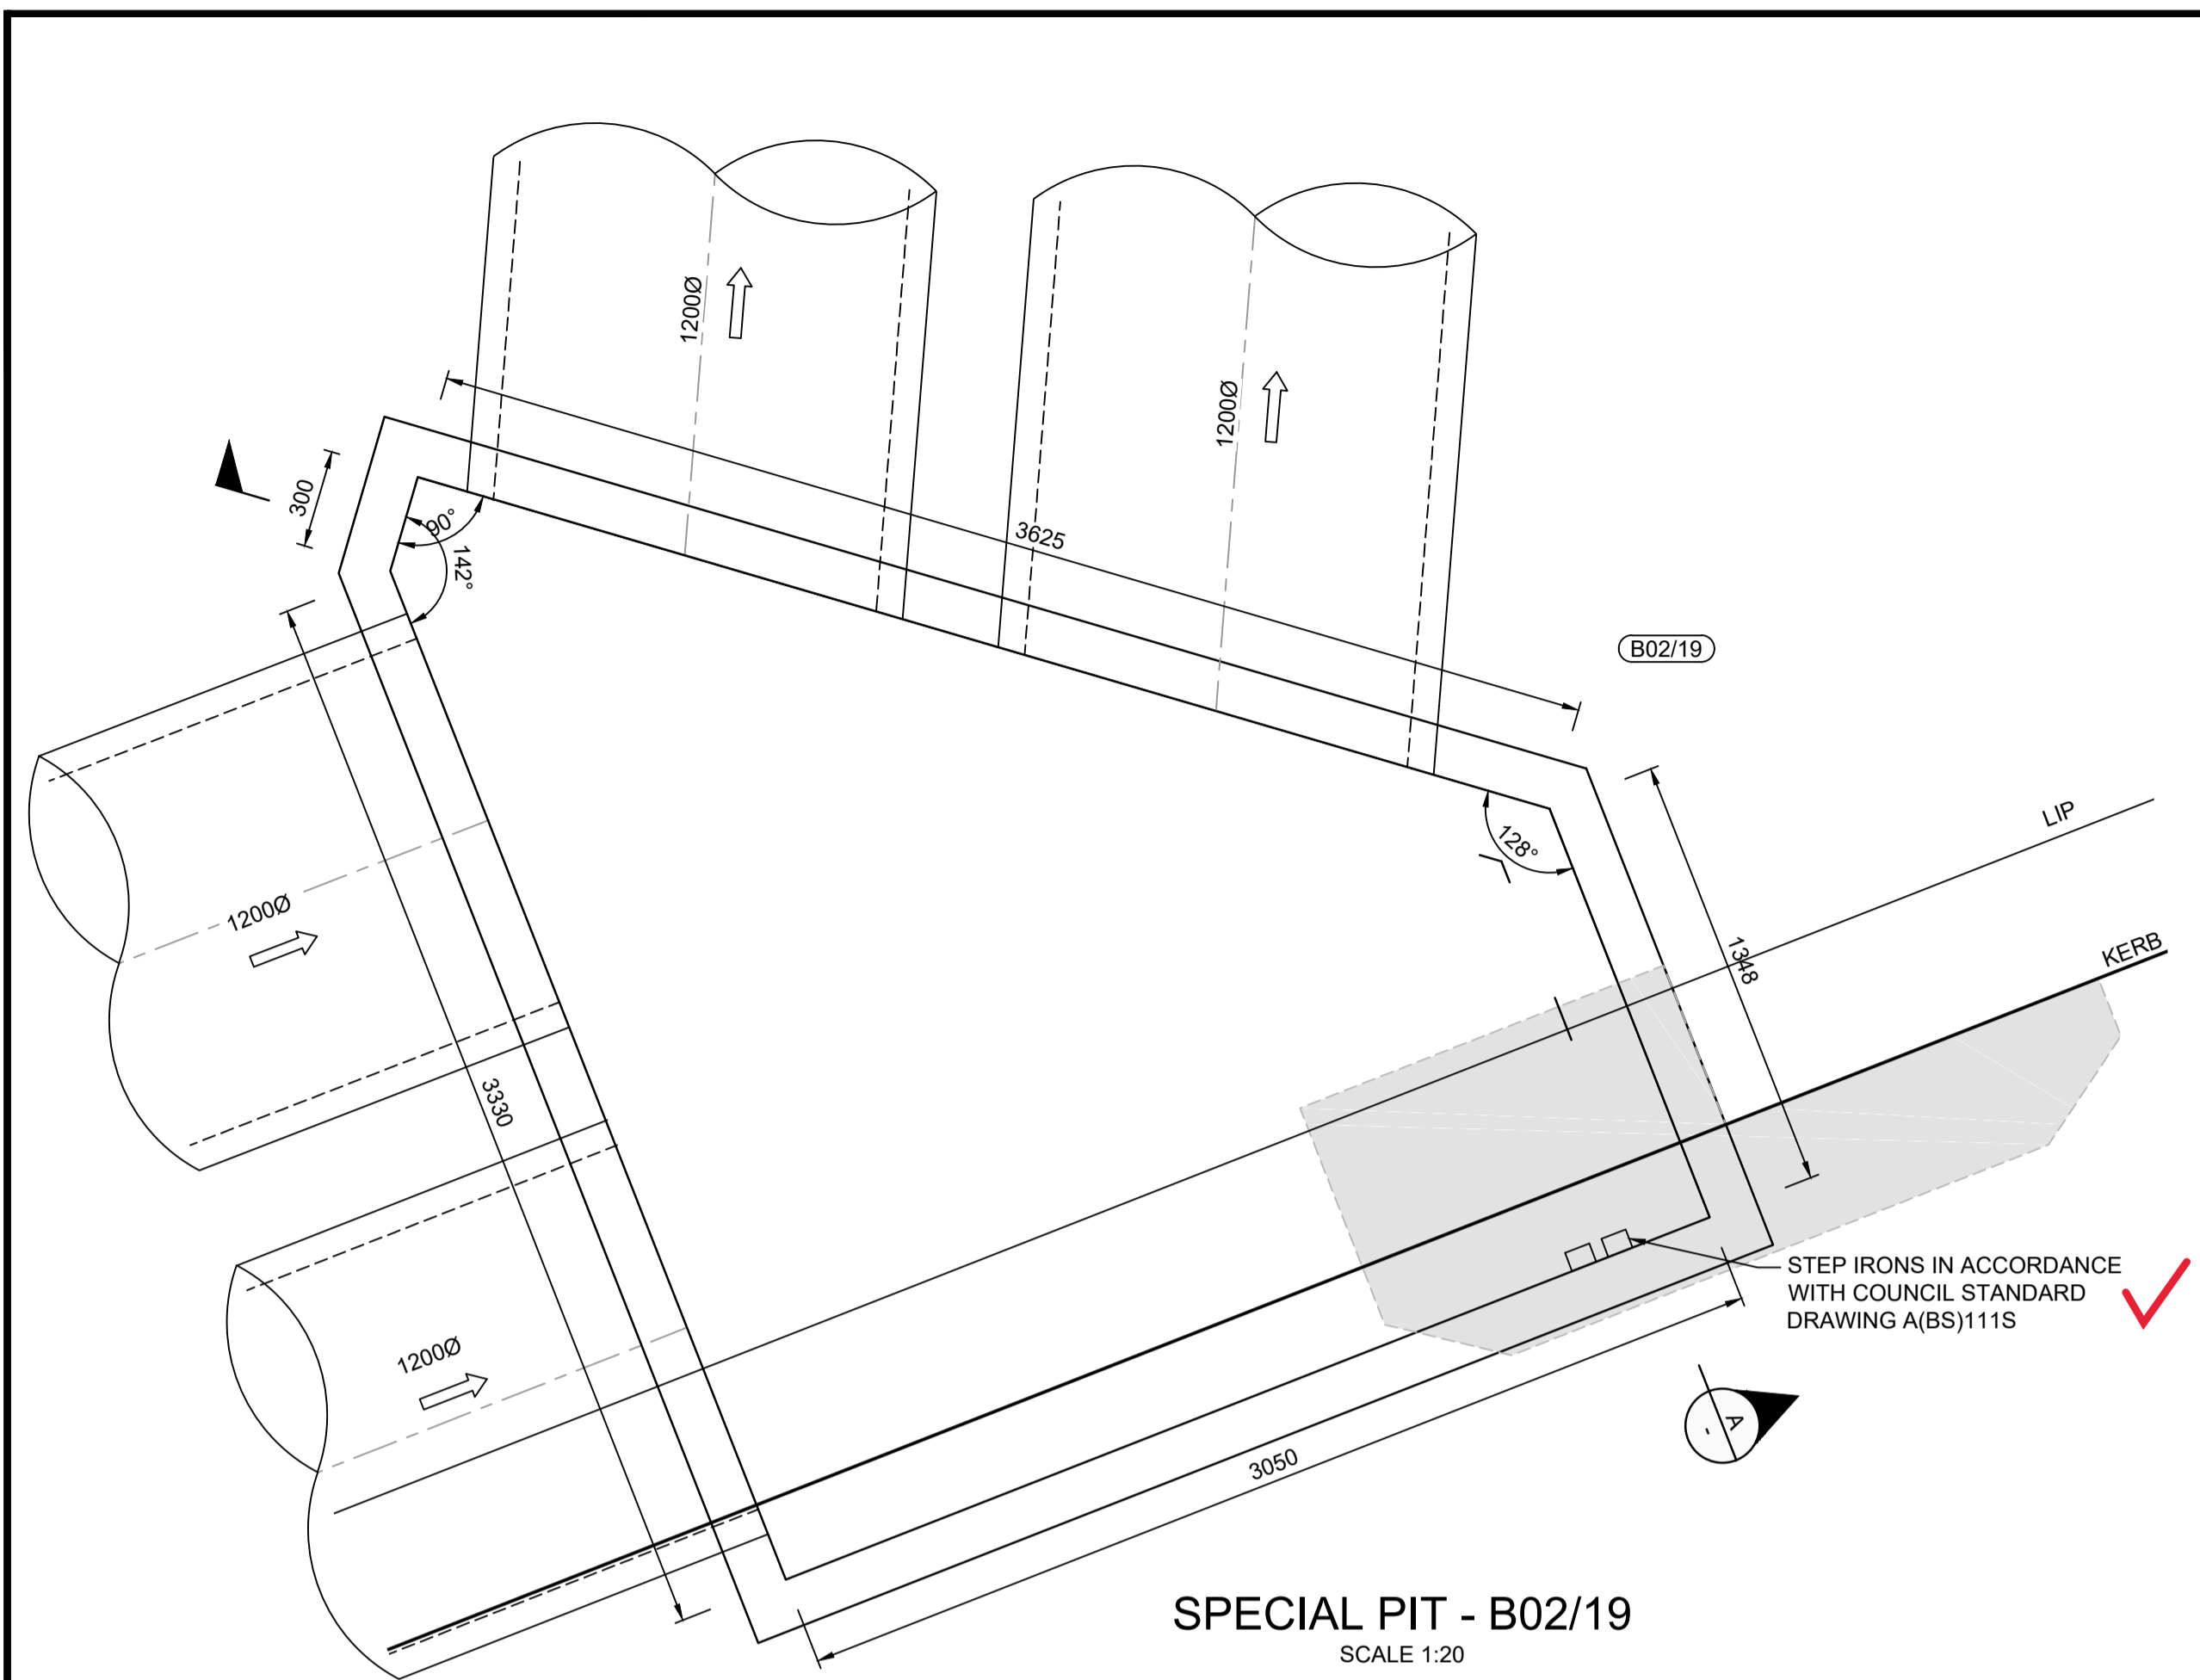


I hereby certify that engineering works shown on this plan have been constructed generally in accordance with Construction Certificate 16635 issued by Land Development Certificates

Signature: *PR*
PETER ROBERT WARWICK
 Registered Land Surveyor
 VINCE MORGAN SURVEYORS PTY LTD

DATE 20/12/2022 REF 20260-7

These plans are referred to in certificate no. 16635 approved by:
Christopher Louis Wahbe
 Registered Certifier
 Registration No: BDC 3015
 Categories: Certifier - Subdivision
Land Development Certificates
 www.LDC.com.au

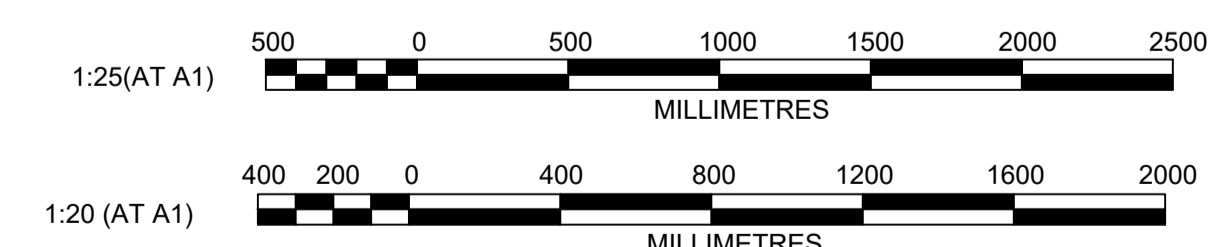

Plotted: 14 September, 2021 1:05:28 PM File Name: J:\9985\DJCC - Construction Certificate Approval Plans\K12 WESTERN PRECINCTS\5 - Precinct 7\9985-12-CC5554.dwg

NO.	DESCRIPTION	DES	DRN	CKD	APR	DATE
A	ISSUE FOR APPROVAL	DG	JM	MP	PJM	12/08/21
	AMENDMENT					

J. WYNDHAM PRINCE
 CONSULTING CIVIL INFRASTRUCTURE ENGINEERS & PROJECT MANAGERS
 PO Box 4366 PENRITH WESTFIELD NSW 2750
 P 02 4720 3300 W www.jwprince.com.au E jwp@jwprince.com.au


CLIENT:
WINTEN PROPERTY GROUP

STATUS:
ISSUE FOR CONSTRUCTION APPROVAL
 THIS DRAWING MUST NOT BE USED FOR CONSTRUCTION UNLESS SIGNED AS PART OF AN APPROVED CONSTRUCTION CERTIFICATE.


NEWPARK PRECINCT 7, STAGE 7B
 SPECIAL PIT DETAILS
 SHEET 5

AZIMUTH: M.G.A.94 DATUM: A.H.D. ORIGIN: SSM 1112 PLAN No: 9985-12-CC5554


PROJECT No:
9985-12
 SHEET No:
CC5554

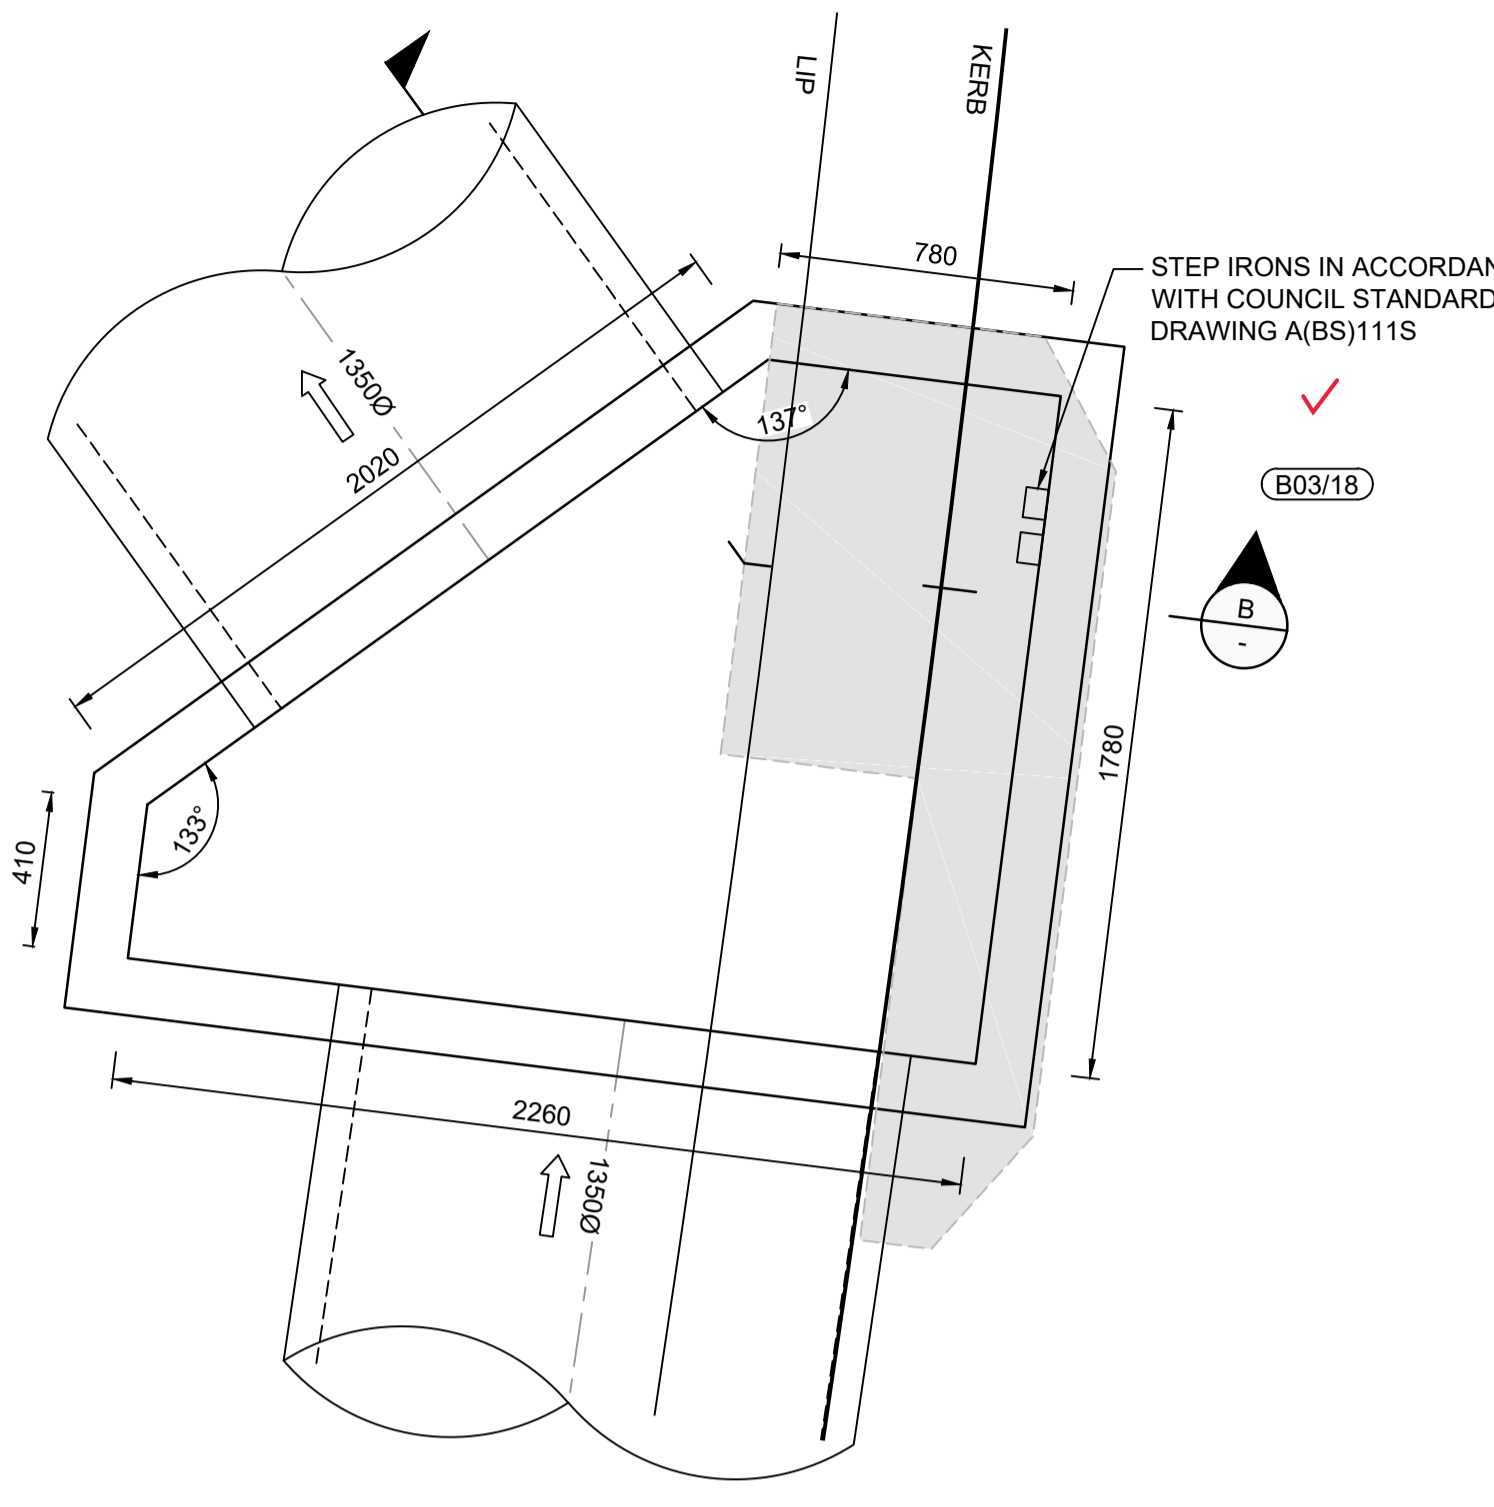


SPECIAL PIT - B03/18
SCALE 1:20

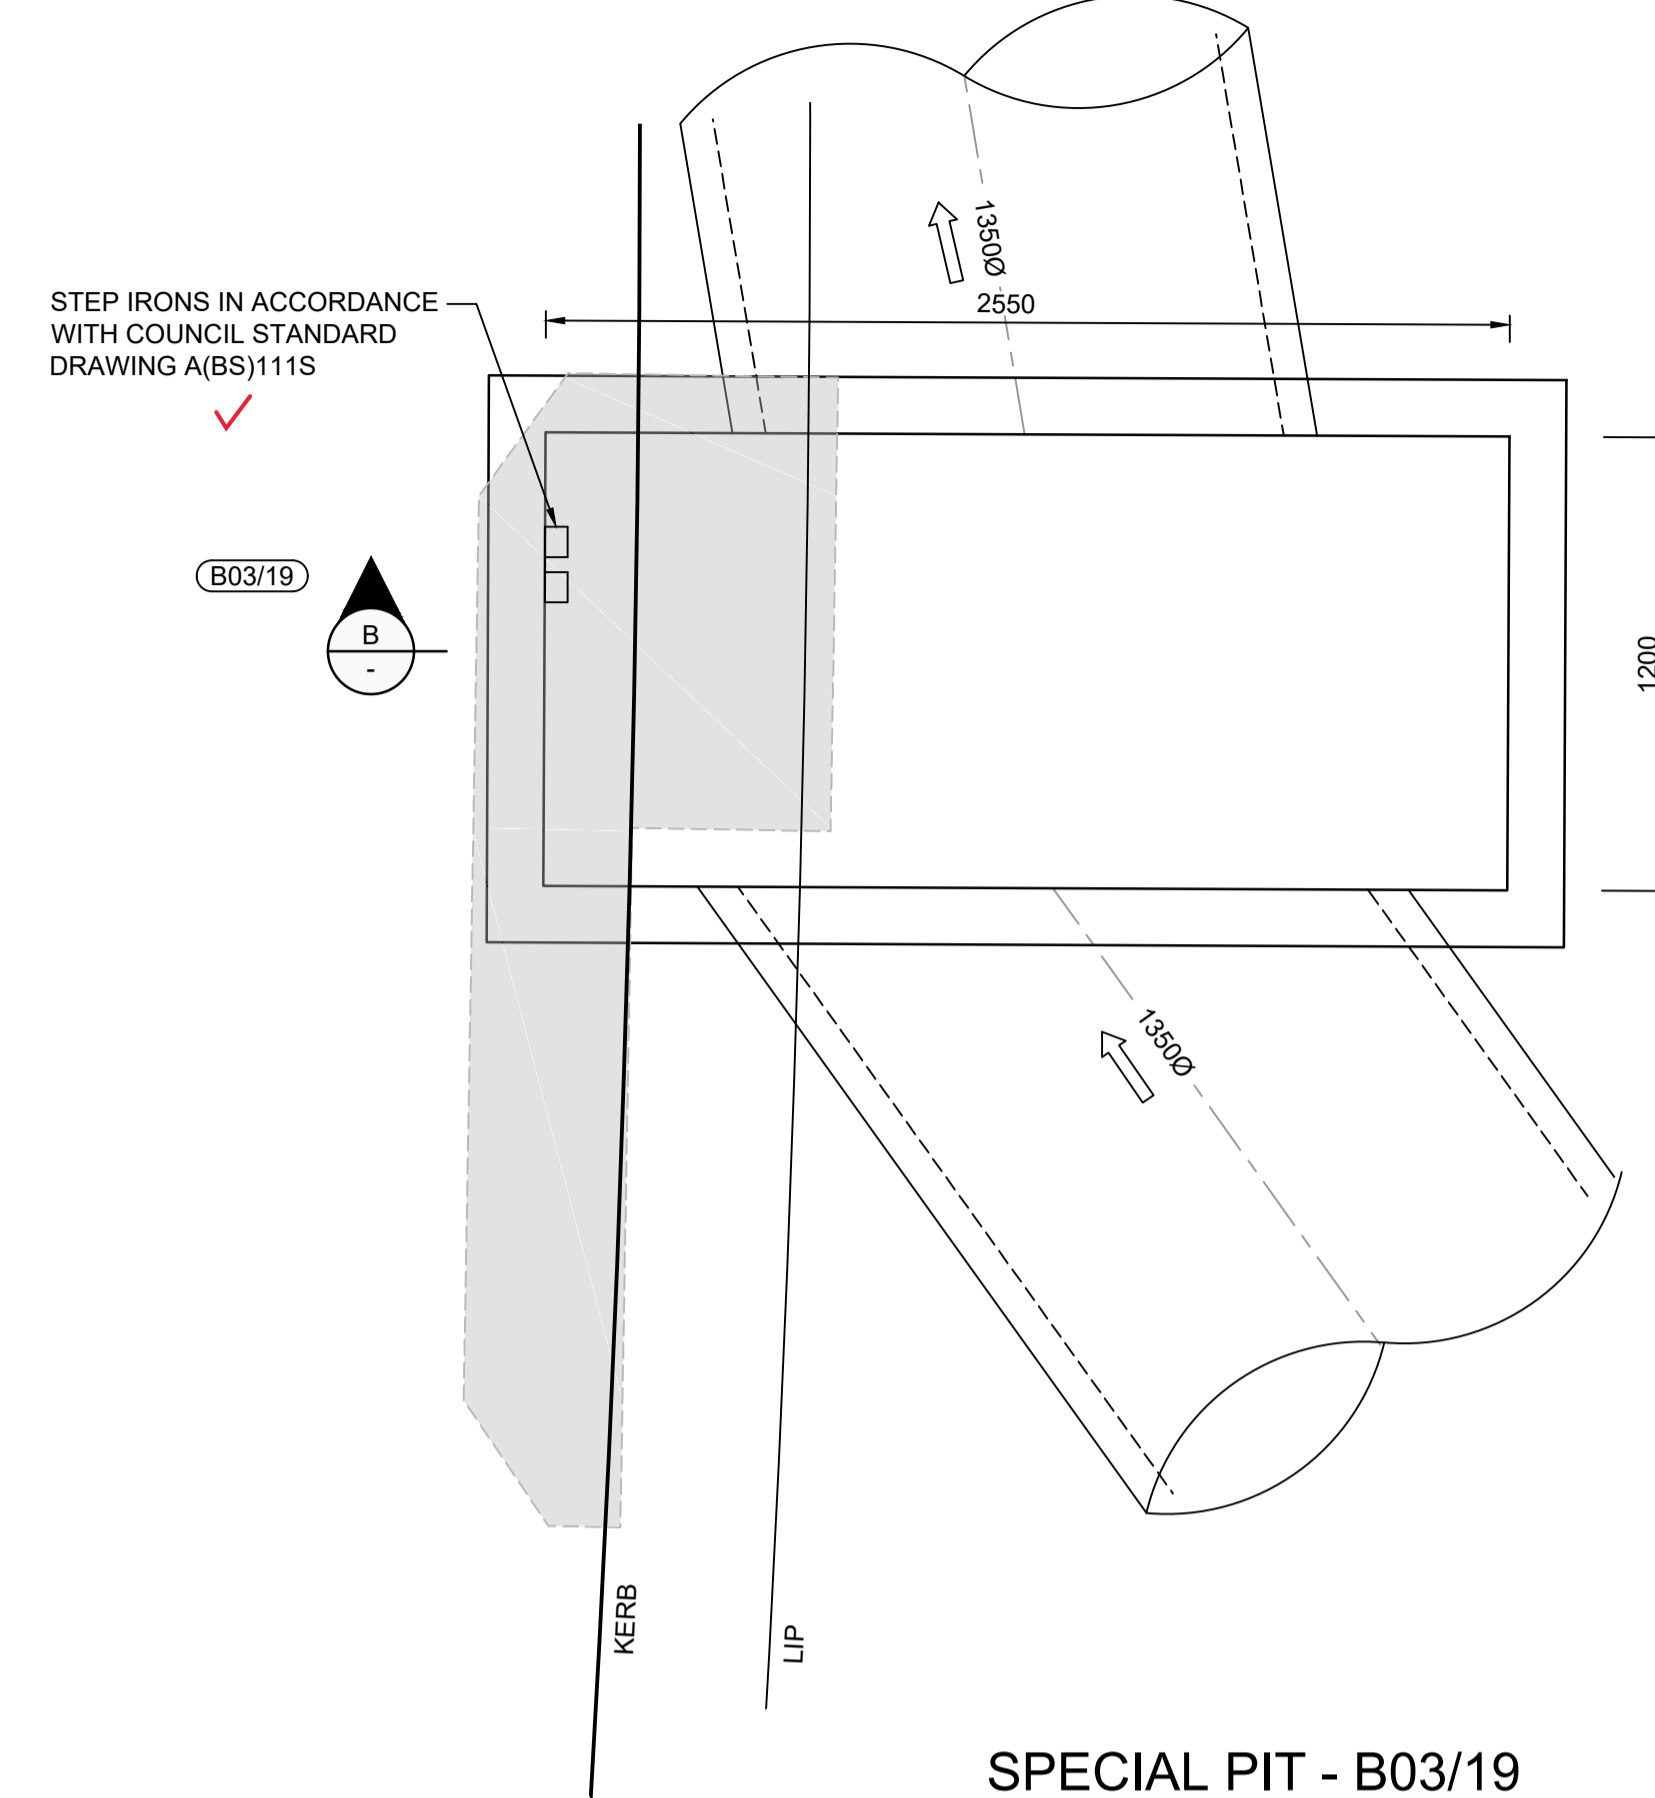


SPECIAL PIT - B03/19
SCALE 1:20

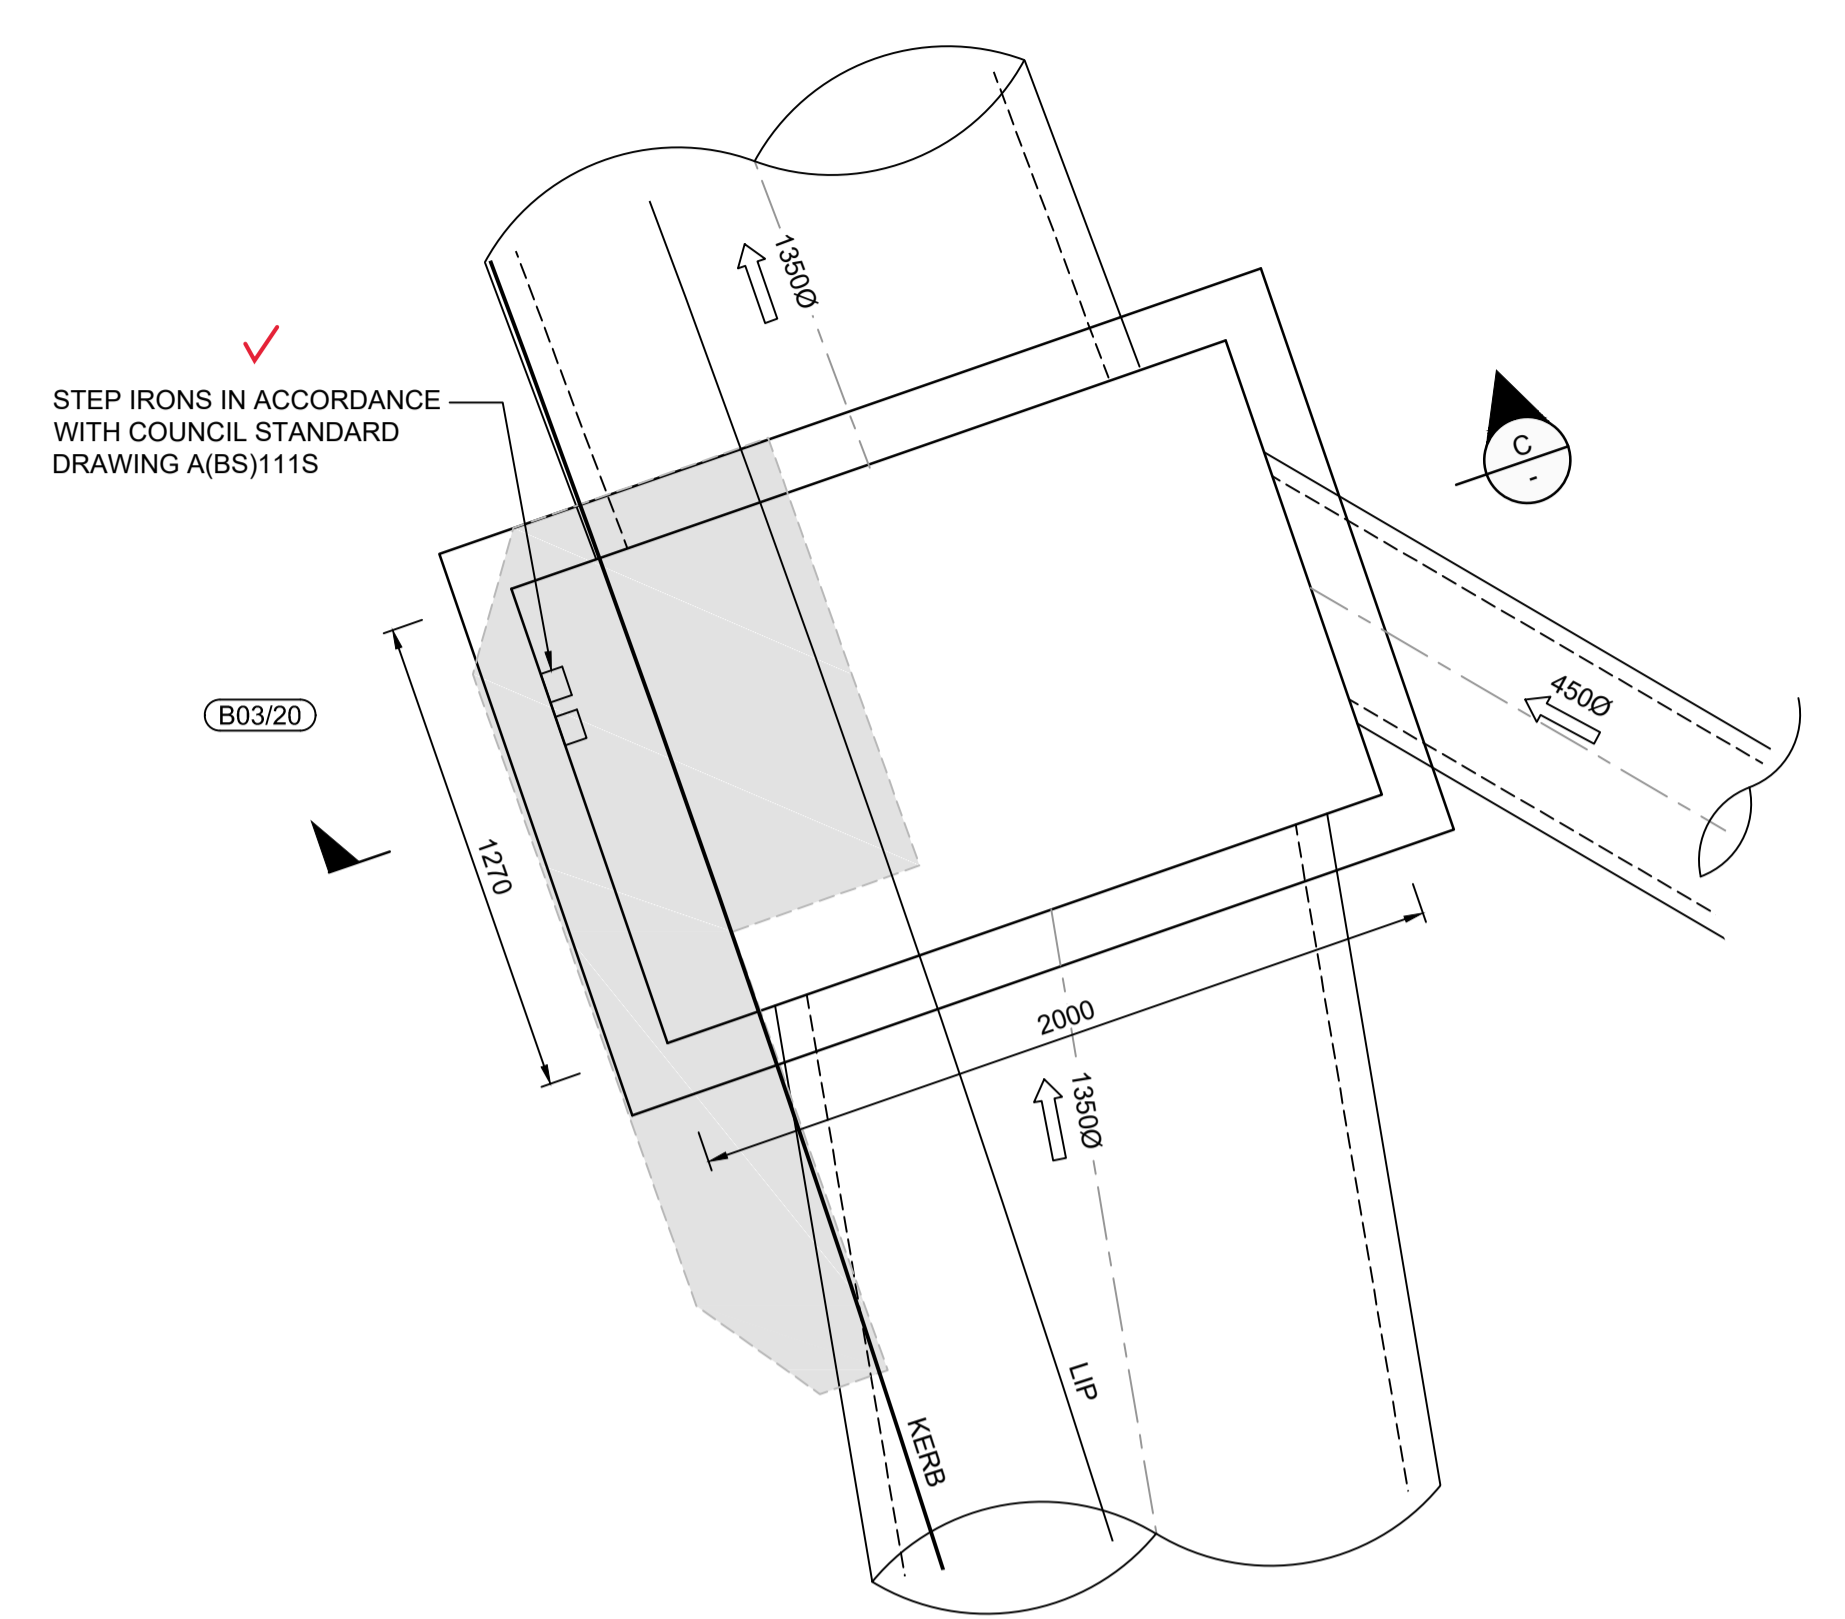

SPECIAL PIT - B03/20
SCALE 1:20

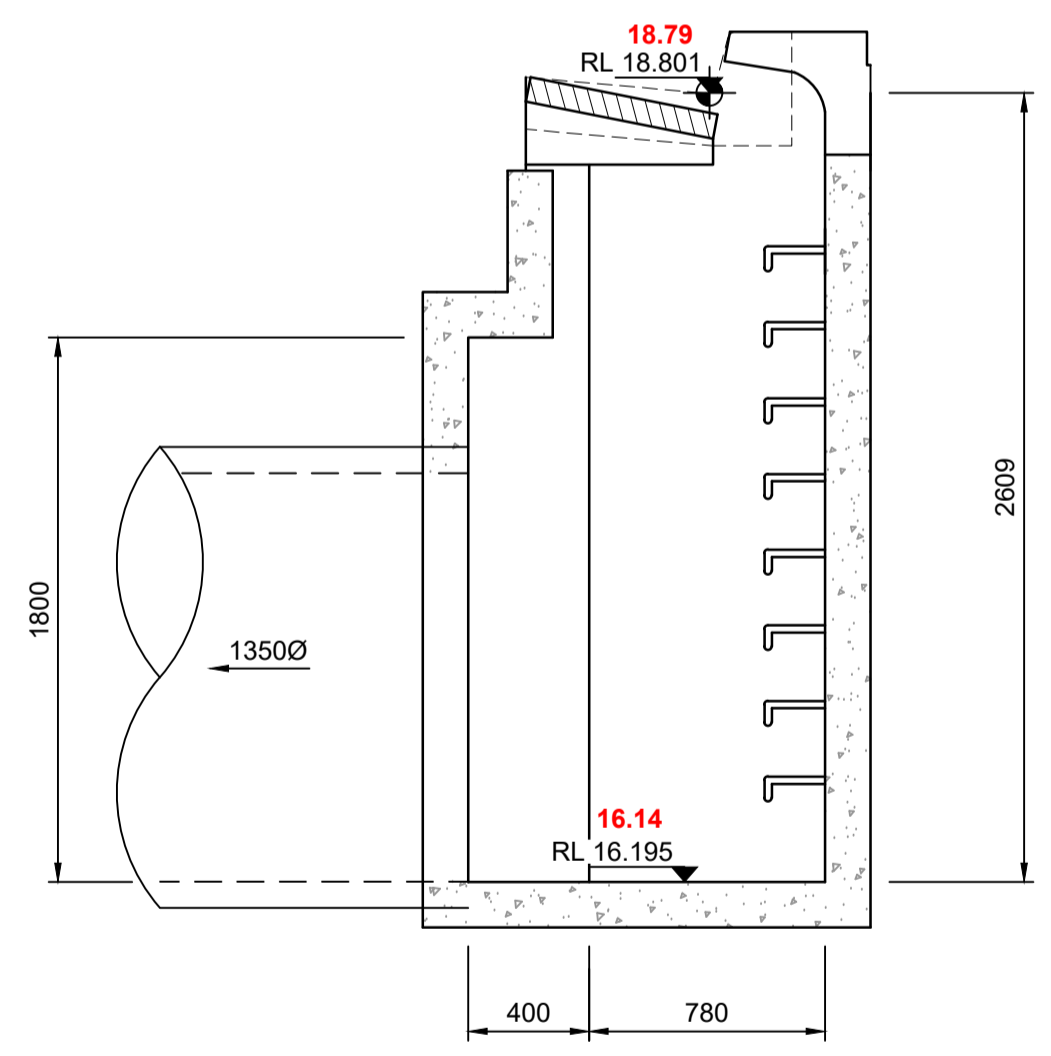

SECTION A
SCALE 1:25

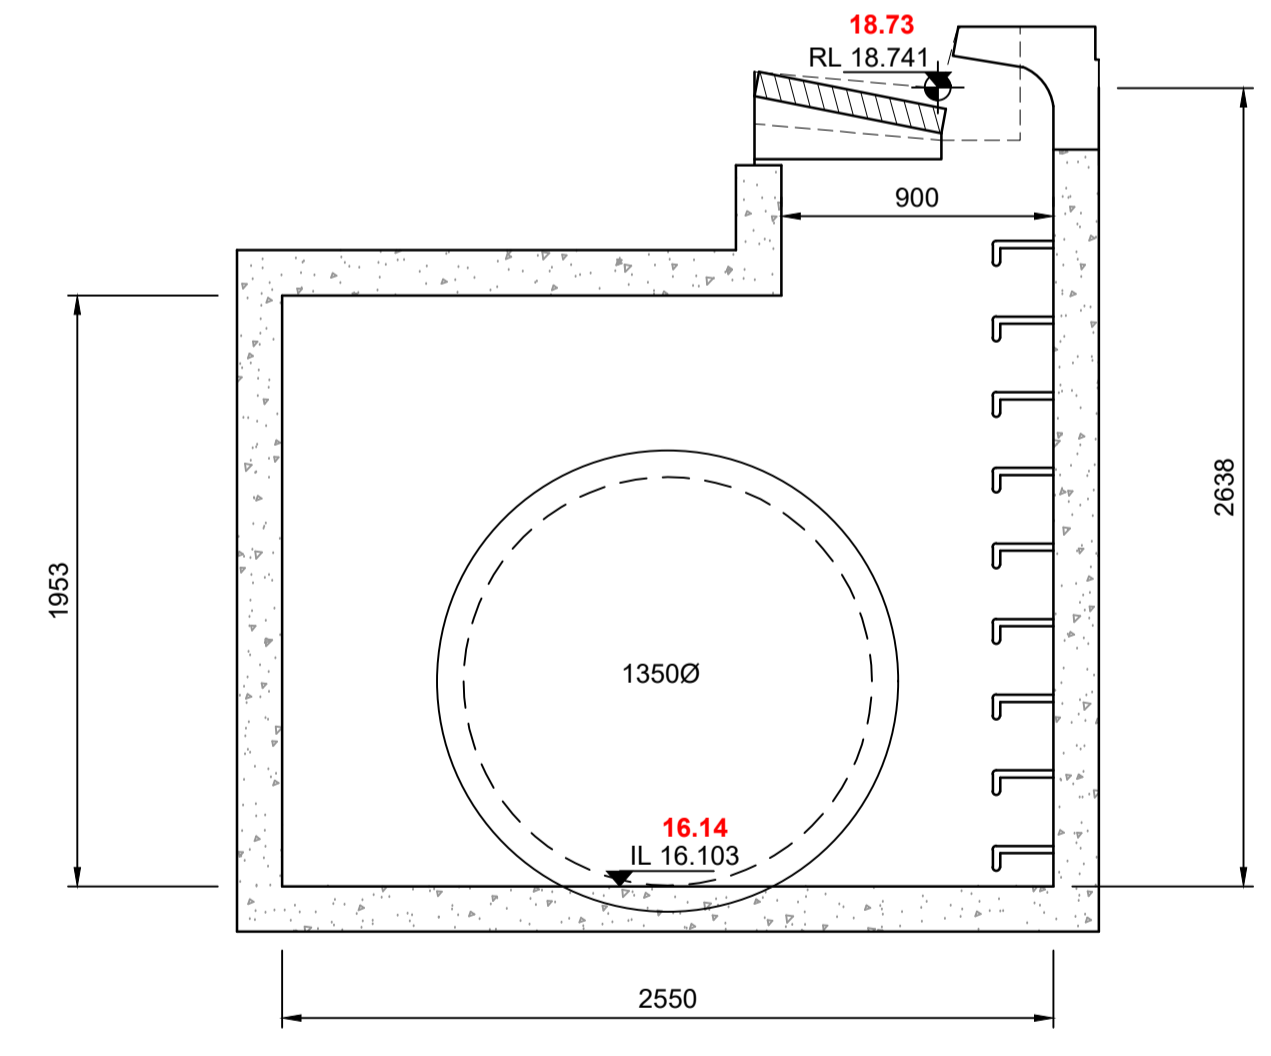


SECTION B
SCALE 1:25

I hereby certify that engineering works shown on this plan have been constructed generally in accordance with Construction Certificate 16635 issued by Land Development Certificates

Signature: *PR*
PETER ROBERT WARWICK
 Registered Land Surveyor
VINCE MORGAN SURVEYORS PTY LTD

DATE 20/12/2022 REF 20260-7

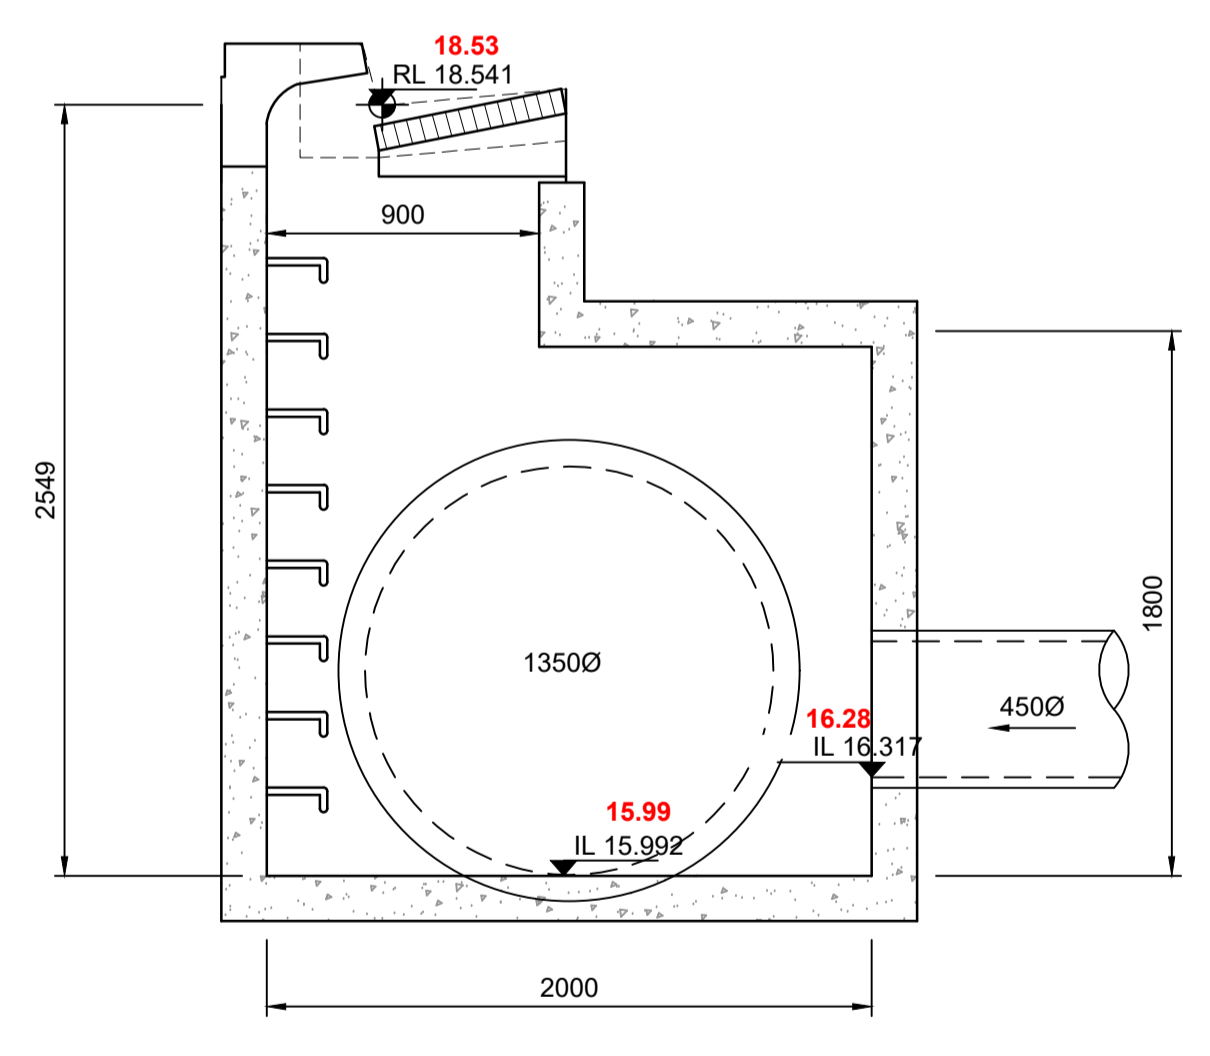


SECTION C
SCALE 1:25

These plans are referred to in certificate no. 16635 approved by:

LDC Christopher Louis Wahbe
 Registered Certifier
 Registration No: BDC 3015
 Categories: Certifier - Subdivision

Land Development Certificates
www.LDC.com.au

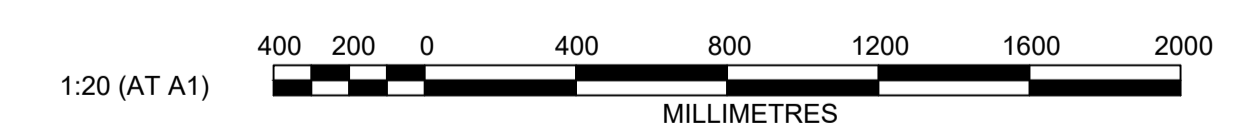

Plotted: 14 September, 2021 1:06:43 PM File Name: J:\9985\BDC - Construction Certificate Approval Plans\PK12 WESTERN PRECINCTS16 - Precinct 7\9985-12-CC5555.dwg

A	ISSUE FOR APPROVAL	DG	JM	MP	PJM
	AMENDMENT	DES	DRN	CKD	APR
					DATE

J. WYNDHAM PRINCE
 CONSULTING CIVIL INFRASTRUCTURE ENGINEERS & PROJECT MANAGERS

PO Box 4366 PENRITH WESTFIELD NSW 2750
 P 02 4720 3300 W www.jwprince.com.au E jwp@jwprince.com.au

CLIENT:

WINTEN PROPERTY GROUP

STATUS: **ISSUE FOR CONSTRUCTION APPROVAL**

THIS DRAWING MUST NOT BE USED FOR CONSTRUCTION UNLESS SIGNED AS PART OF AN APPROVED CONSTRUCTION CERTIFICATE.


NEWPARK PRECINCT 7, STAGE 7B
 SPECIAL PIT DETAILS
 SHEET 6

PROJECT No: **9985-12**
 SHEET No: **CC5555**


AZIMUTH: M.G.A.94 DATUM: A.H.D. ORIGIN: SSM 1112 PLAN No: **9985-12-CC5555**

A

Plotted: 14 September, 2021 1:07:56 PM File Name: J:\9985\BDC - Construction Certificate Approval Plans\K12 WESTERN PRECINCTS\6 - Precinct 7\9985-12-CC5556.dwg

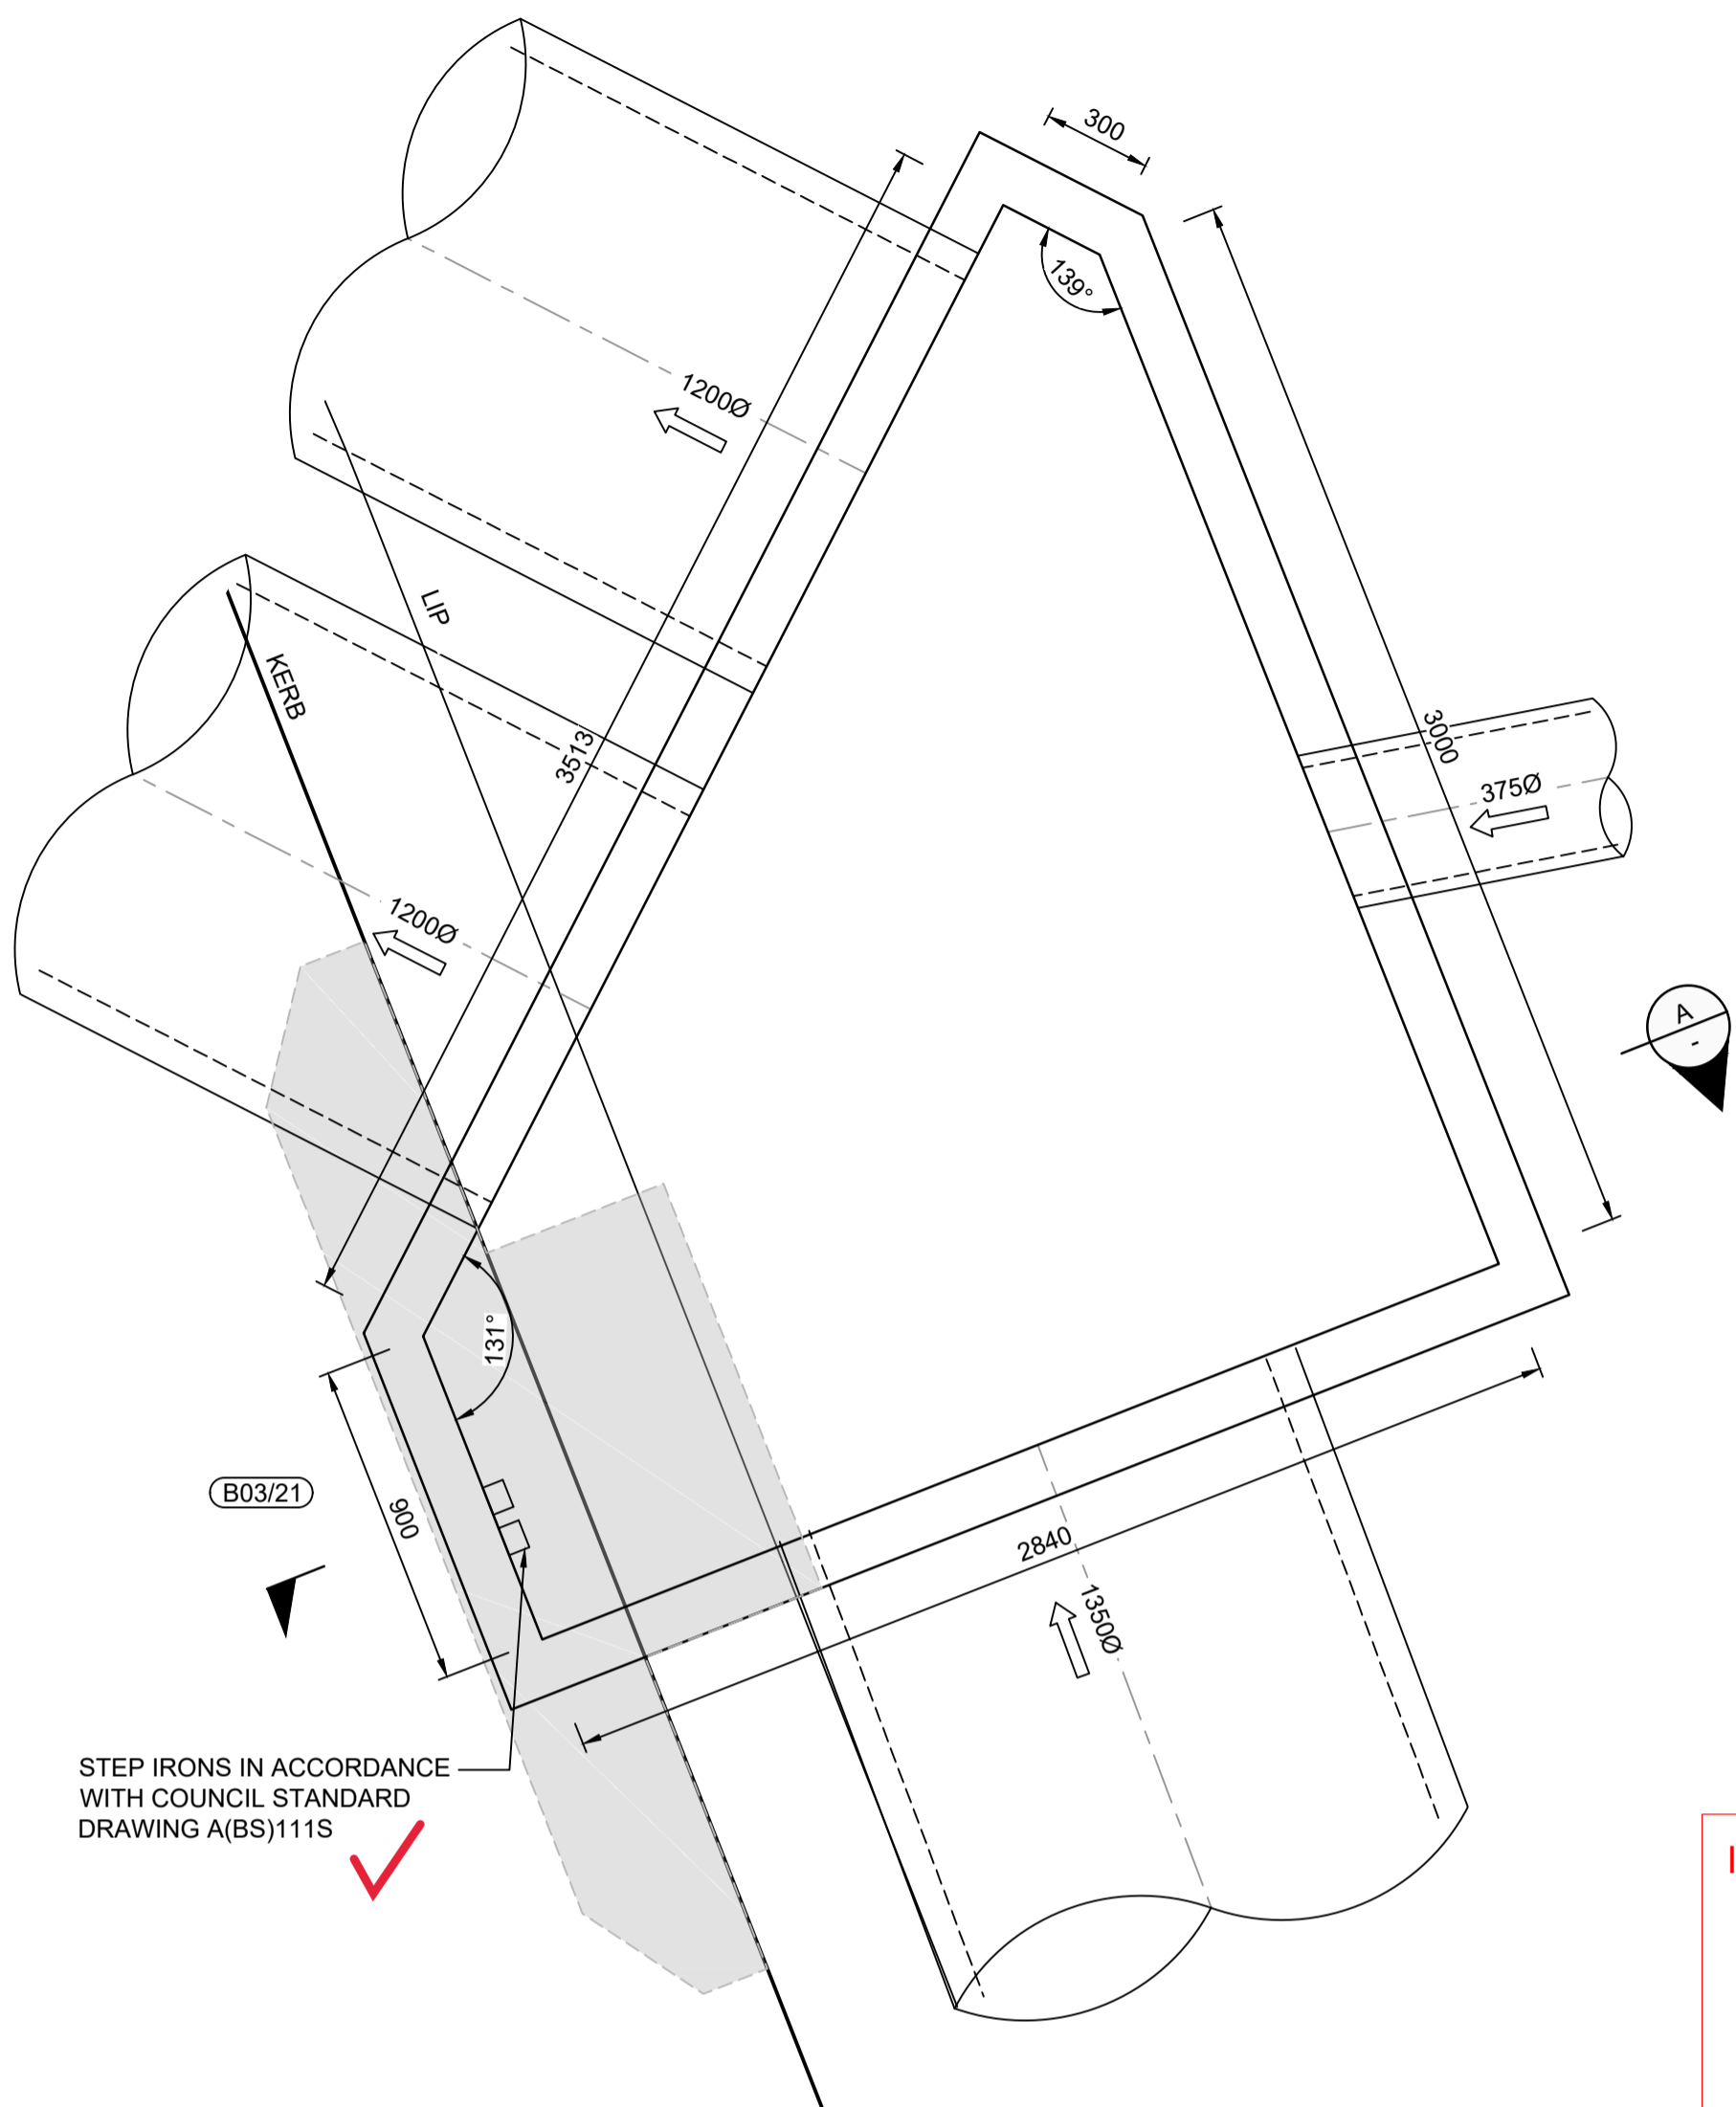

SPECIAL PIT - B03/21
SCALE 1:20

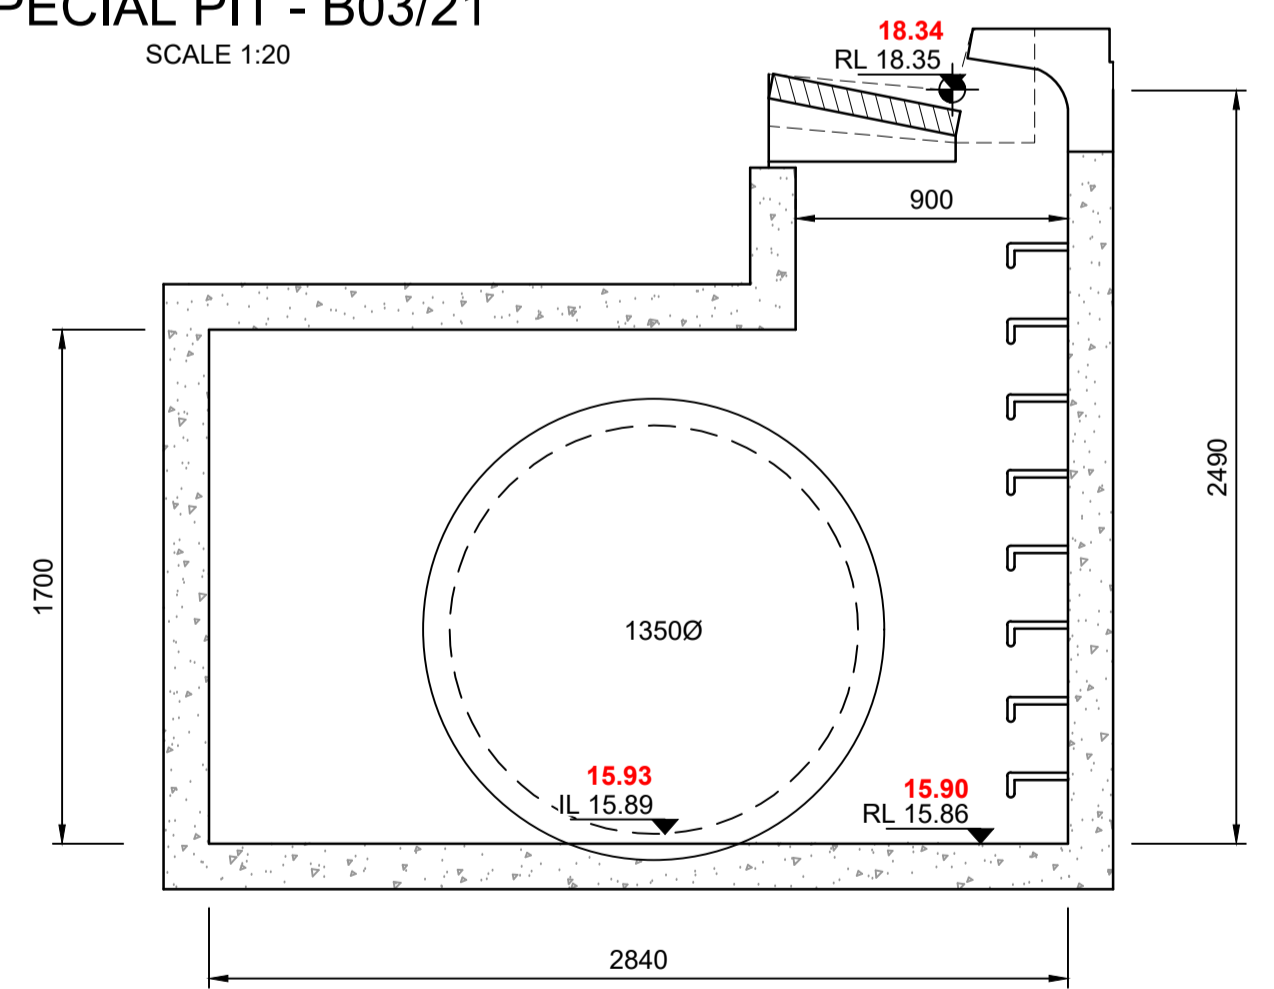


SECTION A
SCALE 1:25

I hereby certify that engineering works shown on this plan have been constructed generally in accordance with Construction Certificate 16635 issued by Land Development Certificates


Signature: *PRW*
PETER ROBERT WARWICK
 Registered Land Surveyor
VINCE MORGAN SURVEYORS PTY LTD

DATE 20/12/2022 REF 20260-7

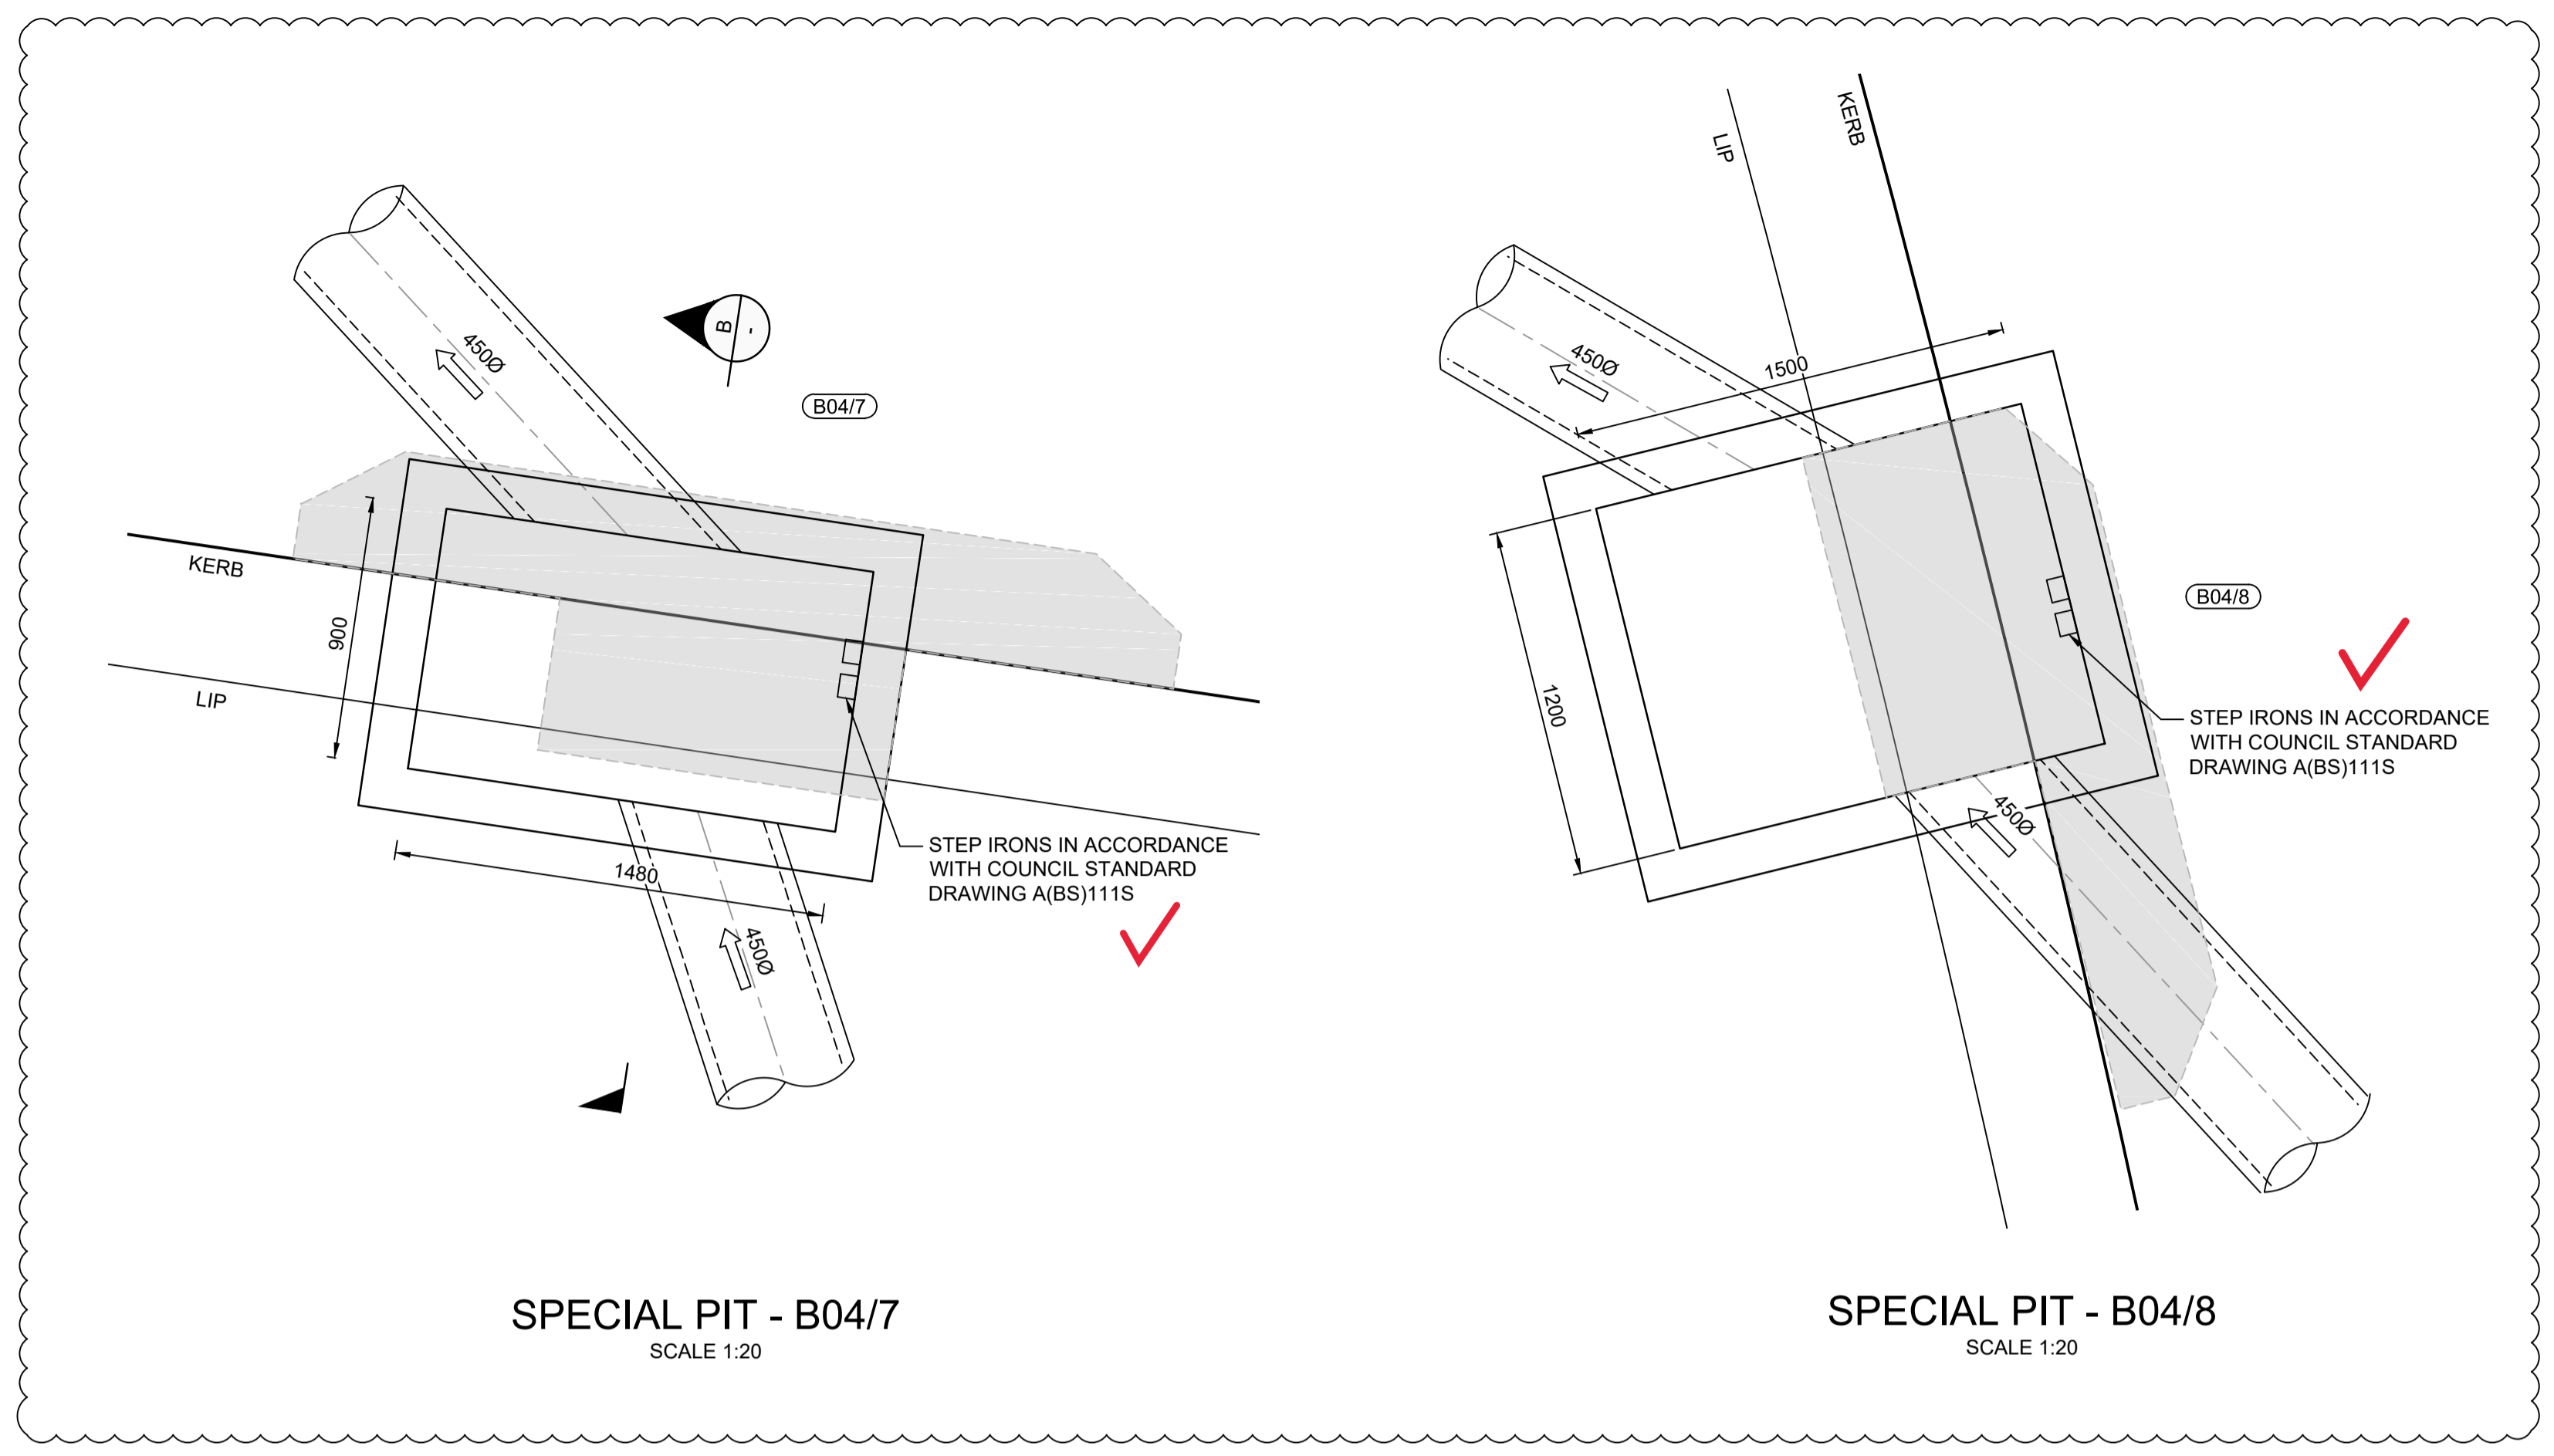


SPECIAL PIT - B04/7
SCALE 1:20

SPECIAL PIT - B04/8
SCALE 1:20

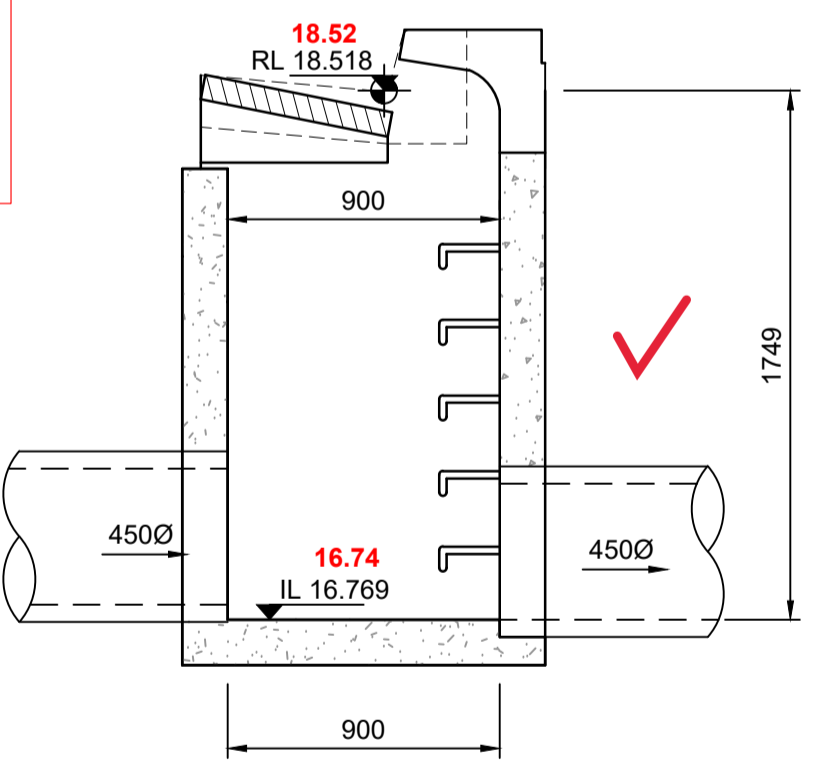

SECTION B
SCALE 1:25

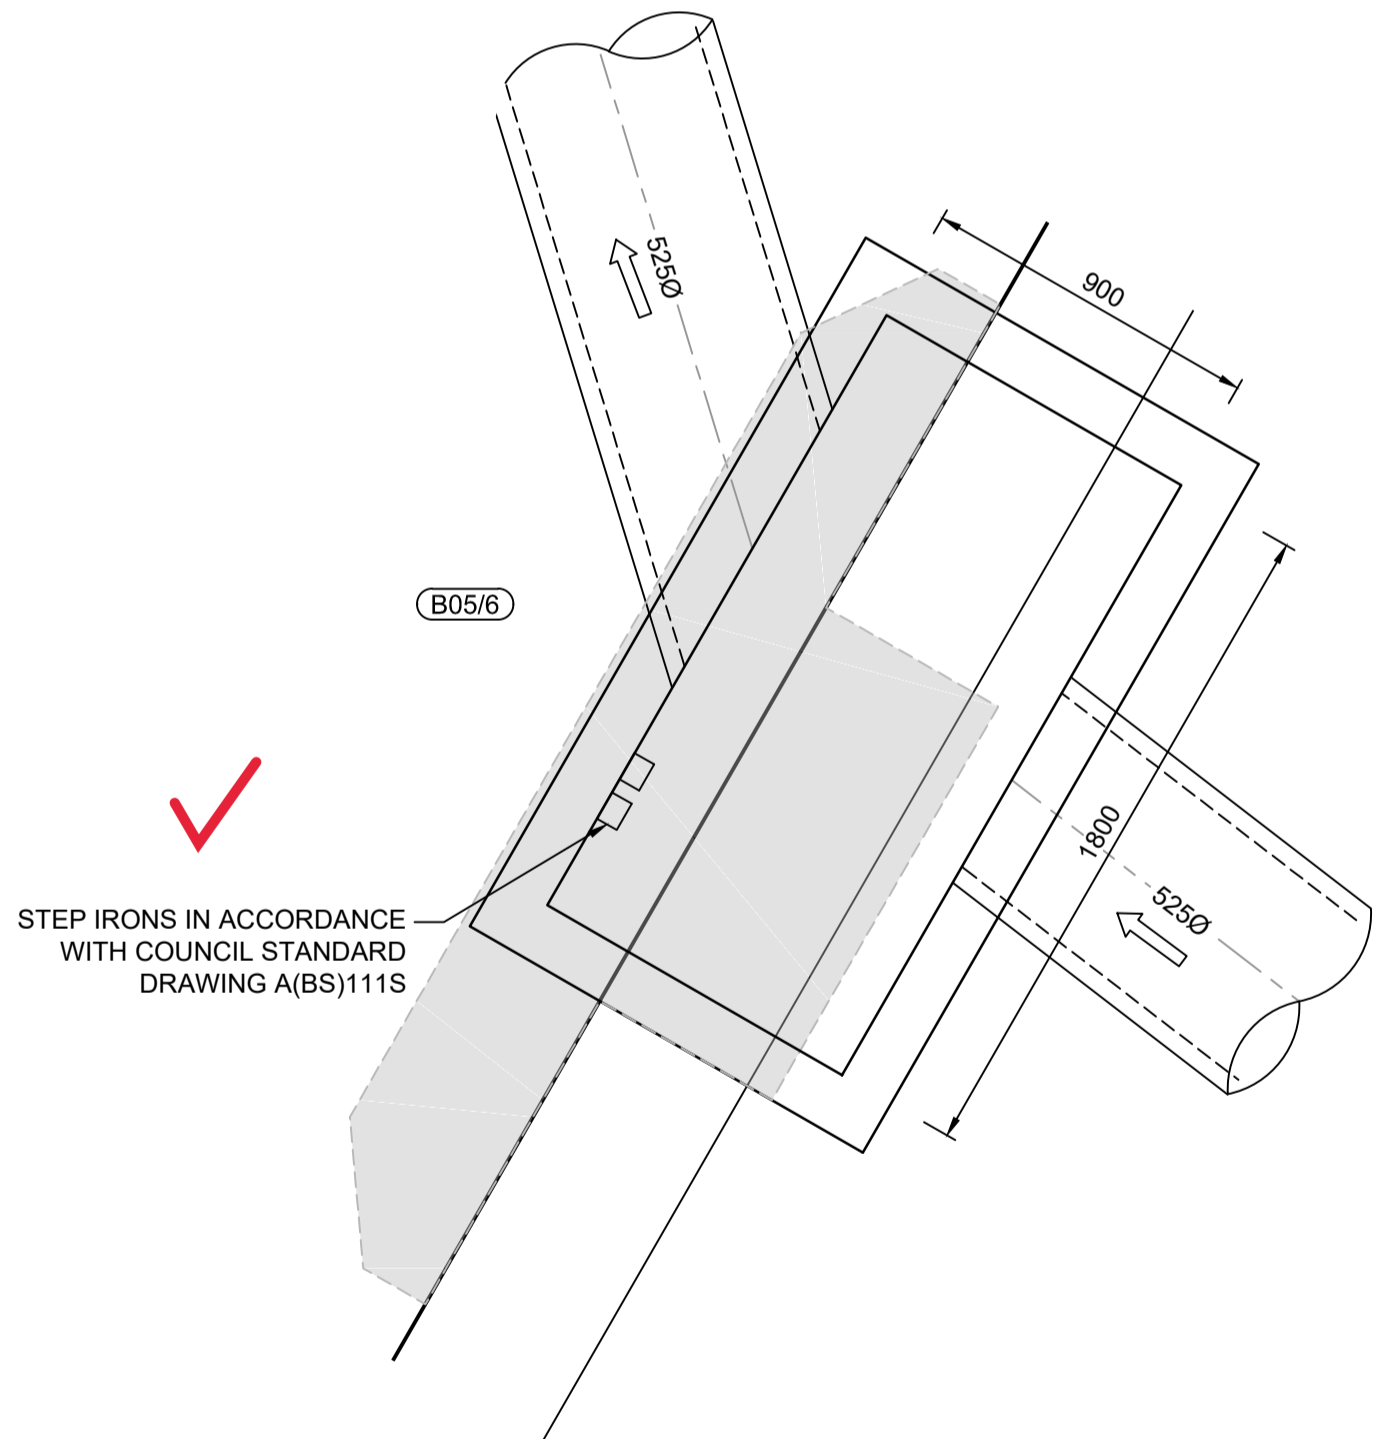


SPECIAL PIT - B05/6
SCALE 1:20

These plans are referred to in certificate no. 16635 approved by:

Christopher Louis Wahbe
 Registered Certifier
 Registration No: BDC 3015
 Categories: Certifier - Subdivision

Land Development Certificates
www.LDC.com.au

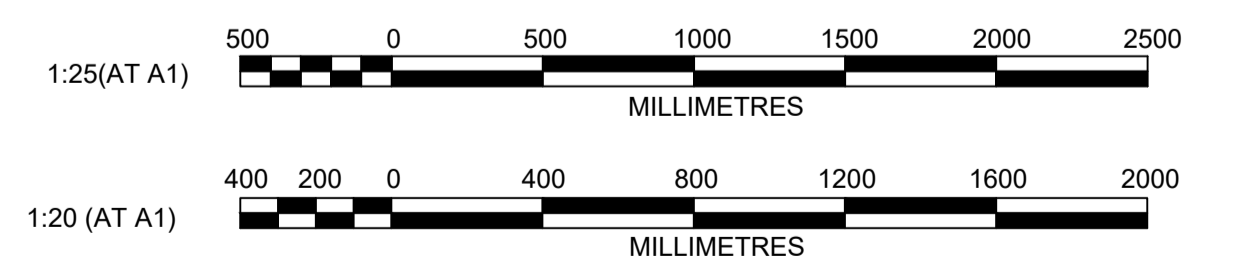

AMENDMENT	DES	DRN	CKD	APR	DATE
B	DG	JM	MP	MS	14/09/21
A	DG	JM	MP	PJM	12/08/21

J. WYNDHAM PRINCE
 CONSULTING CIVIL INFRASTRUCTURE ENGINEERS & PROJECT MANAGERS

PO Box 4366 PENRITH WESTFIELD NSW 2750
 P 02 4720 3300 W www.jwprince.com.au E jwp@jwprince.com.au

CLIENT:

WINTEN PROPERTY GROUP

STATUS: **ISSUE FOR CONSTRUCTION APPROVAL**

THIS DRAWING MUST NOT BE USED FOR CONSTRUCTION UNLESS SIGNED AS PART OF AN APPROVED CONSTRUCTION CERTIFICATE.

NEWPARK PRECINCT 7, STAGE 7B
 SPECIAL PIT DETAILS
 SHEET 7


PROJECT No: **9985-12**
 SHEET No: **CC5556**

AZIMUTH: M.G.A.94 DATUM: A.H.D. ORIGIN: SSM 1112 PLAN No: **9985-12-CC5556**


PROJECT No: **9985-12**
 SHEET No: **CC5556**

AZIMUTH: M.G.A.94 DATUM: A.H.D. ORIGIN: SSM 1112 PLAN No: **9985-12-CC5556**


Plotfile: 14 September, 2021 1:09:02 PM File Name: J:\9985\DC - Construction Certificate Approval Plans\PK12 WESTERN PRECINCTS\6 - Precinct 7\9985-12-CC5557.dwg

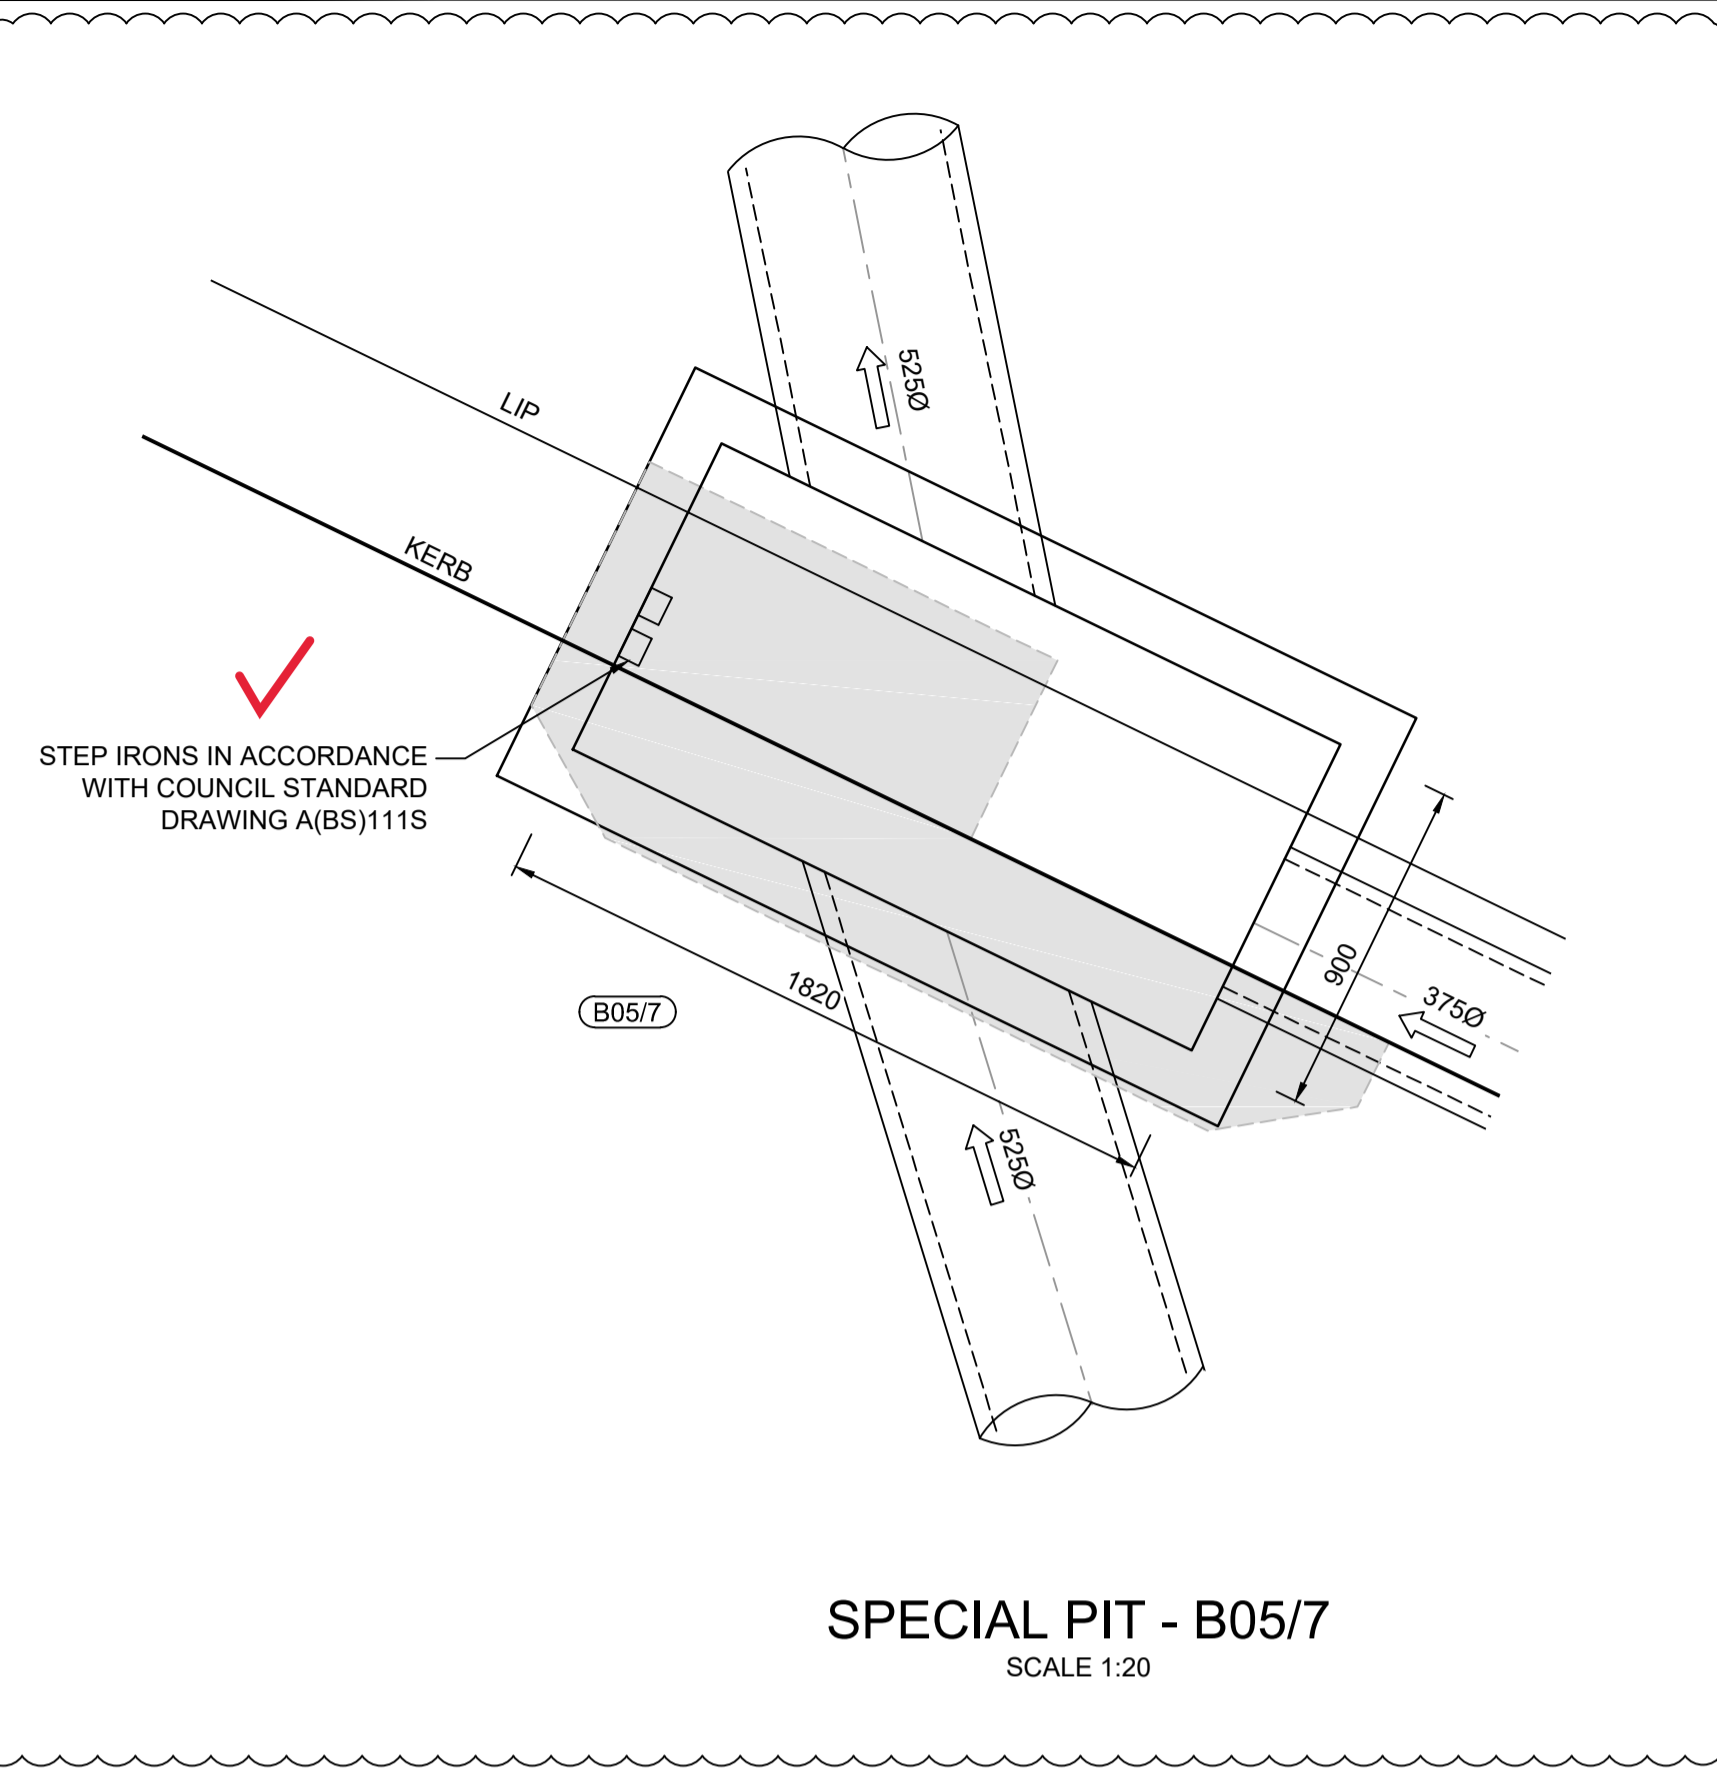


SPECIAL PIT - B05/7
SCALE 1:20

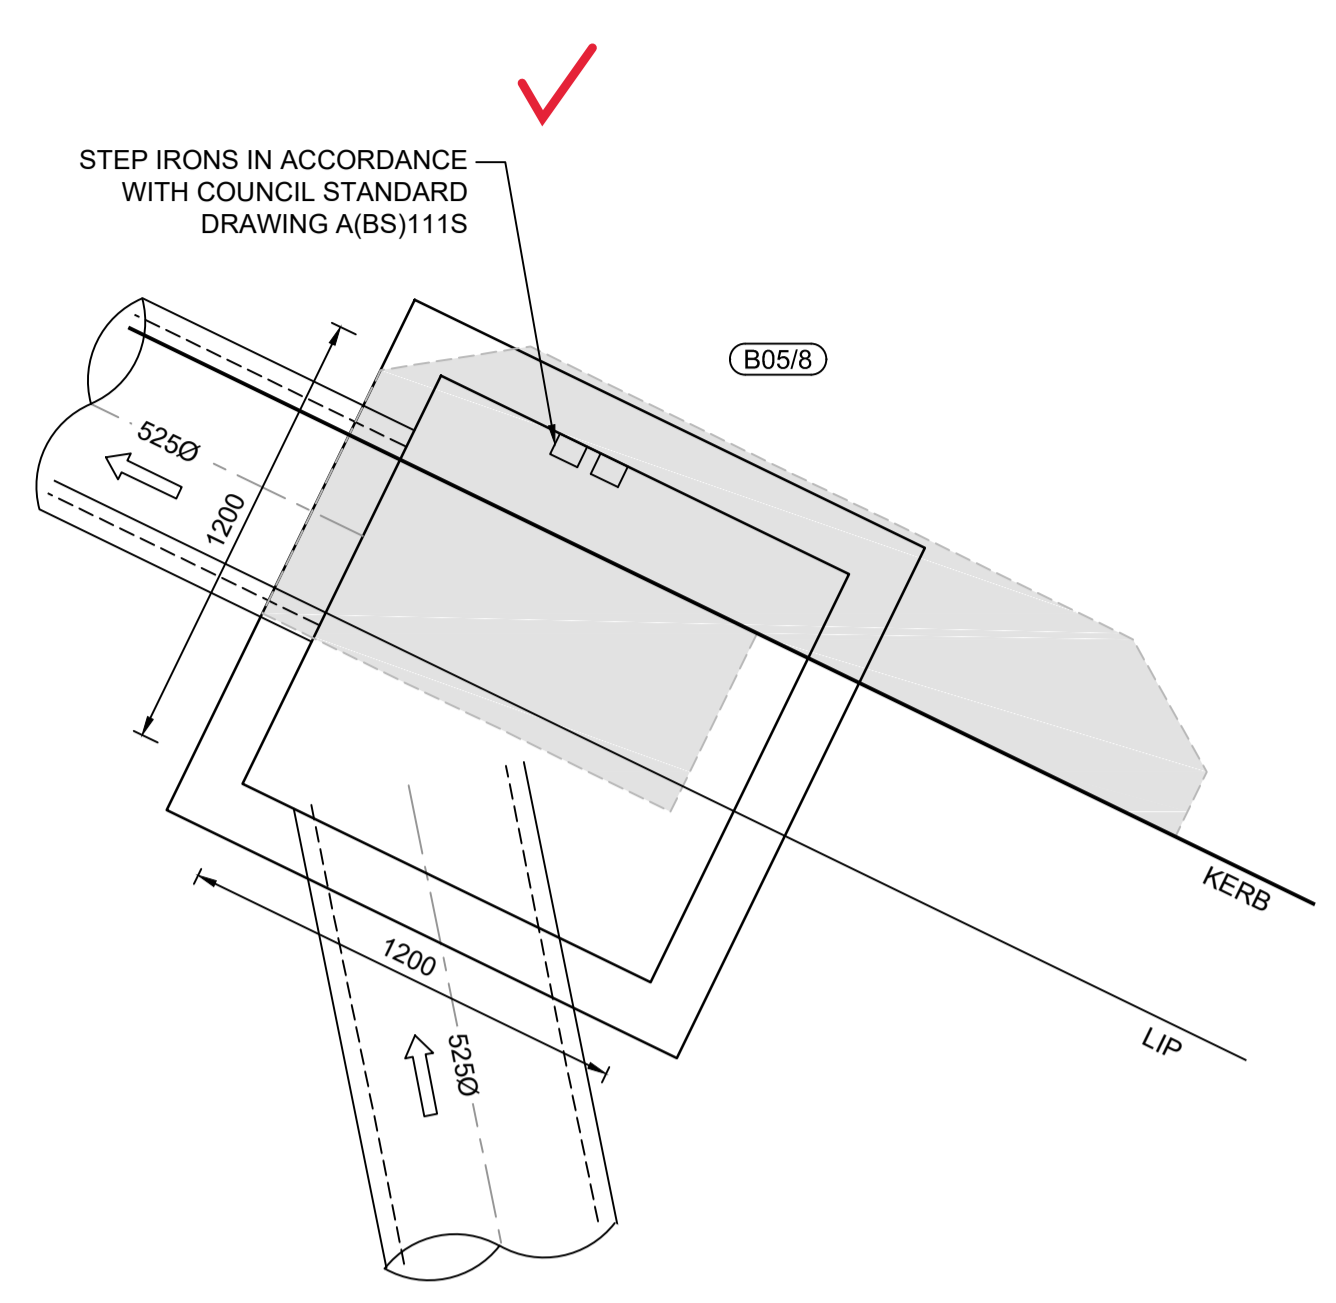

SPECIAL PIT - B05/8
SCALE 1:20

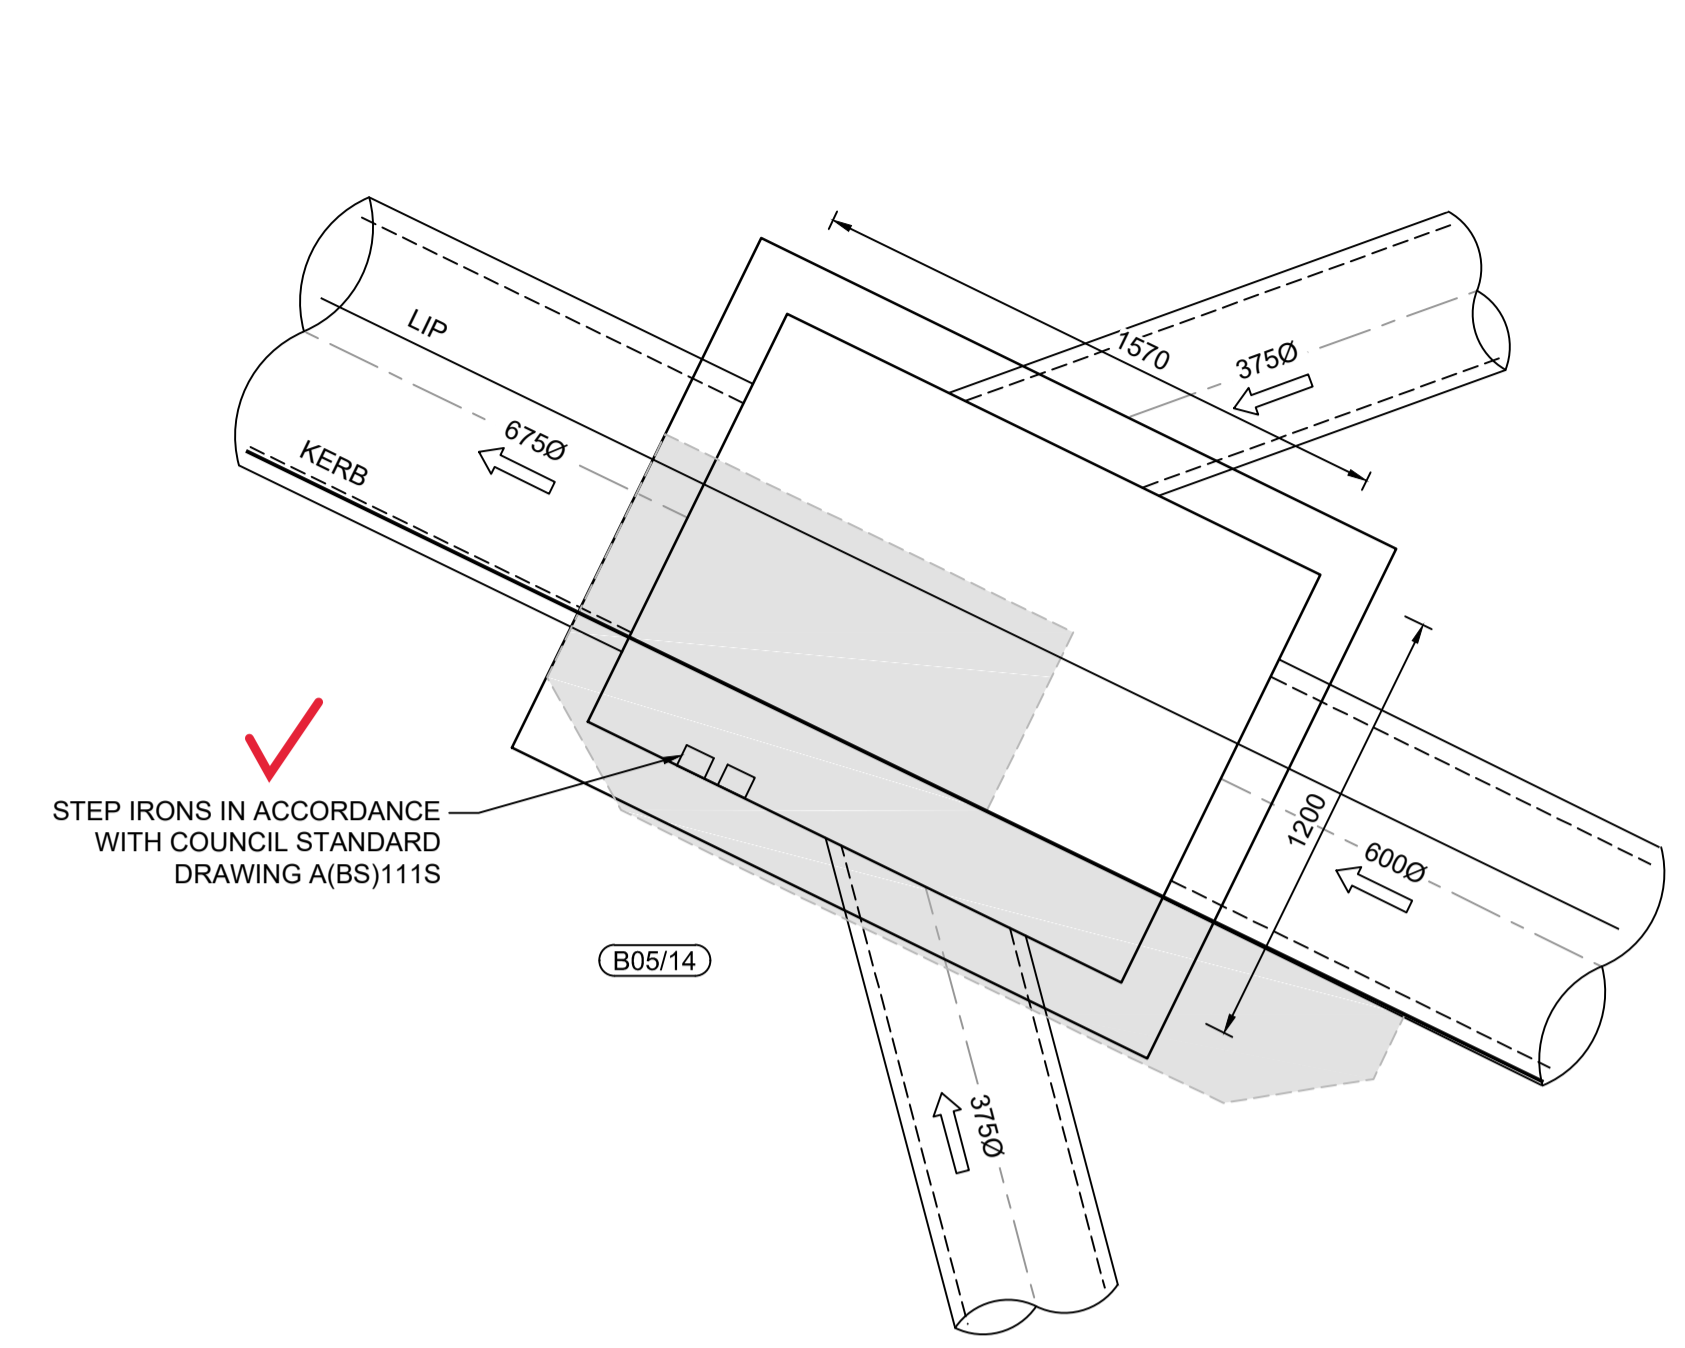

SPECIAL PIT - B05/14
SCALE 1:20

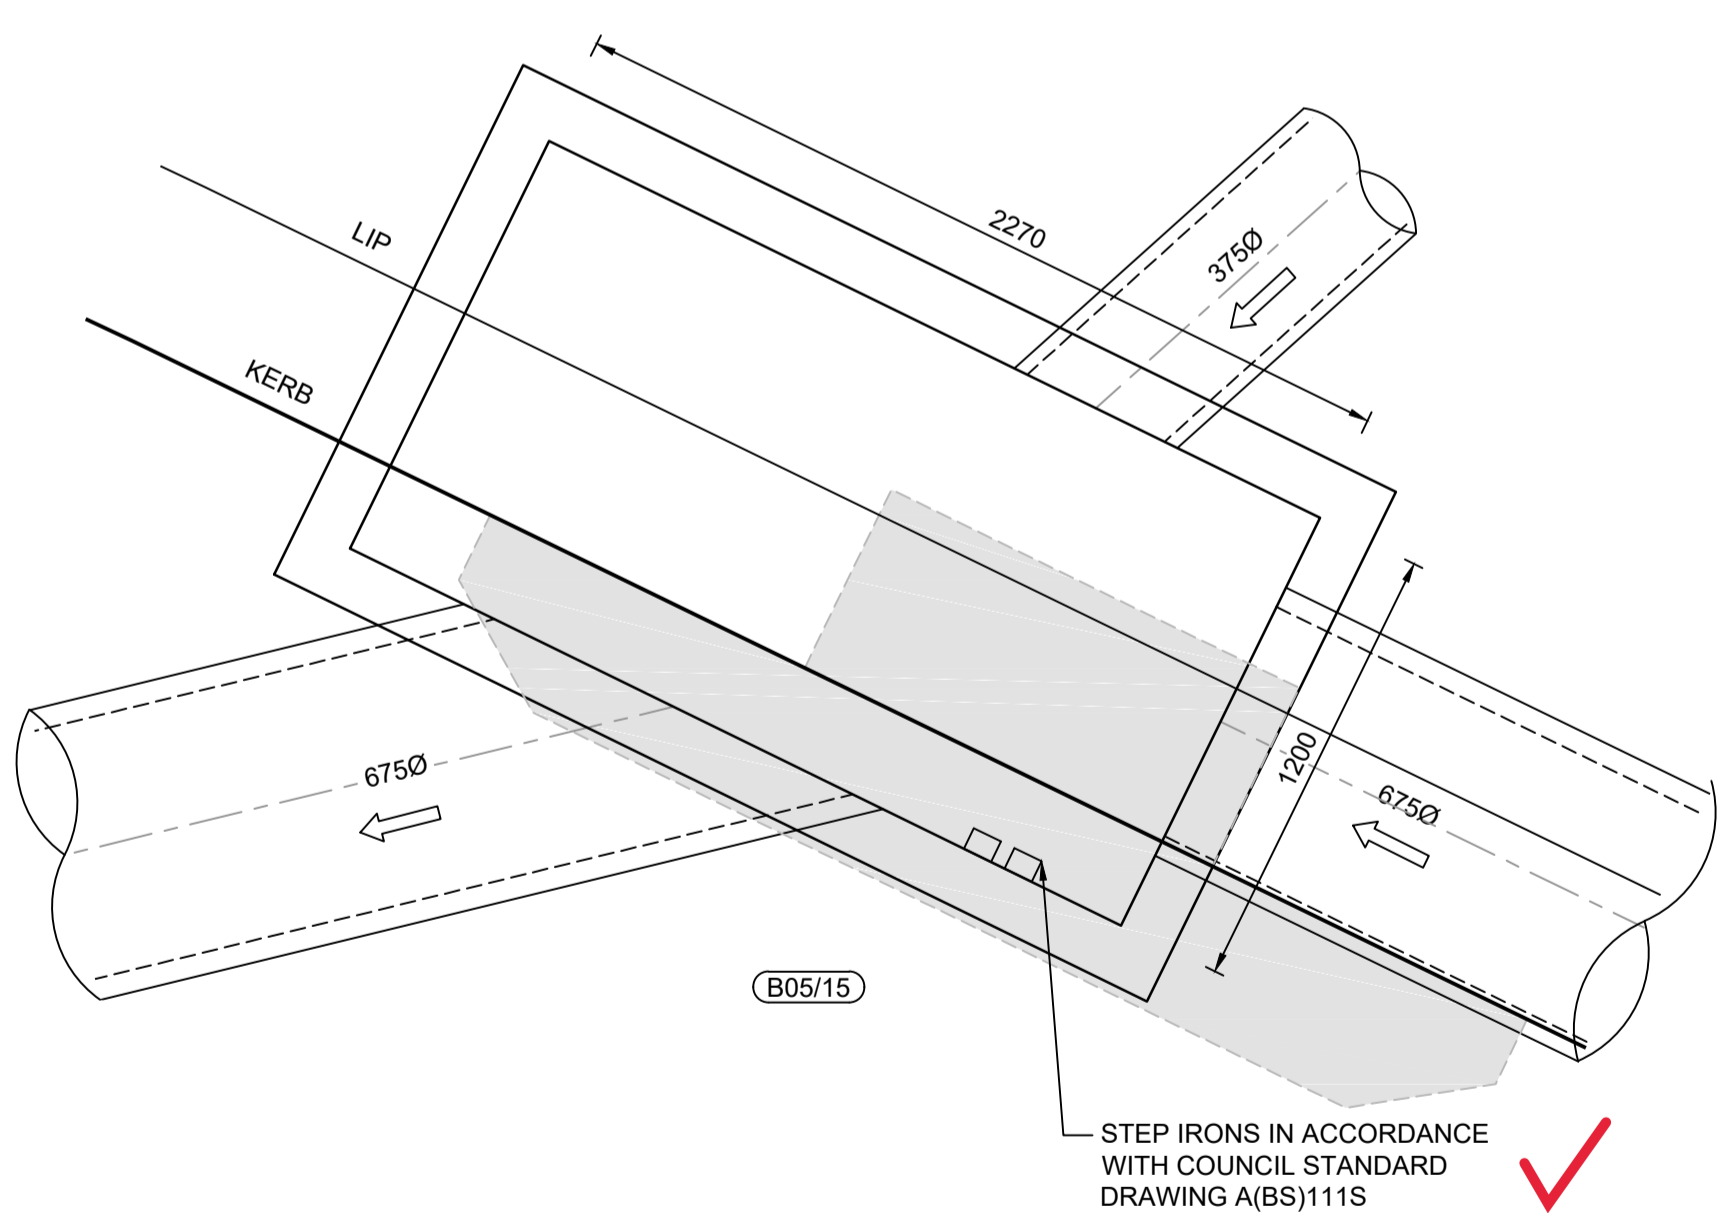

SPECIAL PIT - B05/15
SCALE 1:20

I hereby certify that engineering works shown on this plan have been constructed generally in accordance with Construction Certificate 16635 issued by Land Development Certificates


Signature: *PR*
PETER ROBERT WARWICK
 Registered Land Surveyor
VINCE MORGAN SURVEYORS PTY LTD

DATE 20/12/2022 REF 20260-7

LDC These plans are referred to in certificate no. **16635** approved by:

Christopher Louis Wahbe
 Registered Certifier
 Registration No: BDC 3015
 Categories: Certifier - Subdivision

Land Development Certificates
www.LDC.com.au

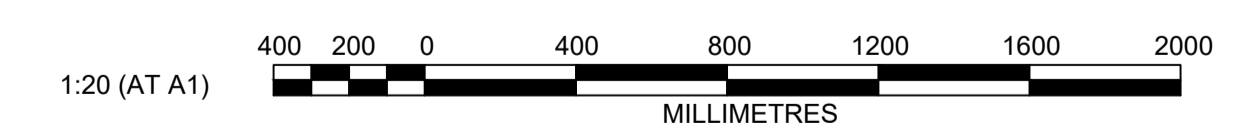

REV	DESCRIPTION	DES	DRN	CKD	APR	DATE
B	PIT B05/7 UPDATED	DG	JM	MP	MS	14/09/21
A	ISSUE FOR APPROVAL	DG	JM	MP	PJM	12/08/21
	AMENDMENT	DES	DRN	CKD	APR	DATE

J. WYNDHAM PRINCE
 CONSULTING CIVIL INFRASTRUCTURE ENGINEERS & PROJECT MANAGERS

PO Box 4366 PENRITH WESTFIELD NSW 2750
 P 02 4720 3300 W www.jwprince.com.au E jwp@jwprince.com.au

CLIENT:

WINTEN PROPERTY GROUP

STATUS: **ISSUE FOR CONSTRUCTION APPROVAL**

THIS DRAWING MUST NOT BE USED FOR CONSTRUCTION UNLESS SIGNED AS PART OF AN APPROVED CONSTRUCTION CERTIFICATE.


NEWPARK PRECINCT 7, STAGE 7B
 SPECIAL PIT DETAILS
 SHEET 8

PROJECT No: **9985-12**
 SHEET No: **CC5557**


AZIMUTH: M.G.A.94 DATUM: A.H.D. ORIGIN: SSM 1112 PLAN No: **9985-12-CC5557**

PROJECT No: **9985-12**
 SHEET No: **CC5557**


AZIMUTH: M.G.A.94 DATUM: A.H.D. ORIGIN: SSM 1112 PLAN No: **9985-12-CC5557**

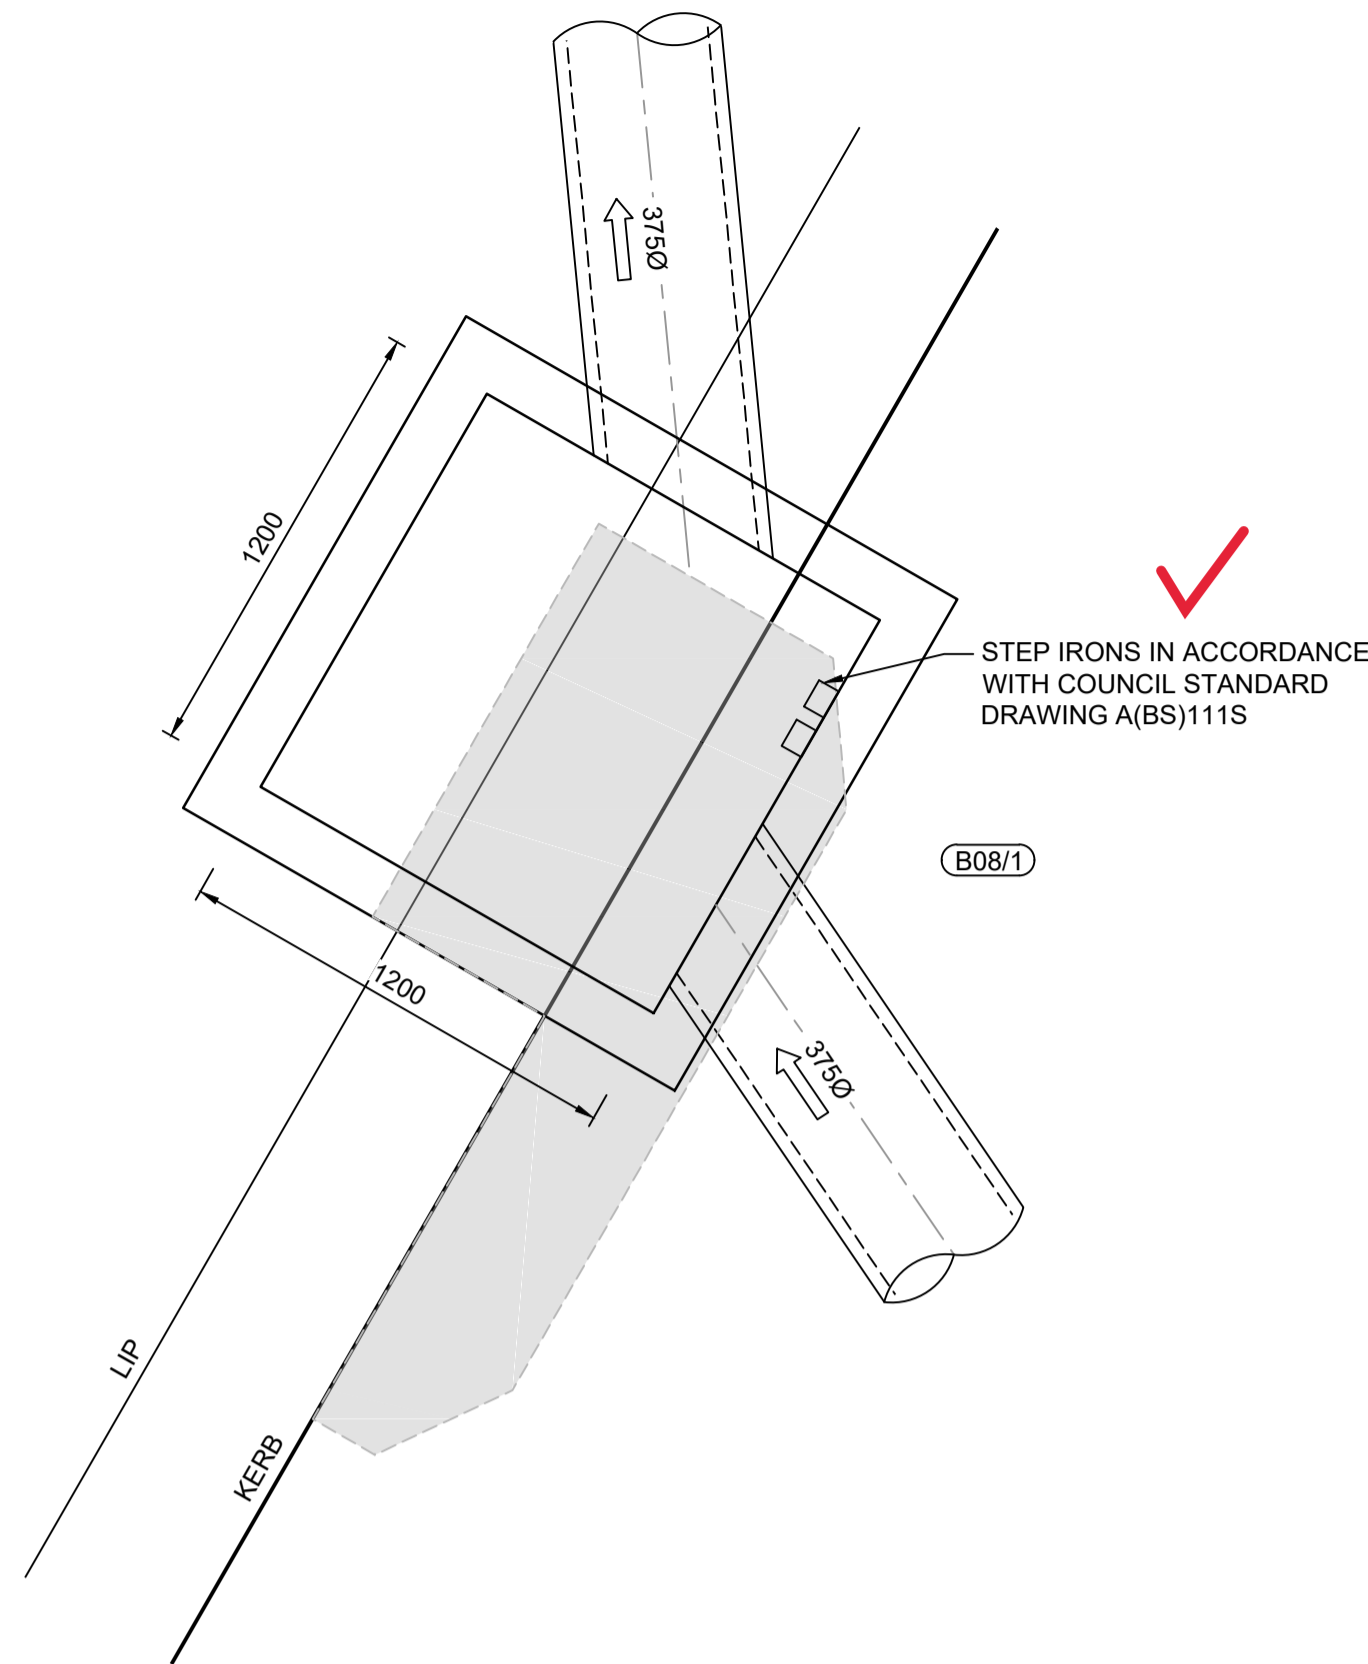

SPECIAL PIT - B08/1
SCALE 1:20

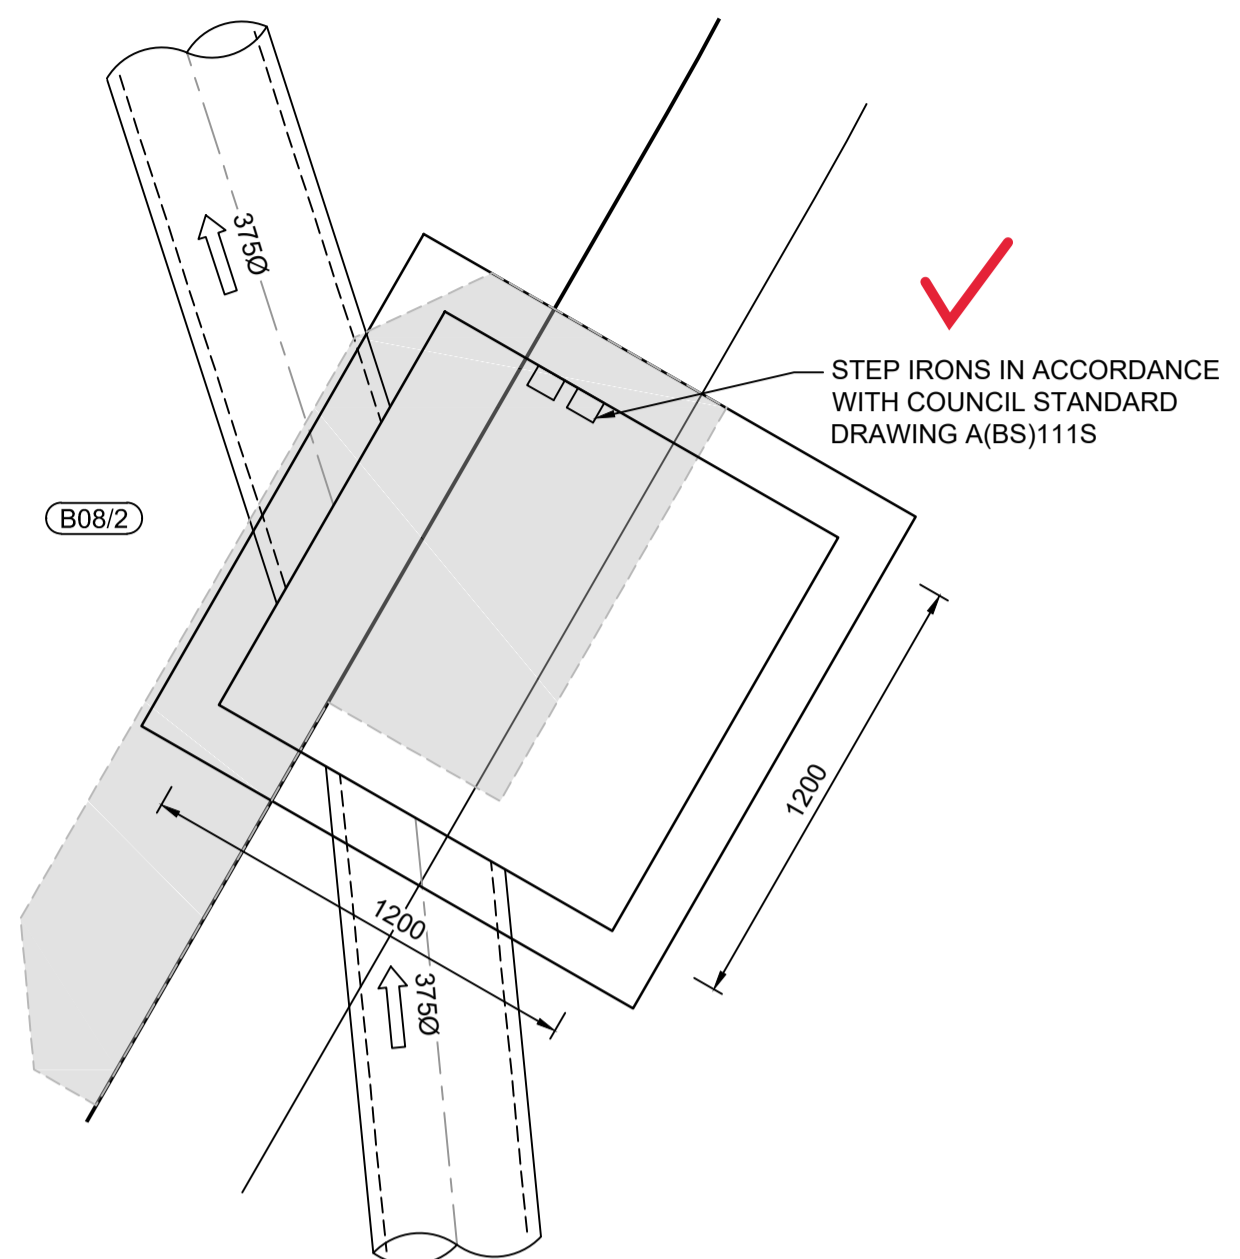


SPECIAL PIT - B08/2
SCALE 1:20

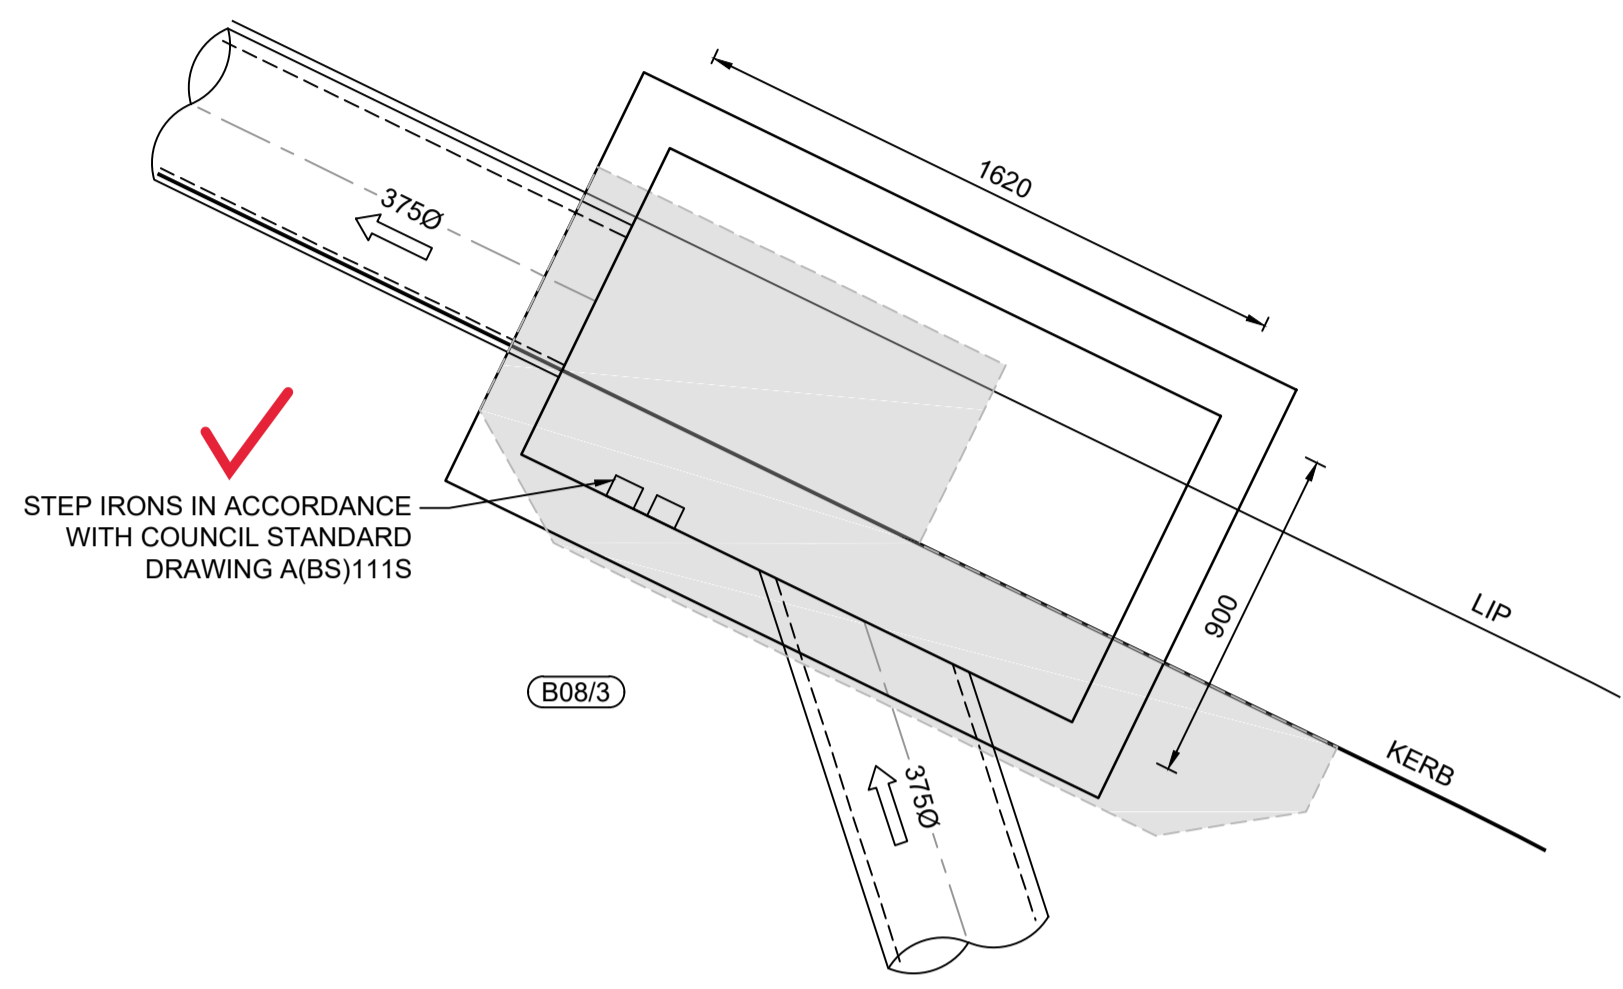


SPECIAL PIT - B08/3
SCALE 1:20


I hereby certify that engineering works shown on this plan have been constructed generally in accordance with Construction Certificate 16635 issued by Land Development Certificates
 Signature.....
PETER ROBERT WARWICK
 Registered Land Surveyor
VINCE MORGAN SURVEYORS PTY LTD
 DATE 20/12/2022 REF 20260-7

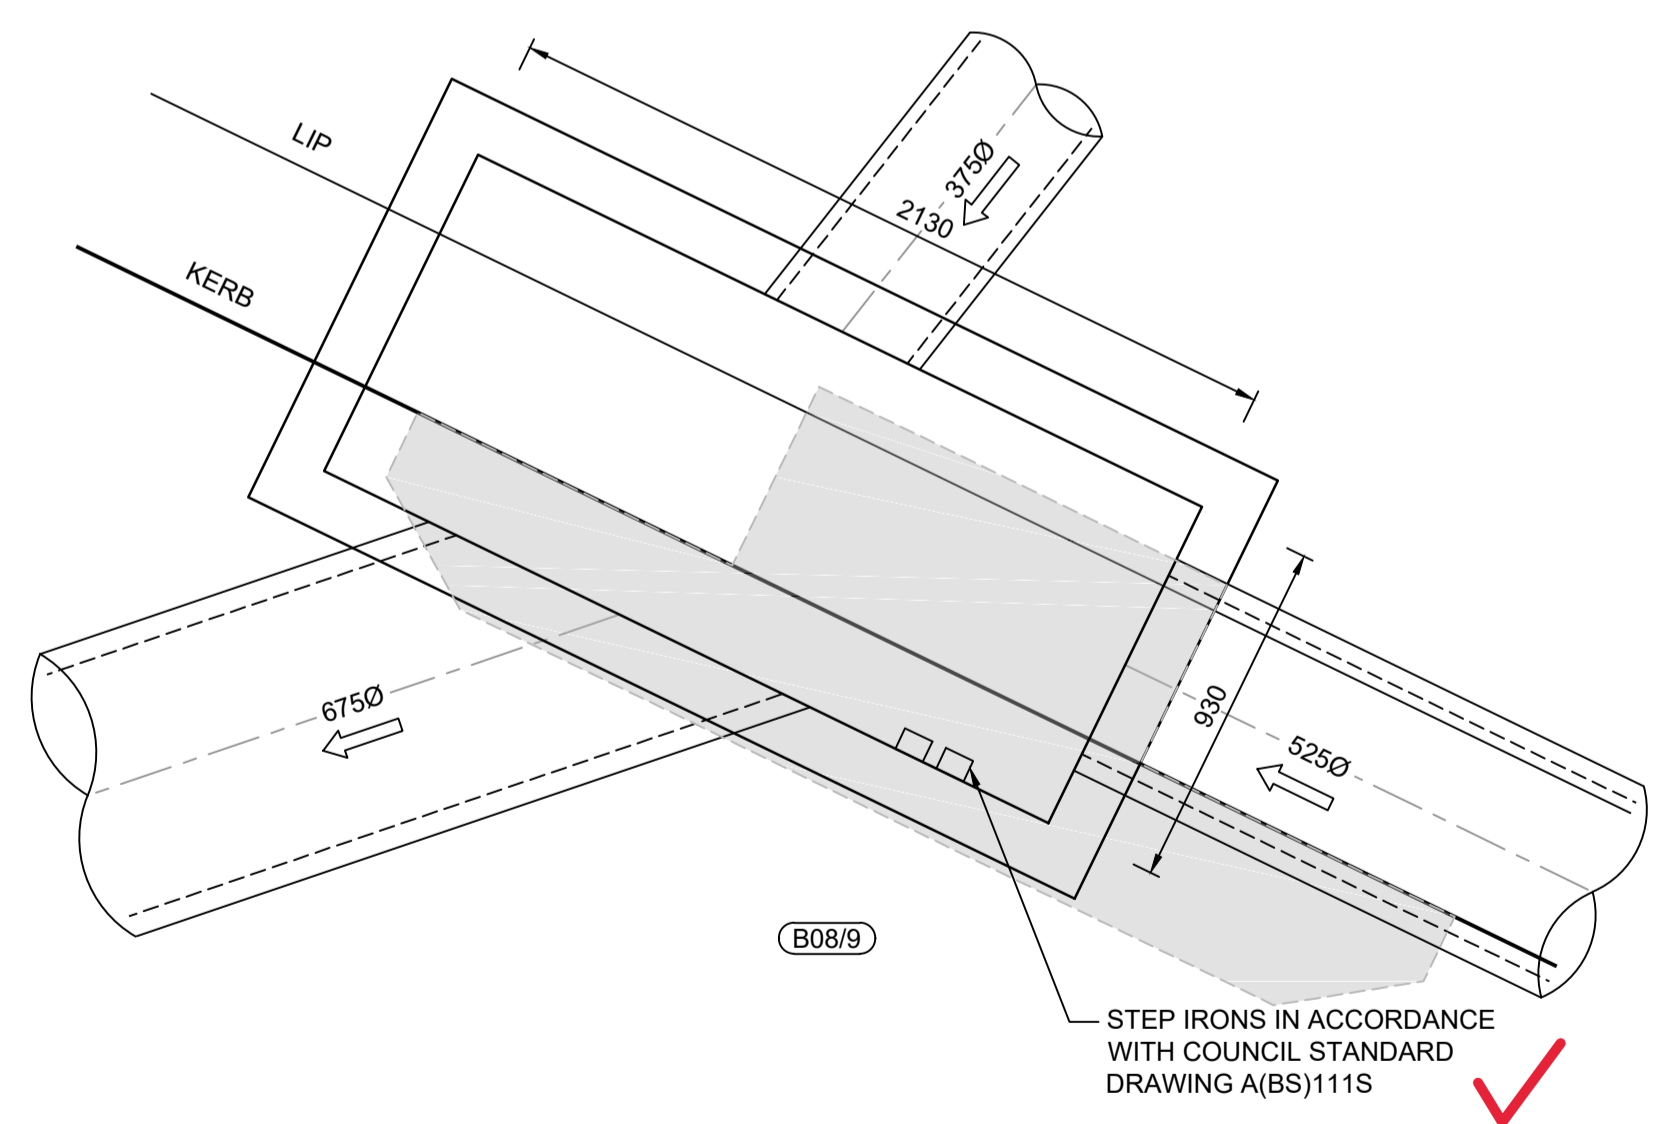


SPECIAL PIT - B08/9
SCALE 1:20

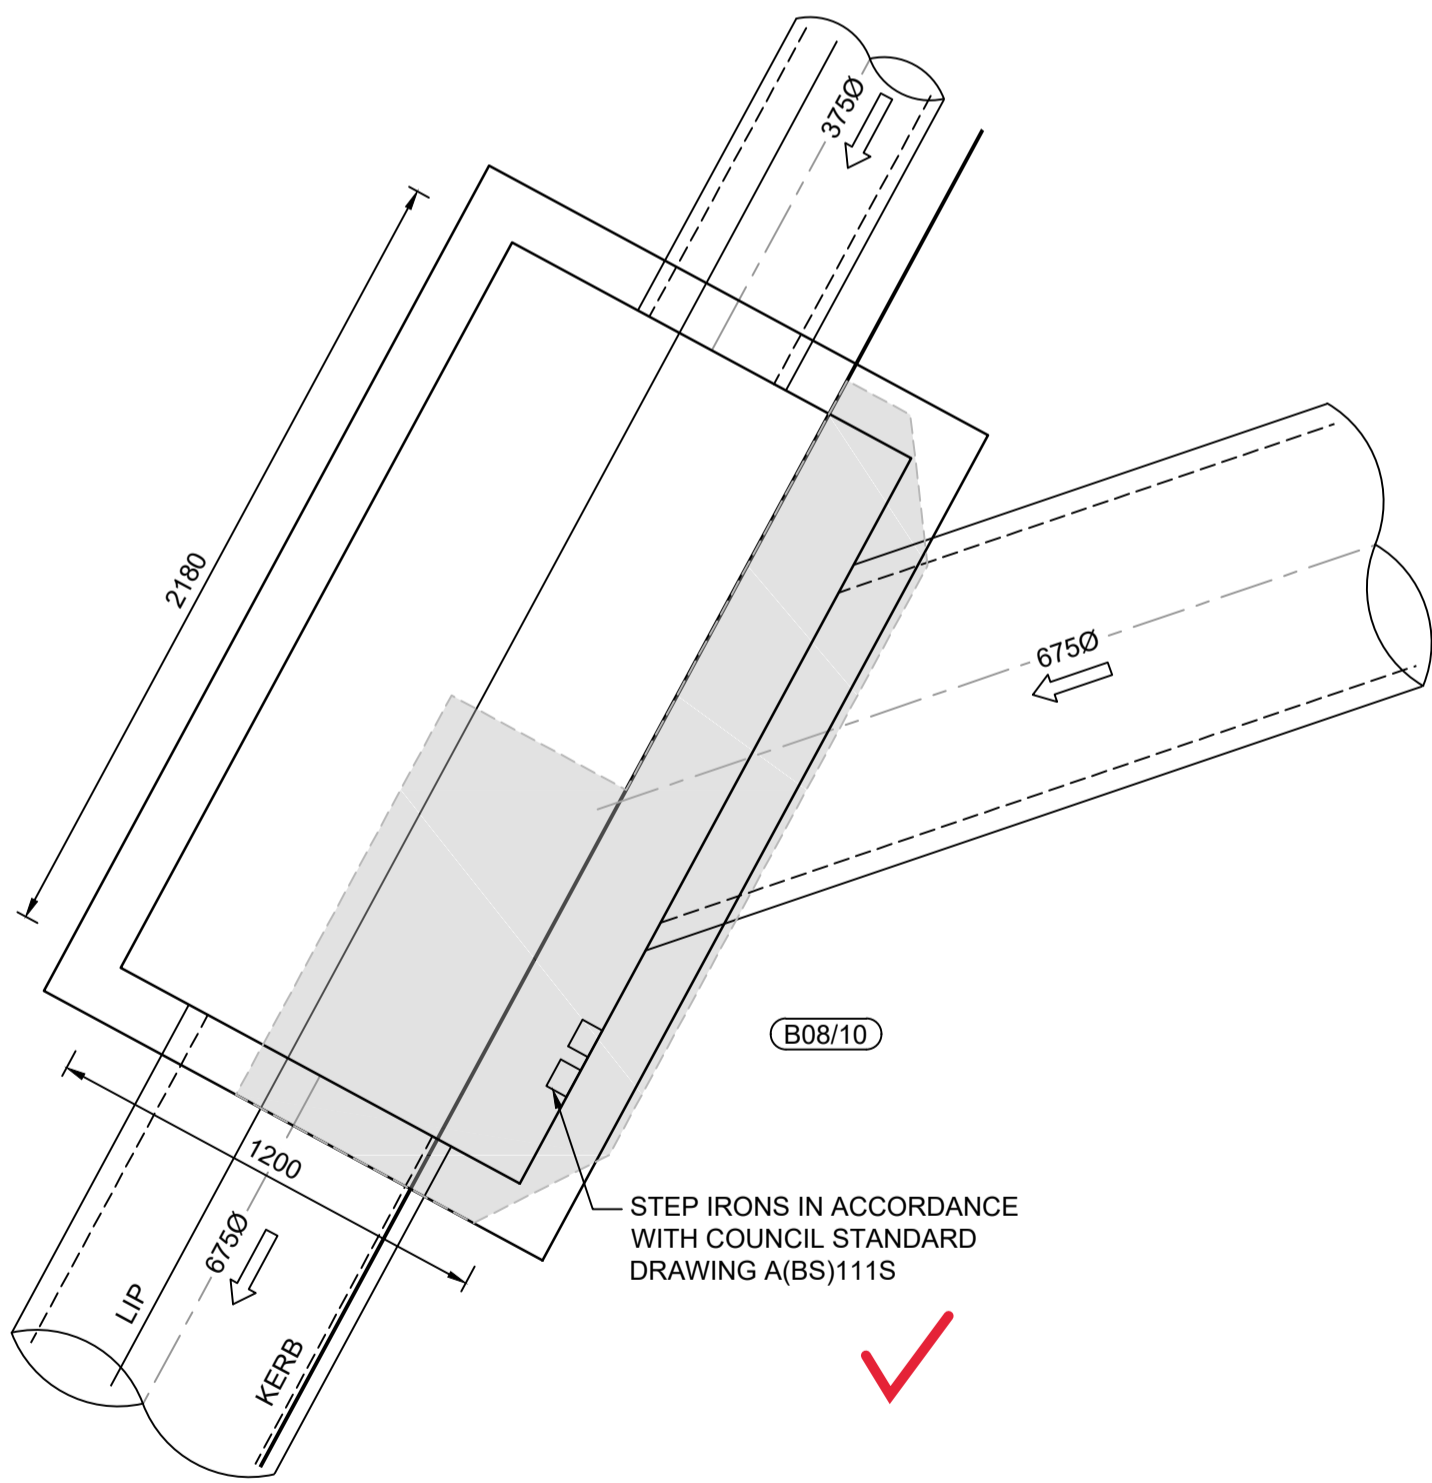

SPECIAL PIT - B08/10
SCALE 1:20

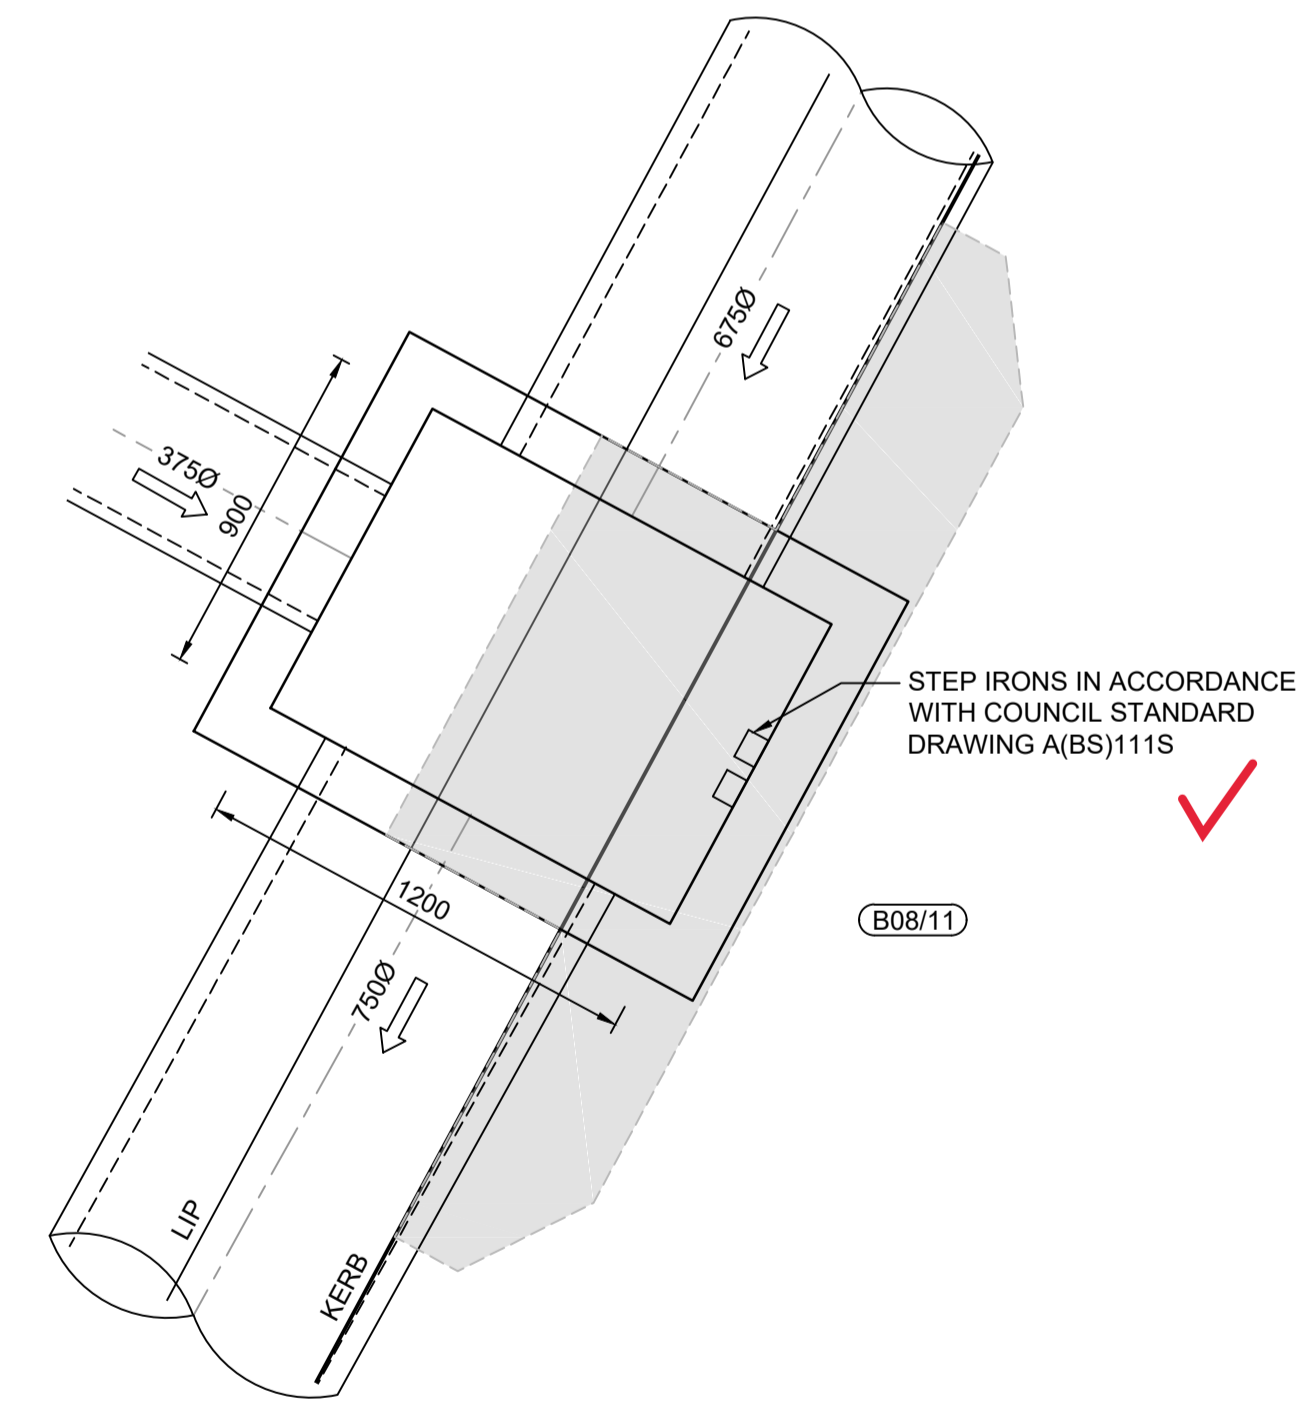

SPECIAL PIT - B08/11
SCALE 1:20

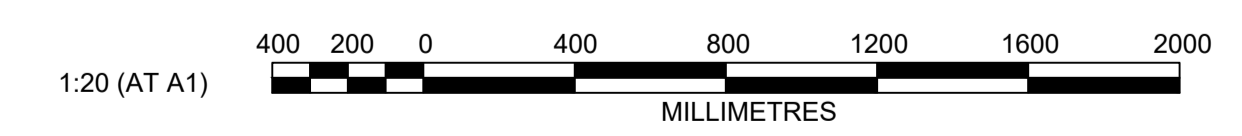

Plotted: 14 September, 2021 1:10:16 PM File Name: J:\0985DCC - Construction Certificate Approval Plans\PK12 WESTERN PRECINCTS\6 - Precinct 7\B0985-12-CC5558.dwg

A	ISSUE FOR APPROVAL	DG	JM	MP	PJM	12/08/21
	AMENDMENT	DES	DRN	CKD	APR	DATE

J. WYNDHAM PRINCE
 CONSULTING CIVIL INFRASTRUCTURE ENGINEERS & PROJECT MANAGERS
 PO Box 4366 PENRITH WESTFIELD NSW 2750
 P 02 4720 3300 W www.jwprince.com.au E jwp@jwprince.com.au

CLIENT:  **WINTAN PROPERTY GROUP**

STATUS: **ISSUE FOR CONSTRUCTION APPROVAL**
 THIS DRAWING MUST NOT BE USED FOR CONSTRUCTION UNLESS SIGNED AS PART OF AN APPROVED CONSTRUCTION CERTIFICATE.

NEWPARK PRECINCT 7, STAGE 7B
 SPECIAL PIT DETAILS
 SHEET 9
 AZIMUTH: M.G.A.94 DATUM: A.H.D. ORIGIN: SSM 1112 PLAN No: 9985-12-CC5558


PROJECT No: **9985-12**
 SHEET No: **CC5558**
 A

I hereby certify that engineering works shown on this plan have been constructed generally in accordance with Construction Certificate 16635 issued by Land Development Certificates


Signature: *[Signature]*
PETER ROBERT WARWICK
 Registered Land Surveyor
VINCE MORGAN SURVEYORS PTY LTD

DATE 20/12/2022 REF 20260-7


LDC These plans are referred to in certificate no. 16635 approved by:
Christopher Louis Wahbe
 Registered Certifier
 Registration No: BDC 3015
 Categories: Certifier - Subdivision
Land Development Certificates
 www.LDC.com.au

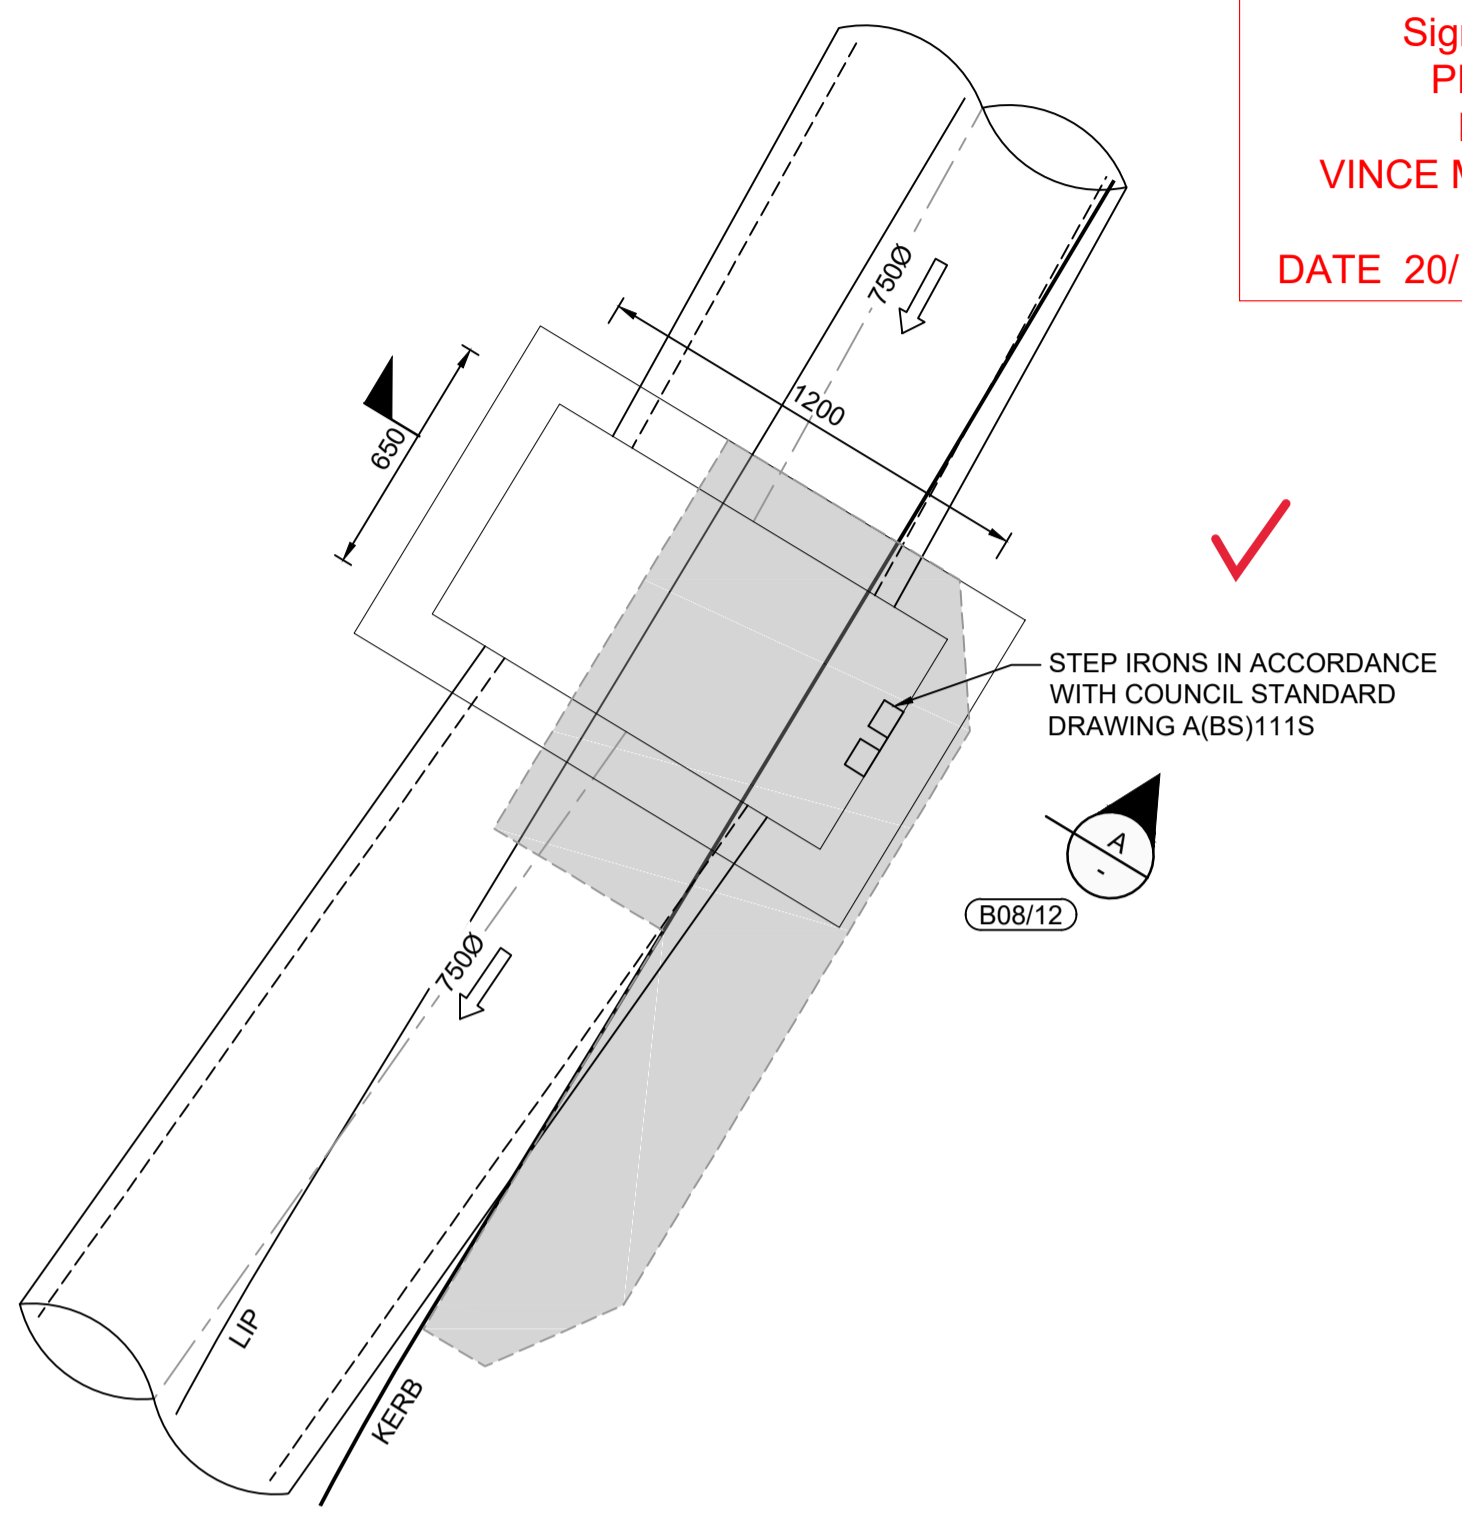


SPECIAL PIT - B08/12
SCALE 1:20

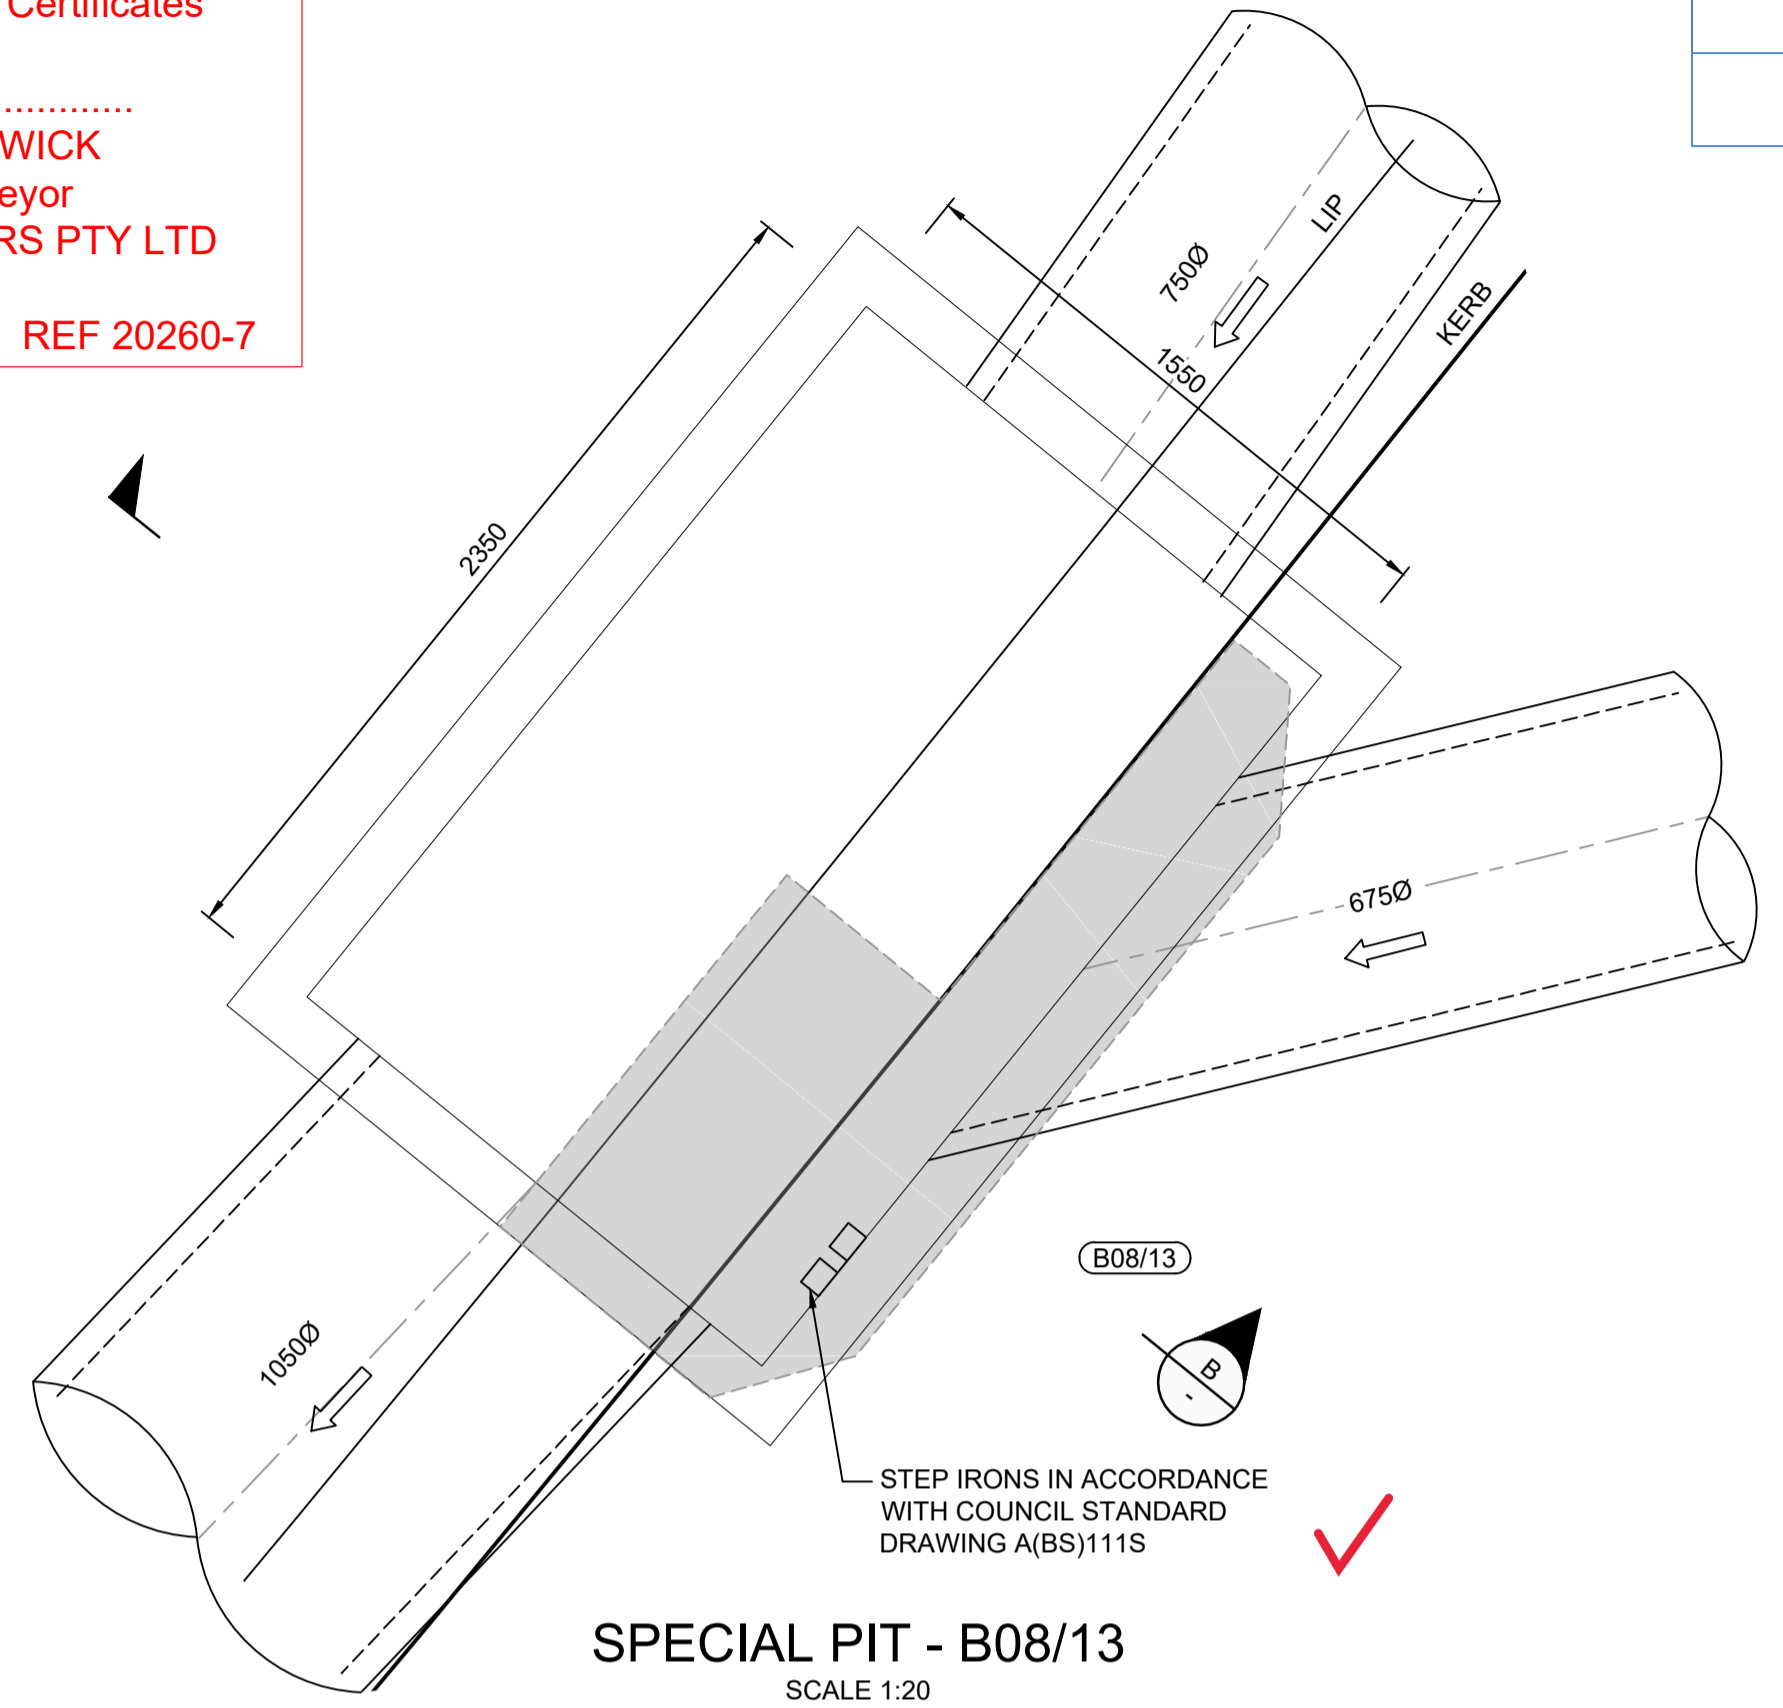


SPECIAL PIT - B08/13
SCALE 1:20

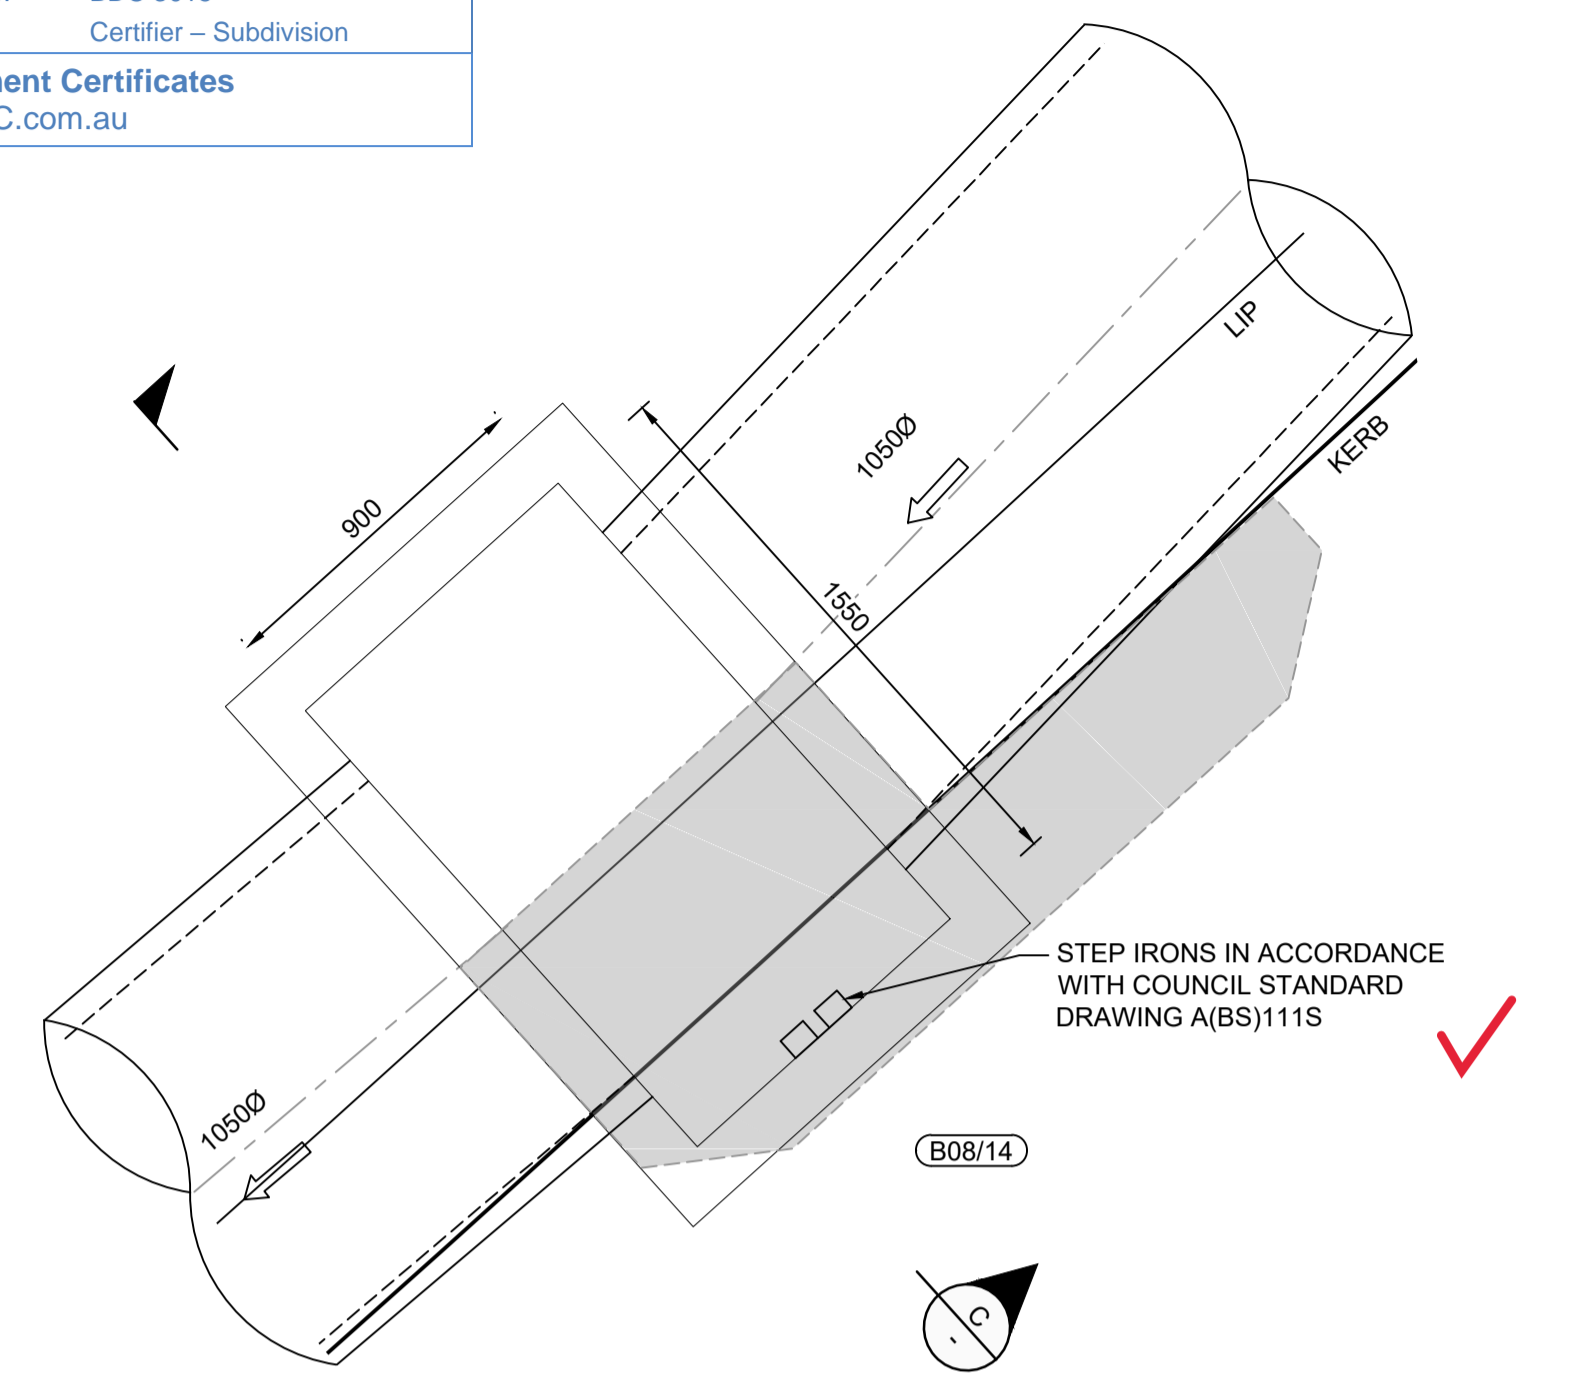


SPECIAL PIT - B08/14
SCALE 1:20

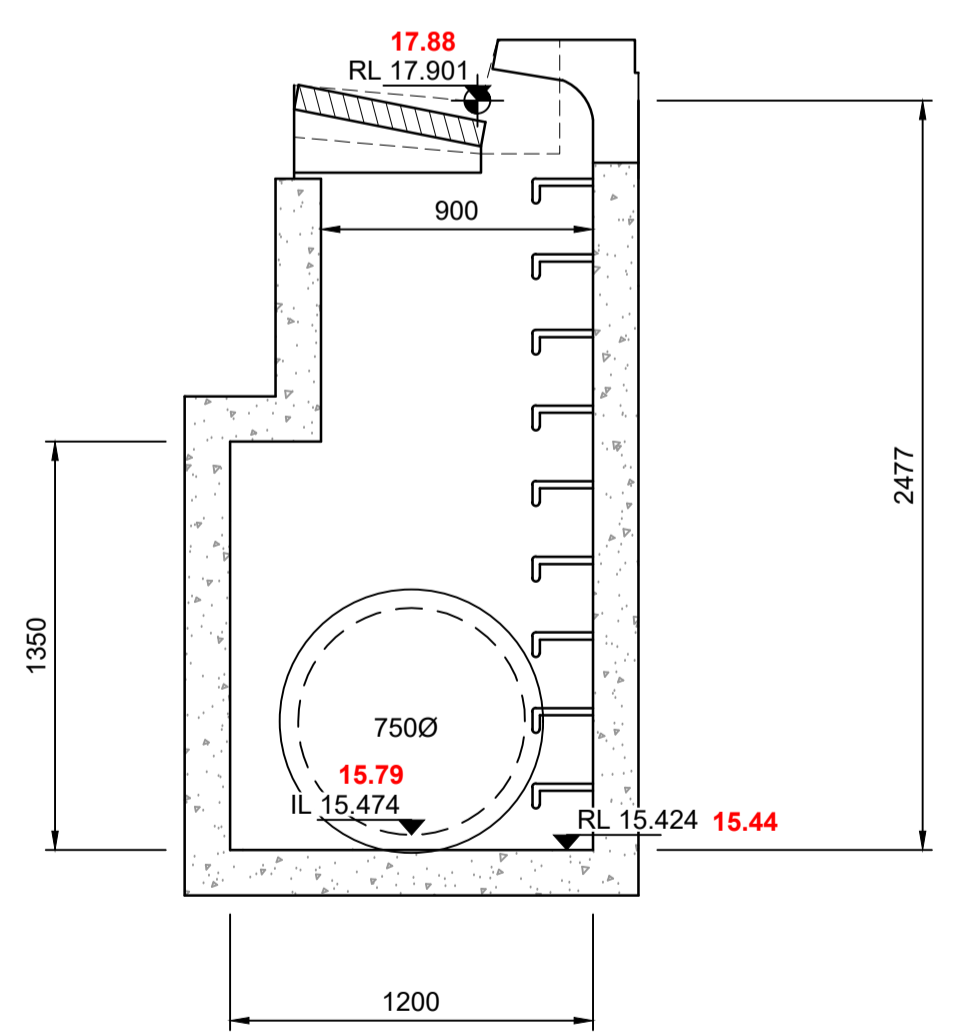


SECTION A
SCALE 1:25

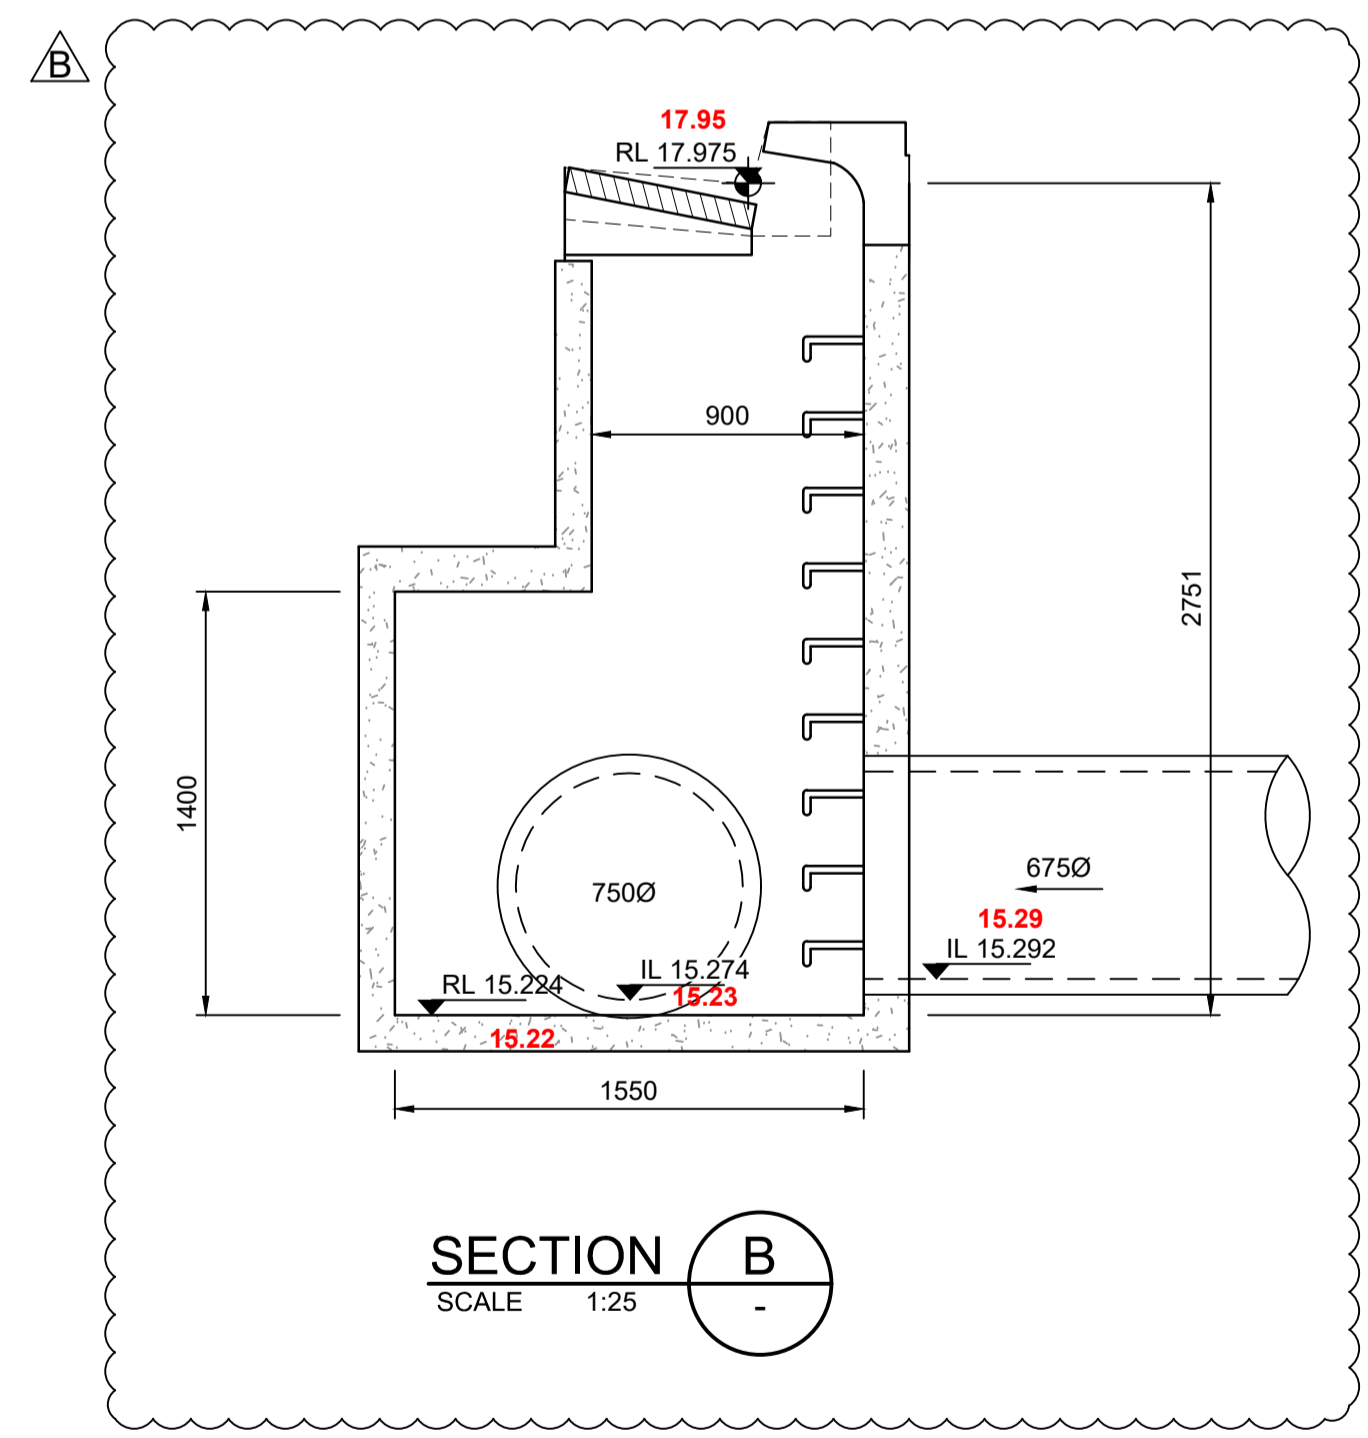

SECTION B
SCALE 1:25

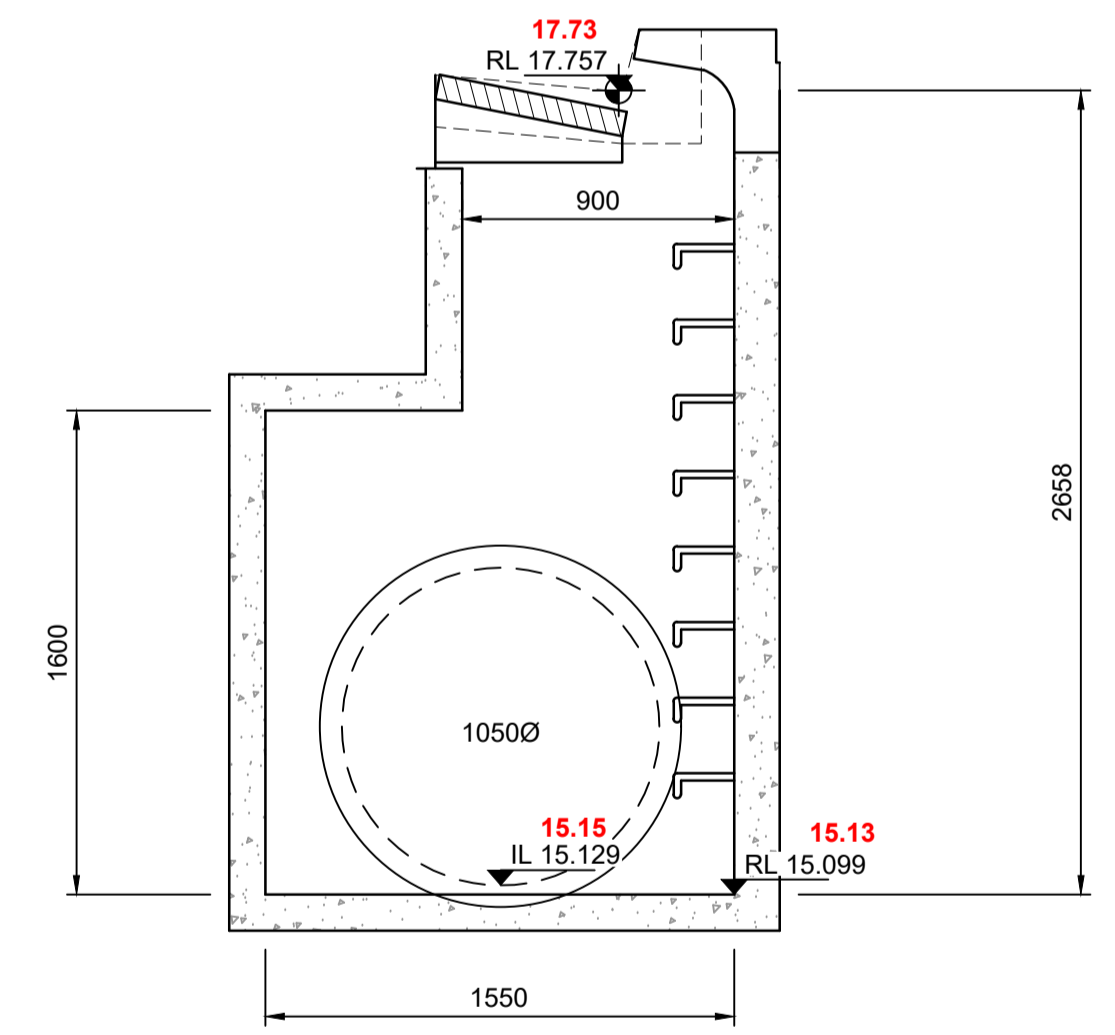

SECTION C
SCALE 1:25

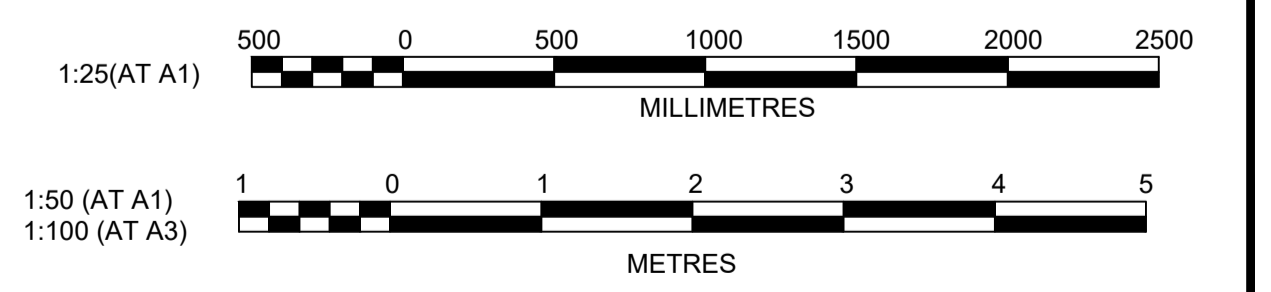

Plotfile: 14 September, 2021 11:29 PM File Name: J:\9985DCC - Construction Certificate Approval Plans\PK12 WESTERN PRECINCTS\6 - Precinct 7\9985-12-CC5559.dwg

NO	DESCRIPTION	DES	DRN	CKD	APR	DATE
B	PIT B08/13 SECTION UPDATED	DG	JM	MP	MS	14/09/21
A	ISSUE FOR APPROVAL	DG	JM	MP	PJM	12/08/21
	AMENDMENT	DES	DRN	CKD	APR	DATE

J. WYNDHAM PRINCE
 CONSULTING CIVIL INFRASTRUCTURE ENGINEERS & PROJECT MANAGERS

PO Box 4366 PENRITH WESTFIELD NSW 2750
 P 02 4720 3300 W www.jwprince.com.au E jwp@jwprince.com.au

CLIENT:

WINTEN PROPERTY GROUP

STATUS: **ISSUE FOR CONSTRUCTION APPROVAL**


THIS DRAWING MUST NOT BE USED FOR CONSTRUCTION UNLESS SIGNED AS PART OF AN APPROVED CONSTRUCTION CERTIFICATE.

NEWPARK PRECINCT 7, STAGE 7B
 SPECIAL PIT DETAILS
 SHEET 10


PROJECT No: **9985-12**
 SHEET No: **CC5559**

AZIMUTH: M.G.A.94 DATUM: A.H.D. ORIGIN: SSM 1112 PLAN No: **9985-12-CC5559**


B

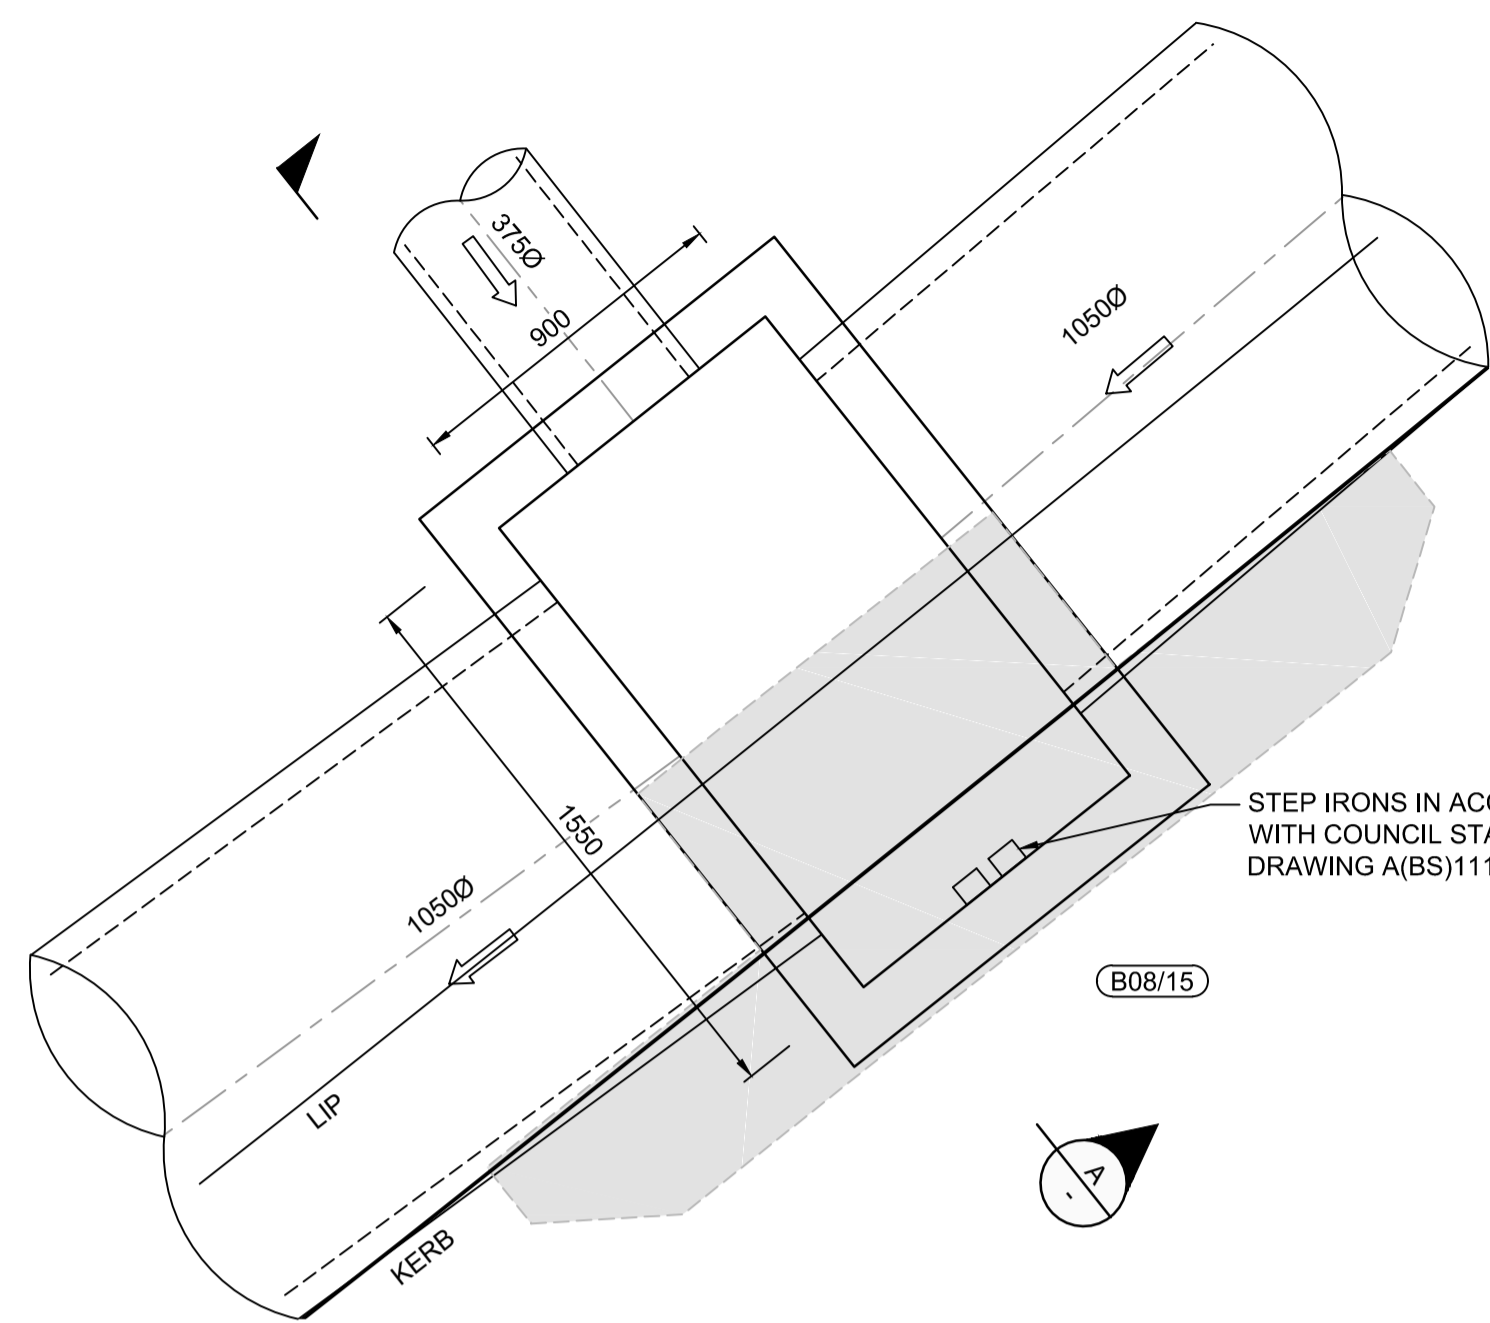

SPECIAL PIT - B08/15
SCALE 1:20

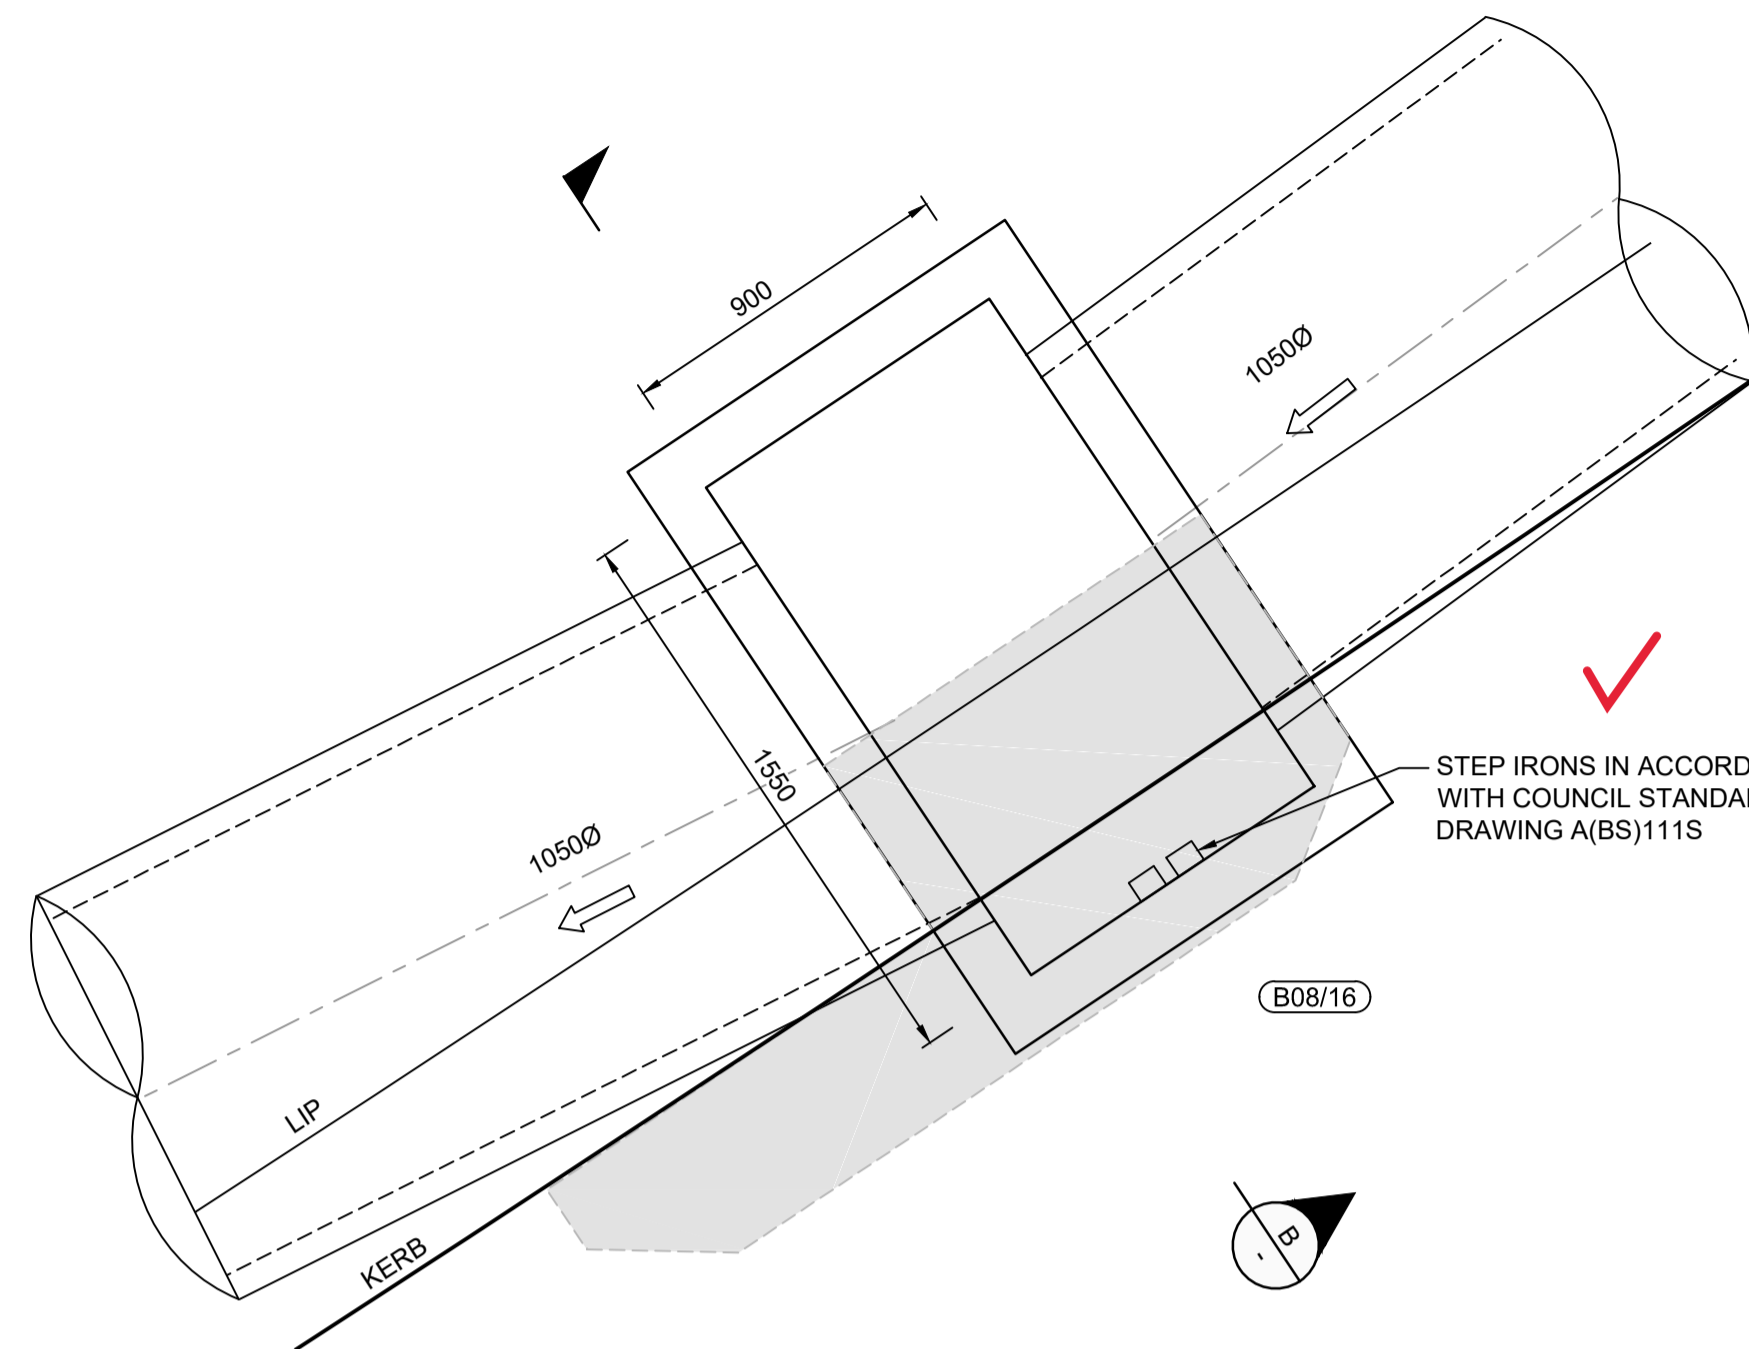


SPECIAL PIT - B08/16
SCALE 1:20

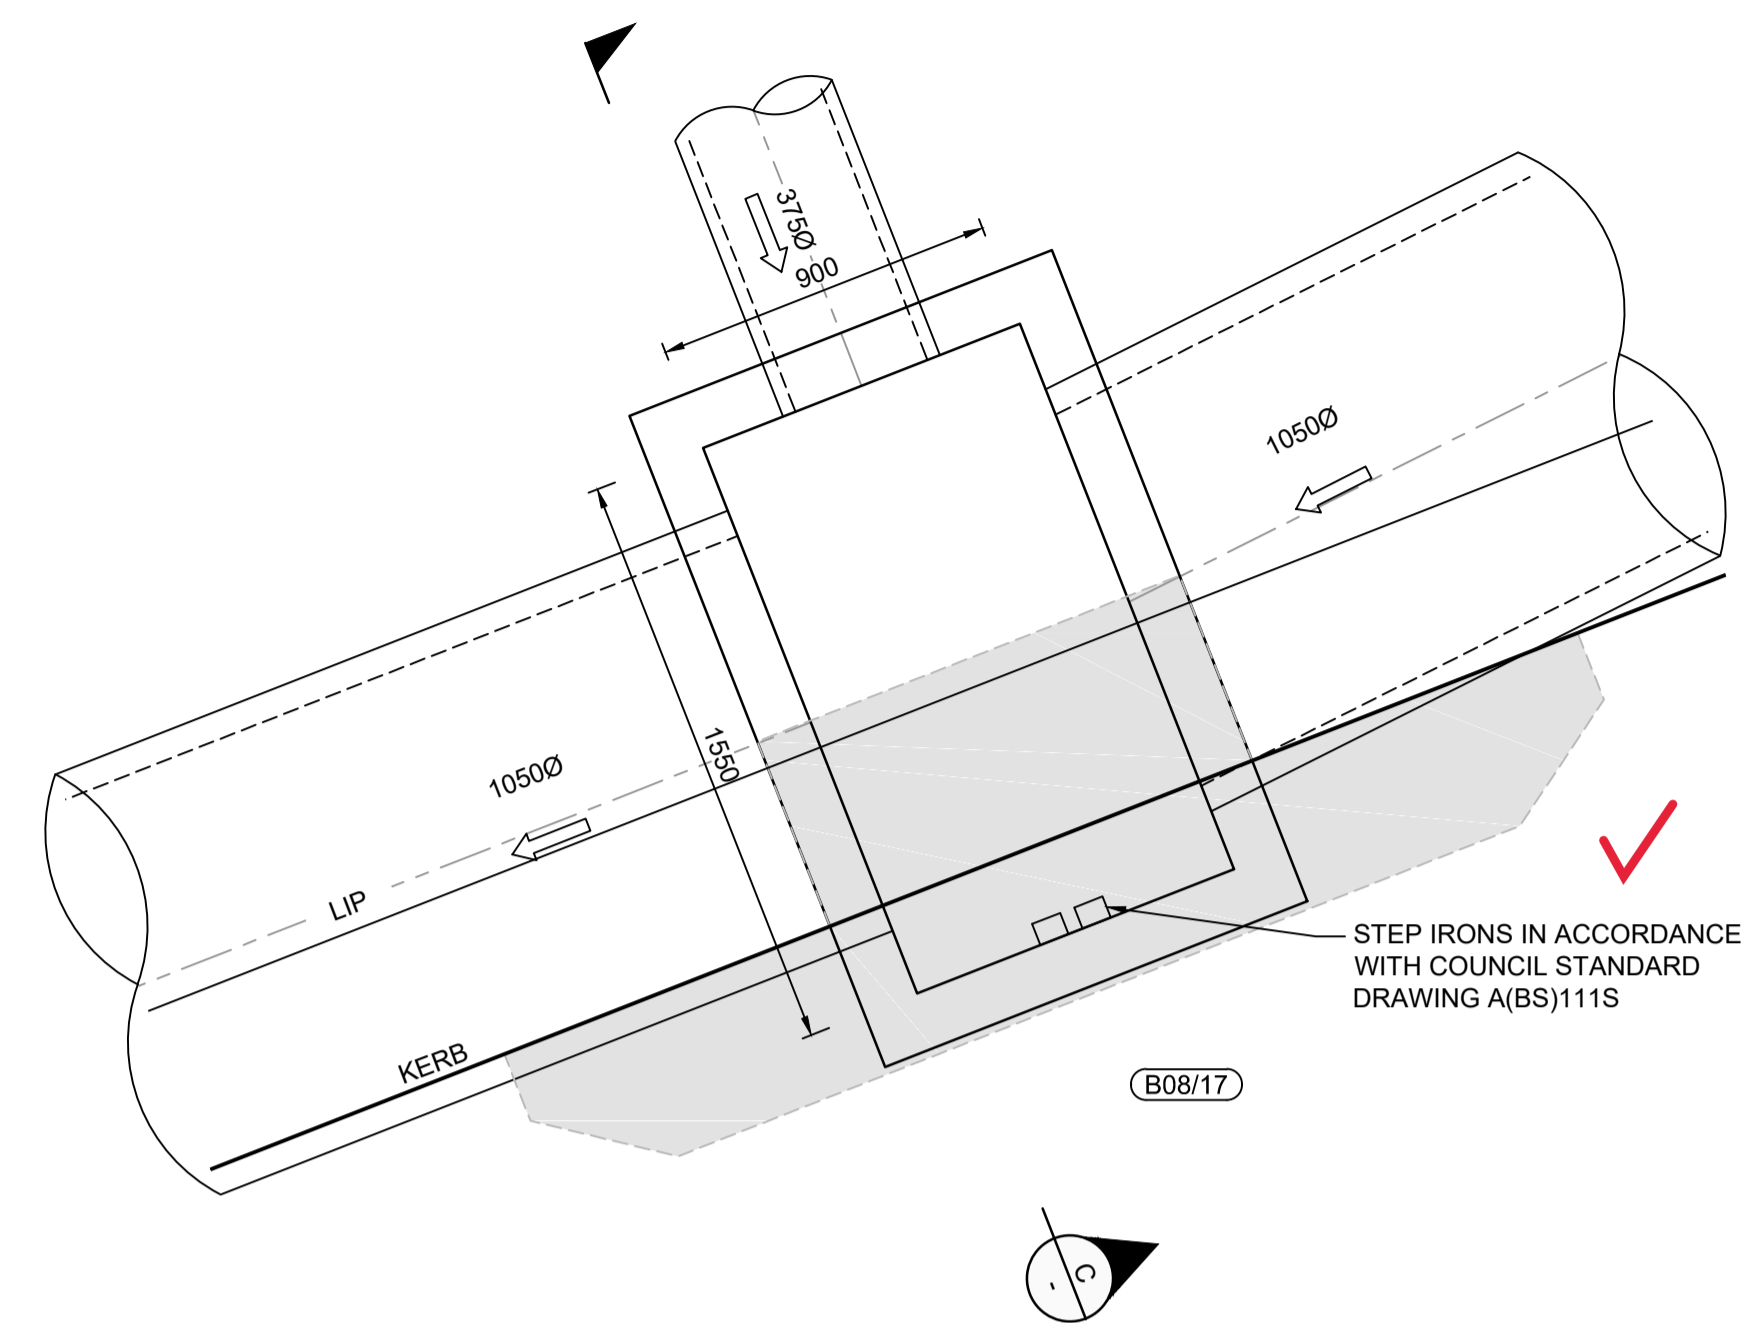


SPECIAL PIT - B08/17
SCALE 1:20

I hereby certify that engineering works shown on this plan have been constructed generally in accordance with Construction Certificate 16635 issued by Land Development Certificates


Signature: *[Signature]*
PETER ROBERT WARWICK
 Registered Land Surveyor
 VINCE MORGAN SURVEYORS PTY LTD
 DATE 20/12/2022 REF 20260-7

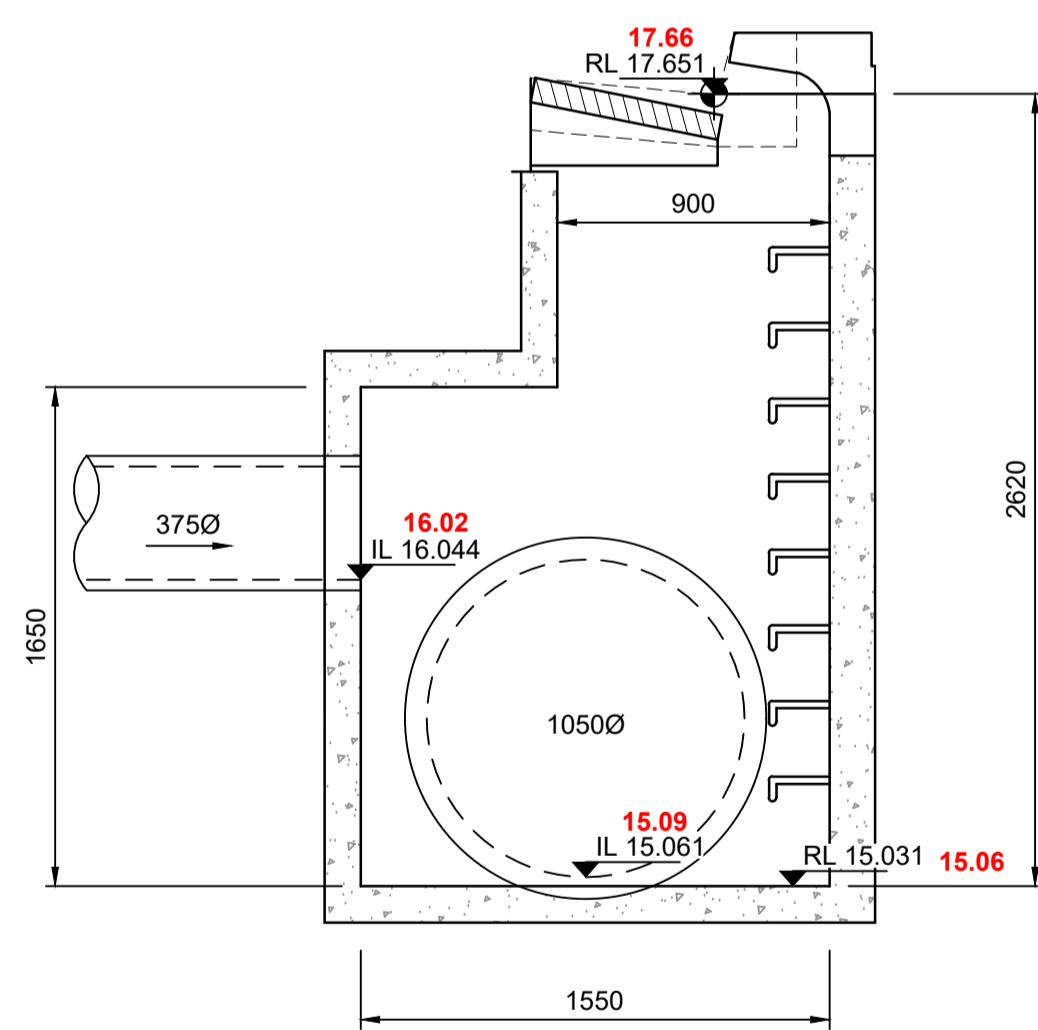

SECTION A
SCALE 1:25

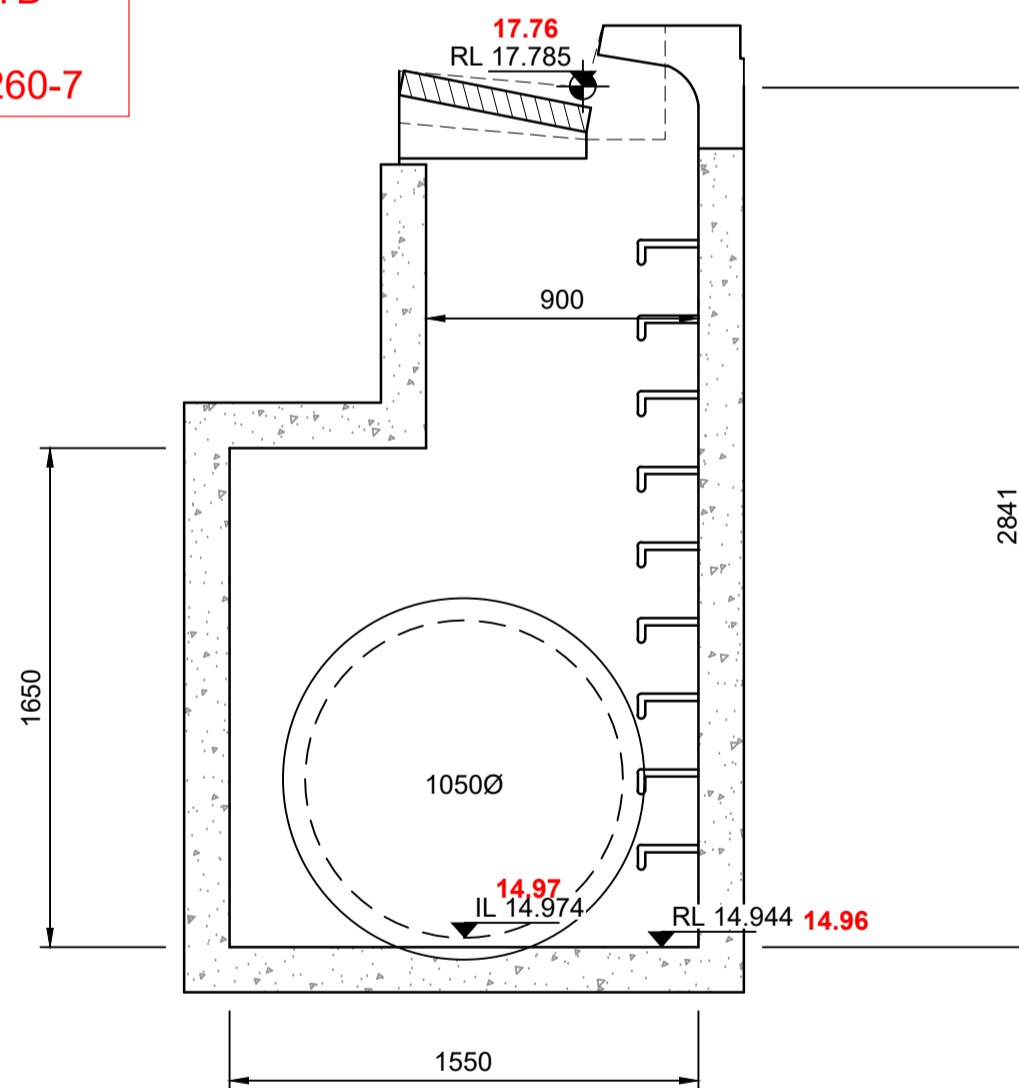


SECTION B
SCALE 1:25

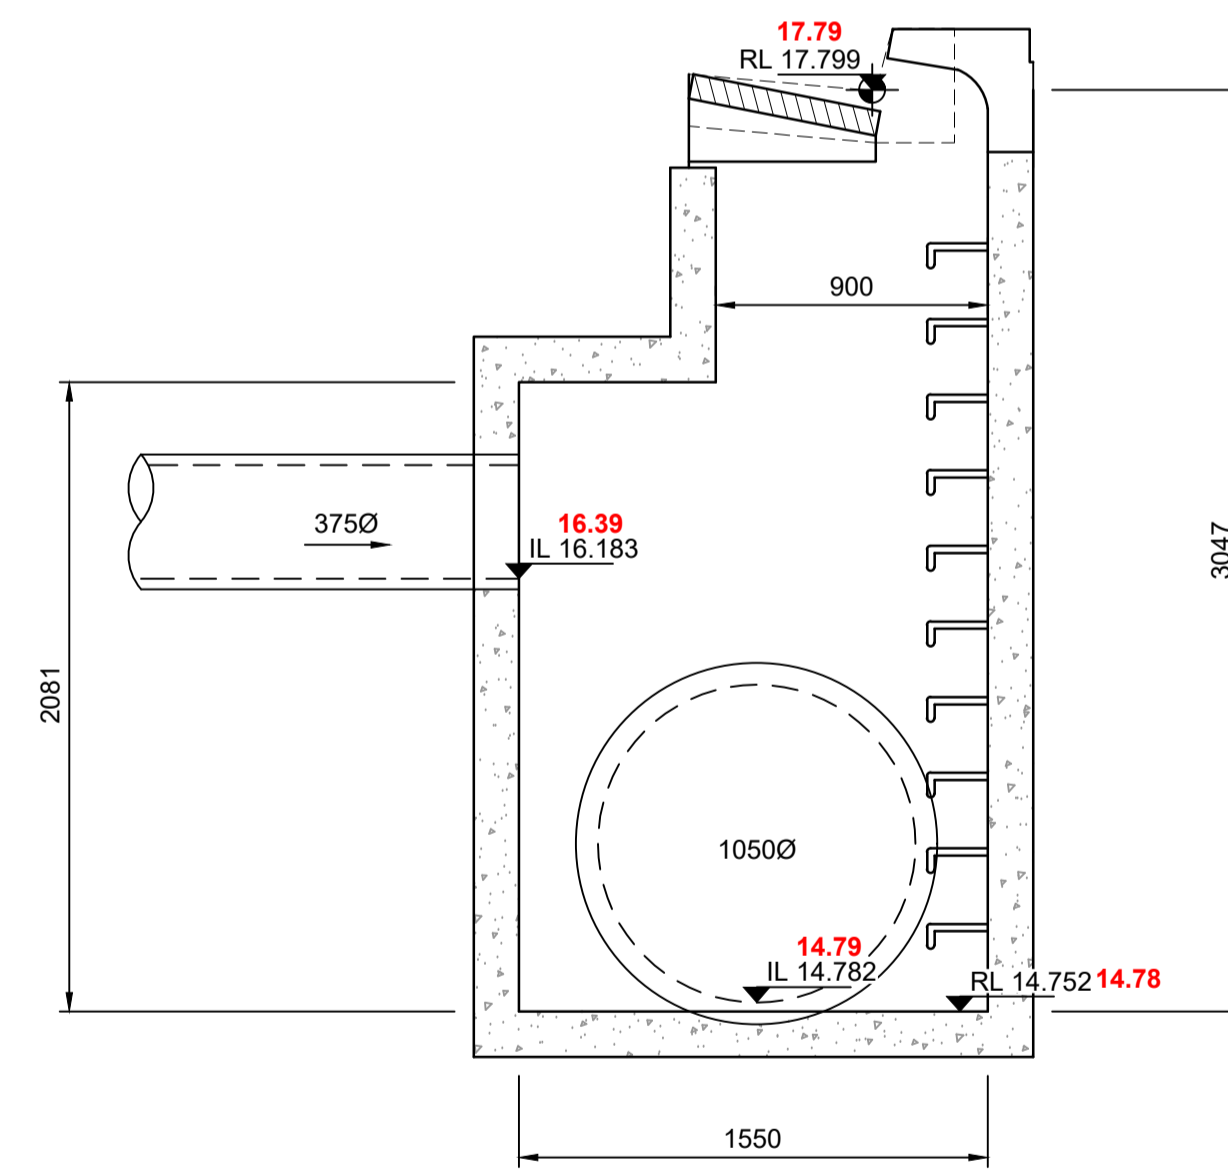

SECTION C
SCALE 1:25

LDC These plans are referred to in certificate no. 16635 approved by:
Christopher Louis Wahbe
 Registered Certifier
 Registration No: BDC 3015
 Categories: Certifier - Subdivision
Land Development Certificates
 www.LDC.com.au

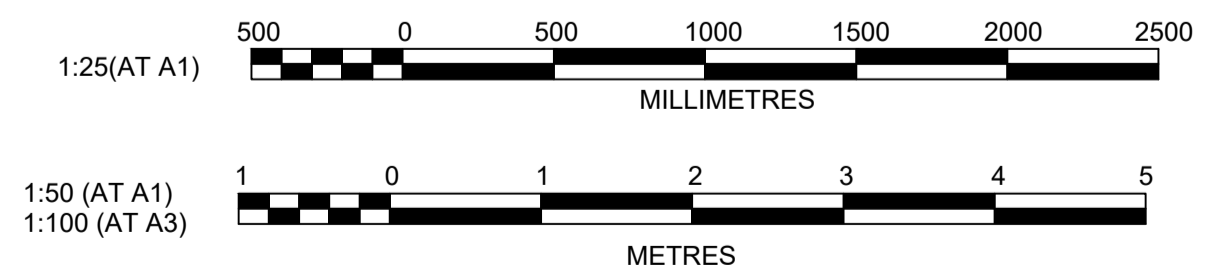

Plotted: 14 September, 2021 11:12:42 PM File Name: J:\9985D\CC - Construction Certificate Approval Plans\K12 WESTERN PRECINCTS\5 - Precinct 7\9985-12-CC5560.dwg

A	ISSUE FOR APPROVAL	DG	JM	MP	PJM	12/08/21
	AMENDMENT	DES	DRN	CKD	APR	DATE



J. WYNDHAM PRINCE
 CONSULTING CIVIL INFRASTRUCTURE ENGINEERS & PROJECT MANAGERS
 PO Box 4366 PENRITH WESTFIELD NSW 2750
 P 02 4720 3300 W www.jwprince.com.au E jwp@jwprince.com.au

CLIENT:
WINTER PROPERTY GROUP


STATUS:
ISSUE FOR CONSTRUCTION APPROVAL
 THIS DRAWING MUST NOT BE USED FOR CONSTRUCTION UNLESS SIGNED AS PART OF AN APPROVED CONSTRUCTION CERTIFICATE.

NEWPARK PRECINCT 7, STAGE 7B
 SPECIAL PIT DETAILS
 SHEET 11


PROJECT No:
9985-12
 SHEET No:
CC5560
 PLAN No: 9985-12-CC5560

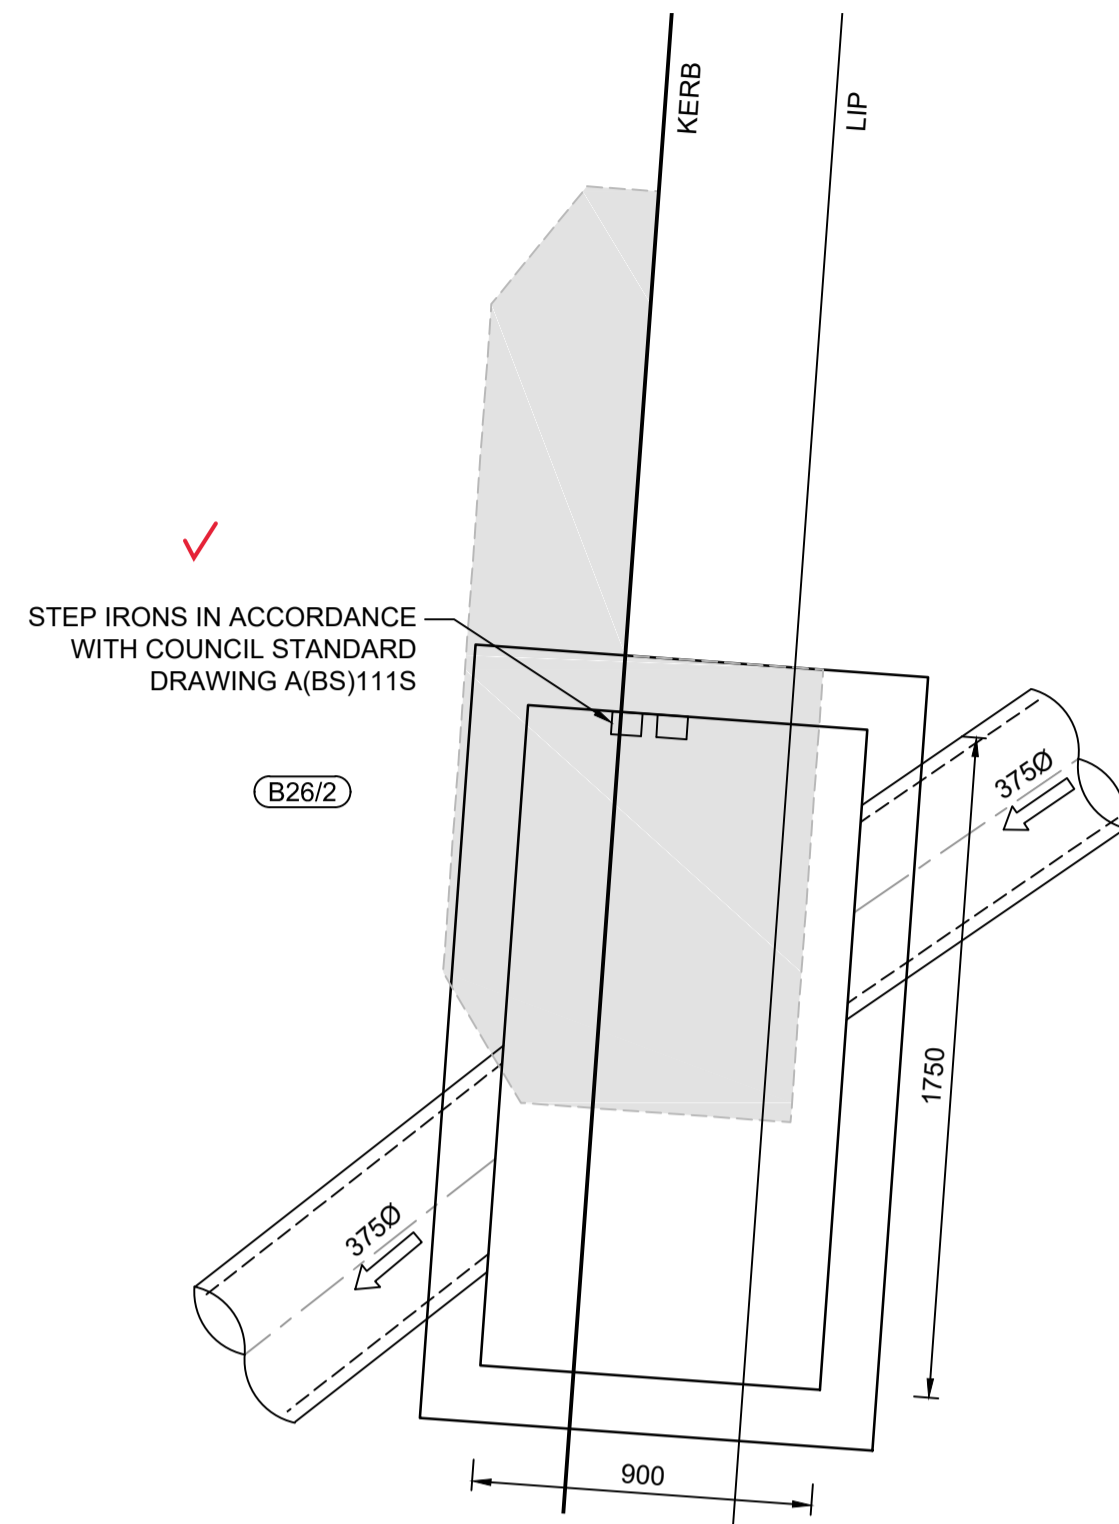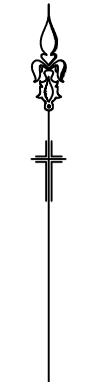


SPECIAL PIT - B26/2
SCALE 1:20

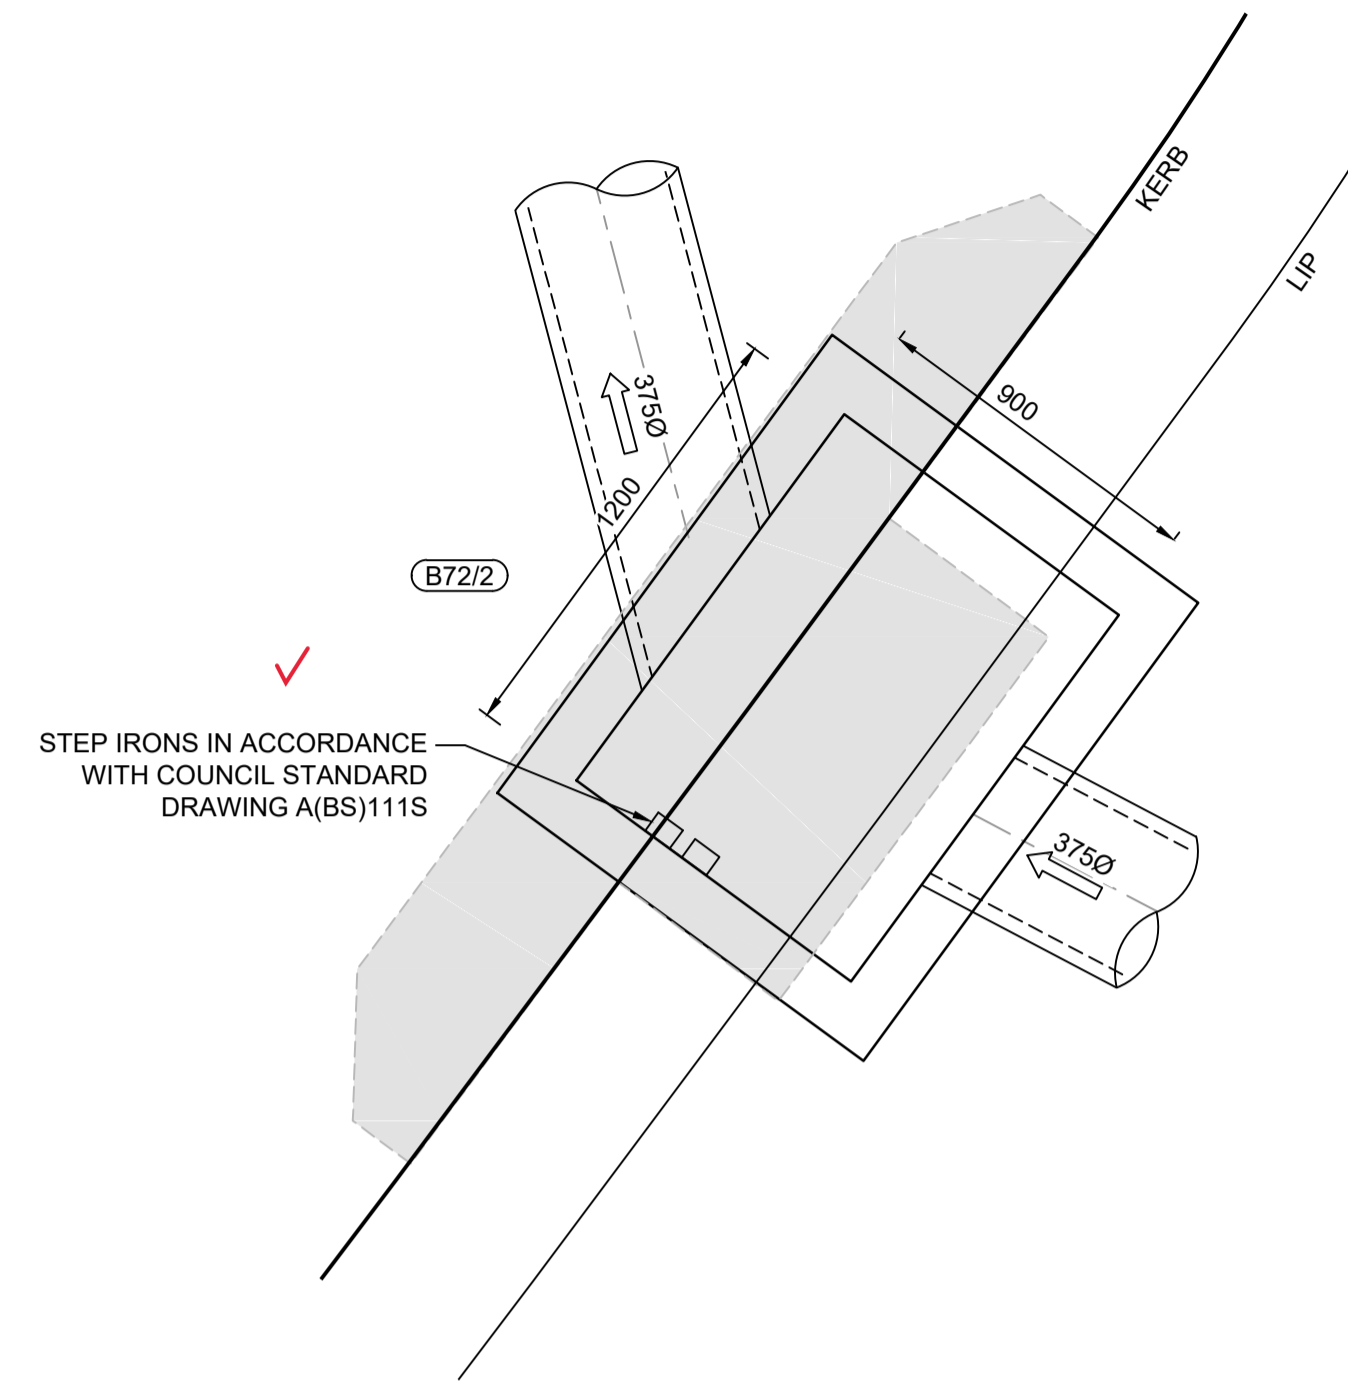

SPECIAL PIT - B72/2
SCALE 1:20

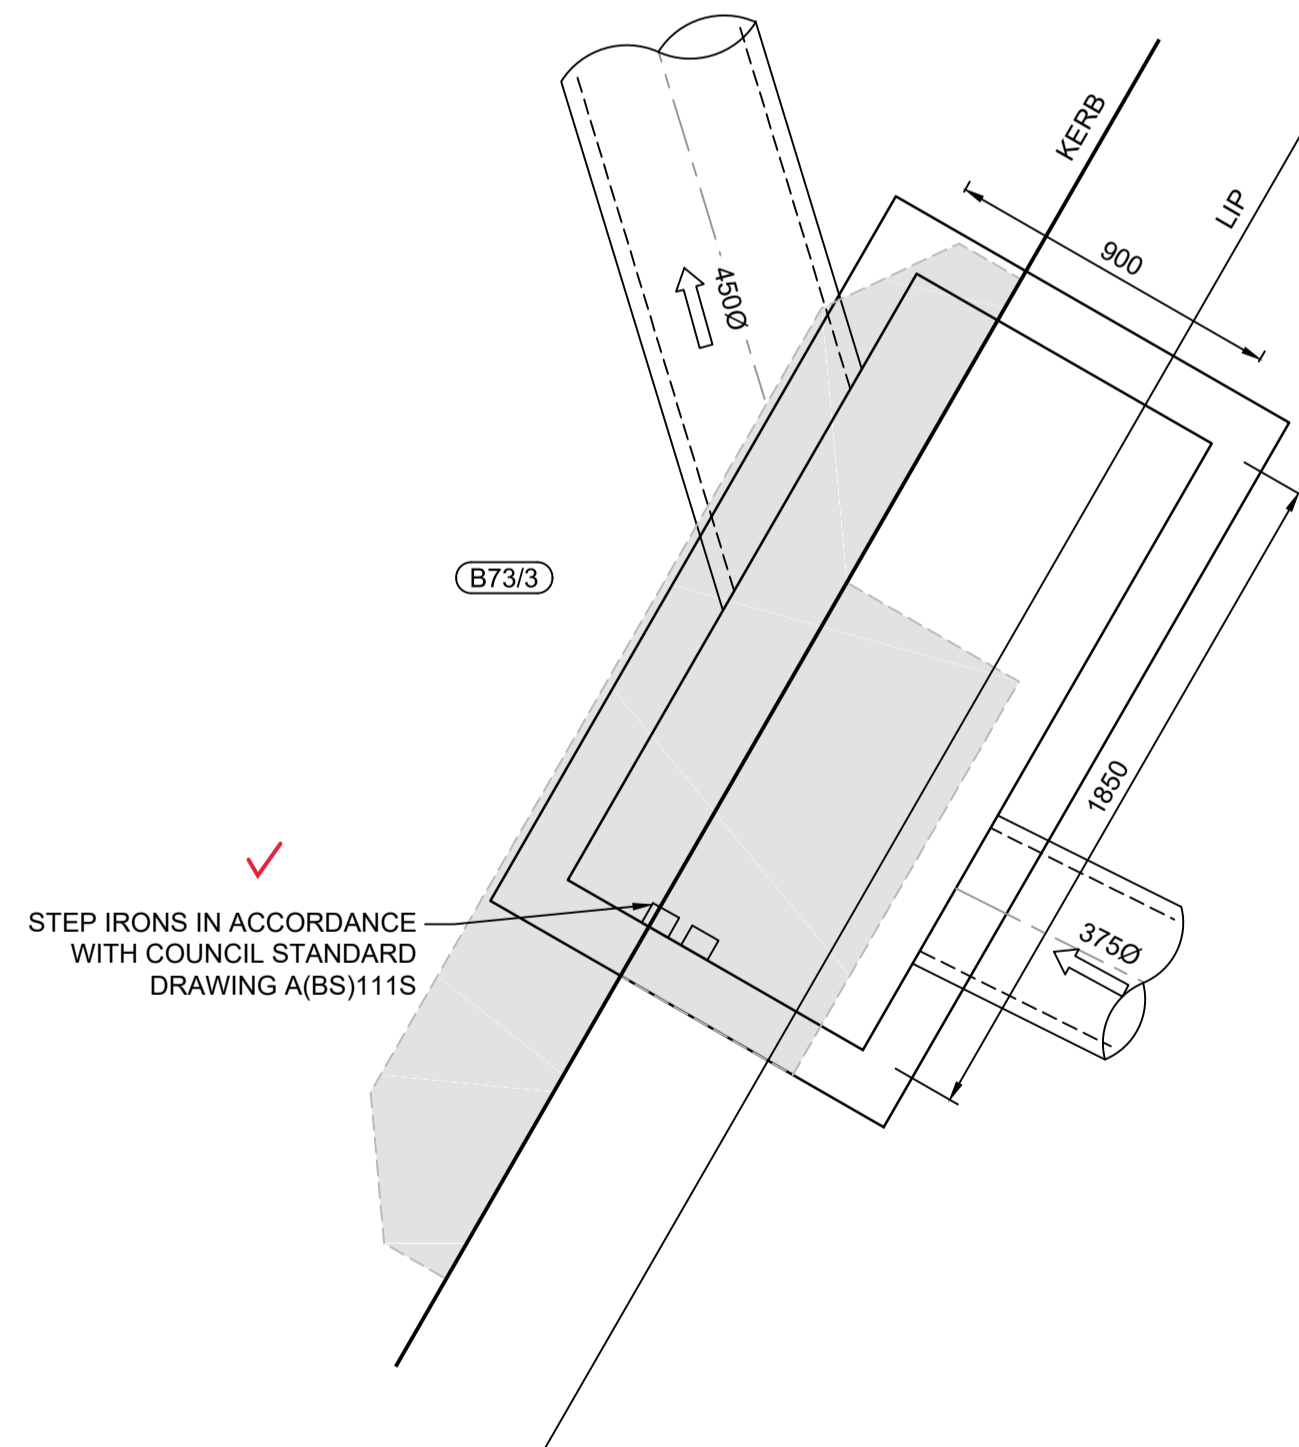

SPECIAL PIT - B73/3
SCALE 1:20

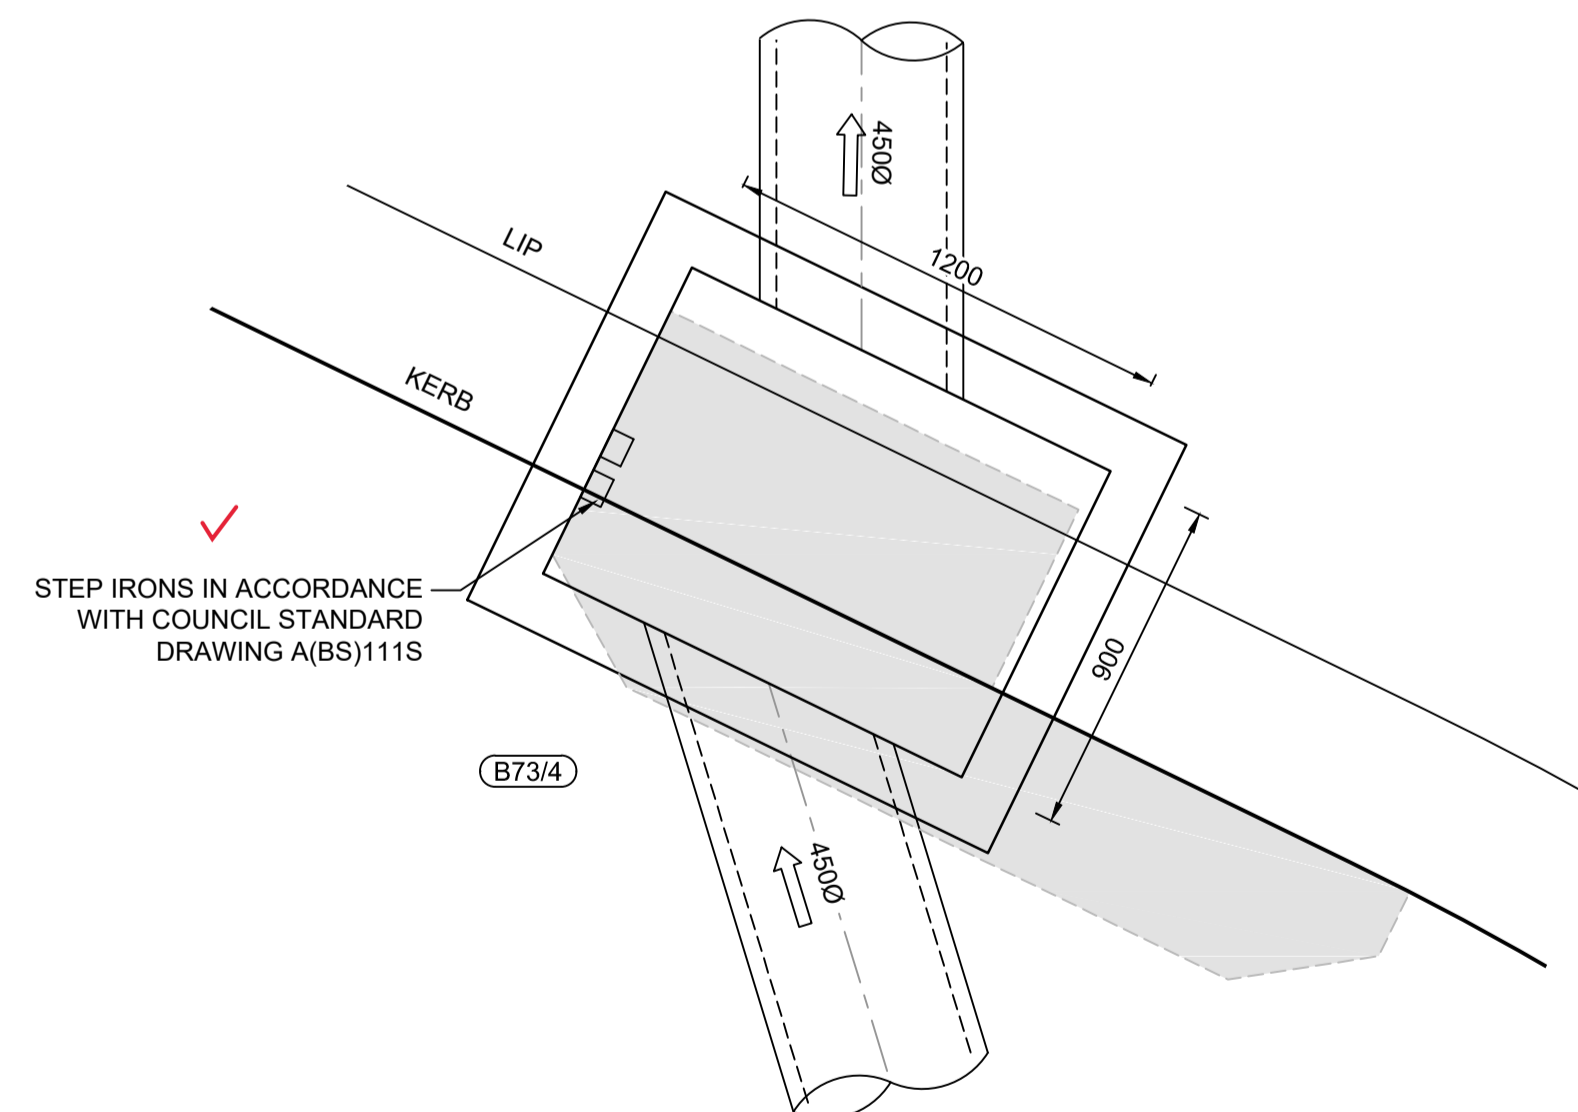

SPECIAL PIT - B73/4
SCALE 1:20

I hereby certify that engineering works shown on this plan have been constructed generally in accordance with Construction Certificate 16635 issued by Land Development Certificates


Signature *[Signature]*
PETER ROBERT WARWICK
 Registered Land Surveyor
VINCE MORGAN SURVEYORS PTY LTD

DATE 20/12/2022 REF 20260-7

These plans are referred to in certificate no. 16635 approved by:

LDC Christopher Louis Wahbe
 Registered Certifier
 Registration No: BDC 3015
 Categories: Certifier - Subdivision

Land Development Certificates
 www.LDC.com.au

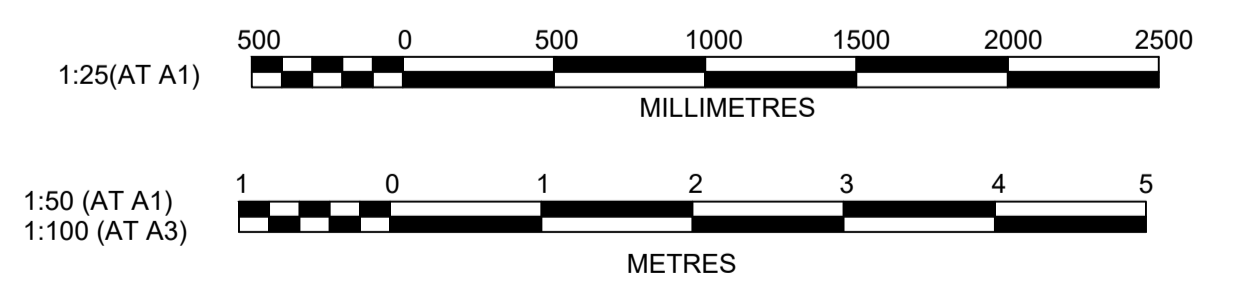

SPECIAL PITS B26/2, B72/2, B73/3 & B73/4 UPDATED

DES	DRN	CKD	APR	DATE		
B	PITS B26/2, B72/2, B73/3 & B73/4 UPDATED	DG	JM	MP	MS	14/09/21
A	ISSUE FOR APPROVAL	DG	JM	MP	PJM	12/08/21
	AMENDMENT	DES	DRN	CKD	APR	DATE

J. WYNDHAM PRINCE
 CONSULTING CIVIL INFRASTRUCTURE ENGINEERS & PROJECT MANAGERS

PO Box 4366 PENRITH WESTFIELD NSW 2750
 P 02 4720 3300 W www.jwprince.com.au E jwp@jwprince.com.au

CLIENT:

WINTEN PROPERTY GROUP

STATUS: **ISSUE FOR CONSTRUCTION APPROVAL**

THIS DRAWING MUST NOT BE USED FOR CONSTRUCTION UNLESS SIGNED AS PART OF AN APPROVED CONSTRUCTION CERTIFICATE.

NEWPARK PRECINCT 7, STAGE 7B
 SPECIAL PIT DETAILS
 SHEET 13

PROJECT No: **9985-12**
 SHEET No: **CC5562**

AZIMUTH: M.G.A.94 DATUM: A.H.D. ORIGIN: SSM 1112 PLAN No: **9985-12-CC5562**

PROJECT No: **9985-12**
 SHEET No: **CC5562**

Plotted: 14 September, 2021 11:42 PM File Name: J:\9985\BDC - Construction Certificate Approval Plans\PK12 WESTERN PRECINCTS\6 - Precinct 7\9985-12-CC5562.dwg

SOIL AND WATER MANAGEMENT NOTES

GENERAL NOTES:

- ALL EROSION AND SEDIMENT CONTROL MEASURES, INCLUDING REVEGETATION AND STORAGE OF SOIL AND TOPSOIL, SHALL BE IMPLEMENTED TO THE REQUIREMENTS OF THE "SOILS AND CONSTRUCTION - VOLUME 1, 4TH EDITION, MARCH 2004".
- TOPSOIL FROM ALL AREAS TO BE DISTURBED SHALL BE STOCKPILED AND LATER RESPREAD TO AID REVEGETATION IN THOSE AREAS.
- ALL DRAINAGE WORKS SHALL BE CONSTRUCTED AND STABILISED AS EARLY AS POSSIBLE DURING DEVELOPMENT.
- ALL TAIL-OUT DRAINS SHALL BE COUCH GRASSED AND TRAPEZOIDAL IN SECTION. STRAW BALES SHALL BE PLACED AS A SEDIMENT CONTROL DEVICE WHERE REQUIRED.
- VEHICULAR TRAFFIC SHALL BE CONTROLLED DURING DEVELOPMENT CONFINING ACCESS WHERE POSSIBLE TO PROPOSED OR EXISTING ROAD ALIGNMENTS. AREAS TO BE LEFT UNDISTURBED SHALL BE MARKED OFF.
- ROADS SHALL BE PAVED AS EARLY AS POSSIBLE AFTER FORMATION.
- DISTURBANCE OF VEGETATION SHALL BE LIMITED TO FILL AREAS, ROADWAYS AND DRAINAGE LINES. NO LOT GRADINGS SHALL BE CARRIED OUT IN UNDISTURBED AREAS WITHOUT CONSULTATION WITH COUNCIL'S ENGINEER.
- ALL DISTURBED AREAS SHALL BE REVEGETATED AS SOON AS THE RELEVANT WORKS ARE COMPLETED.
- ALL SEDIMENT BASINS AND TRAPS SHALL BE CLEANED WHEN THE STRUCTURES ARE A MAXIMUM 60% FULL OF SOLID MATERIALS, INCLUDING DURING THE MAINTENANCE PERIOD.
- THE SOIL AND WATER MANAGEMENT PLAN IS TO BE READ IN CONJUNCTION WITH THE ENGINEERING PLANS, AND COUNCIL'S WRITTEN GUIDELINES FOR THE DEVELOPMENT OF LAND.
- CONTRACTORS SHALL ENSURE THAT ALL SOIL AND WATER MANAGEMENT WORKS ARE UNDERTAKEN AS SPECIFIED ON THE PLAN AND IN ACCORDANCE WITH THE GUIDELINES SHOWN IN "MANAGING URBAN STORMWATER - SOILS AND CONSTRUCTION 4TH EDITION" ("THE BLUE BOOK").
- ALL CONTRACTORS AND SUBCONTRACTORS ARE RESPONSIBLE FOR REDUCING THE SOIL EROSION AND POLLUTION OF DOWNSLOPE AREAS.
- THE SOIL EROSION HAZARD ON THE SITE IS TO BE KEPT AS LOW AS POSSIBLE AND GENERALLY IN ACCORDANCE WITH THE FOLLOWING SCHEDULE:

LAND USE	LIMITATION	COMMENTS
CONSTRUCTION AREAS	DISTURBANCE TO BE NO FURTHER THAN 5m (PREF 2m) FROM THE EDGE OF ANY ESSENTIAL ENGINEERING ACTIVITY AS SHOWN ON THESE PLANS	ALL SITE WORKERS WILL CLEARLY RECOGNISE THESE ZONES - WHERE APPROPRIATE THE CONSTRUCTION AREAS ARE TO BE IDENTIFIED WITH BARRIER FENCING (DOWNSLOPE) OR SIMILAR MATERIAL.
ACCESS AREAS	LIMITED TO A MAXIMUM WIDTH OF 10m	THE SITE MANAGER SHALL DETERMINE AND MARK THE LOCATION OF THESE ZONES ON SITE. THEY CAN VARY IN POSITION TO BEST CONSERVE THE EXISTING VEGETATION AND PROTECT DOWNSTREAM AREAS WHILE BEING CONSIDERATE OF THE NEEDS OF EFFICIENT WORKS ACTIVITIES. ALL SITE WORKERS SHALL CLEARLY RECOGNISE THEIR BOUNDARIES. WHERE APPROPRIATE THE ACCESS AREAS ARE TO BE MARKED WITH BARRIER MESH, SEDIMENT FENCING OR SIMILAR MATERIALS.
REMAINING LANDS	ENTRY PROHIBITED EXCEPT FOR ESSENTIAL THINNING OF PLANT GROWTH	THINNING OF GROWTH MAY BE REQUIRED FOR FIRE HAZARD REDUCTION.

NOTE:
WORKS WITHIN WATERWAYS AND CREEKS SHALL BE RESTRICTED AS DIRECTED - ALL LANDS WITHIN CREEKS AND WATERWAYS SHALL HAVE A GROUND COVER MORE THAN 70%, USING MATERIALS THAT CAN CATER FOR CONCENTRATED FLOWS.

- WORKS ARE TO BE UNDERTAKEN IN THE FOLLOWING SEQUENCE. EACH SUBSEQUENT STAGE IS NOT TO COMMENCE UNTIL THE PREVIOUS ONE IS COMPLETE.
 - INSTALL ALL BARRIER AND SEDIMENT FENCING WHERE SHOWN ON THE PLAN AND TO DETAIL (SD) 6-8.
 - CONSTRUCT STABILISED SITE ACCESS AS SHOWN ON THE PLAN AND TO DETAIL (SD) 6-14.
 - CONSTRUCT LOW FLOW EARTH BANKS WHERE SHOWN ON THE PLAN AND TO DETAIL (SD) 5-5.
 - PROVIDE TEMP. ACCESS TO THE SEDIMENT BASIN(S) AND PROTECT THIS WITH SEDIMENT FENCING (SD) 6-8 OR BARRIER FENCING AND EARTH BANKS (SD) 5-5.
 - PLACE SEDIMENT FENCING (SD) 6-8 DOWNSLOPE OF LANDS TO BE DISTURBED FOR CONSTRUCTION OF THE SEDIMENT BASINS.
 - CONSTRUCT SEDIMENT BASIN(S) GENERALLY IN ACCORDANCE WITH (SD) 6-4
 - STABILISE LAND SURFACES DISTURBED BY CONSTRUCTION OF THE SEDIMENT BASIN(S) AS SOON AS FINAL LEVELS ARE ESTABLISHED
 - CLEAR THE SITE AND STRIP AND STOCKPILE THE TOPSOIL IN THE LOCATIONS SHOWN ON THE PLAN OR AS DIRECTED BY THE SITE SUPERINTENDENT TO DETAIL (SD) 4-1.
 - UNDERTAKE ALL ESSENTIAL CONSTRUCTION WORKS.
 - GRADE LOT AREAS TO FINAL GRADES AND APPLY PERMANENT STABILISATION (LANDSCAPING) WITHIN 14 DAYS OF COMPLETION OF CONSTRUCTION WORKS.
 - REMOVE TEMPORARY EROSION CONTROL MEASURES AFTER THE PERMANENT LANDSCAPING HAS BEEN COMPLETED.
- CLEARLY VISIBLE BARRIER FENCING SHALL BE INSTALLED WHERE DIRECTED BY THE SITE SUPERINTENDENT TO CONTROL AND PROHIBIT UNNECESSARY SITE DISTURBANCE
- EARTH BATTERS SHALL BE CONSTRUCTED WITH AS LOW A GRADIENT AS PRACTICABLE BUT NO STEEPER THAN:-
 - 2(h) - 1(v) WHERE SLOPE LENGTH IS LESS THAN 7m
 - 2.5(h) - 1(v) WHERE SLOPE LENGTH IS BETWEEN 7m AND 10m
 - 3(h) - 1(v) WHERE SLOPE LENGTH IS BETWEEN 10m AND 12m
 - 4(h) - 1(v) WHERE SLOPE LENGTH IS BETWEEN 12m AND 18m
 - 5(h) - 1(v) WHERE SLOPE LENGTH IS BETWEEN 18m AND 27m
 - 6(h) - 1(v) WHERE SLOPE LENGTH IS GREATER THAN 27m

SLOPE LENGTHS CAN BE SHORTENED BY USING LOW FLOW EARTH BANKS AS CATCH DRAINS ABOVE THE EARTH BATTER AREA.

- PROTECTION FROM EROSION FORCES SHALL BE UNDERTAKEN ON ALL LANDS. GROUND COVER TO BE IN PLACE WITHIN 10 WORKING DAYS FROM COMPLETION OF FORMATION AND BEFORE THEY ARE ALLOWED TO CARRY ANY CONCENTRATED FLOWS.
- TEMPORARY GROUND COVER SHOULD BE MINIMUM 70%. FOOT AND VEHICULAR TRAFFIC SHALL BE KEPT AWAY FROM REHABILITATED AREAS.
- WHERE POSSIBLE THE CONSTRUCTION PROGRAM IS TO SCHEDULE WORKS SUCH THAT LAND DISTURBANCE ACTIVITIES ARE COMPLETED IN LESS THAN 6 MONTHS. REVEGETATION WORKS MUST BE CARRIED OUT AS STIPULATED IN THE RELEVANT COUNCIL GUIDELINES / SPECIFICATIONS SUCH THAT A SATISFACTORY GROUND COVER IS PROVIDED TO AT LEAST 60% OF THE DISTURBED AREA WITHIN 10 DAYS AND AT LEAST 70% OF THE DISTURBED AREA WITHIN A FURTHER 60 DAYS..
- SEDIMENT FENCES (SD) 6-8 SHALL:-
 - BE INSTALLED WHERE SHOWN ON THE PLAN AND AS DIRECTED AT THE DISCRETION OF THE SITE SUPERINTENDENT DURING THE COURSE OF CONSTRUCTION TO CONTAIN THE COARSER SEDIMENT FRACTIONS AS NEAR AS POSSIBLE TO THEIR SOURCE.
 - HAVE A CATCHMENT AREA NOT EXCEEDING 720sq.m, AND A STORAGE DEPTH OF AT LEAST 0.6m.
 - PROVIDE AN UPSLOPE RETURN OF 1m AT INTERVALS ALONG THE FENCE WHERE THE CATCHMENT AREA EXCEEDS 720sq.m. TO LIMIT THE DISCHARGE REACHING EACH SECTION TO 50litres/sec IN A MAX. 10yr Tc DISCHARGE.
- STOCKPILES (SD) 4-1 SHALL BE LOCATED AS SHOWN ON THE PLANS AND AT THE DISCRETION OF THE SITE SUPERINTENDENT.
- DURING WINDY WEATHER LARGE UNPROTECTED AREAS ARE TO BE KEPT MOIST (NOT WET) BY SPRINKLING WITH WATER TO KEEP DUST UNDER CONTROL. IN THE EVENT WATER IS NOT AVAILABLE IN SUFFICIENT QUANTITIES SOIL BINDERS AND/OR DUST RETARDANTS SHALL BE USED OR THE SURFACE SHALL BE LEFT IN A CLODDY STATE THAT RESISTS REMOVAL BY WIND.
- STOCKPILES SHALL NOT BE LOCATED WITHIN 5m OF HAZARD AREAS, INCLUDING LIKELY AREAS OF HIGH VELOCITY FLOWS SUCH AS WATERWAYS, PAVED AREAS OR DRIVEWAYS.
- THE SEDIMENT RETENTION BASINS (SD) 6-4 SHALL:-
 - BE CONSTRUCTED WHERE SHOWN ON THE PLANS.
 - BE FLOCCULATED (APPENDIX E MANAGING URBAN STORMWATER SOILS & CONSTRUCTION 4TH ED.) BEFORE DISCHARGE OCCURS (UNLESS THE DESIGN STORM EVENT IS EXCEEDED)
 - HAVE ONE OR MORE PEGS PLACED ON THE FLOOR TO CLEARLY INDICATE THE LEVEL AT WHICH DESIGN CAPACITY OCCURS AND WHEN SEDIMENT SHALL BE REMOVED.
- STORED CONTENTS OF THE BASINS SHALL BE TREATED WITH GYPSUM (APPENDIX E MANAGING URBAN STORMWATER SOILS & CONSTRUCTION 4TH ED.) OR OTHER FLOCCULATING AGENTS WHERE THEY CONTAIN MORE THAN 50mg/litre OF SUSPENDED SOLIDS. TREATMENT SHALL BE AS FOLLOWS:-
 - LOWER SUSPENDED SOLIDS TO LESS THAN 50mg/litre WITHIN 24hrs OF FILLING
 - THE BASINS SHALL THEN BE ALLOWED TO STAND 36 TO 48hrs FOR FLOCCULATED PARTICLES TO SETTLE
 - THE BASINS SHALL THEN BE DRAINED SO THAT FULL STORAGE CAPACITY IS REGAINED WITHOUT DISCHARGING SEDIMENT FROM THE SITE.
- SEDIMENT REMOVED FROM ANY TRAPPING DEVICE SHALL BE DISPOSED IN LOCATIONS WHERE FURTHER EROSION AND CONSEQUENT POLLUTION TO DOWNSLOPE LANDS AND WATERWAYS SHALL NOT OCCUR.
- WATER SHALL BE PREVENTED FROM DIRECTLY ENTERING THE PERMANENT DRAINAGE SYSTEM UNLESS IT IS RELATIVELY SEDIMENT FREE (ie THE CATCHMENT HAS BEEN LANDSCAPED AND/OR ANY LIKELY SEDIMENT HAS BEEN TREATED IN AN APPROVED DEVICE) NEVERTHELESS STORMWATER INLETS SHALL BE PROTECTED (SD) 6-11 & 6-12.
- TEMPORARY SOIL AND WATER MANAGEMENT STRUCTURES SHALL BE REMOVED ONLY AFTER THE LANDS THEY ARE PROTECTING ARE STABILISED.
- ACCEPTABLE BINS SHALL BE PROVIDED FOR ANY CONCRETE AND MORTAR SLURRIES, PAINTS, ACID WASHINGS, LIGHTWEIGHT WASTE MATERIALS AND LITTER. CLEARANCE SERVICES SHALL BE PROVIDED AT LEAST ONCE A WEEK.

STOCKPILE NOTES:

- SPOIL AND TOPSOIL STOCKPILES SHALL BE LOCATED AWAY FROM DRAINAGE LINES AND AREAS WHERE WATER MAY CONCENTRATE.
- IF STOCKPILES ARE TO BE IN PLACE FOR LONGER THAN 14 DAYS THEN THEY SHALL BE STABILIZED BY COVERING WITH A MULCH OR WITH TEMPORARY VEGETATION.
- FOLLOWING CONSTRUCTION, TOPSOIL SHALL BE RESPREAD TO A MINIMUM DEPTH OF 100mm ON THE BARE SOIL SURFACES AND REVEGETATED.

SEDIMENTATION CONTROL DEVICES:

- ALL STRAW BALES SHALL BE BOUND WITH WIRE. STRAW BALES SHALL BE PLACED END TO END IN A SINGLE ROW AND EMBEDDED INTO THE SOIL TO A DEPTH OF 100mm. EACH BALE SHALL BE SECURELY ANCHORED WITH TWO STEEL STAKES DRIVEN 600mm INTO THE GROUND AND LOCKED ON THE BALE CENTRELINE.
- SILT FENCES SHALL BE CONSTRUCTED BY STRETCHING A FILTER FABRIC (PROPEX OR SIMILAR) BETWEEN POSTS AT 2.5m CENTRES. FABRIC SHALL BE BURIED 150mm ALONG ITS LOWER EDGE.
- PROVIDE STRIP OF TURF MIN. 300mm WIDE BEHIND KERB + 1m WIDE AROUND ALL SURFACE INLET PITS

SITE INSPECTION AND MAINTENANCE:

- A SELF-AUDITING PROGRAM SHALL BE ESTABLISHED BASED ON A INSPECTION TEST PLAN (ITP) OR LOG BOOK. A SITE INSPECTION USING THE ITP SHALL BE MADE BY THE SITE MANAGER:-
 - AT LEAST WEEKLY
 - IMMEDIATELY BEFORE SITE CLOSURE
 - IMMEDIATELY FOLLOWING RAINFALL EVENTS IN EXCESS OF 5mm IN ANY 24hr PERIOD.

THE SELF AUDIT SHALL INCLUDE:-

 - RECORDING THE CONDITION OF EVERY 'BEST MANAGEMENT PRACTICE' EMPLOYED
 - RECORDING MAINTENANCE REQUIREMENTS (IF ANY) FOR EACH 'BEST MANAGEMENT PRACTICE'
 - RECORDING THE VOLUMES OF SEDIMENT REMOVED FROM SEDIMENT RETENTION SYSTEMS WHERE APPLICABLE
 - RECORDING THE SITE WHERE SEDIMENT IS DISPOSED
 - FORWARDING A SIGNED DUPLICATE OF THE COMPLETED CHECK SHEET TO THE PROJECT MANAGER/DEVELOPER FOR THEIR INFORMATION.
- IN ADDITION A SUITABLY QUALIFIED PERSON SHALL BE RESPONSIBLE FOR OVERSEEING THE INSTALLATION AND MAINTENANCE OF ALL SOIL AND WATER MANAGEMENT WORKS ON THE SITE. THE PERSON SHALL BE REQUIRED TO SPEND A MINIMUM OF:-
 - 2hrs ONSITE EACH FORTNIGHT UP UNTIL COMPLETION OF ROAD AND DRAINAGE WORKS AND/OR THE COMMISSIONING OF SEDIMENT BASIN(S)/WATER QUALITY CONTROL FACILITIES, AND DURING THE DECOMMISSIONING OF SAME AND/OR FINAL SITE STABILISATION. TO PROVIDE A SHORT MONTHLY WRITTEN REPORT.
 - ONE HOUR ONSITE EACH 2 MONTHS DURING THAT PHASE WHERE THE DEVELOPERS RESPONSIBILITIES ARE LIMITED TO MAINTENANCE OF THE SDS DEVICES AND/OR SEDIMENT BASINS (ie DURING THE STAGE WHEN BUILDING WORKS CAN BE UNDERTAKEN) TO PROVIDE A SHORT WRITTEN REPORT EACH 4 MONTHS

THE RESPONSIBLE PERSON SHALL ENSURE THAT:-

 - THIS PLAN IS BEING IMPLEMENTED CORRECTLY
 - REPAIRS ARE BEING UNDERTAKEN AS REQUIRED
 - ESSENTIAL MODIFICATIONS TO THIS PLAN ARE BEING MADE IF AND WHEN NECESSARY. EACH REPORT SHALL CERTIFY THAT WORKS HAVE BEEN CARRIED OUT ACCORDING TO THE APPROVED PLANS.
- WASTE BINS SHALL BE EMPTIED AS NECESSARY, DISPOSAL OF WASTE SHALL BE IN A MANNER APPROVED BY THE SITE SUPERINTENDENT
- PROPER DRAINAGE OF THE SITE SHALL BE MAINTAINED. DRAINS (INCLUDING INLET AND OUTLET WORKS) SHALL BE CHECKED TO ENSURE THAT THEY ARE OPERATING AS INTENDED, ESPECIALLY THAT:-
 - NO LOW POINTS EXIST WHICH CAN OVERTOP IN A LARGE STORM EVENT.
 - AREAS OF EROSION ARE REPAIRED (eg LINED WITH SUITABLE MATERIAL) AND/OR VELOCITY OF FLOW IS REDUCED APPROPRIATELY THROUGH CONSTRUCTION OF SMALL CHECK DAMS OR INSTALLING ADDITIONAL DIVERSIONS UPSLOPE
 - BLOCKAGES ARE CLEARED (THESE MIGHT OCCUR BECAUSE OF SEDIMENT POLLUTION, SAND/SOIL/SPOIL BEING DEPOSITED IN OR TOO CLOSE TO THEM, BREACHED BY VEHICLE WHEELS etc)
- SAND/SOIL/SPOIL MATERIALS PLACED CLOSER THAN 2m FROM HAZARD AREAS SHALL BE REMOVED SUCH HAZARD AREAS INCLUDE ANY AREAS OF HIGH VELOCITY WATER FLOWS (eg WATERWAYS AND GUTTERS) PAVED AREAS AND DRIVEWAYS.
- RECENTLY STABILISED LANDS SHALL BE CHECKED TO ENSURE THAT THE EROSION HAZARD HAS BEEN EFFECTIVELY REDUCED. ANY REPAIRS SHALL BE INITIATED AS APPROPRIATE.
- EXCESSIVE VEGETATIVE GROWTH SHALL BE CONTROLLED THROUGH MOWING OR SLASHING.
- ALL SEDIMENT DETENTION SYSTEMS SHALL BE KEPT IN GOOD WORKING CONDITION. IN PARTICULAR ATTENTION SHALL BE GIVEN TO:-
 - RECENT WORKS TO ENSURE THAT THEY HAVE NOT RESULTED IN DIVERSION OF SEDIMENT LADEN WATER AWAY FROM THEM
 - DEGRADABLE PRODUCTS TO ENSURE THAT THEY ARE REPLACED AS REQUIRED
 - SEDIMENT REMOVAL TO ENSURE THE DESIGN CAPACITY OR LESS REMAINS IN THE SETTLING ZONE.
- ADDITIONAL EROSION AND/OR SEDIMENT CONTROL WORKS SHALL BE CONSTRUCTED AS MIGHT BECOME NECESSARY TO ENSURE THE DESIRED PROTECTION IS GIVEN TO DOWNSLOPE LANDS AND WATERWAYS (ie MAKE ONGOING CHANGES TO THIS PLAN WHERE IT PROVES INADEQUATE IN PRACTICE OR IS SUBJECTED TO CHANGES IN CONDITIONS AT THE WORKS SITE OR ELSEWHERE IN THE CATCHMENT.
- EROSION AND SEDIMENT CONTROL MEASURES SHALL BE MAINTAINED IN A FUNCTIONING CONDITION UNTIL ALL EARTHWORKS ACTIVITIES ARE COMPLETED AND THE SITE STABILISED.
- WATERS IN SEDIMENT RETENTION BASIN(S) THAT OCCUPY MORE THAN 1/4 OF THE DESIGN CAPACITY DURING THAT STAGE OF THE WORKS UP UNTIL COMMISSIONING OF THE BASIN(S) SHALL BE:-
 - TREATED WITH A FLOCCULATING AGENT (APPENDIX E MANAGING URBAN STORMWATER SOILS & CONSTRUCTION 4TH ED.)
 - DISCHARGED WITHIN 5 days FROM THE CONCLUSION OF ANY STORM EVENT LARGE ENOUGH TO FILL THE BASIN TO THAT LEVEL.
- LITTER, DEBRIS AND COARSE SEDIMENT SHALL BE REMOVED FROM THE GROSS POLLUTANT TRAPS AND TRASH RACKS AS REQUIRED.

I hereby certify that engineering works shown on this plan have been constructed generally in accordance with Construction Certificate 16635 issued by Land Development Certificates

Signature.....
PETER ROBERT WARWICK
 Registered Land Surveyor
VINCE MORGAN SURVEYORS PTY LTD

DATE 20/12/2022 REF 20260-7

These plans are referred to in certificate no. 16635 approved by:
Christopher Louis Wahbe
 Registered Certifier
 Registration No: BDC 3015
 Categories: Certifier - Subdivision
Land Development Certificates
 www.LDC.com.au

Plotfile: 14 September, 2021 1:15:17 PM File Name: J:\0985DCC - Construction Certificate Approval Plans\PK12 WESTERN PRECINCTS\5 - Precinct 7\0985-12-CC5700.dwg

A	ISSUE FOR APPROVAL	DG	VS	MP	PJM	12/08/21	
	AMENDMENT	DES	DRN	CKD	APR	DATE	

J. WYNDHAM PRINCE
 CONSULTING CIVIL INFRASTRUCTURE ENGINEERS & PROJECT MANAGERS

PO Box 4366 PENRITH WESTFIELD NSW 2750
 P 02 4720 3300 W www.jwprince.com.au E jwp@jwprince.com.au

CLIENT:
 **WINTAN PROPERTY GROUP**

STATUS:
ISSUE FOR CONSTRUCTION APPROVAL

THIS DRAWING MUST NOT BE USED FOR CONSTRUCTION UNLESS SIGNED AS PART OF AN APPROVED CONSTRUCTION CERTIFICATE.

NEWPARK PRECINCT 7, STAGE 7B
 SOIL & WATER MANAGEMENT NOTES

PROJECT No: **9985-12**
 SHEET No: **CC5700**

AZIMUTH: M.G.A.94 DATUM: A.H.D. ORIGIN: SSM 1112 PLAN No: **9985-12-CC5700**

PROJECT No: **9985-12**
 SHEET No: **CC5700**

LEGEND

	STABILISED SITE ACCESS & WHEEL WASH BAY
	SEDIMENT FENCE
	CATCH DRAIN
	STRAW BALE BARRIER
	STOCKPILE
	MESH AND GRAVEL INLET FILTER
	GEOTEXTILE INLET FILTER


LDC These plans are referred to in certificate no. 16635 approved by:
Christopher Louis Wahbe
Registered Certifier
Registration No: BDC 3015
Categories: Certifier - Subdivision
Land Development Certificates
www.LDC.com.au

PROTECTIVE FENCING REMOVED
SEDIMENT FENCE ADDED TO STOCKPILE

I hereby certify that engineering works shown on this plan have been constructed generally in accordance with Construction Certificate 16635 issued by Land Development Certificates

Signature:
PETER ROBERT WARWICK
Registered Land Surveyor
VINCE MORGAN SURVEYORS PTY LTD

DATE 20/12/2022 REF 20260-7

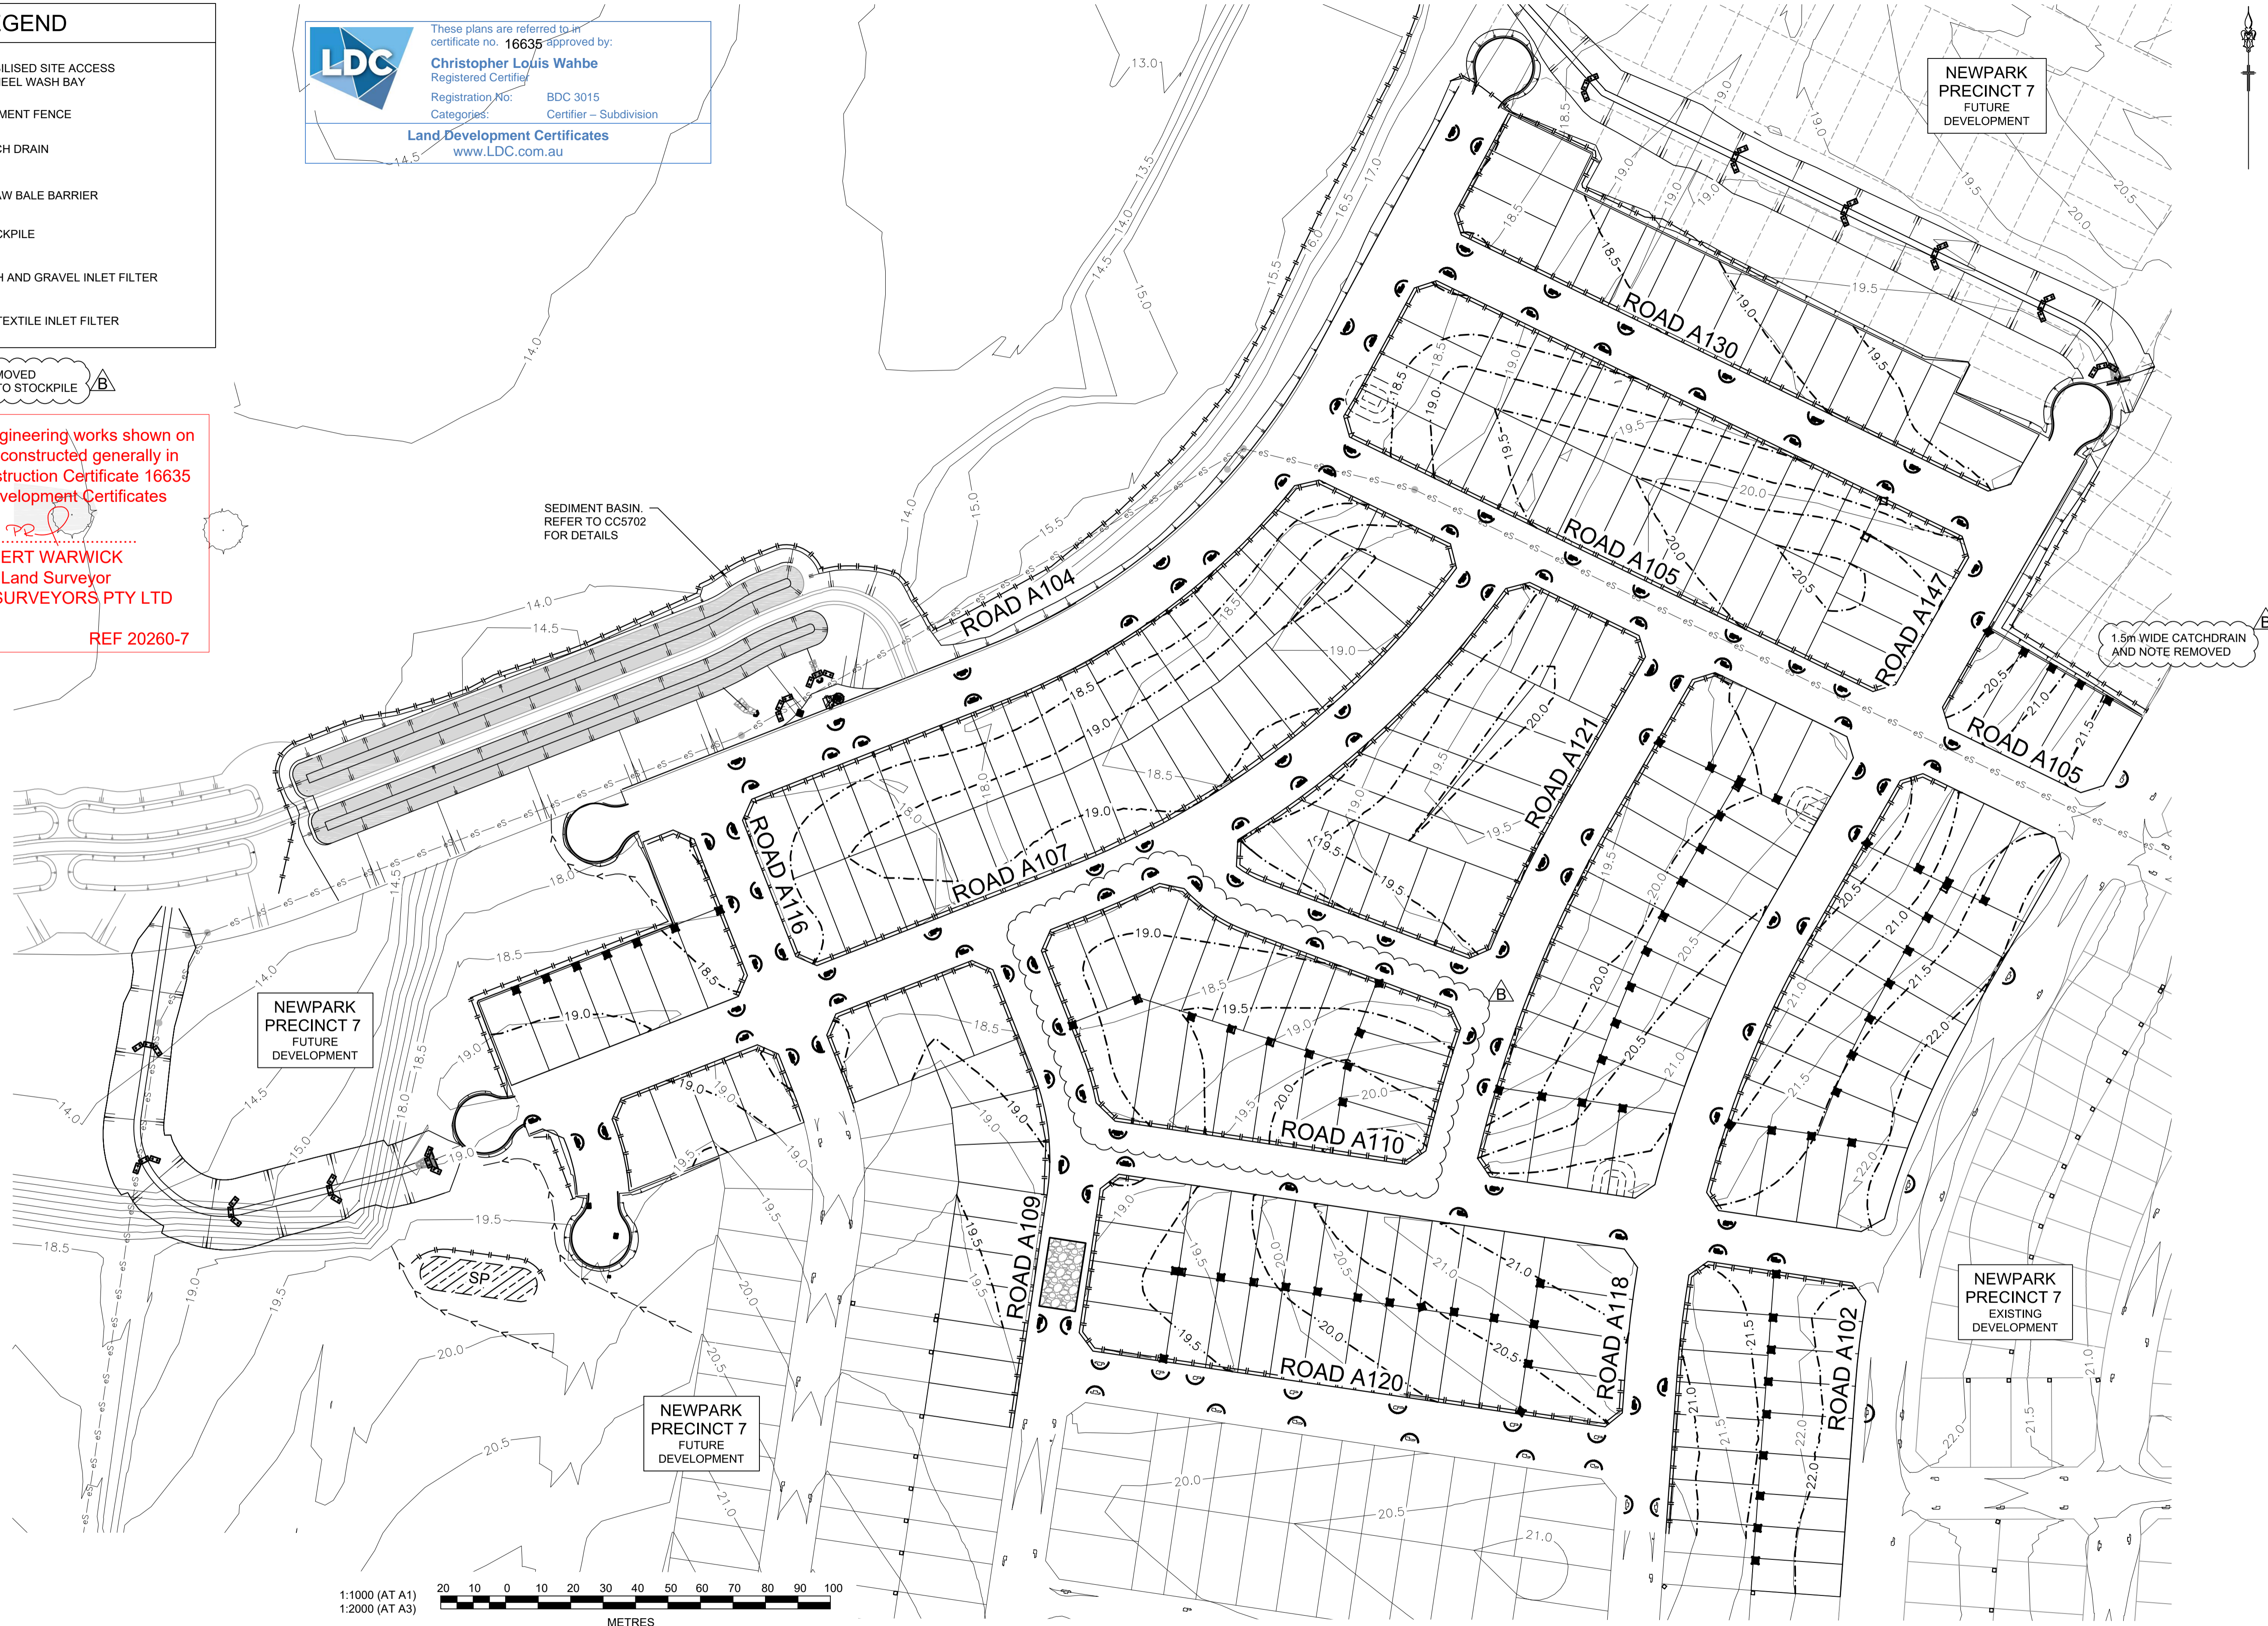

Plotfile: 14 September, 2021 1:17:13 PM File Name: J:\9985DCC - Construction Certificate Approval Plans\PK12 WESTERN PRECINCTS\6 - Precinct 7\9985-12-CC5701.dwg

AMENDMENT	DES	DRN	CKD	APR	DATE	
B	FENCING REMOVED, SEDIEMENT FENCE ADDED & CATCHDRAIN REMOVED	VS	NP	MP	MS	14/09/21
A	ISSUE FOR APPROVAL	DG	VS	MP	PJM	12/08/21

J. WYNDHAM PRINCE
CONSULTING CIVIL INFRASTRUCTURE ENGINEERS & PROJECT MANAGERS

PO Box 4366 PENRITH WESTFIELD NSW 2750
P 02 4720 3300 W www.jwprince.com.au E jwp@jwprince.com.au

CLIENT:

WINTER PROPERTY GROUP

STATUS: **ISSUE FOR CONSTRUCTION APPROVAL**

THIS DRAWING MUST NOT BE USED FOR CONSTRUCTION UNLESS SIGNED AS PART OF AN APPROVED CONSTRUCTION CERTIFICATE.




NEWPARK PRECINCT 7, STAGE 7B
SOIL & WATER MANAGEMENT PLAN

PROJECT No: **9985-12**
SHEET No: **CC5701**


AZIMUTH: M.G.A.94 DATUM: A.H.D. ORIGIN: SSM 1112 PLAN No: **9985-12-CC5701**

PROJECT No: **9985-12**
SHEET No: **CC5701**

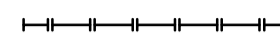
LEGEND

-  SEDIMENT FENCE
-  STRAW BALE BARRIER
-  MESH AND GRAVEL INLET FILTER

I hereby certify that engineering works shown on this plan have been constructed generally in accordance with Construction Certificate 16635 issued by Land Development Certificates

Signature: 
PETER ROBERT WARWICK
 Registered Land Surveyor
VINCE MORGAN SURVEYORS PTY LTD

DATE 20/12/2022 REF 20260-7

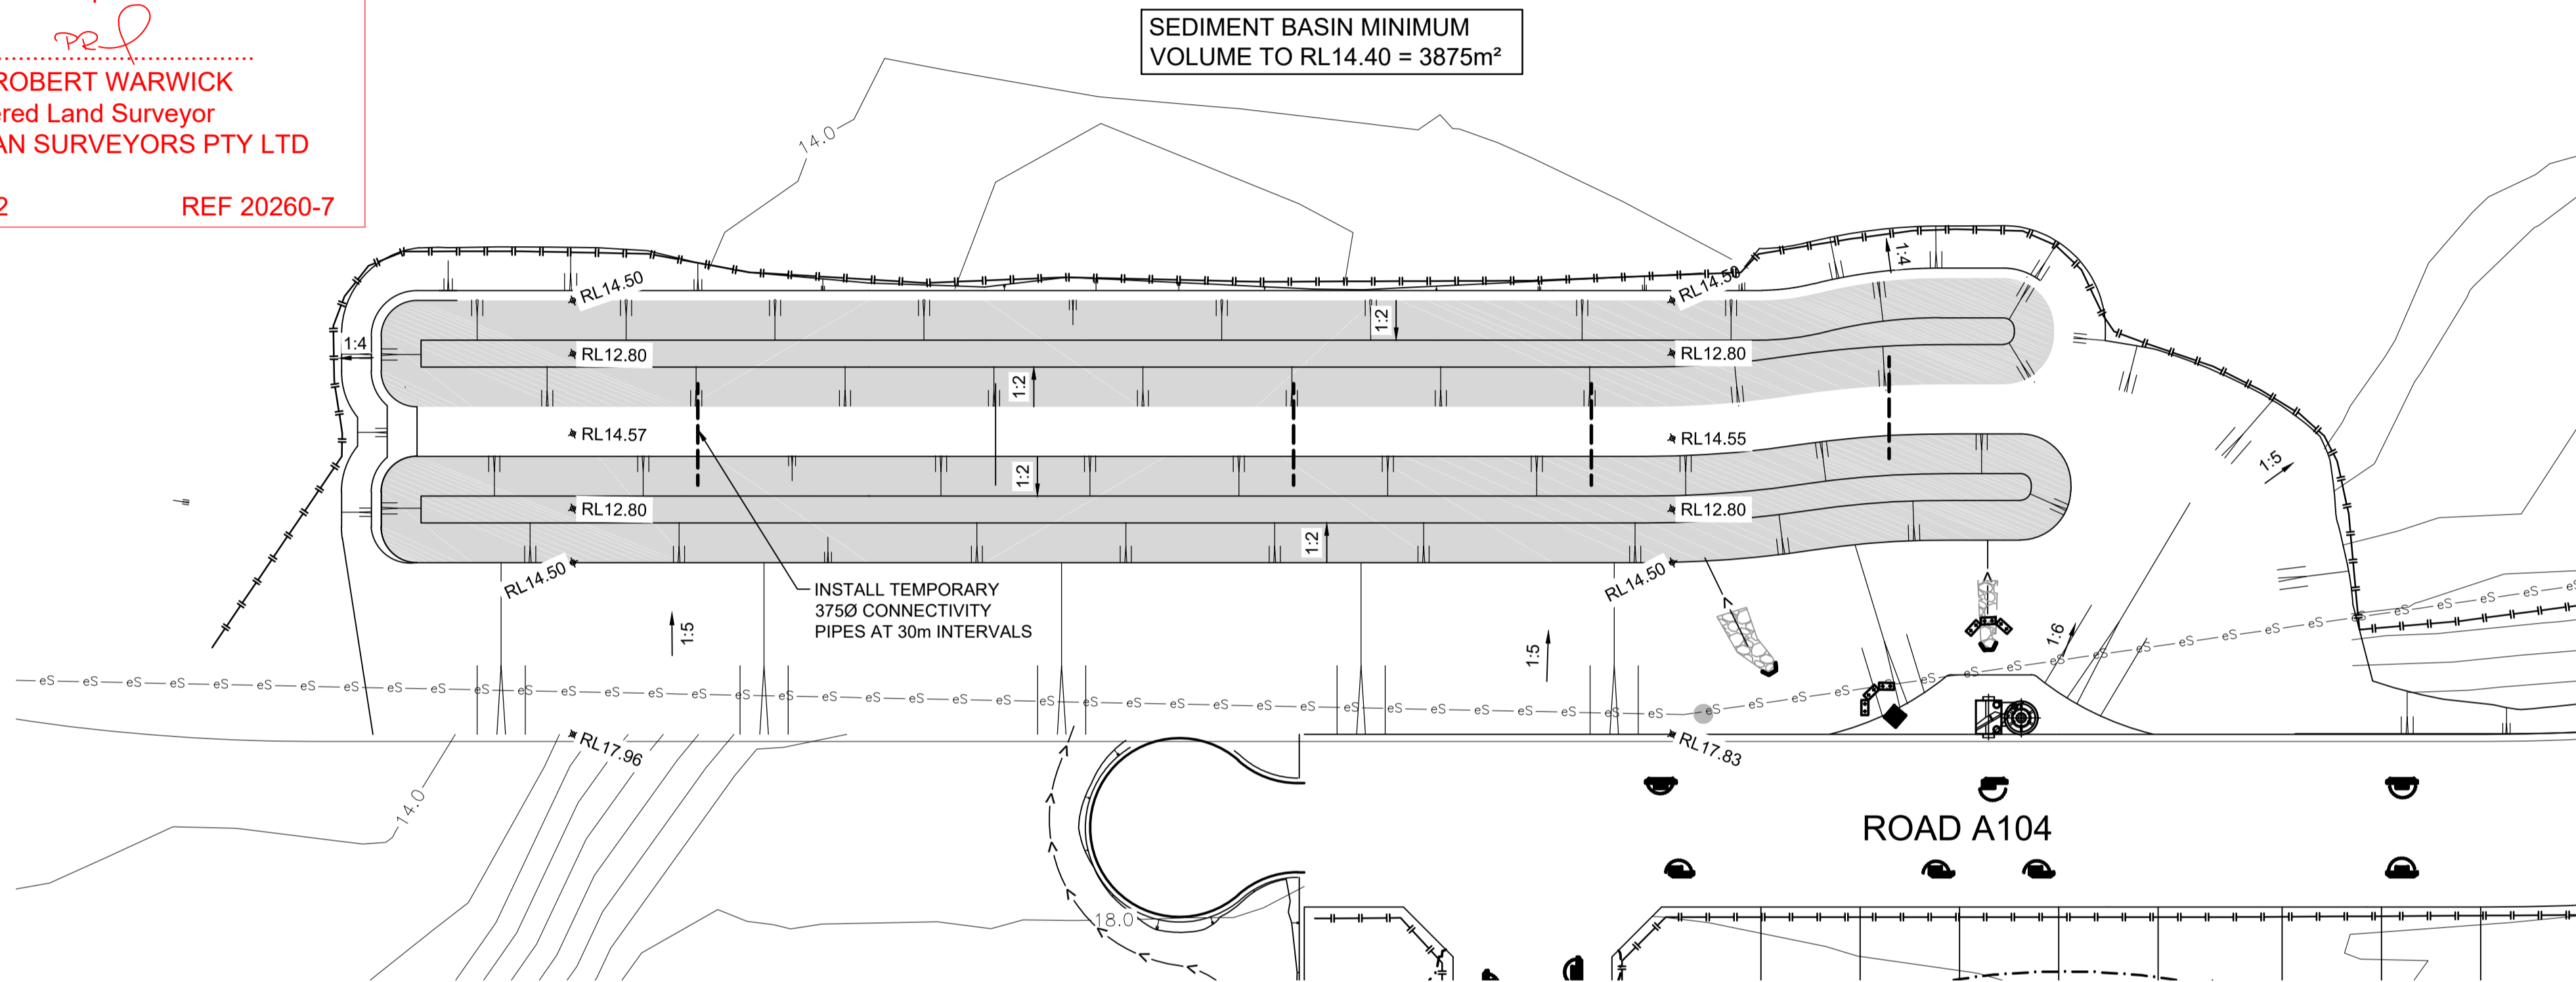

1. Site Data Sheet

Site Name:	NEWPARK PRECINCT 7B & 7C
Site Location:	MARSDEN PARK
Precinct:	BLACKTOWN CITY COUNCIL
Description of Site:	SEDIMENT BASIN TO SUPPORT THE PRECINCT 7B & 7C SUBDIVISION CONSTRUCTION

Site area	Site	Remarks
Total catchment area (ha)	P7BC	
Disturbed catchment area (ha)	22.2	

Soil analysis		
% sand (fraction 0.02 to 2.00 mm)		Soil texture should be assessed through mechanical dispersion only. Dispersing agents (e.g. Calgon) should not be used.
% silt (fraction 0.002 to 0.02 mm)	25	
% clay (fraction finer than 0.002 mm)	75	
Dispersion percentage	100.0	E.g. enter 10 for dispersion of 10%
% of whole soil dispersible	87.5	See Section 6.3.3(e)
Soil Texture Group	D	See Section 6.3.3(c), (d) and (e)

Rainfall data		
Design rainfall depth (days)	5	See Sections 6.3.4 (d) and (e)
Design rainfall depth (percentile)	85	See Sections 6.3.4 (f) and (g)
x-day, y-percentile rainfall event	32.2	See Section 6.3.4 (h)
Rainfall intensity: 2-year, 6-hour storm	10.1	See IFD chart for the site


RUSLE Factors		
Rainfall erosivity (R-factor)	2250	Automatic calculation from above data
Soil erodibility (K-factor)	0.038	
Slope length (m)	80	
Slope gradient (%)	2	RUSLE data can be obtained from Appendixes A, B and C
Length/gradient (LS-factor)	0.65	
Erosion control practice (P-factor)	1.3	
Ground cover (C-factor)	1	

Calculations		
Soil loss (t/ha/y)	72	
Soil Loss Class	1	See Section 4.4.2(b)
Soil loss (m ³ /ha/y)	56	
Sediment basin storage volume, m ³	210	See Sections 6.3.4(i) and 6.3.5 (e)

Total Basin Volume

Site	C _s	R ₂ , day, %/hr	Total catchment area (ha)	Settling zone volume (m ³)	Sediment storage volume (m ³)	Total basin volume (m ³)
P7BC	0.50	32.2	22.2	3574.2	210	3784.2

 These plans are referred to in certificate no. **16635** approved by:
Christopher Louis Wahbe
 Registered Certifier
 Registration No: BDC 3015
 Categories: Certifier – Subdivision
Land Development Certificates
 www.LDC.com.au

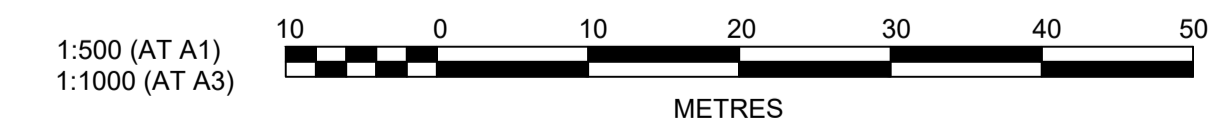

Plotted: 14 September, 2021 1:19:04 PM File Name: J:\9985DCC - Construction Certificate Approval Plans\PK12 WESTERN PRECINCTS\6 - Precinct 7B\9985-12-CC5702.dwg

NO.	DESCRIPTION	DES	DRN	CKD	APR	DATE
A	ISSUE FOR APPROVAL	DG	VS	MP	PJM	12/08/21
	AMENDMENT	DES	DRN	CKD	APR	DATE

J. WYNDHAM PRINCE
 CONSULTING CIVIL INFRASTRUCTURE ENGINEERS & PROJECT MANAGERS

PO Box 4366 PENRITH WESTFIELD NSW 2750
 P 02 4720 3300 W www.jwprince.com.au E jwp@jwprince.com.au

CLIENT:
 **WINTEN PROPERTY GROUP**

STATUS: **ISSUE FOR CONSTRUCTION APPROVAL**
 THIS DRAWING MUST NOT BE USED FOR CONSTRUCTION UNLESS SIGNED AS PART OF AN APPROVED CONSTRUCTION CERTIFICATE.

NEWPARK PRECINCT 7, STAGE 7B
 SEDIMENT BASIN DETAILS

AZIMUTH: M.G.A.94 DATUM: A.H.D. ORIGIN: SSM 1112 PLAN No: 9985-12-CC5702

PROJECT No: **9985-12**
 SHEET No: **CC5702**

A

REFER TO DRAWING CC5802 FOR CONTINUATION

REFER TO DRAWING CC5803 FOR CONTINUATION



REMOVE TEMPORARY CONCRETE BARRIER & SIGN

EXISTING

REMOVE TEMPORARY CONCRETE BARRIERS AND D4-5 SIGNAGE

THESE SIGNAGE AND LINEMARKING PLANS ARE SUBJECT TO APPROVAL BY BLACKTOWN CITY COUNCIL TRAFFIC COMMITTEE


NOTE: REFER TO CC5802 FOR LEGEND AND NOTES.

I hereby certify that engineering works shown on this plan have been constructed generally in accordance with Construction Certificate 16635 issued by Land Development Certificates

Signature: *[Signature]*
PETER ROBERT WARWICK
Registered Land Surveyor
VINCE MORGAN SURVEYORS PTY LTD

DATE 24/02/2023 REF 20260-7

1:500 (AT A1)
1:1000 (AT A3)

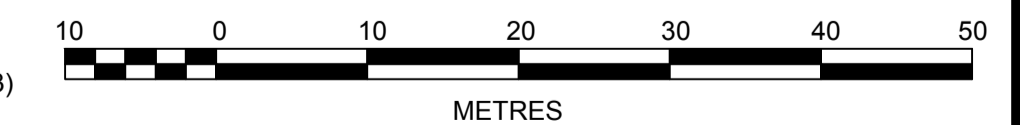

Plotfile: 20 January, 2022 4:26:32 PM File Name: J:\9985DJCC - Construction Certificate Approval Plans\PK12 WESTERN PRECINCTS16 - Precinct7\9985-12-CC5801.dwg

AMENDMENT	DES	DRN	CKD	APR	DATE
B	DG	NDW	DG	KE	20/01/22
A	DG	VS	MP	PJM	12/08/21

J. WYNDHAM PRINCE
CONSULTING CIVIL INFRASTRUCTURE ENGINEERS & PROJECT MANAGERS

PO Box 4366 PENRITH WESTFIELD NSW 2750
P 02 4720 3300 W www.jwprince.com.au E jwp@jwprince.com.au

CLIENT:



STATUS:

ISSUE FOR CONSTRUCTION APPROVAL

THIS DRAWING MUST NOT BE USED FOR CONSTRUCTION UNLESS SIGNED AS PART OF AN APPROVED CONSTRUCTION CERTIFICATE.

**NEWPARK
PRECINCT 7, STAGE 7B
SIGNAGE & LINE MARKING PLAN SHEET 1**

AZIMUTH: M.G.A.94 DATUM: A.H.D. ORIGIN: SSM 1112 PLAN No: 9985-12-CC5801

PROJECT No:

9985-12

SHEET No:

CC5801

B


PAVEMENT MARKING SCHEDULE

CODE	USE	STYLE	COLOUR & TYPE
BB	Barrier line where sight is restricted in both directions or approach to median island		Reflectorised white type 'Y' pavement markers bi-directional reflective yellow
C3	Kerbside Linemarking for No-Stopping Restrictions		Reflectorised yellow
E4	Outline of traffic island or freeway ramp gore		Reflectorised white type 'Y' OR 'R' pavement markers mono-directional reflective yellow or red
TB	Give way line (Used with Signs)		Reflectorised white
TB1	Give way line (Used on right side of side)		Reflectorised white
TBB	Give way line on Path		Reflectorised white
S4	Bicycle lane continuous separation line for off-road bike path		Reflectorised white
S5	Bicycle lane separation line for off-road bike path (straight sections)		Reflectorised white
TBB	Give way line on Path		Reflectorised white
(C)	Shared Path		Reflectorised white

NOTES

- ALL PAVEMENT MARKINGS, CHEVRONS AND REFLECTORS ARE TO BE IN ACCORDANCE WITH AUSTRROADS GUIDE TO TRAFFIC MANAGEMENT PART 6 AND AUSTRALIAN STANDARDS, AS1742-9 AND AS1743.
- ALL SIGNS TO BE IN ACCORDANCE WITH CURRENT AUSTRALIAN STANDARD, AS 1743 - ROAD SIGNS AND COUNCIL'S SPECIFICATION UNLESS OTHERWISE SHOWN.
- ROAD SIGNS ARE SIZE 'B', UNLESS OTHERWISE SHOWN. LOCATE OUTSIDE OF CLEAR ZONES.
- ALL NEW PAVEMENT MARKINGS ARE TO BE INSTALLED IN WHITE, REFLECTIVE, THERMOPLASTIC PAINT.
- KERBSIDE LANE WIDTHS INCLUDE THE WIDTH OF THE GUTTER.
- RE-MARK EXISTING PAVEMENT MARKINGS AS DIRECTED BY THE COUNCIL'S ENGINEER.
- PAVEMENT MARKINGS THAT FORM NO PART OF THE FINAL WORKS ARE TO BE REMOVED BY SAND BLASTING OR OTHER METHOD AS APPROVED BY THE PROJECT MANAGER.
- ALL MEASUREMENTS ARE IN METRES UNLESS OTHERWISE SHOWN.

THESE SIGNAGE AND LINEMARKING PLANS ARE SUBJECT TO APPROVAL BY BLACKTOWN CITY COUNCIL TRAFFIC COMMITTEE

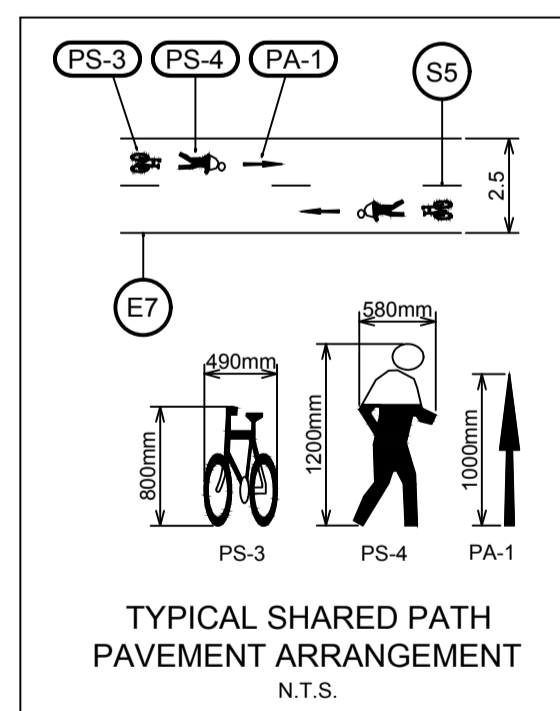


I hereby certify that engineering works shown on this plan have been constructed generally in accordance with Construction Certificate 16635 issued by Land Development Certificates

Signature:
PETER ROBERT WARWICK
Registered Land Surveyor
VINCE MORGAN SURVEYORS PTY LTD

DATE 24/02/2023 REF 20260-7

REFER TO DRAWING CC5803 FOR CONTINUATION

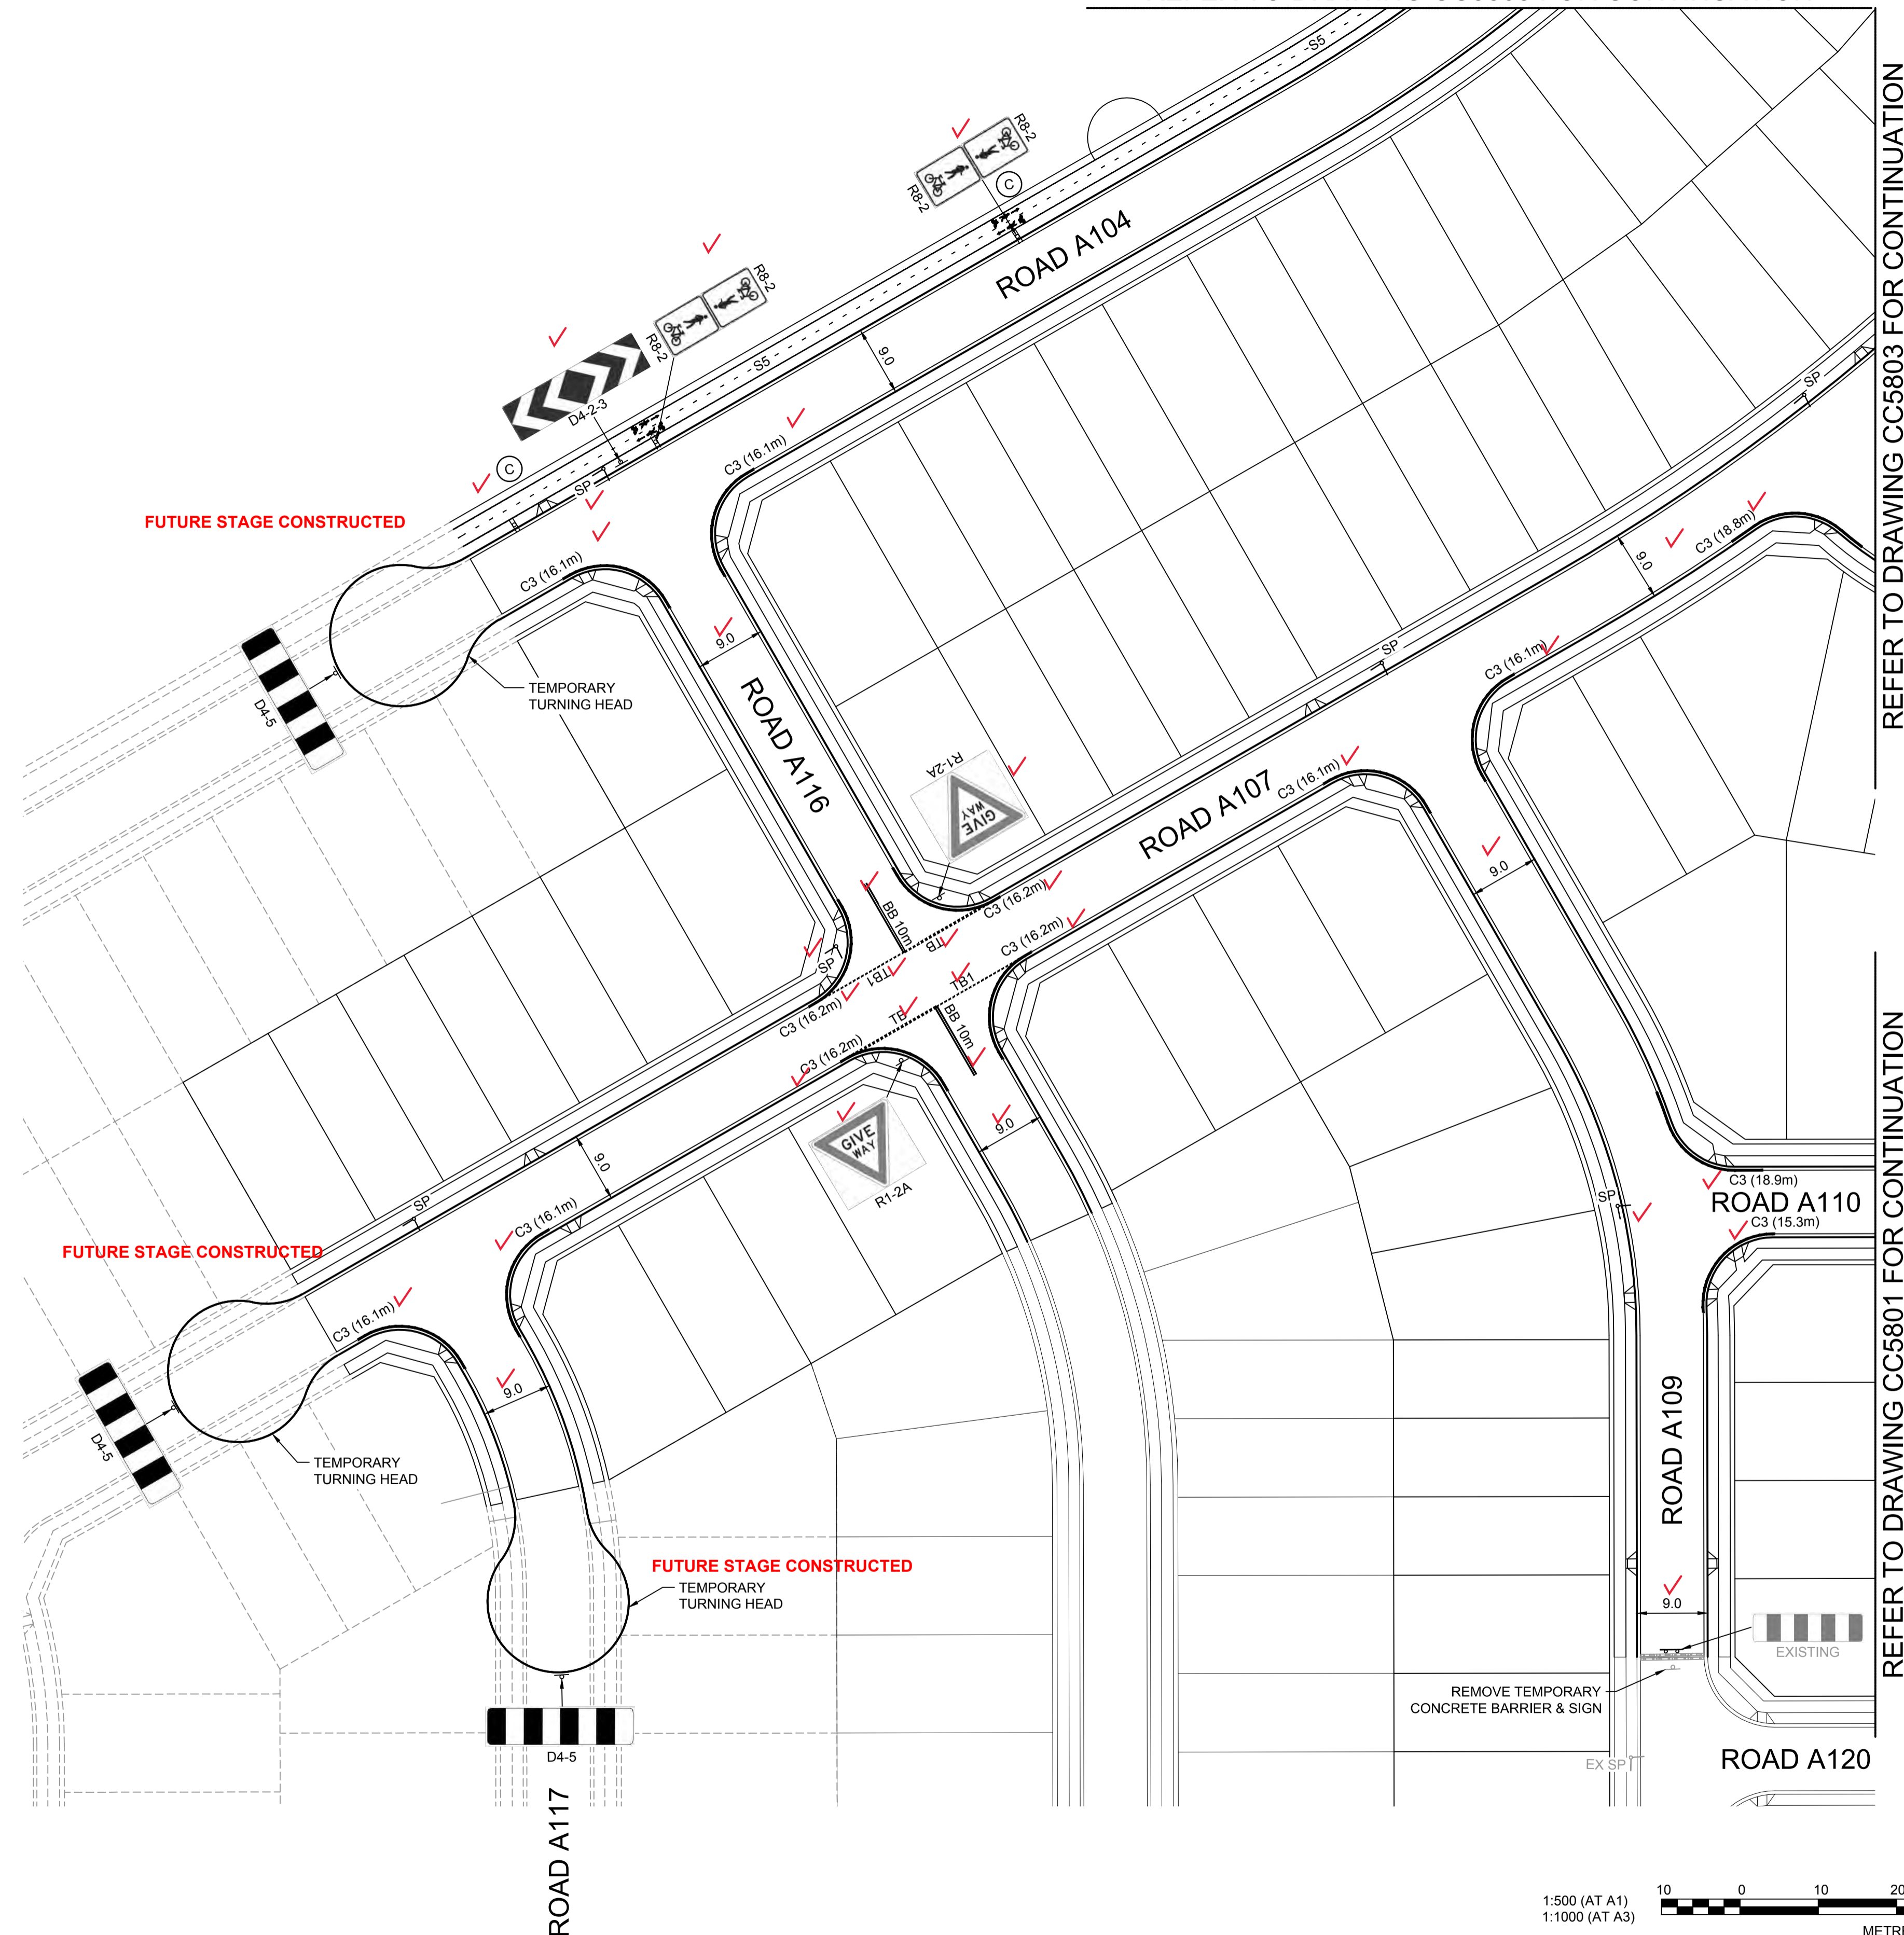

REFER TO DRAWING CC5803 FOR CONTINUATION

REFER TO DRAWING CC5801 FOR CONTINUATION



Plotted: 20 January, 2022 4:26:14 PM. File Name: J:\9985D\CC - Construction Certificate Approval Plans\PK12 WESTERN PRECINCTS\5 - Precinct 7\9985-12-CC5802.dwg

AMENDMENT	DES	DRN	CKD	APR	DATE
B	DG	NDW	DG	KE	20/01/22
A	DG	VS	MP	PJM	12/08/21

J. WYNDHAM PRINCE
CONSULTING CIVIL INFRASTRUCTURE ENGINEERS & PROJECT MANAGERS
PO Box 4366 PENRITH WESTFIELD NSW 2750
P 02 4720 3300 W www.jwprince.com.au E jwp@jwprince.com.au

CLIENT:
 WINTEP PROPERTY GROUP

STATUS:
ISSUE FOR CONSTRUCTION APPROVAL
THIS DRAWING MUST NOT BE USED FOR CONSTRUCTION UNLESS SIGNED AS PART OF AN APPROVED CONSTRUCTION CERTIFICATE.

NEWPARK
PRECINCT 7, STAGE 7B
SIGNAGE & LINE MARKING PLAN SHEET 2

PROJECT No:
9985-12
SHEET No:
CC5802
PLAN No: 9985-12-CC5802

B

REFER TO DRAWING CC5804 FOR CONTINUATION

REFER TO DRAWING CC5802 FOR CONTINUATION

Plotfile: 20 January, 2022 4:25:56 PM File Name: J:\9985\DJCC - Construction Certificate Approval Plans\PK12 WESTERN PRECINCTS16 - Precinct7\9985-12-CC5803.dwg



REFER TO DRAWING CC5801 FOR CONTINUATION


I hereby certify that engineering works shown on this plan have been constructed generally in accordance with Construction Certificate 16635 issued by Land Development Certificates

Signature.....
PETER ROBERT WARWICK
 Registered Land Surveyor
VINCE MORGAN SURVEYORS PTY LTD

DATE 24/02/2023 REF 20260-7

THESE SIGNAGE AND LINEMARKING PLANS ARE SUBJECT TO APPROVAL BY BLACKTOWN CITY COUNCIL TRAFFIC COMMITTEE

NOTE: REFER TO CC5802 FOR LEGEND AND NOTES.

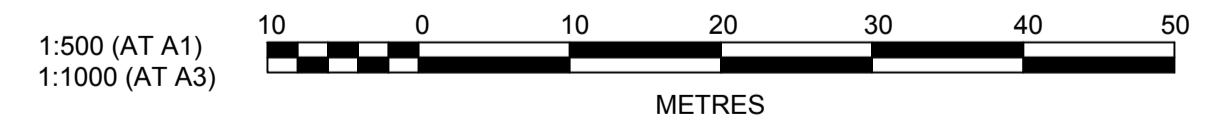

AMENDMENT	DES	DRN	CKD	APR	DATE
B	DG	NDW	DG	KE	20/01/22
A	DG	VS	MP	PJM	12/08/21

J. WYNDHAM PRINCE
 CONSULTING CIVIL INFRASTRUCTURE ENGINEERS & PROJECT MANAGERS

PO Box 4366 PENRITH WESTFIELD NSW 2750
 P 02 4720 3300 W www.jwprince.com.au E jwp@jwprince.com.au

CLIENT:

STATUS: **ISSUE FOR CONSTRUCTION APPROVAL**

THIS DRAWING MUST NOT BE USED FOR CONSTRUCTION UNLESS SIGNED AS PART OF AN APPROVED CONSTRUCTION CERTIFICATE.

NEWPARK
 PRECINCT 7, STAGE 7B
 SIGNAGE & LINE MARKING PLAN SHEET 3

PROJECT No: **9985-12**
 SHEET No: **CC5803**

AZIMUTH: M.G.A.94 DATUM: A.H.D. ORIGIN: SSM 1112 PLAN No: **9985-12-CC5803**

PROJECT No: **9985-12**
 SHEET No: **CC5803**

B

THESE SIGNAGE AND LINEMARKING PLANS ARE SUBJECT TO APPROVAL BY BLACKTOWN CITY COUNCIL TRAFFIC COMMITTEE

NOTE: REFER TO CC5802 FOR LEGEND AND NOTES.

I hereby certify that engineering works shown on this plan have been constructed generally in accordance with Construction Certificate 16635 issued by Land Development Certificates


Signature: 
 PETER ROBERT WARWICK
 Registered Land Surveyor
 VINCE MORGAN SURVEYORS PTY LTD

DATE: 24/02/2023 REF: 20260-7



REFER TO DRAWING CC5803 FOR CONTINUATION

1:500 (AT A1)
 1:1000 (AT A3)



METRES

Plotfile: 20 January, 2022 4:25:22 PM File Name: J:\9985D\CC - Construction Certificate Approval Plans\PK12 WESTERN PRECINCTS16 - Precinct7B\9985-12-CC5804.dwg

AMENDMENT	DES	DRN	CKD	APR	DATE
B	DG	NDW	DG	KE	20/01/22
A	DG	VS	MP	PJM	12/08/21

J. WYNDHAM PRINCE
 CONSULTING CIVIL INFRASTRUCTURE ENGINEERS & PROJECT MANAGERS

PO Box 4366 PENRITH WESTFIELD NSW 2750
 P 02 4720 3300 W www.jwprince.com.au E jwp@jwprince.com.au

CLIENT:



WINTAN PROPERTY GROUP

STATUS: **ISSUE FOR CONSTRUCTION APPROVAL**

THIS DRAWING MUST NOT BE USED FOR CONSTRUCTION UNLESS SIGNED AS PART OF AN APPROVED CONSTRUCTION CERTIFICATE.

NEWPARK
 PRECINCT 7, STAGE 7B
 SIGNAGE & LINE MARKING PLAN SHEET 4

PROJECT No: **9985-12**
 SHEET No: **CC5804**

AZIMUTH: M.G.A.94 DATUM: A.H.D. ORIGIN: SSM 1112 PLAN No: **9985-12-CC5804**

PROJECT No: **9985-12**
 SHEET No: **CC5804**

PLAN No: **9985-12-CC5804**