



Job No: 8599/84
Our Ref: 8599/84-AB
6 December 2023

Daracon Contractors Pty Ltd
184 Adderley Street West
AUBURN NSW 2144
Email: Sabina.Moktan@daracon.com.au

Dear Sabina

**Re: Precinct 7, Part of the BEW (DA-15-02273) &
Precinct 7, Stage 7F Civil Works (SPP-17-00046)
Bulk Earthworks Completion, Compliance Certificate**

Geotech Testing Pty Ltd has provided site supervision and compaction control testing during placement of fill at the above project.

Land Filling and Compaction

Site supervision and compaction control tests were undertaken within the terms of our NATA accreditation at the dates and to the procedures shown on the test results sheets, copies of which were submitted monthly during the duration of the project.

The following 139 tests were conducted during placement of fill from November 2017 to November 2023 and the testing results were submitted as shown below:

Report	Test Nos	No of tests
8599/1-R10	3368-3376, 3419-3426, 3624-3635, 3651-3653, 3656-3669, 3702-3703, 3706-3709	68
8599/1-R15	5881-5882, 5915-5916	
8599/1-R16	5922, 5941-5942, 5955, 5967-5970, 5989-5992	
8599-84	1 to 59	59
8599-115	1 to 12	12

The frequency of field density and compaction tests were carried out in accordance with Level 1 as defined in AS3798 "Guidelines on Earthworks for Commercial & Residential Development". Based on the foregoing, it is considered that the fill placed at the above project is classified as "CONTROLLED FILL" and that the specified compaction level has been achieved within the lots and road reserves.

8599/84-AB
Newpark Precinct 7F - Marsden Park

Salinity Certification

All site works were carried out in accordance with the Soil Management Plan included in Geotechnique Pty Ltd Land Capability Study Report (Our Ref: 12576/1-AA dated 27 February 2012). The salinity of the imported fill was confirmed as non to slightly saline soils, thus reducing the overall effect of any saline soils on ground concrete structures such as footings. Based on the foregoing, it is our opinion that the works completed at Precincts 7C comply with the salinity report.

Validation of Imported Fill

All imported fill, if any, have been assessed as VENM as per Geotech Testing Report 9599/61-AC dated 25 March 2022. Based on the foregoing, it is our opinion that the site is validated in accordance with the Environment Protection Authority guidelines (*Contaminated Land Sites*). No contaminants were encountered during bulk earthworks, other than that noted in the RAP report.

Newpark Precinct 7F is suitable for the intended land use consistent with NEPM 2013 Residential A - Residential with Garden / Accessible soil.

If you have any questions, please do not hesitate to contact the undersigned.

Yours faithfully
GEOTECH TESTING PTY LTD



EMGED RIZKALLA
Director

Attached 8599/1-R10, R15 & R16
8599/84-FDT1 to 59 & associated drawings
8599/115-FDT1 to 12 & associated drawings

Our Ref: 8599/1-R10
27 November 2017

Daracon Contractors Pty Ltd
P O Box 6145
SILVERWATER BC NSW 1811
Email: SimpsonW@daracon.com.au

Attention: Mr S Wong

Dear Sir

Re: **Woorong Bulk Earthworks
Marsden Park
Monthly Site Filling Certificate - November 2017**

For the production period 10 October to 10 November 2017 inclusive, we submit our Geotech Monthly Report for the above project.

During the foregoing testing period, a total of six hundred & thirty compaction control tests (Tests 3246 to 3875 inclusive) were carried out and reported. The locations of the 630 tests are shown on the attached Drawing Nos 8599/1-56 to 8599/1-64, inclusive (9 drawings). All tests have been undertaken in accordance with the Test Methods and Specifications shown on the attached certificates. Scanned daily records and subgrade reports are also attached.

Based on the fill quantities/survey data, the frequency of field density and compaction tests was in accordance with Level 1 as defined in AS3798 "Guidelines on Earthworks for Commercial & Residential Development". We certify that all tested locations attained the density ratio shown on the test results sheets. Where failures were encountered, the areas were re-worked and re-tested to achieve the specified density ratio.

Based on site observations and testing, it is considered that the fill placed to date at the locations shown on the attached drawings is classified as "Controlled" fill and that the specified compaction level has been achieved within the tested area.

If you have any questions, please do not hesitate to contact the undersigned.

Yours faithfully
GEOTECH TESTING PTY LTD



EMGED RIZKALLA
Director

Attached Density Test Results Certificates Tests 3246 to 3875
Test Location Drawings 8599/1-56 to 8599/1-64
Daily Records
Subgrade Approvals (S16 to S19)

FIELD DENSITY RESULTS

DARACON CONTRACTORS PTY LTD
PO BOX 299
WALLSEND NSW 2287

Laboratory: Penrith
Job No: 8599/1
Date: 24/11/2017

PROJECT: SITE FILL TESTING - AREA B
RESIDENTIAL DEVELOPMENT.WOORONG PARK, MARSDEN PARK

Page 1 of 79

TEST NUMBER	3246	3247	3248	3249	3250	3251	3252	3253		
DATE TESTED	10/10/2017									
RESULTS										
Hiif Density Ratio	Standard	%	100	99.5	98	98.5	98	97	100	98
Moisture Variation from OMC (-Drier/+Wetter)		%	0.0	0.0	0.0	-0.5	-0.5	0.5	0.0	0.5
Specification	Density Ratio (Standard)	≥95%	Specification				Moisture Variance from OMC			±2%
TEST LOCATION										
Easting	295261.341	295237.966	295243.232	295247.341	295234.783	295236.615	295233.835	295252.502		
Northing	6268935.461	6268949.704	6268984.437	6269014.11	6269012.589	6268977.182	6268944.871	6268935.995		
Reduced Level	m	17.621	17.213	17.113	17.001	17.061	17.212	17.586	17.816	
Shown on Drawing No	8599/1-59									
Retested by Test	-	-	-	-	-	-	-	-		
FIELD & LABORATORY DATA										
Field Wet Density	t/m ³	2.09	2.09	2.06	2.08	2.05	2.05	2.09	2.07	
Field Moisture Content	%	21.5	20.0	20.5	20.5	22.0	22.0	22.0	21.0	
Material retained on 19mm Sieve (wet)	%	<5	<5	<5	<5	<5	<5	<5	<5	
Lab Compaction result from test number		3246	3247	3248	3249	3250	3251	3252	3253	
Peak Converted Wet Density	t/m ³	2.09	2.10	2.10	2.11	2.09	2.11	2.09	2.11	
Apparent Optimum Moisture Content	%	21.5	20.0	20.5	21.0	22.5	21.5	22.0	20.5	
Number of Compaction Points		3	3	3	3	3	3	3	3	
Test Procedures - See Note Number		12	12	12	12	12	12	12	12	
Material Description - see below		3	2-3	2-3	2-3	3	3	3	2-3	
Notes										
1: Assigned Values have been obtained from our Penrith laboratory – Accreditation No 2734					10: AS 1289 1.2.1 clause 6.4 (b), 2.1.1, 5.3.1, 5.5.1, 5.6.1					
2: Assigned Values have been obtained from our Prestons laboratory – Accreditation No 14234					11: AS 1289 1.2.1 clause 6.4 (b), 2.1.1, 5.3.1, 5.7.1					
3: Results have been calculated using infinite decimal places. Therefore, calculated values may vary from those shown										
4: AS 1289 1.2.1 clause 6.4 (b), 2.1.1, 5.1.1, 5.3.1, 5.4.1					12: AS 1289 1.2.1 clause 6.4 (b), 2.1.1, 5.7.1, 5.8.1					
5: AS 1289 1.2.1 clause 6.4 (b), 2.1.1, 5.2.1, 5.3.1, 5.4.1					13: RMS T111, T119, T120, T166					
6: AS 1289 1.2.1 clause 6.4 (b),					14: RMS T111, T120, T166, T173					
7: AS 1289 1.2.1 clause 6.4 (b), 2.1.1, 5.2.1, 5.4.1, 5.8.1					15: RMS T120, T119, T162					
8: AS 1289 1.2.1 clause 6.4 (b), 2.1.1., 5.5.1, 5.6.1, 5.8.1					16: RMS T120, T162, T173					
9: Full details of Test Procedure 5.8.1 available on request					17: RMS T120, T164, T173					
Material Description										
1. CL-Clays of low plasticity, gravelly clays, sandy clays, silty clays			11. DGS40			* Cement Stabilised				
2. CI-Clay of medium plasticity, gravelly clays, sandy clays, silty clays			12. FCR20			# Lime Stabilised				
3. CH-Clays of high plasticity			13. FCR40			\$ Gypsum Stabilised				
4. SC-Clayey sands, sand-clay mixtures			14. RC - Recycled Concrete							
5. SM-Silty sands, sand-silt mixtures			15. Recycled Roadbase							
6. GC-Clayey gravels, gravel-sand-clay mixtures			16. RSB - Recycled Sub-base							
7. SP-Sand, crushed dust, filling sand, washed sand			17. CSS - Crushed Sandstone							
8. DGB20			18. RSS - Ripped Sandstone							
9. DGB40			19. Cowels Brown							
10. DGS20										

Form No R 020c Version 01 06/17 - issued by ER



Accreditation Number 2734
Corporate Site Number 2727

Accredited for compliance with
ISO/IEC 17025 - Testing.

A Kench 24/11/2017

Approved Signatory

Head Office:
34 Borec Road, Penrith NSW 2750
P O Box 880 Penrith NSW 2751
Telephone: (02) 4722 21

Prestons Laboratory:
Unit 4, 18-20 Whyalla Place, Prestons NSW 2170
Telephone: (02) 9607 6111 Facsimile: (02) 9607 6200

FIELD DENSITY RESULTS

DARACON CONTRACTORS PTY LTD
PO BOX 299
WALLSEND NSW 2287

Laboratory: Penrith
Job No: 8599/1
Date: 24/11/2017

PROJECT: SITE FILL TESTING - AREA B
RESIDENTIAL DEVELOPMENT.WOORONG PARK, MARSDEN PARK

Page 2 of 79

TEST NUMBER	3254	3255	3256	3257	3258	3259	3260	3261		
DATE TESTED	10/10/2017									
RESULTS										
Hilf Density Ratio	Standard	%	98	100.5	100.5	98.5	98.5	99	97	97.5
Moisture Variation from OMC (-Drier/+Wetter)		%	-0.5	-1.0	-0.5	0.0	-0.5	0.0	0.0	0.0
Specification	Density Ratio (Standard)	≥95%	Specification			Moisture Variance from OMC			±2%	
TEST LOCATION										
Easting	295260.032	295272.444	295264.093	295237.297	295217.843	295241.795	295258.659	295245.187		
Northing	6268961.635	6269001.367	6269016.529	6268987.254	6268949.792	6268941.543	6268983.401	6269011.448		
Reduced Level	m	17.641	17.621	17.721	17.533	17.581	18.181	18.034	17.763	
Shown on Drawing No	8599/1-59									
Retested by Test	-	-	-	-	-	-	-	-		
FIELD & LABORATORY DATA										
Field Wet Density	t/m ³	2.07	2.11	2.10	2.07	2.08	2.08	2.04	2.07	
Field Moisture Content	%	22.0	21.5	21.0	20.5	21.0	21.5	22.0	22.0	
Material retained on 19mm Sieve (wet)	%	<5	<5	<5	<5	<5	<5	<5	<5	
Lab Compaction result from test number		3254	3255	3256	3257	3258	3259	3260	3261	
Peak Converted Wet Density	t/m ³	2.11	2.10	2.09	2.10	2.11	2.10	2.10	2.12	
Apparent Optimum Moisture Content	%	22.5	22.0	21.5	20.5	21.5	21.5	22.0	22.0	
Number of Compaction Points		3	3	3	3	3	3	3	3	
Test Procedures - See Note Number		12	12	12	12	12	12	12	12	
Material Description - see below		3	3	3	2-3	3	3	3	3	
Notes										
1: Assigned Values have been obtained from our Penrith laboratory – Accreditation No 2734					10: AS 1289 1.2.1 clause 6.4 (b), 2.1.1, 5.3.1, 5.5.1, 5.6.1					
2: Assigned Values have been obtained from our Prestons laboratory – Accreditation No 14234					11: AS 1289 1.2.1 clause 6.4 (b), 2.1.1, 5.3.1, 5.7.1					
3: Results have been calculated using infinite decimal places. Therefore, calculated values may vary from those shown					12: AS 1289 1.2.1 clause 6.4 (b), 2.1.1, 5.7.1, 5.8.1					
4: AS 1289 1.2.1 clause 6.4 (b), 2.1.1, 5.1.1, 5.3.1, 5.4.1					13: RMS T111, T119, T120, T166					
5: AS 1289 1.2.1 clause 6.4 (b), 2.1.1, 5.2.1, 5.3.1, 5.4.1					14: RMS T111, T120, T166, T173					
6: AS 1289 1.2.1 clause 6.4 (b),					15: RMS T120, T119, T162					
7: AS 1289 1.2.1 clause 6.4 (b), 2.1.1, 5.2.1, 5.4.1, 5.8.1					16: RMS T120, T162, T173					
8: AS 1289 1.2.1 clause 6.4 (b), 2.1.1., 5.5.1, 5.6.1, 5.8.1					17: RMS T120, T164, T173					
9: Full details of Test Procedure 5.8.1 available on request										
Material Description										
1. CL-Clays of low plasticity, gravelly clays, sandy clays, silty clays			11. DGS40			* Cement Stabilised				
2. CI-Clay of medium plasticity, gravelly clays, sandy clays, silty clays			12. FCR20			# Lime Stabilised				
3. CH-Clays of high plasticity			13. FCR40			\$ Gypsum Stabilised				
4. SC-Clayey sands, sand-clay mixtures			14. RC - Recycled Concrete							
5. SM-Silty sands, sand-silt mixtures			15. Recycled Roadbase							
6. GC-Clayey gravels, gravel-sand-clay mixtures			16. RSB - Recycled Sub-base							
7. SP-Sand, crushed dust, filling sand, washed sand			17. CSS - Crushed Sandstone							
8. DGB20			18. RSS - Ripped Sandstone							
9. DGB40			19. Cowels Brown							
10. DGS20										

Form No R 020c Version 01 06/17 - issued by ER



Accreditation Number 2734
Corporate Site Number 2727

Accredited for compliance with
ISO/IEC 17025 - Testing.

A Kench 24/11/2017

Approved Signatory

Head Office:
34 Borec Road, Penrith NSW 2750
P O Box 880 Penrith NSW 2751
Telephone: (02) 4722 21

Prestons Laboratory:
Unit 4, 18-20 Whyalla Place, Prestons NSW 2170
Telephone: (02) 9607 6111 Facsimile: (02) 9607 6200

FIELD DENSITY RESULTS

DARACON CONTRACTORS PTY LTD
PO BOX 299
WALLSEND NSW 2287

Laboratory: Penrith
Job No: 8599/1
Date: 24/11/2017

PROJECT: SITE FILL TESTING - AREA B
RESIDENTIAL DEVELOPMENT.WOORONG PARK, MARSDEN PARK

Page 3 of 79

TEST NUMBER	3262	3263	3264	3265	3266	3267	3268	3269		
DATE TESTED	10/10/2017									
RESULTS										
Hiif Density Ratio	Standard	%	99.5	100	98	98.5	97.5	98.5	99.5	98.5
Moisture Variation from OMC (-Drier/+Wetter)		%	0.5	0.5	0.5	-0.5	0.0	0.0	0.0	0.0
Specification	Density Ratio (Standard)		≥95%			Specification	Moisture Variance from OMC		±2%	
TEST LOCATION										
Easting	295233.613	295219.002	295243.597	295260.006	295303.055	295262.556	295218.774	295211.423		
Northing	6268990.457	6268948.32	6268948.814	6268987.693	6269001.958	6269001.354	6269008.56	6268992.77		
Reduced Level	m	18.073	18.167	18.378	18.283	19.228	18.636	18.07	18.099	
Shown on Drawing No	8599/1-59									
Retested by Test	-	-	-	-	-	-	-	-		
FIELD & LABORATORY DATA										
Field Wet Density	t/m ³	2.11	2.12	2.08	2.06	2.05	2.06	2.08	2.08	
Field Moisture Content	%	21.5	20.5	22.5	21.5	16.5	19.5	19.5	20.0	
Material retained on 19mm Sieve (wet)	%	<5	<5	<5	<5	<5	<5	<5	<5	
Lab Compaction result from test number		3262	3263	3264	3265	3266	3267	3268	3269	
Peak Converted Wet Density	t/m ³	2.12	2.12	2.12	2.09	2.10	2.09	2.09	2.11	
Apparent Optimum Moisture Content	%	21.0	20.0	22.0	22.0	16.5	19.5	19.5	20.5	
Number of Compaction Points		3	3	3	3	3	3	3	3	
Test Procedures - See Note Number		12	12	12	12	12	12	12	12	
Material Description - see below		2-3	2-3	3	3	2	2-3	2-3	2-3	
Notes										
1: Assigned Values have been obtained from our Penrith laboratory – Accreditation No 2734					10: AS 1289 1.2.1 clause 6.4 (b), 2.1.1, 5.3.1, 5.5.1, 5.6.1					
2: Assigned Values have been obtained from our Prestons laboratory – Accreditation No 14234					11: AS 1289 1.2.1 clause 6.4 (b), 2.1.1, 5.3.1, 5.7.1					
3: Results have been calculated using infinite decimal places. Therefore, calculated values may vary from those shown					12: AS 1289 1.2.1 clause 6.4 (b), 2.1.1, 5.7.1, 5.8.1					
4: AS 1289 1.2.1 clause 6.4 (b), 2.1.1, 5.1.1, 5.3.1, 5.4.1					13: RMS T111, T119, T120, T166					
5: AS 1289 1.2.1 clause 6.4 (b), 2.1.1, 5.2.1, 5.3.1, 5.4.1					14: RMS T111, T120, T166, T173					
6: AS 1289 1.2.1 clause 6.4 (b),					15: RMS T120, T119, T162					
7: AS 1289 1.2.1 clause 6.4 (b), 2.1.1, 5.2.1, 5.4.1, 5.8.1					16: RMS T120, T162, T173					
8: AS 1289 1.2.1 clause 6.4 (b), 2.1.1., 5.5.1, 5.6.1, 5.8.1					17: RMS T120, T164, T173					
9: Full details of Test Procedure 5.8.1 available on request										
Material Description										
1. CL-Clays of low plasticity, gravelly clays, sandy clays, silty clays			11. DGS40			* Cement Stabilised				
2. CI-Clay of medium plasticity, gravelly clays, sandy clays, silty clays			12. FCR20			# Lime Stabilised				
3. CH-Clays of high plasticity			13. FCR40			\$ Gypsum Stabilised				
4. SC-Clayey sands, sand-clay mixtures			14. RC - Recycled Concrete							
5. SM-Silty sands, sand-silt mixtures			15. Recycled Roadbase							
6. GC-Clayey gravels, gravel-sand-clay mixtures			16. RSB - Recycled Sub-base							
7. SP-Sand, crushed dust, filling sand, washed sand			17. CSS - Crushed Sandstone							
8. DGB20			18. RSS - Ripped Sandstone							
9. DGB40			19. Cowels Brown							
10. DGS20										

Form No R 020c Version 01 06/17 - issued by ER



Accreditation Number 2734
Corporate Site Number 2727

Accredited for compliance with
ISO/IEC 17025 - Testing.

A Kench 24/11/2017

Approved Signatory

Head Office:
34 Borec Road, Penrith NSW 2750
P O Box 880 Penrith NSW 2751
Telephone: (02) 4722 21

Prestons Laboratory:
Unit 4, 18-20 Whyalla Place, Prestons NSW 2170
Telephone: (02) 9607 6111 Facsimile: (02) 9607 6200

FIELD DENSITY RESULTS

DARACON CONTRACTORS PTY LTD
PO BOX 299
WALLSEND NSW 2287

Laboratory: Penrith
Job No: 8599/1
Date: 24/11/2017

PROJECT: SITE FILL TESTING - AREA B
RESIDENTIAL DEVELOPMENT.WOORONG PARK, MARSDEN PARK

Page 4 of 79

TEST NUMBER	3270	3271	3272	3273	3274	3275	3276	3277		
DATE TESTED	10/10/2017									
RESULTS										
Hiif Density Ratio	Standard	%	98.5	99.5	98.5	98.5	99.5	99.5	99	98.5
Moisture Variation from OMC (-Drier/+Wetter)		%	0.0	-0.5	-0.5	-0.5	0.0	0.0	0.0	-0.5
Specification	Density Ratio (Standard)	≥95%	Specification				Moisture Variance from OMC			±2%
TEST LOCATION										
Easting	295271.349	295288.261	295246.467	295211.439	295209.889	295261.127	295487.598	295514.537		
Northing	6268979.656	6268958.507	6268958.527	6268962.755	6268940.304	6268930.464	6269508.534	6269489.444		
Reduced Level	m		18.835	19.543	18.434	18.405	18.625	19.043	17.39	16.983
Shown on Drawing No	8599/1-59								8599/1-58	
Retested by Test	-	-	-	-	-	-	-	-	-	
FIELD & LABORATORY DATA										
Field Wet Density	t/m ³	2.06	2.09	2.08	2.07	2.10	2.09	2.08	2.07	
Field Moisture Content	%	22.5	22.0	21.5	22.0	21.0	20.0	21.5	21.0	
Material retained on 19mm Sieve (wet)	%	<5	<5	<5	<5	<5	<5	<5	<5	
Lab Compaction result from test number		3270	3271	3272	3273	3274	3275	3276	3277	
Peak Converted Wet Density	t/m ³	2.09	2.10	2.11	2.10	2.11	2.10	2.10	2.10	
Apparent Optimum Moisture Content	%	22.5	22.5	22.0	22.0	21.0	20.5	21.5	21.5	
Number of Compaction Points		3	3	3	3	3	3	3	3	
Test Procedures - See Note Number		12	12	12	12	12	12	12	12	
Material Description - see below		3	3	3	3	2-3	2-3	3	3	
Notes										
1: Assigned Values have been obtained from our Penrith laboratory – Accreditation No 2734					10: AS 1289 1.2.1 clause 6.4 (b), 2.1.1, 5.3.1, 5.5.1, 5.6.1					
2: Assigned Values have been obtained from our Prestons laboratory – Accreditation No 14234					11: AS 1289 1.2.1 clause 6.4 (b), 2.1.1, 5.3.1, 5.7.1					
3: Results have been calculated using infinite decimal places. Therefore, calculated values may vary from those shown										
4: AS 1289 1.2.1 clause 6.4 (b), 2.1.1, 5.1.1, 5.3.1, 5.4.1					12: AS 1289 1.2.1 clause 6.4 (b), 2.1.1, 5.7.1, 5.8.1					
5: AS 1289 1.2.1 clause 6.4 (b), 2.1.1, 5.2.1, 5.3.1, 5.4.1					13: RMS T111, T119, T120, T166					
6: AS 1289 1.2.1 clause 6.4 (b),					14: RMS T111, T120, T166, T173					
7: AS 1289 1.2.1 clause 6.4 (b), 2.1.1, 5.2.1, 5.4.1, 5.8.1					15: RMS T120, T119, T162					
8: AS 1289 1.2.1 clause 6.4 (b), 2.1.1., 5.5.1, 5.6.1, 5.8.1					16: RMS T120, T162, T173					
9: Full details of Test Procedure 5.8.1 available on request					17: RMS T120, T164, T173					
Material Description										
1. CL-Clays of low plasticity, gravelly clays, sandy clays, silty clays			11. DGS40			* Cement Stabilised				
2. CI-Clay of medium plasticity, gravelly clays, sandy clays, silty clays			12. FCR20			# Lime Stabilised				
3. CH-Clays of high plasticity			13. FCR40			\$ Gypsum Stabilised				
4. SC-Clayey sands, sand-clay mixtures			14. RC - Recycled Concrete							
5. SM-Silty sands, sand-silt mixtures			15. Recycled Roadbase							
6. GC-Clayey gravels, gravel-sand-clay mixtures			16. RSB - Recycled Sub-base							
7. SP-Sand, crushed dust, filling sand, washed sand			17. CSS - Crushed Sandstone							
8. DGB20			18. RSS - Ripped Sandstone							
9. DGB40			19. Cowels Brown							
10. DGS20										

Form No R 020c Version 01 06/17 - issued by ER



Accreditation Number 2734
Corporate Site Number 2727

Accredited for compliance with
ISO/IEC 17025 - Testing.

A Kench 24/11/2017

Approved Signatory

Head Office:
34 Borec Road, Penrith NSW 2750
P O Box 880 Penrith NSW 2751
Telephone: (02) 4722 21

Prestons Laboratory:
Unit 4, 18-20 Whyalla Place, Prestons NSW 2170
Telephone: (02) 9607 6111 Facsimile: (02) 9607 6200

FIELD DENSITY RESULTS

DARACON CONTRACTORS PTY LTD
PO BOX 299
WALLSEND NSW 2287

Laboratory: Penrith
Job No: 8599/1
Date: 24/11/2017

PROJECT: SITE FILL TESTING - AREA B
RESIDENTIAL DEVELOPMENT.WOORONG PARK, MARSDEN PARK

Page 5 of 79

TEST NUMBER	3278	3279	3280	3281	3282	3283	3284	3285		
DATE TESTED	10/10/2017									
RESULTS										
Hilf Density Ratio	Standard	%	96.5	97.5	97	99	100.5	99.5	99	98.5
Moisture Variation from OMC (-Drier/+Wetter)		%	0.0	-0.5	0.0	-0.5	-0.5	0.0	0.0	-0.5
Specification	Density Ratio (Standard)	≥95%	Specification Moisture Variance from OMC				±2%			
TEST LOCATION										
Easting	295533.456	295515.626	295489.17	295457.9	295445.161	295488.928	295522.092	295133.317		
Northing	6269470.597	6269458.138	6269476.475	6269499.962	6269483.165	6269452.506	6269430.553	6269024.101		
Reduced Level	m	17.563	17.101	16.427	16.396	14.847	15.839	16.901	16.994	
Shown on Drawing No	8599/1-58									
Retested by Test	-	-	-	-	-	-	-	-	8599/1-59	
FIELD & LABORATORY DATA										
Field Wet Density	t/m ³	2.04	2.05	2.06	2.07	2.11	2.10	2.09	2.08	
Field Moisture Content	%	20.5	22.0	21.0	20.0	19.0	21.5	21.5	19.5	
Material retained on 19mm Sieve (wet)	%	<5	<5	<5	<5	<5	<5	<5	<5	
Lab Compaction result from test number		3278	3279	3280	3281	3282	3283	3284	3285	
Peak Converted Wet Density	t/m ³	2.11	2.10	2.12	2.09	2.10	2.11	2.11	2.11	
Apparent Optimum Moisture Content	%	20.5	22.0	21.0	20.5	19.5	21.5	21.5	19.5	
Number of Compaction Points		3	3	3	3	3	3	3	3	
Test Procedures - See Note Number		12	12	12	12	12	12	12	12	
Material Description - see below		2-3	3	2-3	2-3	2-3	3	3	2-3	
Notes										
1: Assigned Values have been obtained from our Penrith laboratory – Accreditation No 2734					10: AS 1289 1.2.1 clause 6.4 (b), 2.1.1, 5.3.1, 5.5.1, 5.6.1					
2: Assigned Values have been obtained from our Prestons laboratory – Accreditation No 14234					11: AS 1289 1.2.1 clause 6.4 (b), 2.1.1, 5.3.1, 5.7.1					
3: Results have been calculated using infinite decimal places. Therefore, calculated values may vary from those shown					12: AS 1289 1.2.1 clause 6.4 (b), 2.1.1, 5.7.1, 5.8.1					
4: AS 1289 1.2.1 clause 6.4 (b), 2.1.1, 5.1.1, 5.3.1, 5.4.1					13: RMS T111, T119, T120, T166					
5: AS 1289 1.2.1 clause 6.4 (b), 2.1.1, 5.2.1, 5.3.1, 5.4.1					14: RMS T111, T120, T166, T173					
6: AS 1289 1.2.1 clause 6.4 (b),					15: RMS T120, T119, T162					
7: AS 1289 1.2.1 clause 6.4 (b), 2.1.1, 5.2.1, 5.4.1, 5.8.1					16: RMS T120, T162, T173					
8: AS 1289 1.2.1 clause 6.4 (b), 2.1.1., 5.5.1, 5.6.1, 5.8.1					17: RMS T120, T164, T173					
9: Full details of Test Procedure 5.8.1 available on request										
Material Description										
1. CL-Clays of low plasticity, gravelly clays, sandy clays, silty clays			11. DGS40			* Cement Stabilised				
2. CI-Clay of medium plasticity, gravelly clays, sandy clays, silty clays			12. FCR20			# Lime Stabilised				
3. CH-Clays of high plasticity			13. FCR40			\$ Gypsum Stabilised				
4. SC-Clayey sands, sand-clay mixtures			14. RC - Recycled Concrete							
5. SM-Silty sands, sand-silt mixtures			15. Recycled Roadbase							
6. GC-Clayey gravels, gravel-sand-clay mixtures			16. RSB - Recycled Sub-base							
7. SP-Sand, crushed dust, filling sand, washed sand			17. CSS - Crushed Sandstone							
8. DGB20			18. RSS - Ripped Sandstone							
9. DGB40			19. Cowels Brown							
10. DGS20										

Form No R 020c Version 01 06/17 - issued by ER



Accreditation Number 2734
Corporate Site Number 2727

Accredited for compliance with
ISO/IEC 17025 - Testing.

A Kench 24/11/2017

Approved Signatory

Head Office:
34 Borec Road, Penrith NSW 2750
P O Box 880 Penrith NSW 2751
Telephone: (02) 4722 21

Prestons Laboratory:
Unit 4, 18-20 Whyalla Place, Prestons NSW 2170
Telephone: (02) 9607 6111 Facsimile: (02) 9607 6200

FIELD DENSITY RESULTS

DARACON CONTRACTORS PTY LTD
PO BOX 299
WALLSEND NSW 2287

Laboratory: Penrith
Job No: 8599/1
Date: 24/11/2017

PROJECT: SITE FILL TESTING - AREA B
RESIDENTIAL DEVELOPMENT.WOORONG PARK, MARSDEN PARK

Page 6 of 79

TEST NUMBER	3286	3287	3288	3289	3290	3291	3292	3293		
DATE TESTED	10/10/2017	11/10/2017								
RESULTS										
Hilf Density Ratio	Standard	%	100	96	97	97.5	98	96	95.5	97.5
Moisture Variation from OMC (-Drier/+Wetter)		%	0.0	0.0	0.0	0.0	0.0	0.0	0.0	0.0
Specification	Density Ratio (Standard)		≥95%			Specification	Moisture Variance from OMC		±2%	
TEST LOCATION										
Easting	295095.465	295055.886	295092.907	295122.608	295125.53	295054.373	295048.705	295111.492		
Northing	6269026.582	6269013.147	6269007.546	6269003.308	6268991.312	6268994.761	6268978.48	6268964.952		
Reduced Level	m	15.944	15.512	16.449	17.254	17.282	15.945	15.916	17.337	
Shown on Drawing No	8599/1-59									
Retested by Test	-	-	-	-	-	-	-	-		
FIELD & LABORATORY DATA										
Field Wet Density	t/m ³	2.11	2.04	2.06	2.08	2.10	2.05	2.03	2.08	
Field Moisture Content	%	21.0	20.0	21.5	21.5	21.0	21.5	20.5	21.5	
Material retained on 19mm Sieve (wet)	%	<5	<5	<5	<5	<5	<5	<5	<5	
Lab Compaction result from test number		3286	3287	3288	3289	3290	3291	3292	3293	
Peak Converted Wet Density	t/m ³	2.11	2.13	2.12	2.13	2.14	2.14	2.13	2.13	
Apparent Optimum Moisture Content	%	21.0	20.0	21.0	22.0	21.0	21.5	20.5	21.5	
Number of Compaction Points		3	3	3	3	3	3	3	3	
Test Procedures - See Note Number		12	12	12	12	12	12	12	12	
Material Description - see below		2-3	2-3	3	3	2-3	3	2-3	3	
Notes										
1: Assigned Values have been obtained from our Penrith laboratory – Accreditation No 2734					10: AS 1289 1.2.1 clause 6.4 (b), 2.1.1, 5.3.1, 5.5.1, 5.6.1					
2: Assigned Values have been obtained from our Prestons laboratory – Accreditation No 14234					11: AS 1289 1.2.1 clause 6.4 (b), 2.1.1, 5.3.1, 5.7.1					
3: Results have been calculated using infinite decimal places. Therefore, calculated values may vary from those shown					12: AS 1289 1.2.1 clause 6.4 (b), 2.1.1, 5.7.1, 5.8.1					
4: AS 1289 1.2.1 clause 6.4 (b), 2.1.1, 5.1.1, 5.3.1, 5.4.1					13: RMS T111, T119, T120, T166					
5: AS 1289 1.2.1 clause 6.4 (b), 2.1.1, 5.2.1, 5.3.1, 5.4.1					14: RMS T111, T120, T166, T173					
6: AS 1289 1.2.1 clause 6.4 (b),					15: RMS T120, T119, T162					
7: AS 1289 1.2.1 clause 6.4 (b), 2.1.1, 5.2.1, 5.4.1, 5.8.1					16: RMS T120, T162, T173					
8: AS 1289 1.2.1 clause 6.4 (b), 2.1.1., 5.5.1, 5.6.1, 5.8.1					17: RMS T120, T164, T173					
9: Full details of Test Procedure 5.8.1 available on request										
Material Description										
1. CL-Clays of low plasticity, gravelly clays, sandy clays, silty clays			11. DGS40			* Cement Stabilised				
2. CI-Clay of medium plasticity, gravelly clays, sandy clays, silty clays			12. FCR20			# Lime Stabilised				
3. CH-Clays of high plasticity			13. FCR40			\$ Gypsum Stabilised				
4. SC-Clayey sands, sand-clay mixtures			14. RC - Recycled Concrete							
5. SM-Silty sands, sand-silt mixtures			15. Recycled Roadbase							
6. GC-Clayey gravels, gravel-sand-clay mixtures			16. RSB - Recycled Sub-base							
7. SP-Sand, crushed dust, filling sand, washed sand			17. CSS - Crushed Sandstone							
8. DGB20			18. RSS - Ripped Sandstone							
9. DGB40			19. Cowels Brown							
10. DGS20										

Form No R 020c Version 01 06/17 - issued by ER



Accreditation Number 2734
Corporate Site Number 2727

Accredited for compliance with
ISO/IEC 17025 - Testing.

A Kench 24/11/2017

Approved Signatory

Head Office:
34 Borec Road, Penrith NSW 2750
P O Box 880 Penrith NSW 2751
Telephone: (02) 4722 21

Prestons Laboratory:
Unit 4, 18-20 Whyalla Place, Prestons NSW 2170
Telephone: (02) 9607 6111 Facsimile: (02) 9607 6200

FIELD DENSITY RESULTS

DARACON CONTRACTORS PTY LTD
PO BOX 299
WALLSEND NSW 2287

Laboratory: Penrith
Job No: 8599/1
Date: 24/11/2017

PROJECT: SITE FILL TESTING - AREA B
RESIDENTIAL DEVELOPMENT.WOORONG PARK, MARSDEN PARK

Page 7 of 79

TEST NUMBER	3294	3295	3296	3297	3298	3299	3300	3301		
DATE TESTED	11/10/2017									
RESULTS										
Hilf Density Ratio	Standard	%	99	97	97.5	98	98	97	97.5	96
Moisture Variation from OMC (-Drier/+Wetter)		%	0.0	0.0	0.0	0.0	0.0	0.0	0.0	0.0
Specification	Density Ratio (Standard)		≥95%			Specification	Moisture Variance from OMC		±2%	
TEST LOCATION										
Easting	295116.255	295052.532	295040.509	295109.607	295129.665	295080.46	295056.673	295115.91		
Northing	6268940.573	6268946.756	6268963.979	6268953.273	6268965.789	6268972.43	6268991.327	6268981.781		
Reduced Level	m	17.893	16.831	16.231	17.775	17.804	16.926	16.337	17.568	
Shown on Drawing No	8599/1-59									
Retested by Test	-	-	-	-	-	-	-	-		
FIELD & LABORATORY DATA										
Field Wet Density	t/m ³	2.11	2.07	2.08	2.08	2.09	2.08	2.07	2.05	
Field Moisture Content	%	19.5	20.0	20.5	21.0	19.5	21.0	20.5	21.0	
Material retained on 19mm Sieve (wet)	%	<5	<5	<5	<5	<5	<5	<5	<5	
Lab Compaction result from test number		3294	3295	3296	3297	3298	3299	3300	3301	
Peak Converted Wet Density	t/m ³	2.13	2.13	2.13	2.12	2.13	2.14	2.12	2.13	
Apparent Optimum Moisture Content	%	19.5	20.0	20.5	21.0	19.5	20.5	20.5	21.0	
Number of Compaction Points		3	3	3	3	3	3	3	3	
Test Procedures - See Note Number		12	12	12	12	12	12	12	12	
Material Description - see below		2-3	2-3	2-3	2-3	2-3	2-3	2-3	2-3	
Notes										
1: Assigned Values have been obtained from our Penrith laboratory – Accreditation No 2734					10: AS 1289 1.2.1 clause 6.4 (b), 2.1.1, 5.3.1, 5.5.1, 5.6.1					
2: Assigned Values have been obtained from our Prestons laboratory – Accreditation No 14234					11: AS 1289 1.2.1 clause 6.4 (b), 2.1.1, 5.3.1, 5.7.1					
3: Results have been calculated using infinite decimal places. Therefore, calculated values may vary from those shown					12: AS 1289 1.2.1 clause 6.4 (b), 2.1.1, 5.7.1, 5.8.1					
4: AS 1289 1.2.1 clause 6.4 (b), 2.1.1, 5.1.1, 5.3.1, 5.4.1					13: RMS T111, T119, T120, T166					
5: AS 1289 1.2.1 clause 6.4 (b), 2.1.1, 5.2.1, 5.3.1, 5.4.1					14: RMS T111, T120, T166, T173					
6: AS 1289 1.2.1 clause 6.4 (b)					15: RMS T120, T119, T162					
7: AS 1289 1.2.1 clause 6.4 (b), 2.1.1, 5.2.1, 5.4.1, 5.8.1					16: RMS T120, T162, T173					
8: AS 1289 1.2.1 clause 6.4 (b), 2.1.1., 5.5.1, 5.6.1, 5.8.1					17: RMS T120, T164, T173					
9: Full details of Test Procedure 5.8.1 available on request										
Material Description										
1. CL-Clays of low plasticity, gravelly clays, sandy clays, silty clays			11. DGS40			* Cement Stabilised				
2. CI-Clay of medium plasticity, gravelly clays, sandy clays, silty clays			12. FCR20			# Lime Stabilised				
3. CH-Clays of high plasticity			13. FCR40			\$ Gypsum Stabilised				
4. SC-Clayey sands, sand-clay mixtures			14. RC - Recycled Concrete							
5. SM-Silty sands, sand-silt mixtures			15. Recycled Roadbase							
6. GC-Clayey gravels, gravel-sand-clay mixtures			16. RSB - Recycled Sub-base							
7. SP-Sand, crushed dust, filling sand, washed sand			17. CSS - Crushed Sandstone							
8. DGB20			18. RSS - Ripped Sandstone							
9. DGB40			19. Cowels Brown							
10. DGS20										

Form No R 020c Version 01 06/17 - issued by ER



Accreditation Number 2734
Corporate Site Number 2727

Accredited for compliance with
ISO/IEC 17025 - Testing.

A Kench 24/11/2017

Approved Signatory

Head Office:
34 Borec Road, Penrith NSW 2750
P O Box 880 Penrith NSW 2751
Telephone: (02) 4722 21

Prestons Laboratory:
Unit 4, 18-20 Whyalla Place, Prestons NSW 2170
Telephone: (02) 9607 6111 Facsimile: (02) 9607 6200

FIELD DENSITY RESULTS

DARACON CONTRACTORS PTY LTD
PO BOX 299
WALLSEND NSW 2287

Laboratory: Penrith
Job No: 8599/1
Date: 24/11/2017

PROJECT: SITE FILL TESTING - AREA B
RESIDENTIAL DEVELOPMENT.WOORONG PARK, MARSDEN PARK

Page 8 of 79

TEST NUMBER	3302	3303	3304	3305	3306	3307	3308	3309		
DATE TESTED	11/10/2017									
RESULTS										
Hiif Density Ratio	Standard	%	95.5	98	98	97.5	98	96.5	98	98
Moisture Variation from OMC (-Drier/+Wetter)		%	0.0	0.0	0.0	0.0	0.0	0.0	0.0	0.0
Specification	Density Ratio (Standard)		≥95%			Specification	Moisture Variance from OMC		±2%	
TEST LOCATION										
Easting	295122.951	295064.007	295443.563	295461.902	295500.887	295505.758	295480.681	295444.647		
Northing	6269001.238	6269003.942	6269486.614	6269456.231	6269427.425	6269412.357	6269421.035	6269445.523		
Reduced Level	m		17.368	16.066	15.478	15.561	16.648	16.978	16.277	15.261
Shown on Drawing No	8599/1-59				8599/1-58					
Retested by Test	-	-	-	-	-	-	-	-		
FIELD & LABORATORY DATA										
Field Wet Density	t/m ³	2.04	2.09	2.10	2.08	2.08	2.06	2.08	2.09	
Field Moisture Content	%	21.0	21.5	20.0	21.0	21.0	21.0	21.0	20.5	
Material retained on 19mm Sieve (wet)	%	<5	<5	<5	<5	<5	<5	<5	<5	
Lab Compaction result from test number		3302	3303	3304	3305	3306	3307	3308	3309	
Peak Converted Wet Density	t/m ³	2.14	2.13	2.14	2.13	2.12	2.14	2.12	2.13	
Apparent Optimum Moisture Content	%	21.0	21.5	20.0	20.5	21.0	21.0	21.0	20.0	
Number of Compaction Points		3	3	3	3	3	3	3	3	
Test Procedures - See Note Number		12	12	12	12	12	12	12	12	
Material Description - see below		2-3	3	2-3	2-3	2-3	2-3	2-3	2-3	
Notes										
1: Assigned Values have been obtained from our Penrith laboratory – Accreditation No 2734					10: AS 1289 1.2.1 clause 6.4 (b), 2.1.1, 5.3.1, 5.5.1, 5.6.1					
2: Assigned Values have been obtained from our Prestons laboratory – Accreditation No 14234					11: AS 1289 1.2.1 clause 6.4 (b), 2.1.1, 5.3.1, 5.7.1					
3: Results have been calculated using infinite decimal places. Therefore, calculated values may vary from those shown					12: AS 1289 1.2.1 clause 6.4 (b), 2.1.1, 5.7.1, 5.8.1					
4: AS 1289 1.2.1 clause 6.4 (b), 2.1.1, 5.1.1, 5.3.1, 5.4.1					13: RMS T111, T119, T120, T166					
5: AS 1289 1.2.1 clause 6.4 (b), 2.1.1, 5.2.1, 5.3.1, 5.4.1					14: RMS T111, T120, T166, T173					
6: AS 1289 1.2.1 clause 6.4 (b)					15: RMS T120, T119, T162					
7: AS 1289 1.2.1 clause 6.4 (b), 2.1.1, 5.2.1, 5.4.1, 5.8.1					16: RMS T120, T162, T173					
8: AS 1289 1.2.1 clause 6.4 (b), 2.1.1., 5.5.1, 5.6.1, 5.8.1					17: RMS T120, T164, T173					
9: Full details of Test Procedure 5.8.1 available on request										
Material Description										
1. CL-Clays of low plasticity, gravelly clays, sandy clays, silty clays			11. DGS40			* Cement Stabilised				
2. CI-Clay of medium plasticity, gravelly clays, sandy clays, silty clays			12. FCR20			# Lime Stabilised				
3. CH-Clays of high plasticity			13. FCR40			\$ Gypsum Stabilised				
4. SC-Clayey sands, sand-clay mixtures			14. RC - Recycled Concrete							
5. SM-Silty sands, sand-silt mixtures			15. Recycled Roadbase							
6. GC-Clayey gravels, gravel-sand-clay mixtures			16. RSB - Recycled Sub-base							
7. SP-Sand, crushed dust, filling sand, washed sand			17. CSS - Crushed Sandstone							
8. DGB20			18. RSS - Ripped Sandstone							
9. DGB40			19. Cowels Brown							
10. DGS20										

Form No R 020c Version 01 06/17 - issued by ER



Accreditation Number 2734
Corporate Site Number 2727

Accredited for compliance with
ISO/IEC 17025 - Testing.

A Kench 24/11/2017

Approved Signatory

Head Office:
34 Borec Road, Penrith NSW 2750
P O Box 880 Penrith NSW 2751
Telephone: (02) 4722 21

Prestons Laboratory:
Unit 4, 18-20 Whyalla Place, Prestons NSW 2170
Telephone: (02) 9607 6111 Facsimile: (02) 9607 6200

FIELD DENSITY RESULTS

DARACON CONTRACTORS PTY LTD
PO BOX 299
WALLSEND NSW 2287

Laboratory: Penrith
Job No: 8599/1
Date: 24/11/2017

PROJECT: SITE FILL TESTING - AREA B
RESIDENTIAL DEVELOPMENT.WOORONG PARK, MARSDEN PARK

Page 9 of 79

TEST NUMBER	3310	3311	3312	3313	3314	3315	3316	3317		
DATE TESTED	11/10/2017									
RESULTS										
Hiif Density Ratio	Standard	%	97.5	98	97.5	96.5	98.5	96	96.5	96
Moisture Variation from OMC (-Drier/+Wetter)		%	0.0	0.0	0.0	0.5	0.0	0.0	0.0	0.5
Specification	Density Ratio (Standard)	≥95%	Specification Moisture Variance from OMC				±2%			
TEST LOCATION										
Easting	295432.32	295451.512	295489.755	295545.415	295522.321	295534.691	295560.623	295560.186		
Northing	6269431.452	6269412.299	6269381.312	6269625.838	6269643.349	6269653.257	6269644.135	6269672.586		
Reduced Level	m	15.109	15.801	16.387	15.056	13.836	14.034	15.014	14.728	
Shown on Drawing No	8599/1-58				8599/1-57					
Retested by Test	-	-	-	-	-	-	-	-		
FIELD & LABORATORY DATA										
Field Wet Density	t/m ³	2.09	2.11	2.07	2.06	2.10	2.04	2.06	2.05	
Field Moisture Content	%	21.0	18.0	17.5	17.0	17.0	18.0	18.5	17.0	
Material retained on 19mm Sieve (wet)	%	<5	<5	<5	<5	<5	<5	<5	<5	
Lab Compaction result from test number		3310	3311	3312	3313	3314	3315	3316	3317	
Peak Converted Wet Density	t/m ³	2.14	2.15	2.12	2.13	2.13	2.13	2.13	2.13	
Apparent Optimum Moisture Content	%	20.5	18.0	17.5	17.0	17.0	17.5	18.5	17.0	
Number of Compaction Points		3	3	3	3	3	3	3	3	
Test Procedures - See Note Number		12	12	12	12	12	12	12	12	
Material Description - see below		2-3	2	2	2	2	2	2-3	2	
Notes										
1: Assigned Values have been obtained from our Penrith laboratory – Accreditation No 2734					10: AS 1289 1.2.1 clause 6.4 (b), 2.1.1, 5.3.1, 5.5.1, 5.6.1					
2: Assigned Values have been obtained from our Prestons laboratory – Accreditation No 14234					11: AS 1289 1.2.1 clause 6.4 (b), 2.1.1, 5.3.1, 5.7.1					
3: Results have been calculated using infinite decimal places. Therefore, calculated values may vary from those shown					12: AS 1289 1.2.1 clause 6.4 (b), 2.1.1, 5.7.1, 5.8.1					
4: AS 1289 1.2.1 clause 6.4 (b), 2.1.1, 5.1.1, 5.3.1, 5.4.1					13: RMS T111, T119, T120, T166					
5: AS 1289 1.2.1 clause 6.4 (b), 2.1.1, 5.2.1, 5.3.1, 5.4.1					14: RMS T111, T120, T166, T173					
6: AS 1289 1.2.1 clause 6.4 (b),					15: RMS T120, T119, T162					
7: AS 1289 1.2.1 clause 6.4 (b), 2.1.1, 5.2.1, 5.4.1, 5.8.1					16: RMS T120, T162, T173					
8: AS 1289 1.2.1 clause 6.4 (b), 2.1.1., 5.5.1, 5.6.1, 5.8.1					17: RMS T120, T164, T173					
9: Full details of Test Procedure 5.8.1 available on request										
Material Description										
1. CL-Clays of low plasticity, gravelly clays, sandy clays, silty clays			11. DGS40			* Cement Stabilised				
2. CI-Clay of medium plasticity, gravelly clays, sandy clays, silty clays			12. FCR20			# Lime Stabilised				
3. CH-Clays of high plasticity			13. FCR40			\$ Gypsum Stabilised				
4. SC-Clayey sands, sand-clay mixtures			14. RC - Recycled Concrete							
5. SM-Silty sands, sand-silt mixtures			15. Recycled Roadbase							
6. GC-Clayey gravels, gravel-sand-clay mixtures			16. RSB - Recycled Sub-base							
7. SP-Sand, crushed dust, filling sand, washed sand			17. CSS - Crushed Sandstone							
8. DGB20			18. RSS - Ripped Sandstone							
9. DGB40			19. Cowels Brown							
10. DGS20										

Form No R 020c Version 01 06/17 - issued by ER



Accreditation Number 2734
Corporate Site Number 2727

Accredited for compliance with
ISO/IEC 17025 - Testing.

A Kench 24/11/2017

Approved Signatory

Head Office:
34 Borec Road, Penrith NSW 2750
P O Box 880 Penrith NSW 2751
Telephone: (02) 4722 21

Prestons Laboratory:
Unit 4, 18-20 Whyalla Place, Prestons NSW 2170
Telephone: (02) 9607 6111 Facsimile: (02) 9607 6200

FIELD DENSITY RESULTS

DARACON CONTRACTORS PTY LTD
PO BOX 299
WALLSEND NSW 2287

Laboratory: Penrith
Job No: 8599/1
Date: 24/11/2017

PROJECT: SITE FILL TESTING - AREA B
RESIDENTIAL DEVELOPMENT.WOORONG PARK, MARSDEN PARK

Page 10 of 79

TEST NUMBER	3318	3319	3320	3321	3322	3323	3324	3325		
DATE TESTED	11/10/2017			12/10/2017						
RESULTS										
Hilf Density Ratio	Standard	%	97.5	97.5	96.5	96.5	98.5	95.5	98	96.5
Moisture Variation from OMC (-Drier/+Wetter)		%	0.0	0.0	0.0	0.0	0.0	0.0	0.0	0.0
Specification	Density Ratio (Standard)	≥95%	Specification				Moisture Variance from OMC			±2%
TEST LOCATION										
Easting	295047.631	295085.812	295123.312	295134.457	295096.738	295054.208	295048.954	295082.092		
Northing	6269023.514	6269019.769	6269017.347	6268997.955	6269004.423	6269006.923	6268989.24	6268982.007		
Reduced Level	m	15.005	16.104	17.16	17.618	17.166	15.778	16.16	17.069	
Shown on Drawing No	8599/1-59									
Retested by Test	-	-	-	-	-	-	-	-		
FIELD & LABORATORY DATA										
Field Wet Density	t/m ³	2.08	2.10	2.06	2.07	2.10	2.02	2.09	2.06	
Field Moisture Content	%	18.0	17.5	18.5	19.0	18.5	18.0	20.0	18.5	
Material retained on 19mm Sieve (wet)	%	<5	<5	<5	<5	<5	<5	<5	<5	
Lab Compaction result from test number		3318	3319	3320	3321	3322	3323	3324	3325	
Peak Converted Wet Density	t/m ³	2.13	2.15	2.13	2.14	2.13	2.12	2.13	2.13	
Apparent Optimum Moisture Content	%	18.0	18.0	18.5	19.0	18.0	18.0	20.0	18.0	
Number of Compaction Points		3	3	3	3	3	3	3	3	
Test Procedures - See Note Number		12	12	12	12	12	12	12	12	
Material Description - see below		2	2	2	2-3	2	2	2-3	2	
Notes										
1: Assigned Values have been obtained from our Penrith laboratory – Accreditation No 2734					10: AS 1289 1.2.1 clause 6.4 (b), 2.1.1, 5.3.1, 5.5.1, 5.6.1					
2: Assigned Values have been obtained from our Prestons laboratory – Accreditation No 14234					11: AS 1289 1.2.1 clause 6.4 (b), 2.1.1, 5.3.1, 5.7.1					
3: Results have been calculated using infinite decimal places. Therefore, calculated values may vary from those shown					12: AS 1289 1.2.1 clause 6.4 (b), 2.1.1, 5.7.1, 5.8.1					
4: AS 1289 1.2.1 clause 6.4 (b), 2.1.1, 5.1.1, 5.3.1, 5.4.1					13: RMS T111, T119, T120, T166					
5: AS 1289 1.2.1 clause 6.4 (b), 2.1.1, 5.2.1, 5.3.1, 5.4.1					14: RMS T111, T120, T166, T173					
6: AS 1289 1.2.1 clause 6.4 (b),					15: RMS T120, T119, T162					
7: AS 1289 1.2.1 clause 6.4 (b), 2.1.1, 5.2.1, 5.4.1, 5.8.1					16: RMS T120, T162, T173					
8: AS 1289 1.2.1 clause 6.4 (b), 2.1.1., 5.5.1, 5.6.1, 5.8.1					17: RMS T120, T164, T173					
9: Full details of Test Procedure 5.8.1 available on request										
Material Description										
1. CL-Clays of low plasticity, gravelly clays, sandy clays, silty clays			11. DGS40			* Cement Stabilised				
2. CI-Clay of medium plasticity, gravelly clays, sandy clays, silty clays			12. FCR20			# Lime Stabilised				
3. CH-Clays of high plasticity			13. FCR40			\$ Gypsum Stabilised				
4. SC-Clayey sands, sand-clay mixtures			14. RC - Recycled Concrete							
5. SM-Silty sands, sand-silt mixtures			15. Recycled Roadbase							
6. GC-Clayey gravels, gravel-sand-clay mixtures			16. RSB - Recycled Sub-base							
7. SP-Sand, crushed dust, filling sand, washed sand			17. CSS - Crushed Sandstone							
8. DGB20			18. RSS - Ripped Sandstone							
9. DGB40			19. Cowels Brown							
10. DGS20										

Form No R 020c Version 01 06/17 - issued by ER



Accreditation Number 2734
Corporate Site Number 2727

Accredited for compliance with
ISO/IEC 17025 - Testing.

A Kench 24/11/2017

Approved Signatory

Head Office:
34 Borec Road, Penrith NSW 2750
P O Box 880 Penrith NSW 2751
Telephone: (02) 4722 21

Prestons Laboratory:
Unit 4, 18-20 Whyalla Place, Prestons NSW 2170
Telephone: (02) 9607 6111 Facsimile: (02) 9607 6200

FIELD DENSITY RESULTS

DARACON CONTRACTORS PTY LTD
PO BOX 299
WALLSEND NSW 2287

Laboratory: Penrith
Job No: 8599/1
Date: 24/11/2017

PROJECT: SITE FILL TESTING - AREA B
RESIDENTIAL DEVELOPMENT.WOORONG PARK, MARSDEN PARK

Page 11 of 79

TEST NUMBER	3326	3327	3328	3329	3330	3331	3332	3333		
DATE TESTED	12/10/2017									
RESULTS										
Hilf Density Ratio	Standard	%	98	96.5	96.5	97	96.5	98	96	96.5
Moisture Variation from OMC (-Drier/+Wetter)		%	0.0	0.0	0.0	0.0	0.0	0.0	0.0	0.0
Specification	Density Ratio (Standard)		≥95%			Specification	Moisture Variance from OMC		±2%	
TEST LOCATION										
Easting	295125.924	295129.535	295087.511	295048.333	295046.786	295097.539	295540.234	295516.179		
Northing	6268973.936	6268955.257	6268958.898	6268963.046	6268946.615	6268942.591	6269465.204	6269491.638		
Reduced Level	m	17.685	18.227	17.414	16.584	16.932	17.986	18.207	17.67	
Shown on Drawing No	8599/1-59							8599/1-58		
Retested by Test	-	-	-	-	-	-	-	-		
FIELD & LABORATORY DATA										
Field Wet Density	t/m ³	2.08	2.06	2.04	2.07	2.06	2.08	2.05	2.07	
Field Moisture Content	%	19.0	18.0	17.0	18.5	19.0	18.5	17.5	16.5	
Material retained on 19mm Sieve (wet)	%	<5	<5	<5	<5	<5	<5	<5	<5	
Lab Compaction result from test number		3326	3327	3328	3329	3330	3331	3332	3333	
Peak Converted Wet Density	t/m ³	2.12	2.13	2.11	2.13	2.13	2.12	2.13	2.14	
Apparent Optimum Moisture Content	%	19.0	18.0	16.5	18.5	19.5	18.5	17.5	16.5	
Number of Compaction Points		3	3	3	3	3	3	3	3	
Test Procedures - See Note Number		12	12	12	12	12	12	12	12	
Material Description - see below		2-3	2	2	2	2-3	2	2	2	
Notes										
1: Assigned Values have been obtained from our Penrith laboratory – Accreditation No 2734					10: AS 1289 1.2.1 clause 6.4 (b), 2.1.1, 5.3.1, 5.5.1, 5.6.1					
2: Assigned Values have been obtained from our Prestons laboratory – Accreditation No 14234					11: AS 1289 1.2.1 clause 6.4 (b), 2.1.1, 5.3.1, 5.7.1					
3: Results have been calculated using infinite decimal places. Therefore, calculated values may vary from those shown					12: AS 1289 1.2.1 clause 6.4 (b), 2.1.1, 5.7.1, 5.8.1					
4: AS 1289 1.2.1 clause 6.4 (b), 2.1.1, 5.1.1, 5.3.1, 5.4.1					13: RMS T111, T119, T120, T166					
5: AS 1289 1.2.1 clause 6.4 (b), 2.1.1, 5.2.1, 5.3.1, 5.4.1					14: RMS T111, T120, T166, T173					
6: AS 1289 1.2.1 clause 6.4 (b),					15: RMS T120, T119, T162					
7: AS 1289 1.2.1 clause 6.4 (b), 2.1.1, 5.2.1, 5.4.1, 5.8.1					16: RMS T120, T162, T173					
8: AS 1289 1.2.1 clause 6.4 (b), 2.1.1., 5.5.1, 5.6.1, 5.8.1					17: RMS T120, T164, T173					
9: Full details of Test Procedure 5.8.1 available on request										
Material Description										
1. CL-Clays of low plasticity, gravelly clays, sandy clays, silty clays			11. DGS40			* Cement Stabilised				
2. CI-Clay of medium plasticity, gravelly clays, sandy clays, silty clays			12. FCR20			# Lime Stabilised				
3. CH-Clays of high plasticity			13. FCR40			\$ Gypsum Stabilised				
4. SC-Clayey sands, sand-clay mixtures			14. RC - Recycled Concrete							
5. SM-Silty sands, sand-silt mixtures			15. Recycled Roadbase							
6. GC-Clayey gravels, gravel-sand-clay mixtures			16. RSB - Recycled Sub-base							
7. SP-Sand, crushed dust, filling sand, washed sand			17. CSS - Crushed Sandstone							
8. DGB20			18. RSS - Ripped Sandstone							
9. DGB40			19. Cowels Brown							
10. DGS20										

Form No R 020c Version 01 06/17 - issued by ER



Accreditation Number 2734
Corporate Site Number 2727

Accredited for compliance with
ISO/IEC 17025 - Testing.

A Kench 24/11/2017

Approved Signatory

Head Office:
34 Borec Road, Penrith NSW 2750
P O Box 880 Penrith NSW 2751
Telephone: (02) 4722 21

Prestons Laboratory:
Unit 4, 18-20 Whyalla Place, Prestons NSW 2170
Telephone: (02) 9607 6111 Facsimile: (02) 9607 6200

FIELD DENSITY RESULTS

DARACON CONTRACTORS PTY LTD
PO BOX 299
WALLSEND NSW 2287

Laboratory: Penrith
Job No: 8599/1
Date: 24/11/2017

PROJECT: SITE FILL TESTING - AREA B
RESIDENTIAL DEVELOPMENT.WOORONG PARK, MARSDEN PARK

Page 12 of 79

TEST NUMBER	3334	3335	3336	3337	3338	3339	3340	3341		
DATE TESTED	12/10/2017									
RESULTS										
Hilf Density Ratio	Standard	%	98	98	98	97.5	96	95.5	99.5	96.5
Moisture Variation from OMC (-Drier/+Wetter)		%	0.0	0.0	0.0	0.0	0.0	0.0	0.0	0.5
Specification	Density Ratio (Standard)	≥95%	Specification				Moisture Variance from OMC			±2%
TEST LOCATION										
Easting	295487.16	295477.363	295505.896	295532.442	295515.34	295482.187	295450.423	295405.682		
Northing	6269511.266	6269495.501	6269477.22	6269454.436	6269443.685	6269466.52	6269490.777	6269412.182		
Reduced Level	m	17.457	17.549	17.643	18.167	17.797	16.893	16.398	14.538	
Shown on Drawing No	8599/1-58									
Retested by Test	-	-	-	-	-	-	-	-		
FIELD & LABORATORY DATA										
Field Wet Density	t/m ³	2.09	2.09	2.08	2.08	2.06	2.03	2.11	2.06	
Field Moisture Content	%	17.0	17.0	19.5	19.0	19.0	18.5	17.0	18.0	
Material retained on 19mm Sieve (wet)	%	<5	<5	<5	<5	<5	<5	<5	<5	
Lab Compaction result from test number		3334	3335	3336	3337	3338	3339	3340	3341	
Peak Converted Wet Density	t/m ³	2.13	2.13	2.12	2.13	2.15	2.13	2.12	2.13	
Apparent Optimum Moisture Content	%	16.5	17.0	19.5	19.0	19.0	18.5	17.0	17.5	
Number of Compaction Points		3	3	3	3	3	3	3	3	
Test Procedures - See Note Number		12	12	12	12	12	12	12	12	
Material Description - see below		2	2	2-3	2-3	2-3	2	2	2	
Notes										
1: Assigned Values have been obtained from our Penrith laboratory – Accreditation No 2734					10: AS 1289 1.2.1 clause 6.4 (b), 2.1.1, 5.3.1, 5.5.1, 5.6.1					
2: Assigned Values have been obtained from our Prestons laboratory – Accreditation No 14234					11: AS 1289 1.2.1 clause 6.4 (b), 2.1.1, 5.3.1, 5.7.1					
3: Results have been calculated using infinite decimal places. Therefore, calculated values may vary from those shown										
4: AS 1289 1.2.1 clause 6.4 (b), 2.1.1, 5.1.1, 5.3.1, 5.4.1					12: AS 1289 1.2.1 clause 6.4 (b), 2.1.1, 5.7.1, 5.8.1					
5: AS 1289 1.2.1 clause 6.4 (b), 2.1.1, 5.2.1, 5.3.1, 5.4.1					13: RMS T111, T119, T120, T166					
6: AS 1289 1.2.1 clause 6.4 (b)					14: RMS T111, T120, T166, T173					
7: AS 1289 1.2.1 clause 6.4 (b), 2.1.1, 5.2.1, 5.4.1, 5.8.1					15: RMS T120, T119, T162					
8: AS 1289 1.2.1 clause 6.4 (b), 2.1.1., 5.5.1, 5.6.1, 5.8.1					16: RMS T120, T162, T173					
9: Full details of Test Procedure 5.8.1 available on request					17: RMS T120, T164, T173					
Material Description										
1. CL-Clays of low plasticity, gravelly clays, sandy clays, silty clays			11. DGS40			* Cement Stabilised				
2. CI-Clay of medium plasticity, gravelly clays, sandy clays, silty clays			12. FCR20			# Lime Stabilised				
3. CH-Clays of high plasticity			13. FCR40			\$ Gypsum Stabilised				
4. SC-Clayey sands, sand-clay mixtures			14. RC - Recycled Concrete							
5. SM-Silty sands, sand-silt mixtures			15. Recycled Roadbase							
6. GC-Clayey gravels, gravel-sand-clay mixtures			16. RSB - Recycled Sub-base							
7. SP-Sand, crushed dust, filling sand, washed sand			17. CSS - Crushed Sandstone							
8. DGB20			18. RSS - Ripped Sandstone							
9. DGB40			19. Cowels Brown							
10. DGS20										

Form No R 020c Version 01 06/17 - issued by ER



Accreditation Number 2734
Corporate Site Number 2727

Accredited for compliance with
ISO/IEC 17025 - Testing.

A Kench 24/11/2017

Approved Signatory

Head Office:
34 Borec Road, Penrith NSW 2750
P O Box 880 Penrith NSW 2751
Telephone: (02) 4722 21

Prestons Laboratory:
Unit 4, 18-20 Whyalla Place, Prestons NSW 2170
Telephone: (02) 9607 6111 Facsimile: (02) 9607 6200

FIELD DENSITY RESULTS

DARACON CONTRACTORS PTY LTD
PO BOX 299
WALLSEND NSW 2287

Laboratory: Penrith
Job No: 8599/1
Date: 24/11/2017

PROJECT: SITE FILL TESTING - AREA B
RESIDENTIAL DEVELOPMENT.WOORONG PARK, MARSDEN PARK

TEST NUMBER	3342	3343	3344	3345	3346	3347	3348	3349		
DATE TESTED	12/10/2017									
RESULTS										
Hiif Density Ratio	Standard	%	96	97.5	98	97.5	97	95	96.5	99
Moisture Variation from OMC (-Drier/+Wetter)		%	0.0	-0.5	-0.5	0.0	0.0	0.0	0.0	0.0
Specification	Density Ratio (Standard)		≥95%			Specification	Moisture Variance from OMC		±2%	
TEST LOCATION										
Easting	295442.606	295489.087	295614.95	295585.901	295649.105	295631.179	295628.874	295630.95		
Northing	6269387.453	6269378.554	6269650.278	6269645.271	6269728.286	6269715.908	6269745.224	6269782.478		
Reduced Level	m		16.009	16.709	16.713	16.079	16.248	16.454	15.905	15.151
Shown on Drawing No	8599/1-58				8599/1-57					
Retested by Test	-	-	-	-	-	-	-	-		
FIELD & LABORATORY DATA										
Field Wet Density	t/m ³	2.04	2.07	2.10	2.08	2.07	2.03	2.06	2.10	
Field Moisture Content	%	18.5	17.5	17.0	17.5	18.0	18.0	17.5	17.5	
Material retained on 19mm Sieve (wet)	%	<5	<5	<5	<5	<5	<5	<5	<5	
Lab Compaction result from test number		3342	3343	3344	3345	3346	3347	3348	3349	
Peak Converted Wet Density	t/m ³	2.12	2.12	2.14	2.13	2.13	2.14	2.14	2.12	
Apparent Optimum Moisture Content	%	19.0	18.0	17.5	17.0	18.5	18.0	17.5	17.5	
Number of Compaction Points		3	3	3	3	3	3	3	3	
Test Procedures - See Note Number		12	12	12	12	12	12	12	12	
Material Description - see below		2	2	2	2	2	2	2	2	
Notes										
1: Assigned Values have been obtained from our Penrith laboratory – Accreditation No 2734					10: AS 1289 1.2.1 clause 6.4 (b), 2.1.1, 5.3.1, 5.5.1, 5.6.1					
2: Assigned Values have been obtained from our Prestons laboratory – Accreditation No 14234					11: AS 1289 1.2.1 clause 6.4 (b), 2.1.1, 5.3.1, 5.7.1					
3: Results have been calculated using infinite decimal places. Therefore, calculated values may vary from those shown					12: AS 1289 1.2.1 clause 6.4 (b), 2.1.1, 5.7.1, 5.8.1					
4: AS 1289 1.2.1 clause 6.4 (b), 2.1.1, 5.1.1, 5.3.1, 5.4.1					13: RMS T111, T119, T120, T166					
5: AS 1289 1.2.1 clause 6.4 (b), 2.1.1, 5.2.1, 5.3.1, 5.4.1					14: RMS T111, T120, T166, T173					
6: AS 1289 1.2.1 clause 6.4 (b),					15: RMS T120, T119, T162					
7: AS 1289 1.2.1 clause 6.4 (b), 2.1.1, 5.2.1, 5.4.1, 5.8.1					16: RMS T120, T162, T173					
8: AS 1289 1.2.1 clause 6.4 (b), 2.1.1., 5.5.1, 5.6.1, 5.8.1					17: RMS T120, T164, T173					
9: Full details of Test Procedure 5.8.1 available on request										
Material Description										
1. CL-Clays of low plasticity, gravelly clays, sandy clays, silty clays			11. DGS40			* Cement Stabilised				
2. CI-Clay of medium plasticity, gravelly clays, sandy clays, silty clays			12. FCR20			# Lime Stabilised				
3. CH-Clays of high plasticity			13. FCR40			\$ Gypsum Stabilised				
4. SC-Clayey sands, sand-clay mixtures			14. RC - Recycled Concrete							
5. SM-Silty sands, sand-silt mixtures			15. Recycled Roadbase							
6. GC-Clayey gravels, gravel-sand-clay mixtures			16. RSB - Recycled Sub-base							
7. SP-Sand, crushed dust, filling sand, washed sand			17. CSS - Crushed Sandstone							
8. DGB20			18. RSS - Ripped Sandstone							
9. DGB40			19. Cowels Brown							
10. DGS20										

Form No R 020c Version 01 06/17 - issued by ER



Accreditation Number 2734
Corporate Site Number 2727

Accredited for compliance with
ISO/IEC 17025 - Testing.

A Kench 24/11/2017

Approved Signatory

Head Office:
34 Borec Road, Penrith NSW 2750
P O Box 880 Penrith NSW 2751
Telephone: (02) 4722 21

Prestons Laboratory:
Unit 4, 18-20 Whyalla Place, Prestons NSW 2170
Telephone: (02) 9607 6111 Facsimile: (02) 9607 6200

FIELD DENSITY RESULTS

DARACON CONTRACTORS PTY LTD
PO BOX 299
WALLSEND NSW 2287

Laboratory: Penrith
Job No: 8599/1
Date: 24/11/2017

PROJECT: SITE FILL TESTING - AREA B
RESIDENTIAL DEVELOPMENT.WOORONG PARK, MARSDEN PARK

Page 14 of 79

TEST NUMBER	3350	3351	3352	3353	3354	3355	3356	3357		
DATE TESTED	12/10/2017									
RESULTS										
Hilf Density Ratio	Standard	%	97.5	97	95	97	97	96.5	97	97.5
Moisture Variation from OMC (-Drier/+Wetter)		%	0.0	0.0	0.0	0.0	0.0	-1.0	-0.5	0.0
Specification	Density Ratio (Standard)	≥95%	Specification				Moisture Variance from OMC			±2%
TEST LOCATION										
Easting	295602.115	296419.644	296371.943	296358.977	296416.079	296421.936	296372.43	296430.726		
Northing	6269759.741	6268762.877	6268758.411	6268742.274	6268750.144	6268735.222	6268726.186	6268721.647		
Reduced Level	m									
Shown on Drawing No	15.088	20.997	20.172	19.806	21.032	20.817	20.003	20.984		
Retested by Test	8599/1-57				8599/1-64					
-	-	-	-	-	-	-	-	-		
FIELD & LABORATORY DATA										
Field Wet Density	t/m ³		2.09	2.08	2.03	2.07	2.08	2.07	2.07	2.08
Field Moisture Content	%		18.5	17.5	17.0	16.0	16.0	16.0	18.5	16.0
Material retained on 19mm Sieve (wet)	%		<5	<5	<5	<5	<5	<5	<5	<5
Lab Compaction result from test number			3350	3351	3352	3353	3354	3355	3356	3357
Peak Converted Wet Density	t/m ³		2.14	2.14	2.14	2.13	2.14	2.15	2.13	2.13
Apparent Optimum Moisture Content	%		18.5	17.5	17.0	16.0	16.0	16.5	19.0	16.0
Number of Compaction Points			3	3	3	3	3	3	3	3
Test Procedures - See Note Number			12	12	12	12	12	12	12	12
Material Description - see below			2	2	2	2	2	2	2-3	2
Notes										
1: Assigned Values have been obtained from our Penrith laboratory – Accreditation No 2734			10: AS 1289 1.2.1 clause 6.4 (b), 2.1.1, 5.3.1, 5.5.1, 5.6.1			11: AS 1289 1.2.1 clause 6.4 (b), 2.1.1, 5.3.1, 5.7.1				
2: Assigned Values have been obtained from our Prestons laboratory – Accreditation No 14234			12: AS 1289 1.2.1 clause 6.4 (b), 2.1.1, 5.7.1, 5.8.1			13: RMS T111, T119, T120, T166				
3: Results have been calculated using infinite decimal places. Therefore, calculated values may vary from those shown										
4: AS 1289 1.2.1 clause 6.4 (b), 2.1.1, 5.1.1, 5.3.1, 5.4.1			14: RMS T111, T120, T166, T173			15: RMS T120, T119, T162				
5: AS 1289 1.2.1 clause 6.4 (b), 2.1.1, 5.2.1, 5.3.1, 5.4.1			16: RMS T120, T162, T173			17: RMS T120, T164, T173				
6: AS 1289 1.2.1 clause 6.4 (b)										
7: AS 1289 1.2.1 clause 6.4 (b), 2.1.1, 5.2.1, 5.4.1, 5.8.1										
8: AS 1289 1.2.1 clause 6.4 (b), 2.1.1., 5.5.1, 5.6.1, 5.8.1										
9: Full details of Test Procedure 5.8.1 available on request										
Material Description										
1. CL-Clays of low plasticity, gravelly clays, sandy clays, silty clays			11. DGS40			* Cement Stabilised				
2. CI-Clay of medium plasticity, gravelly clays, sandy clays, silty clays			12. FCR20			# Lime Stabilised				
3. CH-Clays of high plasticity			13. FCR40			\$ Gypsum Stabilised				
4. SC-Clayey sands, sand-clay mixtures			14. RC - Recycled Concrete							
5. SM-Silty sands, sand-silt mixtures			15. Recycled Roadbase							
6. GC-Clayey gravels, gravel-sand-clay mixtures			16. RSB - Recycled Sub-base							
7. SP-Sand, crushed dust, filling sand, washed sand			17. CSS - Crushed Sandstone							
8. DGB20			18. RSS - Ripped Sandstone							
9. DGB40			19. Cowels Brown							
10. DGS20										

Form No R 020c Version 01 06/17 - issued by ER



Accreditation Number 2734
Corporate Site Number 2727

Accredited for compliance with
ISO/IEC 17025 - Testing.

A Kench 24/11/2017

Approved Signatory

Head Office:
34 Borec Road, Penrith NSW 2750
P O Box 880 Penrith NSW 2751
Telephone: (02) 4722 21

Prestons Laboratory:
Unit 4, 18-20 Whyalla Place, Prestons NSW 2170
Telephone: (02) 9607 6111 Facsimile: (02) 9607 6200

FIELD DENSITY RESULTS

DARACON CONTRACTORS PTY LTD
PO BOX 299
WALLSEND NSW 2287

Laboratory: Penrith
Job No: 8599/1
Date: 24/11/2017

PROJECT: SITE FILL TESTING - AREA B
RESIDENTIAL DEVELOPMENT.WOORONG PARK, MARSDEN PARK

TEST NUMBER	3358	3359	3360	3361	3362	3363	3364	3365		
DATE TESTED	12/10/2017					13/10/2017				
RESULTS										
Hilf Density Ratio	Standard	%	98.5	97	97.5	96.5	98	97	98	98
Moisture Variation from OMC (-Drier/+Wetter)		%	0.0	-0.5	0.0	0.0	0.0	0.5	0.0	0.0
Specification	Density Ratio (Standard)	≥95%	Specification Moisture Variance from OMC				±2%			
TEST LOCATION										
Easting	296406.395	296374.437	294904.523	294875.301	294843.315	294849.254	294874.871	294902.617		
Northing	6268712.038	6268699.956	6268767.041	6268772.853	6268775.386	6268755.373	6268744.513	6268729.216		
Reduced Level	m	20.59	19.654	19.365	18.028	16.496	17.262	18.91	20.225	
Shown on Drawing No	8599/1-64				8599/1-60					
Retested by Test	-	-	-	-	-	-	-	-		
FIELD & LABORATORY DATA										
Field Wet Density	t/m ³	2.10	2.08	2.08	2.07	2.09	2.06	2.04	2.10	
Field Moisture Content	%	17.0	16.0	17.0	16.5	17.5	20.0	19.5	20.0	
Material retained on 19mm Sieve (wet)	%	<5	<5	<5	<5	<5	<5	<5	<5	
Lab Compaction result from test number		3358	3359	3360	3361	3362	3363	3364	3365	
Peak Converted Wet Density	t/m ³	2.13	2.14	2.13	2.15	2.13	2.12	2.08	2.14	
Apparent Optimum Moisture Content	%	17.0	16.5	17.5	16.5	17.5	20.0	19.5	19.5	
Number of Compaction Points		3	3	3	3	3	3	3	3	
Test Procedures - See Note Number		12	12	12	12	12	12	12	12	
Material Description - see below		2	2	2	2	2	2-3	2-3	2-3	
Notes										
1: Assigned Values have been obtained from our Penrith laboratory – Accreditation No 2734					10: AS 1289 1.2.1 clause 6.4 (b), 2.1.1, 5.3.1, 5.5.1, 5.6.1					
2: Assigned Values have been obtained from our Prestons laboratory – Accreditation No 14234					11: AS 1289 1.2.1 clause 6.4 (b), 2.1.1, 5.3.1, 5.7.1					
3: Results have been calculated using infinite decimal places. Therefore, calculated values may vary from those shown					12: AS 1289 1.2.1 clause 6.4 (b), 2.1.1, 5.7.1, 5.8.1					
4: AS 1289 1.2.1 clause 6.4 (b), 2.1.1, 5.1.1, 5.3.1, 5.4.1					13: RMS T111, T119, T120, T166					
5: AS 1289 1.2.1 clause 6.4 (b), 2.1.1, 5.2.1, 5.3.1, 5.4.1					14: RMS T111, T120, T166, T173					
6: AS 1289 1.2.1 clause 6.4 (b)					15: RMS T120, T119, T162					
7: AS 1289 1.2.1 clause 6.4 (b), 2.1.1, 5.2.1, 5.4.1, 5.8.1					16: RMS T120, T162, T173					
8: AS 1289 1.2.1 clause 6.4 (b), 2.1.1, 5.5.1, 5.6.1, 5.8.1					17: RMS T120, T164, T173					
9: Full details of Test Procedure 5.8.1 available on request										
Material Description										
1. CL-Clays of low plasticity, gravelly clays, sandy clays, silty clays			11. DGS40			* Cement Stabilised				
2. CI-Clay of medium plasticity, gravelly clays, sandy clays, silty clays			12. FCR20			# Lime Stabilised				
3. CH-Clays of high plasticity			13. FCR40			\$ Gypsum Stabilised				
4. SC-Clayey sands, sand-clay mixtures			14. RC - Recycled Concrete							
5. SM-Silty sands, sand-silt mixtures			15. Recycled Roadbase							
6. GC-Clayey gravels, gravel-sand-clay mixtures			16. RSB - Recycled Sub-base							
7. SP-Sand, crushed dust, filling sand, washed sand			17. CSS - Crushed Sandstone							
8. DGB20			18. RSS - Ripped Sandstone							
9. DGB40			19. Cowels Brown							
10. DGS20										

Form No R 020c Version 01 06/17 - issued by ER



Accreditation Number 2734
Corporate Site Number 2727

Accredited for compliance with
ISO/IEC 17025 - Testing.

A Kench 24/11/2017

Approved Signatory

Head Office:
34 Borec Road, Penrith NSW 2750
P O Box 880 Penrith NSW 2751
Telephone: (02) 4722 21

Prestons Laboratory:
Unit 4, 18-20 Whyalla Place, Prestons NSW 2170
Telephone: (02) 9607 6111 Facsimile: (02) 9607 6200

FIELD DENSITY RESULTS

DARACON CONTRACTORS PTY LTD
PO BOX 299
WALLSEND NSW 2287

Laboratory: Penrith
Job No: 8599/1
Date: 24/11/2017

PROJECT: SITE FILL TESTING - AREA B
RESIDENTIAL DEVELOPMENT.WOORONG PARK, MARSDEN PARK

Page 16 of 79

TEST NUMBER	3366	3367	3368	3369	3370	3371	3372	3373	
DATE TESTED	13/10/2017								
RESULTS									
Hilf Density Ratio	Standard	%	97	96.5	98.5	97	96.5	96.5	
Moisture Variation from OMC (-Drier/+Wetter)		%	0.0	0.5	0.5	0.0	0.0	0.5	
Specification	Density Ratio (Standard)	≥95%	Specification			Moisture Variance from OMC			±2%
TEST LOCATION									
Easting	294883.795	294849.1	294831.096	294870.193	294896.329	294883.924	294849.707	294820.678	
Northing	6268726.06	6268733.102	6268711.431	6268704.41	6268698.413	6268682.361	6268683.824	6268675.121	
Reduced Level	m	19.302	17.761	17.096	19.139	20.294	19.704	18.217	
Shown on Drawing No	8599/1-60				8599/1-61				
Retested by Test	-	-	-	-	-	-	-	-	
FIELD & LABORATORY DATA									
Field Wet Density	t/m ³	2.07	2.07	2.09	2.07	2.06	2.05	2.07	
Field Moisture Content	%	22.5	19.5	19.5	19.5	20.5	18.0	19.5	
Material retained on 19mm Sieve (wet)	%	<5	<5	<5	<5	<5	<5	<5	
Lab Compaction result from test number		3366	3367	3368	3369	3370	3371	3372	
Peak Converted Wet Density	t/m ³	2.13	2.14	2.12	2.13	2.14	2.12	2.13	
Apparent Optimum Moisture Content	%	22.5	19.0	19.0	19.5	20.5	17.5	19.5	
Number of Compaction Points		3	3	3	3	3	3	3	
Test Procedures - See Note Number		12	12	12	12	12	12	12	
Material Description - see below		3	2-3	2-3	2-3	2-3	2	2-3	
Notes									
1: Assigned Values have been obtained from our Penrith laboratory – Accreditation No 2734					10: AS 1289 1.2.1 clause 6.4 (b), 2.1.1, 5.3.1, 5.5.1, 5.6.1				
2: Assigned Values have been obtained from our Prestons laboratory – Accreditation No 14234					11: AS 1289 1.2.1 clause 6.4 (b), 2.1.1, 5.3.1, 5.7.1				
3: Results have been calculated using infinite decimal places. Therefore, calculated values may vary from those shown					12: AS 1289 1.2.1 clause 6.4 (b), 2.1.1, 5.7.1, 5.8.1				
4: AS 1289 1.2.1 clause 6.4 (b), 2.1.1, 5.1.1, 5.3.1, 5.4.1					13: RMS T111, T119, T120, T166				
5: AS 1289 1.2.1 clause 6.4 (b), 2.1.1, 5.2.1, 5.3.1, 5.4.1					14: RMS T111, T120, T166, T173				
6: AS 1289 1.2.1 clause 6.4 (b),					15: RMS T120, T119, T162				
7: AS 1289 1.2.1 clause 6.4 (b), 2.1.1, 5.2.1, 5.4.1, 5.8.1					16: RMS T120, T162, T173				
8: AS 1289 1.2.1 clause 6.4 (b), 2.1.1., 5.5.1, 5.6.1, 5.8.1					17: RMS T120, T164, T173				
9: Full details of Test Procedure 5.8.1 available on request									
Material Description									
1. CL-Clays of low plasticity, gravelly clays, sandy clays, silty clays			11. DGS40			* Cement Stabilised			
2. CI-Clay of medium plasticity, gravelly clays, sandy clays, silty clays			12. FCR20			# Lime Stabilised			
3. CH-Clays of high plasticity			13. FCR40			\$ Gypsum Stabilised			
4. SC-Clayey sands, sand-clay mixtures			14. RC - Recycled Concrete						
5. SM-Silty sands, sand-silt mixtures			15. Recycled Roadbase						
6. GC-Clayey gravels, gravel-sand-clay mixtures			16. RSB - Recycled Sub-base						
7. SP-Sand, crushed dust, filling sand, washed sand			17. CSS - Crushed Sandstone						
8. DGB20			18. RSS - Ripped Sandstone						
9. DGB40			19. Cowels Brown						
10. DGS20									

Form No R 020c Version 01 06/17 - issued by ER



Accreditation Number 2734
Corporate Site Number 2727

Accredited for compliance with
ISO/IEC 17025 - Testing.

A Kench 24/11/2017

Approved Signatory

Head Office:
34 Borec Road, Penrith NSW 2750
P O Box 880 Penrith NSW 2751
Telephone: (02) 4722 21

Prestons Laboratory:
Unit 4, 18-20 Whyalla Place, Prestons NSW 2170
Telephone: (02) 9607 6111 Facsimile: (02) 9607 6200

FIELD DENSITY RESULTS

DARACON CONTRACTORS PTY LTD
PO BOX 299
WALLSEND NSW 2287

Laboratory: Penrith
Job No: 8599/1
Date: 24/11/2017

PROJECT: SITE FILL TESTING - AREA B
RESIDENTIAL DEVELOPMENT.WOORONG PARK, MARSDEN PARK

Page 17 of 79

TEST NUMBER	3374	3375	3376	3377	3378	3379	3380	3381		
DATE TESTED	13/10/2017									
RESULTS										
Hiif Density Ratio	Standard	%	96.5	96	96	3.5	96	97.5	98.5	97.5
Moisture Variation from OMC (-Drier/+Wetter)		%	0.5	0.0	0.0	0.0	0.0	0.5	1.0	0.5
Specification	Density Ratio (Standard)	≥95%	Specification			Moisture Variance from OMC			±2%	
TEST LOCATION										
Easting	294825.483	294855.471	294895.191	294942.693	294976.956	295011.395	295067.499	294993.3		
Northing	6268653.649	6268652.247	6268655.4	6268775.34	6268790.579	6268791.136	6268783.478	6268808.085		
Reduced Level	m	17.561	18.527	19.945	20.497	21.413	22.376	22.578	20.775	
Shown on Drawing No	8599/1-61				8599/1-60					
Retested by Test	-	-	-	-	-	-	-	-		
FIELD & LABORATORY DATA										
Field Wet Density	t/m ³	2.06	2.04	2.05	0.07	2.05	2.07	2.10	2.09	
Field Moisture Content	%	20.0	21.5	21.5	21.5	20.0	21.0	21.0	16.5	
Material retained on 19mm Sieve (wet)	%	<5	<5	<5	<5	<5	<5	<5	<5	
Lab Compaction result from test number		3374	3375	3376	3377	3378	3379	3380	3381	
Peak Converted Wet Density	t/m ³	2.13	2.13	2.14	2.12	2.13	2.12	2.13	2.14	
Apparent Optimum Moisture Content	%	19.5	21.5	21.5	21.5	20.0	20.5	20.0	16.5	
Number of Compaction Points		3	3	3	3	3	3	3	3	
Test Procedures - See Note Number		12	12	12	12	12	12	12	12	
Material Description - see below		2-3	3	3	3	2-3	2-3	2-3	2	
Notes										
1: Assigned Values have been obtained from our Penrith laboratory – Accreditation No 2734					10: AS 1289 1.2.1 clause 6.4 (b), 2.1.1, 5.3.1, 5.5.1, 5.6.1					
2: Assigned Values have been obtained from our Prestons laboratory – Accreditation No 14234					11: AS 1289 1.2.1 clause 6.4 (b), 2.1.1, 5.3.1, 5.7.1					
3: Results have been calculated using infinite decimal places. Therefore, calculated values may vary from those shown					12: AS 1289 1.2.1 clause 6.4 (b), 2.1.1, 5.7.1, 5.8.1					
4: AS 1289 1.2.1 clause 6.4 (b), 2.1.1, 5.1.1, 5.3.1, 5.4.1					13: RMS T111, T119, T120, T166					
5: AS 1289 1.2.1 clause 6.4 (b), 2.1.1, 5.2.1, 5.3.1, 5.4.1					14: RMS T111, T120, T166, T173					
6: AS 1289 1.2.1 clause 6.4 (b)					15: RMS T120, T119, T162					
7: AS 1289 1.2.1 clause 6.4 (b), 2.1.1, 5.2.1, 5.4.1, 5.8.1					16: RMS T120, T162, T173					
8: AS 1289 1.2.1 clause 6.4 (b), 2.1.1., 5.5.1, 5.6.1, 5.8.1					17: RMS T120, T164, T173					
9: Full details of Test Procedure 5.8.1 available on request										
Material Description										
1. CL-Clays of low plasticity, gravelly clays, sandy clays, silty clays			11. DGS40			* Cement Stabilised				
2. CI-Clay of medium plasticity, gravelly clays, sandy clays, silty clays			12. FCR20			# Lime Stabilised				
3. CH-Clays of high plasticity			13. FCR40			\$ Gypsum Stabilised				
4. SC-Clayey sands, sand-clay mixtures			14. RC - Recycled Concrete							
5. SM-Silty sands, sand-silt mixtures			15. Recycled Roadbase							
6. GC-Clayey gravels, gravel-sand-clay mixtures			16. RSB - Recycled Sub-base							
7. SP-Sand, crushed dust, filling sand, washed sand			17. CSS - Crushed Sandstone							
8. DGB20			18. RSS - Ripped Sandstone							
9. DGB40			19. Cowels Brown							
10. DGS20										

Form No R 020c Version 01 06/17 - issued by ER



Accreditation Number 2734
Corporate Site Number 2727

Accredited for compliance with
ISO/IEC 17025 - Testing.

A Kench 24/11/2017

Approved Signatory

Head Office:
34 Borec Road, Penrith NSW 2750
P O Box 880 Penrith NSW 2751
Telephone: (02) 4722 21

Prestons Laboratory:
Unit 4, 18-20 Whyalla Place, Prestons NSW 2170
Telephone: (02) 9607 6111 Facsimile: (02) 9607 6200

FIELD DENSITY RESULTS

DARACON CONTRACTORS PTY LTD
PO BOX 299
WALLSEND NSW 2287

Laboratory: Penrith
Job No: 8599/1
Date: 24/11/2017

PROJECT: SITE FILL TESTING - AREA B
RESIDENTIAL DEVELOPMENT.WOORONG PARK, MARSDEN PARK

Page 18 of 79

TEST NUMBER	3382	3383	3384	3385	3386	3387	3388	3389		
DATE TESTED	13/10/2017									
RESULTS										
Hiif Density Ratio	Standard	%	98.5	98	96.5	96.5	97	96.5	95.5	98
Moisture Variation from OMC (-Drier/+Wetter)		%	0.0	-0.5	-0.5	-0.5	-0.5	-0.5	-0.5	-0.5
Specification	Density Ratio (Standard)		≥95%				Specification	Moisture Variance from OMC	±2%	
TEST LOCATION										
Easting	295018.573	295046.395	295062.127	295026.432	294985.535	294985.949	294999.546	295013.684		
Northing	6268806.322	6268812.085	6268816.465	6268828.989	6268842.085	6268843.044	6268883.08	6268919.016		
Reduced Level	m	21.84	22.047	22.127	21.199	19.876	19.871	19.743	19.606	
Shown on Drawing No	8599/1-60									
Retested by Test	-	-	-	-	-	-	-	-	8599/1-59	
FIELD & LABORATORY DATA										
Field Wet Density	t/m ³	2.10	2.08	2.06	2.07	2.09	2.07	2.07	2.08	
Field Moisture Content	%	19.5	20.0	17.5	18.5	18.5	19.0	18.5	18.5	
Material retained on 19mm Sieve (wet)	%	<5	<5	<5	<5	<5	<5	<5	<5	
Lab Compaction result from test number		3382	3383	3384	3385	3386	3387	3388	3389	
Peak Converted Wet Density	t/m ³	2.13	2.12	2.13	2.14	2.15	2.15	2.17	2.12	
Apparent Optimum Moisture Content	%	19.5	21.0	18.0	19.5	19.0	19.5	19.0	19.5	
Number of Compaction Points		3	3	3	3	3	3	3	3	
Test Procedures - See Note Number		12	12	12	12	12	12	12	12	
Material Description - see below		23	2-3	2	2-3	2-3	2-3	2-3	2-3	
Notes										
1: Assigned Values have been obtained from our Penrith laboratory – Accreditation No 2734					10: AS 1289 1.2.1 clause 6.4 (b), 2.1.1, 5.3.1, 5.5.1, 5.6.1					
2: Assigned Values have been obtained from our Prestons laboratory – Accreditation No 14234					11: AS 1289 1.2.1 clause 6.4 (b), 2.1.1, 5.3.1, 5.7.1					
3: Results have been calculated using infinite decimal places. Therefore, calculated values may vary from those shown					12: AS 1289 1.2.1 clause 6.4 (b), 2.1.1, 5.7.1, 5.8.1					
4: AS 1289 1.2.1 clause 6.4 (b), 2.1.1, 5.1.1, 5.3.1, 5.4.1					13: RMS T111, T119, T120, T166					
5: AS 1289 1.2.1 clause 6.4 (b), 2.1.1, 5.2.1, 5.3.1, 5.4.1					14: RMS T111, T120, T166, T173					
6: AS 1289 1.2.1 clause 6.4 (b),					15: RMS T120, T119, T162					
7: AS 1289 1.2.1 clause 6.4 (b), 2.1.1, 5.2.1, 5.4.1, 5.8.1					16: RMS T120, T162, T173					
8: AS 1289 1.2.1 clause 6.4 (b), 2.1.1., 5.5.1, 5.6.1, 5.8.1					17: RMS T120, T164, T173					
9: Full details of Test Procedure 5.8.1 available on request										
Material Description										
1. CL-Clays of low plasticity, gravelly clays, sandy clays, silty clays			11. DGS40			* Cement Stabilised				
2. CI-Clay of medium plasticity, gravelly clays, sandy clays, silty clays			12. FCR20			# Lime Stabilised				
3. CH-Clays of high plasticity			13. FCR40			\$ Gypsum Stabilised				
4. SC-Clayey sands, sand-clay mixtures			14. RC - Recycled Concrete							
5. SM-Silty sands, sand-silt mixtures			15. Recycled Roadbase							
6. GC-Clayey gravels, gravel-sand-clay mixtures			16. RSB - Recycled Sub-base							
7. SP-Sand, crushed dust, filling sand, washed sand			17. CSS - Crushed Sandstone							
8. DGB20			18. RSS - Ripped Sandstone							
9. DGB40			19. Cowels Brown							
10. DGS20										

Form No R 020c Version 01 06/17 - issued by ER



Accreditation Number 2734
Corporate Site Number 2727

Accredited for compliance with
ISO/IEC 17025 - Testing.

A Kench 24/11/2017

Approved Signatory

Head Office:
34 Borec Road, Penrith NSW 2750
P O Box 880 Penrith NSW 2751
Telephone: (02) 4722 21

Prestons Laboratory:
Unit 4, 18-20 Whyalla Place, Prestons NSW 2170
Telephone: (02) 9607 6111 Facsimile: (02) 9607 6200

FIELD DENSITY RESULTS

DARACON CONTRACTORS PTY LTD
PO BOX 299
WALLSEND NSW 2287

Laboratory: Penrith
Job No: 8599/1
Date: 24/11/2017

PROJECT: SITE FILL TESTING - AREA B
RESIDENTIAL DEVELOPMENT.WOORONG PARK, MARSDEN PARK

Page 19 of 79

TEST NUMBER	3390	3391	3392	3393	3394	3395	3396	3397		
DATE TESTED	13/10/2017									
RESULTS										
Hilf Density Ratio	Standard	%	98.5	98	98	96	95	99.5	97.5	96
Moisture Variation from OMC (-Drier/+Wetter)		%	-0.5	-0.5	-0.5	-0.5	-0.5	-0.5	-0.5	-0.5
Specification	Density Ratio (Standard)	≥95%	Specification				Moisture Variance from OMC			±2%
TEST LOCATION										
Easting	295053.653	295052.099	295041.457	295125.917	295105.477	295056.975	295054.691	295084.986		
Northing	6268922.75	6268904.442	6268872.412	6268942.786	6268944.63	6268947.76	6268969.774	6268969.747		
Reduced Level	m	19.553	19.785	20.259	18.752	18.63	18.002	17.542	18.049	
Shown on Drawing No	8599/1-60									
Retested by Test	-	-	-	-	-	-	-	-		
FIELD & LABORATORY DATA										
Field Wet Density	t/m ³	2.10	2.10	2.11	2.07	2.06	2.11	2.08	2.05	
Field Moisture Content	%	20.0	17.0	18.5	18.0	18.5	19.0	19.0	18.5	
Material retained on 19mm Sieve (wet)	%	<5	<5	<5	<5	<5	<5	<5	<5	
Lab Compaction result from test number		3390	3391	3392	3393	3394	3395	3396	3397	
Peak Converted Wet Density	t/m ³	2.13	2.14	2.15	2.16	2.17	2.12	2.13	2.13	
Apparent Optimum Moisture Content	%	20.5	17.5	19.0	18.5	19.0	19.5	19.5	19.0	
Number of Compaction Points		3	3	3	3	3	3	3	3	
Test Procedures - See Note Number		12	12	12	12	12	12	12	12	
Material Description - see below		2-3	2	2-3	2	2-3	2-3	2-3	2-3	
Notes										
1: Assigned Values have been obtained from our Penrith laboratory – Accreditation No 2734					10: AS 1289 1.2.1 clause 6.4 (b), 2.1.1, 5.3.1, 5.5.1, 5.6.1					
2: Assigned Values have been obtained from our Prestons laboratory – Accreditation No 14234					11: AS 1289 1.2.1 clause 6.4 (b), 2.1.1, 5.3.1, 5.7.1					
3: Results have been calculated using infinite decimal places. Therefore, calculated values may vary from those shown					12: AS 1289 1.2.1 clause 6.4 (b), 2.1.1, 5.7.1, 5.8.1					
4: AS 1289 1.2.1 clause 6.4 (b), 2.1.1, 5.1.1, 5.3.1, 5.4.1					13: RMS T111, T119, T120, T166					
5: AS 1289 1.2.1 clause 6.4 (b), 2.1.1, 5.2.1, 5.3.1, 5.4.1					14: RMS T111, T120, T166, T173					
6: AS 1289 1.2.1 clause 6.4 (b)					15: RMS T120, T119, T162					
7: AS 1289 1.2.1 clause 6.4 (b), 2.1.1, 5.2.1, 5.4.1, 5.8.1					16: RMS T120, T162, T173					
8: AS 1289 1.2.1 clause 6.4 (b), 2.1.1, 5.5.1, 5.6.1, 5.8.1					17: RMS T120, T164, T173					
9: Full details of Test Procedure 5.8.1 available on request										
Material Description										
1. CL-Clays of low plasticity, gravelly clays, sandy clays, silty clays			11. DGS40			* Cement Stabilised				
2. CI-Clay of medium plasticity, gravelly clays, sandy clays, silty clays			12. FCR20			# Lime Stabilised				
3. CH-Clays of high plasticity			13. FCR40			\$ Gypsum Stabilised				
4. SC-Clayey sands, sand-clay mixtures			14. RC - Recycled Concrete							
5. SM-Silty sands, sand-silt mixtures			15. Recycled Roadbase							
6. GC-Clayey gravels, gravel-sand-clay mixtures			16. RSB - Recycled Sub-base							
7. SP-Sand, crushed dust, filling sand, washed sand			17. CSS - Crushed Sandstone							
8. DGB20			18. RSS - Ripped Sandstone							
9. DGB40			19. Cowels Brown							
10. DGS20										

Form No R 020c Version 01 06/17 - issued by ER



Accreditation Number 2734
Corporate Site Number 2727

Accredited for compliance with
ISO/IEC 17025 - Testing.

A Kench 24/11/2017

Approved Signatory

Head Office:
34 Borec Road, Penrith NSW 2750
P O Box 880 Penrith NSW 2751
Telephone: (02) 4722 21

Prestons Laboratory:
Unit 4, 18-20 Whyalla Place, Prestons NSW 2170
Telephone: (02) 9607 6111 Facsimile: (02) 9607 6200

FIELD DENSITY RESULTS

DARACON CONTRACTORS PTY LTD
PO BOX 299
WALLSEND NSW 2287

Laboratory: Penrith
Job No: 8599/1
Date: 24/11/2017

PROJECT: SITE FILL TESTING - AREA B
RESIDENTIAL DEVELOPMENT.WOORONG PARK, MARSDEN PARK

Page 20 of 79

TEST NUMBER	3398	3399	3400	3401	3402	3403	3404	3405		
DATE TESTED	13/10/2017									
RESULTS										
Hilf Density Ratio	Standard	%	95.5	99.5	99	2	97	95	96.5	96
Moisture Variation from OMC (-Drier/+Wetter)		%	-0.5	-0.5	0.0	0.0	0.0	-0.5	-0.5	0.0
Specification	Density Ratio (Standard)	≥95%	Specification				Moisture Variance from OMC			±2%
TEST LOCATION										
Easting	295107.092	295116.033	295079.702	295064.887	295103.374	295131.355	295432.489	295462.046		
Northing	6268970.639	6268993.962	6268999.128	6269016.798	6269019.993	6269020.918	6269424.768	6269413.049		
Reduced Level	m	18.326	18.29	17.694	16.877	17.674	17.952	16.02	16.832	
Shown on Drawing No	8599/1-60		8599/1-59				8599/1-58			
Retested by Test	-	-	-	-	-	-	-	-		
FIELD & LABORATORY DATA										
Field Wet Density	t/m ³	2.05	2.11	2.11	0.04	2.08	2.05	2.09	2.08	
Field Moisture Content	%	19.0	20.5	20.5	19.5	19.0	17.0	18.0	19.5	
Material retained on 19mm Sieve (wet)	%	<5	<5	<5	<5	<5	<5	<5	<5	
Lab Compaction result from test number		3398	3399	3400	3401	3402	3403	3404	3405	
Peak Converted Wet Density	t/m ³	2.15	2.12	2.13	2.14	2.14	2.16	2.17	2.17	
Apparent Optimum Moisture Content	%	19.5	21.0	21.0	19.5	19.0	18.0	18.5	19.5	
Number of Compaction Points		3	3	3	3	3	3	3	3	
Test Procedures - See Note Number		12	12	12	12	12	12	12	12	
Material Description - see below		2-3	2-3	2-3	2-3	2-3	2	2	2-3	
Notes										
1: Assigned Values have been obtained from our Penrith laboratory – Accreditation No 2734					10: AS 1289 1.2.1 clause 6.4 (b), 2.1.1, 5.3.1, 5.5.1, 5.6.1					
2: Assigned Values have been obtained from our Prestons laboratory – Accreditation No 14234					11: AS 1289 1.2.1 clause 6.4 (b), 2.1.1, 5.3.1, 5.7.1					
3: Results have been calculated using infinite decimal places. Therefore, calculated values may vary from those shown					12: AS 1289 1.2.1 clause 6.4 (b), 2.1.1, 5.7.1, 5.8.1					
4: AS 1289 1.2.1 clause 6.4 (b), 2.1.1, 5.1.1, 5.3.1, 5.4.1					13: RMS T111, T119, T120, T166					
5: AS 1289 1.2.1 clause 6.4 (b), 2.1.1, 5.2.1, 5.3.1, 5.4.1					14: RMS T111, T120, T166, T173					
6: AS 1289 1.2.1 clause 6.4 (b),					15: RMS T120, T119, T162					
7: AS 1289 1.2.1 clause 6.4 (b), 2.1.1, 5.2.1, 5.4.1, 5.8.1					16: RMS T120, T162, T173					
8: AS 1289 1.2.1 clause 6.4 (b), 2.1.1., 5.5.1, 5.6.1, 5.8.1					17: RMS T120, T164, T173					
9: Full details of Test Procedure 5.8.1 available on request										
Material Description										
1. CL-Clays of low plasticity, gravelly clays, sandy clays, silty clays			11. DGS40			* Cement Stabilised				
2. CI-Clay of medium plasticity, gravelly clays, sandy clays, silty clays			12. FCR20			# Lime Stabilised				
3. CH-Clays of high plasticity			13. FCR40			\$ Gypsum Stabilised				
4. SC-Clayey sands, sand-clay mixtures			14. RC - Recycled Concrete							
5. SM-Silty sands, sand-silt mixtures			15. Recycled Roadbase							
6. GC-Clayey gravels, gravel-sand-clay mixtures			16. RSB - Recycled Sub-base							
7. SP-Sand, crushed dust, filling sand, washed sand			17. CSS - Crushed Sandstone							
8. DGB20			18. RSS - Ripped Sandstone							
9. DGB40			19. Cowels Brown							
10. DGS20										

Form No R 020c Version 01 06/17 - issued by ER



Accreditation Number 2734
Corporate Site Number 2727

Accredited for compliance with
ISO/IEC 17025 - Testing.

A Kench 24/11/2017

Approved Signatory

Head Office:
34 Borec Road, Penrith NSW 2750
P O Box 880 Penrith NSW 2751
Telephone: (02) 4722 21

Prestons Laboratory:
Unit 4, 18-20 Whyalla Place, Prestons NSW 2170
Telephone: (02) 9607 6111 Facsimile: (02) 9607 6200

FIELD DENSITY RESULTS

DARACON CONTRACTORS PTY LTD
PO BOX 299
WALLSEND NSW 2287

Laboratory: Penrith
Job No: 8599/1
Date: 24/11/2017

PROJECT: SITE FILL TESTING - AREA B
RESIDENTIAL DEVELOPMENT.WOORONG PARK, MARSDEN PARK

Page 21 of 79

TEST NUMBER	3406	3407	3408	3409	3410	3411	3412	3413		
DATE TESTED	13/10/2017									
RESULTS										
Hilf Density Ratio	Standard	%	99	97	96	95.5	96	96	98.5	97.5
Moisture Variation from OMC (-Drier/+Wetter)		%	0.0	-0.5	-0.5	-0.5	0.0	-0.5	-0.5	0.0
Specification	Density Ratio (Standard)		≥95%			Specification Moisture Variance from OMC			±2%	
TEST LOCATION										
Easting	295492.217	295503.806	295483.205	295451.776	296450.987	296416.003	296386.718	296438.593		
Northing	6269395.794	6269418.529	6269433.352	6269450.058	6268713.374	6268702.831	6268693.6	6268742.712		
Reduced Level	m	17.313	17.335	16.706	15.966	22.2	21.779	20.979	21.736	
Shown on Drawing No	8599/1-58				8599/1-64					
Retested by Test	-	-	-	-	-	-	-	-		
FIELD & LABORATORY DATA										
Field Wet Density	t/m ³	2.09	2.08	2.05	2.05	2.07	2.05	2.11	2.10	
Field Moisture Content	%	18.5	18.5	17.5	19.0	20.0	17.0	17.5	19.0	
Material retained on 19mm Sieve (wet)	%	<5	<5	<5	<5	<5	<5	<5	<5	
Lab Compaction result from test number		3406	3407	3408	3409	3410	3411	3412	3413	
Peak Converted Wet Density	t/m ³	2.11	2.14	2.14	2.15	2.16	2.13	2.14	2.15	
Apparent Optimum Moisture Content	%	18.5	19.0	18.5	20.0	20.0	17.5	18.0	19.0	
Number of Compaction Points		3	3	3	3	3	3	3	3	
Test Procedures - See Note Number		12	12	12	12	12	12	12	12	
Material Description - see below		2	2-3	2	2-3	2-3	2	2	2-3	
Notes										
1: Assigned Values have been obtained from our Penrith laboratory – Accreditation No 2734					10: AS 1289 1.2.1 clause 6.4 (b), 2.1.1, 5.3.1, 5.5.1, 5.6.1					
2: Assigned Values have been obtained from our Prestons laboratory – Accreditation No 14234					11: AS 1289 1.2.1 clause 6.4 (b), 2.1.1, 5.3.1, 5.7.1					
3: Results have been calculated using infinite decimal places. Therefore, calculated values may vary from those shown					12: AS 1289 1.2.1 clause 6.4 (b), 2.1.1, 5.7.1, 5.8.1					
4: AS 1289 1.2.1 clause 6.4 (b), 2.1.1, 5.1.1, 5.3.1, 5.4.1					13: RMS T111, T119, T120, T166					
5: AS 1289 1.2.1 clause 6.4 (b), 2.1.1, 5.2.1, 5.3.1, 5.4.1					14: RMS T111, T120, T166, T173					
6: AS 1289 1.2.1 clause 6.4 (b)					15: RMS T120, T119, T162					
7: AS 1289 1.2.1 clause 6.4 (b), 2.1.1, 5.2.1, 5.4.1, 5.8.1					16: RMS T120, T162, T173					
8: AS 1289 1.2.1 clause 6.4 (b), 2.1.1., 5.5.1, 5.6.1, 5.8.1					17: RMS T120, T164, T173					
9: Full details of Test Procedure 5.8.1 available on request										
Material Description										
1. CL-Clays of low plasticity, gravelly clays, sandy clays, silty clays			11. DGS40			* Cement Stabilised				
2. CI-Clay of medium plasticity, gravelly clays, sandy clays, silty clays			12. FCR20			# Lime Stabilised				
3. CH-Clays of high plasticity			13. FCR40			\$ Gypsum Stabilised				
4. SC-Clayey sands, sand-clay mixtures			14. RC - Recycled Concrete							
5. SM-Silty sands, sand-silt mixtures			15. Recycled Roadbase							
6. GC-Clayey gravels, gravel-sand-clay mixtures			16. RSB - Recycled Sub-base							
7. SP-Sand, crushed dust, filling sand, washed sand			17. CSS - Crushed Sandstone							
8. DGB20			18. RSS - Ripped Sandstone							
9. DGB40			19. Cowels Brown							
10. DGS20										

Form No R 020c Version 01 06/17 - issued by ER



Accreditation Number 2734
Corporate Site Number 2727

Accredited for compliance with
ISO/IEC 17025 - Testing.

A Kench 24/11/2017

Approved Signatory

Head Office:
34 Borec Road, Penrith NSW 2750
P O Box 880 Penrith NSW 2751
Telephone: (02) 4722 21

Prestons Laboratory:
Unit 4, 18-20 Whyalla Place, Prestons NSW 2170
Telephone: (02) 9607 6111 Facsimile: (02) 9607 6200

FIELD DENSITY RESULTS

DARACON CONTRACTORS PTY LTD
PO BOX 299
WALLSEND NSW 2287

Laboratory: Penrith
Job No: 8599/1
Date: 24/11/2017

PROJECT: SITE FILL TESTING - AREA B
RESIDENTIAL DEVELOPMENT.WOORONG PARK, MARSDEN PARK

Page 22 of 79

TEST NUMBER	3414	3415	3416	3417	3418	3419	3420	3421		
DATE TESTED	13/10/2017									
RESULTS										
Hilf Density Ratio	Standard	%	96.5	97	97	95	96	97	97	96.5
Moisture Variation from OMC (-Drier/+Wetter)		%	-0.5	0.0	-0.5	0.0	-0.5	-0.5	-0.5	-0.5
Specification	Density Ratio (Standard)		≥95%			Specification	Moisture Variance from OMC		±2%	
TEST LOCATION										
Easting	296402.707	296361.988	296348.591	296389.564	296426.269	294815.258	294847.267	294876.667		
Northing	6268733.622	6268726.313	6268750.179	6268759.762	6268767.626	6268647.39	6268650.509	6268652.352		
Reduced Level	m	21.458	20.352	20.308	21.277	21.596	17.548	18.998	20.076	
Shown on Drawing No	8599/1-64						8599/1-61			
Retested by Test	-	-	-	-	-	-	-	-		
FIELD & LABORATORY DATA										
Field Wet Density	t/m ³	2.07	2.07	2.09	2.05	2.08	2.06	2.07	2.06	
Field Moisture Content	%	19.0	19.0	19.0	19.5	18.5	20.5	21.0	18.0	
Material retained on 19mm Sieve (wet)	%	<5	<5	<5	<5	<5	<5	<5	<5	
Lab Compaction result from test number		3414	3415	3416	3417	3418	3419	3420	3421	
Peak Converted Wet Density	t/m ³	2.15	2.13	2.15	2.16	2.17	2.12	2.13	2.14	
Apparent Optimum Moisture Content	%	19.5	19.0	20.0	19.5	19.0	21.0	21.5	18.5	
Number of Compaction Points		3	3	3	3	3	3	3	3	
Test Procedures - See Note Number		12	12	12	12	12	12	12	12	
Material Description - see below		2-3	2-3	2-3	3	2-3	2-3	3	2	
Notes										
1: Assigned Values have been obtained from our Penrith laboratory – Accreditation No 2734					10: AS 1289 1.2.1 clause 6.4 (b), 2.1.1, 5.3.1, 5.5.1, 5.6.1					
2: Assigned Values have been obtained from our Prestons laboratory – Accreditation No 14234					11: AS 1289 1.2.1 clause 6.4 (b), 2.1.1, 5.3.1, 5.7.1					
3: Results have been calculated using infinite decimal places. Therefore, calculated values may vary from those shown					12: AS 1289 1.2.1 clause 6.4 (b), 2.1.1, 5.7.1, 5.8.1					
4: AS 1289 1.2.1 clause 6.4 (b), 2.1.1, 5.1.1, 5.3.1, 5.4.1					13: RMS T111, T119, T120, T166					
5: AS 1289 1.2.1 clause 6.4 (b), 2.1.1, 5.2.1, 5.3.1, 5.4.1					14: RMS T111, T120, T166, T173					
6: AS 1289 1.2.1 clause 6.4 (b),					15: RMS T120, T119, T162					
7: AS 1289 1.2.1 clause 6.4 (b), 2.1.1, 5.2.1, 5.4.1, 5.8.1					16: RMS T120, T162, T173					
8: AS 1289 1.2.1 clause 6.4 (b), 2.1.1., 5.5.1, 5.6.1, 5.8.1					17: RMS T120, T164, T173					
9: Full details of Test Procedure 5.8.1 available on request										
Material Description										
1. CL-Clays of low plasticity, gravelly clays, sandy clays, silty clays			11. DGS40			* Cement Stabilised				
2. CI-Clay of medium plasticity, gravelly clays, sandy clays, silty clays			12. FCR20			# Lime Stabilised				
3. CH-Clays of high plasticity			13. FCR40			\$ Gypsum Stabilised				
4. SC-Clayey sands, sand-clay mixtures			14. RC - Recycled Concrete							
5. SM-Silty sands, sand-silt mixtures			15. Recycled Roadbase							
6. GC-Clayey gravels, gravel-sand-clay mixtures			16. RSB - Recycled Sub-base							
7. SP-Sand, crushed dust, filling sand, washed sand			17. CSS - Crushed Sandstone							
8. DGB20			18. RSS - Ripped Sandstone							
9. DGB40			19. Cowels Brown							
10. DGS20										

Form No R 020c Version 01 06/17 - issued by ER



Accreditation Number 2734
Corporate Site Number 2727

Accredited for compliance with
ISO/IEC 17025 - Testing.

A Kench 24/11/2017

Approved Signatory

Head Office:
34 Borec Road, Penrith NSW 2750
P O Box 880 Penrith NSW 2751
Telephone: (02) 4722 21

Prestons Laboratory:
Unit 4, 18-20 Whyalla Place, Prestons NSW 2170
Telephone: (02) 9607 6111 Facsimile: (02) 9607 6200

FIELD DENSITY RESULTS

DARACON CONTRACTORS PTY LTD
PO BOX 299
WALLSEND NSW 2287

Laboratory: Penrith
Job No: 8599/1
Date: 24/11/2017

PROJECT: SITE FILL TESTING - AREA B
RESIDENTIAL DEVELOPMENT.WOORONG PARK, MARSDEN PARK

Page 23 of 79

TEST NUMBER	3422	3423	3424	3425	3426	3427	3428	3429		
DATE TESTED	16/10/2017									
RESULTS										
Hiif Density Ratio	Standard	%	95.5	97	96	96.5	97	95	96.5	95
Moisture Variation from OMC (-Drier/+Wetter)		%	0.5	0.5	0.0	0.5	0.0	0.0	0.0	0.5
Specification	Density Ratio (Standard)		≥95%			Specification	Moisture Variance from OMC		±2%	
TEST LOCATION										
Easting	294877.253	294847.325	294823.617	294826.678	294852.945	294904.982	294892.627	294868.309		
Northing	6268682.702	6268684.557	6268689.44	6268720.636	6268722.747	6268720.248	6268751.835	6268763.377		
Reduced Level	m		19.919	18.719	17.422	17.104	18.8	20.43	19.861	18.599
Shown on Drawing No	8599/1-61								8599/1-60	
Retested by Test	-	-	-	-	-	-	-	-	-	-
FIELD & LABORATORY DATA										
Field Wet Density	t/m ³	2.07	2.09	2.06	2.08	2.06	2.05	2.07	2.05	
Field Moisture Content	%	20.0	17.5	20.0	19.5	19.0	20.0	18.5	19.0	
Material retained on 19mm Sieve (wet)	%	<5	<5	<5	<5	<5	<5	<5	<5	
Lab Compaction result from test number		3422	3423	3424	3425	3426	3427	3428	3429	
Peak Converted Wet Density	t/m ³	2.17	2.15	2.15	2.15	2.12	2.16	2.15	2.16	
Apparent Optimum Moisture Content	%	20.0	17.5	19.5	19.0	18.5	20.0	18.0	18.5	
Number of Compaction Points		3	3	3	3	3	3	3	3	
Test Procedures - See Note Number		12	12	12	12	12	12	12	12	
Material Description - see below		2-3	2	2-3	2-3	2	2-3	2	2	
Notes										
1: Assigned Values have been obtained from our Penrith laboratory – Accreditation No 2734					10: AS 1289 1.2.1 clause 6.4 (b), 2.1.1, 5.3.1, 5.5.1, 5.6.1					
2: Assigned Values have been obtained from our Prestons laboratory – Accreditation No 14234					11: AS 1289 1.2.1 clause 6.4 (b), 2.1.1, 5.3.1, 5.7.1					
3: Results have been calculated using infinite decimal places. Therefore, calculated values may vary from those shown					12: AS 1289 1.2.1 clause 6.4 (b), 2.1.1, 5.7.1, 5.8.1					
4: AS 1289 1.2.1 clause 6.4 (b), 2.1.1, 5.1.1, 5.3.1, 5.4.1					13: RMS T111, T119, T120, T166					
5: AS 1289 1.2.1 clause 6.4 (b), 2.1.1, 5.2.1, 5.3.1, 5.4.1					14: RMS T111, T120, T166, T173					
6: AS 1289 1.2.1 clause 6.4 (b),					15: RMS T120, T119, T162					
7: AS 1289 1.2.1 clause 6.4 (b), 2.1.1, 5.2.1, 5.4.1, 5.8.1					16: RMS T120, T162, T173					
8: AS 1289 1.2.1 clause 6.4 (b), 2.1.1., 5.5.1, 5.6.1, 5.8.1					17: RMS T120, T164, T173					
9: Full details of Test Procedure 5.8.1 available on request										
Material Description										
1. CL-Clays of low plasticity, gravelly clays, sandy clays, silty clays			11. DGS40			* Cement Stabilised				
2. CI-Clay of medium plasticity, gravelly clays, sandy clays, silty clays			12. FCR20			# Lime Stabilised				
3. CH-Clays of high plasticity			13. FCR40			\$ Gypsum Stabilised				
4. SC-Clayey sands, sand-clay mixtures			14. RC - Recycled Concrete							
5. SM-Silty sands, sand-silt mixtures			15. Recycled Roadbase							
6. GC-Clayey gravels, gravel-sand-clay mixtures			16. RSB - Recycled Sub-base							
7. SP-Sand, crushed dust, filling sand, washed sand			17. CSS - Crushed Sandstone							
8. DGB20			18. RSS - Ripped Sandstone							
9. DGB40			19. Cowels Brown							
10. DGS20										

Form No R 020c Version 01 06/17 - issued by ER



Accreditation Number 2734
Corporate Site Number 2727

Accredited for compliance with
ISO/IEC 17025 - Testing.

A Kench 24/11/2017

Approved Signatory

Head Office:
34 Borec Road, Penrith NSW 2750
P O Box 880 Penrith NSW 2751
Telephone: (02) 4722 21

Prestons Laboratory:
Unit 4, 18-20 Whyalla Place, Prestons NSW 2170
Telephone: (02) 9607 6111 Facsimile: (02) 9607 6200

FIELD DENSITY RESULTS

DARACON CONTRACTORS PTY LTD
PO BOX 299
WALLSEND NSW 2287

Laboratory: Penrith
Job No: 8599/1
Date: 24/11/2017

PROJECT: SITE FILL TESTING - AREA B
RESIDENTIAL DEVELOPMENT.WOORONG PARK, MARSDEN PARK

Page 24 of 79

TEST NUMBER	3430	3431	3432	3433	3434	3435	3436	3437		
DATE TESTED	16/10/2017									
RESULTS										
Hiif Density Ratio	Standard	%	97	96	97	95	96.5	95.5	96.5	96.5
Moisture Variation from OMC (-Drier/+Wetter)		%	-0.5	0.0	0.0	0.0	-0.5	0.5	0.5	0.0
Specification	Density Ratio (Standard)	≥95%	Specification				Moisture Variance from OMC			±2%
TEST LOCATION										
Easting	294841.494	295135.08	295091.198	295061.54	295050.925	295081.748	295104.922	295122.962		
Northing	6268774.488	6268942.396	6268947.066	6268947.01	6268966.378	6268966.06	6268965.879	6268999.655		
Reduced Level	m	16.8	19.197	19.277	18.949	18.255	19.034	19.189	18.444	
Shown on Drawing No	8599/1-60									
Retested by Test	-	-	-	-	-	-	-	-	8599/1-59	
FIELD & LABORATORY DATA										
Field Wet Density	t/m ³	2.09	2.07	2.09	2.05	2.08	2.06	2.07	2.07	
Field Moisture Content	%	17.0	18.5	18.5	18.0	17.5	19.5	17.5	19.5	
Material retained on 19mm Sieve (wet)	%	<5	<5	<5	<5	<5	<5	<5	<5	
Lab Compaction result from test number		3430	3431	3432	3433	3434	3435	3436	3437	
Peak Converted Wet Density	t/m ³	2.16	2.16	2.15	2.16	2.15	2.16	2.15	2.15	
Apparent Optimum Moisture Content	%	17.5	18.0	18.0	18.0	18.0	19.0	17.0	19.0	
Number of Compaction Points		3	3	3	3	3	3	3	3	
Test Procedures - See Note Number		12	12	12	12	12	12	12	12	
Material Description - see below		2	2	2	2	2	2-3	2	2-3	
Notes										
1: Assigned Values have been obtained from our Penrith laboratory – Accreditation No 2734					10: AS 1289 1.2.1 clause 6.4 (b), 2.1.1, 5.3.1, 5.5.1, 5.6.1					
2: Assigned Values have been obtained from our Prestons laboratory – Accreditation No 14234					11: AS 1289 1.2.1 clause 6.4 (b), 2.1.1, 5.3.1, 5.7.1					
3: Results have been calculated using infinite decimal places. Therefore, calculated values may vary from those shown					12: AS 1289 1.2.1 clause 6.4 (b), 2.1.1, 5.7.1, 5.8.1					
4: AS 1289 1.2.1 clause 6.4 (b), 2.1.1, 5.1.1, 5.3.1, 5.4.1					13: RMS T111, T119, T120, T166					
5: AS 1289 1.2.1 clause 6.4 (b), 2.1.1, 5.2.1, 5.3.1, 5.4.1					14: RMS T111, T120, T166, T173					
6: AS 1289 1.2.1 clause 6.4 (b),					15: RMS T120, T119, T162					
7: AS 1289 1.2.1 clause 6.4 (b), 2.1.1, 5.2.1, 5.4.1, 5.8.1					16: RMS T120, T162, T173					
8: AS 1289 1.2.1 clause 6.4 (b), 2.1.1., 5.5.1, 5.6.1, 5.8.1					17: RMS T120, T164, T173					
9: Full details of Test Procedure 5.8.1 available on request										
Material Description										
1. CL-Clays of low plasticity, gravelly clays, sandy clays, silty clays			11. DGS40			* Cement Stabilised				
2. CI-Clay of medium plasticity, gravelly clays, sandy clays, silty clays			12. FCR20			# Lime Stabilised				
3. CH-Clays of high plasticity			13. FCR40			\$ Gypsum Stabilised				
4. SC-Clayey sands, sand-clay mixtures			14. RC - Recycled Concrete							
5. SM-Silty sands, sand-silt mixtures			15. Recycled Roadbase							
6. GC-Clayey gravels, gravel-sand-clay mixtures			16. RSB - Recycled Sub-base							
7. SP-Sand, crushed dust, filling sand, washed sand			17. CSS - Crushed Sandstone							
8. DGB20			18. RSS - Ripped Sandstone							
9. DGB40			19. Cowels Brown							
10. DGS20										

Form No R 020c Version 01 06/17 - issued by ER



Accreditation Number 2734
Corporate Site Number 2727

Accredited for compliance with
ISO/IEC 17025 - Testing.

A Kench 24/11/2017

Approved Signatory

Head Office:
34 Borec Road, Penrith NSW 2750
P O Box 880 Penrith NSW 2751
Telephone: (02) 4722 21

Prestons Laboratory:
Unit 4, 18-20 Whyalla Place, Prestons NSW 2170
Telephone: (02) 9607 6111 Facsimile: (02) 9607 6200

FIELD DENSITY RESULTS

DARACON CONTRACTORS PTY LTD
PO BOX 299
WALLSEND NSW 2287

Laboratory: Penrith
Job No: 8599/1
Date: 24/11/2017

PROJECT: SITE FILL TESTING - AREA B
RESIDENTIAL DEVELOPMENT.WOORONG PARK, MARSDEN PARK

Page 25 of 79

TEST NUMBER	3438	3439	3440	3441	3442	3443	3444	3445		
DATE TESTED	16/10/2017									
RESULTS										
Hilf Density Ratio	Standard	%	96.5	96	95	95.5	95.5	95	96.5	95.5
Moisture Variation from OMC (-Drier/+Wetter)		%	0.0	-6.0	0.5	0.0	0.0	0.5	0.0	0.0
Specification	Density Ratio (Standard)		≥95%			Specification	Moisture Variance from OMC		±2%	
TEST LOCATION										
Easting	295089.024	295089.024	295061.332	295579.151	295558.485	295534.047	295524.653	295498.11		
Northing	6269011.107	6269011.109	6269016.936	6269540.945	6269508.399	6269461.661	6269442.308	6269443.731		
Reduced Level	m	18.271	18.269	17.788	18.599	18.485	18.559	18.43	17.581	
Shown on Drawing No	8599/1-59				8599/1-58					
Retested by Test	-	-	-	-	-	-	-	-		
FIELD & LABORATORY DATA										
Field Wet Density	t/m ³	2.07	2.06	2.05	2.05	2.04	2.05	2.06	2.05	
Field Moisture Content	%	17.0	16.5	19.0	19.5	18.0	18.5	18.5	18.5	
Material retained on 19mm Sieve (wet)	%	<5	<5	<5	<5	<5	<5	<5	<5	
Lab Compaction result from test number		3438	3439	3440	3441	3442	3443	3444	3445	
Peak Converted Wet Density	t/m ³	2.14	2.15	2.16	2.15	2.14	2.16	2.14	2.15	
Apparent Optimum Moisture Content	%	16.5	22.5	18.0	19.5	18.0	18.5	18.5	18.5	
Number of Compaction Points		3	3	3	3	3	3	3	3	
Test Procedures - See Note Number		12	12	12	12	12	12	12	12	
Material Description - see below		2	2	2	2-3	2	2	2	2	
Notes										
1: Assigned Values have been obtained from our Penrith laboratory – Accreditation No 2734					10: AS 1289 1.2.1 clause 6.4 (b), 2.1.1, 5.3.1, 5.5.1, 5.6.1					
2: Assigned Values have been obtained from our Prestons laboratory – Accreditation No 14234					11: AS 1289 1.2.1 clause 6.4 (b), 2.1.1, 5.3.1, 5.7.1					
3: Results have been calculated using infinite decimal places. Therefore, calculated values may vary from those shown					12: AS 1289 1.2.1 clause 6.4 (b), 2.1.1, 5.7.1, 5.8.1					
4: AS 1289 1.2.1 clause 6.4 (b), 2.1.1, 5.1.1, 5.3.1, 5.4.1					13: RMS T111, T119, T120, T166					
5: AS 1289 1.2.1 clause 6.4 (b), 2.1.1, 5.2.1, 5.3.1, 5.4.1					14: RMS T111, T120, T166, T173					
6: AS 1289 1.2.1 clause 6.4 (b),					15: RMS T120, T119, T162					
7: AS 1289 1.2.1 clause 6.4 (b), 2.1.1, 5.2.1, 5.4.1, 5.8.1					16: RMS T120, T162, T173					
8: AS 1289 1.2.1 clause 6.4 (b), 2.1.1., 5.5.1, 5.6.1, 5.8.1					17: RMS T120, T164, T173					
9: Full details of Test Procedure 5.8.1 available on request										
Material Description										
1. CL-Clays of low plasticity, gravelly clays, sandy clays, silty clays			11. DGS40			* Cement Stabilised				
2. CI-Clay of medium plasticity, gravelly clays, sandy clays, silty clays			12. FCR20			# Lime Stabilised				
3. CH-Clays of high plasticity			13. FCR40			\$ Gypsum Stabilised				
4. SC-Clayey sands, sand-clay mixtures			14. RC - Recycled Concrete							
5. SM-Silty sands, sand-silt mixtures			15. Recycled Roadbase							
6. GC-Clayey gravels, gravel-sand-clay mixtures			16. RSB - Recycled Sub-base							
7. SP-Sand, crushed dust, filling sand, washed sand			17. CSS - Crushed Sandstone							
8. DGB20			18. RSS - Ripped Sandstone							
9. DGB40			19. Cowels Brown							
10. DGS20										

Form No R 020c Version 01 06/17 - issued by ER



Accreditation Number 2734
Corporate Site Number 2727

Accredited for compliance with
ISO/IEC 17025 - Testing.

A Kench 24/11/2017

Approved Signatory

Head Office:
34 Borec Road, Penrith NSW 2750
P O Box 880 Penrith NSW 2751
Telephone: (02) 4722 21

Prestons Laboratory:
Unit 4, 18-20 Whyalla Place, Prestons NSW 2170
Telephone: (02) 9607 6111 Facsimile: (02) 9607 6200

FIELD DENSITY RESULTS

DARACON CONTRACTORS PTY LTD
PO BOX 299
WALLSEND NSW 2287

Laboratory: Penrith
Job No: 8599/1
Date: 24/11/2017

PROJECT: SITE FILL TESTING - AREA B
RESIDENTIAL DEVELOPMENT.WOORONG PARK, MARSDEN PARK

Page 26 of 79

TEST NUMBER	3446	3447	3448	3449	3450	3451	3452	3453		
DATE TESTED	16/10/2017									
RESULTS										
Hiif Density Ratio	Standard	%	95.5	96.5	96	96.5	96.5	95.5	96.5	97
Moisture Variation from OMC (-Drier/+Wetter)		%	0.5	-0.5	0.5	1.0	0.0	0.0	0.0	0.5
Specification	Density Ratio (Standard)	≥95%	Specification				Moisture Variance from OMC			±2%
TEST LOCATION										
Easting	295515.698	295536.321	295562.565	295520.381	295499.403	295472.21	295449.929	295454.113		
Northing	6269479.206	6269511.182	6269548.306	6269523.583	6269504.501	6269474.683	6269476.802	6269515.756		
Reduced Level	m									
Shown on Drawing No	18.07	17.985	18.225	18.053	17.779	17.187	16.502	16.34		
Retested by Test	8599/1-58									
	-	-	-	-	-	-	-	-		
FIELD & LABORATORY DATA										
Field Wet Density	t/m ³	2.04	2.07	2.07	2.06	2.07	2.05	2.06	2.08	
Field Moisture Content	%	16.0	17.5	17.5	16.5	16.0	16.0	19.5	19.5	
Material retained on 19mm Sieve (wet)	%	<5	<5	<5	<5	<5	<5	<5	<5	
Lab Compaction result from test number		3446	3447	3448	3449	3450	3451	3452	3453	
Peak Converted Wet Density	t/m ³	2.14	2.15	2.16	2.14	2.14	2.15	2.14	2.14	
Apparent Optimum Moisture Content	%	16.0	18.0	17.0	15.5	15.5	15.5	19.5	19.5	
Number of Compaction Points		3	3	3	3	3	3	3	3	
Test Procedures - See Note Number		12	12	12	12	12	12	12	12	
Material Description - see below		2	2	2	2	2	2	2-3	2-3	
Notes										
1: Assigned Values have been obtained from our Penrith laboratory – Accreditation No 2734					10: AS 1289 1.2.1 clause 6.4 (b), 2.1.1, 5.3.1, 5.5.1, 5.6.1					
2: Assigned Values have been obtained from our Prestons laboratory – Accreditation No 14234					11: AS 1289 1.2.1 clause 6.4 (b), 2.1.1, 5.3.1, 5.7.1					
3: Results have been calculated using infinite decimal places. Therefore, calculated values may vary from those shown					12: AS 1289 1.2.1 clause 6.4 (b), 2.1.1, 5.7.1, 5.8.1					
4: AS 1289 1.2.1 clause 6.4 (b), 2.1.1, 5.1.1, 5.3.1, 5.4.1					13: RMS T111, T119, T120, T166					
5: AS 1289 1.2.1 clause 6.4 (b), 2.1.1, 5.2.1, 5.3.1, 5.4.1					14: RMS T111, T120, T166, T173					
6: AS 1289 1.2.1 clause 6.4 (b)					15: RMS T120, T119, T162					
7: AS 1289 1.2.1 clause 6.4 (b), 2.1.1, 5.2.1, 5.4.1, 5.8.1					16: RMS T120, T162, T173					
8: AS 1289 1.2.1 clause 6.4 (b), 2.1.1., 5.5.1, 5.6.1, 5.8.1					17: RMS T120, T164, T173					
9: Full details of Test Procedure 5.8.1 available on request										
Material Description										
1. CL-Clays of low plasticity, gravelly clays, sandy clays, silty clays			11. DGS40			* Cement Stabilised				
2. CI-Clay of medium plasticity, gravelly clays, sandy clays, silty clays			12. FCR20			# Lime Stabilised				
3. CH-Clays of high plasticity			13. FCR40			\$ Gypsum Stabilised				
4. SC-Clayey sands, sand-clay mixtures			14. RC - Recycled Concrete							
5. SM-Silty sands, sand-silt mixtures			15. Recycled Roadbase							
6. GC-Clayey gravels, gravel-sand-clay mixtures			16. RSB - Recycled Sub-base							
7. SP-Sand, crushed dust, filling sand, washed sand			17. CSS - Crushed Sandstone							
8. DGB20			18. RSS - Ripped Sandstone							
9. DGB40			19. Cowels Brown							
10. DGS20										

Form No R 020c Version 01 06/17 - issued by ER



Accreditation Number 2734
Corporate Site Number 2727

Accredited for compliance with
ISO/IEC 17025 - Testing.

A Kench 24/11/2017

Approved Signatory

Head Office:
34 Borec Road, Penrith NSW 2750
P O Box 880 Penrith NSW 2751
Telephone: (02) 4722 21

Prestons Laboratory:
Unit 4, 18-20 Whyalla Place, Prestons NSW 2170
Telephone: (02) 9607 6111 Facsimile: (02) 9607 6200

FIELD DENSITY RESULTS

DARACON CONTRACTORS PTY LTD
PO BOX 299
WALLSEND NSW 2287

Laboratory: Penrith
Job No: 8599/1
Date: 24/11/2017

PROJECT: SITE FILL TESTING - AREA B
RESIDENTIAL DEVELOPMENT.WOORONG PARK, MARSDEN PARK

TEST NUMBER	3454	3455	3456	3457	3458	3459	3460	3461		
DATE TESTED	16/10/2017									
RESULTS										
Hiif Density Ratio	Standard	%	97.5	96.5	96	97.5	96.5	96	95.5	96.5
Moisture Variation from OMC (-Drier/+Wetter)		%	0.0	0.5	0.0	0.0	0.5	0.0	0.0	0.0
Specification	Density Ratio (Standard)	≥95%	Specification				Moisture Variance from OMC			±2%
TEST LOCATION										
Easting	295583.213	295542.311	295506.436	295486.341	295485.21	295506.601	295541.013	295567.365		
Northing	6269660.759	6269618.119	6269576.128	6269547.793	6269568.254	6269597.086	6269634.235	6269664.437		
Reduced Level	m	15.777	15.665	15.642	15.604	15.552	15.742	15.481	15.633	
Shown on Drawing No	8599/1-57				8599/1-58			8599/1-57		
Retested by Test	-	-	-	-	-	-	-	-		
FIELD & LABORATORY DATA										
Field Wet Density	t/m ³	2.10	2.07	2.06	2.09	2.07	2.05	2.05	2.07	
Field Moisture Content	%	19.0	16.5	17.5	19.5	17.0	19.0	20.0	20.0	
Material retained on 19mm Sieve (wet)	%	<5	<5	<5	<5	<5	<5	<5	<5	
Lab Compaction result from test number		3454	3455	3456	3457	3458	3459	3460	3461	
Peak Converted Wet Density	t/m ³	2.15	2.15	2.15	2.14	2.14	2.14	2.15	2.15	
Apparent Optimum Moisture Content	%	18.5	16.5	17.5	19.0	17.0	18.5	19.5	20.0	
Number of Compaction Points		3	3	3	3	3	3	3	3	
Test Procedures - See Note Number		12	12	12	12	12	12	12	12	
Material Description - see below		2	2	2	2-3	2	2-3	2-3	2-3	
Notes										
1: Assigned Values have been obtained from our Penrith laboratory – Accreditation No 2734					10: AS 1289 1.2.1 clause 6.4 (b), 2.1.1, 5.3.1, 5.5.1, 5.6.1					
2: Assigned Values have been obtained from our Prestons laboratory – Accreditation No 14234					11: AS 1289 1.2.1 clause 6.4 (b), 2.1.1, 5.3.1, 5.7.1					
3: Results have been calculated using infinite decimal places. Therefore, calculated values may vary from those shown					12: AS 1289 1.2.1 clause 6.4 (b), 2.1.1, 5.7.1, 5.8.1					
4: AS 1289 1.2.1 clause 6.4 (b), 2.1.1, 5.1.1, 5.3.1, 5.4.1					13: RMS T111, T119, T120, T166					
5: AS 1289 1.2.1 clause 6.4 (b), 2.1.1, 5.2.1, 5.3.1, 5.4.1					14: RMS T111, T120, T166, T173					
6: AS 1289 1.2.1 clause 6.4 (b),					15: RMS T120, T119, T162					
7: AS 1289 1.2.1 clause 6.4 (b), 2.1.1, 5.2.1, 5.4.1, 5.8.1					16: RMS T120, T162, T173					
8: AS 1289 1.2.1 clause 6.4 (b), 2.1.1., 5.5.1, 5.6.1, 5.8.1					17: RMS T120, T164, T173					
9: Full details of Test Procedure 5.8.1 available on request										
Material Description										
1. CL-Clays of low plasticity, gravelly clays, sandy clays, silty clays			11. DGS40			* Cement Stabilised				
2. CI-Clay of medium plasticity, gravelly clays, sandy clays, silty clays			12. FCR20			# Lime Stabilised				
3. CH-Clays of high plasticity			13. FCR40			\$ Gypsum Stabilised				
4. SC-Clayey sands, sand-clay mixtures			14. RC - Recycled Concrete							
5. SM-Silty sands, sand-silt mixtures			15. Recycled Roadbase							
6. GC-Clayey gravels, gravel-sand-clay mixtures			16. RSB - Recycled Sub-base							
7. SP-Sand, crushed dust, filling sand, washed sand			17. CSS - Crushed Sandstone							
8. DGB20			18. RSS - Ripped Sandstone							
9. DGB40			19. Cowels Brown							
10. DGS20										

Form No R 020c Version 01 06/17 - issued by ER



Accreditation Number 2734
Corporate Site Number 2727

Accredited for compliance with
ISO/IEC 17025 - Testing.

A Kench 24/11/2017

Approved Signatory

Head Office:
34 Borec Road, Penrith NSW 2750
P O Box 880 Penrith NSW 2751
Telephone: (02) 4722 21

Prestons Laboratory:
Unit 4, 18-20 Whyalla Place, Prestons NSW 2170
Telephone: (02) 9607 6111 Facsimile: (02) 9607 6200

FIELD DENSITY RESULTS

DARACON CONTRACTORS PTY LTD
PO BOX 299
WALLSEND NSW 2287

Laboratory: Penrith
Job No: 8599/1
Date: 24/11/2017

PROJECT: SITE FILL TESTING - AREA B
RESIDENTIAL DEVELOPMENT.WOORONG PARK, MARSDEN PARK

Page 28 of 79

TEST NUMBER	3462	3463	3464	3465	3466	3467	3468	3469		
DATE TESTED	16/10/2017									
RESULTS										
Hiif Density Ratio	Standard	%	96	98.5	98	96	98	97	97.5	98
Moisture Variation from OMC (-Drier/+Wetter)		%	0.5	0.5	0.0	0.0	0.5	0.0	0.0	0.0
Specification	Density Ratio (Standard)	≥95%	Specification				Moisture Variance from OMC			±2%
TEST LOCATION										
Easting	295438.703	295431.645	295424.292	295446.959	295461.885	295475.52	295499.044	295497.856		
Northing	6269467.32	6269445.357	6269424.76	6269406.062	6269418.131	6269433.178	6269423.278	6269404.767		
Reduced Level	m	15.089	15.336	15.805	16.726	16.806	16.655	17.169	17.222	
Shown on Drawing No	8599/1-58									
Retested by Test	-	-	-	-	-	-	-	-		
FIELD & LABORATORY DATA										
Field Wet Density	t/m ³	2.05	2.10	2.09	2.05	2.08	2.07	2.08	2.08	
Field Moisture Content	%	17.0	17.5	11.5	16.5	17.0	17.0	17.0	16.5	
Material retained on 19mm Sieve (wet)	%	<5	<5	<5	<5	<5	<5	<5	<5	
Lab Compaction result from test number		3462	3463	3464	3465	3466	3467	3468	3469	
Peak Converted Wet Density	t/m ³	2.14	2.13	2.13	2.14	2.12	2.13	2.13	2.12	
Apparent Optimum Moisture Content	%	16.5	16.5	11.0	16.5	16.5	17.0	17.0	16.5	
Number of Compaction Points		3	3	3	3	3	3	3	3	
Test Procedures - See Note Number		12	12	12	12	12	12	12	12	
Material Description - see below		2	2	2	2	2	2	2	2	
Notes										
1: Assigned Values have been obtained from our Penrith laboratory – Accreditation No 2734					10: AS 1289 1.2.1 clause 6.4 (b), 2.1.1, 5.3.1, 5.5.1, 5.6.1					
2: Assigned Values have been obtained from our Prestons laboratory – Accreditation No 14234					11: AS 1289 1.2.1 clause 6.4 (b), 2.1.1, 5.3.1, 5.7.1					
3: Results have been calculated using infinite decimal places. Therefore, calculated values may vary from those shown					12: AS 1289 1.2.1 clause 6.4 (b), 2.1.1, 5.7.1, 5.8.1					
4: AS 1289 1.2.1 clause 6.4 (b), 2.1.1, 5.1.1, 5.3.1, 5.4.1					13: RMS T111, T119, T120, T166					
5: AS 1289 1.2.1 clause 6.4 (b), 2.1.1, 5.2.1, 5.3.1, 5.4.1					14: RMS T111, T120, T166, T173					
6: AS 1289 1.2.1 clause 6.4 (b)					15: RMS T120, T119, T162					
7: AS 1289 1.2.1 clause 6.4 (b), 2.1.1, 5.2.1, 5.4.1, 5.8.1					16: RMS T120, T162, T173					
8: AS 1289 1.2.1 clause 6.4 (b), 2.1.1., 5.5.1, 5.6.1, 5.8.1					17: RMS T120, T164, T173					
9: Full details of Test Procedure 5.8.1 available on request										
Material Description										
1. CL-Clays of low plasticity, gravelly clays, sandy clays, silty clays			11. DGS40			* Cement Stabilised				
2. CI-Clay of medium plasticity, gravelly clays, sandy clays, silty clays			12. FCR20			# Lime Stabilised				
3. CH-Clays of high plasticity			13. FCR40			\$ Gypsum Stabilised				
4. SC-Clayey sands, sand-clay mixtures			14. RC - Recycled Concrete							
5. SM-Silty sands, sand-silt mixtures			15. Recycled Roadbase							
6. GC-Clayey gravels, gravel-sand-clay mixtures			16. RSB - Recycled Sub-base							
7. SP-Sand, crushed dust, filling sand, washed sand			17. CSS - Crushed Sandstone							
8. DGB20			18. RSS - Ripped Sandstone							
9. DGB40			19. Cowels Brown							
10. DGS20										

Form No R 020c Version 01 06/17 - issued by ER



Accreditation Number 2734
Corporate Site Number 2727

Accredited for compliance with
ISO/IEC 17025 - Testing.

A Kench 24/11/2017

Approved Signatory

Head Office:
34 Borec Road, Penrith NSW 2750
P O Box 880 Penrith NSW 2751
Telephone: (02) 4722 21

Prestons Laboratory:
Unit 4, 18-20 Whyalla Place, Prestons NSW 2170
Telephone: (02) 9607 6111 Facsimile: (02) 9607 6200

FIELD DENSITY RESULTS

DARACON CONTRACTORS PTY LTD
PO BOX 299
WALLSEND NSW 2287

Laboratory: Penrith
Job No: 8599/1
Date: 24/11/2017

PROJECT: SITE FILL TESTING - AREA B
RESIDENTIAL DEVELOPMENT.WOORONG PARK, MARSDEN PARK

Page 29 of 79

TEST NUMBER	3470	3471	3472	3473	3474	3475	3476	3477		
DATE TESTED	16/10/2017									
RESULTS										
Hiif Density Ratio	Standard	%	97	98	98	98.5	97	97	99	99.5
Moisture Variation from OMC (-Drier/+Wetter)		%	0.0	0.0	0.0	0.0	0.0	0.0	0.5	0.0
Specification	Density Ratio (Standard)		≥95%			Specification	Moisture Variance from OMC		±2%	
TEST LOCATION										
Easting	295486.428	295407.485	295418.134	295446.618	296439.669	296395.455	296356.481	296355.67		
Northing	6269385.112	6269416.278	6269397.126	6269383.995	6268763.93	6268760.071	6268753.421	6268728.536		
Reduced Level	m		17.295	14.573	15.366	15.897	22.102	21.689	20.856	21.155
Shown on Drawing No	8599/1-58				8599/1-64					
Retested by Test	-	-	-	-	-	-	-	-		
FIELD & LABORATORY DATA										
Field Wet Density	t/m ³	2.07	2.08	2.09	2.08	2.07	2.07	2.10	2.10	
Field Moisture Content	%	16.5	16.5	15.5	19.0	16.5	17.0	16.5	17.0	
Material retained on 19mm Sieve (wet)	%	<5	<5	<5	<5	<5	<5	<5	<5	
Lab Compaction result from test number		3470	3471	3472	3473	3474	3475	3476	3477	
Peak Converted Wet Density	t/m ³	2.13	2.12	2.13	2.11	2.13	2.13	2.12	2.11	
Apparent Optimum Moisture Content	%	16.5	16.5	15.5	19.0	16.5	17.0	16.5	17.0	
Number of Compaction Points		3	3	3	3	3	3	3	3	
Test Procedures - See Note Number		12	12	12	12	12	12	12	12	
Material Description - see below		2	2	2	2-3	2	2	2	2	
Notes										
1: Assigned Values have been obtained from our Penrith laboratory – Accreditation No 2734					10: AS 1289 1.2.1 clause 6.4 (b), 2.1.1, 5.3.1, 5.5.1, 5.6.1					
2: Assigned Values have been obtained from our Prestons laboratory – Accreditation No 14234					11: AS 1289 1.2.1 clause 6.4 (b), 2.1.1, 5.3.1, 5.7.1					
3: Results have been calculated using infinite decimal places. Therefore, calculated values may vary from those shown					12: AS 1289 1.2.1 clause 6.4 (b), 2.1.1, 5.7.1, 5.8.1					
4: AS 1289 1.2.1 clause 6.4 (b), 2.1.1, 5.1.1, 5.3.1, 5.4.1					13: RMS T111, T119, T120, T166					
5: AS 1289 1.2.1 clause 6.4 (b), 2.1.1, 5.2.1, 5.3.1, 5.4.1					14: RMS T111, T120, T166, T173					
6: AS 1289 1.2.1 clause 6.4 (b),					15: RMS T120, T119, T162					
7: AS 1289 1.2.1 clause 6.4 (b), 2.1.1, 5.2.1, 5.4.1, 5.8.1					16: RMS T120, T162, T173					
8: AS 1289 1.2.1 clause 6.4 (b), 2.1.1., 5.5.1, 5.6.1, 5.8.1					17: RMS T120, T164, T173					
9: Full details of Test Procedure 5.8.1 available on request										
Material Description										
1. CL-Clays of low plasticity, gravelly clays, sandy clays, silty clays			11. DGS40			* Cement Stabilised				
2. CI-Clay of medium plasticity, gravelly clays, sandy clays, silty clays			12. FCR20			# Lime Stabilised				
3. CH-Clays of high plasticity			13. FCR40			\$ Gypsum Stabilised				
4. SC-Clayey sands, sand-clay mixtures			14. RC - Recycled Concrete							
5. SM-Silty sands, sand-silt mixtures			15. Recycled Roadbase							
6. GC-Clayey gravels, gravel-sand-clay mixtures			16. RSB - Recycled Sub-base							
7. SP-Sand, crushed dust, filling sand, washed sand			17. CSS - Crushed Sandstone							
8. DGB20			18. RSS - Ripped Sandstone							
9. DGB40			19. Cowels Brown							
10. DGS20										

Form No R 020c Version 01 06/17 - issued by ER



Accreditation Number 2734
Corporate Site Number 2727

Accredited for compliance with
ISO/IEC 17025 - Testing.

A Kench 24/11/2017

Approved Signatory

Head Office:
34 Borec Road, Penrith NSW 2750
P O Box 880 Penrith NSW 2751
Telephone: (02) 4722 21

Prestons Laboratory:
Unit 4, 18-20 Whyalla Place, Prestons NSW 2170
Telephone: (02) 9607 6111 Facsimile: (02) 9607 6200

FIELD DENSITY RESULTS

DARACON CONTRACTORS PTY LTD
PO BOX 299
WALLSEND NSW 2287

Laboratory: Penrith
Job No: 8599/1
Date: 24/11/2017

PROJECT: SITE FILL TESTING - AREA B
RESIDENTIAL DEVELOPMENT.WOORONG PARK, MARSDEN PARK

Page 30 of 79

TEST NUMBER	3478	3479	3480	3481	3482	3483	3484	3485		
DATE TESTED	16/10/2017									
RESULTS										
Hilf Density Ratio	Standard	%	96.5	96.5	97	97.5	96.5	98	98.5	97.5
Moisture Variation from OMC (-Drier/+Wetter)		%	0.0	0.0	0.0	0.0	0.0	0.0	0.0	0.0
Specification	Density Ratio (Standard)	≥95%	Specification				Moisture Variance from OMC			±2%
TEST LOCATION										
Easting	296395.69	296440.435	296452.211	296420.351	296391.254	294839.258	294846.929	294851.862		
Northing	6268732.316	6268739.018	6268716.956	6268707.883	6268698.484	6268809.163	6268862.322	6268901.508		
Reduced Level	m	21.916	22.107	22.532	22.221	21.575	15.922	15.3	14.977	
Shown on Drawing No	8599/1-64							8599/1-60		
Retested by Test	-	-	-	-	-	-	-	-		
FIELD & LABORATORY DATA										
Field Wet Density	t/m ³	2.04	2.05	2.05	2.07	2.04	2.09	2.08	2.08	
Field Moisture Content	%	16.5	17.0	16.5	17.0	17.0	17.0	17.0	17.0	
Material retained on 19mm Sieve (wet)	%	<5	<5	<5	<5	<5	<5	<5	<5	
Lab Compaction result from test number		3478	3479	3480	3481	3482	3483	3484	3485	
Peak Converted Wet Density	t/m ³	2.11	2.12	2.11	2.12	2.11	2.13	2.11	2.13	
Apparent Optimum Moisture Content	%	16.5	17.0	16.5	17.0	16.5	17.0	17.0	17.0	
Number of Compaction Points		3	3	3	3	3	3	3	3	
Test Procedures - See Note Number		12	12	12	12	12	12	12	12	
Material Description - see below		2	2	2	2	2	2	2	2	
Notes										
1: Assigned Values have been obtained from our Penrith laboratory – Accreditation No 2734					10: AS 1289 1.2.1 clause 6.4 (b), 2.1.1, 5.3.1, 5.5.1, 5.6.1					
2: Assigned Values have been obtained from our Prestons laboratory – Accreditation No 14234					11: AS 1289 1.2.1 clause 6.4 (b), 2.1.1, 5.3.1, 5.7.1					
3: Results have been calculated using infinite decimal places. Therefore, calculated values may vary from those shown					12: AS 1289 1.2.1 clause 6.4 (b), 2.1.1, 5.7.1, 5.8.1					
4: AS 1289 1.2.1 clause 6.4 (b), 2.1.1, 5.1.1, 5.3.1, 5.4.1					13: RMS T111, T119, T120, T166					
5: AS 1289 1.2.1 clause 6.4 (b), 2.1.1, 5.2.1, 5.3.1, 5.4.1					14: RMS T111, T120, T166, T173					
6: AS 1289 1.2.1 clause 6.4 (b),					15: RMS T120, T119, T162					
7: AS 1289 1.2.1 clause 6.4 (b), 2.1.1, 5.2.1, 5.4.1, 5.8.1					16: RMS T120, T162, T173					
8: AS 1289 1.2.1 clause 6.4 (b), 2.1.1., 5.5.1, 5.6.1, 5.8.1					17: RMS T120, T164, T173					
9: Full details of Test Procedure 5.8.1 available on request										
Material Description										
1. CL-Clays of low plasticity, gravelly clays, sandy clays, silty clays			11. DGS40			* Cement Stabilised				
2. CI-Clay of medium plasticity, gravelly clays, sandy clays, silty clays			12. FCR20			# Lime Stabilised				
3. CH-Clays of high plasticity			13. FCR40			\$ Gypsum Stabilised				
4. SC-Clayey sands, sand-clay mixtures			14. RC - Recycled Concrete							
5. SM-Silty sands, sand-silt mixtures			15. Recycled Roadbase							
6. GC-Clayey gravels, gravel-sand-clay mixtures			16. RSB - Recycled Sub-base							
7. SP-Sand, crushed dust, filling sand, washed sand			17. CSS - Crushed Sandstone							
8. DGB20			18. RSS - Ripped Sandstone							
9. DGB40			19. Cowels Brown							
10. DGS20										

Form No R 020c Version 01 06/17 - issued by ER



Accreditation Number 2734
Corporate Site Number 2727

Accredited for compliance with
ISO/IEC 17025 - Testing.

A Kench 24/11/2017

Approved Signatory

Head Office:
34 Borec Road, Penrith NSW 2750
P O Box 880 Penrith NSW 2751
Telephone: (02) 4722 21

Prestons Laboratory:
Unit 4, 18-20 Whyalla Place, Prestons NSW 2170
Telephone: (02) 9607 6111 Facsimile: (02) 9607 6200

FIELD DENSITY RESULTS

DARACON CONTRACTORS PTY LTD
PO BOX 299
WALLSEND NSW 2287

Laboratory: Penrith
Job No: 8599/1
Date: 24/11/2017

PROJECT: SITE FILL TESTING - AREA B
RESIDENTIAL DEVELOPMENT.WOORONG PARK, MARSDEN PARK

Page 31 of 79

TEST NUMBER	3486	3487	3488	3489	3490	3491	3492	3493		
DATE TESTED	17/10/2017									
RESULTS										
Hilf Density Ratio	Standard	%	96.5	98	96	99.5	96.5	98	97.5	98.5
Moisture Variation from OMC (-Drier/+Wetter)		%	0.0	0.0	0.0	0.5	0.5	0.5	0.0	0.0
Specification	Density Ratio (Standard)		≥95%			Specification	Moisture Variance from OMC		±2%	
TEST LOCATION										
Easting	294857.488	294880.098	294882.76	294880.007	294877.925	294895.812	294900.603	294902.281		
Northing	6268942.142	6268948.014	6268917.473	6268881.875	6268831.81	6268818.789	6268874.416	6268913.265		
Reduced Level	m	14.697	14.549	14.851	15.128	16.008	16.769	15.285	14.83	
Shown on Drawing No	8599/1-60									
Retested by Test	-	-	-	-	-	-	-	-		
FIELD & LABORATORY DATA										
Field Wet Density	t/m ³	2.06	2.07	2.05	2.10	2.07	2.07	2.05	2.08	
Field Moisture Content	%	17.0	17.0	17.5	16.5	17.0	17.0	17.5	17.5	
Material retained on 19mm Sieve (wet)	%	<5	<5	<5	<5	<5	<5	<5	<5	
Lab Compaction result from test number		3486	3487	3488	3489	3490	3491	3492	3493	
Peak Converted Wet Density	t/m ³	2.13	2.11	2.13	2.11	2.14	2.11	2.10	2.11	
Apparent Optimum Moisture Content	%	16.5	16.5	17.5	16.5	16.5	16.5	17.0	17.5	
Number of Compaction Points		3	3	3	3	3	3	3	3	
Test Procedures - See Note Number		12	12	12	12	12	12	12	12	
Material Description - see below		2	2	2	2	2	2	2	2	
Notes										
1: Assigned Values have been obtained from our Penrith laboratory – Accreditation No 2734					10: AS 1289 1.2.1 clause 6.4 (b), 2.1.1, 5.3.1, 5.5.1, 5.6.1					
2: Assigned Values have been obtained from our Prestons laboratory – Accreditation No 14234					11: AS 1289 1.2.1 clause 6.4 (b), 2.1.1, 5.3.1, 5.7.1					
3: Results have been calculated using infinite decimal places. Therefore, calculated values may vary from those shown					12: AS 1289 1.2.1 clause 6.4 (b), 2.1.1, 5.7.1, 5.8.1					
4: AS 1289 1.2.1 clause 6.4 (b), 2.1.1, 5.1.1, 5.3.1, 5.4.1					13: RMS T111, T119, T120, T166					
5: AS 1289 1.2.1 clause 6.4 (b), 2.1.1, 5.2.1, 5.3.1, 5.4.1					14: RMS T111, T120, T166, T173					
6: AS 1289 1.2.1 clause 6.4 (b),					15: RMS T120, T119, T162					
7: AS 1289 1.2.1 clause 6.4 (b), 2.1.1, 5.2.1, 5.4.1, 5.8.1					16: RMS T120, T162, T173					
8: AS 1289 1.2.1 clause 6.4 (b), 2.1.1., 5.5.1, 5.6.1, 5.8.1					17: RMS T120, T164, T173					
9: Full details of Test Procedure 5.8.1 available on request										
Material Description										
1. CL-Clays of low plasticity, gravelly clays, sandy clays, silty clays			11. DGS40			* Cement Stabilised				
2. CI-Clay of medium plasticity, gravelly clays, sandy clays, silty clays			12. FCR20			# Lime Stabilised				
3. CH-Clays of high plasticity			13. FCR40			\$ Gypsum Stabilised				
4. SC-Clayey sands, sand-clay mixtures			14. RC - Recycled Concrete							
5. SM-Silty sands, sand-silt mixtures			15. Recycled Roadbase							
6. GC-Clayey gravels, gravel-sand-clay mixtures			16. RSB - Recycled Sub-base							
7. SP-Sand, crushed dust, filling sand, washed sand			17. CSS - Crushed Sandstone							
8. DGB20			18. RSS - Ripped Sandstone							
9. DGB40			19. Cowels Brown							
10. DGS20										

Form No R 020c Version 01 06/17 - issued by ER



Accreditation Number 2734
Corporate Site Number 2727

Accredited for compliance with
ISO/IEC 17025 - Testing.

A Kench 24/11/2017

Approved Signatory

Head Office:
34 Borec Road, Penrith NSW 2750
P O Box 880 Penrith NSW 2751
Telephone: (02) 4722 21

Prestons Laboratory:
Unit 4, 18-20 Whyalla Place, Prestons NSW 2170
Telephone: (02) 9607 6111 Facsimile: (02) 9607 6200

FIELD DENSITY RESULTS

DARACON CONTRACTORS PTY LTD
PO BOX 299
WALLSEND NSW 2287

Laboratory: Penrith
Job No: 8599/1
Date: 24/11/2017

PROJECT: SITE FILL TESTING - AREA B
RESIDENTIAL DEVELOPMENT.WOORONG PARK, MARSDEN PARK

Page 32 of 79

TEST NUMBER	3494	3495	3496	3497	3498	3499	3500	3501		
DATE TESTED	17/10/2017			18/10/2017						
RESULTS										
Hilf Density Ratio	Standard	%	98	96.5	96.5	98	98.5	99.5	97.5	98.5
Moisture Variation from OMC (-Drier/+Wetter)		%	0.0	0.0	0.0	0.0	0.0	0.0	0.5	0.5
Specification	Density Ratio (Standard)	≥95%	Specification				Moisture Variance from OMC			±2%
TEST LOCATION										
Easting	294904.607	294839.241	294845.428	294850.906	294859.899	294892.419	294891.435	294887.332		
Northing	6268942.164	6268778.259	6268828.933	6268872.881	6268942.044	6268951.593	6268899.092	6268863.863		
Reduced Level	m	14.449	16.74	16.132	15.579	15.105	14.885	15.475	16.067	
Shown on Drawing No	8599/1-60	8599/1-61	8599/1-60							
Retested by Test	-	-	-	-	-	-	-	-		
FIELD & LABORATORY DATA										
Field Wet Density	t/m ³	2.08	2.06	2.06	2.07	2.07	2.09	2.05	2.07	
Field Moisture Content	%	17.0	18.5	17.5	18.5	17.5	18.5	18.0	16.0	
Material retained on 19mm Sieve (wet)	%	<5	<5	<5	<5	<5	<5	<5	<5	
Lab Compaction result from test number		3494	3495	3496	3497	3498	3499	3500	3501	
Peak Converted Wet Density	t/m ³	2.12	2.13	2.13	2.11	2.10	2.10	2.10	2.10	
Apparent Optimum Moisture Content	%	17.0	18.0	17.5	18.0	17.5	18.5	17.5	15.5	
Number of Compaction Points		3	3	3	3	3	3	3	3	
Test Procedures - See Note Number		12	12	12	12	12	12	12	12	
Material Description - see below		2	2	2	2	2	2	2	2	
Notes										
1: Assigned Values have been obtained from our Penrith laboratory – Accreditation No 2734					10: AS 1289 1.2.1 clause 6.4 (b), 2.1.1, 5.3.1, 5.5.1, 5.6.1					
2: Assigned Values have been obtained from our Prestons laboratory – Accreditation No 14234					11: AS 1289 1.2.1 clause 6.4 (b), 2.1.1, 5.3.1, 5.7.1					
3: Results have been calculated using infinite decimal places. Therefore, calculated values may vary from those shown					12: AS 1289 1.2.1 clause 6.4 (b), 2.1.1, 5.7.1, 5.8.1					
4: AS 1289 1.2.1 clause 6.4 (b), 2.1.1, 5.1.1, 5.3.1, 5.4.1					13: RMS T111, T119, T120, T166					
5: AS 1289 1.2.1 clause 6.4 (b), 2.1.1, 5.2.1, 5.3.1, 5.4.1					14: RMS T111, T120, T166, T173					
6: AS 1289 1.2.1 clause 6.4 (b),					15: RMS T120, T119, T162					
7: AS 1289 1.2.1 clause 6.4 (b), 2.1.1, 5.2.1, 5.4.1, 5.8.1					16: RMS T120, T162, T173					
8: AS 1289 1.2.1 clause 6.4 (b), 2.1.1., 5.5.1, 5.6.1, 5.8.1					17: RMS T120, T164, T173					
9: Full details of Test Procedure 5.8.1 available on request										
Material Description										
1. CL-Clays of low plasticity, gravelly clays, sandy clays, silty clays			11. DGS40			* Cement Stabilised				
2. CI-Clay of medium plasticity, gravelly clays, sandy clays, silty clays			12. FCR20			# Lime Stabilised				
3. CH-Clays of high plasticity			13. FCR40			\$ Gypsum Stabilised				
4. SC-Clayey sands, sand-clay mixtures			14. RC - Recycled Concrete							
5. SM-Silty sands, sand-silt mixtures			15. Recycled Roadbase							
6. GC-Clayey gravels, gravel-sand-clay mixtures			16. RSB - Recycled Sub-base							
7. SP-Sand, crushed dust, filling sand, washed sand			17. CSS - Crushed Sandstone							
8. DGB20			18. RSS - Ripped Sandstone							
9. DGB40			19. Cowels Brown							
10. DGS20										

Form No R 020c Version 01 06/17 - issued by ER



Accreditation Number 2734
Corporate Site Number 2727

Accredited for compliance with
ISO/IEC 17025 - Testing.

A Kench 24/11/2017

Approved Signatory

Head Office:
34 Borec Road, Penrith NSW 2750
P O Box 880 Penrith NSW 2751
Telephone: (02) 4722 21

Prestons Laboratory:
Unit 4, 18-20 Whyalla Place, Prestons NSW 2170
Telephone: (02) 9607 6111 Facsimile: (02) 9607 6200

FIELD DENSITY RESULTS

DARACON CONTRACTORS PTY LTD
PO BOX 299
WALLSEND NSW 2287

Laboratory: Penrith
Job No: 8599/1
Date: 24/11/2017

PROJECT: SITE FILL TESTING - AREA B
RESIDENTIAL DEVELOPMENT.WOORONG PARK, MARSDEN PARK

Page 33 of 79

TEST NUMBER	3502	3503	3504	3505	3506	3507	3508	3509		
DATE TESTED	18/10/2017									
RESULTS										
Hiif Density Ratio	Standard	%	99.5	97.5	99	97.5	99.5	98	99	98.5
Moisture Variation from OMC (-Drier/+Wetter)		%	-0.5	0.5	0.5	0.5	0.0	0.0	0.5	-0.5
Specification	Density Ratio (Standard)	≥95%	Specification				Moisture Variance from OMC			±2%
TEST LOCATION										
Easting	294879.7	294860.196	294866.666	294873.784	294877.169	294911.527	294907.72	294898.437		
Northing	6268810.415	6268789.491	6268845.372	6268901.761	6268946.456	6268948.005	6268908.584	6268846.448		
Reduced Level	m	17.009	17.277	16.097	15.606	15.024	14.787	15.248	16.485	
Shown on Drawing No	8599/1-61				8599/1-60					
Retested by Test	-	-	-	-	-	-	-	-		
FIELD & LABORATORY DATA										
Field Wet Density	t/m ³	2.09	2.05	2.07	2.06	2.07	2.06	2.09	2.07	
Field Moisture Content	%	17.5	17.0	17.5	17.0	17.0	17.5	16.5	17.0	
Material retained on 19mm Sieve (wet)	%	<5	<5	<5	<5	<5	<5	<5	<5	
Lab Compaction result from test number		3502	3503	3504	3505	3506	3507	3508	3509	
Peak Converted Wet Density	t/m ³	2.10	2.10	2.09	2.11	2.08	2.10	2.11	2.10	
Apparent Optimum Moisture Content	%	18.5	16.5	17.0	16.5	17.0	17.5	16.5	17.5	
Number of Compaction Points		3	3	3	3	3	3	3	3	
Test Procedures - See Note Number		12	12	12	12	12	12	12	12	
Material Description - see below		2	2	2	2	2	2	2	2	
Notes										
1: Assigned Values have been obtained from our Penrith laboratory – Accreditation No 2734					10: AS 1289 1.2.1 clause 6.4 (b), 2.1.1, 5.3.1, 5.5.1, 5.6.1					
2: Assigned Values have been obtained from our Prestons laboratory – Accreditation No 14234					11: AS 1289 1.2.1 clause 6.4 (b), 2.1.1, 5.3.1, 5.7.1					
3: Results have been calculated using infinite decimal places. Therefore, calculated values may vary from those shown					12: AS 1289 1.2.1 clause 6.4 (b), 2.1.1, 5.7.1, 5.8.1					
4: AS 1289 1.2.1 clause 6.4 (b), 2.1.1, 5.1.1, 5.3.1, 5.4.1					13: RMS T111, T119, T120, T166					
5: AS 1289 1.2.1 clause 6.4 (b), 2.1.1, 5.2.1, 5.3.1, 5.4.1					14: RMS T111, T120, T166, T173					
6: AS 1289 1.2.1 clause 6.4 (b),					15: RMS T120, T119, T162					
7: AS 1289 1.2.1 clause 6.4 (b), 2.1.1, 5.2.1, 5.4.1, 5.8.1					16: RMS T120, T162, T173					
8: AS 1289 1.2.1 clause 6.4 (b), 2.1.1., 5.5.1, 5.6.1, 5.8.1					17: RMS T120, T164, T173					
9: Full details of Test Procedure 5.8.1 available on request										
Material Description										
1. CL-Clays of low plasticity, gravelly clays, sandy clays, silty clays			11. DGS40			* Cement Stabilised				
2. CI-Clay of medium plasticity, gravelly clays, sandy clays, silty clays			12. FCR20			# Lime Stabilised				
3. CH-Clays of high plasticity			13. FCR40			\$ Gypsum Stabilised				
4. SC-Clayey sands, sand-clay mixtures			14. RC - Recycled Concrete							
5. SM-Silty sands, sand-silt mixtures			15. Recycled Roadbase							
6. GC-Clayey gravels, gravel-sand-clay mixtures			16. RSB - Recycled Sub-base							
7. SP-Sand, crushed dust, filling sand, washed sand			17. CSS - Crushed Sandstone							
8. DGB20			18. RSS - Ripped Sandstone							
9. DGB40			19. Cowels Brown							
10. DGS20										

Form No R 020c Version 01 06/17 - issued by ER



Accreditation Number 2734
Corporate Site Number 2727

Accredited for compliance with
ISO/IEC 17025 - Testing.

A Kench 24/11/2017

Approved Signatory

Head Office:
34 Borec Road, Penrith NSW 2750
P O Box 880 Penrith NSW 2751
Telephone: (02) 4722 21

Prestons Laboratory:
Unit 4, 18-20 Whyalla Place, Prestons NSW 2170
Telephone: (02) 9607 6111 Facsimile: (02) 9607 6200

FIELD DENSITY RESULTS

DARACON CONTRACTORS PTY LTD
PO BOX 299
WALLSEND NSW 2287

Laboratory: Penrith
Job No: 8599/1
Date: 24/11/2017

PROJECT: SITE FILL TESTING - AREA B
RESIDENTIAL DEVELOPMENT.WOORONG PARK, MARSDEN PARK

Page 34 of 79

TEST NUMBER	3510	3511	3512	3513	3514	3515	3516	3517		
DATE TESTED	18/10/2017									
RESULTS										
Hilf Density Ratio	Standard	%	97	98	98.5	98.5	97	96.5	96.5	98
Moisture Variation from OMC (-Drier/+Wetter)		%	0.0	0.0	0.0	0.0	0.0	0.0	0.5	0.0
Specification	Density Ratio (Standard)		≥95%				Specification	Moisture Variance from OMC		±2%
TEST LOCATION										
Easting	294920.615	294924.277	294927.548	294932.046	294950.939	294949.592	294937.722	295853.89		
Northing	6268826.048	6268867.198	6268899.363	6268933.823	6268939.985	6268906.891	6268833.723	6268628.325		
Reduced Level	m	17.405	16.011	15.557	14.973	15.16	15.619	17.378	18.839	
Shown on Drawing No	8599/1-61	8599/1-60						8599/1-63		
Retested by Test	-	-	-	-	-	-	-	-		
FIELD & LABORATORY DATA										
Field Wet Density	t/m ³	2.07	2.06	2.08	2.08	2.06	2.05	2.05	2.07	
Field Moisture Content	%	17.5	15.0	17.5	16.5	16.5	18.0	16.0	17.0	
Material retained on 19mm Sieve (wet)	%	<5	<5	<5	<5	<5	<5	<5	<5	
Lab Compaction result from test number		3510	3511	3512	3513	3514	3515	3516	3517	
Peak Converted Wet Density	t/m ³	2.13	2.10	2.11	2.11	2.12	2.12	2.12	2.11	
Apparent Optimum Moisture Content	%	17.5	15.0	17.5	16.5	16.5	18.0	16.0	16.5	
Number of Compaction Points		3	3	3	3	3	3	3	3	
Test Procedures - See Note Number		12	12	12	12	12	12	12	12	
Material Description - see below		2	2	2	2	2	2	2	2	
Notes										
1: Assigned Values have been obtained from our Penrith laboratory – Accreditation No 2734					10: AS 1289 1.2.1 clause 6.4 (b), 2.1.1, 5.3.1, 5.5.1, 5.6.1					
2: Assigned Values have been obtained from our Prestons laboratory – Accreditation No 14234					11: AS 1289 1.2.1 clause 6.4 (b), 2.1.1, 5.3.1, 5.7.1					
3: Results have been calculated using infinite decimal places. Therefore, calculated values may vary from those shown					12: AS 1289 1.2.1 clause 6.4 (b), 2.1.1, 5.7.1, 5.8.1					
4: AS 1289 1.2.1 clause 6.4 (b), 2.1.1, 5.1.1, 5.3.1, 5.4.1					13: RMS T111, T119, T120, T166					
5: AS 1289 1.2.1 clause 6.4 (b), 2.1.1, 5.2.1, 5.3.1, 5.4.1					14: RMS T111, T120, T166, T173					
6: AS 1289 1.2.1 clause 6.4 (b),					15: RMS T120, T119, T162					
7: AS 1289 1.2.1 clause 6.4 (b), 2.1.1, 5.2.1, 5.4.1, 5.8.1					16: RMS T120, T162, T173					
8: AS 1289 1.2.1 clause 6.4 (b), 2.1.1., 5.5.1, 5.6.1, 5.8.1					17: RMS T120, T164, T173					
9: Full details of Test Procedure 5.8.1 available on request										
Material Description										
1. CL-Clays of low plasticity, gravelly clays, sandy clays, silty clays			11. DGS40			* Cement Stabilised				
2. CI-Clay of medium plasticity, gravelly clays, sandy clays, silty clays			12. FCR20			# Lime Stabilised				
3. CH-Clays of high plasticity			13. FCR40			\$ Gypsum Stabilised				
4. SC-Clayey sands, sand-clay mixtures			14. RC - Recycled Concrete							
5. SM-Silty sands, sand-silt mixtures			15. Recycled Roadbase							
6. GC-Clayey gravels, gravel-sand-clay mixtures			16. RSB - Recycled Sub-base							
7. SP-Sand, crushed dust, filling sand, washed sand			17. CSS - Crushed Sandstone							
8. DGB20			18. RSS - Ripped Sandstone							
9. DGB40			19. Cowels Brown							
10. DGS20										

Form No R 020c Version 01 06/17 - issued by ER



Accreditation Number 2734
Corporate Site Number 2727

Accredited for compliance with
ISO/IEC 17025 - Testing.

A Kench 24/11/2017

Approved Signatory

Head Office:
34 Borec Road, Penrith NSW 2750
P O Box 880 Penrith NSW 2751
Telephone: (02) 4722 21

Prestons Laboratory:
Unit 4, 18-20 Whyalla Place, Prestons NSW 2170
Telephone: (02) 9607 6111 Facsimile: (02) 9607 6200

FIELD DENSITY RESULTS

DARACON CONTRACTORS PTY LTD
PO BOX 299
WALLSEND NSW 2287

Laboratory: Penrith
Job No: 8599/1
Date: 24/11/2017

PROJECT: SITE FILL TESTING - AREA B
RESIDENTIAL DEVELOPMENT.WOORONG PARK, MARSDEN PARK

Page 35 of 79

TEST NUMBER	3518	3519	3520	3521	3522	3523	3524	3525		
DATE TESTED	18/10/2017									
RESULTS										
Hilf Density Ratio	Standard	%	98.5	97	97	97	98	96.5	96.5	98
Moisture Variation from OMC (-Drier/+Wetter)		%	0.0	0.0	0.0	0.5	0.5	0.0	0.0	0.5
Specification	Density Ratio (Standard)	≥95%	Specification				Moisture Variance from OMC			±2%
TEST LOCATION										
Easting	295860.229	295866.093	295881.462	295908.739	295906.253	295892.388	295889.77	295908.324		
Northing	6268578.962	6268549.634	6268505.29	6268476.611	6268518.621	6268576.881	6268634.271	6268619.415		
Reduced Level	m	18.978	18.836	19.054	19.686	20	19.282	18.889	19.27	
Shown on Drawing No	8599/1-63									
Retested by Test	-	-	-	-	-	-	-	-		
FIELD & LABORATORY DATA										
Field Wet Density	t/m ³	2.08	2.06	2.06	2.07	2.07	2.05	2.06	2.07	
Field Moisture Content	%	17.0	17.5	17.0	16.5	17.0	18.0	17.5	16.5	
Material retained on 19mm Sieve (wet)	%	<5	<5	<5	<5	<5	<5	<5	<5	
Lab Compaction result from test number		3518	3519	3520	3521	3522	3523	3524	3525	
Peak Converted Wet Density	t/m ³	2.11	2.12	2.12	2.13	2.11	2.12	2.13	2.11	
Apparent Optimum Moisture Content	%	17.0	17.0	17.0	16.0	16.5	18.0	17.0	16.0	
Number of Compaction Points		3	3	3	3	3	3	3	3	
Test Procedures - See Note Number		12	12	12	12	12	12	12	12	
Material Description - see below		2	2	2	2	2	2	2	2	
Notes										
1: Assigned Values have been obtained from our Penrith laboratory – Accreditation No 2734					10: AS 1289 1.2.1 clause 6.4 (b), 2.1.1, 5.3.1, 5.5.1, 5.6.1					
2: Assigned Values have been obtained from our Prestons laboratory – Accreditation No 14234					11: AS 1289 1.2.1 clause 6.4 (b), 2.1.1, 5.3.1, 5.7.1					
3: Results have been calculated using infinite decimal places. Therefore, calculated values may vary from those shown										
4: AS 1289 1.2.1 clause 6.4 (b), 2.1.1, 5.1.1, 5.3.1, 5.4.1					12: AS 1289 1.2.1 clause 6.4 (b), 2.1.1, 5.7.1, 5.8.1					
5: AS 1289 1.2.1 clause 6.4 (b), 2.1.1, 5.2.1, 5.3.1, 5.4.1					13: RMS T111, T119, T120, T166					
6: AS 1289 1.2.1 clause 6.4 (b)					14: RMS T111, T120, T166, T173					
7: AS 1289 1.2.1 clause 6.4 (b), 2.1.1, 5.2.1, 5.4.1, 5.8.1					15: RMS T120, T119, T162					
8: AS 1289 1.2.1 clause 6.4 (b), 2.1.1., 5.5.1, 5.6.1, 5.8.1					16: RMS T120, T162, T173					
9: Full details of Test Procedure 5.8.1 available on request					17: RMS T120, T164, T173					
Material Description										
1. CL-Clays of low plasticity, gravelly clays, sandy clays, silty clays			11. DGS40			* Cement Stabilised				
2. CI-Clay of medium plasticity, gravelly clays, sandy clays, silty clays			12. FCR20			# Lime Stabilised				
3. CH-Clays of high plasticity			13. FCR40			\$ Gypsum Stabilised				
4. SC-Clayey sands, sand-clay mixtures			14. RC - Recycled Concrete							
5. SM-Silty sands, sand-silt mixtures			15. Recycled Roadbase							
6. GC-Clayey gravels, gravel-sand-clay mixtures			16. RSB - Recycled Sub-base							
7. SP-Sand, crushed dust, filling sand, washed sand			17. CSS - Crushed Sandstone							
8. DGB20			18. RSS - Ripped Sandstone							
9. DGB40			19. Cowels Brown							
10. DGS20										

Form No R 020c Version 01 06/17 - issued by ER



Accreditation Number 2734
Corporate Site Number 2727

Accredited for compliance with
ISO/IEC 17025 - Testing.

A Kench 24/11/2017

Approved Signatory

Head Office:
34 Borec Road, Penrith NSW 2750
P O Box 880 Penrith NSW 2751
Telephone: (02) 4722 21

Prestons Laboratory:
Unit 4, 18-20 Whyalla Place, Prestons NSW 2170
Telephone: (02) 9607 6111 Facsimile: (02) 9607 6200

FIELD DENSITY RESULTS

DARACON CONTRACTORS PTY LTD
PO BOX 299
WALLSEND NSW 2287

Laboratory: Penrith
Job No: 8599/1
Date: 24/11/2017

PROJECT: SITE FILL TESTING - AREA B
RESIDENTIAL DEVELOPMENT.WOORONG PARK, MARSDEN PARK

Page 36 of 79

TEST NUMBER	3526	3527	3528	3529	3530	3531	3532	3533		
DATE TESTED	18/10/2017									
RESULTS										
Hilf Density Ratio	Standard	%	99.5	97.5	96	97.5	96	98	97.5	97
Moisture Variation from OMC (-Drier/+Wetter)		%	0.0	0.0	0.0	0.0	0.0	0.0	0.0	0.0
Specification	Density Ratio (Standard)		≥95%			Specification	Moisture Variance from OMC		±2%	
TEST LOCATION										
Easting	295915.403	295917.097	295956.345	295958.426	295980.73	295995.174	296077.344	296108.584		
Northing	6268577.504	6268540.293	6268595.164	6268623.797	6268640.948	6268614.739	6268688.031	6268691.719		
Reduced Level	m	19.712	20.011	20.347	20.149	20.62	21.478	22.039	21.787	
Shown on Drawing No	8599/1-63									
Retested by Test	-	-	-	-	-	-	-	-		
FIELD & LABORATORY DATA										
Field Wet Density	t/m ³	2.10	2.07	2.05	2.06	2.05	2.08	2.06	2.07	
Field Moisture Content	%	15.5	16.0	17.0	15.5	17.5	18.0	18.0	16.0	
Material retained on 19mm Sieve (wet)	%	<5	<5	<5	<5	<5	<5	<5	<5	
Lab Compaction result from test number		3526	3527	3528	3529	3530	3531	3532	3533	
Peak Converted Wet Density	t/m ³	2.11	2.12	2.13	2.11	2.13	2.12	2.11	2.13	
Apparent Optimum Moisture Content	%	15.0	16.0	17.0	15.5	17.0	18.0	18.0	16.0	
Number of Compaction Points		3	3	3	3	3	3	3	3	
Test Procedures - See Note Number		12	12	12	12	12	12	12	12	
Material Description - see below		2	2	2	2	2	2	2	2	
Notes										
1: Assigned Values have been obtained from our Penrith laboratory – Accreditation No 2734					10: AS 1289 1.2.1 clause 6.4 (b), 2.1.1, 5.3.1, 5.5.1, 5.6.1					
2: Assigned Values have been obtained from our Prestons laboratory – Accreditation No 14234					11: AS 1289 1.2.1 clause 6.4 (b), 2.1.1, 5.3.1, 5.7.1					
3: Results have been calculated using infinite decimal places. Therefore, calculated values may vary from those shown										
4: AS 1289 1.2.1 clause 6.4 (b), 2.1.1, 5.1.1, 5.3.1, 5.4.1					12: AS 1289 1.2.1 clause 6.4 (b), 2.1.1, 5.7.1, 5.8.1					
5: AS 1289 1.2.1 clause 6.4 (b), 2.1.1, 5.2.1, 5.3.1, 5.4.1					13: RMS T111, T119, T120, T166					
6: AS 1289 1.2.1 clause 6.4 (b),					14: RMS T111, T120, T166, T173					
7: AS 1289 1.2.1 clause 6.4 (b), 2.1.1, 5.2.1, 5.4.1, 5.8.1					15: RMS T120, T119, T162					
8: AS 1289 1.2.1 clause 6.4 (b), 2.1.1., 5.5.1, 5.6.1, 5.8.1					16: RMS T120, T162, T173					
9: Full details of Test Procedure 5.8.1 available on request					17: RMS T120, T164, T173					
Material Description										
1. CL-Clays of low plasticity, gravelly clays, sandy clays, silty clays			11. DGS40			* Cement Stabilised				
2. CI-Clay of medium plasticity, gravelly clays, sandy clays, silty clays			12. FCR20			# Lime Stabilised				
3. CH-Clays of high plasticity			13. FCR40			\$ Gypsum Stabilised				
4. SC-Clayey sands, sand-clay mixtures			14. RC - Recycled Concrete							
5. SM-Silty sands, sand-silt mixtures			15. Recycled Roadbase							
6. GC-Clayey gravels, gravel-sand-clay mixtures			16. RSB - Recycled Sub-base							
7. SP-Sand, crushed dust, filling sand, washed sand			17. CSS - Crushed Sandstone							
8. DGB20			18. RSS - Ripped Sandstone							
9. DGB40			19. Cowels Brown							
10. DGS20										

Form No R 020c Version 01 06/17 - issued by ER



Accreditation Number 2734
Corporate Site Number 2727

Accredited for compliance with
ISO/IEC 17025 - Testing.

A Kench 24/11/2017

Approved Signatory

Head Office:
34 Borec Road, Penrith NSW 2750
P O Box 880 Penrith NSW 2751
Telephone: (02) 4722 21

Prestons Laboratory:
Unit 4, 18-20 Whyalla Place, Prestons NSW 2170
Telephone: (02) 9607 6111 Facsimile: (02) 9607 6200

FIELD DENSITY RESULTS

DARACON CONTRACTORS PTY LTD
PO BOX 299
WALLSEND NSW 2287

Laboratory: Penrith
Job No: 8599/1
Date: 24/11/2017

PROJECT: SITE FILL TESTING - AREA B
RESIDENTIAL DEVELOPMENT.WOORONG PARK, MARSDEN PARK

Page 37 of 79

TEST NUMBER	3534	3535	3536	3537	3538	3539	3540	3541		
DATE TESTED	18/10/2017									
RESULTS										
Hiif Density Ratio	Standard	%	97	98	99	97	97	97	96.5	98
Moisture Variation from OMC (-Drier/+Wetter)		%	0.0	0.0	0.0	0.0	0.0	0.0	0.5	0.5
Specification	Density Ratio (Standard)	≥95%	Specification Moisture Variance from OMC						±2%	
TEST LOCATION										
Easting	296170.414	296170.421	296170.424	296224.115	296202.938	296166.186	296188.097	296195.771		
Northing	6268697.458	6268697.462	6268697.457	6268721.181	6268768.909	6268777.019	6268742.202	6268722.413		
Reduced Level	m	20.863	20.87	20.856	18.866	18.263	18.279	18.949	19.217	
Shown on Drawing No	8599/1-63				8599/1-64				8599/1-63	
Retested by Test	-	-	-	-	-	-	-	-	-	
FIELD & LABORATORY DATA										
Field Wet Density	t/m ³	2.06	2.09	2.10	2.05	2.07	2.07	2.05	2.07	
Field Moisture Content	%	16.0	16.5	16.5	15.5	17.0	15.5	16.0	16.5	
Material retained on 19mm Sieve (wet)	%	<5	<5	<5	<5	<5	<5	<5	<5	
Lab Compaction result from test number		3534	3535	3536	3537	3538	3539	3540	3541	
Peak Converted Wet Density	t/m ³	2.12	2.13	2.12	2.11	2.13	2.13	2.12	2.11	
Apparent Optimum Moisture Content	%	15.5	16.5	16.5	15.5	16.5	15.5	15.5	16.0	
Number of Compaction Points		3	3	3	3	3	3	3	3	
Test Procedures - See Note Number		12	12	12	12	12	12	12	12	
Material Description - see below		2	2	2	2	2	2	2	2	
Notes										
1: Assigned Values have been obtained from our Penrith laboratory – Accreditation No 2734					10: AS 1289 1.2.1 clause 6.4 (b), 2.1.1, 5.3.1, 5.5.1, 5.6.1					
2: Assigned Values have been obtained from our Prestons laboratory – Accreditation No 14234					11: AS 1289 1.2.1 clause 6.4 (b), 2.1.1, 5.3.1, 5.7.1					
3: Results have been calculated using infinite decimal places. Therefore, calculated values may vary from those shown					12: AS 1289 1.2.1 clause 6.4 (b), 2.1.1, 5.7.1, 5.8.1					
4: AS 1289 1.2.1 clause 6.4 (b), 2.1.1, 5.1.1, 5.3.1, 5.4.1					13: RMS T111, T119, T120, T166					
5: AS 1289 1.2.1 clause 6.4 (b), 2.1.1, 5.2.1, 5.3.1, 5.4.1					14: RMS T111, T120, T166, T173					
6: AS 1289 1.2.1 clause 6.4 (b),					15: RMS T120, T119, T162					
7: AS 1289 1.2.1 clause 6.4 (b), 2.1.1, 5.2.1, 5.4.1, 5.8.1					16: RMS T120, T162, T173					
8: AS 1289 1.2.1 clause 6.4 (b), 2.1.1., 5.5.1, 5.6.1, 5.8.1					17: RMS T120, T164, T173					
9: Full details of Test Procedure 5.8.1 available on request										
Material Description										
1. CL-Clays of low plasticity, gravelly clays, sandy clays, silty clays			11. DGS40			* Cement Stabilised				
2. CI-Clay of medium plasticity, gravelly clays, sandy clays, silty clays			12. FCR20			# Lime Stabilised				
3. CH-Clays of high plasticity			13. FCR40			\$ Gypsum Stabilised				
4. SC-Clayey sands, sand-clay mixtures			14. RC - Recycled Concrete							
5. SM-Silty sands, sand-silt mixtures			15. Recycled Roadbase							
6. GC-Clayey gravels, gravel-sand-clay mixtures			16. RSB - Recycled Sub-base							
7. SP-Sand, crushed dust, filling sand, washed sand			17. CSS - Crushed Sandstone							
8. DGB20			18. RSS - Ripped Sandstone							
9. DGB40			19. Cowels Brown							
10. DGS20										

Form No R 020c Version 01 06/17 - issued by ER



Accreditation Number 2734
Corporate Site Number 2727

Accredited for compliance with
ISO/IEC 17025 - Testing.

A Kench 24/11/2017

Approved Signatory

Head Office:
34 Borec Road, Penrith NSW 2750
P O Box 880 Penrith NSW 2751
Telephone: (02) 4722 21

Prestons Laboratory:
Unit 4, 18-20 Whyalla Place, Prestons NSW 2170
Telephone: (02) 9607 6111 Facsimile: (02) 9607 6200

FIELD DENSITY RESULTS

DARACON CONTRACTORS PTY LTD
PO BOX 299
WALLSEND NSW 2287

Laboratory: Penrith
Job No: 8599/1
Date: 24/11/2017

PROJECT: SITE FILL TESTING - AREA B
RESIDENTIAL DEVELOPMENT.WOORONG PARK, MARSDEN PARK

Page 38 of 79

TEST NUMBER	3542	3543	3544	3545	3546	3547	3548	3549		
DATE TESTED	18/10/2017									
RESULTS										
Hilf Density Ratio	Standard	%	98	96	96.5	96.5	97.5	97.5	97	98
Moisture Variation from OMC (-Drier/+Wetter)		%	0.0	0.0	0.5	1.0	0.0	0.0	0.0	0.5
Specification	Density Ratio (Standard)		≥95%				Specification Moisture Variance from OMC	±2%		
TEST LOCATION										
Easting	296131.161	296079.853	296079.879	296113.333	296111.662	296085.666	296086.044	296123.525		
Northing	6268707.28	6268710.321	6268657.784	6268658.955	6268644.478	6268637.555	6268612.509	6268608.809		
Reduced Level	m		21.109	21.436	22.3	22.372	22.642	22.619	22.664	22.838
Shown on Drawing No	8599/1-64				8599/1-63					
Retested by Test	-	-	-	-	-	-	-	-		
FIELD & LABORATORY DATA										
Field Wet Density	t/m ³	2.07	2.05	2.06	2.05	2.08	2.06	2.07	2.07	
Field Moisture Content	%	16.0	16.5	16.5	16.5	16.5	16.5	17.0	16.5	
Material retained on 19mm Sieve (wet)	%	<5	<5	<5	<5	<5	<5	<5	<5	
Lab Compaction result from test number		3542	3543	3544	3545	3546	3547	3548	3549	
Peak Converted Wet Density	t/m ³	2.11	2.13	2.13	2.12	2.13	2.11	2.13	2.11	
Apparent Optimum Moisture Content	%	16.0	16.5	16.5	16.0	16.5	16.0	17.0	16.0	
Number of Compaction Points		3	3	3	3	3	3	3	3	
Test Procedures - See Note Number		12	12	12	12	12	12	12	12	
Material Description - see below		2	2	2	2	2	2	2	2	
Notes										
1: Assigned Values have been obtained from our Penrith laboratory – Accreditation No 2734					10: AS 1289 1.2.1 clause 6.4 (b), 2.1.1, 5.3.1, 5.5.1, 5.6.1					
2: Assigned Values have been obtained from our Prestons laboratory – Accreditation No 14234					11: AS 1289 1.2.1 clause 6.4 (b), 2.1.1, 5.3.1, 5.7.1					
3: Results have been calculated using infinite decimal places. Therefore, calculated values may vary from those shown					12: AS 1289 1.2.1 clause 6.4 (b), 2.1.1, 5.7.1, 5.8.1					
4: AS 1289 1.2.1 clause 6.4 (b), 2.1.1, 5.1.1, 5.3.1, 5.4.1					13: RMS T111, T119, T120, T166					
5: AS 1289 1.2.1 clause 6.4 (b), 2.1.1, 5.2.1, 5.3.1, 5.4.1					14: RMS T111, T120, T166, T173					
6: AS 1289 1.2.1 clause 6.4 (b),					15: RMS T120, T119, T162					
7: AS 1289 1.2.1 clause 6.4 (b), 2.1.1, 5.2.1, 5.4.1, 5.8.1					16: RMS T120, T162, T173					
8: AS 1289 1.2.1 clause 6.4 (b), 2.1.1., 5.5.1, 5.6.1, 5.8.1					17: RMS T120, T164, T173					
9: Full details of Test Procedure 5.8.1 available on request										
Material Description										
1. CL-Clays of low plasticity, gravelly clays, sandy clays, silty clays			11. DGS40			* Cement Stabilised				
2. CI-Clay of medium plasticity, gravelly clays, sandy clays, silty clays			12. FCR20			# Lime Stabilised				
3. CH-Clays of high plasticity			13. FCR40			\$ Gypsum Stabilised				
4. SC-Clayey sands, sand-clay mixtures			14. RC - Recycled Concrete							
5. SM-Silty sands, sand-silt mixtures			15. Recycled Roadbase							
6. GC-Clayey gravels, gravel-sand-clay mixtures			16. RSB - Recycled Sub-base							
7. SP-Sand, crushed dust, filling sand, washed sand			17. CSS - Crushed Sandstone							
8. DGB20			18. RSS - Ripped Sandstone							
9. DGB40			19. Cowels Brown							
10. DGS20										

Form No R 020c Version 01 06/17 - issued by ER



Accreditation Number 2734
Corporate Site Number 2727

Accredited for compliance with
ISO/IEC 17025 - Testing.

A Kench 24/11/2017

Approved Signatory

Head Office:
34 Borec Road, Penrith NSW 2750
P O Box 880 Penrith NSW 2751
Telephone: (02) 4722 21

Prestons Laboratory:
Unit 4, 18-20 Whyalla Place, Prestons NSW 2170
Telephone: (02) 9607 6111 Facsimile: (02) 9607 6200

FIELD DENSITY RESULTS

DARACON CONTRACTORS PTY LTD
PO BOX 299
WALLSEND NSW 2287

Laboratory: Penrith
Job No: 8599/1
Date: 24/11/2017

PROJECT: SITE FILL TESTING - AREA B
RESIDENTIAL DEVELOPMENT.WOORONG PARK, MARSDEN PARK

Page 39 of 79

TEST NUMBER	3550	3551	3552	3553	3554	3555	3556	3557		
DATE TESTED	18/10/2017									
RESULTS										
Hiif Density Ratio	Standard	%	97.5	97.5	99	98	97.5	97	97	98
Moisture Variation from OMC (-Drier/+Wetter)		%	0.0	0.0	0.0	0.5	0.0	0.0	0.0	0.0
Specification	Density Ratio (Standard)	≥95%	Specification				Moisture Variance from OMC			±2%
TEST LOCATION										
Easting	296027.152	295983.288	295944.013	295938.181	295977.789	296016.245	296016.821	295971.714		
Northing	6268685.319	6268682.345	6268677.132	6268698.783	6268701.302	6268701.423	6268719.034	6268723.843		
Reduced Level	m	21.902	20.817	19.439	19.305	20.467	21.51	21.111	19.964	
Shown on Drawing No	8599/1-63									
Retested by Test	-	-	-	-	-	-	-	-		
FIELD & LABORATORY DATA										
Field Wet Density	t/m ³	2.07	2.08	2.08	2.07	2.08	2.05	2.07	2.07	
Field Moisture Content	%	16.0	17.0	16.5	16.0	16.0	16.0	15.5	17.0	
Material retained on 19mm Sieve (wet)	%	<5	<5	<5	<5	<5	<5	<5	<5	
Lab Compaction result from test number		3550	3551	3552	3553	3554	3555	3556	3557	
Peak Converted Wet Density	t/m ³	2.12	2.13	2.10	2.11	2.13	2.11	2.13	2.11	
Apparent Optimum Moisture Content	%	16.0	17.0	16.5	15.5	16.0	16.0	15.5	17.0	
Number of Compaction Points		3	3	3	3	3	3	3	3	
Test Procedures - See Note Number		12	12	12	12	12	12	12	12	
Material Description - see below		2	2	2	2	2	2	2	2	
Notes										
1: Assigned Values have been obtained from our Penrith laboratory – Accreditation No 2734					10: AS 1289 1.2.1 clause 6.4 (b), 2.1.1, 5.3.1, 5.5.1, 5.6.1					
2: Assigned Values have been obtained from our Prestons laboratory – Accreditation No 14234					11: AS 1289 1.2.1 clause 6.4 (b), 2.1.1, 5.3.1, 5.7.1					
3: Results have been calculated using infinite decimal places. Therefore, calculated values may vary from those shown					12: AS 1289 1.2.1 clause 6.4 (b), 2.1.1, 5.7.1, 5.8.1					
4: AS 1289 1.2.1 clause 6.4 (b), 2.1.1, 5.1.1, 5.3.1, 5.4.1					13: RMS T111, T119, T120, T166					
5: AS 1289 1.2.1 clause 6.4 (b), 2.1.1, 5.2.1, 5.3.1, 5.4.1					14: RMS T111, T120, T166, T173					
6: AS 1289 1.2.1 clause 6.4 (b),					15: RMS T120, T119, T162					
7: AS 1289 1.2.1 clause 6.4 (b), 2.1.1, 5.2.1, 5.4.1, 5.8.1					16: RMS T120, T162, T173					
8: AS 1289 1.2.1 clause 6.4 (b), 2.1.1., 5.5.1, 5.6.1, 5.8.1					17: RMS T120, T164, T173					
9: Full details of Test Procedure 5.8.1 available on request										
Material Description										
1. CL-Clays of low plasticity, gravelly clays, sandy clays, silty clays			11. DGS40			* Cement Stabilised				
2. CI-Clay of medium plasticity, gravelly clays, sandy clays, silty clays			12. FCR20			# Lime Stabilised				
3. CH-Clays of high plasticity			13. FCR40			\$ Gypsum Stabilised				
4. SC-Clayey sands, sand-clay mixtures			14. RC - Recycled Concrete							
5. SM-Silty sands, sand-silt mixtures			15. Recycled Roadbase							
6. GC-Clayey gravels, gravel-sand-clay mixtures			16. RSB - Recycled Sub-base							
7. SP-Sand, crushed dust, filling sand, washed sand			17. CSS - Crushed Sandstone							
8. DGB20			18. RSS - Ripped Sandstone							
9. DGB40			19. Cowels Brown							
10. DGS20										

Form No R 020c Version 01 06/17 - issued by ER



Accreditation Number 2734
Corporate Site Number 2727

Accredited for compliance with
ISO/IEC 17025 - Testing.

A Kench 24/11/2017

Approved Signatory

Head Office:
34 Borec Road, Penrith NSW 2750
P O Box 880 Penrith NSW 2751
Telephone: (02) 4722 21

Prestons Laboratory:
Unit 4, 18-20 Whyalla Place, Prestons NSW 2170
Telephone: (02) 9607 6111 Facsimile: (02) 9607 6200

FIELD DENSITY RESULTS

DARACON CONTRACTORS PTY LTD
PO BOX 299
WALLSEND NSW 2287

Laboratory: Penrith
Job No: 8599/1
Date: 24/11/2017

PROJECT: SITE FILL TESTING - AREA B
RESIDENTIAL DEVELOPMENT.WOORONG PARK, MARSDEN PARK

Page 40 of 79

TEST NUMBER	3558	3559	3560	3561	3562	3563	3564	3565		
DATE TESTED	18/10/2017			19/10/2017						
RESULTS										
Hilf Density Ratio	Standard	%	99	98	97.5	98.5	98	99	97	97.5
Moisture Variation from OMC (-Drier/+Wetter)		%	0.0	0.0	0.0	0.0	0.0	-1.0	-0.5	0.0
Specification	Density Ratio (Standard)		≥95%			Specification Moisture Variance from OMC			±2%	
TEST LOCATION										
Easting	295934.904	296442.084	296414.198	296384.591	296349.905	296367.331	296392.377	296421.913		
Northing	6268723.846	6268771.16	6268766.614	6268761.384	6268754.111	6268724.973	6268732.913	6268740.75		
Reduced Level	m		18.952	22.468	22.313	21.955	21.142	21.822	22.612	22.893
Shown on Drawing No			8599/1-63			8599/1-64				
Retested by Test	-	-	-	-	-	-	-	-	-	
FIELD & LABORATORY DATA										
Field Wet Density	t/m ³	2.08	2.08	2.08	2.07	2.06	2.08	2.05	2.08	
Field Moisture Content	%	16.5	16.5	17.0	16.0	17.0	16.0	16.0	16.5	
Material retained on 19mm Sieve (wet)	%	<5	<5	<5	<5	<5	<5	<5	<5	
Lab Compaction result from test number		3558	3559	3560	3561	3562	3563	3564	3565	
Peak Converted Wet Density	t/m ³	2.10	2.12	2.13	2.10	2.10	2.10	2.11	2.13	
Apparent Optimum Moisture Content	%	16.5	16.5	16.5	16.0	16.5	16.5	16.5	16.5	
Number of Compaction Points		3	3	3	3	3	3	3	3	
Test Procedures - See Note Number		12	12	12	12	12	12	12	12	
Material Description - see below		2	2	2	2	2	2	2	2	
Notes										
1: Assigned Values have been obtained from our Penrith laboratory – Accreditation No 2734					10: AS 1289 1.2.1 clause 6.4 (b), 2.1.1, 5.3.1, 5.5.1, 5.6.1					
2: Assigned Values have been obtained from our Prestons laboratory – Accreditation No 14234					11: AS 1289 1.2.1 clause 6.4 (b), 2.1.1, 5.3.1, 5.7.1					
3: Results have been calculated using infinite decimal places. Therefore, calculated values may vary from those shown					12: AS 1289 1.2.1 clause 6.4 (b), 2.1.1, 5.7.1, 5.8.1					
4: AS 1289 1.2.1 clause 6.4 (b), 2.1.1, 5.1.1, 5.3.1, 5.4.1					13: RMS T111, T119, T120, T166					
5: AS 1289 1.2.1 clause 6.4 (b), 2.1.1, 5.2.1, 5.3.1, 5.4.1					14: RMS T111, T120, T166, T173					
6: AS 1289 1.2.1 clause 6.4 (b),					15: RMS T120, T119, T162					
7: AS 1289 1.2.1 clause 6.4 (b), 2.1.1, 5.2.1, 5.4.1, 5.8.1					16: RMS T120, T162, T173					
8: AS 1289 1.2.1 clause 6.4 (b), 2.1.1., 5.5.1, 5.6.1, 5.8.1					17: RMS T120, T164, T173					
9: Full details of Test Procedure 5.8.1 available on request										
Material Description										
1. CL-Clays of low plasticity, gravelly clays, sandy clays, silty clays			11. DGS40			* Cement Stabilised				
2. CI-Clay of medium plasticity, gravelly clays, sandy clays, silty clays			12. FCR20			# Lime Stabilised				
3. CH-Clays of high plasticity			13. FCR40			\$ Gypsum Stabilised				
4. SC-Clayey sands, sand-clay mixtures			14. RC - Recycled Concrete							
5. SM-Silty sands, sand-silt mixtures			15. Recycled Roadbase							
6. GC-Clayey gravels, gravel-sand-clay mixtures			16. RSB - Recycled Sub-base							
7. SP-Sand, crushed dust, filling sand, washed sand			17. CSS - Crushed Sandstone							
8. DGB20			18. RSS - Ripped Sandstone							
9. DGB40			19. Cowels Brown							
10. DGS20										

Form No R 020c Version 01 06/17 - issued by ER



Accreditation Number 2734
Corporate Site Number 2727

Accredited for compliance with
ISO/IEC 17025 - Testing.

A Kench 24/11/2017

Approved Signatory

Head Office:
34 Borec Road, Penrith NSW 2750
P O Box 880 Penrith NSW 2751
Telephone: (02) 4722 21

Prestons Laboratory:
Unit 4, 18-20 Whyalla Place, Prestons NSW 2170
Telephone: (02) 9607 6111 Facsimile: (02) 9607 6200

FIELD DENSITY RESULTS

DARACON CONTRACTORS PTY LTD
PO BOX 299
WALLSEND NSW 2287

Laboratory: Penrith
Job No: 8599/1
Date: 24/11/2017

PROJECT: SITE FILL TESTING - AREA B
RESIDENTIAL DEVELOPMENT.WOORONG PARK, MARSDEN PARK

TEST NUMBER	3566	3567	3568	3569	3570	3571	3572	3573		
DATE TESTED	19/10/2017									
RESULTS										
Hilf Density Ratio	Standard	%	99.5	99	97.5	99	98.5	97.5	98	96.5
Moisture Variation from OMC (-Drier/+Wetter)		%	0.5	0.0	-0.5	0.0	-0.5	0.5	0.0	-0.5
Specification	Density Ratio (Standard)		≥95%			Specification	Moisture Variance from OMC		±2%	
TEST LOCATION										
Easting	296448.136	296454.9	296428.718	296402.093	296373.844	296394.033	296412.477	296438.795		
Northing	6268747.93	6268728.518	6268721.715	6268716.923	6268709.988	6268689.351	6268695.735	6268702.864		
Reduced Level	m	23.087	23.681	23.518	22.865	22.152	22.773	23.253	23.829	
Shown on Drawing No	8599/1-64									
Retested by Test	-	-	-	-	-	-	-	-		
FIELD & LABORATORY DATA										
Field Wet Density	t/m ³	2.09	2.08	2.06	2.08	2.08	2.06	2.06	2.05	
Field Moisture Content	%	15.5	16.5	16.0	15.0	#NUM!	16.5	#NUM!	16.5	
Material retained on 19mm Sieve (wet)	%	<5	<5	<5	<5	<5	<5	<5	<5	
Lab Compaction result from test number		3566	3567	3568	3569	3570	3571	3572	3573	
Peak Converted Wet Density	t/m ³	2.10	2.10	2.11	2.10	2.11	2.11	2.10	2.12	
Apparent Optimum Moisture Content	%	15.0	16.5	16.0	15.0	#NUM!	16.5	#NUM!	16.5	
Number of Compaction Points		3	3	3	3	3	3	3	3	
Test Procedures - See Note Number		12	12	12	12	12	12	12	12	
Material Description - see below		2	2	2	2	2	2	2	2	
Notes										
1: Assigned Values have been obtained from our Penrith laboratory – Accreditation No 2734					10: AS 1289 1.2.1 clause 6.4 (b), 2.1.1, 5.3.1, 5.5.1, 5.6.1					
2: Assigned Values have been obtained from our Prestons laboratory – Accreditation No 14234					11: AS 1289 1.2.1 clause 6.4 (b), 2.1.1, 5.3.1, 5.7.1					
3: Results have been calculated using infinite decimal places. Therefore, calculated values may vary from those shown					12: AS 1289 1.2.1 clause 6.4 (b), 2.1.1, 5.7.1, 5.8.1					
4: AS 1289 1.2.1 clause 6.4 (b), 2.1.1, 5.1.1, 5.3.1, 5.4.1					13: RMS T111, T119, T120, T166					
5: AS 1289 1.2.1 clause 6.4 (b), 2.1.1, 5.2.1, 5.3.1, 5.4.1					14: RMS T111, T120, T166, T173					
6: AS 1289 1.2.1 clause 6.4 (b),					15: RMS T120, T119, T162					
7: AS 1289 1.2.1 clause 6.4 (b), 2.1.1, 5.2.1, 5.4.1, 5.8.1					16: RMS T120, T162, T173					
8: AS 1289 1.2.1 clause 6.4 (b), 2.1.1., 5.5.1, 5.6.1, 5.8.1					17: RMS T120, T164, T173					
9: Full details of Test Procedure 5.8.1 available on request										
Material Description										
1. CL-Clays of low plasticity, gravelly clays, sandy clays, silty clays			11. DGS40			* Cement Stabilised				
2. CI-Clay of medium plasticity, gravelly clays, sandy clays, silty clays			12. FCR20			# Lime Stabilised				
3. CH-Clays of high plasticity			13. FCR40			\$ Gypsum Stabilised				
4. SC-Clayey sands, sand-clay mixtures			14. RC - Recycled Concrete							
5. SM-Silty sands, sand-silt mixtures			15. Recycled Roadbase							
6. GC-Clayey gravels, gravel-sand-clay mixtures			16. RSB - Recycled Sub-base							
7. SP-Sand, crushed dust, filling sand, washed sand			17. CSS - Crushed Sandstone							
8. DGB20			18. RSS - Ripped Sandstone							
9. DGB40			19. Cowels Brown							
10. DGS20										

Form No R 020c Version 01 06/17 - issued by ER



Accreditation Number 2734
Corporate Site Number 2727

Accredited for compliance with
ISO/IEC 17025 - Testing.

A Kench 24/11/2017

Approved Signatory

Head Office:
34 Borec Road, Penrith NSW 2750
P O Box 880 Penrith NSW 2751
Telephone: (02) 4722 21

Prestons Laboratory:
Unit 4, 18-20 Whyalla Place, Prestons NSW 2170
Telephone: (02) 9607 6111 Facsimile: (02) 9607 6200

FIELD DENSITY RESULTS

DARACON CONTRACTORS PTY LTD
PO BOX 299
WALLSEND NSW 2287

Laboratory: Penrith
Job No: 8599/1
Date: 24/11/2017

PROJECT: SITE FILL TESTING - AREA B
RESIDENTIAL DEVELOPMENT.WOORONG PARK, MARSDEN PARK

Page 42 of 79

TEST NUMBER	3574	3575	3576	3577	3578	3579	3580	3581		
DATE TESTED	19/10/2017				24/10/2017					
RESULTS										
Hiif Density Ratio	Standard	%	99.5	98	98	97	98.5	96.5	97	96.5
Moisture Variation from OMC (-Drier/+Wetter)		%	0.0	-0.5	0.0	0.0	-0.5	0.5	0.0	0.0
Specification	Density Ratio (Standard)		≥95%			Specification	Moisture Variance from OMC		±2%	
TEST LOCATION										
Easting	296467.679	296499.183	296524.326	294842.583	294849.77	294858.017	294870.462	294891.34		
Northing	6268710.554	6268721.646	6268727.049	6268820.585	6268852.555	6268892.436	6268940.783	6268949.686		
Reduced Level	m	24.078	24.364	24.411	16.934	16.972	16.76	16.488	16.227	
Shown on Drawing No	8599/1-64			8599/1-61		8599/1-60				
Retested by Test	-	-	-	-	-	-	-	-		
FIELD & LABORATORY DATA										
Field Wet Density	t/m ³	2.09	2.05	2.06	2.05	2.07	2.06	2.07	2.07	
Field Moisture Content	%	15.5	16.0	16.0	16.0	17.0	20.0	19.5	19.5	
Material retained on 19mm Sieve (wet)	%	<5	<5	<5	<5	<5	<5	<5	<5	
Lab Compaction result from test number		3574	3575	3576	3577	3578	3579	3580	3581	
Peak Converted Wet Density	t/m ³	2.10	2.09	2.10	2.11	2.10	2.14	2.13	2.14	
Apparent Optimum Moisture Content	%	15.5	16.0	16.0	16.0	17.5	19.5	19.5	20.0	
Number of Compaction Points		3	3	3	3	3	3	3	3	
Test Procedures - See Note Number		12	12	12	12	12	12	12	12	
Material Description - see below		2	2	2	2	2	2-3	2-3	2-3	
Notes										
1: Assigned Values have been obtained from our Penrith laboratory – Accreditation No 2734					10: AS 1289 1.2.1 clause 6.4 (b), 2.1.1, 5.3.1, 5.5.1, 5.6.1					
2: Assigned Values have been obtained from our Prestons laboratory – Accreditation No 14234					11: AS 1289 1.2.1 clause 6.4 (b), 2.1.1, 5.3.1, 5.7.1					
3: Results have been calculated using infinite decimal places. Therefore, calculated values may vary from those shown					12: AS 1289 1.2.1 clause 6.4 (b), 2.1.1, 5.7.1, 5.8.1					
4: AS 1289 1.2.1 clause 6.4 (b), 2.1.1, 5.1.1, 5.3.1, 5.4.1					13: RMS T111, T119, T120, T166					
5: AS 1289 1.2.1 clause 6.4 (b), 2.1.1, 5.2.1, 5.3.1, 5.4.1					14: RMS T111, T120, T166, T173					
6: AS 1289 1.2.1 clause 6.4 (b),					15: RMS T120, T119, T162					
7: AS 1289 1.2.1 clause 6.4 (b), 2.1.1, 5.2.1, 5.4.1, 5.8.1					16: RMS T120, T162, T173					
8: AS 1289 1.2.1 clause 6.4 (b), 2.1.1., 5.5.1, 5.6.1, 5.8.1					17: RMS T120, T164, T173					
9: Full details of Test Procedure 5.8.1 available on request										
Material Description										
1. CL-Clays of low plasticity, gravelly clays, sandy clays, silty clays			11. DGS40			* Cement Stabilised				
2. CI-Clay of medium plasticity, gravelly clays, sandy clays, silty clays			12. FCR20			# Lime Stabilised				
3. CH-Clays of high plasticity			13. FCR40			\$ Gypsum Stabilised				
4. SC-Clayey sands, sand-clay mixtures			14. RC - Recycled Concrete							
5. SM-Silty sands, sand-silt mixtures			15. Recycled Roadbase							
6. GC-Clayey gravels, gravel-sand-clay mixtures			16. RSB - Recycled Sub-base							
7. SP-Sand, crushed dust, filling sand, washed sand			17. CSS - Crushed Sandstone							
8. DGB20			18. RSS - Ripped Sandstone							
9. DGB40			19. Cowels Brown							
10. DGS20										

Form No R 020c Version 01 06/17 - issued by ER



Accreditation Number 2734
Corporate Site Number 2727

Accredited for compliance with
ISO/IEC 17025 - Testing.

A Kench 24/11/2017

Approved Signatory

Head Office:
34 Borec Road, Penrith NSW 2750
P O Box 880 Penrith NSW 2751
Telephone: (02) 4722 21

Prestons Laboratory:
Unit 4, 18-20 Whyalla Place, Prestons NSW 2170
Telephone: (02) 9607 6111 Facsimile: (02) 9607 6200

FIELD DENSITY RESULTS

DARACON CONTRACTORS PTY LTD
PO BOX 299
WALLSEND NSW 2287

Laboratory: Penrith
Job No: 8599/1
Date: 24/11/2017

PROJECT: SITE FILL TESTING - AREA B
RESIDENTIAL DEVELOPMENT.WOORONG PARK, MARSDEN PARK

Page 43 of 79

TEST NUMBER	3582	3583	3584	3585	3586	3587	3588	3589		
DATE TESTED	24/10/2017									
RESULTS										
Hilf Density Ratio	Standard	%	97	95.5	97.5	97.5	96.5	97.5	97.5	98.5
Moisture Variation from OMC (-Drier/+Wetter)		%	-0.5	0.0	0.0	0.5	0.5	-0.5	0.0	0.5
Specification	Density Ratio (Standard)	≥95%	Specification Moisture Variance from OMC				±2%			
TEST LOCATION										
Easting	294889.093	294876.755	294866.003	294895.427	294905.554	294916.617	294927.172	294951.713		
Northing	6268915.206	6268874.205	6268834.981	6268822.105	6268853.485	6268884.652	6268931.183	6268935.711		
Reduced Level	m	16.523	16.857	17.216	17.578	17.265	16.908	16.174	16.238	
Shown on Drawing No	8599/1-60			8599/1-61			8599/1-60			
Retested by Test	-	-	-	-	-	-	-	-		
FIELD & LABORATORY DATA										
Field Wet Density	t/m ³	2.06	2.05	2.06	2.08	2.07	2.08	2.08	2.09	
Field Moisture Content	%	20.5	20.5	20.5	20.0	19.0	20.0	20.0	20.0	
Material retained on 19mm Sieve (wet)	%	<5	<5	<5	<5	<5	<5	<5	<5	
Lab Compaction result from test number		3582	3583	3584	3585	3586	3587	3588	3589	
Peak Converted Wet Density	t/m ³	2.12	2.15	2.11	2.13	2.14	2.13	2.13	2.12	
Apparent Optimum Moisture Content	%	20.5	20.5	20.5	19.5	18.5	20.0	20.0	19.5	
Number of Compaction Points		3	3	3	3	3	3	3	3	
Test Procedures - See Note Number		12	12	12	12	12	12	12	12	
Material Description - see below		3	2-3	2-3	2-3	2	2-3	2-3	2-3	
Notes										
1: Assigned Values have been obtained from our Penrith laboratory – Accreditation No 2734					10: AS 1289 1.2.1 clause 6.4 (b), 2.1.1, 5.3.1, 5.5.1, 5.6.1					
2: Assigned Values have been obtained from our Prestons laboratory – Accreditation No 14234					11: AS 1289 1.2.1 clause 6.4 (b), 2.1.1, 5.3.1, 5.7.1					
3: Results have been calculated using infinite decimal places. Therefore, calculated values may vary from those shown					12: AS 1289 1.2.1 clause 6.4 (b), 2.1.1, 5.7.1, 5.8.1					
4: AS 1289 1.2.1 clause 6.4 (b), 2.1.1, 5.1.1, 5.3.1, 5.4.1					13: RMS T111, T119, T120, T166					
5: AS 1289 1.2.1 clause 6.4 (b), 2.1.1, 5.2.1, 5.3.1, 5.4.1					14: RMS T111, T120, T166, T173					
6: AS 1289 1.2.1 clause 6.4 (b),					15: RMS T120, T119, T162					
7: AS 1289 1.2.1 clause 6.4 (b), 2.1.1, 5.2.1, 5.4.1, 5.8.1					16: RMS T120, T162, T173					
8: AS 1289 1.2.1 clause 6.4 (b), 2.1.1., 5.5.1, 5.6.1, 5.8.1					17: RMS T120, T164, T173					
9: Full details of Test Procedure 5.8.1 available on request										
Material Description										
1. CL-Clays of low plasticity, gravelly clays, sandy clays, silty clays			11. DGS40			* Cement Stabilised				
2. CI-Clay of medium plasticity, gravelly clays, sandy clays, silty clays			12. FCR20			# Lime Stabilised				
3. CH-Clays of high plasticity			13. FCR40			\$ Gypsum Stabilised				
4. SC-Clayey sands, sand-clay mixtures			14. RC - Recycled Concrete							
5. SM-Silty sands, sand-silt mixtures			15. Recycled Roadbase							
6. GC-Clayey gravels, gravel-sand-clay mixtures			16. RSB - Recycled Sub-base							
7. SP-Sand, crushed dust, filling sand, washed sand			17. CSS - Crushed Sandstone							
8. DGB20			18. RSS - Ripped Sandstone							
9. DGB40			19. Cowels Brown							
10. DGS20										

Form No R 020c Version 01 06/17 - issued by ER



Accreditation Number 2734
Corporate Site Number 2727

Accredited for compliance with
ISO/IEC 17025 - Testing.

A Kench 24/11/2017

Approved Signatory

Head Office:
34 Borec Road, Penrith NSW 2750
P O Box 880 Penrith NSW 2751
Telephone: (02) 4722 21

Prestons Laboratory:
Unit 4, 18-20 Whyalla Place, Prestons NSW 2170
Telephone: (02) 9607 6111 Facsimile: (02) 9607 6200

FIELD DENSITY RESULTS

DARACON CONTRACTORS PTY LTD
PO BOX 299
WALLSEND NSW 2287

Laboratory: Penrith
Job No: 8599/1
Date: 24/11/2017

PROJECT: SITE FILL TESTING - AREA B
RESIDENTIAL DEVELOPMENT.WOORONG PARK, MARSDEN PARK

Page 44 of 79

TEST NUMBER	3590	3591	3592	3593	3594	3595	3596	3597		
DATE TESTED	24/10/2017									
RESULTS										
Hiif Density Ratio	Standard	%	96.5	96	97	97	97.5	95.5	96.5	97
Moisture Variation from OMC (-Drier/+Wetter)		%	1.0	0.0	0.5	-0.5	0.0	0.5	0.0	0.0
Specification	Density Ratio (Standard)	≥95%	Specification				Moisture Variance from OMC			±2%
TEST LOCATION										
Easting	294942.801	294931.104	294916.818	294935.743	294958.446	294979.746	294993.024	295250.98		
Northing	6268894.403	6268863.08	6268819.392	6268816.552	6268854.309	6268901.911	6268930.569	6269120.431		
Reduced Level	m	16.839	17.151	17.825	18.328	17.354	16.65	16.239	15.085	
Shown on Drawing No	8599/1-60		8599/1-61			8599/1-60		8599/1-59		
Retested by Test	-	-	-	-	-	-	-	-		
FIELD & LABORATORY DATA										
Field Wet Density	t/m ³	2.05	2.05	2.08	2.07	2.09	2.05	2.06	2.08	
Field Moisture Content	%	20.0	20.0	20.0	19.5	20.0	19.5	20.0	20.0	
Material retained on 19mm Sieve (wet)	%	<5	<5	<5	<5	<5	<5	<5	<5	
Lab Compaction result from test number		3590	3591	3592	3593	3594	3595	3596	3597	
Peak Converted Wet Density	t/m ³	2.12	2.14	2.14	2.13	2.14	2.15	2.13	2.14	
Apparent Optimum Moisture Content	%	19.0	20.5	19.5	20.0	20.5	19.5	20.0	20.0	
Number of Compaction Points		3	3	3	3	3	3	3	3	
Test Procedures - See Note Number		12	12	12	12	12	12	12	12	
Material Description - see below		2-3	2-3	2-3	2-3	2-3	2-3	2-3	2-3	
Notes										
1: Assigned Values have been obtained from our Penrith laboratory – Accreditation No 2734					10: AS 1289 1.2.1 clause 6.4 (b), 2.1.1, 5.3.1, 5.5.1, 5.6.1					
2: Assigned Values have been obtained from our Prestons laboratory – Accreditation No 14234					11: AS 1289 1.2.1 clause 6.4 (b), 2.1.1, 5.3.1, 5.7.1					
3: Results have been calculated using infinite decimal places. Therefore, calculated values may vary from those shown					12: AS 1289 1.2.1 clause 6.4 (b), 2.1.1, 5.7.1, 5.8.1					
4: AS 1289 1.2.1 clause 6.4 (b), 2.1.1, 5.1.1, 5.3.1, 5.4.1					13: RMS T111, T119, T120, T166					
5: AS 1289 1.2.1 clause 6.4 (b), 2.1.1, 5.2.1, 5.3.1, 5.4.1					14: RMS T111, T120, T166, T173					
6: AS 1289 1.2.1 clause 6.4 (b),					15: RMS T120, T119, T162					
7: AS 1289 1.2.1 clause 6.4 (b), 2.1.1, 5.2.1, 5.4.1, 5.8.1					16: RMS T120, T162, T173					
8: AS 1289 1.2.1 clause 6.4 (b), 2.1.1., 5.5.1, 5.6.1, 5.8.1					17: RMS T120, T164, T173					
9: Full details of Test Procedure 5.8.1 available on request										
Material Description										
1. CL-Clays of low plasticity, gravelly clays, sandy clays, silty clays			11. DGS40			* Cement Stabilised				
2. CI-Clay of medium plasticity, gravelly clays, sandy clays, silty clays			12. FCR20			# Lime Stabilised				
3. CH-Clays of high plasticity			13. FCR40			\$ Gypsum Stabilised				
4. SC-Clayey sands, sand-clay mixtures			14. RC - Recycled Concrete							
5. SM-Silty sands, sand-silt mixtures			15. Recycled Roadbase							
6. GC-Clayey gravels, gravel-sand-clay mixtures			16. RSB - Recycled Sub-base							
7. SP-Sand, crushed dust, filling sand, washed sand			17. CSS - Crushed Sandstone							
8. DGB20			18. RSS - Ripped Sandstone							
9. DGB40			19. Cowels Brown							
10. DGS20										

Form No R 020c Version 01 06/17 - issued by ER



Accreditation Number 2734
Corporate Site Number 2727

Accredited for compliance with
ISO/IEC 17025 - Testing.

A Kench 24/11/2017

Approved Signatory

Head Office:
34 Borec Road, Penrith NSW 2750
P O Box 880 Penrith NSW 2751
Telephone: (02) 4722 21

Prestons Laboratory:
Unit 4, 18-20 Whyalla Place, Prestons NSW 2170
Telephone: (02) 9607 6111 Facsimile: (02) 9607 6200

FIELD DENSITY RESULTS

DARACON CONTRACTORS PTY LTD
PO BOX 299
WALLSEND NSW 2287

Laboratory: Penrith
Job No: 8599/1
Date: 24/11/2017

PROJECT: SITE FILL TESTING - AREA B
RESIDENTIAL DEVELOPMENT.WOORONG PARK, MARSDEN PARK

Page 45 of 79

TEST NUMBER	3598	3599	3600	3601	3602	3603	3604	3605		
DATE TESTED	24/10/2017		25/10/2017							
RESULTS										
Hiif Density Ratio	Standard	%	98	97	97	97	96.5	95	98	96.5
Moisture Variation from OMC (-Drier/+Wetter)		%	0.0	-0.5	-0.5	-0.5	-0.5	-0.5	-0.5	-0.5
Specification	Density Ratio (Standard)		≥95%			Specification	Moisture Variance from OMC		±2%	
TEST LOCATION										
Easting	295272.168	295298.28	295326.533	295313.983	295287.84	295250.926	295218.821	295201.442		
Northing	6269118.105	6269112.981	6269108.188	6269089.739	6269091.61	6269095.9	6269100.083	6269084.485		
Reduced Level	m	15.893	17.004	17.817	18.139	17.723	16.922	15.891	15.772	
Shown on Drawing No	8599/1-59									
Retested by Test	-	-	-	-	-	-	-	-		
FIELD & LABORATORY DATA										
Field Wet Density	t/m ³	2.08	2.06	2.07	2.08	2.08	2.05	2.06	2.05	
Field Moisture Content	%	20.0	20.0	19.5	19.0	18.5	20.5	19.5	19.5	
Material retained on 19mm Sieve (wet)	%	<5	<5	<5	<5	<5	<5	<5	<5	
Lab Compaction result from test number		3598	3599	3600	3601	3602	3603	3604	3605	
Peak Converted Wet Density	t/m ³	2.12	2.12	2.13	2.14	2.15	2.16	2.10	2.12	
Apparent Optimum Moisture Content	%	20.0	20.5	20.0	20.0	19.5	21.0	20.0	20.5	
Number of Compaction Points		3	3	3	3	3	3	3	3	
Test Procedures - See Note Number		12	12	12	12	12	12	12	12	
Material Description - see below		2-3	2-3	2-3	2-3	2	3	2-3	2-3	
Notes										
1: Assigned Values have been obtained from our Penrith laboratory – Accreditation No 2734					10: AS 1289 1.2.1 clause 6.4 (b), 2.1.1, 5.3.1, 5.5.1, 5.6.1					
2: Assigned Values have been obtained from our Prestons laboratory – Accreditation No 14234					11: AS 1289 1.2.1 clause 6.4 (b), 2.1.1, 5.3.1, 5.7.1					
3: Results have been calculated using infinite decimal places. Therefore, calculated values may vary from those shown					12: AS 1289 1.2.1 clause 6.4 (b), 2.1.1, 5.7.1, 5.8.1					
4: AS 1289 1.2.1 clause 6.4 (b), 2.1.1, 5.1.1, 5.3.1, 5.4.1					13: RMS T111, T119, T120, T166					
5: AS 1289 1.2.1 clause 6.4 (b), 2.1.1, 5.2.1, 5.3.1, 5.4.1					14: RMS T111, T120, T166, T173					
6: AS 1289 1.2.1 clause 6.4 (b),					15: RMS T120, T119, T162					
7: AS 1289 1.2.1 clause 6.4 (b), 2.1.1, 5.2.1, 5.4.1, 5.8.1					16: RMS T120, T162, T173					
8: AS 1289 1.2.1 clause 6.4 (b), 2.1.1., 5.5.1, 5.6.1, 5.8.1					17: RMS T120, T164, T173					
9: Full details of Test Procedure 5.8.1 available on request										
Material Description										
1. CL-Clays of low plasticity, gravelly clays, sandy clays, silty clays			11. DGS40			* Cement Stabilised				
2. CI-Clay of medium plasticity, gravelly clays, sandy clays, silty clays			12. FCR20			# Lime Stabilised				
3. CH-Clays of high plasticity			13. FCR40			\$ Gypsum Stabilised				
4. SC-Clayey sands, sand-clay mixtures			14. RC - Recycled Concrete							
5. SM-Silty sands, sand-silt mixtures			15. Recycled Roadbase							
6. GC-Clayey gravels, gravel-sand-clay mixtures			16. RSB - Recycled Sub-base							
7. SP-Sand, crushed dust, filling sand, washed sand			17. CSS - Crushed Sandstone							
8. DGB20			18. RSS - Ripped Sandstone							
9. DGB40			19. Cowels Brown							
10. DGS20										

Form No R 020c Version 01 06/17 - issued by ER



Accreditation Number 2734
Corporate Site Number 2727

Accredited for compliance with
ISO/IEC 17025 - Testing.

A Kench 24/11/2017

Approved Signatory

Head Office:
34 Borec Road, Penrith NSW 2750
P O Box 880 Penrith NSW 2751
Telephone: (02) 4722 21

Prestons Laboratory:
Unit 4, 18-20 Whyalla Place, Prestons NSW 2170
Telephone: (02) 9607 6111 Facsimile: (02) 9607 6200

FIELD DENSITY RESULTS

DARACON CONTRACTORS PTY LTD
PO BOX 299
WALLSEND NSW 2287

Laboratory: Penrith
Job No: 8599/1
Date: 24/11/2017

PROJECT: SITE FILL TESTING - AREA B
RESIDENTIAL DEVELOPMENT.WOORONG PARK, MARSDEN PARK

Page 46 of 79

TEST NUMBER	3606	3607	3608	3609	3610	3611	3612	3613		
DATE TESTED	25/10/2017									
RESULTS										
Hiif Density Ratio	Standard	%	97	96.5	98	96.5	95.5	97.5	97	97
Moisture Variation from OMC (-Drier/+Wetter)		%	-0.5	-0.5	0.0	-0.5	-0.5	-0.5	-0.5	-0.5
Specification	Density Ratio (Standard)	≥95%	Specification				Moisture Variance from OMC			±2%
TEST LOCATION										
Easting	295224.035	295238.442	295278.123	295282.981	295277.531	295251.586	295246.438	295246.414		
Northing	6269077.572	6269074.431	6269066.397	6269043.225	6269026.082	6269026.511	6269042.847	6269076.94		
Reduced Level	m									
Shown on Drawing No	16.538	17.023	17.644	18.028	18.407	18.318	17.685	16.935		
Retested by Test	8599/1-59									
	-	-	-	-	-	-	-	-		
FIELD & LABORATORY DATA										
Field Wet Density	t/m ³	2.07	2.07	2.07	2.07	2.06	2.06	2.06	2.07	
Field Moisture Content	%	20.0	20.0	20.0	19.5	20.0	20.5	19.5	20.0	
Material retained on 19mm Sieve (wet)	%	<5	<5	<5	<5	<5	<5	<5	<5	
Lab Compaction result from test number		3606	3607	3608	3609	3610	3611	3612	3613	
Peak Converted Wet Density	t/m ³	2.13	2.14	2.11	2.15	2.16	2.11	2.12	2.13	
Apparent Optimum Moisture Content	%	20.5	21.0	20.0	20.0	20.5	21.0	20.5	20.5	
Number of Compaction Points		3	3	3	3	3	3	3	3	
Test Procedures - See Note Number		12	12	12	12	12	12	12	12	
Material Description - see below		2-3	3	2-3	2-3	2-3	3	2-3	2-3	
Notes										
1: Assigned Values have been obtained from our Penrith laboratory – Accreditation No 2734					10: AS 1289 1.2.1 clause 6.4 (b), 2.1.1, 5.3.1, 5.5.1, 5.6.1					
2: Assigned Values have been obtained from our Prestons laboratory – Accreditation No 14234					11: AS 1289 1.2.1 clause 6.4 (b), 2.1.1, 5.3.1, 5.7.1					
3: Results have been calculated using infinite decimal places. Therefore, calculated values may vary from those shown					12: AS 1289 1.2.1 clause 6.4 (b), 2.1.1, 5.7.1, 5.8.1					
4: AS 1289 1.2.1 clause 6.4 (b), 2.1.1, 5.1.1, 5.3.1, 5.4.1					13: RMS T111, T119, T120, T166					
5: AS 1289 1.2.1 clause 6.4 (b), 2.1.1, 5.2.1, 5.3.1, 5.4.1					14: RMS T111, T120, T166, T173					
6: AS 1289 1.2.1 clause 6.4 (b),					15: RMS T120, T119, T162					
7: AS 1289 1.2.1 clause 6.4 (b), 2.1.1, 5.2.1, 5.4.1, 5.8.1					16: RMS T120, T162, T173					
8: AS 1289 1.2.1 clause 6.4 (b), 2.1.1., 5.5.1, 5.6.1, 5.8.1					17: RMS T120, T164, T173					
9: Full details of Test Procedure 5.8.1 available on request										
Material Description										
1. CL-Clays of low plasticity, gravelly clays, sandy clays, silty clays			11. DGS40			* Cement Stabilised				
2. CI-Clay of medium plasticity, gravelly clays, sandy clays, silty clays			12. FCR20			# Lime Stabilised				
3. CH-Clays of high plasticity			13. FCR40			\$ Gypsum Stabilised				
4. SC-Clayey sands, sand-clay mixtures			14. RC - Recycled Concrete							
5. SM-Silty sands, sand-silt mixtures			15. Recycled Roadbase							
6. GC-Clayey gravels, gravel-sand-clay mixtures			16. RSB - Recycled Sub-base							
7. SP-Sand, crushed dust, filling sand, washed sand			17. CSS - Crushed Sandstone							
8. DGB20			18. RSS - Ripped Sandstone							
9. DGB40			19. Cowels Brown							
10. DGS20										

Form No R 020c Version 01 06/17 - issued by ER



Accreditation Number 2734
Corporate Site Number 2727

Accredited for compliance with
ISO/IEC 17025 - Testing.

A Kench 24/11/2017

Approved Signatory

Head Office:
34 Borec Road, Penrith NSW 2750
P O Box 880 Penrith NSW 2751
Telephone: (02) 4722 21

Prestons Laboratory:
Unit 4, 18-20 Whyalla Place, Prestons NSW 2170
Telephone: (02) 9607 6111 Facsimile: (02) 9607 6200

FIELD DENSITY RESULTS

DARACON CONTRACTORS PTY LTD
PO BOX 299
WALLSEND NSW 2287

Laboratory: Penrith
Job No: 8599/1
Date: 24/11/2017

PROJECT: SITE FILL TESTING - AREA B
RESIDENTIAL DEVELOPMENT.WOORONG PARK, MARSDEN PARK

Page 47 of 79

TEST NUMBER	3614	3615	3616	3617	3618	3619	3620	3621		
DATE TESTED	25/10/2017									
RESULTS										
Hiif Density Ratio	Standard	%	97.5	97	97	98.5	96.5	97	97	96.5
Moisture Variation from OMC (-Drier/+Wetter)		%	0.5	0.0	0.0	0.5	-0.5	-0.5	-0.5	-0.5
Specification	Density Ratio (Standard)	≥95%	Specification				Moisture Variance from OMC			±2%
TEST LOCATION										
Easting	295293.506	295298.993	295266.008	295218.574	295193.811	295179.254	295178.804	295213.983		
Northing	6269071.118	6269050.888	6269054.547	6269061.859	6269068.362	6269077.534	6269049.222	6269040.302		
Reduced Level	m		17.581	17.823	17.134	17.23	16.906	15.868	17.769	17.708
Shown on Drawing No	8599/1-59									
Retested by Test	-	-	-	-	-	-	-	-		
FIELD & LABORATORY DATA										
Field Wet Density	t/m ³	2.07	2.07	2.07	2.08	2.07	2.05	2.06	2.08	
Field Moisture Content	%	20.0	20.0	18.5	19.5	19.5	19.0	18.5	18.5	
Material retained on 19mm Sieve (wet)	%	<5	<5	<5	<5	<5	<5	<5	<5	
Lab Compaction result from test number		3614	3615	3616	3617	3618	3619	3620	3621	
Peak Converted Wet Density	t/m ³	2.12	2.13	2.13	2.11	2.14	2.11	2.12	2.16	
Apparent Optimum Moisture Content	%	19.5	20.0	18.5	19.0	20.0	19.5	19.5	19.5	
Number of Compaction Points		3	3	3	3	3	3	3	3	
Test Procedures - See Note Number		12	12	12	12	12	12	12	12	
Material Description - see below		2-3	2-3	2	3	2-3	2-3	2-3	2-3	
Notes										
1: Assigned Values have been obtained from our Penrith laboratory – Accreditation No 2734					10: AS 1289 1.2.1 clause 6.4 (b), 2.1.1, 5.3.1, 5.5.1, 5.6.1					
2: Assigned Values have been obtained from our Prestons laboratory – Accreditation No 14234					11: AS 1289 1.2.1 clause 6.4 (b), 2.1.1, 5.3.1, 5.7.1					
3: Results have been calculated using infinite decimal places. Therefore, calculated values may vary from those shown					12: AS 1289 1.2.1 clause 6.4 (b), 2.1.1, 5.7.1, 5.8.1					
4: AS 1289 1.2.1 clause 6.4 (b), 2.1.1, 5.1.1, 5.3.1, 5.4.1					13: RMS T111, T119, T120, T166					
5: AS 1289 1.2.1 clause 6.4 (b), 2.1.1, 5.2.1, 5.3.1, 5.4.1					14: RMS T111, T120, T166, T173					
6: AS 1289 1.2.1 clause 6.4 (b),					15: RMS T120, T119, T162					
7: AS 1289 1.2.1 clause 6.4 (b), 2.1.1, 5.2.1, 5.4.1, 5.8.1					16: RMS T120, T162, T173					
8: AS 1289 1.2.1 clause 6.4 (b), 2.1.1., 5.5.1, 5.6.1, 5.8.1					17: RMS T120, T164, T173					
9: Full details of Test Procedure 5.8.1 available on request										
Material Description										
1. CL-Clays of low plasticity, gravelly clays, sandy clays, silty clays			11. DGS40			* Cement Stabilised				
2. CI-Clay of medium plasticity, gravelly clays, sandy clays, silty clays			12. FCR20			# Lime Stabilised				
3. CH-Clays of high plasticity			13. FCR40			\$ Gypsum Stabilised				
4. SC-Clayey sands, sand-clay mixtures			14. RC - Recycled Concrete							
5. SM-Silty sands, sand-silt mixtures			15. Recycled Roadbase							
6. GC-Clayey gravels, gravel-sand-clay mixtures			16. RSB - Recycled Sub-base							
7. SP-Sand, crushed dust, filling sand, washed sand			17. CSS - Crushed Sandstone							
8. DGB20			18. RSS - Ripped Sandstone							
9. DGB40			19. Cowels Brown							
10. DGS20										

Form No R 020c Version 01 06/17 - issued by ER



Accreditation Number 2734
Corporate Site Number 2727

Accredited for compliance with
ISO/IEC 17025 - Testing.

A Kench 24/11/2017

Approved Signatory

Head Office:
34 Borec Road, Penrith NSW 2750
P O Box 880 Penrith NSW 2751
Telephone: (02) 4722 21

Prestons Laboratory:
Unit 4, 18-20 Whyalla Place, Prestons NSW 2170
Telephone: (02) 9607 6111 Facsimile: (02) 9607 6200

FIELD DENSITY RESULTS

DARACON CONTRACTORS PTY LTD
PO BOX 299
WALLSEND NSW 2287

Laboratory: Penrith
Job No: 8599/1
Date: 24/11/2017

PROJECT: SITE FILL TESTING - AREA B
RESIDENTIAL DEVELOPMENT.WOORONG PARK, MARSDEN PARK

Page 48 of 79

TEST NUMBER	3622	3623	3624	3625	3626	3627	3628	3629		
DATE TESTED	25/10/2017				26/10/2017					
RESULTS										
Hiif Density Ratio	Standard	%	97	96	96.5	98	98	97	97.5	98
Moisture Variation from OMC (-Drier/+Wetter)		%	0.5	0.0	0.0	0.5	0.0	0.0	0.0	0.0
Specification	Density Ratio (Standard)	≥95%	Specification				Moisture Variance from OMC			±2%
TEST LOCATION										
Easting	295241.622	295286.445	294924.797	294890.804	294855.713	294824.545	294820.445	294851.807		
Northing	6269034.295	6269024.972	6268655.073	6268653.362	6268651.001	6268647.86	6268670.116	6268675.21		
Reduced Level	m	17.784	18.219	21.167	20.496	19.748	18.455	18.591	19.777	
Shown on Drawing No	8599/1-59				8599/1-61					
Retested by Test	-	-	-	-	-	-	-	-		
FIELD & LABORATORY DATA										
Field Wet Density	t/m ³	2.07	2.05	2.05	2.06	2.08	2.06	2.06	2.09	
Field Moisture Content	%	20.0	19.5	20.0	19.5	18.5	19.0	19.5	19.0	
Material retained on 19mm Sieve (wet)	%	<5	<5	<5	<5	<5	<5	<5	<5	
Lab Compaction result from test number		3622	3623	3624	3625	3626	3627	3628	3629	
Peak Converted Wet Density	t/m ³	2.13	2.14	2.12	2.10	2.12	2.12	2.11	2.13	
Apparent Optimum Moisture Content	%	20.0	19.5	20.0	19.0	18.5	19.0	19.0	19.0	
Number of Compaction Points		3	3	3	3	3	3	3	3	
Test Procedures - See Note Number		12	12	12	12	12	12	12	12	
Material Description - see below		2-3	2-3	2-3	2-3	2	2-3	2-3	2-3	
Notes										
1: Assigned Values have been obtained from our Penrith laboratory – Accreditation No 2734					10: AS 1289 1.2.1 clause 6.4 (b), 2.1.1, 5.3.1, 5.5.1, 5.6.1					
2: Assigned Values have been obtained from our Prestons laboratory – Accreditation No 14234					11: AS 1289 1.2.1 clause 6.4 (b), 2.1.1, 5.3.1, 5.7.1					
3: Results have been calculated using infinite decimal places. Therefore, calculated values may vary from those shown					12: AS 1289 1.2.1 clause 6.4 (b), 2.1.1, 5.7.1, 5.8.1					
4: AS 1289 1.2.1 clause 6.4 (b), 2.1.1, 5.1.1, 5.3.1, 5.4.1					13: RMS T111, T119, T120, T166					
5: AS 1289 1.2.1 clause 6.4 (b), 2.1.1, 5.2.1, 5.3.1, 5.4.1					14: RMS T111, T120, T166, T173					
6: AS 1289 1.2.1 clause 6.4 (b),					15: RMS T120, T119, T162					
7: AS 1289 1.2.1 clause 6.4 (b), 2.1.1, 5.2.1, 5.4.1, 5.8.1					16: RMS T120, T162, T173					
8: AS 1289 1.2.1 clause 6.4 (b), 2.1.1., 5.5.1, 5.6.1, 5.8.1					17: RMS T120, T164, T173					
9: Full details of Test Procedure 5.8.1 available on request										
Material Description										
1. CL-Clays of low plasticity, gravelly clays, sandy clays, silty clays			11. DGS40			* Cement Stabilised				
2. CI-Clay of medium plasticity, gravelly clays, sandy clays, silty clays			12. FCR20			# Lime Stabilised				
3. CH-Clays of high plasticity			13. FCR40			\$ Gypsum Stabilised				
4. SC-Clayey sands, sand-clay mixtures			14. RC - Recycled Concrete							
5. SM-Silty sands, sand-silt mixtures			15. Recycled Roadbase							
6. GC-Clayey gravels, gravel-sand-clay mixtures			16. RSB - Recycled Sub-base							
7. SP-Sand, crushed dust, filling sand, washed sand			17. CSS - Crushed Sandstone							
8. DGB20			18. RSS - Ripped Sandstone							
9. DGB40			19. Cowels Brown							
10. DGS20										

Form No R 020c Version 01 06/17 - issued by ER



Accreditation Number 2734
Corporate Site Number 2727

Accredited for compliance with
ISO/IEC 17025 - Testing.

A Kench 24/11/2017

Approved Signatory

Head Office:
34 Borec Road, Penrith NSW 2750
P O Box 880 Penrith NSW 2751
Telephone: (02) 4722 21

Prestons Laboratory:
Unit 4, 18-20 Whyalla Place, Prestons NSW 2170
Telephone: (02) 9607 6111 Facsimile: (02) 9607 6200

FIELD DENSITY RESULTS

DARACON CONTRACTORS PTY LTD
PO BOX 299
WALLSEND NSW 2287

Laboratory: Penrith
Job No: 8599/1
Date: 24/11/2017

PROJECT: SITE FILL TESTING - AREA B
RESIDENTIAL DEVELOPMENT.WOORONG PARK, MARSDEN PARK

Page 49 of 79

TEST NUMBER	3630	3631	3632	3633	3634	3635	3636	3637		
DATE TESTED	26/10/2017									
RESULTS										
Hilf Density Ratio	Standard	%	96.5	97.5	98	96	97.5	97	97	97.5
Moisture Variation from OMC (-Drier/+Wetter)		%	0.5	0.5	0.0	0.0	0.0	0.0	0.0	0.0
Specification	Density Ratio (Standard)	≥95%	Specification				Moisture Variance from OMC			±2%
TEST LOCATION										
Easting	294883.734	294914.153	294919.218	294886.168	294857.672	294835.064	294839.445	294867.302		
Northing	6268677.548	6268679.607	6268707.146	6268714.061	6268714.414	6268716.682	6268740.695	6268743.585		
Reduced Level	m	20.489	20.923	20.935	20.208	19.388	18.534	18.117	19.399	
Shown on Drawing No	8599/1-61									
Retested by Test	-	-	-	-	-	-	-	-		
FIELD & LABORATORY DATA										
Field Wet Density	t/m ³	2.05	2.06	2.08	2.05	2.07	2.07	2.05	2.08	
Field Moisture Content	%	18.5	20.0	19.0	19.0	15.5	16.0	16.0	15.5	
Material retained on 19mm Sieve (wet)	%	<5	<5	<5	<5	<5	<5	<5	<5	
Lab Compaction result from test number		3630	3631	3632	3633	3634	3635	3636	3637	
Peak Converted Wet Density	t/m ³	2.12	2.11	2.12	2.14	2.12	2.13	2.11	2.13	
Apparent Optimum Moisture Content	%	18.0	19.5	19.0	19.0	15.5	15.5	15.5	15.5	
Number of Compaction Points		3	3	3	3	3	3	3	3	
Test Procedures - See Note Number		12	12	12	12	12	12	12	12	
Material Description - see below		2	2-3	2-3	2-3	2	2	2	2	
Notes										
1: Assigned Values have been obtained from our Penrith laboratory – Accreditation No 2734					10: AS 1289 1.2.1 clause 6.4 (b), 2.1.1, 5.3.1, 5.5.1, 5.6.1					
2: Assigned Values have been obtained from our Prestons laboratory – Accreditation No 14234					11: AS 1289 1.2.1 clause 6.4 (b), 2.1.1, 5.3.1, 5.7.1					
3: Results have been calculated using infinite decimal places. Therefore, calculated values may vary from those shown					12: AS 1289 1.2.1 clause 6.4 (b), 2.1.1, 5.7.1, 5.8.1					
4: AS 1289 1.2.1 clause 6.4 (b), 2.1.1, 5.1.1, 5.3.1, 5.4.1					13: RMS T111, T119, T120, T166					
5: AS 1289 1.2.1 clause 6.4 (b), 2.1.1, 5.2.1, 5.3.1, 5.4.1					14: RMS T111, T120, T166, T173					
6: AS 1289 1.2.1 clause 6.4 (b),					15: RMS T120, T119, T162					
7: AS 1289 1.2.1 clause 6.4 (b), 2.1.1, 5.2.1, 5.4.1, 5.8.1					16: RMS T120, T162, T173					
8: AS 1289 1.2.1 clause 6.4 (b), 2.1.1., 5.5.1, 5.6.1, 5.8.1					17: RMS T120, T164, T173					
9: Full details of Test Procedure 5.8.1 available on request										
Material Description										
1. CL-Clays of low plasticity, gravelly clays, sandy clays, silty clays			11. DGS40			* Cement Stabilised				
2. CI-Clay of medium plasticity, gravelly clays, sandy clays, silty clays			12. FCR20			# Lime Stabilised				
3. CH-Clays of high plasticity			13. FCR40			\$ Gypsum Stabilised				
4. SC-Clayey sands, sand-clay mixtures			14. RC - Recycled Concrete							
5. SM-Silty sands, sand-silt mixtures			15. Recycled Roadbase							
6. GC-Clayey gravels, gravel-sand-clay mixtures			16. RSB - Recycled Sub-base							
7. SP-Sand, crushed dust, filling sand, washed sand			17. CSS - Crushed Sandstone							
8. DGB20			18. RSS - Ripped Sandstone							
9. DGB40			19. Cowels Brown							
10. DGS20										

Form No R 020c Version 01 06/17 - issued by ER



Accreditation Number 2734
Corporate Site Number 2727

Accredited for compliance with
ISO/IEC 17025 - Testing.

A Kench 24/11/2017

Approved Signatory

Head Office:
34 Borec Road, Penrith NSW 2750
P O Box 880 Penrith NSW 2751
Telephone: (02) 4722 21

Prestons Laboratory:
Unit 4, 18-20 Whyalla Place, Prestons NSW 2170
Telephone: (02) 9607 6111 Facsimile: (02) 9607 6200

FIELD DENSITY RESULTS

DARACON CONTRACTORS PTY LTD
PO BOX 299
WALLSEND NSW 2287

Laboratory: Penrith
Job No: 8599/1
Date: 24/11/2017

PROJECT: SITE FILL TESTING - AREA B
RESIDENTIAL DEVELOPMENT.WOORONG PARK, MARSDEN PARK

Page 50 of 79

TEST NUMBER	3638	3639	3640	3641	3642	3643	3644	3645		
DATE TESTED	26/10/2017						30/10/2017			
RESULTS										
Hiif Density Ratio	Standard	%	98	96.5	98	96.5	97.5	97.5	97	97
Moisture Variation from OMC (-Drier/+Wetter)		%	0.5	0.0	0.0	0.0	0.5	0.0	0.0	-0.5
Specification	Density Ratio (Standard)	≥95%	Specification				Moisture Variance from OMC			±2%
TEST LOCATION										
Easting	294910.043	294906.564	294871.656	294848.775	295555.375	295499.739	295499.182	295534.159		
Northing	6268739.838	6268763.239	6268767.776	6268773.934	6269498.782	6269517.758	6269488.756	6269460.202		
Reduced Level	m		20.228	19.668	18.734	17.601	18.507	17.563	17.848	18.549
Shown on Drawing No	8599/1-61				8599/1-58					
Retested by Test	-	-	-	-	-	-	-	-		
FIELD & LABORATORY DATA										
Field Wet Density	t/m ³	2.07	2.06	2.08	2.06	2.08	2.06	2.08	2.08	
Field Moisture Content	%	16.5	16.0	17.0	16.0	19.0	20.0	15.0	15.5	
Material retained on 19mm Sieve (wet)	%	<5	<5	<5	<5	<5	<5	<5	<5	
Lab Compaction result from test number		3638	3639	3640	3641	3642	3643	3644	3645	
Peak Converted Wet Density	t/m ³	2.11	2.13	2.12	2.13	2.13	2.11	2.14	2.14	
Apparent Optimum Moisture Content	%	16.0	16.0	17.0	16.0	19.0	20.0	15.0	16.0	
Number of Compaction Points		3	3	3	3	3	3	3	3	
Test Procedures - See Note Number		12	12	12	12	12	12	12	12	
Material Description - see below		2	2	2	2	2-3	2-3	2	2	
Notes										
1: Assigned Values have been obtained from our Penrith laboratory – Accreditation No 2734					10: AS 1289 1.2.1 clause 6.4 (b), 2.1.1, 5.3.1, 5.5.1, 5.6.1					
2: Assigned Values have been obtained from our Prestons laboratory – Accreditation No 14234					11: AS 1289 1.2.1 clause 6.4 (b), 2.1.1, 5.3.1, 5.7.1					
3: Results have been calculated using infinite decimal places. Therefore, calculated values may vary from those shown					12: AS 1289 1.2.1 clause 6.4 (b), 2.1.1, 5.7.1, 5.8.1					
4: AS 1289 1.2.1 clause 6.4 (b), 2.1.1, 5.1.1, 5.3.1, 5.4.1					13: RMS T111, T119, T120, T166					
5: AS 1289 1.2.1 clause 6.4 (b), 2.1.1, 5.2.1, 5.3.1, 5.4.1					14: RMS T111, T120, T166, T173					
6: AS 1289 1.2.1 clause 6.4 (b)					15: RMS T120, T119, T162					
7: AS 1289 1.2.1 clause 6.4 (b), 2.1.1, 5.2.1, 5.4.1, 5.8.1					16: RMS T120, T162, T173					
8: AS 1289 1.2.1 clause 6.4 (b), 2.1.1., 5.5.1, 5.6.1, 5.8.1					17: RMS T120, T164, T173					
9: Full details of Test Procedure 5.8.1 available on request										
Material Description										
1. CL-Clays of low plasticity, gravelly clays, sandy clays, silty clays			11. DGS40			* Cement Stabilised				
2. CI-Clay of medium plasticity, gravelly clays, sandy clays, silty clays			12. FCR20			# Lime Stabilised				
3. CH-Clays of high plasticity			13. FCR40			\$ Gypsum Stabilised				
4. SC-Clayey sands, sand-clay mixtures			14. RC - Recycled Concrete							
5. SM-Silty sands, sand-silt mixtures			15. Recycled Roadbase							
6. GC-Clayey gravels, gravel-sand-clay mixtures			16. RSB - Recycled Sub-base							
7. SP-Sand, crushed dust, filling sand, washed sand			17. CSS - Crushed Sandstone							
8. DGB20			18. RSS - Ripped Sandstone							
9. DGB40			19. Cowels Brown							
10. DGS20										

Form No R 020c Version 01 06/17 - issued by ER



Accreditation Number 2734
Corporate Site Number 2727

Accredited for compliance with
ISO/IEC 17025 - Testing.

A Kench 24/11/2017

Approved Signatory

Head Office:
34 Borec Road, Penrith NSW 2750
P O Box 880 Penrith NSW 2751
Telephone: (02) 4722 21

Prestons Laboratory:
Unit 4, 18-20 Whyalla Place, Prestons NSW 2170
Telephone: (02) 9607 6111 Facsimile: (02) 9607 6200

FIELD DENSITY RESULTS

DARACON CONTRACTORS PTY LTD
PO BOX 299
WALLSEND NSW 2287

Laboratory: Penrith
Job No: 8599/1
Date: 24/11/2017

PROJECT: SITE FILL TESTING - AREA B
RESIDENTIAL DEVELOPMENT.WOORONG PARK, MARSDEN PARK

Page 51 of 79

TEST NUMBER	3646	3647	3648	3649	3650	3651	3652	3653		
DATE TESTED	30/10/2017									
RESULTS										
Hilf Density Ratio	Standard	%	98	96.5	96.5	96.5	95.5	97.5	99	95.5
Moisture Variation from OMC (-Drier/+Wetter)		%	0.0	0.0	0.0	0.0	-0.5	0.0	-0.5	-0.5
Specification	Density Ratio (Standard)		≥95%			Specification	Moisture Variance from OMC		±2%	
TEST LOCATION										
Easting	295505.855	295453.52	295455.817	295507.028	294839.756	294831.997	294821.064	294847.057		
Northing	6269459.152	6269492.004	6269467.06	6269433.103	6268765.409	6268720.563	6268674.149	6268686.67		
Reduced Level	m	18.155	16.809	16.493	17.978	18.517	19.444	18.996	19.817	
Shown on Drawing No	8599/1-58				8599/1-61					
Retested by Test	-	-	-	-	-	-	-	-		
FIELD & LABORATORY DATA										
Field Wet Density	t/m ³	2.09	2.07	2.06	2.05	2.04	2.09	2.11	2.04	
Field Moisture Content	%	15.0	14.5	13.0	14.0	14.0	14.0	13.0	14.0	
Material retained on 19mm Sieve (wet)	%	<5	<5	<5	<5	<5	<5	<5	<5	
Lab Compaction result from test number		3646	3647	3648	3649	3650	3651	3652	3653	
Peak Converted Wet Density	t/m ³	2.13	2.14	2.14	2.12	2.14	2.14	2.13	2.14	
Apparent Optimum Moisture Content	%	15.5	14.5	13.0	14.0	14.5	14.0	13.5	14.5	
Number of Compaction Points		3	3	3	3	3	3	3	3	
Test Procedures - See Note Number		12	12	12	12	12	12	12	12	
Material Description - see below		2	2	1-2	2	2	2	1-2	2	
Notes										
1: Assigned Values have been obtained from our Penrith laboratory – Accreditation No 2734					10: AS 1289 1.2.1 clause 6.4 (b), 2.1.1, 5.3.1, 5.5.1, 5.6.1					
2: Assigned Values have been obtained from our Prestons laboratory – Accreditation No 14234					11: AS 1289 1.2.1 clause 6.4 (b), 2.1.1, 5.3.1, 5.7.1					
3: Results have been calculated using infinite decimal places. Therefore, calculated values may vary from those shown					12: AS 1289 1.2.1 clause 6.4 (b), 2.1.1, 5.7.1, 5.8.1					
4: AS 1289 1.2.1 clause 6.4 (b), 2.1.1, 5.1.1, 5.3.1, 5.4.1					13: RMS T111, T119, T120, T166					
5: AS 1289 1.2.1 clause 6.4 (b), 2.1.1, 5.2.1, 5.3.1, 5.4.1					14: RMS T111, T120, T166, T173					
6: AS 1289 1.2.1 clause 6.4 (b)					15: RMS T120, T119, T162					
7: AS 1289 1.2.1 clause 6.4 (b), 2.1.1, 5.2.1, 5.4.1, 5.8.1					16: RMS T120, T162, T173					
8: AS 1289 1.2.1 clause 6.4 (b), 2.1.1., 5.5.1, 5.6.1, 5.8.1					17: RMS T120, T164, T173					
9: Full details of Test Procedure 5.8.1 available on request										
Material Description										
1. CL-Clays of low plasticity, gravelly clays, sandy clays, silty clays			11. DGS40			* Cement Stabilised				
2. CI-Clay of medium plasticity, gravelly clays, sandy clays, silty clays			12. FCR20			# Lime Stabilised				
3. CH-Clays of high plasticity			13. FCR40			\$ Gypsum Stabilised				
4. SC-Clayey sands, sand-clay mixtures			14. RC - Recycled Concrete							
5. SM-Silty sands, sand-silt mixtures			15. Recycled Roadbase							
6. GC-Clayey gravels, gravel-sand-clay mixtures			16. RSB - Recycled Sub-base							
7. SP-Sand, crushed dust, filling sand, washed sand			17. CSS - Crushed Sandstone							
8. DGB20			18. RSS - Ripped Sandstone							
9. DGB40			19. Cowels Brown							
10. DGS20										

Form No R 020c Version 01 06/17 - issued by ER



Accreditation Number 2734
Corporate Site Number 2727

Accredited for compliance with
ISO/IEC 17025 - Testing.

A Kench 24/11/2017

Approved Signatory

Head Office:
34 Borec Road, Penrith NSW 2750
P O Box 880 Penrith NSW 2751
Telephone: (02) 4722 21

Prestons Laboratory:
Unit 4, 18-20 Whyalla Place, Prestons NSW 2170
Telephone: (02) 9607 6111 Facsimile: (02) 9607 6200

FIELD DENSITY RESULTS

DARACON CONTRACTORS PTY LTD
PO BOX 299
WALLSEND NSW 2287

Laboratory: Penrith
Job No: 8599/1
Date: 24/11/2017

PROJECT: SITE FILL TESTING - AREA B
RESIDENTIAL DEVELOPMENT.WOORONG PARK, MARSDEN PARK

Page 52 of 79

TEST NUMBER	3654	3655	3656	3657	3658	3659	3660	3661		
DATE TESTED	30/10/2017									
RESULTS										
Hilf Density Ratio	Standard	%	97.5	96.5	97	98	97	97.5	99.5	96.5
Moisture Variation from OMC (-Drier/+Wetter)		%	0.0	0.0	0.0	0.0	0.0	0.0	0.0	-0.5
Specification	Density Ratio (Standard)	≥95%	Specification				Moisture Variance from OMC			±2%
TEST LOCATION										
Easting	294863.755	294880.603	294876.101	294865.998	294839.316	294858.757	294885.074	294903.869		
Northing	6268740.544	6268750.007	6268712.821	6268673.27	6268608.89	6268618.017	6268622.17	6268625		
Reduced Level	m	19.832	19.992	20.008	20.249	17.877	18.855	19.683	20.283	
Shown on Drawing No	8599/1-61									
Retested by Test	-	-	-	-	-	-	-	-		
FIELD & LABORATORY DATA										
Field Wet Density	t/m ³	2.09	2.07	2.07	2.08	2.08	2.05	2.11	2.07	
Field Moisture Content	%	14.0	14.5	15.5	15.0	15.5	14.5	15.0	14.5	
Material retained on 19mm Sieve (wet)	%	<5	<5	<5	<5	<5	<5	<5	<5	
Lab Compaction result from test number		3654	3655	3656	3657	3658	3659	3660	3661	
Peak Converted Wet Density	t/m ³	2.14	2.15	2.13	2.12	2.14	2.10	2.12	2.14	
Apparent Optimum Moisture Content	%	14.5	14.5	15.5	15.0	15.5	14.5	15.0	15.0	
Number of Compaction Points		3	3	3	3	3	3	3	3	
Test Procedures - See Note Number		12	12	12	12	12	12	12	12	
Material Description - see below		2	2	2	2	2	2	2	2	
Notes										
1: Assigned Values have been obtained from our Penrith laboratory – Accreditation No 2734					10: AS 1289 1.2.1 clause 6.4 (b), 2.1.1, 5.3.1, 5.5.1, 5.6.1					
2: Assigned Values have been obtained from our Prestons laboratory – Accreditation No 14234					11: AS 1289 1.2.1 clause 6.4 (b), 2.1.1, 5.3.1, 5.7.1					
3: Results have been calculated using infinite decimal places. Therefore, calculated values may vary from those shown					12: AS 1289 1.2.1 clause 6.4 (b), 2.1.1, 5.7.1, 5.8.1					
4: AS 1289 1.2.1 clause 6.4 (b), 2.1.1, 5.1.1, 5.3.1, 5.4.1					13: RMS T111, T119, T120, T166					
5: AS 1289 1.2.1 clause 6.4 (b), 2.1.1, 5.2.1, 5.3.1, 5.4.1					14: RMS T111, T120, T166, T173					
6: AS 1289 1.2.1 clause 6.4 (b),					15: RMS T120, T119, T162					
7: AS 1289 1.2.1 clause 6.4 (b), 2.1.1, 5.2.1, 5.4.1, 5.8.1					16: RMS T120, T162, T173					
8: AS 1289 1.2.1 clause 6.4 (b), 2.1.1., 5.5.1, 5.6.1, 5.8.1					17: RMS T120, T164, T173					
9: Full details of Test Procedure 5.8.1 available on request										
Material Description										
1. CL-Clays of low plasticity, gravelly clays, sandy clays, silty clays			11. DGS40			* Cement Stabilised				
2. CI-Clay of medium plasticity, gravelly clays, sandy clays, silty clays			12. FCR20			# Lime Stabilised				
3. CH-Clays of high plasticity			13. FCR40			\$ Gypsum Stabilised				
4. SC-Clayey sands, sand-clay mixtures			14. RC - Recycled Concrete							
5. SM-Silty sands, sand-silt mixtures			15. Recycled Roadbase							
6. GC-Clayey gravels, gravel-sand-clay mixtures			16. RSB - Recycled Sub-base							
7. SP-Sand, crushed dust, filling sand, washed sand			17. CSS - Crushed Sandstone							
8. DGB20			18. RSS - Ripped Sandstone							
9. DGB40			19. Cowels Brown							
10. DGS20										

Form No R 020c Version 01 06/17 - issued by ER



Accreditation Number 2734
Corporate Site Number 2727

Accredited for compliance with
ISO/IEC 17025 - Testing.

A Kench 24/11/2017

Approved Signatory

Head Office:
34 Borec Road, Penrith NSW 2750
P O Box 880 Penrith NSW 2751
Telephone: (02) 4722 21

Prestons Laboratory:
Unit 4, 18-20 Whyalla Place, Prestons NSW 2170
Telephone: (02) 9607 6111 Facsimile: (02) 9607 6200

FIELD DENSITY RESULTS

DARACON CONTRACTORS PTY LTD
PO BOX 299
WALLSEND NSW 2287

Laboratory: Penrith
Job No: 8599/1
Date: 24/11/2017

PROJECT: SITE FILL TESTING - AREA B
RESIDENTIAL DEVELOPMENT.WOORONG PARK, MARSDEN PARK

Page 53 of 79

TEST NUMBER	3662	3663	3664	3665	3666	3667	3668	3669		
DATE TESTED	30/10/2017									
RESULTS										
Hilf Density Ratio	Standard	%	97	96	97.5	95	96	97	97.5	98
Moisture Variation from OMC (-Drier/+Wetter)		%	-0.5	0.0	0.0	0.0	0.5	0.0	0.5	-0.5
Specification	Density Ratio (Standard)	≥95%	Specification				Moisture Variance from OMC			±2%
TEST LOCATION										
Easting	294879.534	294851.9	294837.904	294861.677	294883.926	294893.185	294868.761	294847.469		
Northing	6268627.541	6268612.701	6268608.504	6268619.032	6268619.96	6268608.835	6268610.759	6268593.971		
Reduced Level	m	19.769	18.753	18.404	19.549	20.256	21.065	20.226	19.306	
Shown on Drawing No	8599/1-61									
Retested by Test	-	-	-	-	-	-	-	-		
FIELD & LABORATORY DATA										
Field Wet Density	t/m ³	2.09	2.05	2.08	2.03	2.05	2.06	2.09	2.10	
Field Moisture Content	%	14.5	15.5	15.0	15.0	15.5	15.5	15.0	15.0	
Material retained on 19mm Sieve (wet)	%	<5	<5	<5	<5	<5	<5	<5	<5	
Lab Compaction result from test number		3662	3663	3664	3665	3666	3667	3668	3669	
Peak Converted Wet Density	t/m ³	2.15	2.14	2.13	2.14	2.14	2.12	2.14	2.14	
Apparent Optimum Moisture Content	%	15.0	15.5	15.0	15.0	15.0	15.0	14.5	15.5	
Number of Compaction Points		3	3	3	3	3	3	3	3	
Test Procedures - See Note Number		12	12	12	12	12	12	12	12	
Material Description - see below		2	2	2	2	2	2	2	2	
Notes										
1: Assigned Values have been obtained from our Penrith laboratory – Accreditation No 2734					10: AS 1289 1.2.1 clause 6.4 (b), 2.1.1, 5.3.1, 5.5.1, 5.6.1					
2: Assigned Values have been obtained from our Prestons laboratory – Accreditation No 14234					11: AS 1289 1.2.1 clause 6.4 (b), 2.1.1, 5.3.1, 5.7.1					
3: Results have been calculated using infinite decimal places. Therefore, calculated values may vary from those shown					12: AS 1289 1.2.1 clause 6.4 (b), 2.1.1, 5.7.1, 5.8.1					
4: AS 1289 1.2.1 clause 6.4 (b), 2.1.1, 5.1.1, 5.3.1, 5.4.1					13: RMS T111, T119, T120, T166					
5: AS 1289 1.2.1 clause 6.4 (b), 2.1.1, 5.2.1, 5.3.1, 5.4.1					14: RMS T111, T120, T166, T173					
6: AS 1289 1.2.1 clause 6.4 (b),					15: RMS T120, T119, T162					
7: AS 1289 1.2.1 clause 6.4 (b), 2.1.1, 5.2.1, 5.4.1, 5.8.1					16: RMS T120, T162, T173					
8: AS 1289 1.2.1 clause 6.4 (b), 2.1.1., 5.5.1, 5.6.1, 5.8.1					17: RMS T120, T164, T173					
9: Full details of Test Procedure 5.8.1 available on request										
Material Description										
1. CL-Clays of low plasticity, gravelly clays, sandy clays, silty clays			11. DGS40			* Cement Stabilised				
2. CI-Clay of medium plasticity, gravelly clays, sandy clays, silty clays			12. FCR20			# Lime Stabilised				
3. CH-Clays of high plasticity			13. FCR40			\$ Gypsum Stabilised				
4. SC-Clayey sands, sand-clay mixtures			14. RC - Recycled Concrete							
5. SM-Silty sands, sand-silt mixtures			15. Recycled Roadbase							
6. GC-Clayey gravels, gravel-sand-clay mixtures			16. RSB - Recycled Sub-base							
7. SP-Sand, crushed dust, filling sand, washed sand			17. CSS - Crushed Sandstone							
8. DGB20			18. RSS - Ripped Sandstone							
9. DGB40			19. Cowels Brown							
10. DGS20										

Form No R 020c Version 01 06/17 - issued by ER



Accreditation Number 2734
Corporate Site Number 2727

Accredited for compliance with
ISO/IEC 17025 - Testing.

A Kench 24/11/2017

Approved Signatory

Head Office:
34 Borec Road, Penrith NSW 2750
P O Box 880 Penrith NSW 2751
Telephone: (02) 4722 21

Prestons Laboratory:
Unit 4, 18-20 Whyalla Place, Prestons NSW 2170
Telephone: (02) 9607 6111 Facsimile: (02) 9607 6200

FIELD DENSITY RESULTS

DARACON CONTRACTORS PTY LTD
PO BOX 299
WALLSEND NSW 2287

Laboratory: Penrith
Job No: 8599/1
Date: 24/11/2017

PROJECT: SITE FILL TESTING - AREA B
RESIDENTIAL DEVELOPMENT.WOORONG PARK, MARSDEN PARK

Page 54 of 79

TEST NUMBER	3670	3671	3672	3673	3674	3675	3676	3677		
DATE TESTED	30/10/2017		31/10/2017							
RESULTS										
Hiif Density Ratio	Standard	%	97	96.5	97	96.5	98.5	98	98	97
Moisture Variation from OMC (-Drier/+Wetter)		%	0.0	0.0	0.5	0.0	0.0	0.0	0.0	0.5
Specification	Density Ratio (Standard)	≥95%	Specification				Moisture Variance from OMC			±2%
TEST LOCATION										
Easting	295254.774	295265.462	295260.455	295239.553	295225.272	295211.849	295218.32	295196.285		
Northing	6269049.657	6269085.402	6269113.922	6269085.673	6269049.162	6269070.498	6269106.591	6269109.596		
Reduced Level	m	18.181	17.742	16.712	17.419	17.866	17.653	16.854	16.061	
Shown on Drawing No	8599/1-59									
Retested by Test	-	-	-	-	-	-	-	-		
FIELD & LABORATORY DATA										
Field Wet Density	t/m ³	2.07	2.06	2.05	2.07	2.08	2.09	2.08	2.06	
Field Moisture Content	%	15.5	14.5	14.0	14.5	14.0	14.5	15.5	15.5	
Material retained on 19mm Sieve (wet)	%	<5	<5	<5	<5	<5	<5	<5	<5	
Lab Compaction result from test number		3670	3671	3672	3673	3674	3675	3676	3677	
Peak Converted Wet Density	t/m ³	2.13	2.13	2.11	2.14	2.11	2.13	2.12	2.12	
Apparent Optimum Moisture Content	%	15.5	14.5	13.5	14.5	13.5	14.5	15.5	15.0	
Number of Compaction Points		3	3	3	3	3	3	3	3	
Test Procedures - See Note Number		12	12	12	12	12	12	12	12	
Material Description - see below		2	2	1-2	2	1-2	2	2	2	
Notes										
1: Assigned Values have been obtained from our Penrith laboratory – Accreditation No 2734					10: AS 1289 1.2.1 clause 6.4 (b), 2.1.1, 5.3.1, 5.5.1, 5.6.1					
2: Assigned Values have been obtained from our Prestons laboratory – Accreditation No 14234					11: AS 1289 1.2.1 clause 6.4 (b), 2.1.1, 5.3.1, 5.7.1					
3: Results have been calculated using infinite decimal places. Therefore, calculated values may vary from those shown					12: AS 1289 1.2.1 clause 6.4 (b), 2.1.1, 5.7.1, 5.8.1					
4: AS 1289 1.2.1 clause 6.4 (b), 2.1.1, 5.1.1, 5.3.1, 5.4.1					13: RMS T111, T119, T120, T166					
5: AS 1289 1.2.1 clause 6.4 (b), 2.1.1, 5.2.1, 5.3.1, 5.4.1					14: RMS T111, T120, T166, T173					
6: AS 1289 1.2.1 clause 6.4 (b),					15: RMS T120, T119, T162					
7: AS 1289 1.2.1 clause 6.4 (b), 2.1.1, 5.2.1, 5.4.1, 5.8.1					16: RMS T120, T162, T173					
8: AS 1289 1.2.1 clause 6.4 (b), 2.1.1., 5.5.1, 5.6.1, 5.8.1					17: RMS T120, T164, T173					
9: Full details of Test Procedure 5.8.1 available on request										
Material Description										
1. CL-Clays of low plasticity, gravelly clays, sandy clays, silty clays			11. DGS40			* Cement Stabilised				
2. CI-Clay of medium plasticity, gravelly clays, sandy clays, silty clays			12. FCR20			# Lime Stabilised				
3. CH-Clays of high plasticity			13. FCR40			\$ Gypsum Stabilised				
4. SC-Clayey sands, sand-clay mixtures			14. RC - Recycled Concrete							
5. SM-Silty sands, sand-silt mixtures			15. Recycled Roadbase							
6. GC-Clayey gravels, gravel-sand-clay mixtures			16. RSB - Recycled Sub-base							
7. SP-Sand, crushed dust, filling sand, washed sand			17. CSS - Crushed Sandstone							
8. DGB20			18. RSS - Ripped Sandstone							
9. DGB40			19. Cowels Brown							
10. DGS20										

Form No R 020c Version 01 06/17 - issued by ER



Accreditation Number 2734
Corporate Site Number 2727

Accredited for compliance with
ISO/IEC 17025 - Testing.

A Kench 24/11/2017

Approved Signatory

Head Office:
34 Borec Road, Penrith NSW 2750
P O Box 880 Penrith NSW 2751
Telephone: (02) 4722 21

Prestons Laboratory:
Unit 4, 18-20 Whyalla Place, Prestons NSW 2170
Telephone: (02) 9607 6111 Facsimile: (02) 9607 6200

FIELD DENSITY RESULTS

DARACON CONTRACTORS PTY LTD
PO BOX 299
WALLSEND NSW 2287

Laboratory: Penrith
Job No: 8599/1
Date: 24/11/2017

PROJECT: SITE FILL TESTING - AREA B
RESIDENTIAL DEVELOPMENT.WOORONG PARK, MARSDEN PARK

Page 55 of 79

TEST NUMBER	3678	3679	3680	3681	3682	3683	3684	3685		
DATE TESTED	31/10/2017									
RESULTS										
Hilf Density Ratio	Standard	%	96.5	99	96.5	98.5	96	97	100	99
Moisture Variation from OMC (-Drier/+Wetter)		%	0.0	0.0	0.0	0.5	0.0	0.0	0.0	0.0
Specification	Density Ratio (Standard)	≥95%	Specification Moisture Variance from OMC				±2%			
TEST LOCATION										
Easting	295179.773	296047.608	296045.226	296035.851	296029.923	296029.776	296002.365	296001.031		
Northing	6269063.263	6268644.879	6268583.614	6268539.306	6268589.187	6268649.847	6268643.55	6268599.052		
Reduced Level	m									
Shown on Drawing No	17.37	22.12	22.28	22.268	21.992	21.994	21.393	21.657		
Retested by Test	8599/1-59				8599/1-63					
	-	-	-	-	-	-	-	-		
FIELD & LABORATORY DATA										
Field Wet Density	t/m ³	2.06	2.09	2.05	2.07	2.04	2.06	2.11	2.09	
Field Moisture Content	%	15.0	15.0	14.5	15.0	14.0	15.5	14.5	14.5	
Material retained on 19mm Sieve (wet)	%	<5	<5	<5	<5	<5	<5	<5	<5	
Lab Compaction result from test number		3678	3679	3680	3681	3682	3683	3684	3685	
Peak Converted Wet Density	t/m ³	2.14	2.11	2.12	2.10	2.12	2.12	2.11	2.11	
Apparent Optimum Moisture Content	%	15.0	15.0	15.0	14.5	14.0	15.0	14.0	14.0	
Number of Compaction Points		3	3	3	3	3	3	3	3	
Test Procedures - See Note Number		12	12	12	12	12	12	12	12	
Material Description - see below		2	2	2	2	1-2	2	1-2	2	
Notes										
1: Assigned Values have been obtained from our Penrith laboratory – Accreditation No 2734					10: AS 1289 1.2.1 clause 6.4 (b), 2.1.1, 5.3.1, 5.5.1, 5.6.1					
2: Assigned Values have been obtained from our Prestons laboratory – Accreditation No 14234					11: AS 1289 1.2.1 clause 6.4 (b), 2.1.1, 5.3.1, 5.7.1					
3: Results have been calculated using infinite decimal places. Therefore, calculated values may vary from those shown					12: AS 1289 1.2.1 clause 6.4 (b), 2.1.1, 5.7.1, 5.8.1					
4: AS 1289 1.2.1 clause 6.4 (b), 2.1.1, 5.1.1, 5.3.1, 5.4.1					13: RMS T111, T119, T120, T166					
5: AS 1289 1.2.1 clause 6.4 (b), 2.1.1, 5.2.1, 5.3.1, 5.4.1					14: RMS T111, T120, T166, T173					
6: AS 1289 1.2.1 clause 6.4 (b),					15: RMS T120, T119, T162					
7: AS 1289 1.2.1 clause 6.4 (b), 2.1.1, 5.2.1, 5.4.1, 5.8.1					16: RMS T120, T162, T173					
8: AS 1289 1.2.1 clause 6.4 (b), 2.1.1., 5.5.1, 5.6.1, 5.8.1					17: RMS T120, T164, T173					
9: Full details of Test Procedure 5.8.1 available on request										
Material Description										
1. CL-Clays of low plasticity, gravelly clays, sandy clays, silty clays			11. DGS40			* Cement Stabilised				
2. CI-Clay of medium plasticity, gravelly clays, sandy clays, silty clays			12. FCR20			# Lime Stabilised				
3. CH-Clays of high plasticity			13. FCR40			\$ Gypsum Stabilised				
4. SC-Clayey sands, sand-clay mixtures			14. RC - Recycled Concrete							
5. SM-Silty sands, sand-silt mixtures			15. Recycled Roadbase							
6. GC-Clayey gravels, gravel-sand-clay mixtures			16. RSB - Recycled Sub-base							
7. SP-Sand, crushed dust, filling sand, washed sand			17. CSS - Crushed Sandstone							
8. DGB20			18. RSS - Ripped Sandstone							
9. DGB40			19. Cowels Brown							
10. DGS20										

Form No R 020c Version 01 06/17 - issued by ER



Accreditation Number 2734
Corporate Site Number 2727

Accredited for compliance with
ISO/IEC 17025 - Testing.

A Kench 24/11/2017

Approved Signatory

Head Office:
34 Borec Road, Penrith NSW 2750
P O Box 880 Penrith NSW 2751
Telephone: (02) 4722 21

Prestons Laboratory:
Unit 4, 18-20 Whyalla Place, Prestons NSW 2170
Telephone: (02) 9607 6111 Facsimile: (02) 9607 6200

FIELD DENSITY RESULTS

DARACON CONTRACTORS PTY LTD
PO BOX 299
WALLSEND NSW 2287

Laboratory: Penrith
Job No: 8599/1
Date: 24/11/2017

PROJECT: SITE FILL TESTING - AREA B
RESIDENTIAL DEVELOPMENT.WOORONG PARK, MARSDEN PARK

Page 56 of 79

TEST NUMBER	3686	3687	3688	3689	3690	3691	3692	3693		
DATE TESTED	31/10/2017									
RESULTS										
Hilf Density Ratio	Standard	%	98	97	96.5	97	98	97.5	97	98
Moisture Variation from OMC (-Drier/+Wetter)		%	0.5	0.0	0.0	1.0	0.0	0.5	0.0	1.0
Specification	Density Ratio (Standard)	≥95%	Specification				Moisture Variance from OMC			±2%
TEST LOCATION										
Easting	295973.745	295959.809	295931.553	295914.449	295891.933	295860.205	295862.45	296057.137		
Northing	6268597.018	6268645.859	6268617.374	6268574.41	6268624.433	6268613.31	6268579.029	6269743.289		
Reduced Level	m	20.624	19.891	19.655	19.639	19.073	19.021	19.035	16.934	
Shown on Drawing No	8599/1-63								8599/1-56	
Retested by Test	-	-	-	-	-	-	-	-	-	
FIELD & LABORATORY DATA										
Field Wet Density	t/m ³	2.09	2.06	2.05	2.06	2.07	2.08	2.07	2.08	
Field Moisture Content	%	15.0	15.5	15.0	14.5	15.0	15.0	15.5	14.5	
Material retained on 19mm Sieve (wet)	%	<5	<5	<5	<5	<5	<5	<5	<5	
Lab Compaction result from test number		3686	3687	3688	3689	3690	3691	3692	3693	
Peak Converted Wet Density	t/m ³	2.13	2.12	2.12	2.12	2.11	2.13	2.13	2.12	
Apparent Optimum Moisture Content	%	14.5	15.0	15.0	13.5	15.0	14.5	15.5	13.5	
Number of Compaction Points		3	3	3	3	3	3	3	3	
Test Procedures - See Note Number		12	12	12	12	12	12	12	12	
Material Description - see below		2	2	2	1-2	2	1-2	2	1-2	
Notes										
1: Assigned Values have been obtained from our Penrith laboratory – Accreditation No 2734					10: AS 1289 1.2.1 clause 6.4 (b), 2.1.1, 5.3.1, 5.5.1, 5.6.1					
2: Assigned Values have been obtained from our Prestons laboratory – Accreditation No 14234					11: AS 1289 1.2.1 clause 6.4 (b), 2.1.1, 5.3.1, 5.7.1					
3: Results have been calculated using infinite decimal places. Therefore, calculated values may vary from those shown										
4: AS 1289 1.2.1 clause 6.4 (b), 2.1.1, 5.1.1, 5.3.1, 5.4.1					12: AS 1289 1.2.1 clause 6.4 (b), 2.1.1, 5.7.1, 5.8.1					
5: AS 1289 1.2.1 clause 6.4 (b), 2.1.1, 5.2.1, 5.3.1, 5.4.1					13: RMS T111, T119, T120, T166					
6: AS 1289 1.2.1 clause 6.4 (b),					14: RMS T111, T120, T166, T173					
7: AS 1289 1.2.1 clause 6.4 (b), 2.1.1, 5.2.1, 5.4.1, 5.8.1					15: RMS T120, T119, T162					
8: AS 1289 1.2.1 clause 6.4 (b), 2.1.1., 5.5.1, 5.6.1, 5.8.1					16: RMS T120, T162, T173					
9: Full details of Test Procedure 5.8.1 available on request					17: RMS T120, T164, T173					
Material Description										
1. CL-Clays of low plasticity, gravelly clays, sandy clays, silty clays			11. DGS40			* Cement Stabilised				
2. CI-Clay of medium plasticity, gravelly clays, sandy clays, silty clays			12. FCR20			# Lime Stabilised				
3. CH-Clays of high plasticity			13. FCR40			\$ Gypsum Stabilised				
4. SC-Clayey sands, sand-clay mixtures			14. RC - Recycled Concrete							
5. SM-Silty sands, sand-silt mixtures			15. Recycled Roadbase							
6. GC-Clayey gravels, gravel-sand-clay mixtures			16. RSB - Recycled Sub-base							
7. SP-Sand, crushed dust, filling sand, washed sand			17. CSS - Crushed Sandstone							
8. DGB20			18. RSS - Ripped Sandstone							
9. DGB40			19. Cowels Brown							
10. DGS20										

Form No R 020c Version 01 06/17 - issued by ER



Accreditation Number 2734
Corporate Site Number 2727

Accredited for compliance with
ISO/IEC 17025 - Testing.

A Kench 24/11/2017

Approved Signatory

Head Office:
34 Borec Road, Penrith NSW 2750
P O Box 880 Penrith NSW 2751
Telephone: (02) 4722 21

Prestons Laboratory:
Unit 4, 18-20 Whyalla Place, Prestons NSW 2170
Telephone: (02) 9607 6111 Facsimile: (02) 9607 6200

FIELD DENSITY RESULTS

DARACON CONTRACTORS PTY LTD
PO BOX 299
WALLSEND NSW 2287

Laboratory: Penrith
Job No: 8599/1
Date: 24/11/2017

PROJECT: SITE FILL TESTING - AREA B
RESIDENTIAL DEVELOPMENT.WOORONG PARK, MARSDEN PARK

TEST NUMBER	3694	3695	3696	3697	3698	3699	3700	3701		
DATE TESTED	31/10/2017									
RESULTS										
Hiif Density Ratio	Standard	%	98.5	97	99	99.5	99.5	97	97.5	98.5
Moisture Variation from OMC (-Drier/+Wetter)		%	-0.5	0.0	0.0	0.0	0.5	0.0	0.0	0.0
Specification	Density Ratio (Standard)	≥95%	Specification				Moisture Variance from OMC			±2%
TEST LOCATION										
Easting	296073.625	296056.162	296034.281	296017.233	296038.965	296028.955	295998.221	295974.502		
Northing	6269787.912	6269798.504	6269750.227	6269754.927	6269810.84	6269837.257	6269792.509	6269752.886		
Reduced Level	m	17.026	17.559	18.02	18.477	17.95	17.908	18.649	19.377	
Shown on Drawing No	8599/1-56									
Retested by Test	-	-	-	-	-	-	-	-		
FIELD & LABORATORY DATA										
Field Wet Density	t/m ³	2.10	2.04	2.10	2.12	2.10	2.08	2.07	2.10	
Field Moisture Content	%	14.0	14.5	14.5	15.0	15.5	15.5	15.0	14.5	
Material retained on 19mm Sieve (wet)	%	<5	<5	<5	<5	<5	<5	<5	<5	
Lab Compaction result from test number		3694	3695	3696	3697	3698	3699	3700	3701	
Peak Converted Wet Density	t/m ³	2.13	2.10	2.12	2.13	2.11	2.14	2.12	2.13	
Apparent Optimum Moisture Content	%	14.5	14.5	14.0	15.0	15.0	15.5	15.0	14.5	
Number of Compaction Points		3	3	3	3	3	3	3	3	
Test Procedures - See Note Number		12	12	12	12	12	12	12	12	
Material Description - see below		2	2	1-2	2	2	2	2	2	
Notes										
1: Assigned Values have been obtained from our Penrith laboratory – Accreditation No 2734					10: AS 1289 1.2.1 clause 6.4 (b), 2.1.1, 5.3.1, 5.5.1, 5.6.1					
2: Assigned Values have been obtained from our Prestons laboratory – Accreditation No 14234					11: AS 1289 1.2.1 clause 6.4 (b), 2.1.1, 5.3.1, 5.7.1					
3: Results have been calculated using infinite decimal places. Therefore, calculated values may vary from those shown										
4: AS 1289 1.2.1 clause 6.4 (b), 2.1.1, 5.1.1, 5.3.1, 5.4.1					12: AS 1289 1.2.1 clause 6.4 (b), 2.1.1, 5.7.1, 5.8.1					
5: AS 1289 1.2.1 clause 6.4 (b), 2.1.1, 5.2.1, 5.3.1, 5.4.1					13: RMS T111, T119, T120, T166					
6: AS 1289 1.2.1 clause 6.4 (b),					14: RMS T111, T120, T166, T173					
7: AS 1289 1.2.1 clause 6.4 (b), 2.1.1, 5.2.1, 5.4.1, 5.8.1					15: RMS T120, T119, T162					
8: AS 1289 1.2.1 clause 6.4 (b), 2.1.1., 5.5.1, 5.6.1, 5.8.1					16: RMS T120, T162, T173					
9: Full details of Test Procedure 5.8.1 available on request					17: RMS T120, T164, T173					
Material Description										
1. CL-Clays of low plasticity, gravelly clays, sandy clays, silty clays			11. DGS40			* Cement Stabilised				
2. CI-Clay of medium plasticity, gravelly clays, sandy clays, silty clays			12. FCR20			# Lime Stabilised				
3. CH-Clays of high plasticity			13. FCR40			\$ Gypsum Stabilised				
4. SC-Clayey sands, sand-clay mixtures			14. RC - Recycled Concrete							
5. SM-Silty sands, sand-silt mixtures			15. Recycled Roadbase							
6. GC-Clayey gravels, gravel-sand-clay mixtures			16. RSB - Recycled Sub-base							
7. SP-Sand, crushed dust, filling sand, washed sand			17. CSS - Crushed Sandstone							
8. DGB20			18. RSS - Ripped Sandstone							
9. DGB40			19. Cowels Brown							
10. DGS20										

Form No R 020c Version 01 06/17 - issued by ER



Accreditation Number 2734
Corporate Site Number 2727

Accredited for compliance with
ISO/IEC 17025 - Testing.

A Kench 24/11/2017

Approved Signatory

Head Office:
34 Borec Road, Penrith NSW 2750
P O Box 880 Penrith NSW 2751
Telephone: (02) 4722 21

Prestons Laboratory:
Unit 4, 18-20 Whyalla Place, Prestons NSW 2170
Telephone: (02) 9607 6111 Facsimile: (02) 9607 6200

FIELD DENSITY RESULTS

DARACON CONTRACTORS PTY LTD
PO BOX 299
WALLSEND NSW 2287

Laboratory: Penrith
Job No: 8599/1
Date: 24/11/2017

PROJECT: SITE FILL TESTING - AREA B
RESIDENTIAL DEVELOPMENT.WOORONG PARK, MARSDEN PARK

Page 58 of 79

TEST NUMBER	3702	3703	3704	3705	3706	3707	3708	3709		
DATE TESTED	31/10/2017									
RESULTS										
Hiif Density Ratio	Standard	%	98.5	97	95	99	98	97	98	96.5
Moisture Variation from OMC (-Drier/+Wetter)		%	0.5	0.5	0.0	0.0	0.0	0.0	0.0	-0.5
Specification	Density Ratio (Standard)		≥95%				Specification	Moisture Variance from OMC		±2%
TEST LOCATION										
Easting	294864.774	294871.715	294883.054	294869.088	294856.03	294844.298	294823.007	294827.309		
Northing	6268669.07	6268703.38	6268745.448	6268762.146	6268723.584	6268680.094	6268669.343	6268698.934		
Reduced Level	m	20.278	20.199	20.087	19.554	19.934	19.768	19.194	19.278	
Shown on Drawing No	8599/1-61									
Retested by Test	-	-	-	-	-	-	-	-		
FIELD & LABORATORY DATA										
Field Wet Density	t/m ³	2.09	2.07	2.02	2.08	2.08	2.06	2.09	2.06	
Field Moisture Content	%	15.0	15.5	15.0	15.0	15.0	14.5	15.0	15.0	
Material retained on 19mm Sieve (wet)	%	<5	<5	<5	<5	<5	<5	<5	<5	
Lab Compaction result from test number		3702	3703	3704	3705	3706	3707	3708	3709	
Peak Converted Wet Density	t/m ³	2.12	2.13	2.13	2.10	2.12	2.12	2.13	2.13	
Apparent Optimum Moisture Content	%	14.5	15.0	15.0	14.5	15.0	14.5	15.0	15.5	
Number of Compaction Points		3	3	3	3	3	3	3	3	
Test Procedures - See Note Number		12	12	12	12	12	12	12	12	
Material Description - see below		2	2	2	2	2	2	2	2	
Notes										
1: Assigned Values have been obtained from our Penrith laboratory – Accreditation No 2734					10: AS 1289 1.2.1 clause 6.4 (b), 2.1.1, 5.3.1, 5.5.1, 5.6.1					
2: Assigned Values have been obtained from our Prestons laboratory – Accreditation No 14234					11: AS 1289 1.2.1 clause 6.4 (b), 2.1.1, 5.3.1, 5.7.1					
3: Results have been calculated using infinite decimal places. Therefore, calculated values may vary from those shown					12: AS 1289 1.2.1 clause 6.4 (b), 2.1.1, 5.7.1, 5.8.1					
4: AS 1289 1.2.1 clause 6.4 (b), 2.1.1, 5.1.1, 5.3.1, 5.4.1					13: RMS T111, T119, T120, T166					
5: AS 1289 1.2.1 clause 6.4 (b), 2.1.1, 5.2.1, 5.3.1, 5.4.1					14: RMS T111, T120, T166, T173					
6: AS 1289 1.2.1 clause 6.4 (b),					15: RMS T120, T119, T162					
7: AS 1289 1.2.1 clause 6.4 (b), 2.1.1, 5.2.1, 5.4.1, 5.8.1					16: RMS T120, T162, T173					
8: AS 1289 1.2.1 clause 6.4 (b), 2.1.1., 5.5.1, 5.6.1, 5.8.1					17: RMS T120, T164, T173					
9: Full details of Test Procedure 5.8.1 available on request										
Material Description										
1. CL-Clays of low plasticity, gravelly clays, sandy clays, silty clays			11. DGS40			* Cement Stabilised				
2. CI-Clay of medium plasticity, gravelly clays, sandy clays, silty clays			12. FCR20			# Lime Stabilised				
3. CH-Clays of high plasticity			13. FCR40			\$ Gypsum Stabilised				
4. SC-Clayey sands, sand-clay mixtures			14. RC - Recycled Concrete							
5. SM-Silty sands, sand-silt mixtures			15. Recycled Roadbase							
6. GC-Clayey gravels, gravel-sand-clay mixtures			16. RSB - Recycled Sub-base							
7. SP-Sand, crushed dust, filling sand, washed sand			17. CSS - Crushed Sandstone							
8. DGB20			18. RSS - Ripped Sandstone							
9. DGB40			19. Cowels Brown							
10. DGS20										

Form No R 020c Version 01 06/17 - issued by ER



Accreditation Number 2734
Corporate Site Number 2727

Accredited for compliance with
ISO/IEC 17025 - Testing.

A Kench 24/11/2017

Approved Signatory

Head Office:
34 Borec Road, Penrith NSW 2750
P O Box 880 Penrith NSW 2751
Telephone: (02) 4722 21

Prestons Laboratory:
Unit 4, 18-20 Whyalla Place, Prestons NSW 2170
Telephone: (02) 9607 6111 Facsimile: (02) 9607 6200

FIELD DENSITY RESULTS

DARACON CONTRACTORS PTY LTD
PO BOX 299
WALLSEND NSW 2287

Laboratory: Penrith
Job No: 8599/1
Date: 24/11/2017

PROJECT: SITE FILL TESTING - AREA B
RESIDENTIAL DEVELOPMENT.WOORONG PARK, MARSDEN PARK

Page 59 of 79

TEST NUMBER	3710	3711	3712	3713	3714	3715	3716	3717		
DATE TESTED	31/10/2017			01/11/2017						
RESULTS										
Hilf Density Ratio	Standard	%	96.5	97	98	96.5	98	96.5	97.5	96
Moisture Variation from OMC (-Drier/+Wetter)		%	0.5	0.0	0.0	0.0	0.0	0.5	-0.5	0.5
Specification	Density Ratio (Standard)		≥95%			Specification	Moisture Variance from OMC		±2%	
TEST LOCATION										
Easting	294839.519	295418.03	295414.32	295426.412	295436.573	295449.477	295464.696	295473.627		
Northing	6268751.259	6268580.728	6268614.328	6268636.138	6268602.767	6268579.177	6268614.553	6268636.633		
Reduced Level	m									
Shown on Drawing No	19.193	23.902	23.504	23.156	23.767	23.661	23.733	22.953		
Retested by Test	8599/1-61				8599/1-62					
	-	-	-	-	-	-	-	-		
FIELD & LABORATORY DATA										
Field Wet Density	t/m ³		2.06	2.05	2.08	2.06	2.09	2.06	2.09	2.04
Field Moisture Content	%		15.5	15.0	15.0	14.0	15.0	15.0	13.5	15.0
Material retained on 19mm Sieve (wet)	%		<5	<5	<5	<5	<5	<5	<5	<5
Lab Compaction result from test number			3710	3711	3712	3713	3714	3715	3716	3717
Peak Converted Wet Density	t/m ³		2.13	2.11	2.12	2.13	2.13	2.13	2.14	2.13
Apparent Optimum Moisture Content	%		14.5	15.0	14.5	14.0	15.0	14.5	14.0	14.5
Number of Compaction Points			3	3	3	3	3	3	3	3
Test Procedures - See Note Number			12	12	12	12	12	12	12	12
Material Description - see below			2	2	2	1-2	2	2	1-2	2
Notes										
1: Assigned Values have been obtained from our Penrith laboratory – Accreditation No 2734					10: AS 1289 1.2.1 clause 6.4 (b), 2.1.1, 5.3.1, 5.5.1, 5.6.1					
2: Assigned Values have been obtained from our Prestons laboratory – Accreditation No 14234					11: AS 1289 1.2.1 clause 6.4 (b), 2.1.1, 5.3.1, 5.7.1					
3: Results have been calculated using infinite decimal places. Therefore, calculated values may vary from those shown					12: AS 1289 1.2.1 clause 6.4 (b), 2.1.1, 5.7.1, 5.8.1					
4: AS 1289 1.2.1 clause 6.4 (b), 2.1.1, 5.1.1, 5.3.1, 5.4.1					13: RMS T111, T119, T120, T166					
5: AS 1289 1.2.1 clause 6.4 (b), 2.1.1, 5.2.1, 5.3.1, 5.4.1					14: RMS T111, T120, T166, T173					
6: AS 1289 1.2.1 clause 6.4 (b),					15: RMS T120, T119, T162					
7: AS 1289 1.2.1 clause 6.4 (b), 2.1.1, 5.2.1, 5.4.1, 5.8.1					16: RMS T120, T162, T173					
8: AS 1289 1.2.1 clause 6.4 (b), 2.1.1., 5.5.1, 5.6.1, 5.8.1					17: RMS T120, T164, T173					
9: Full details of Test Procedure 5.8.1 available on request										
Material Description										
1. CL-Clays of low plasticity, gravelly clays, sandy clays, silty clays			11. DGS40			* Cement Stabilised				
2. CI-Clay of medium plasticity, gravelly clays, sandy clays, silty clays			12. FCR20			# Lime Stabilised				
3. CH-Clays of high plasticity			13. FCR40			\$ Gypsum Stabilised				
4. SC-Clayey sands, sand-clay mixtures			14. RC - Recycled Concrete							
5. SM-Silty sands, sand-silt mixtures			15. Recycled Roadbase							
6. GC-Clayey gravels, gravel-sand-clay mixtures			16. RSB - Recycled Sub-base							
7. SP-Sand, crushed dust, filling sand, washed sand			17. CSS - Crushed Sandstone							
8. DGB20			18. RSS - Ripped Sandstone							
9. DGB40			19. Cowels Brown							
10. DGS20										

Form No R 020c Version 01 06/17 - issued by ER



Accreditation Number 2734
Corporate Site Number 2727

Accredited for compliance with
ISO/IEC 17025 - Testing.

A Kench 24/11/2017

Approved Signatory

Head Office:
34 Borec Road, Penrith NSW 2750
P O Box 880 Penrith NSW 2751
Telephone: (02) 4722 21

Prestons Laboratory:
Unit 4, 18-20 Whyalla Place, Prestons NSW 2170
Telephone: (02) 9607 6111 Facsimile: (02) 9607 6200

FIELD DENSITY RESULTS

DARACON CONTRACTORS PTY LTD
PO BOX 299
WALLSEND NSW 2287

Laboratory: Penrith
Job No: 8599/1
Date: 24/11/2017

PROJECT: SITE FILL TESTING - AREA B
RESIDENTIAL DEVELOPMENT.WOORONG PARK, MARSDEN PARK

Page 60 of 79

TEST NUMBER	3718	3719	3720	3721	3722	3723	3724	3725		
DATE TESTED	01/11/2017									
RESULTS										
Hiif Density Ratio	Standard	%	96	97.5	97.5	98.5	96.5	96.5		
Moisture Variation from OMC (-Drier/+Wetter)		%	0.0	0.0	-0.5	-0.5	0.0	0.0		
Specification	Density Ratio (Standard)	≥95%	Specification				Moisture Variance from OMC		±2%	
TEST LOCATION										
Easting	295483.585	295503.127	295517.321	295531.899	295550.015	295563.222	295596.724	295619.487		
Northing	6268589.698	6268574.374	6268600.891	6268639.073	6268607.773	6268566.968	6268644.518	6268588.144		
Reduced Level	m		23.557	23.099	23.425	22.797	23.049	22.864	23.049	22.458
Shown on Drawing No	8599/1-62									
Retested by Test	-	-	-	-	-	-	-	-		
FIELD & LABORATORY DATA										
Field Wet Density	t/m ³	2.04	2.08	2.07	2.11	2.06	2.07	2.05	2.07	
Field Moisture Content	%	14.0	15.0	14.5	14.5	13.0	14.5	14.5	14.5	
Material retained on 19mm Sieve (wet)	%	<5	<5	<5	<5	<5	<5	<5	<5	
Lab Compaction result from test number		3718	3719	3720	3721	3722	3723	3724	3725	
Peak Converted Wet Density	t/m ³	2.13	2.13	2.12	2.14	2.13	2.14	2.13	2.14	
Apparent Optimum Moisture Content	%	14.0	15.0	15.0	15.0	13.0	14.5	14.5	14.0	
Number of Compaction Points		3	3	3	3	3	3	3	3	
Test Procedures - See Note Number		12	12	12	12	12	12	12	12	
Material Description - see below		1-2	2	2	2	1	2	2	1-2	
Notes										
1: Assigned Values have been obtained from our Penrith laboratory – Accreditation No 2734					10: AS 1289 1.2.1 clause 6.4 (b), 2.1.1, 5.3.1, 5.5.1, 5.6.1					
2: Assigned Values have been obtained from our Prestons laboratory – Accreditation No 14234					11: AS 1289 1.2.1 clause 6.4 (b), 2.1.1, 5.3.1, 5.7.1					
3: Results have been calculated using infinite decimal places. Therefore, calculated values may vary from those shown					12: AS 1289 1.2.1 clause 6.4 (b), 2.1.1, 5.7.1, 5.8.1					
4: AS 1289 1.2.1 clause 6.4 (b), 2.1.1, 5.1.1, 5.3.1, 5.4.1					13: RMS T111, T119, T120, T166					
5: AS 1289 1.2.1 clause 6.4 (b), 2.1.1, 5.2.1, 5.3.1, 5.4.1					14: RMS T111, T120, T166, T173					
6: AS 1289 1.2.1 clause 6.4 (b),					15: RMS T120, T119, T162					
7: AS 1289 1.2.1 clause 6.4 (b), 2.1.1, 5.2.1, 5.4.1, 5.8.1					16: RMS T120, T162, T173					
8: AS 1289 1.2.1 clause 6.4 (b), 2.1.1., 5.5.1, 5.6.1, 5.8.1					17: RMS T120, T164, T173					
9: Full details of Test Procedure 5.8.1 available on request										
Material Description										
1. CL-Clays of low plasticity, gravelly clays, sandy clays, silty clays			11. DGS40			* Cement Stabilised				
2. CI-Clay of medium plasticity, gravelly clays, sandy clays, silty clays			12. FCR20			# Lime Stabilised				
3. CH-Clays of high plasticity			13. FCR40			\$ Gypsum Stabilised				
4. SC-Clayey sands, sand-clay mixtures			14. RC - Recycled Concrete							
5. SM-Silty sands, sand-silt mixtures			15. Recycled Roadbase							
6. GC-Clayey gravels, gravel-sand-clay mixtures			16. RSB - Recycled Sub-base							
7. SP-Sand, crushed dust, filling sand, washed sand			17. CSS - Crushed Sandstone							
8. DGB20			18. RSS - Ripped Sandstone							
9. DGB40			19. Cowels Brown							
10. DGS20										

Form No R 020c Version 01 06/17 - issued by ER



Accreditation Number 2734
Corporate Site Number 2727

Accredited for compliance with
ISO/IEC 17025 - Testing.

A Kench 24/11/2017

Approved Signatory

Head Office:
34 Borec Road, Penrith NSW 2750
P O Box 880 Penrith NSW 2751
Telephone: (02) 4722 21

Prestons Laboratory:
Unit 4, 18-20 Whyalla Place, Prestons NSW 2170
Telephone: (02) 9607 6111 Facsimile: (02) 9607 6200

FIELD DENSITY RESULTS

DARACON CONTRACTORS PTY LTD
PO BOX 299
WALLSEND NSW 2287

Laboratory: Penrith
Job No: 8599/1
Date: 24/11/2017

PROJECT: SITE FILL TESTING - AREA B
RESIDENTIAL DEVELOPMENT.WOORONG PARK, MARSDEN PARK

Page 61 of 79

TEST NUMBER	3726	3727	3728	3729	3730	3731	3732	3733		
DATE TESTED	01/11/2017									
RESULTS										
Hilf Density Ratio	Standard	%	97.5	99	96	96	96.5	97.5	96.5	97
Moisture Variation from OMC (-Drier/+Wetter)		%	0.0	-0.5	0.0	0.0	0.5	0.0	0.0	0.5
Specification	Density Ratio (Standard)	≥95%	Specification				Moisture Variance from OMC			±2%
TEST LOCATION										
Easting	295638.695	295652.891	295840.919	295897.212	295963.965	296011.126	296018.269	295974.302		
Northing	6268565.075	6268612.434	6268654.903	6268664.371	6268669.734	6268676.075	6268699.66	6268695.208		
Reduced Level	m	21.93	22.732	18.267	18.365	19.943	21.629	21.524	20.359	
Shown on Drawing No	8599/1-62				8599/1-63					
Retested by Test	-	-	-	-	-	-	-	-		
FIELD & LABORATORY DATA										
Field Wet Density	t/m ³	2.09	2.10	2.04	2.05	2.06	2.08	2.08	2.08	
Field Moisture Content	%	15.0	14.5	15.0	14.0	15.0	14.5	14.5	15.0	
Material retained on 19mm Sieve (wet)	%	<5	<5	<5	<5	<5	<5	<5	<5	
Lab Compaction result from test number		3726	3727	3728	3729	3730	3731	3732	3733	
Peak Converted Wet Density	t/m ³	2.14	2.12	2.13	2.13	2.13	2.13	2.15	2.14	
Apparent Optimum Moisture Content	%	14.5	15.0	15.0	14.0	14.0	14.5	14.5	14.5	
Number of Compaction Points		3	3	3	3	3	3	3	3	
Test Procedures - See Note Number		12	12	12	12	12	12	12	12	
Material Description - see below		2	2	2	1-2	2	2	2	2	
Notes										
1: Assigned Values have been obtained from our Penrith laboratory – Accreditation No 2734					10: AS 1289 1.2.1 clause 6.4 (b), 2.1.1, 5.3.1, 5.5.1, 5.6.1					
2: Assigned Values have been obtained from our Prestons laboratory – Accreditation No 14234					11: AS 1289 1.2.1 clause 6.4 (b), 2.1.1, 5.3.1, 5.7.1					
3: Results have been calculated using infinite decimal places. Therefore, calculated values may vary from those shown					12: AS 1289 1.2.1 clause 6.4 (b), 2.1.1, 5.7.1, 5.8.1					
4: AS 1289 1.2.1 clause 6.4 (b), 2.1.1, 5.1.1, 5.3.1, 5.4.1					13: RMS T111, T119, T120, T166					
5: AS 1289 1.2.1 clause 6.4 (b), 2.1.1, 5.2.1, 5.3.1, 5.4.1					14: RMS T111, T120, T166, T173					
6: AS 1289 1.2.1 clause 6.4 (b),					15: RMS T120, T119, T162					
7: AS 1289 1.2.1 clause 6.4 (b), 2.1.1, 5.2.1, 5.4.1, 5.8.1					16: RMS T120, T162, T173					
8: AS 1289 1.2.1 clause 6.4 (b), 2.1.1., 5.5.1, 5.6.1, 5.8.1					17: RMS T120, T164, T173					
9: Full details of Test Procedure 5.8.1 available on request										
Material Description										
1. CL-Clays of low plasticity, gravelly clays, sandy clays, silty clays			11. DGS40			* Cement Stabilised				
2. CI-Clay of medium plasticity, gravelly clays, sandy clays, silty clays			12. FCR20			# Lime Stabilised				
3. CH-Clays of high plasticity			13. FCR40			\$ Gypsum Stabilised				
4. SC-Clayey sands, sand-clay mixtures			14. RC - Recycled Concrete							
5. SM-Silty sands, sand-silt mixtures			15. Recycled Roadbase							
6. GC-Clayey gravels, gravel-sand-clay mixtures			16. RSB - Recycled Sub-base							
7. SP-Sand, crushed dust, filling sand, washed sand			17. CSS - Crushed Sandstone							
8. DGB20			18. RSS - Ripped Sandstone							
9. DGB40			19. Cowels Brown							
10. DGS20										

Form No R 020c Version 01 06/17 - issued by ER



Accreditation Number 2734
Corporate Site Number 2727

Accredited for compliance with
ISO/IEC 17025 - Testing.

A Kench 24/11/2017

Approved Signatory

Head Office:
34 Borec Road, Penrith NSW 2750
P O Box 880 Penrith NSW 2751
Telephone: (02) 4722 21

Prestons Laboratory:
Unit 4, 18-20 Whyalla Place, Prestons NSW 2170
Telephone: (02) 9607 6111 Facsimile: (02) 9607 6200

FIELD DENSITY RESULTS

DARACON CONTRACTORS PTY LTD
PO BOX 299
WALLSEND NSW 2287

Laboratory: Penrith
Job No: 8599/1
Date: 24/11/2017

PROJECT: SITE FILL TESTING - AREA B
RESIDENTIAL DEVELOPMENT.WOORONG PARK, MARSDEN PARK

Page 62 of 79

TEST NUMBER	3734	3735	3736	3737	3738	3739	3740	3741		
DATE TESTED	01/11/2017									
RESULTS										
Hilf Density Ratio	Standard	%	96	97.5	96	98	96	97.5	97.5	97.5
Moisture Variation from OMC (-Drier/+Wetter)		%	0.0	0.5	-0.5	-0.5	0.0	-0.5	0.0	-0.5
Specification	Density Ratio (Standard)		≥95%			Specification	Moisture Variance from OMC		±2%	
TEST LOCATION										
Easting	295922.188	295873.099	295864.203	295901.372	295954.256	296002.702	295173.557	295128.609		
Northing	6268691.616	6268689.625	6268708.657	6268722.484	6268727.093	6268730.652	6269070.214	6269072.925		
Reduced Level	m	18.939	18.263	18.099	17.961	19.504	20.842	16.932	16.242	
Shown on Drawing No	8599/1-63							8599/1-59		
Retested by Test	-	-	-	-	-	-	-	-		
FIELD & LABORATORY DATA										
Field Wet Density	t/m ³	2.04	2.07	2.05	2.10	2.05	2.07	2.08	2.09	
Field Moisture Content	%	15.0	15.0	15.5	15.0	14.5	15.5	14.5	15.5	
Material retained on 19mm Sieve (wet)	%	<5	<5	<5	<5	<5	<5	<5	<5	
Lab Compaction result from test number		3734	3735	3736	3737	3738	3739	3740	3741	
Peak Converted Wet Density	t/m ³	2.12	2.12	2.13	2.14	2.13	2.12	2.13	2.14	
Apparent Optimum Moisture Content	%	15.0	14.5	15.5	15.5	14.5	16.0	14.5	15.5	
Number of Compaction Points		3	3	3	3	3	3	3	3	
Test Procedures - See Note Number		12	12	12	12	12	12	12	12	
Material Description - see below		2	2	2	2	2	2	2	2	
Notes										
1: Assigned Values have been obtained from our Penrith laboratory – Accreditation No 2734					10: AS 1289 1.2.1 clause 6.4 (b), 2.1.1, 5.3.1, 5.5.1, 5.6.1					
2: Assigned Values have been obtained from our Prestons laboratory – Accreditation No 14234					11: AS 1289 1.2.1 clause 6.4 (b), 2.1.1, 5.3.1, 5.7.1					
3: Results have been calculated using infinite decimal places. Therefore, calculated values may vary from those shown					12: AS 1289 1.2.1 clause 6.4 (b), 2.1.1, 5.7.1, 5.8.1					
4: AS 1289 1.2.1 clause 6.4 (b), 2.1.1, 5.1.1, 5.3.1, 5.4.1					13: RMS T111, T119, T120, T166					
5: AS 1289 1.2.1 clause 6.4 (b), 2.1.1, 5.2.1, 5.3.1, 5.4.1					14: RMS T111, T120, T166, T173					
6: AS 1289 1.2.1 clause 6.4 (b)					15: RMS T120, T119, T162					
7: AS 1289 1.2.1 clause 6.4 (b), 2.1.1, 5.2.1, 5.4.1, 5.8.1					16: RMS T120, T162, T173					
8: AS 1289 1.2.1 clause 6.4 (b), 2.1.1., 5.5.1, 5.6.1, 5.8.1					17: RMS T120, T164, T173					
9: Full details of Test Procedure 5.8.1 available on request										
Material Description										
1. CL-Clays of low plasticity, gravelly clays, sandy clays, silty clays			11. DGS40			* Cement Stabilised				
2. CI-Clay of medium plasticity, gravelly clays, sandy clays, silty clays			12. FCR20			# Lime Stabilised				
3. CH-Clays of high plasticity			13. FCR40			\$ Gypsum Stabilised				
4. SC-Clayey sands, sand-clay mixtures			14. RC - Recycled Concrete							
5. SM-Silty sands, sand-silt mixtures			15. Recycled Roadbase							
6. GC-Clayey gravels, gravel-sand-clay mixtures			16. RSB - Recycled Sub-base							
7. SP-Sand, crushed dust, filling sand, washed sand			17. CSS - Crushed Sandstone							
8. DGB20			18. RSS - Ripped Sandstone							
9. DGB40			19. Cowels Brown							
10. DGS20										

Form No R 020c Version 01 06/17 - issued by ER



Accreditation Number 2734
Corporate Site Number 2727

Accredited for compliance with
ISO/IEC 17025 - Testing.

A Kench 24/11/2017

Approved Signatory

Head Office:
34 Borec Road, Penrith NSW 2750
P O Box 880 Penrith NSW 2751
Telephone: (02) 4722 21

Prestons Laboratory:
Unit 4, 18-20 Whyalla Place, Prestons NSW 2170
Telephone: (02) 9607 6111 Facsimile: (02) 9607 6200

FIELD DENSITY RESULTS

DARACON CONTRACTORS PTY LTD
PO BOX 299
WALLSEND NSW 2287

Laboratory: Penrith
Job No: 8599/1
Date: 24/11/2017

PROJECT: SITE FILL TESTING - AREA B
RESIDENTIAL DEVELOPMENT.WOORONG PARK, MARSDEN PARK

Page 63 of 79

TEST NUMBER	3742	3743	3744	3745	3746	3747	3748	3749		
DATE TESTED	01/11/2017									
RESULTS										
Hilf Density Ratio	Standard	%	96.5	98.5	96.5	96.5	97.5	97	97.5	97
Moisture Variation from OMC (-Drier/+Wetter)		%	0.0	-0.5	0.0	-0.5	-0.5	0.0	0.0	-0.5
Specification	Density Ratio (Standard)	≥95%	Specification				Moisture Variance from OMC			±2%
TEST LOCATION										
Easting	295085.46	295044.022	295097.59	295137.077	295136.553	295099.181	295063.072	295154.416		
Northing	6269076.23	6269061.901	6269058.728	6269055.716	6269034.87	6269035.62	6269036.543	6269083.259		
Reduced Level	m	15.578	14.766	16.608	17.203	17.616	17.013	16.24	16.898	
Shown on Drawing No	8599/1-59									
Retested by Test	-	-	-	-	-	-	-	-		
FIELD & LABORATORY DATA										
Field Wet Density	t/m ³	2.07	2.08	2.06	2.06	2.09	2.08	2.09	2.08	
Field Moisture Content	%	13.5	15.0	14.0	14.5	13.5	14.5	15.5	15.0	
Material retained on 19mm Sieve (wet)	%	<5	<5	<5	<5	<5	<5	<5	<5	
Lab Compaction result from test number		3742	3743	3744	3745	3746	3747	3748	3749	
Peak Converted Wet Density	t/m ³	2.14	2.11	2.13	2.14	2.14	2.14	2.14	2.14	
Apparent Optimum Moisture Content	%	13.5	15.0	14.0	15.0	14.0	14.5	15.5	16.0	
Number of Compaction Points		3	3	3	3	3	3	3	3	
Test Procedures - See Note Number		12	12	12	12	12	12	12	12	
Material Description - see below		1-2	2	2	2	2	2	2	2	
Notes										
1: Assigned Values have been obtained from our Penrith laboratory – Accreditation No 2734					10: AS 1289 1.2.1 clause 6.4 (b), 2.1.1, 5.3.1, 5.5.1, 5.6.1					
2: Assigned Values have been obtained from our Prestons laboratory – Accreditation No 14234					11: AS 1289 1.2.1 clause 6.4 (b), 2.1.1, 5.3.1, 5.7.1					
3: Results have been calculated using infinite decimal places. Therefore, calculated values may vary from those shown										
4: AS 1289 1.2.1 clause 6.4 (b), 2.1.1, 5.1.1, 5.3.1, 5.4.1					12: AS 1289 1.2.1 clause 6.4 (b), 2.1.1, 5.7.1, 5.8.1					
5: AS 1289 1.2.1 clause 6.4 (b), 2.1.1, 5.2.1, 5.3.1, 5.4.1					13: RMS T111, T119, T120, T166					
6: AS 1289 1.2.1 clause 6.4 (b),					14: RMS T111, T120, T166, T173					
7: AS 1289 1.2.1 clause 6.4 (b), 2.1.1, 5.2.1, 5.4.1, 5.8.1					15: RMS T120, T119, T162					
8: AS 1289 1.2.1 clause 6.4 (b), 2.1.1., 5.5.1, 5.6.1, 5.8.1					16: RMS T120, T162, T173					
9: Full details of Test Procedure 5.8.1 available on request					17: RMS T120, T164, T173					
Material Description										
1. CL-Clays of low plasticity, gravelly clays, sandy clays, silty clays			11. DGS40			* Cement Stabilised				
2. CI-Clay of medium plasticity, gravelly clays, sandy clays, silty clays			12. FCR20			# Lime Stabilised				
3. CH-Clays of high plasticity			13. FCR40			\$ Gypsum Stabilised				
4. SC-Clayey sands, sand-clay mixtures			14. RC - Recycled Concrete							
5. SM-Silty sands, sand-silt mixtures			15. Recycled Roadbase							
6. GC-Clayey gravels, gravel-sand-clay mixtures			16. RSB - Recycled Sub-base							
7. SP-Sand, crushed dust, filling sand, washed sand			17. CSS - Crushed Sandstone							
8. DGB20			18. RSS - Ripped Sandstone							
9. DGB40			19. Cowels Brown							
10. DGS20										

Form No R 020c Version 01 06/17 - issued by ER



Accreditation Number 2734
Corporate Site Number 2727

Accredited for compliance with
ISO/IEC 17025 - Testing.

A Kench 24/11/2017

Approved Signatory

Head Office:
34 Borec Road, Penrith NSW 2750
P O Box 880 Penrith NSW 2751
Telephone: (02) 4722 21

Prestons Laboratory:
Unit 4, 18-20 Whyalla Place, Prestons NSW 2170
Telephone: (02) 9607 6111 Facsimile: (02) 9607 6200

FIELD DENSITY RESULTS

DARACON CONTRACTORS PTY LTD
PO BOX 299
WALLSEND NSW 2287

Laboratory: Penrith
Job No: 8599/1
Date: 24/11/2017

PROJECT: SITE FILL TESTING - AREA B
RESIDENTIAL DEVELOPMENT.WOORONG PARK, MARSDEN PARK

Page 64 of 79

TEST NUMBER	3750	3751	3752	3753	3754	3755	3756	3757		
DATE TESTED	01/11/2017	02/11/2017						02/11/2017		
RESULTS										
Hilf Density Ratio	Standard	%	98	97	97.5	98.5	96	96	96	96
Moisture Variation from OMC (-Drier/+Wetter)		%	0.0	0.0	0.0	0.0	0.0	0.5	0.0	-0.5
Specification	Density Ratio (Standard)		≥95%			Specification	Moisture Variance from OMC		±2%	
TEST LOCATION										
Easting	295098.747	295068.972	295117.471	295151.177	295117.733	295066.538	295060.002	295118.758		
Northing	6269081.151	6269068.163	6269063.146	6269061.547	6269048.958	6269048.437	6269030.074	6269027.174		
Reduced Level	m	16.316	16.452	17.228	17.273	17.501	16.961	17.507	17.934	
Shown on Drawing No	8599/1-59									
Retested by Test	-	-	-	-	-	-	-	-		
FIELD & LABORATORY DATA										
Field Wet Density	t/m ³	2.10	2.06	2.09	2.09	2.05	2.05	2.04	2.05	
Field Moisture Content	%	14.5	17.0	16.5	17.0	17.0	16.5	17.5	17.5	
Material retained on 19mm Sieve (wet)	%	<5	<5	<5	<5	<5	<5	<5	<5	
Lab Compaction result from test number		3750	3751	3752	3753	3754	3755	3756	3757	
Peak Converted Wet Density	t/m ³	2.14	2.12	2.14	2.12	2.14	2.13	2.13	2.14	
Apparent Optimum Moisture Content	%	14.5	17.0	16.5	17.0	17.0	16.5	17.5	18.0	
Number of Compaction Points		3	3	3	3	3	3	3	3	
Test Procedures - See Note Number		12	12	12	12	12	12	12	12	
Material Description - see below		2	2	2	2	2	2	2	2	
Notes										
1: Assigned Values have been obtained from our Penrith laboratory – Accreditation No 2734					10: AS 1289 1.2.1 clause 6.4 (b), 2.1.1, 5.3.1, 5.5.1, 5.6.1					
2: Assigned Values have been obtained from our Prestons laboratory – Accreditation No 14234					11: AS 1289 1.2.1 clause 6.4 (b), 2.1.1, 5.3.1, 5.7.1					
3: Results have been calculated using infinite decimal places. Therefore, calculated values may vary from those shown										
4: AS 1289 1.2.1 clause 6.4 (b), 2.1.1, 5.1.1, 5.3.1, 5.4.1					12: AS 1289 1.2.1 clause 6.4 (b), 2.1.1, 5.7.1, 5.8.1					
5: AS 1289 1.2.1 clause 6.4 (b), 2.1.1, 5.2.1, 5.3.1, 5.4.1					13: RMS T111, T119, T120, T166					
6: AS 1289 1.2.1 clause 6.4 (b),					14: RMS T111, T120, T166, T173					
7: AS 1289 1.2.1 clause 6.4 (b), 2.1.1, 5.2.1, 5.4.1, 5.8.1					15: RMS T120, T119, T162					
8: AS 1289 1.2.1 clause 6.4 (b), 2.1.1., 5.5.1, 5.6.1, 5.8.1					16: RMS T120, T162, T173					
9: Full details of Test Procedure 5.8.1 available on request					17: RMS T120, T164, T173					
Material Description										
1. CL-Clays of low plasticity, gravelly clays, sandy clays, silty clays			11. DGS40			* Cement Stabilised				
2. CI-Clay of medium plasticity, gravelly clays, sandy clays, silty clays			12. FCR20			# Lime Stabilised				
3. CH-Clays of high plasticity			13. FCR40			\$ Gypsum Stabilised				
4. SC-Clayey sands, sand-clay mixtures			14. RC - Recycled Concrete							
5. SM-Silty sands, sand-silt mixtures			15. Recycled Roadbase							
6. GC-Clayey gravels, gravel-sand-clay mixtures			16. RSB - Recycled Sub-base							
7. SP-Sand, crushed dust, filling sand, washed sand			17. CSS - Crushed Sandstone							
8. DGB20			18. RSS - Ripped Sandstone							
9. DGB40			19. Cowels Brown							
10. DGS20										

Form No R 020c Version 01 06/17 - issued by ER



Accreditation Number 2734
Corporate Site Number 2727

Accredited for compliance with
ISO/IEC 17025 - Testing.

A Kench 24/11/2017

Approved Signatory

Head Office:
34 Borec Road, Penrith NSW 2750
P O Box 880 Penrith NSW 2751
Telephone: (02) 4722 21

Prestons Laboratory:
Unit 4, 18-20 Whyalla Place, Prestons NSW 2170
Telephone: (02) 9607 6111 Facsimile: (02) 9607 6200

FIELD DENSITY RESULTS

DARACON CONTRACTORS PTY LTD
PO BOX 299
WALLSEND NSW 2287

Laboratory: Penrith
Job No: 8599/1
Date: 24/11/2017

PROJECT: SITE FILL TESTING - AREA B
RESIDENTIAL DEVELOPMENT.WOORONG PARK, MARSDEN PARK

Page 65 of 79

TEST NUMBER	3758	3759	3760	3761	3762	3763	3764	3765		
DATE TESTED	02/11/2017									
RESULTS										
Hilf Density Ratio	Standard	%	96.5	97	97	96	96	97.5	99	97
Moisture Variation from OMC (-Drier/+Wetter)		%	0.5	0.0	0.5	0.5	0.0	0.5	0.0	0.0
Specification	Density Ratio (Standard)		≥95%			Specification	Moisture Variance from OMC		±2%	
TEST LOCATION										
Easting	295680.479	295636.184	295585.54	295576.998	295622.316	295658.832	295643.07	295599.171		
Northing	6268637.005	6268637.834	6268636.865	6268618.061	6268613.292	6268605.697	6268588.501	6268596.882		
Reduced Level	m	22.822	23.21	23.156	23.573	23.355	22.897	22.828	23.528	
Shown on Drawing No	8599/1-62									
Retested by Test	-	-	-	-	-	-	-	-		
FIELD & LABORATORY DATA										
Field Wet Density	t/m ³	2.06	2.08	2.07	2.05	2.04	2.07	2.09	2.08	
Field Moisture Content	%	18.0	17.0	16.5	18.5	18.5	18.5	18.0	17.0	
Material retained on 19mm Sieve (wet)	%	<5	<5	<5	<5	<5	<5	<5	<5	
Lab Compaction result from test number		3758	3759	3760	3761	3762	3763	3764	3765	
Peak Converted Wet Density	t/m ³	2.14	2.14	2.13	2.13	2.13	2.12	2.11	2.14	
Apparent Optimum Moisture Content	%	17.0	17.0	16.0	18.0	18.0	18.5	17.5	17.0	
Number of Compaction Points		3	3	3	3	3	3	3	3	
Test Procedures - See Note Number		12	12	12	12	12	12	12	12	
Material Description - see below		2	2	2	2	2	2	2	2	
Notes										
1: Assigned Values have been obtained from our Penrith laboratory – Accreditation No 2734					10: AS 1289 1.2.1 clause 6.4 (b), 2.1.1, 5.3.1, 5.5.1, 5.6.1					
2: Assigned Values have been obtained from our Prestons laboratory – Accreditation No 14234					11: AS 1289 1.2.1 clause 6.4 (b), 2.1.1, 5.3.1, 5.7.1					
3: Results have been calculated using infinite decimal places. Therefore, calculated values may vary from those shown					12: AS 1289 1.2.1 clause 6.4 (b), 2.1.1, 5.7.1, 5.8.1					
4: AS 1289 1.2.1 clause 6.4 (b), 2.1.1, 5.1.1, 5.3.1, 5.4.1					13: RMS T111, T119, T120, T166					
5: AS 1289 1.2.1 clause 6.4 (b), 2.1.1, 5.2.1, 5.3.1, 5.4.1					14: RMS T111, T120, T166, T173					
6: AS 1289 1.2.1 clause 6.4 (b),					15: RMS T120, T119, T162					
7: AS 1289 1.2.1 clause 6.4 (b), 2.1.1, 5.2.1, 5.4.1, 5.8.1					16: RMS T120, T162, T173					
8: AS 1289 1.2.1 clause 6.4 (b), 2.1.1., 5.5.1, 5.6.1, 5.8.1					17: RMS T120, T164, T173					
9: Full details of Test Procedure 5.8.1 available on request										
Material Description										
1. CL-Clays of low plasticity, gravelly clays, sandy clays, silty clays			11. DGS40			* Cement Stabilised				
2. CI-Clay of medium plasticity, gravelly clays, sandy clays, silty clays			12. FCR20			# Lime Stabilised				
3. CH-Clays of high plasticity			13. FCR40			\$ Gypsum Stabilised				
4. SC-Clayey sands, sand-clay mixtures			14. RC - Recycled Concrete							
5. SM-Silty sands, sand-silt mixtures			15. Recycled Roadbase							
6. GC-Clayey gravels, gravel-sand-clay mixtures			16. RSB - Recycled Sub-base							
7. SP-Sand, crushed dust, filling sand, washed sand			17. CSS - Crushed Sandstone							
8. DGB20			18. RSS - Ripped Sandstone							
9. DGB40			19. Cowels Brown							
10. DGS20										

Form No R 020c Version 01 06/17 - issued by ER



Accreditation Number 2734
Corporate Site Number 2727

Accredited for compliance with
ISO/IEC 17025 - Testing.

A Kench 24/11/2017

Approved Signatory

Head Office:
34 Borec Road, Penrith NSW 2750
P O Box 880 Penrith NSW 2751
Telephone: (02) 4722 21

Prestons Laboratory:
Unit 4, 18-20 Whyalla Place, Prestons NSW 2170
Telephone: (02) 9607 6111 Facsimile: (02) 9607 6200

FIELD DENSITY RESULTS

DARACON CONTRACTORS PTY LTD
PO BOX 299
WALLSEND NSW 2287

Laboratory: Penrith
Job No: 8599/1
Date: 24/11/2017

PROJECT: SITE FILL TESTING - AREA B
RESIDENTIAL DEVELOPMENT.WOORONG PARK, MARSDEN PARK

Page 66 of 79

TEST NUMBER	3766	3767	3768	3769	3770	3771	3772	3773		
DATE TESTED	02/11/2017									
RESULTS										
Hilf Density Ratio	Standard	%	96	98.5	97.5	96	97	96	96	96.5
Moisture Variation from OMC (-Drier/+Wetter)		%	0.0	0.0	0.0	0.0	0.0	-0.5	0.0	0.0
Specification	Density Ratio (Standard)		≥95%			Specification	Moisture Variance from OMC		±2%	
TEST LOCATION										
Easting	295559.722	295598.3	295639.719	295643.294	295614.133	295472.836	295502.959	295519.259		
Northing	6268599.685	6268585.072	6268577.137	6268554.767	6268560.373	6268609.562	6268604.266	6268622.371		
Reduced Level	m	23.468	23.479	22.917	22.027	22.362	23.907	23.662	23.208	
Shown on Drawing No	8599/1-62									
Retested by Test	-	-	-	-	-	-	-	-		
FIELD & LABORATORY DATA										
Field Wet Density	t/m ³	2.05	2.09	2.07	2.04	2.07	2.05	2.03	2.06	
Field Moisture Content	%	17.5	18.0	17.0	19.0	18.5	17.5	17.5	18.0	
Material retained on 19mm Sieve (wet)	%	<5	<5	<5	<5	<5	<5	<5	<5	
Lab Compaction result from test number		3766	3767	3768	3769	3770	3771	3772	3773	
Peak Converted Wet Density	t/m ³	2.14	2.12	2.12	2.12	2.13	2.14	2.12	2.14	
Apparent Optimum Moisture Content	%	17.5	18.0	17.0	18.5	18.5	17.5	17.5	18.5	
Number of Compaction Points		3	3	3	3	3	3	3	3	
Test Procedures - See Note Number		12	12	12	12	12	12	12	12	
Material Description - see below		2	2	2	2	2	2	2	2	
Notes										
1: Assigned Values have been obtained from our Penrith laboratory – Accreditation No 2734					10: AS 1289 1.2.1 clause 6.4 (b), 2.1.1, 5.3.1, 5.5.1, 5.6.1					
2: Assigned Values have been obtained from our Prestons laboratory – Accreditation No 14234					11: AS 1289 1.2.1 clause 6.4 (b), 2.1.1, 5.3.1, 5.7.1					
3: Results have been calculated using infinite decimal places. Therefore, calculated values may vary from those shown										
4: AS 1289 1.2.1 clause 6.4 (b), 2.1.1, 5.1.1, 5.3.1, 5.4.1					12: AS 1289 1.2.1 clause 6.4 (b), 2.1.1, 5.7.1, 5.8.1					
5: AS 1289 1.2.1 clause 6.4 (b), 2.1.1, 5.2.1, 5.3.1, 5.4.1					13: RMS T111, T119, T120, T166					
6: AS 1289 1.2.1 clause 6.4 (b),					14: RMS T111, T120, T166, T173					
7: AS 1289 1.2.1 clause 6.4 (b), 2.1.1, 5.2.1, 5.4.1, 5.8.1					15: RMS T120, T119, T162					
8: AS 1289 1.2.1 clause 6.4 (b), 2.1.1., 5.5.1, 5.6.1, 5.8.1					16: RMS T120, T162, T173					
9: Full details of Test Procedure 5.8.1 available on request					17: RMS T120, T164, T173					
Material Description										
1. CL-Clays of low plasticity, gravelly clays, sandy clays, silty clays			11. DGS40			* Cement Stabilised				
2. CI-Clay of medium plasticity, gravelly clays, sandy clays, silty clays			12. FCR20			# Lime Stabilised				
3. CH-Clays of high plasticity			13. FCR40			\$ Gypsum Stabilised				
4. SC-Clayey sands, sand-clay mixtures			14. RC - Recycled Concrete							
5. SM-Silty sands, sand-silt mixtures			15. Recycled Roadbase							
6. GC-Clayey gravels, gravel-sand-clay mixtures			16. RSB - Recycled Sub-base							
7. SP-Sand, crushed dust, filling sand, washed sand			17. CSS - Crushed Sandstone							
8. DGB20			18. RSS - Ripped Sandstone							
9. DGB40			19. Cowels Brown							
10. DGS20										

Form No R 020c Version 01 06/17 - issued by ER



Accreditation Number 2734
Corporate Site Number 2727

Accredited for compliance with
ISO/IEC 17025 - Testing.

A Kench 24/11/2017

Approved Signatory

Head Office:
34 Borec Road, Penrith NSW 2750
P O Box 880 Penrith NSW 2751
Telephone: (02) 4722 21

Prestons Laboratory:
Unit 4, 18-20 Whyalla Place, Prestons NSW 2170
Telephone: (02) 9607 6111 Facsimile: (02) 9607 6200

FIELD DENSITY RESULTS

DARACON CONTRACTORS PTY LTD
PO BOX 299
WALLSEND NSW 2287

Laboratory: Penrith
Job No: 8599/1
Date: 24/11/2017

PROJECT: SITE FILL TESTING - AREA B
RESIDENTIAL DEVELOPMENT.WOORONG PARK, MARSDEN PARK

Page 67 of 79

TEST NUMBER	3774	3775	3776	3777	3778	3779	3780	3781		
DATE TESTED	02/11/2017									
RESULTS										
Hilf Density Ratio	Standard	%	98	96	97	96.5	99	95	98.5	98.5
Moisture Variation from OMC (-Drier/+Wetter)		%	0.0	0.5	0.5	0.0	0.5	0.0	0.0	0.0
Specification	Density Ratio (Standard)	≥95%	Specification			Moisture Variance from OMC			±2%	
TEST LOCATION										
Easting	295499.125	295466.3	295959.339	295913.403	295888.332	295942.221	295991.879	296024.414		
Northing	6268624.197	6268633.234	6268486.476	6268495.872	6268516.705	6268521.307	6268518.146	6268527.022		
Reduced Level	m	23.386	23.121	21.246	19.943	19.318	20.969	21.434	22.183	
Shown on Drawing No	8599/1-62				8599/1-63					
Retested by Test	-	-	-	-	-	-	-	-		
FIELD & LABORATORY DATA										
Field Wet Density	t/m ³	2.09	2.05	2.06	2.07	2.10	2.03	2.10	2.11	
Field Moisture Content	%	17.5	16.5	17.0	16.5	18.0	18.0	17.5	17.5	
Material retained on 19mm Sieve (wet)	%	<5	<5	<5	<5	<5	<5	<5	<5	
Lab Compaction result from test number		3774	3775	3776	3777	3778	3779	3780	3781	
Peak Converted Wet Density	t/m ³	2.13	2.13	2.12	2.14	2.12	2.14	2.13	2.14	
Apparent Optimum Moisture Content	%	17.5	16.0	17.0	16.5	17.5	18.0	17.5	17.5	
Number of Compaction Points		3	3	3	3	3	3	3	3	
Test Procedures - See Note Number		12	12	12	12	12	12	12	12	
Material Description - see below		2	2	2	2	2	2	2	2	
Notes										
1: Assigned Values have been obtained from our Penrith laboratory – Accreditation No 2734					10: AS 1289 1.2.1 clause 6.4 (b), 2.1.1, 5.3.1, 5.5.1, 5.6.1					
2: Assigned Values have been obtained from our Prestons laboratory – Accreditation No 14234					11: AS 1289 1.2.1 clause 6.4 (b), 2.1.1, 5.3.1, 5.7.1					
3: Results have been calculated using infinite decimal places. Therefore, calculated values may vary from those shown					12: AS 1289 1.2.1 clause 6.4 (b), 2.1.1, 5.7.1, 5.8.1					
4: AS 1289 1.2.1 clause 6.4 (b), 2.1.1, 5.1.1, 5.3.1, 5.4.1					13: RMS T111, T119, T120, T166					
5: AS 1289 1.2.1 clause 6.4 (b), 2.1.1, 5.2.1, 5.3.1, 5.4.1					14: RMS T111, T120, T166, T173					
6: AS 1289 1.2.1 clause 6.4 (b),					15: RMS T120, T119, T162					
7: AS 1289 1.2.1 clause 6.4 (b), 2.1.1, 5.2.1, 5.4.1, 5.8.1					16: RMS T120, T162, T173					
8: AS 1289 1.2.1 clause 6.4 (b), 2.1.1., 5.5.1, 5.6.1, 5.8.1					17: RMS T120, T164, T173					
9: Full details of Test Procedure 5.8.1 available on request										
Material Description										
1. CL-Clays of low plasticity, gravelly clays, sandy clays, silty clays			11. DGS40			* Cement Stabilised				
2. CI-Clay of medium plasticity, gravelly clays, sandy clays, silty clays			12. FCR20			# Lime Stabilised				
3. CH-Clays of high plasticity			13. FCR40			\$ Gypsum Stabilised				
4. SC-Clayey sands, sand-clay mixtures			14. RC - Recycled Concrete							
5. SM-Silty sands, sand-silt mixtures			15. Recycled Roadbase							
6. GC-Clayey gravels, gravel-sand-clay mixtures			16. RSB - Recycled Sub-base							
7. SP-Sand, crushed dust, filling sand, washed sand			17. CSS - Crushed Sandstone							
8. DGB20			18. RSS - Ripped Sandstone							
9. DGB40			19. Cowels Brown							
10. DGS20										

Form No R 020c Version 01 06/17 - issued by ER



Accreditation Number 2734
Corporate Site Number 2727

Accredited for compliance with
ISO/IEC 17025 - Testing.

A Kench 24/11/2017

Approved Signatory

Head Office:
34 Borec Road, Penrith NSW 2750
P O Box 880 Penrith NSW 2751
Telephone: (02) 4722 21

Prestons Laboratory:
Unit 4, 18-20 Whyalla Place, Prestons NSW 2170
Telephone: (02) 9607 6111 Facsimile: (02) 9607 6200

FIELD DENSITY RESULTS

DARACON CONTRACTORS PTY LTD
PO BOX 299
WALLSEND NSW 2287

Laboratory: Penrith
Job No: 8599/1
Date: 24/11/2017

PROJECT: SITE FILL TESTING - AREA B
RESIDENTIAL DEVELOPMENT.WOORONG PARK, MARSDEN PARK

Page 68 of 79

TEST NUMBER	3782	3783	3784	3785	3786	3787	3788	3789		
DATE TESTED	02/11/2017									
RESULTS										
Hilf Density Ratio	Standard	%	97.5	96.5	97.5	96.5	98	98	96	96
Moisture Variation from OMC (-Drier/+Wetter)		%	0.0	0.0	0.0	0.0	0.0	0.5	0.0	0.0
Specification	Density Ratio (Standard)	≥95%	Specification				Moisture Variance from OMC			±2%
TEST LOCATION										
Easting	295979.63	295938.707	295891.514	295864.254	295899.871	295941.718	295573.486	295622.531		
Northing	6268536.193	6268542.669	6268550.003	6268559.111	6268571.82	6268574.776	6268628.972	6268629.391		
Reduced Level	m	21.644	20.451	19.382	18.835	19.485	20.046	23.357	23.27	
Shown on Drawing No	8599/1-63						8599/1-62			
Retested by Test	-	-	-	-	-	-	-	-		
FIELD & LABORATORY DATA										
Field Wet Density	t/m ³	2.07	2.05	2.07	2.06	2.08	2.08	2.05	2.05	
Field Moisture Content	%	17.5	17.5	18.0	18.5	18.5	17.0	17.0	17.0	
Material retained on 19mm Sieve (wet)	%	<5	<5	<5	<5	<5	<5	<5	<5	
Lab Compaction result from test number		3782	3783	3784	3785	3786	3787	3788	3789	
Peak Converted Wet Density	t/m ³	2.12	2.12	2.12	2.13	2.12	2.12	2.14	2.13	
Apparent Optimum Moisture Content	%	17.5	17.5	18.0	18.5	18.5	16.5	17.0	17.0	
Number of Compaction Points		3	3	3	3	3	3	3	3	
Test Procedures - See Note Number		12	12	12	12	12	12	12	12	
Material Description - see below		2	2	2	2	2	2	2	2	
Notes										
1: Assigned Values have been obtained from our Penrith laboratory – Accreditation No 2734					10: AS 1289 1.2.1 clause 6.4 (b), 2.1.1, 5.3.1, 5.5.1, 5.6.1					
2: Assigned Values have been obtained from our Prestons laboratory – Accreditation No 14234					11: AS 1289 1.2.1 clause 6.4 (b), 2.1.1, 5.3.1, 5.7.1					
3: Results have been calculated using infinite decimal places. Therefore, calculated values may vary from those shown					12: AS 1289 1.2.1 clause 6.4 (b), 2.1.1, 5.7.1, 5.8.1					
4: AS 1289 1.2.1 clause 6.4 (b), 2.1.1, 5.1.1, 5.3.1, 5.4.1					13: RMS T111, T119, T120, T166					
5: AS 1289 1.2.1 clause 6.4 (b), 2.1.1, 5.2.1, 5.3.1, 5.4.1					14: RMS T111, T120, T166, T173					
6: AS 1289 1.2.1 clause 6.4 (b),					15: RMS T120, T119, T162					
7: AS 1289 1.2.1 clause 6.4 (b), 2.1.1, 5.2.1, 5.4.1, 5.8.1					16: RMS T120, T162, T173					
8: AS 1289 1.2.1 clause 6.4 (b), 2.1.1., 5.5.1, 5.6.1, 5.8.1					17: RMS T120, T164, T173					
9: Full details of Test Procedure 5.8.1 available on request										
Material Description										
1. CL-Clays of low plasticity, gravelly clays, sandy clays, silty clays			11. DGS40			* Cement Stabilised				
2. CI-Clay of medium plasticity, gravelly clays, sandy clays, silty clays			12. FCR20			# Lime Stabilised				
3. CH-Clays of high plasticity			13. FCR40			\$ Gypsum Stabilised				
4. SC-Clayey sands, sand-clay mixtures			14. RC - Recycled Concrete							
5. SM-Silty sands, sand-silt mixtures			15. Recycled Roadbase							
6. GC-Clayey gravels, gravel-sand-clay mixtures			16. RSB - Recycled Sub-base							
7. SP-Sand, crushed dust, filling sand, washed sand			17. CSS - Crushed Sandstone							
8. DGB20			18. RSS - Ripped Sandstone							
9. DGB40			19. Cowels Brown							
10. DGS20										

Form No R 020c Version 01 06/17 - issued by ER



Accreditation Number 2734
Corporate Site Number 2727

Accredited for compliance with
ISO/IEC 17025 - Testing.

A Kench 24/11/2017

Approved Signatory

Head Office:
34 Borec Road, Penrith NSW 2750
P O Box 880 Penrith NSW 2751
Telephone: (02) 4722 21

Prestons Laboratory:
Unit 4, 18-20 Whyalla Place, Prestons NSW 2170
Telephone: (02) 9607 6111 Facsimile: (02) 9607 6200

FIELD DENSITY RESULTS

DARACON CONTRACTORS PTY LTD
PO BOX 299
WALLSEND NSW 2287

Laboratory: Penrith
Job No: 8599/1
Date: 24/11/2017

PROJECT: SITE FILL TESTING - AREA B
RESIDENTIAL DEVELOPMENT.WOORONG PARK, MARSDEN PARK

Page 69 of 79

TEST NUMBER	3790	3791	3792	3793	3794	3795	3796	3797		
DATE TESTED	03/11/2017									
RESULTS										
Hilf Density Ratio	Standard	%	98.5	96.5	97	97	95.5	97	98	96
Moisture Variation from OMC (-Drier/+Wetter)		%	0.0	1.0	0.0	0.0	0.0	0.0	0.0	0.5
Specification	Density Ratio (Standard)	≥95%	Specification				Moisture Variance from OMC			±2%
TEST LOCATION										
Easting	295664.119	295660.93	295622.505	295580.345	295570.007	295606.485	295639.742	295645.657		
Northing	6268628.39	6268609.847	6268611.595	6268612.626	6268590.555	6268588.672	6268584.977	6268566.267		
Reduced Level	m	23.012	22.823	23.552	23.797	23.981	23.796	23.257	23.078	
Shown on Drawing No	8599/1-62									
Retested by Test	-	-	-	-	-	-	-	-		
FIELD & LABORATORY DATA										
Field Wet Density	t/m ³	2.10	2.06	2.08	2.07	2.05	2.06	2.08	2.05	
Field Moisture Content	%	18.0	17.5	17.5	16.5	16.5	17.0	17.5	17.0	
Material retained on 19mm Sieve (wet)	%	<5	<5	<5	<5	<5	<5	<5	<5	
Lab Compaction result from test number		3790	3791	3792	3793	3794	3795	3796	3797	
Peak Converted Wet Density	t/m ³	2.13	2.13	2.14	2.13	2.15	2.12	2.12	2.13	
Apparent Optimum Moisture Content	%	18.0	16.5	17.5	16.5	16.5	17.0	17.5	16.5	
Number of Compaction Points		3	3	3	3	3	3	3	3	
Test Procedures - See Note Number		12	12	12	12	12	12	12	12	
Material Description - see below		2	2	2	2	2	2	2	2	
Notes										
1: Assigned Values have been obtained from our Penrith laboratory – Accreditation No 2734					10: AS 1289 1.2.1 clause 6.4 (b), 2.1.1, 5.3.1, 5.5.1, 5.6.1					
2: Assigned Values have been obtained from our Prestons laboratory – Accreditation No 14234					11: AS 1289 1.2.1 clause 6.4 (b), 2.1.1, 5.3.1, 5.7.1					
3: Results have been calculated using infinite decimal places. Therefore, calculated values may vary from those shown										
4: AS 1289 1.2.1 clause 6.4 (b), 2.1.1, 5.1.1, 5.3.1, 5.4.1					12: AS 1289 1.2.1 clause 6.4 (b), 2.1.1, 5.7.1, 5.8.1					
5: AS 1289 1.2.1 clause 6.4 (b), 2.1.1, 5.2.1, 5.3.1, 5.4.1					13: RMS T111, T119, T120, T166					
6: AS 1289 1.2.1 clause 6.4 (b),					14: RMS T111, T120, T166, T173					
7: AS 1289 1.2.1 clause 6.4 (b), 2.1.1, 5.2.1, 5.4.1, 5.8.1					15: RMS T120, T119, T162					
8: AS 1289 1.2.1 clause 6.4 (b), 2.1.1., 5.5.1, 5.6.1, 5.8.1					16: RMS T120, T162, T173					
9: Full details of Test Procedure 5.8.1 available on request					17: RMS T120, T164, T173					
Material Description										
1. CL-Clays of low plasticity, gravelly clays, sandy clays, silty clays			11. DGS40			* Cement Stabilised				
2. CI-Clay of medium plasticity, gravelly clays, sandy clays, silty clays			12. FCR20			# Lime Stabilised				
3. CH-Clays of high plasticity			13. FCR40			\$ Gypsum Stabilised				
4. SC-Clayey sands, sand-clay mixtures			14. RC - Recycled Concrete							
5. SM-Silty sands, sand-silt mixtures			15. Recycled Roadbase							
6. GC-Clayey gravels, gravel-sand-clay mixtures			16. RSB - Recycled Sub-base							
7. SP-Sand, crushed dust, filling sand, washed sand			17. CSS - Crushed Sandstone							
8. DGB20			18. RSS - Ripped Sandstone							
9. DGB40			19. Cowels Brown							
10. DGS20										

Form No R 020c Version 01 06/17 - issued by ER



Accreditation Number 2734
Corporate Site Number 2727

Accredited for compliance with
ISO/IEC 17025 - Testing.

A Kench 24/11/2017

Approved Signatory

Head Office:
34 Borec Road, Penrith NSW 2750
P O Box 880 Penrith NSW 2751
Telephone: (02) 4722 21

Prestons Laboratory:
Unit 4, 18-20 Whyalla Place, Prestons NSW 2170
Telephone: (02) 9607 6111 Facsimile: (02) 9607 6200

FIELD DENSITY RESULTS

DARACON CONTRACTORS PTY LTD
PO BOX 299
WALLSEND NSW 2287

Laboratory: Penrith
Job No: 8599/1
Date: 24/11/2017

PROJECT: SITE FILL TESTING - AREA B
RESIDENTIAL DEVELOPMENT.WOORONG PARK, MARSDEN PARK

Page 70 of 79

TEST NUMBER	3798	3799	3800	3801	3802	3803	3804	3805		
DATE TESTED	03/11/2017									
RESULTS										
Hilf Density Ratio	Standard	%	96	95.5	96.5	98	96	96	98	98.5
Moisture Variation from OMC (-Drier/+Wetter)		%	0.0	0.0	0.5	0.0	0.0	0.5	0.5	0.0
Specification	Density Ratio (Standard)		≥95%			Specification	Moisture Variance from OMC		±2%	
TEST LOCATION										
Easting	295612.183	295569.1	295524.55	295487.688	295439.692	295398.977	295397.65	295431.52		
Northing	6268568.181	6268574.401	6268580.53	6268584.146	6268587.671	6268588.333	6268605.982	6268599.024		
Reduced Level	m	23.401	23.641	23.478	23.764	23.936	23.822	23.919	24.298	
Shown on Drawing No	8599/1-62									
Retested by Test	-	-	-	-	-	-	-	-		
FIELD & LABORATORY DATA										
Field Wet Density	t/m ³	2.03	2.04	2.05	2.07	2.04	2.05	2.08	2.10	
Field Moisture Content	%	17.5	18.5	18.5	17.0	17.0	17.5	17.0	16.5	
Material retained on 19mm Sieve (wet)	%	<5	<5	<5	<5	<5	<5	<5	<5	
Lab Compaction result from test number		3798	3799	3800	3801	3802	3803	3804	3805	
Peak Converted Wet Density	t/m ³	2.12	2.14	2.12	2.11	2.13	2.13	2.12	2.13	
Apparent Optimum Moisture Content	%	17.0	18.5	18.5	17.0	17.0	17.0	17.0	16.5	
Number of Compaction Points		3	3	3	3	3	3	3	3	
Test Procedures - See Note Number		12	12	12	12	12	12	12	12	
Material Description - see below		2	2	2	2	2	2	2	2	
Notes										
1: Assigned Values have been obtained from our Penrith laboratory – Accreditation No 2734					10: AS 1289 1.2.1 clause 6.4 (b), 2.1.1, 5.3.1, 5.5.1, 5.6.1					
2: Assigned Values have been obtained from our Prestons laboratory – Accreditation No 14234					11: AS 1289 1.2.1 clause 6.4 (b), 2.1.1, 5.3.1, 5.7.1					
3: Results have been calculated using infinite decimal places. Therefore, calculated values may vary from those shown					12: AS 1289 1.2.1 clause 6.4 (b), 2.1.1, 5.7.1, 5.8.1					
4: AS 1289 1.2.1 clause 6.4 (b), 2.1.1, 5.1.1, 5.3.1, 5.4.1					13: RMS T111, T119, T120, T166					
5: AS 1289 1.2.1 clause 6.4 (b), 2.1.1, 5.2.1, 5.3.1, 5.4.1					14: RMS T111, T120, T166, T173					
6: AS 1289 1.2.1 clause 6.4 (b)					15: RMS T120, T119, T162					
7: AS 1289 1.2.1 clause 6.4 (b), 2.1.1, 5.2.1, 5.4.1, 5.8.1					16: RMS T120, T162, T173					
8: AS 1289 1.2.1 clause 6.4 (b), 2.1.1., 5.5.1, 5.6.1, 5.8.1					17: RMS T120, T164, T173					
9: Full details of Test Procedure 5.8.1 available on request										
Material Description										
1. CL-Clays of low plasticity, gravelly clays, sandy clays, silty clays			11. DGS40			* Cement Stabilised				
2. CI-Clay of medium plasticity, gravelly clays, sandy clays, silty clays			12. FCR20			# Lime Stabilised				
3. CH-Clays of high plasticity			13. FCR40			\$ Gypsum Stabilised				
4. SC-Clayey sands, sand-clay mixtures			14. RC - Recycled Concrete							
5. SM-Silty sands, sand-silt mixtures			15. Recycled Roadbase							
6. GC-Clayey gravels, gravel-sand-clay mixtures			16. RSB - Recycled Sub-base							
7. SP-Sand, crushed dust, filling sand, washed sand			17. CSS - Crushed Sandstone							
8. DGB20			18. RSS - Ripped Sandstone							
9. DGB40			19. Cowels Brown							
10. DGS20										

Form No R 020c Version 01 06/17 - issued by ER



Accreditation Number 2734
Corporate Site Number 2727

Accredited for compliance with
ISO/IEC 17025 - Testing.

A Kench 24/11/2017

Approved Signatory

Head Office:
34 Borec Road, Penrith NSW 2750
P O Box 880 Penrith NSW 2751
Telephone: (02) 4722 21

Prestons Laboratory:
Unit 4, 18-20 Whyalla Place, Prestons NSW 2170
Telephone: (02) 9607 6111 Facsimile: (02) 9607 6200

FIELD DENSITY RESULTS

DARACON CONTRACTORS PTY LTD
PO BOX 299
WALLSEND NSW 2287

Laboratory: Penrith
Job No: 8599/1
Date: 24/11/2017

PROJECT: SITE FILL TESTING - AREA B
RESIDENTIAL DEVELOPMENT.WOORONG PARK, MARSDEN PARK

Page 71 of 79

TEST NUMBER	3806	3807	3808	3809	3810	3811	3812	3813		
DATE TESTED	03/11/2017									
RESULTS										
Hilf Density Ratio	Standard	%	96.5	96.5	96.5	95	99.5	97.5	96.5	97
Moisture Variation from OMC (-Drier/+Wetter)		%	0.0	0.5	0.0	0.0	0.5	0.0	0.5	0.5
Specification	Density Ratio (Standard)		≥95%				Specification Moisture Variance from OMC	±2%		
TEST LOCATION										
Easting	295480.073	295512.181	295210.767	295192.426	295209.128	295231.399	295253.893	295264.134		
Northing	6268597.285	6268596.34	6269121.079	6269095.385	6269087.139	6269108.244	6269106.102	6269082.867		
Reduced Level	m		24.117	23.74	15.774	16.295	16.901	16.803	16.985	17.81
Shown on Drawing No	8599/1-62				8599/1-59					
Retested by Test	-	-	-	-	-	-	-	-		
FIELD & LABORATORY DATA										
Field Wet Density	t/m ³	2.07	2.06	2.06	2.03	2.11	2.07	2.06	2.06	
Field Moisture Content	%	17.0	17.0	16.0	16.0	18.5	17.5	18.5	17.5	
Material retained on 19mm Sieve (wet)	%	<5	<5	<5	<5	<5	<5	<5	<5	
Lab Compaction result from test number		3806	3807	3808	3809	3810	3811	3812	3813	
Peak Converted Wet Density	t/m ³	2.14	2.13	2.13	2.14	2.12	2.12	2.13	2.12	
Apparent Optimum Moisture Content	%	16.5	16.5	16.0	16.0	18.0	17.5	18.0	17.0	
Number of Compaction Points		3	3	3	3	3	3	3	3	
Test Procedures - See Note Number		12	12	12	12	12	12	12	12	
Material Description - see below		2	2	2	2	2	2	2	2	
Notes										
1: Assigned Values have been obtained from our Penrith laboratory – Accreditation No 2734					10: AS 1289 1.2.1 clause 6.4 (b), 2.1.1, 5.3.1, 5.5.1, 5.6.1					
2: Assigned Values have been obtained from our Prestons laboratory – Accreditation No 14234					11: AS 1289 1.2.1 clause 6.4 (b), 2.1.1, 5.3.1, 5.7.1					
3: Results have been calculated using infinite decimal places. Therefore, calculated values may vary from those shown										
4: AS 1289 1.2.1 clause 6.4 (b), 2.1.1, 5.1.1, 5.3.1, 5.4.1					12: AS 1289 1.2.1 clause 6.4 (b), 2.1.1, 5.7.1, 5.8.1					
5: AS 1289 1.2.1 clause 6.4 (b), 2.1.1, 5.2.1, 5.3.1, 5.4.1					13: RMS T111, T119, T120, T166					
6: AS 1289 1.2.1 clause 6.4 (b)					14: RMS T111, T120, T166, T173					
7: AS 1289 1.2.1 clause 6.4 (b), 2.1.1, 5.2.1, 5.4.1, 5.8.1					15: RMS T120, T119, T162					
8: AS 1289 1.2.1 clause 6.4 (b), 2.1.1., 5.5.1, 5.6.1, 5.8.1					16: RMS T120, T162, T173					
9: Full details of Test Procedure 5.8.1 available on request					17: RMS T120, T164, T173					
Material Description										
1. CL-Clays of low plasticity, gravelly clays, sandy clays, silty clays			11. DGS40			* Cement Stabilised				
2. CI-Clay of medium plasticity, gravelly clays, sandy clays, silty clays			12. FCR20			# Lime Stabilised				
3. CH-Clays of high plasticity			13. FCR40			\$ Gypsum Stabilised				
4. SC-Clayey sands, sand-clay mixtures			14. RC - Recycled Concrete							
5. SM-Silty sands, sand-silt mixtures			15. Recycled Roadbase							
6. GC-Clayey gravels, gravel-sand-clay mixtures			16. RSB - Recycled Sub-base							
7. SP-Sand, crushed dust, filling sand, washed sand			17. CSS - Crushed Sandstone							
8. DGB20			18. RSS - Ripped Sandstone							
9. DGB40			19. Cowels Brown							
10. DGS20										

Form No R 020c Version 01 06/17 - issued by ER



Accreditation Number 2734
Corporate Site Number 2727

Accredited for compliance with
ISO/IEC 17025 - Testing.

A Kench 24/11/2017

Approved Signatory

Head Office:
34 Borec Road, Penrith NSW 2750
P O Box 880 Penrith NSW 2751
Telephone: (02) 4722 21

Prestons Laboratory:
Unit 4, 18-20 Whyalla Place, Prestons NSW 2170
Telephone: (02) 9607 6111 Facsimile: (02) 9607 6200

FIELD DENSITY RESULTS

DARACON CONTRACTORS PTY LTD
PO BOX 299
WALLSEND NSW 2287

Laboratory: Penrith
Job No: 8599/1
Date: 24/11/2017

PROJECT: SITE FILL TESTING - AREA B
RESIDENTIAL DEVELOPMENT.WOORONG PARK, MARSDEN PARK

Page 72 of 79

TEST NUMBER	3814	3815	3816	3817	3818	3819	3820	3821		
DATE TESTED	03/11/2017			09/11/2017						
RESULTS										
Hiif Density Ratio	Standard	%	97	98	99.5	99.5	96.5	96.5	98.5	96.5
Moisture Variation from OMC (-Drier/+Wetter)		%	0.0	0.5	0.0	0.0	0.0	1.0	-0.5	0.0
Specification	Density Ratio (Standard)	≥95%	Specification				Moisture Variance from OMC			±2%
TEST LOCATION										
Easting	295424.541	295450.123	295486.156	295511.034	295493.11	295462.612	295430.362	295401.979		
Northing	6269576.868	6269601.996	6269642.978	6269669.666	6269680.32	6269649.921	6269614.435	6269579.604		
Reduced Level	m	12.407	12.647	12.387	12.339	12.322	12.498	12.304	12.408	
Shown on Drawing No	8599/1-58			8599/1-57			8599/1-58			
Retested by Test	-	-	-	-	-	-	-	-		
FIELD & LABORATORY DATA										
Field Wet Density	t/m ³	2.08	2.07	2.12	2.09	2.06	2.05	2.10	2.04	
Field Moisture Content	%	18.5	17.5	19.5	20.0	19.5	19.5	19.5	20.0	
Material retained on 19mm Sieve (wet)	%	<5	<5	<5	<5	<5	<5	<5	<5	
Lab Compaction result from test number		3814	3815	3816	3817	3818	3819	3820	3821	
Peak Converted Wet Density	t/m ³	2.14	2.11	2.13	2.10	2.13	2.12	2.13	2.11	
Apparent Optimum Moisture Content	%	18.5	17.0	19.5	20.0	19.5	18.5	20.0	20.0	
Number of Compaction Points		3	3	3	3	3	3	3	3	
Test Procedures - See Note Number		12	12	12	12	12	12	12	12	
Material Description - see below		2	2	2-3	2-3	2-3	2-3	2-3	2-3	
Notes										
1: Assigned Values have been obtained from our Penrith laboratory – Accreditation No 2734					10: AS 1289 1.2.1 clause 6.4 (b), 2.1.1, 5.3.1, 5.5.1, 5.6.1					
2: Assigned Values have been obtained from our Prestons laboratory – Accreditation No 14234					11: AS 1289 1.2.1 clause 6.4 (b), 2.1.1, 5.3.1, 5.7.1					
3: Results have been calculated using infinite decimal places. Therefore, calculated values may vary from those shown					12: AS 1289 1.2.1 clause 6.4 (b), 2.1.1, 5.7.1, 5.8.1					
4: AS 1289 1.2.1 clause 6.4 (b), 2.1.1, 5.1.1, 5.3.1, 5.4.1					13: RMS T111, T119, T120, T166					
5: AS 1289 1.2.1 clause 6.4 (b), 2.1.1, 5.2.1, 5.3.1, 5.4.1					14: RMS T111, T120, T166, T173					
6: AS 1289 1.2.1 clause 6.4 (b),					15: RMS T120, T119, T162					
7: AS 1289 1.2.1 clause 6.4 (b), 2.1.1, 5.2.1, 5.4.1, 5.8.1					16: RMS T120, T162, T173					
8: AS 1289 1.2.1 clause 6.4 (b), 2.1.1., 5.5.1, 5.6.1, 5.8.1					17: RMS T120, T164, T173					
9: Full details of Test Procedure 5.8.1 available on request										
Material Description										
1. CL-Clays of low plasticity, gravelly clays, sandy clays, silty clays			11. DGS40			* Cement Stabilised				
2. CI-Clay of medium plasticity, gravelly clays, sandy clays, silty clays			12. FCR20			# Lime Stabilised				
3. CH-Clays of high plasticity			13. FCR40			\$ Gypsum Stabilised				
4. SC-Clayey sands, sand-clay mixtures			14. RC - Recycled Concrete							
5. SM-Silty sands, sand-silt mixtures			15. Recycled Roadbase							
6. GC-Clayey gravels, gravel-sand-clay mixtures			16. RSB - Recycled Sub-base							
7. SP-Sand, crushed dust, filling sand, washed sand			17. CSS - Crushed Sandstone							
8. DGB20			18. RSS - Ripped Sandstone							
9. DGB40			19. Cowels Brown							
10. DGS20										

Form No R 020c Version 01 06/17 - issued by ER



Accreditation Number 2734
Corporate Site Number 2727

Accredited for compliance with
ISO/IEC 17025 - Testing.

A Kench 24/11/2017

Approved Signatory

Head Office:
34 Borec Road, Penrith NSW 2750
P O Box 880 Penrith NSW 2751
Telephone: (02) 4722 21

Prestons Laboratory:
Unit 4, 18-20 Whyalla Place, Prestons NSW 2170
Telephone: (02) 9607 6111 Facsimile: (02) 9607 6200

FIELD DENSITY RESULTS

DARACON CONTRACTORS PTY LTD
PO BOX 299
WALLSEND NSW 2287

Laboratory: Penrith
Job No: 8599/1
Date: 24/11/2017

PROJECT: SITE FILL TESTING - AREA B
RESIDENTIAL DEVELOPMENT.WOORONG PARK, MARSDEN PARK

Page 73 of 79

TEST NUMBER	3822	3823	3824	3825	3826	3827	3828	3829		
DATE TESTED	09/11/2017									
RESULTS										
Hiif Density Ratio	Standard	%	98.5	98	97	96	96.5	96.5	99	97.5
Moisture Variation from OMC (-Drier/+Wetter)		%	-0.5	0.5	0.0	0.0	0.5	0.0	0.0	0.0
Specification	Density Ratio (Standard)	≥95%	Specification				Moisture Variance from OMC			±2%
TEST LOCATION										
Easting	295388.05	295424.921	295464.959	295494.851	295590.301	295609.481	295629.048	295645.186		
Northing	6269596.59	6269639.512	6269680.66	6269709.551	6269623.495	6269650.23	6269686.027	6269718.382		
Reduced Level	m									
Shown on Drawing No	12.026	12.25	12.557	12.123	17.95	17.922	17.651	17.105		
Retested by Test	8599/1-58				8599/1-57					
	-	-	-	-	-	-	-	-		
FIELD & LABORATORY DATA										
Field Wet Density	t/m ³									
Field Moisture Content	2.08	2.07	2.05	2.04	2.04	2.05	2.10	2.06		
Material retained on 19mm Sieve (wet)	%									
Lab Compaction result from test number	18.5	18.5	19.0	19.0	19.5	20.0	18.0	20.0		
Peak Converted Wet Density	<5	<5	<5	<5	<5	<5	<5	<5		
Apparent Optimum Moisture Content	3822	3823	3824	3825	3826	3827	3828	3829		
Number of Compaction Points	t/m ³									
Test Procedures - See Note Number	2.11	2.11	2.11	2.13	2.11	2.12	2.12	2.11		
Material Description - see below	%									
	19.0	18.0	19.0	18.5	19.0	20.0	17.5	19.5		
	3	3	3	3	3	3	3	3		
	12	12	12	12	12	12	12	12		
	2-3	2	2-3	2-3	2-3	2-3	2	2-3		
Notes										
1: Assigned Values have been obtained from our Penrith laboratory – Accreditation No 2734					10: AS 1289 1.2.1 clause 6.4 (b), 2.1.1, 5.3.1, 5.5.1, 5.6.1					
2: Assigned Values have been obtained from our Prestons laboratory – Accreditation No 14234					11: AS 1289 1.2.1 clause 6.4 (b), 2.1.1, 5.3.1, 5.7.1					
3: Results have been calculated using infinite decimal places. Therefore, calculated values may vary from those shown					12: AS 1289 1.2.1 clause 6.4 (b), 2.1.1, 5.7.1, 5.8.1					
4: AS 1289 1.2.1 clause 6.4 (b), 2.1.1, 5.1.1, 5.3.1, 5.4.1					13: RMS T111, T119, T120, T166					
5: AS 1289 1.2.1 clause 6.4 (b), 2.1.1, 5.2.1, 5.3.1, 5.4.1					14: RMS T111, T120, T166, T173					
6: AS 1289 1.2.1 clause 6.4 (b)					15: RMS T120, T119, T162					
7: AS 1289 1.2.1 clause 6.4 (b), 2.1.1, 5.2.1, 5.4.1, 5.8.1					16: RMS T120, T162, T173					
8: AS 1289 1.2.1 clause 6.4 (b), 2.1.1., 5.5.1, 5.6.1, 5.8.1					17: RMS T120, T164, T173					
9: Full details of Test Procedure 5.8.1 available on request										
Material Description										
1. CL-Clays of low plasticity, gravelly clays, sandy clays, silty clays			11. DGS40			* Cement Stabilised				
2. CI-Clay of medium plasticity, gravelly clays, sandy clays, silty clays			12. FCR20			# Lime Stabilised				
3. CH-Clays of high plasticity			13. FCR40			\$ Gypsum Stabilised				
4. SC-Clayey sands, sand-clay mixtures			14. RC - Recycled Concrete							
5. SM-Silty sands, sand-silt mixtures			15. Recycled Roadbase							
6. GC-Clayey gravels, gravel-sand-clay mixtures			16. RSB - Recycled Sub-base							
7. SP-Sand, crushed dust, filling sand, washed sand			17. CSS - Crushed Sandstone							
8. DGB20			18. RSS - Ripped Sandstone							
9. DGB40			19. Cowels Brown							
10. DGS20										

Form No R 020c Version 01 06/17 - issued by ER



Accreditation Number 2734
Corporate Site Number 2727

Accredited for compliance with
ISO/IEC 17025 - Testing.

A Kench 24/11/2017

Approved Signatory

Head Office:
34 Borec Road, Penrith NSW 2750
P O Box 880 Penrith NSW 2751
Telephone: (02) 4722 21

Prestons Laboratory:
Unit 4, 18-20 Whyalla Place, Prestons NSW 2170
Telephone: (02) 9607 6111 Facsimile: (02) 9607 6200

FIELD DENSITY RESULTS

DARACON CONTRACTORS PTY LTD
PO BOX 299
WALLSEND NSW 2287

Laboratory: Penrith
Job No: 8599/1
Date: 24/11/2017

PROJECT: SITE FILL TESTING - AREA B
RESIDENTIAL DEVELOPMENT.WOORONG PARK, MARSDEN PARK

Page 74 of 79

TEST NUMBER	3830	3831	3832	3833	3834	3835	3836	3837		
DATE TESTED	09/11/2017									
RESULTS										
Hilf Density Ratio	Standard	%	98.5	97	98	97.5	96	96.5	97.5	97
Moisture Variation from OMC (-Drier/+Wetter)		%	0.0	0.0	0.0	0.0	0.0	0.5	0.0	0.0
Specification	Density Ratio (Standard)	≥95%	Specification				Moisture Variance from OMC			±2%
TEST LOCATION										
Easting	295667.138	295700.215	295704.441	295680.616	295664.478	295645.285	295625.1	295656.689		
Northing	6269762.881	6269815.722	6269791.482	6269742.553	6269711.069	6269680.77	6269635.769	6269632.134		
Reduced Level	m		16.032	16.117	16.506	16.948	17.683	18.187	18.489	18.81
Shown on Drawing No	8599/1-57				8599/1-57					
Retested by Test	-	-	-	-	-	-	-	-		
FIELD & LABORATORY DATA										
Field Wet Density	t/m ³	2.09	2.07	2.07	2.08	2.03	2.04	2.07	2.05	
Field Moisture Content	%	22.0	19.5	18.0	18.5	22.5	21.0	20.0	20.0	
Material retained on 19mm Sieve (wet)	%	<5	<5	<5	<5	<5	<5	<5	<5	
Lab Compaction result from test number		3830	3831	3832	3833	3834	3835	3836	3837	
Peak Converted Wet Density	t/m ³	2.12	2.13	2.11	2.13	2.12	2.11	2.12	2.11	
Apparent Optimum Moisture Content	%	21.5	19.5	18.0	18.5	22.5	20.5	20.0	20.0	
Number of Compaction Points		3	3	3	3	3	3	3	3	
Test Procedures - See Note Number		12	12	12	12	12	12	12	12	
Material Description - see below		3	2-3	2	2	3	2-3	2-3	2-3	
Notes										
1: Assigned Values have been obtained from our Penrith laboratory – Accreditation No 2734					10: AS 1289 1.2.1 clause 6.4 (b), 2.1.1, 5.3.1, 5.5.1, 5.6.1					
2: Assigned Values have been obtained from our Prestons laboratory – Accreditation No 14234					11: AS 1289 1.2.1 clause 6.4 (b), 2.1.1, 5.3.1, 5.7.1					
3: Results have been calculated using infinite decimal places. Therefore, calculated values may vary from those shown					12: AS 1289 1.2.1 clause 6.4 (b), 2.1.1, 5.7.1, 5.8.1					
4: AS 1289 1.2.1 clause 6.4 (b), 2.1.1, 5.1.1, 5.3.1, 5.4.1					13: RMS T111, T119, T120, T166					
5: AS 1289 1.2.1 clause 6.4 (b), 2.1.1, 5.2.1, 5.3.1, 5.4.1					14: RMS T111, T120, T166, T173					
6: AS 1289 1.2.1 clause 6.4 (b),					15: RMS T120, T119, T162					
7: AS 1289 1.2.1 clause 6.4 (b), 2.1.1, 5.2.1, 5.4.1, 5.8.1					16: RMS T120, T162, T173					
8: AS 1289 1.2.1 clause 6.4 (b), 2.1.1., 5.5.1, 5.6.1, 5.8.1					17: RMS T120, T164, T173					
9: Full details of Test Procedure 5.8.1 available on request										
Material Description										
1. CL-Clays of low plasticity, gravelly clays, sandy clays, silty clays			11. DGS40			* Cement Stabilised				
2. CI-Clay of medium plasticity, gravelly clays, sandy clays, silty clays			12. FCR20			# Lime Stabilised				
3. CH-Clays of high plasticity			13. FCR40			\$ Gypsum Stabilised				
4. SC-Clayey sands, sand-clay mixtures			14. RC - Recycled Concrete							
5. SM-Silty sands, sand-silt mixtures			15. Recycled Roadbase							
6. GC-Clayey gravels, gravel-sand-clay mixtures			16. RSB - Recycled Sub-base							
7. SP-Sand, crushed dust, filling sand, washed sand			17. CSS - Crushed Sandstone							
8. DGB20			18. RSS - Ripped Sandstone							
9. DGB40			19. Cowels Brown							
10. DGS20										

Form No R 020c Version 01 06/17 - issued by ER



Accreditation Number 2734
Corporate Site Number 2727

Accredited for compliance with
ISO/IEC 17025 - Testing.

A Kench 24/11/2017

Approved Signatory

Head Office:
34 Borec Road, Penrith NSW 2750
P O Box 880 Penrith NSW 2751
Telephone: (02) 4722 21

Prestons Laboratory:
Unit 4, 18-20 Whyalla Place, Prestons NSW 2170
Telephone: (02) 9607 6111 Facsimile: (02) 9607 6200

FIELD DENSITY RESULTS

DARACON CONTRACTORS PTY LTD
PO BOX 299
WALLSEND NSW 2287

Laboratory: Penrith
Job No: 8599/1
Date: 24/11/2017

PROJECT: SITE FILL TESTING - AREA B
RESIDENTIAL DEVELOPMENT.WOORONG PARK, MARSDEN PARK

Page 75 of 79

TEST NUMBER	3838	3839	3840	3841	3842	3843	3844	3845		
DATE TESTED	09/11/2017									
RESULTS										
Hilf Density Ratio	Standard	%	97	98.5	98	98.5	98	96	96	98
Moisture Variation from OMC (-Drier/+Wetter)		%	-0.5	0.0	0.0	0.0	0.5	0.0	0.0	0.0
Specification	Density Ratio (Standard)		≥95%			Specification	Moisture Variance from OMC		±2%	
TEST LOCATION										
Easting	295695.502	295724.441	295757.051	295774.053	295738.526	295752.195	295673.958	295652.646		
Northing	6269680.916	6269725.745	6269779.939	6269761.505	6269712.455	6269707.856	6269813.356	6269783.208		
Reduced Level	m	18.606	17.901	17.547	18.056	18.463	18.675	15.654	15.449	
Shown on Drawing No	8599/1-56									
Retested by Test	-	-	-	-	-	-	-	-	-	
FIELD & LABORATORY DATA										
Field Wet Density	t/m ³	2.07	2.09	2.09	2.08	2.07	2.04	2.04	2.07	
Field Moisture Content	%	20.0	20.5	22.0	20.0	20.5	20.5	19.5	19.5	
Material retained on 19mm Sieve (wet)	%	<5	<5	<5	<5	<5	<5	<5	<5	
Lab Compaction result from test number		3838	3839	3840	3841	3842	3843	3844	3845	
Peak Converted Wet Density	t/m ³	2.13	2.12	2.13	2.11	2.11	2.12	2.12	2.11	
Apparent Optimum Moisture Content	%	20.5	20.5	22.0	20.0	20.0	20.5	19.5	19.0	
Number of Compaction Points		3	3	3	3	3	3	3	3	
Test Procedures - See Note Number		12	12	12	12	12	12	12	12	
Material Description - see below		2-3	3	3	2-3	2-3	2-3	2-3	2-3	
Notes										
1: Assigned Values have been obtained from our Penrith laboratory – Accreditation No 2734					10: AS 1289 1.2.1 clause 6.4 (b), 2.1.1, 5.3.1, 5.5.1, 5.6.1					
2: Assigned Values have been obtained from our Prestons laboratory – Accreditation No 14234					11: AS 1289 1.2.1 clause 6.4 (b), 2.1.1, 5.3.1, 5.7.1					
3: Results have been calculated using infinite decimal places. Therefore, calculated values may vary from those shown										
4: AS 1289 1.2.1 clause 6.4 (b), 2.1.1, 5.1.1, 5.3.1, 5.4.1					12: AS 1289 1.2.1 clause 6.4 (b), 2.1.1, 5.7.1, 5.8.1					
5: AS 1289 1.2.1 clause 6.4 (b), 2.1.1, 5.2.1, 5.3.1, 5.4.1					13: RMS T111, T119, T120, T166					
6: AS 1289 1.2.1 clause 6.4 (b),					14: RMS T111, T120, T166, T173					
7: AS 1289 1.2.1 clause 6.4 (b), 2.1.1, 5.2.1, 5.4.1, 5.8.1					15: RMS T120, T119, T162					
8: AS 1289 1.2.1 clause 6.4 (b), 2.1.1., 5.5.1, 5.6.1, 5.8.1					16: RMS T120, T162, T173					
9: Full details of Test Procedure 5.8.1 available on request					17: RMS T120, T164, T173					
Material Description										
1. CL-Clays of low plasticity, gravelly clays, sandy clays, silty clays			11. DGS40			* Cement Stabilised				
2. CI-Clay of medium plasticity, gravelly clays, sandy clays, silty clays			12. FCR20			# Lime Stabilised				
3. CH-Clays of high plasticity			13. FCR40			\$ Gypsum Stabilised				
4. SC-Clayey sands, sand-clay mixtures			14. RC - Recycled Concrete							
5. SM-Silty sands, sand-silt mixtures			15. Recycled Roadbase							
6. GC-Clayey gravels, gravel-sand-clay mixtures			16. RSB - Recycled Sub-base							
7. SP-Sand, crushed dust, filling sand, washed sand			17. CSS - Crushed Sandstone							
8. DGB20			18. RSS - Ripped Sandstone							
9. DGB40			19. Cowels Brown							
10. DGS20										

Form No R 020c Version 01 06/17 - issued by ER



Accreditation Number 2734
Corporate Site Number 2727

Accredited for compliance with
ISO/IEC 17025 - Testing.

A Kench 24/11/2017

Approved Signatory

Head Office:
34 Borec Road, Penrith NSW 2750
P O Box 880 Penrith NSW 2751
Telephone: (02) 4722 21

Prestons Laboratory:
Unit 4, 18-20 Whyalla Place, Prestons NSW 2170
Telephone: (02) 9607 6111 Facsimile: (02) 9607 6200

FIELD DENSITY RESULTS

DARACON CONTRACTORS PTY LTD
PO BOX 299
WALLSEND NSW 2287

Laboratory: Penrith
Job No: 8599/1
Date: 24/11/2017

PROJECT: SITE FILL TESTING - AREA B
RESIDENTIAL DEVELOPMENT.WOORONG PARK, MARSDEN PARK

Page 76 of 79

TEST NUMBER	3846	3847	3848	3849	3850	3851	3852	3853		
DATE TESTED	09/11/2017					10/11/2017				
RESULTS										
Hiif Density Ratio	Standard	%	97.5	98.5	95.5	97	96.5	96.5	96.5	97.5
Moisture Variation from OMC (-Drier/+Wetter)		%	0.5	0.5	0.0	0.0	0.0	0.5	0.5	0.5
Specification	Density Ratio (Standard)	≥95%	Specification Moisture Variance from OMC				±2%			
TEST LOCATION										
Easting	295616.571	295635.406	295664.514	295595.851	295615.177	295635.461	295652.943	295678.963		
Northing	6269729.926	6269780.265	6269830.939	6269640.008	6269676.231	6269724.202	6269760.513	6269803.205		
Reduced Level	m	15.613	15.452	14.636	17.777	17.8	16.964	16.434	16.194	
Shown on Drawing No	8599/1-57							8599/1-56		
Retested by Test	-	-	-	-	-	-	-	-		
FIELD & LABORATORY DATA										
Field Wet Density	t/m ³	2.07	2.09	2.03	2.06	2.04	2.07	2.05	2.07	
Field Moisture Content	%	20.5	20.5	19.5	19.5	20.0	14.0	14.5	15.0	
Material retained on 19mm Sieve (wet)	%	<5	<5	<5	<5	<5	<5	<5	<5	
Lab Compaction result from test number		3846	3847	3848	3849	3850	3851	3852	3853	
Peak Converted Wet Density	t/m ³	2.12	2.12	2.13	2.12	2.11	2.14	2.12	2.12	
Apparent Optimum Moisture Content	%	20.0	20.0	19.5	19.0	20.0	13.5	14.5	14.5	
Number of Compaction Points		3	3	3	3	3	3	3	3	
Test Procedures - See Note Number		12	12	12	12	12	12	12	12	
Material Description - see below		2-3	2-3	2-3	2-3	2-3	1-2	2	2	
Notes										
1: Assigned Values have been obtained from our Penrith laboratory – Accreditation No 2734					10: AS 1289 1.2.1 clause 6.4 (b), 2.1.1, 5.3.1, 5.5.1, 5.6.1					
2: Assigned Values have been obtained from our Prestons laboratory – Accreditation No 14234					11: AS 1289 1.2.1 clause 6.4 (b), 2.1.1, 5.3.1, 5.7.1					
3: Results have been calculated using infinite decimal places. Therefore, calculated values may vary from those shown					12: AS 1289 1.2.1 clause 6.4 (b), 2.1.1, 5.7.1, 5.8.1					
4: AS 1289 1.2.1 clause 6.4 (b), 2.1.1, 5.1.1, 5.3.1, 5.4.1					13: RMS T111, T119, T120, T166					
5: AS 1289 1.2.1 clause 6.4 (b), 2.1.1, 5.2.1, 5.3.1, 5.4.1					14: RMS T111, T120, T166, T173					
6: AS 1289 1.2.1 clause 6.4 (b),					15: RMS T120, T119, T162					
7: AS 1289 1.2.1 clause 6.4 (b), 2.1.1, 5.2.1, 5.4.1, 5.8.1					16: RMS T120, T162, T173					
8: AS 1289 1.2.1 clause 6.4 (b), 2.1.1., 5.5.1, 5.6.1, 5.8.1					17: RMS T120, T164, T173					
9: Full details of Test Procedure 5.8.1 available on request										
Material Description										
1. CL-Clays of low plasticity, gravelly clays, sandy clays, silty clays			11. DGS40			* Cement Stabilised				
2. CI-Clay of medium plasticity, gravelly clays, sandy clays, silty clays			12. FCR20			# Lime Stabilised				
3. CH-Clays of high plasticity			13. FCR40			\$ Gypsum Stabilised				
4. SC-Clayey sands, sand-clay mixtures			14. RC - Recycled Concrete							
5. SM-Silty sands, sand-silt mixtures			15. Recycled Roadbase							
6. GC-Clayey gravels, gravel-sand-clay mixtures			16. RSB - Recycled Sub-base							
7. SP-Sand, crushed dust, filling sand, washed sand			17. CSS - Crushed Sandstone							
8. DGB20			18. RSS - Ripped Sandstone							
9. DGB40			19. Cowels Brown							
10. DGS20										

Form No R 020c Version 01 06/17 - issued by ER



Accreditation Number 2734
Corporate Site Number 2727

Accredited for compliance with
ISO/IEC 17025 - Testing.

A Kench 24/11/2017

Approved Signatory

Head Office:
34 Borec Road, Penrith NSW 2750
P O Box 880 Penrith NSW 2751
Telephone: (02) 4722 21

Prestons Laboratory:
Unit 4, 18-20 Whyalla Place, Prestons NSW 2170
Telephone: (02) 9607 6111 Facsimile: (02) 9607 6200

FIELD DENSITY RESULTS

DARACON CONTRACTORS PTY LTD
PO BOX 299
WALLSEND NSW 2287

Laboratory: Penrith
Job No: 8599/1
Date: 24/11/2017

PROJECT: SITE FILL TESTING - AREA B
RESIDENTIAL DEVELOPMENT.WOORONG PARK, MARSDEN PARK

Page 77 of 79

TEST NUMBER	3854	3855	3856	3857	3858	3859	3860	3861		
DATE TESTED	10/11/2017									
RESULTS										
Hilf Density Ratio	Standard	%	98.5	98	96.5	96	97	98.5	97.5	97.5
Moisture Variation from OMC (-Drier/+Wetter)		%	0.5	0.5	-0.5	0.5	0.0	0.0	0.5	1.0
Specification	Density Ratio (Standard)	≥95%	Specification				Moisture Variance from OMC			±2%
TEST LOCATION										
Easting	295710.159	295692.415	295671.228	295653.526	295633.255	295653.845	295673.974	295698.2		
Northing	6269818.362	6269791.696	6269753.649	6269722.819	6269664.643	6269690.195	6269724.009	6269759.272		
Reduced Level	m	16.266	16.572	16.757	16.982	18.094	18.473	17.408	17.184	
Shown on Drawing No	8599/1-57									
Retested by Test	-	-	-	-	-	-	-	-		
FIELD & LABORATORY DATA										
Field Wet Density	t/m ³	2.09	2.08	2.06	2.05	2.06	2.08	2.07	2.08	
Field Moisture Content	%	15.5	15.5	18.0	15.0	21.5	15.0	12.0	15.5	
Material retained on 19mm Sieve (wet)	%	<5	<5	<5	<5	<5	<5	<5	<5	
Lab Compaction result from test number		3854	3855	3856	3857	3858	3859	3860	3861	
Peak Converted Wet Density	t/m ³	2.12	2.12	2.13	2.13	2.12	2.11	2.12	2.13	
Apparent Optimum Moisture Content	%	14.5	15.0	18.5	14.5	21.5	15.0	11.5	15.0	
Number of Compaction Points		3	3	3	3	3	3	3	3	
Test Procedures - See Note Number		12	12	12	12	12	12	12	12	
Material Description - see below		2	2	2	2	3	2	1	2	
Notes										
1: Assigned Values have been obtained from our Penrith laboratory – Accreditation No 2734					10: AS 1289 1.2.1 clause 6.4 (b), 2.1.1, 5.3.1, 5.5.1, 5.6.1					
2: Assigned Values have been obtained from our Prestons laboratory – Accreditation No 14234					11: AS 1289 1.2.1 clause 6.4 (b), 2.1.1, 5.3.1, 5.7.1					
3: Results have been calculated using infinite decimal places. Therefore, calculated values may vary from those shown										
4: AS 1289 1.2.1 clause 6.4 (b), 2.1.1, 5.1.1, 5.3.1, 5.4.1					12: AS 1289 1.2.1 clause 6.4 (b), 2.1.1, 5.7.1, 5.8.1					
5: AS 1289 1.2.1 clause 6.4 (b), 2.1.1, 5.2.1, 5.3.1, 5.4.1					13: RMS T111, T119, T120, T166					
6: AS 1289 1.2.1 clause 6.4 (b)					14: RMS T111, T120, T166, T173					
7: AS 1289 1.2.1 clause 6.4 (b), 2.1.1, 5.2.1, 5.4.1, 5.8.1					15: RMS T120, T119, T162					
8: AS 1289 1.2.1 clause 6.4 (b), 2.1.1., 5.5.1, 5.6.1, 5.8.1					16: RMS T120, T162, T173					
9: Full details of Test Procedure 5.8.1 available on request					17: RMS T120, T164, T173					
Material Description										
1. CL-Clays of low plasticity, gravelly clays, sandy clays, silty clays			11. DGS40			* Cement Stabilised				
2. CI-Clay of medium plasticity, gravelly clays, sandy clays, silty clays			12. FCR20			# Lime Stabilised				
3. CH-Clays of high plasticity			13. FCR40			\$ Gypsum Stabilised				
4. SC-Clayey sands, sand-clay mixtures			14. RC - Recycled Concrete							
5. SM-Silty sands, sand-silt mixtures			15. Recycled Roadbase							
6. GC-Clayey gravels, gravel-sand-clay mixtures			16. RSB - Recycled Sub-base							
7. SP-Sand, crushed dust, filling sand, washed sand			17. CSS - Crushed Sandstone							
8. DGB20			18. RSS - Ripped Sandstone							
9. DGB40			19. Cowels Brown							
10. DGS20										

Form No R 020c Version 01 06/17 - issued by ER



Accreditation Number 2734
Corporate Site Number 2727

Accredited for compliance with
ISO/IEC 17025 - Testing.

A Kench 24/11/2017

Approved Signatory

Head Office:
34 Borec Road, Penrith NSW 2750
P O Box 880 Penrith NSW 2751
Telephone: (02) 4722 21

Prestons Laboratory:
Unit 4, 18-20 Whyalla Place, Prestons NSW 2170
Telephone: (02) 9607 6111 Facsimile: (02) 9607 6200

FIELD DENSITY RESULTS

DARACON CONTRACTORS PTY LTD
PO BOX 299
WALLSEND NSW 2287

Laboratory: Penrith
Job No: 8599/1
Date: 24/11/2017

PROJECT: SITE FILL TESTING - AREA B
RESIDENTIAL DEVELOPMENT.WOORONG PARK, MARSDEN PARK

Page 78 of 79

TEST NUMBER	3862	3863	3864	3865	3866	3867	3868	3869		
DATE TESTED	10/11/2017									
RESULTS										
Hiif Density Ratio	Standard	%	97	96.5	97.5	99	98.5	98.5	98.5	97.5
Moisture Variation from OMC (-Drier/+Wetter)		%	0.0	0.0	0.5	0.5	0.0	0.0	0.5	0.5
Specification	Density Ratio (Standard)		≥95%			Specification	Moisture Variance from OMC		±2%	
TEST LOCATION										
Easting	295729.354	295740.887	295719.306	295700.596	295669.751	295683.253	295700.996	295723.673		
Northing	6269806.354	6269788.676	6269746.963	6269709.969	6269653.595	6269626.883	6269652.982	6269699.974		
Reduced Level	m 16.85 17.483 17.955 18.148 18.604 18.598 18.903 18.553									
Shown on Drawing No	8599/1-57									
Retested by Test	-	-	-	-	-	-	-	-		
FIELD & LABORATORY DATA										
Field Wet Density	t/m ³	2.05	2.06	2.08	2.09	2.07	2.10	2.09	2.06	
Field Moisture Content	%	15.5	18.5	17.5	19.5	18.5	22.5	22.5	22.5	
Material retained on 19mm Sieve (wet)	%	<5	<5	<5	<5	<5	<5	<5	<5	
Lab Compaction result from test number		3862	3863	3864	3865	3866	3867	3868	3869	
Peak Converted Wet Density	t/m ³	2.11	2.13	2.13	2.11	2.10	2.13	2.12	2.11	
Apparent Optimum Moisture Content	%	15.5	18.5	17.0	19.5	18.5	22.5	22.0	22.0	
Number of Compaction Points		3	3	3	3	3	3	3	3	
Test Procedures - See Note Number		12	12	12	12	12	12	12	12	
Material Description - see below		2	2	2	2-3	2	3	3	3	
Notes										
1: Assigned Values have been obtained from our Penrith laboratory – Accreditation No 2734					10: AS 1289 1.2.1 clause 6.4 (b), 2.1.1, 5.3.1, 5.5.1, 5.6.1					
2: Assigned Values have been obtained from our Prestons laboratory – Accreditation No 14234					11: AS 1289 1.2.1 clause 6.4 (b), 2.1.1, 5.3.1, 5.7.1					
3: Results have been calculated using infinite decimal places. Therefore, calculated values may vary from those shown					12: AS 1289 1.2.1 clause 6.4 (b), 2.1.1, 5.7.1, 5.8.1					
4: AS 1289 1.2.1 clause 6.4 (b), 2.1.1, 5.1.1, 5.3.1, 5.4.1					13: RMS T111, T119, T120, T166					
5: AS 1289 1.2.1 clause 6.4 (b), 2.1.1, 5.2.1, 5.3.1, 5.4.1					14: RMS T111, T120, T166, T173					
6: AS 1289 1.2.1 clause 6.4 (b),					15: RMS T120, T119, T162					
7: AS 1289 1.2.1 clause 6.4 (b), 2.1.1, 5.2.1, 5.4.1, 5.8.1					16: RMS T120, T162, T173					
8: AS 1289 1.2.1 clause 6.4 (b), 2.1.1., 5.5.1, 5.6.1, 5.8.1					17: RMS T120, T164, T173					
9: Full details of Test Procedure 5.8.1 available on request										
Material Description										
1. CL-Clays of low plasticity, gravelly clays, sandy clays, silty clays			11. DGS40			* Cement Stabilised				
2. CI-Clay of medium plasticity, gravelly clays, sandy clays, silty clays			12. FCR20			# Lime Stabilised				
3. CH-Clays of high plasticity			13. FCR40			\$ Gypsum Stabilised				
4. SC-Clayey sands, sand-clay mixtures			14. RC - Recycled Concrete							
5. SM-Silty sands, sand-silt mixtures			15. Recycled Roadbase							
6. GC-Clayey gravels, gravel-sand-clay mixtures			16. RSB - Recycled Sub-base							
7. SP-Sand, crushed dust, filling sand, washed sand			17. CSS - Crushed Sandstone							
8. DGB20			18. RSS - Ripped Sandstone							
9. DGB40			19. Cowels Brown							
10. DGS20										

Form No R 020c Version 01 06/17 - issued by ER



Accreditation Number 2734
Corporate Site Number 2727

Accredited for compliance with
ISO/IEC 17025 - Testing.

A Kench 24/11/2017

Approved Signatory

Head Office:
34 Borec Road, Penrith NSW 2750
P O Box 880 Penrith NSW 2751
Telephone: (02) 4722 21

Prestons Laboratory:
Unit 4, 18-20 Whyalla Place, Prestons NSW 2170
Telephone: (02) 9607 6111 Facsimile: (02) 9607 6200

FIELD DENSITY RESULTS

DARACON CONTRACTORS PTY LTD
PO BOX 299
WALLSEND NSW 2287

Laboratory: Penrith
Job No: 8599/1
Date: 24/11/2017

PROJECT: SITE FILL TESTING - AREA B
RESIDENTIAL DEVELOPMENT.WOORONG PARK, MARSDEN PARK

Page 79 of 79

TEST NUMBER	3870	3871	3872	3873	3874	3875			
DATE TESTED	10/11/2017								
RESULTS									
Hilf Density Ratio	Standard	%	97	96	97.5	98	98	98	
Moisture Variation from OMC (-Drier/+Wetter)		%	0.5	0.0	0.5	0.0	0.5	0.0	
Specification	Density Ratio (Standard)		≥95%			Specification	Moisture Variance from OMC	±2%	
TEST LOCATION									
Easting	295757.334	295782.779	295813.9	295846.422	295520.267	295549.617			
Northing	6269756.135	6269773.908	6269758.051	6269742.702	6269401.04	6269386.018			
Reduced Level	m	18.098	18.481	18.88	19.602	17.19	18.02		
Shown on Drawing No	8599/1-57	8599/1-56			8599/1-58				
Retested by Test	-	-	-	-	-	-			
FIELD & LABORATORY DATA									
Field Wet Density	t/m ³	2.06	2.05	2.06	2.09	2.07	2.09		
Field Moisture Content	%	23.5	17.0	19.5	17.0	15.0	14.5		
Material retained on 19mm Sieve (wet)	%	<5	<5	<5	<5	<5	<5		
Lab Compaction result from test number		3870	3871	3872	3873	3874	3875		
Peak Converted Wet Density	t/m ³	2.12	2.13	2.11	2.13	2.11	2.13		
Apparent Optimum Moisture Content	%	23.0	17.0	19.5	16.5	15.0	14.5		
Number of Compaction Points		3	3	3	3	3	3		
Test Procedures - See Note Number		12	12	12	12	12	12		
Material Description - see below		3	2	2-3	2	2	2		
Notes									
1: Assigned Values have been obtained from our Penrith laboratory – Accreditation No 2734			10: AS 1289 1.2.1 clause 6.4 (b), 2.1.1, 5.3.1, 5.5.1, 5.6.1						
2: Assigned Values have been obtained from our Prestons laboratory – Accreditation No 14234			11: AS 1289 1.2.1 clause 6.4 (b), 2.1.1, 5.3.1, 5.7.1						
3: Results have been calculated using infinite decimal places. Therefore, calculated values may vary from those shown			12: AS 1289 1.2.1 clause 6.4 (b), 2.1.1, 5.7.1, 5.8.1						
4: AS 1289 1.2.1 clause 6.4 (b), 2.1.1, 5.1.1, 5.3.1, 5.4.1			13: RMS T111, T119, T120, T166						
5: AS 1289 1.2.1 clause 6.4 (b), 2.1.1, 5.2.1, 5.3.1, 5.4.1			14: RMS T111, T120, T166, T173						
6: AS 1289 1.2.1 clause 6.4 (b),			15: RMS T120, T119, T162						
7: AS 1289 1.2.1 clause 6.4 (b), 2.1.1, 5.2.1, 5.4.1, 5.8.1			16: RMS T120, T162, T173						
8: AS 1289 1.2.1 clause 6.4 (b), 2.1.1., 5.5.1, 5.6.1, 5.8.1			17: RMS T120, T164, T173						
9: Full details of Test Procedure 5.8.1 available on request									
Material Description									
1. CL-Clays of low plasticity, gravelly clays, sandy clays, silty clays			11. DGS40			* Cement Stabilised			
2. CI-Clay of medium plasticity, gravelly clays, sandy clays, silty clays			12. FCR20			# Lime Stabilised			
3. CH-Clays of high plasticity			13. FCR40			\$ Gypsum Stabilised			
4. SC-Clayey sands, sand-clay mixtures			14. RC - Recycled Concrete						
5. SM-Silty sands, sand-silt mixtures			15. Recycled Roadbase						
6. GC-Clayey gravels, gravel-sand-clay mixtures			16. RSB - Recycled Sub-base						
7. SP-Sand, crushed dust, filling sand, washed sand			17. CSS - Crushed Sandstone						
8. DGB20			18. RSS - Ripped Sandstone						
9. DGB40			19. Cowels Brown						
10. DGS20									

Form No R 020c Version 01 06/17 - issued by ER



Accreditation Number 2734
Corporate Site Number 2727

Accredited for compliance with
ISO/IEC 17025 - Testing.

A Kench 24/11/2017

Approved Signatory

Head Office:
34 Borec Road, Penrith NSW 2750
P O Box 880 Penrith NSW 2751
Telephone: (02) 4722 21

Prestons Laboratory:
Unit 4, 18-20 Whyalla Place, Prestons NSW 2170
Telephone: (02) 9607 6111 Facsimile: (02) 9607 6200



LEGEND

● Density Test



34 Borec Road
Penrith
NSW 2750
ABN 71 076 676 321

Ph: 02 4722 2744
Fx: 02 4722 2777
www.geotech.com.au
e-mail: info@geotech.com.au

NOTES


1. Site features are indicative and are not to scale.
2. This drawing has been produced using a base plan provided by others to which additional information e.g test pits, borehole locations or notes have been added. Some or all of the plan may not be relevant at the time of producing this drawing

Daracon Contractors Pty Ltd
Residential Development
Woorong Park - Area B
Marsden Park

Location of Field Density Tests

Drawing No: 8599/1-56
Job No: 8599/1
Drawn By: MH
Date: 24 November 2017
Checked By: AK

File No: 8599-1
Layers: 0, Lay56

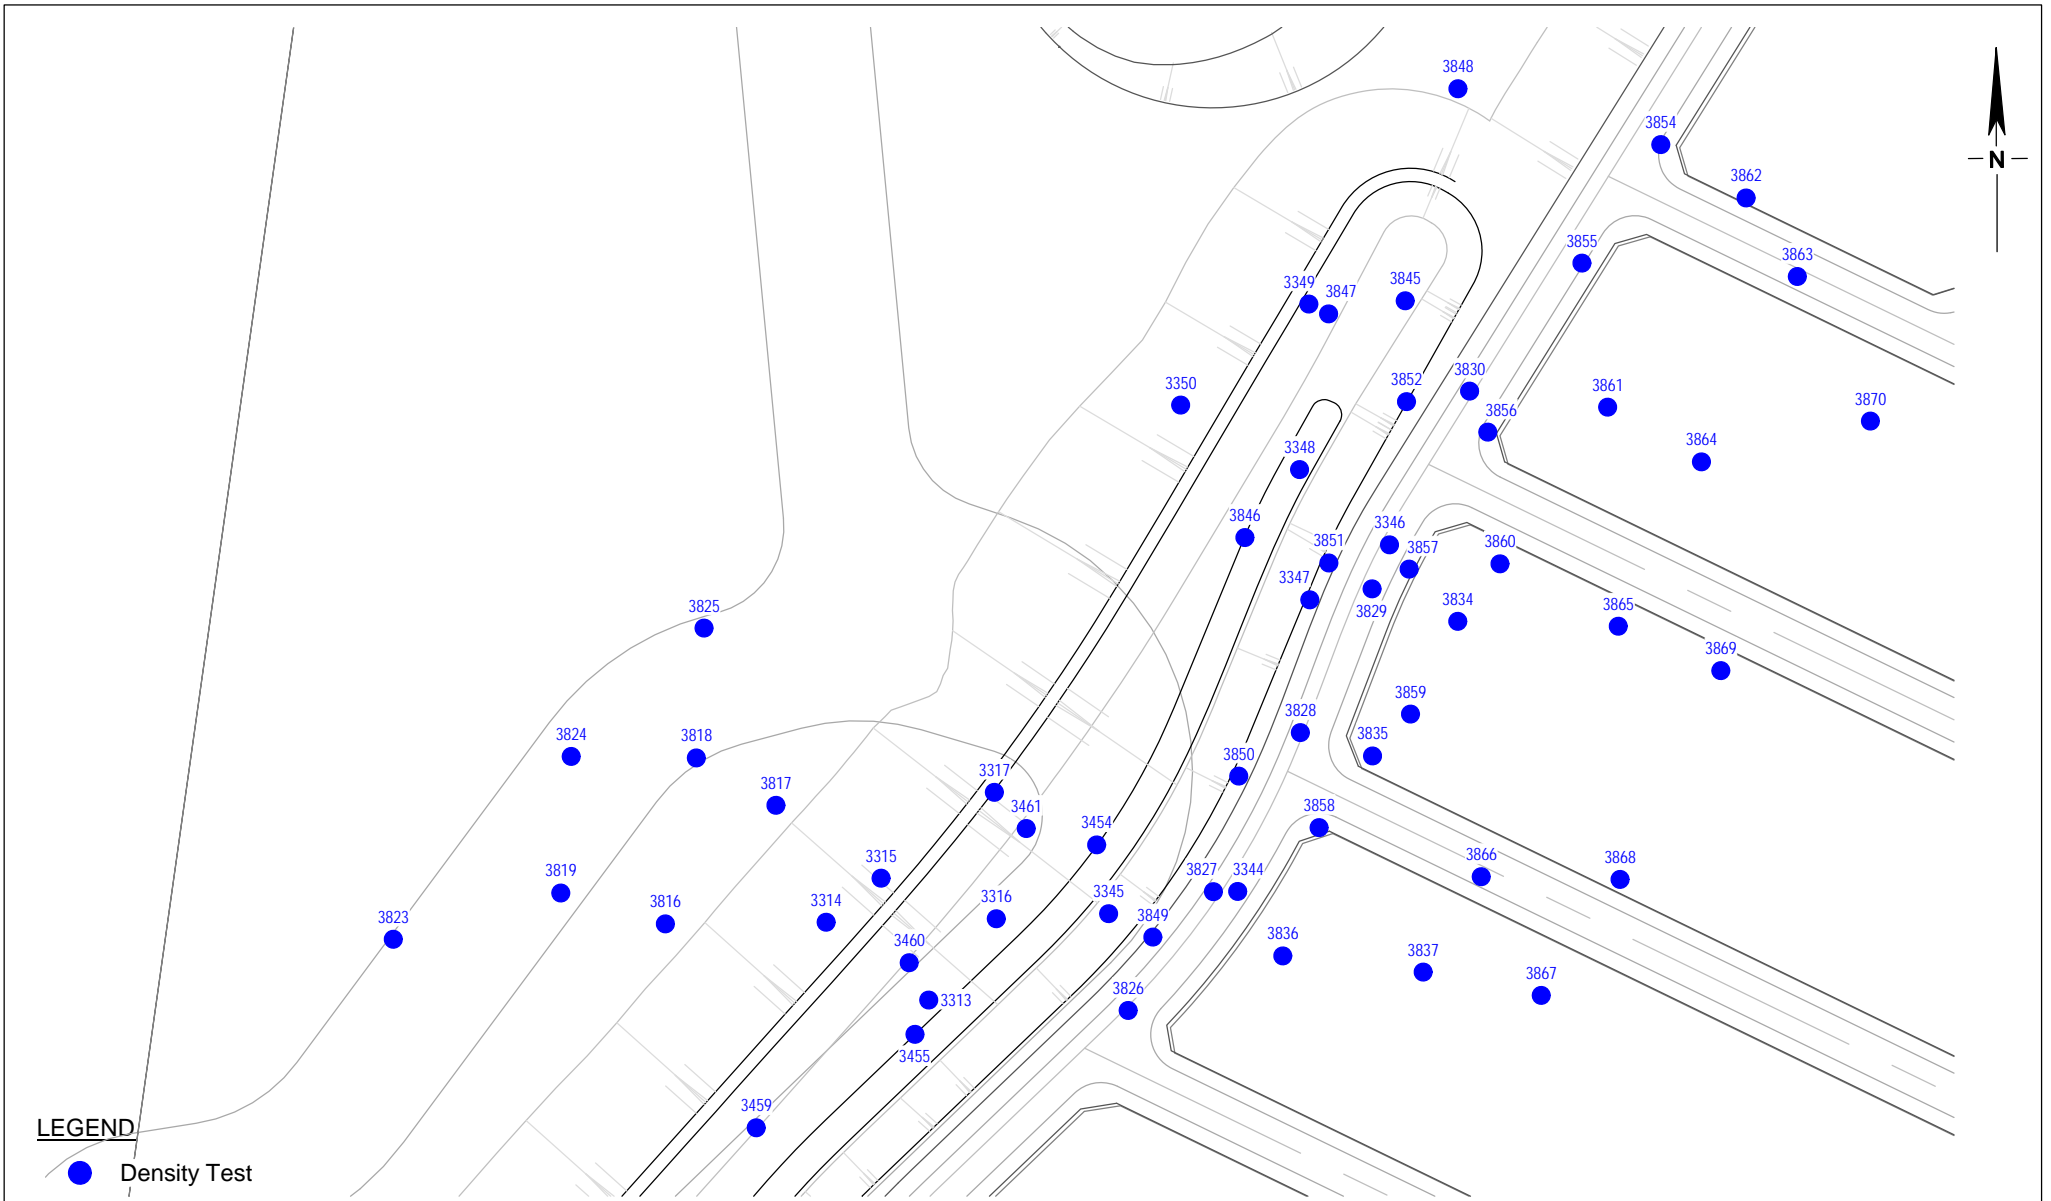

LEGEND

● Density Test



34 Borec Road
 Penrith
 NSW 2750
 ABN 71 076 676 321

Ph: 02 4722 2744
 Fx: 02 4722 2777
 www.geotech.com.au
 e-mail: info@geotech.com.au

NOTES


1. Site features are indicative and are not to scale.
2. This drawing has been produced using a base plan provided by others to which additional information e.g test pits, borehole locations or notes have been added. Some or all of the plan may not be relevant at the time of producing this drawing

**Daracon Contractors Pty Ltd
 Residential Development
 Woorong Park - Area B
 Marsden Park**

Location of Field Density Tests

Drawing No: 8599/1-57
 Job No: 8599/1
 Drawn By: MH
 Date: 24 November 2017
 Checked By: AK

File No: 8599-1
 Layers: 0, Lay57

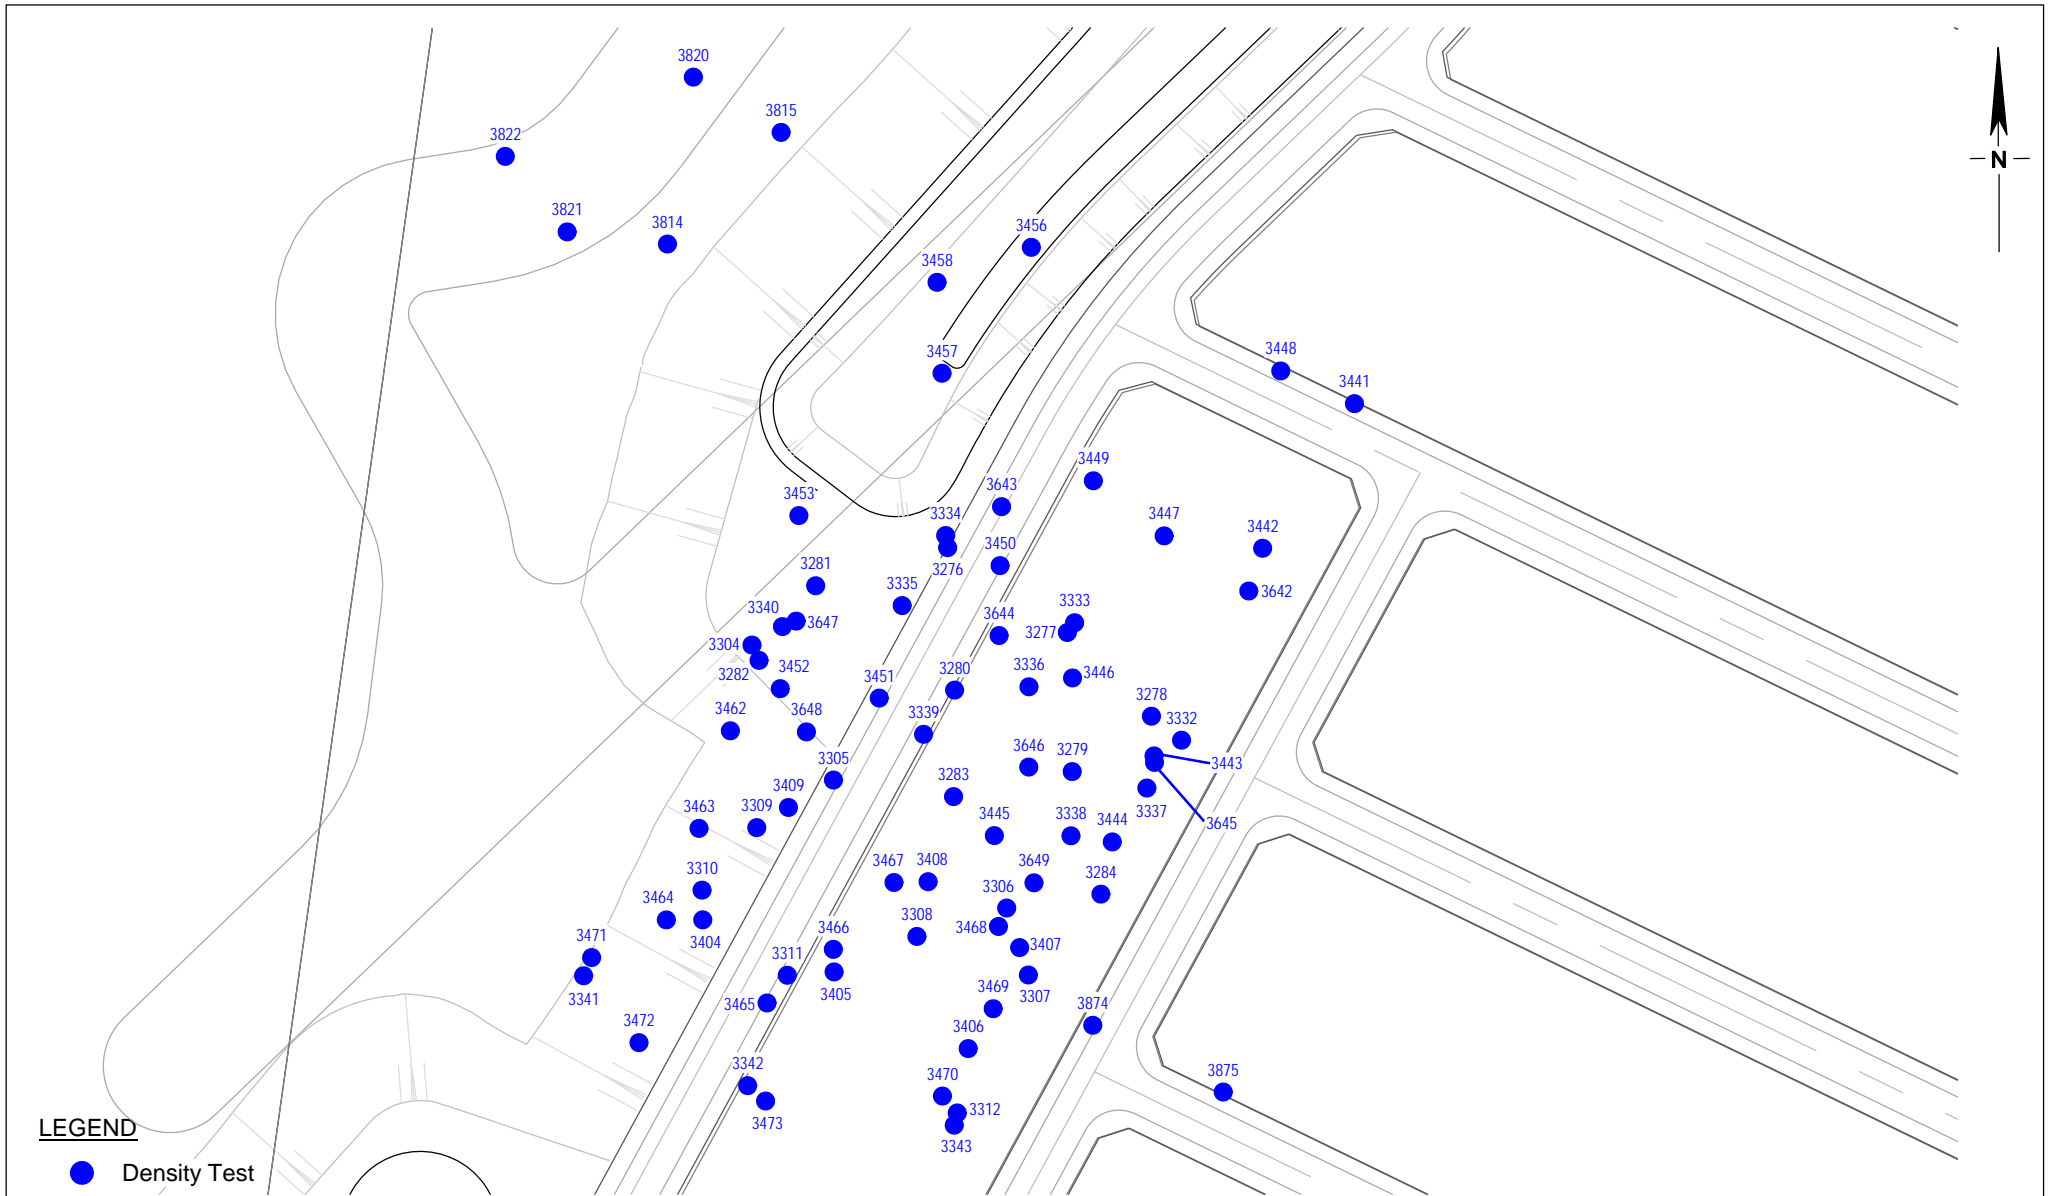

LEGEND

● Density Test



34 Borec Road
Penrith
NSW 2750
ABN 71 076 676 321

Ph: 02 4722 2744
Fx: 02 4722 2777
www.geotech.com.au
e-mail: info@geotech.com.au

NOTES


1. Site features are indicative and are not to scale.
2. This drawing has been produced using a base plan provided by others to which additional information e.g test pits, borehole locations or notes have been added. Some or all of the plan may not be relevant at the time of producing this drawing

Daracon Contractors Pty Ltd
Residential Development
Woorong Park - Area B
Marsden Park

Location of Field Density Tests

Drawing No: 8599/1-58
Job No: 8599/1
Drawn By: MH
Date: 24 November 2017
Checked By: AK

File No: 8599-1
Layers: 0, Lay58

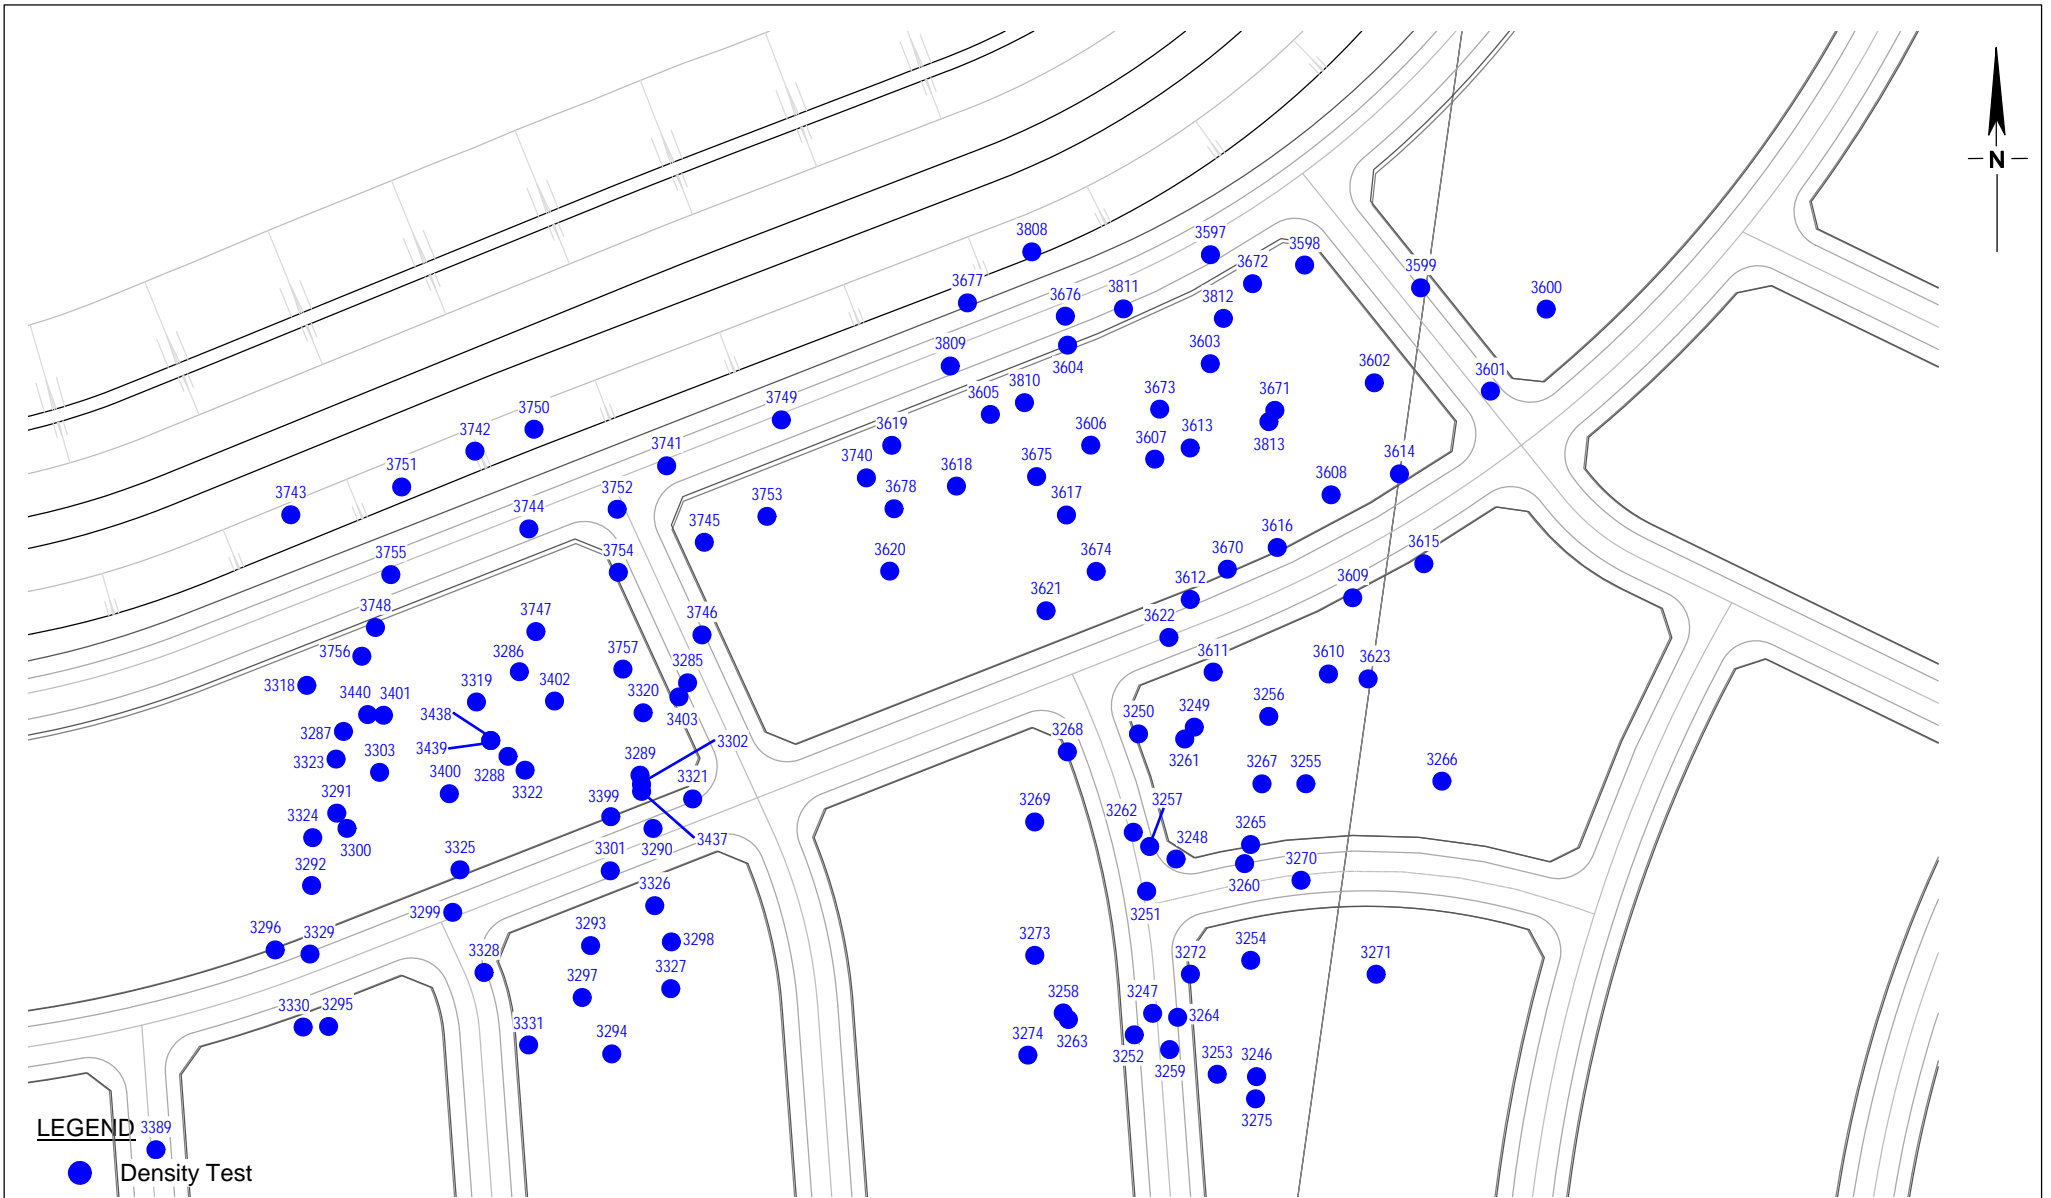

34 Borec Road
 Penrith
 NSW 2750
 ABN 71 076 676 321

Ph: 02 4722 2744
 Fx: 02 4722 2777
 www.geotech.com.au
 e-mail: info@geotech.com.au

NOTES


1. Site features are indicative and are not to scale.
2. This drawing has been produced using a base plan provided by others to which additional information e.g test pits, borehole locations or notes have been added. Some or all of the plan may not be relevant at the time of producing this drawing

Daracon Contractors Pty Ltd
 Residential Development
 Woorong Park - Area B
 Marsden Park

Location of Field Density Tests

Drawing No: 8599/1-59
 Job No: 8599/1
 Drawn By: MH
 Date: 24 November 2017
 Checked By: AK

File No: 8599-1
 Layers: 0, Lay59

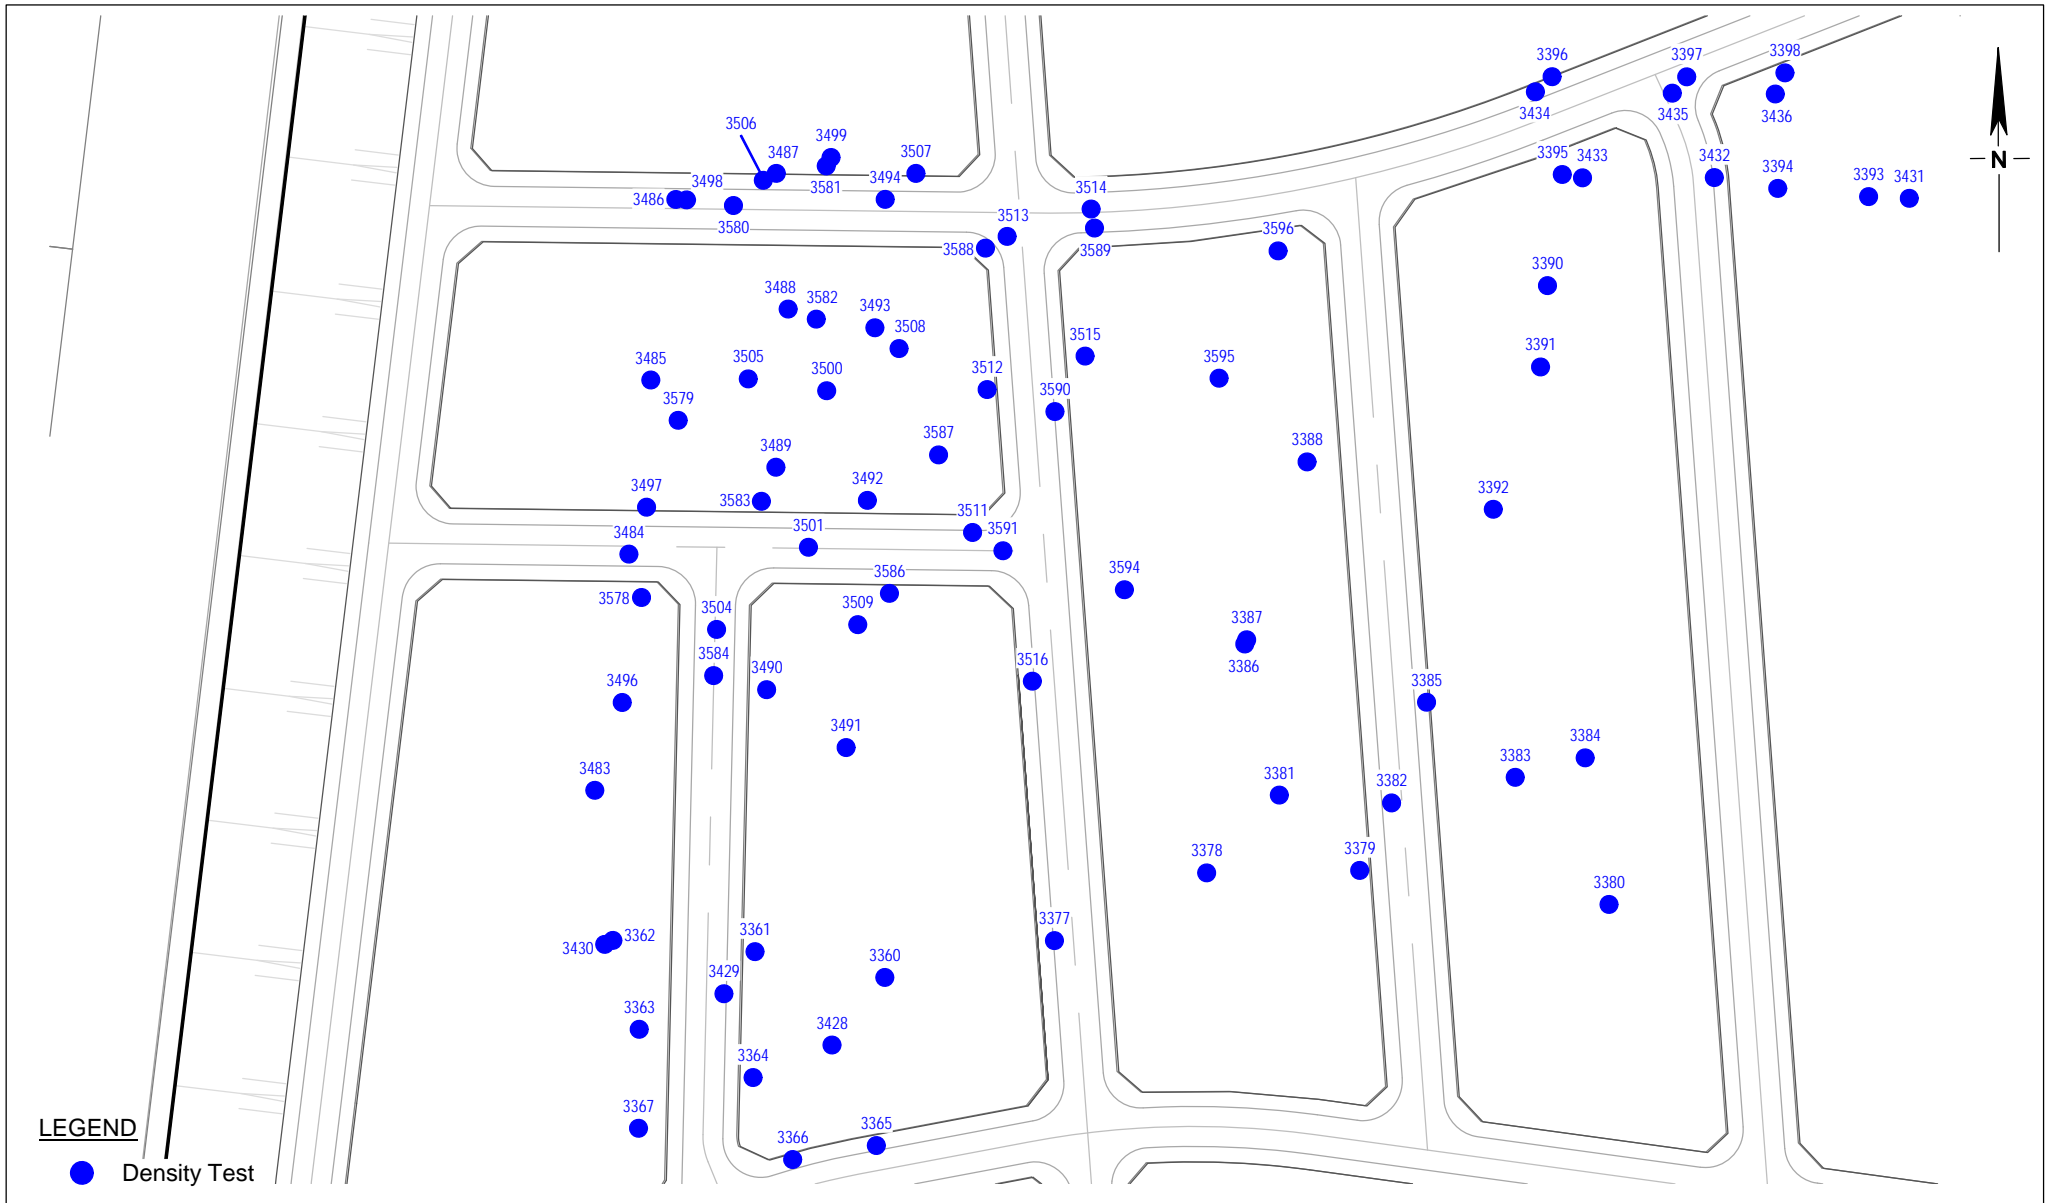

34 Borec Road
 Penrith
 NSW 2750
 ABN 71 076 676 321

Ph: 02 4722 2744
 Fx: 02 4722 2777
 www.geotech.com.au
 e-mail: info@geotech.com.au

NOTES


1. Site features are indicative and are not to scale.
2. This drawing has been produced using a base plan provided by others to which additional information e.g test pits, borehole locations or notes have been added. Some or all of the plan may not be relevant at the time of producing this drawing

Daracon Contractors Pty Ltd
 Residential Development
 Woorong Park - Area B
 Marsden Park

Location of Field Density Tests

Drawing No: 8599/1-60
 Job No: 8599/1
 Drawn By: MH
 Date: 24 November 2017
 Checked By: AK

File No: 8599-1
 Layers: 0, Lay60

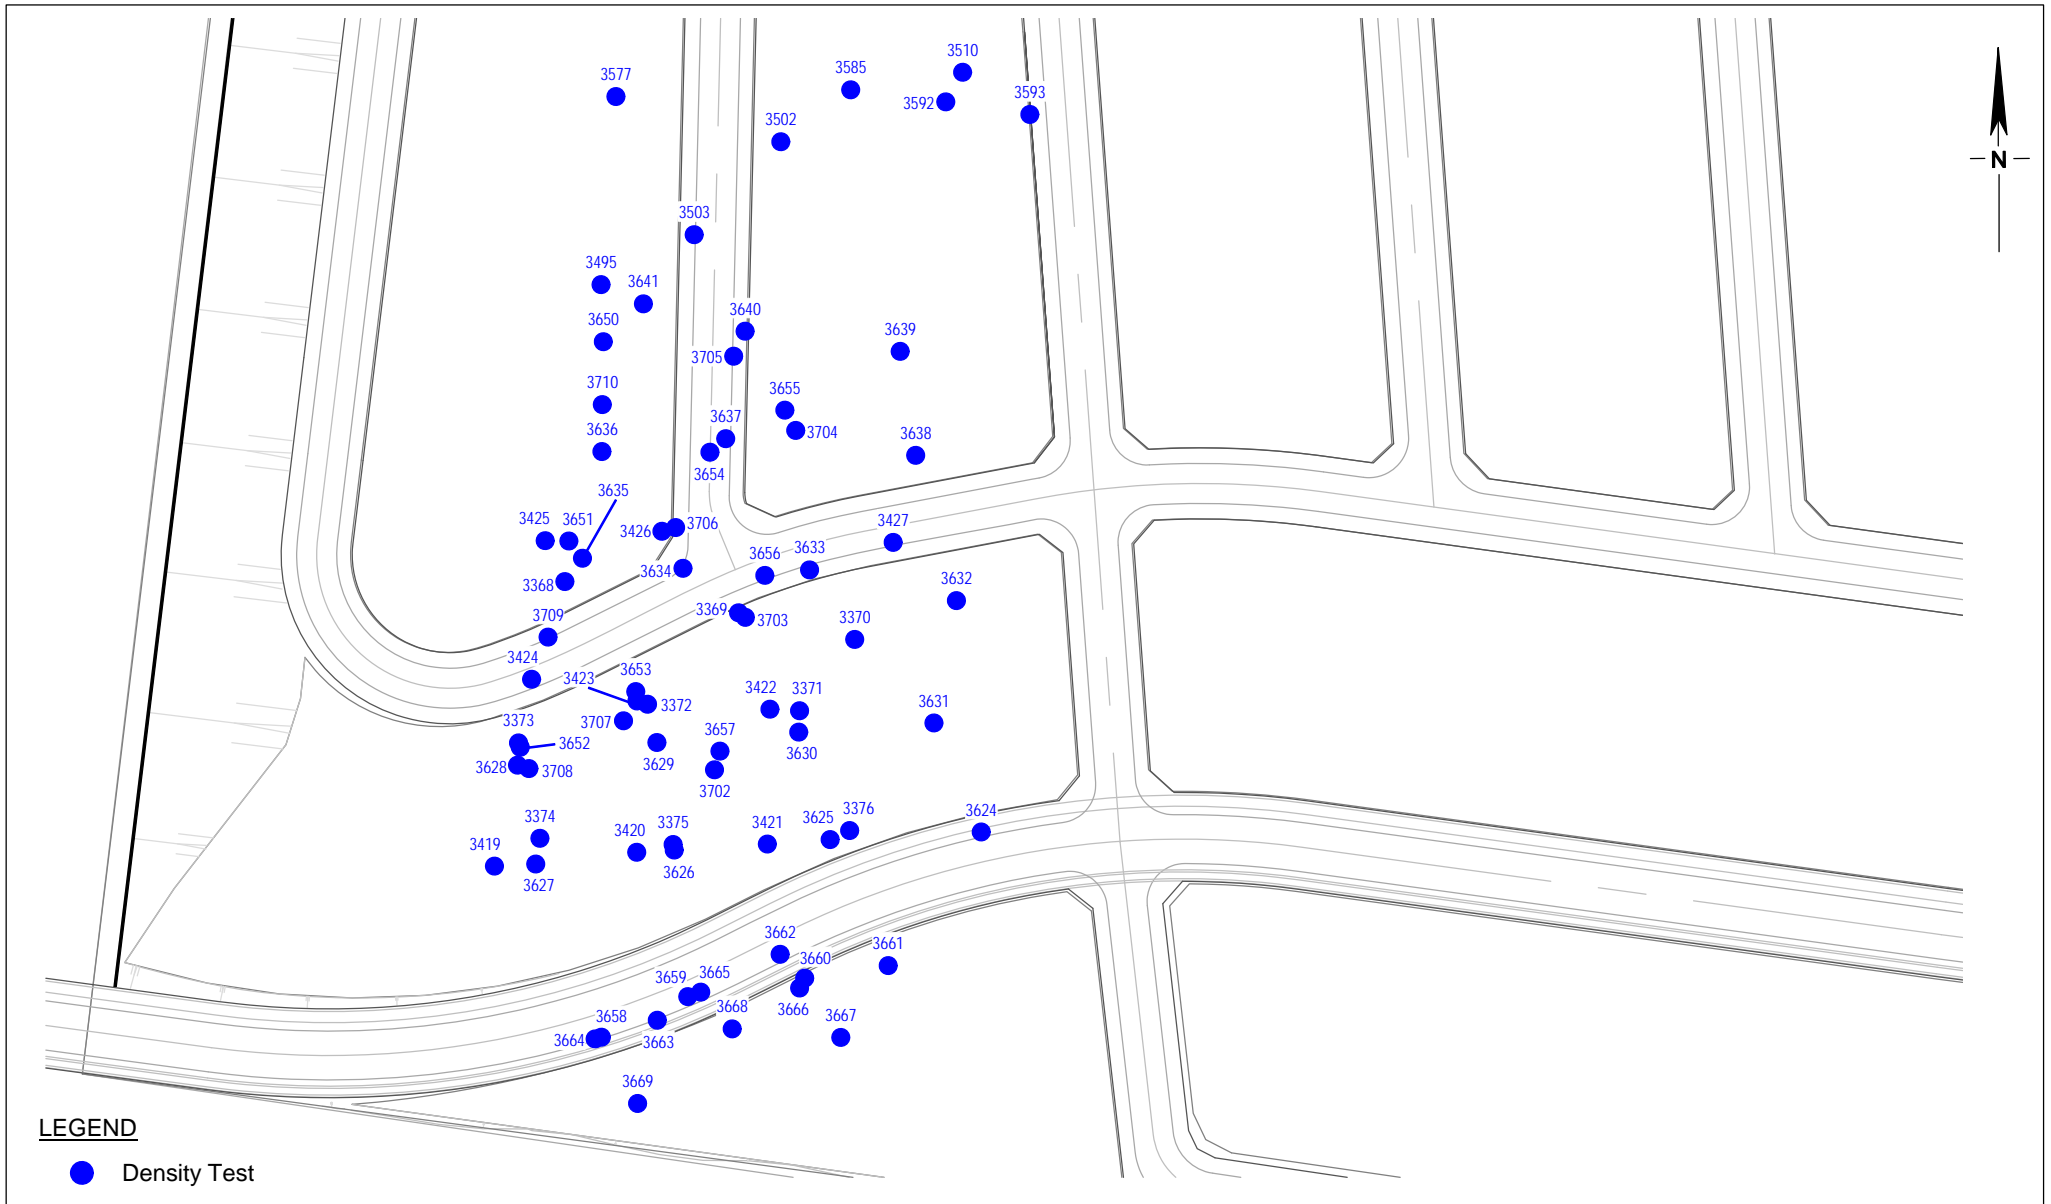

LEGEND

● Density Test



34 Borec Road
Penrith
NSW 2750
ABN 71 076 676 321

Ph: 02 4722 2744
Fx: 02 4722 2777
www.geotech.com.au
e-mail: info@geotech.com.au

NOTES


1. Site features are indicative and are not to scale.
2. This drawing has been produced using a base plan provided by others to which additional information e.g test pits, borehole locations or notes have been added. Some or all of the plan may not be relevant at the time of producing this drawing

Daracon Contractors Pty Ltd
Residential Development
Woorong Park - Area B
Marsden Park

Location of Field Density Tests

Drawing No: 8599/1-61
Job No: 8599/1
Drawn By: MH
Date: 24 November 2017
Checked By: AK

File No: 8599-1
Layers: 0, Lay61

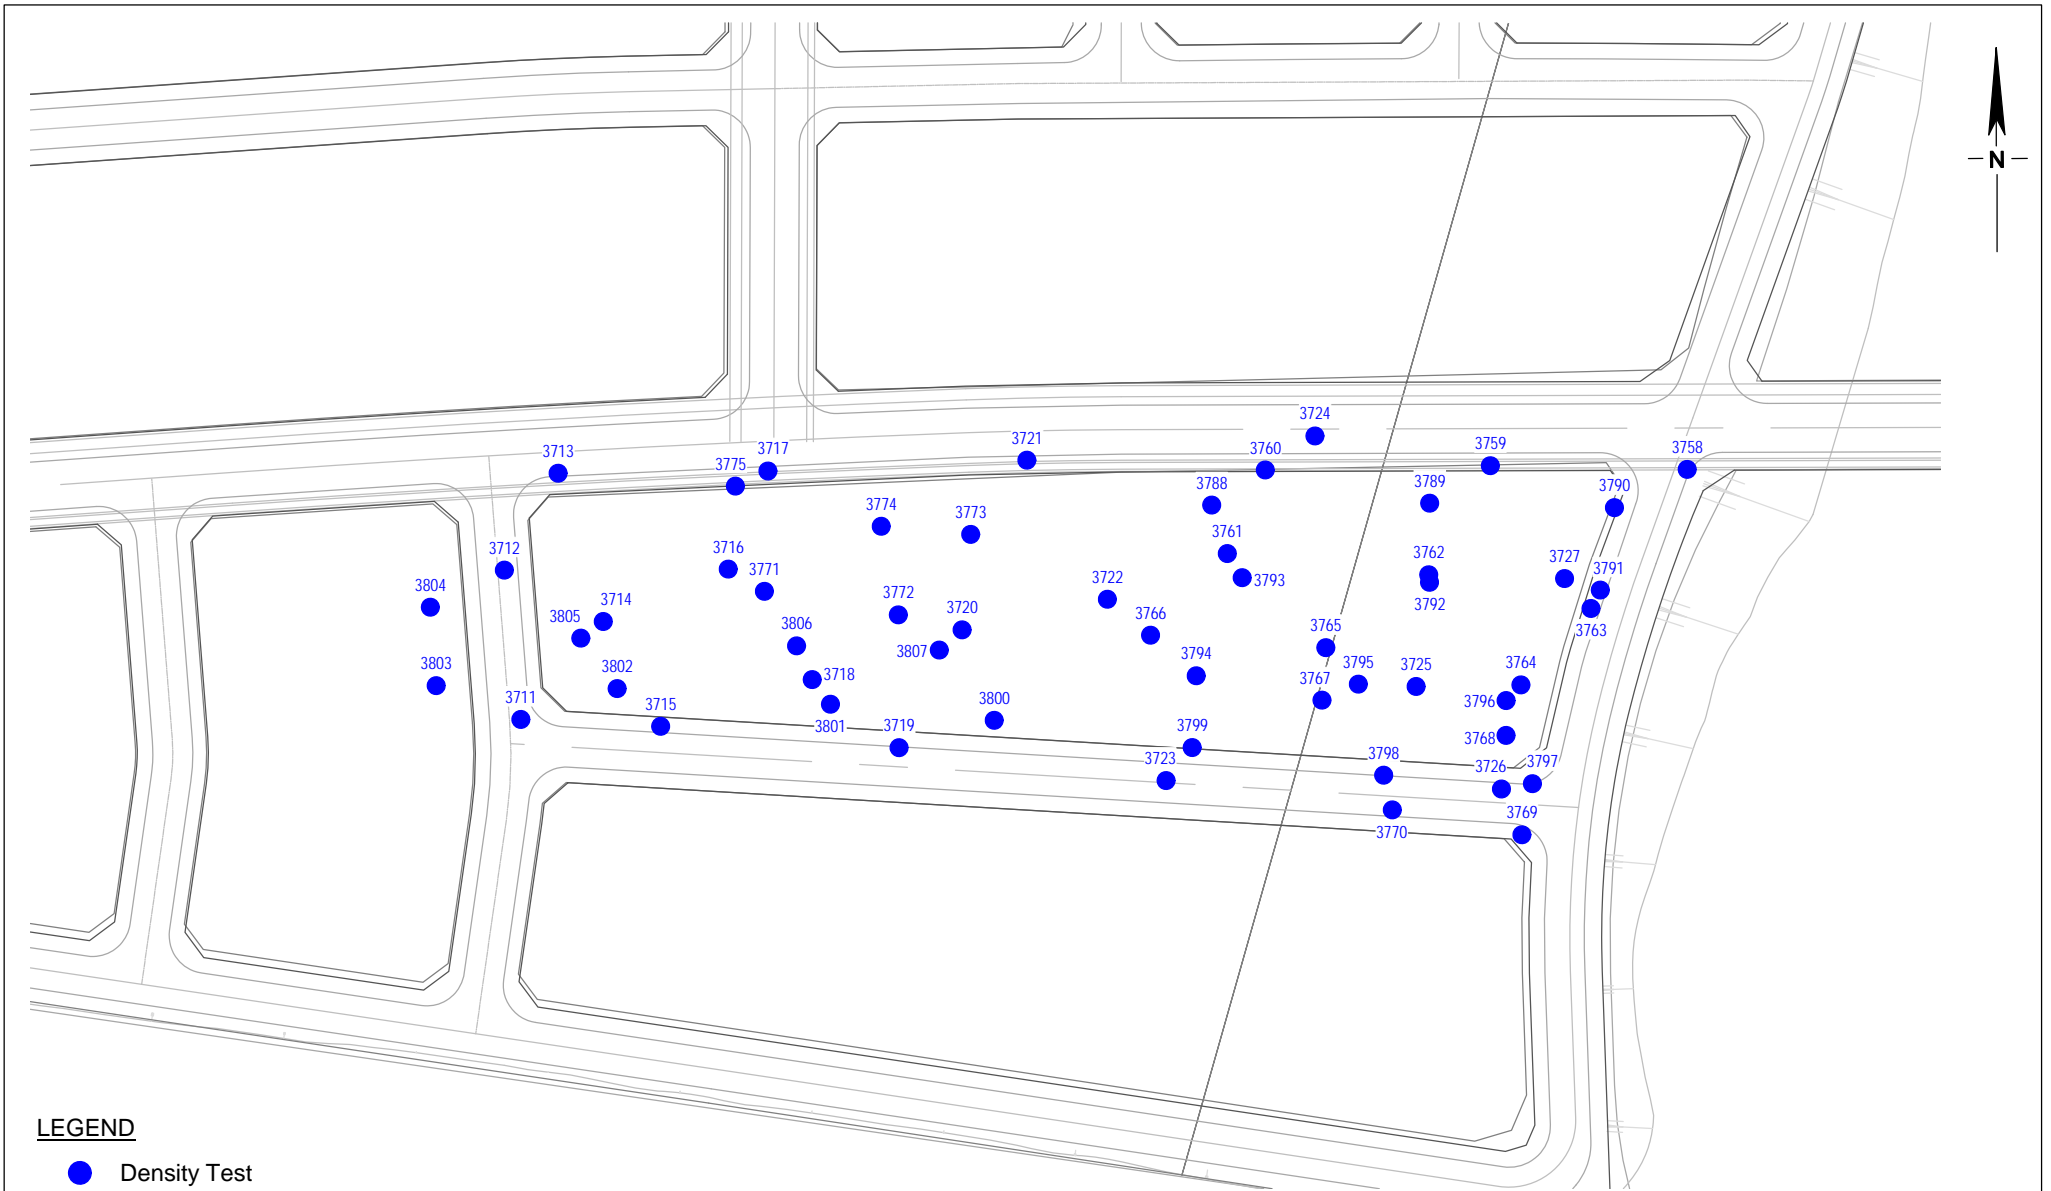

LEGEND

● Density Test



34 Borec Road
Penrith
NSW 2750
ABN 71 076 676 321

Ph: 02 4722 2744
Fx: 02 4722 2777
www.geotech.com.au
e-mail: info@geotech.com.au

NOTES

1. Site features are indicative and are not to scale.
2. This drawing has been produced using a base plan provided by others to which additional information e.g test pits, borehole locations or notes have been added. Some or all of the plan may not be relevant at the time of producing this drawing

Daracon Contractors Pty Ltd
Residential Development
Woorong Park - Area B
Marsden Park

Location of Field Density Tests

Drawing No: 8599/1-62
Job No: 8599/1
Drawn By: MH
Date: 24 November 2017
Checked By: AK

File No: 8599-1
Layers: 0, Lay62



LEGEND

● Density Test



34 Borec Road
 Penrith
 NSW 2750
 ABN 71 076 676 321

Ph: 02 4722 2744
 Fx: 02 4722 2777
 www.geotech.com.au
 e-mail: info@geotech.com.au

NOTES


1. Site features are indicative and are not to scale.
2. This drawing has been produced using a base plan provided by others to which additional information e.g test pits, borehole locations or notes have been added. Some or all of the plan may not be relevant at the time of producing this drawing

Daracon Contractors Pty Ltd
 Residential Development
 Woorong Park - Area B
 Marsden Park

Location of Field Density Tests

Drawing No: 8599/1-63
 Job No: 8599/1
 Drawn By: MH
 Date: 24 November 2017
 Checked By: AK

File No: 8599-1
 Layers: 0, Lay63

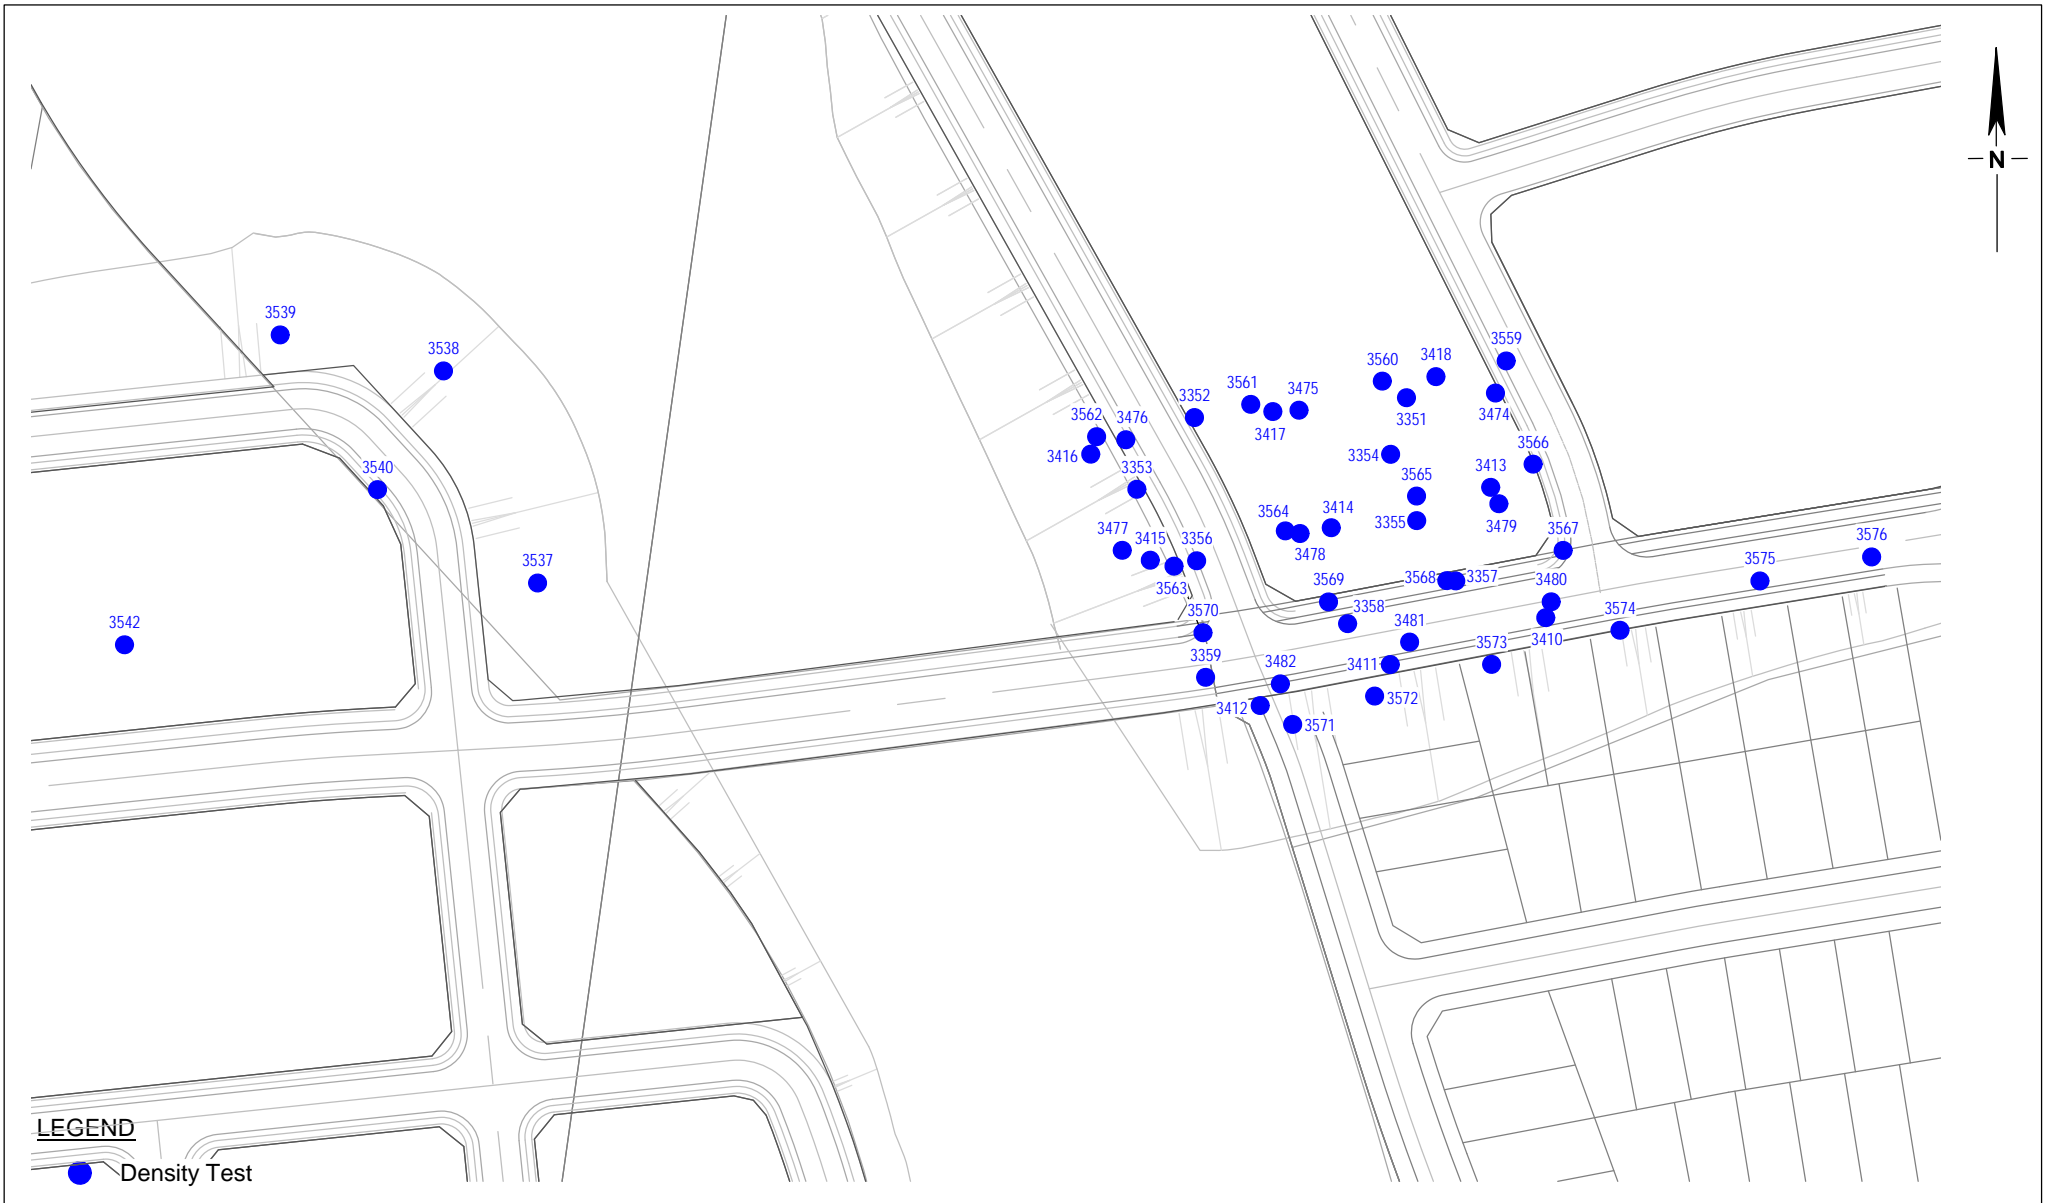

34 Borec Road
 Penrith
 NSW 2750
 ABN 71 076 676 321

Ph: 02 4722 2744
 Fx: 02 4722 2777
 www.geotech.com.au
 e-mail: info@geotech.com.au

NOTES

1. Site features are indicative and are not to scale.
2. This drawing has been produced using a base plan provided by others to which additional information e.g test pits, borehole locations or notes have been added. Some or all of the plan may not be relevant at the time of producing this drawing

Daracon Contractors Pty Ltd
 Residential Development
 Woorong Park - Area B
 Marsden Park

Location of Field Density Tests

Drawing No: 8599/1-64
 Job No: 8599/1
 Drawn By: MH
 Date: 24 November 2017
 Checked By: AK

File No: 8599-1
 Layers: 0, Lay64

GEOTECH

TESTING PTY LTD[®]

ABN 71 076 676 321



Quality
ISO 9001

SAI GLOBAL

GEOTECHNICAL INSPECTION AND TESTING AUTHORITY

Accreditation No 2734 Corporate Site No 2727

LEVEL 1 DAILY REPORT

Client:	Daracon Contractors Pty Ltd	Project No:	8599/1
Project:	Woorong Bulk Earthworks	Report No:	179
Location:	Marsden Park	Report Date:	10/10/2017
Test Methods:	AS 1289 5.1.1, 5.8.1	Technician:	Heath Wilson
Time on site: 0630			
Time off site: 1700			
1. Subgrade Approval			
Areas ID	Subgrade Approval Report No:	Comments	
APPROVED SUBGRADE	SUBGRADE 15	TEST NO'S 3246-3277 / 32	
APPROVED SUBGRADE	SUBGRADE 13	TEST NO'S 3278-3286 / 9	
2. Lot Approval			
Lot ID	Lot Approval Report No:	Comments	
3. Survey			
Type of Survey Test Locations Lot Boundaries	Survey undertaken by: Geotech / Geotech /	Reference	
4. Instructions received on site			
9x OLDMANURE LOADED BY 2x 65T EXCAVATORS FROM DESIGNATED BARRON ZONES EIF AND DESTINATION HEADED TO (S4)13 / DAM AREA 825 COMPACTOR PUSHING SOUTH TOWARDS (S4)15 BDY FENCE 2x 631 SCRAPERS PUSHED BY D10 IN CUT AREA IN (S4)15 MATERIAL PLACED			
5. Instructions given on site			
IN FILL AREA (S4)15 6x 627 SCRAPERS ALSO SELF LOADING IN SAME CUT AS 631'S AND PLACING IN AREA OF FILL 825 FILLING 10M SPOT TOWARDS THE WEST FOR WATER RUN OFF INTO NATURAL EVENMENT			
COMMENTS: 40,000LITRE WATERLARK #2 RUNNING AROUND FILL AREA DADS TO KEEP THE MATERIAL TO SPEC			
Signed:	Date: 10-10-17		

GEOTECH

TESTING PTY LTD[®]

ABN 71 076 676 321



Quality
ISO 9001

SAI GLOBAL

GEOTECHNICAL INSPECTION AND TESTING AUTHORITY

Accreditation No 2734 Corporate Site No 2727


LEVEL 1 DAILY REPORT

Client:	Daracon Contractors Pty Ltd	Project No:	8599/1
Project:	Woorong Bulk Earthworks	Report No:	190
Location:	Marsden Park	Report Date:	11/10/2017
Test Methods:	AS 1289 5.1.1, 5.8.1	Technician:	Heath Wilson
Time on site: 0630			
Time off site: 1700			
1. Subgrade Approval			
Areas ID	Subgrade Approval Report No:	Comments	
APPROVED SUBGRADE	SUBGRADE 14	TEST NO'S 3287-3303/19	
APPROVED SUBGRADE	SUBGRADE 13	TEST NO'S 3306-3312/19	
2. Lot Approval			
Lot ID	Lot Approval Report No:	Comments	
NO SUBGRADE APPROVAL	DAM AREA	TEST NO'S 3315-3319/5	
3. Survey			
Type of Survey Test Locations Lot Boundaries	Survey undertaken by: Geotech / Geotech /	Reference	
4. Instructions received on site			
6x 627 SCRAPERS CARRYING MATERIAL FROM LOT IN AREAS 54 12 AND 14 AND PLACING IN APPROVED SUBGRADE 14 825 COMPACTOR PUSHING TO THE WEST TOWARDS STONEY CREEK ROAD 4x 637 B2H SCRAPERS CARRYING MATERIAL TO (54) 04 WITH 825 COMPACTOR			
5. Instructions given on site			
ALSO PUSHING TO THE WEST TIGHT AGAINST BOY INTO (54) 11 10x DUMPER TRUCKS LOADED BY 651 EXCAVATORS FROM BORROW ZONES E.P AND HEADED TO APPROVED 54 13 AND DAM AREA 825 AND 815 COMPACTOR PUSHING AND COMPACTING OF THE GALE, GRADER TRIMMING LIAISON ROADS			
COMMENTS: FOR MACHINES THE EXIT AND ENTRY TO PLACEMENT AREAS ALSO THE FILL AREAS THAT ARE CLOSE TO FSL			
Signed:		Date: 11.10.17	

GEOTECHNICAL INSPECTION AND TESTING AUTHORITY

Accreditation No 2734 Corporate Site No 2727

LEVEL 1 DAILY REPORT

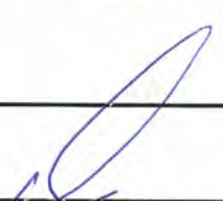Client:	Daracon Contractors Pty Ltd	Project No:	8599/1
Project:	Woorong Bulk Earthworks	Report No:	151
Location:	Marsden Park	Report Date:	12/10/2017
Test Methods:	AS 1289 5.1.1, 5.8.1	Technician:	Heath Wilson
Time on site: 0630			
Time off site: 1700			
1. Subgrade Approval			
Areas ID	Subgrade Approval Report No:	Comments	
APPROVED SUBGRADE	SUBGRADE 15	TEST NO'S 3320-3333/14	
APPROVED SUBGRADE	SUBGRADE 13 AND DAM AREA	TEST NO'S 3334 3252/19	
2. Lot Approval			
Lot ID	Lot Approval Report No:	Comments	
APPROVED SUBGRADE	SUBGRADE 04/8H MINING	TEST NO'S 3353/3362/10	
3. Survey			
Type of Survey	Survey undertaken by:	Reference	
Test Locations	Geotech /		
Lot Boundaries	Geotech /		
4. Instructions received on site			
<p>08 RIPPING CUT IN (54)14 FOR SCRAPERS DID PUSHING THE 631'S THROUGH IT AND PLACED IN (54)15 ANOTHER 44 627 SCRAPERS ALSO CARING FROM THE SAME AREA AND PLACING IN DESIGNATED 10M AREAS ALONG SPUNEY CREEK ROAD (B07) 825 WORKING (54)15 AT THE MOMENT AND WILL WORK ACROSS TO PLACED</p>			
5. Instructions given on site			
<p>MATERIAL, 40,000LIR WATERCART SPRAYING WHERE CUT NEEDS TO BE PLACED BEFORE AND AFTER PLACEMENT 8 DUMPTRUCKS HAULING FROM BORRACH ZONE 611 BY 2x 65t EXCAVATORS AND HAULED TO APPROVED SUBGRADE 13/DAM AREA 825 ALSO PUSHING EAST TO B07</p>			
COMMENTS: FOR NEXT LIME/LAYER			
<p>Signed: </p>			
			Date: 12.10.17

GEOTECH

TESTING PTY LTD[®]

ABN 71 076 676 321



Quality
ISO 9001

SAI GLOBAL

GEOTECHNICAL INSPECTION AND TESTING AUTHORITY

Accreditation No 2734 Corporate Site No 2727

LEVEL 1 DAILY REPORT

Client:	Daracon Contractors Pty Ltd	Project No:	8599/1
Project:	Woorong Bulk Earthworks	Report No:	182
Location:	Marsden Park	Report Date:	13/10/2017
Test Methods:	AS 1289 5.1.1, 5.8.1	Technician:	Tomas Heath Wilson
Time on site:	6:30		
Time off site:	4:30		
1. Subgrade Approval			
Areas ID	Subgrade Approval Report No:	Comments	
Approved Subgrade	Subgrade 16	test No's 3363-3379/17	
Approved Subgrade	Subgrade 14	test No's 3380-3416/31	
2. Lot Approval			
Lot ID	Lot Approval Report No:	Comments	
Approved Subgrade	Subgrade 15	test No's 3411-3424/11	
Approved Subgrade	Subgrade 13 & dam	test No's 3404 3409	
3. Survey			
Type of Survey	Survey undertaken by:	Reference	
Test Locations	Geotech /		
Lot Boundaries	Geotech /		
4. Instructions received on site			
5. Instructions given on site			
COMMENTS:			
Signed:		Date:	13/10/2017

9

GEOTECH

TESTING PTY LTD[®]

ABN 71 076 676 321



Quality
ISO 9001

SAI GLOBAL

GEOTECHNICAL INSPECTION AND TESTING AUTHORITY

Accreditation No 2734 Corporate Site No 2727

LEVEL 1 DAILY REPORT

Client: Daracon Contractors Pty Ltd	Project No: 8599/1
Project: Woorong Bulk Earthworks	Report No: 183
Location: Marsden Park	Report Date: 16/10/2017
Test Methods: AS 1289 5.1.1, 5.8.1	Technician: J-S Heath-Wilson
Time on site: 6:30	
Time off site: 4:30	
1. Subgrade Approval	
Areas ID Approved subgrade Approved subgrade	Subgrade Approval Report No: Subgrade 16 Subgrade 15
Comments test No's 3422-3433/12 test No's 3434-3461 / 28	
2. Lot Approval	
Lot ID Approved subgrade	Lot Approval Report No: 13 & dam
Comments test No's 3462-3485/24	
3. Survey	
Type of Survey Test Locations Lot Boundaries	Survey undertaken by: Geotech / Geotech /
Reference	
4. Instructions received on site	
5. Instructions given on site	
COMMENTS:	
Signed:	Date: 16/10/2017

GEOTECH

TESTING PTY LTD[®]

ABN 71 076 676 321



Quality
ISO 9001
SAI GLOBAL

GEOTECHNICAL INSPECTION AND TESTING AUTHORITY

Accreditation No 2734 Corporate Site No 2727

LEVEL 1 DAILY REPORT

Client:	Daracon Contractors Pty Ltd	Project No:	8599/1
Project:	Woorong Bulk Earthworks	Report No:	184
Location:	Marsden Park	Report Date:	17 / 10/2017
Test Methods:	AS 1289 5.1.1, 5.8.1	Technician:	Heath Wilson
Time on site:	6:30		
Time off site:	4:30		
1. Subgrade Approval			
Areas ID A Approved Subgrade	Subgrade Approval Report No: Subgrade IG	Comments Test No's 3486-3496/17	
2. Lot Approval			
Lot ID	Lot Approval Report No:	Comments	
3. Survey			
Type of Survey Test Locations Lot Boundaries	Survey undertaken by: Geotech / Geotech /	Reference	
4. Instructions received on site			
5. Instructions given on site			
COMMENTS:			
Signed:		Date:	17/10/2017

GEOTECH

TESTING PTY LTD[®]

ABN 71 076 676 321



Quality
ISO 9001
SAI GLOBAL

GEOTECHNICAL INSPECTION AND TESTING AUTHORITY

Accreditation No 2734 Corporate Site No 2727

LEVEL 1 DAILY REPORT

Client:	Daracon Contractors Pty Ltd	Project No:	8599/1
Project:	Woorong Bulk Earthworks	Report No:	195
Location:	Marsden Park	Report Date:	18 / 10 / 2017
Test Methods:	AS 1289 5.1.1, 5.8.1	Technician:	Heath Wilson
Time on site:	6:30		
Time off site:	4:30		
1. Subgrade Approval			
Areas ID Approved SG Approved SG	Subgrade Approval Report No: Subgrade 16 Subgrade 11	Comments test No's 3497-3518/22 test No's - 3519-3560/42	
2. Lot Approval			
Lot ID	Lot Approval Report No:	Comments	
3. Survey			
Type of Survey Test Locations Lot Boundaries	Survey undertaken by: Geotech / Geotech /	Reference	
4. Instructions received on site			
5. Instructions given on site			
COMMENTS:			
Signed:		Date:	18/10/2017

GEOTECH

TESTING PTY LTD[®]

ABN 71 076 676 321



Quality
ISO 9001

SAI GLOBAL

GEOTECHNICAL INSPECTION AND TESTING AUTHORITY

Accreditation No 2734 Corporate Site No 2727

LEVEL 1 DAILY REPORT

Client:	Daracon Contractors Pty Ltd	Project No:	8599/1
Project:	Woorong Bulk Earthworks	Report No:	D186
Location:	Marsden Park	Report Date:	19/10/2017
Test Methods:	AS 1289 5.1.1, 5.8.1	Technician:	
Time on site:	6:30		
Time off site:	4:30		
1. Subgrade Approval			
Areas ID	Subgrade Approval Report No:	Comments	
Approved Subgrade	Subgrade 14	Test no's 3561-3578/18	
2. Lot Approval			
Lot ID	Lot Approval Report No:	Comments	
3. Survey			
Type of Survey	Survey undertaken by:	Reference	
Test Locations	Geotech /		
Lot Boundaries	Geotech /		
4. Instructions received on site			
5. Instructions given on site			
COMMENTS:			
Signed:		Date:	19/10/2017

GEOTECH

TESTING PTY LTD[®]

ABN 71 076 676 321




Quality
ISO 9001

SAI GLOBAL

GEOTECHNICAL INSPECTION AND TESTING AUTHORITY

Accreditation No 2734 Corporate Site No 2727

LEVEL 1 DAILY REPORT

Client:	Daracon Contractors Pty Ltd	Project No:	8599/1
Project:	Woorong Bulk Earthworks	Report No:	D 187
Location:	Marsden Park	Report Date:	24/10/2017
Test Methods:	AS 1289 5.1.1, 5.8.1	Technician:	
Time on site:	6:30		
Time off site:	4:30		
1. Subgrade Approval			
Areas ID	Subgrade Approval Report No:	Comments	
Approved Subgrade	Subgrade 16	test no's 3579 - 3579/20	
2. Lot Approval			
Lot ID	Lot Approval Report No:	Comments	
3. Survey			
Type of Survey Test Locations Lot Boundaries	Survey undertaken by: Geotech / Geotech /	Reference	
4. Instructions received on site			
5. Instructions given on site			
COMMENTS:			
Signed:		Date:	24/10/2017

GEOTECH

TESTING PTY LTD®

ABN 71 076 676 321




Quality
ISO 9001

SAI GLOBAL

GEOTECHNICAL INSPECTION AND TESTING AUTHORITY

Accreditation No 2734 Corporate Site No 2727


LEVEL 1 DAILY REPORT

Client:	Daracon Contractors Pty Ltd	Project No:	8599/3
Project:	Woorong Bulk Earthworks	Report No:	D 188
Location:	Marsden Park	Report Date:	25/10/2017
Test Methods:	AS 1289 5.1.1, 5.8.1	Technician:	TS
Time on site: 0630			
Time off site: 1630			
1. Subgrade Approval			
Areas ID	Subgrade Approval Report No:	Comments	
Approved Subgrade	Subgrade 15	test no's 3599-7625/27	
2. Lot Approval			
Lot ID	Lot Approval Report No:	Comments	
3. Survey			
Type of Survey	Survey undertaken by:	Reference	
Test Locations	Geotech /		
Lot Boundaries	Geotech /		
4. Instructions received on site			
5. Instructions given on site			
COMMENTS:			
Signed:		Date:	25/10/2017

GEOTECHNICAL INSPECTION AND TESTING AUTHORITY

Accreditation No 2734 Corporate Site No 2727

LEVEL 1 DAILY REPORT

Client:	Daracon Contractors Pty Ltd	Project No:	8599/1
Project:	Woorong Bulk Earthworks	Report No:	D 187
Location:	Marsden Park	Report Date:	26/10/2017
Test Methods:	AS 1289 5.1.1, 5.8.1	Technician:	TS
Time on site: 0630			
Time off site: 1630			
1. Subgrade Approval			
Areas ID	Subgrade Approval Report No:	Comments	
Approved Subgrade	Subgrade 16	test no's 3626..3643/18	
2. Lot Approval			
Lot ID	Lot Approval Report No:	Comments	
3. Survey			
Type of Survey	Survey undertaken by:	Reference	
Test Locations	Geotech /		
Lot Boundaries	Geotech /		
4. Instructions received on site			
5. Instructions given on site			
COMMENTS:			
Signed:		Date:	26/10/2017

GEOTECH

TESTING PTY LTD[®]

ABN 71 076 676 321



Quality
ISO 9001

SAI GLOBAL

GEOTECHNICAL INSPECTION AND TESTING AUTHORITY

Accreditation No 2734 Corporate Site No 2727

LEVEL 1 DAILY REPORT

Client:	Daracon Contractors Pty Ltd	Project No:	8599/1
Project:	Woorong Bulk Earthworks	Report No:	D 190
Location:	Marsden Park	Report Date:	30/10/2017
Test Methods:	AS 1289 5.1.1, 5.8.1	Technician:	AW
Time on site: 0630			
Time off site: 1700			
1. Subgrade Approval			
Areas ID	Subgrade Approval Report No:	Comments	
APPROVED SUBGRADE	SUBGRADE 13	TEST NO'S 3644-3651/8	
APPROVED SUBGRADE	SUBGRADE 16	TEST NO'S 3652-3659/8	
2. Lot Approval			
Lot ID	Lot Approval Report No:	Comments	
APPROVED SUBGRADE	SUBGRADE 17	TEST NO'S 3660-3671/12	
3. Survey			
Type of Survey	Survey undertaken by:	Reference	
Test Locations	Geotech /		
Lot Boundaries	Geotech /		
4. Instructions received on site			
BY 631 SURFERS POSING BY 010 IN LOT AREA MATERIAL ORDER IN (54) IN 875 COMPACTOR POSING MATERIAL WEST FOR NEW LAYER / LIFT ALSO BY 637 SURFERS LIFTING FROM LOT AREA IN (54) 17 AND POSING IN APPROVED SUBGRADE 16 ALSO 875 COMPACTOR POSING EAST ALONG THE			
5. Instructions given on site			
FACE OF BARRIER FORWARD 56 (17) OVER EXISTING WALL ROAD SELF LOADING TRAIL SURFERS PILING TOPSOIL OVER FINISHED ROAD (55) 10 AND 12 IN 6RS FILL PILES BARRIER TRIMMING UP PILES DUE TO HEAVY RAIN CLEAN UP NEEDED FOR			
COMMENTS: FURTHER PILEMENT			
Signed:		Date: 30-10-17	

GEOTECH

TESTING PTY LTD[®]

ABN 71 076 676 321



Quality
ISO 9001

SAI GLOBAL

GEOTECHNICAL INSPECTION AND TESTING AUTHORITY

Accreditation No 2734 Corporate Site No 2727

LEVEL 1 DAILY REPORT

Client:	Daracon Contractors Pty Ltd	Project No:	8599/1
Project:	Woorong Bulk Earthworks	Report No:	D 191
Location:	Marsden Park	Report Date:	31/10/2017
Test Methods:	AS 1289 5.1.1, 5.8.1	Technician:	HW
Time on site: 0630			
Time off site: 1700			
1. Subgrade Approval			
Areas ID	Subgrade Approval Report No:	Comments	
APPROVED SUBGRADE	SUBGRADES 14.15	TEST NO'S 3672-3679/8	
APPROVED SUBGRADE	SUBGRADE 11	TEST NO'S 3680-3699/15	
2. Lot Approval			
Lot ID	Lot Approval Report No:	Comments	
APPROVED SUBGRADE	SUBGRADE 08	TEST NO'S 3695-3703/9	
APPROVED SUBGRADE	SUBGRADE 16	TEST NO'S 3704-3712/12	
3. Survey			
Type of Survey Test Locations Lot Boundaries	Survey undertaken by: Geotech / Geotech /	Reference	
4. Instructions received on site			
08 RIPPING CUT AREA ON HIGH SPOT OF (S4) 14 TO BE COMPLETED IN (S4) 14 BY 631 SCRAPERS PROVIDED BY DIO TO BE PLACED AT THE MATERIAL UP AGAINST FACE OF BANKER ALSO TO SOIL LOADING BABY-SCRAPER LAYING TO THE SAME TONG ALSO ANOTHER 08 RIPPING CUT FOR BY 631 SCRAPERS TO BE PLACED IN (S4) 12			
5. Instructions given on site			
WHERE 825 COMPACTOR IS TURNING EAST TOWARDS ZONE (D) BOY AREA FOR THE FINAL PUSH LATER BEFORE POSING THE KARAOA TRIMMING SUBGRADE FOR WATER RUNOFF AS EXPECTED			
COMMENTS:			
Signed:		Date: 31-10-17	

GEOTECH

TESTING PTY LTD[®]

ABN 71 076 676 321




Quality
ISO 9001

SAI GLOBAL

GEOTECHNICAL INSPECTION AND TESTING AUTHORITY

Accreditation No 2734 Corporate Site No 2727

LEVEL 1 DAILY REPORT

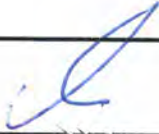Client:	Daracon Contractors Pty Ltd	Project No:	8599/1
Project:	Woorong Bulk Earthworks	Report No:	D 192
Location:	Marsden Park	Report Date:	01/11/2017
Test Methods:	AS 1289 5.1.1, 5.8.1	Technician:	HW
Time on site:	0630		
Time off site:	1700		
1. Subgrade Approval			
Areas ID	Subgrade Approval Report No:	Comments	
APPROVED SUBGRADE	SUBGRADE 12	TEST NO'S 3713-3729/17	
APPROVED SUBGRADE	SUBGRADE 11	TEST NO'S 3730-3741/12	
2. Lot Approval			
Lot ID	Lot Approval Report No:	Comments	
APPROVED SUBGRADE	SUBGRADE 15	TEST NO'S 3742-3750/10	
3. Survey			
Type of Survey	Survey undertaken by:	Reference	
Test Locations	Geotech /		
Lot Boundaries	Geotech /		
4. Instructions received on site			
ON RIPPING CUT AREA AT THE START OF SUBGRADE 16 WHERE OLD M-SHINY X2 631 SCRAPERS TO PLACE AT LOWER POINT TOWARDS STONEY CR ROAD 825 COMPACTOR PUSHING WEST ALONG WITH 2x 627 SCRAPERS WORKING INTO SUBGRADE (15) 8x 627 SCRAPERS ALSO PICKING UP RIPPED MATERIAL FOR PLACEMENT			
5. Instructions given on site			
IN APPROVED SUBGRADE 12 ALSO 825 PUSHING EAST TOWARDS SIFT FENCE OVER THE CUTS GRADER TRIMMING UP FILL AREAS FOR TRED MACHINES IN AND OUT EXITS FOR SAFE ACCESS			
COMMENTS:			
Signed: 			
		Date:	01-11-17

GEOTECH

TESTING PTY LTD[®]

ABN 71 076 676 321



Quality
ISO 9001

SAI GLOBAL

GEOTECHNICAL INSPECTION AND TESTING AUTHORITY

Accreditation No 2734 Corporate Site No 2727

LEVEL 1 DAILY REPORT

Client:	Daracon Contractors Pty Ltd	Project No:	8599/1
Project:	Woorong Bulk Earthworks	Report No:	D 193
Location:	Marsden Park	Report Date:	02/11/2017
Test Methods:	AS 1289 5.1.1, 5.8.1	Technician:	HW
Time on site: 0630			
Time off site: 1700			
1. Subgrade Approval			
Areas ID	Subgrade Approval Report No:	Comments	
APPROVED SUBGRADE	SUBGRADE 15	TEST NO'S 3751-3759/9	
APPROVED SUBGRADE	SUBGRADE 12	TEST NO'S 3760-3777/18	
2. Lot Approval			
Lot ID	Lot Approval Report No:	Comments	
APPROVED SUBGRADE	SUBGRADE 11	TEST NO'S 3778-3789/12	
3. Survey			
Type of Survey Test Locations Lot Boundaries	Survey undertaken by: Geotech / Geotech /	Reference	
4. Instructions received on site			
DID PUSHING 2x 621 SLABBERS THROUGH CUT AREA RIPPED BY D8 IN ZONE OF SUBGRADE (15) ALONG WITH 2x 627 SLABBERS FILL BEING PLACED IN (14) IS 825 COMPACTOR PUSHING MATERIAL WEST DOWN HILL FOR NEXT COVER LAYER BRIDGING WET EXCAVATED SPOT			
5. Instructions given on site			
DID ANOTHER 4x 627 SLABBERS CUTTING IN HIGH AREA (12) AFTER D8 RIPPING MATERIAL PLACED FOR FINAL LAYER OVER EAST ENT TOWARDS (14) 11 OVER CURBET 40,000LIT WATERBART SPRAYING AS NEEDED BETWEEN HALL ROADS AND FILL AREA			
COMMENTS: GRADER TRIMMING UP AREAS THAT HAVE FILL PLACED AND WILL AT A LATER DATE			
Signed:			Date: 02/11/17

GEOTECH

TESTING PTY LTD[®]

ABN 71 076 676 321



Quality
ISO 9001

SAI GLOBAL

GEOTECHNICAL INSPECTION AND TESTING AUTHORITY

Accreditation No 2734 Corporate Site No 2727

LEVEL 1 DAILY REPORT

Client:	Daracon Contractors Pty Ltd	Project No:	8599/1
Project:	Woorong Bulk Earthworks	Report No:	194
Location:	Marsden Park	Report Date:	03/11/2017
Test Methods:	AS 1289 5.1.1, 5.8.1	Technician:	Heath Wilson
Time on site: 0630			
Time off site: 1700			
1. Subgrade Approval			
Areas ID	Subgrade Approval Report No:	Comments	
APPROVED SUBGRADE	SUBGRADE 12	TEST NO'S 3790 - 3809/20	
APPROVED SUBGRADE	SUBGRADE 15	TEST NO'S 3810 - 3815/6	
2. Lot Approval			
Lot ID	Lot Approval Report No:	Comments	
3. Survey			
Type of Survey Test Locations Lot Boundaries	Survey undertaken by: Geotech / Geotech /	Reference	
4. Instructions received on site			
2x 631 SCRAPERS PLACED BY DIO MATERIAL LTD AND PLACED BY IN APPROVED (54) 15 ALSO 2x 627 SCRAPERS PLACING IN THE SAME AREA WHILE 825 COMPACTS AND PUSHERS WENT TOWARDS STONEY CREEK ROAD SUBGRADE 18 PICKED UP ROWS UP AGAINST FACE OPPOSITE (54) 15			
5. Instructions given on site			
CUT TO FILL WILL START AT SOME POINT TODAY TO CREATE WATER RUNOFF AREA AS RAIN FORECAST 2x 631 SCRAPERS BOXING OUT ROADS IN AREA WITH GRADER MATERIAL PLACED UP AS FILL IS BEING PLACED IN APPROVED SUBGRADE (08) 815 PUSHING SPREAD			
COMMENTS: MATERIAL OVER PAD FOR FURTHER 194R 2x 631 SCRAPERS CARRYING RIPPED MATERIAL FROM BORROW ZONE (54) 12 AND DISCHARGING AT THE TAIL END OF (54) 12 NEAR CULVERT 6046 825 COMPACTING AS PLACED			
Signed:		Date: 03/11/17	

GEOTECH

TESTING PTY LTD[®]

ABN 71 076 676 321



Quality
ISO 9001

SAI GLOBAL

GEOTECHNICAL INSPECTION AND TESTING AUTHORITY

Accreditation No 2734 Corporate Site No 2727

LEVEL 1 DAILY REPORT

Client:	Daracon Contractors Pty Ltd	Project No:	8599/1
Project:	Woorong Bulk Earthworks	Report No:	195
Location:	Marsden Park	Report Date:	07 / 11 / 2017
Test Methods:	AS 1289 5.1.1, 5.8.1	Technician:	Heath Wilson
Time on site:	—		
Time off site:	—		
1. Subgrade Approval			
Areas ID	Subgrade Approval Report No:	Comments	
2. Lot Approval			
Lot ID	Lot Approval Report No:	Comments	
3. Survey			
Type of Survey Test Locations Lot Boundaries	Survey undertaken by: Geotech / Geotech /	Reference	
4. Instructions received on site			
5. Instructions given on site			
COMMENTS:	Due to earlier rain, the job has been postponed to a later date as site access is unsafe for tyred vehicles to safely carry out tasks.		
Signed:			Date: 08.11.17

GEOTECH

TESTING PTY LTD[®]

ABN 71 076 676 321




Quality
ISO 9001

SAI GLOBAL

GEOTECHNICAL INSPECTION AND TESTING AUTHORITY

Accreditation No 2734 Corporate Site No 2727

LEVEL 1 DAILY REPORT

Client:	Daracon Contractors Pty Ltd	Project No:	8599/1
Project:	Woorong Bulk Earthworks	Report No:	196
Location:	Marsden Park	Report Date:	06/11/2017
Test Methods:	AS 1289 5.1.1, 5.8.1	Technician:	Heath Wilson
Time on site:	—		
Time off site:	—		
1. Subgrade Approval			
Areas ID	Subgrade Approval Report No:	Comments	
2. Lot Approval			
Lot ID	Lot Approval Report No:	Comments	
3. Survey			
Type of Survey Test Locations Lot Boundaries	Survey undertaken by: Geotech / Geotech /	Reference	
4. Instructions received on site			
5. Instructions given on site			
COMMENTS:	Due to earlier rain, the job has been postponed to a later date as site access is unsafe for tyred vehicles to safely carry out tasks.		
Signed:		Date:	06.11.17

GEOTECH

TESTING PTY LTD[®]

ABN 71 076 676 321



Quality
ISO 9001

SAI GLOBAL

GEOTECHNICAL INSPECTION AND TESTING AUTHORITY

Accreditation No 2734 Corporate Site No 2727

LEVEL 1 DAILY REPORT

Client:	Daracon Contractors Pty Ltd	Project No:	8599/1
Project:	Woorong Bulk Earthworks	Report No:	197
Location:	Marsden Park	Report Date:	08 / 11 / 2017
Test Methods:	AS 1289 5.1.1, 5.8.1	Technician:	Heath Wilson
Time on site: 0630			
Time off site: 1700			
1. Subgrade Approval			
Areas ID	Subgrade Approval Report No:	Comments	
2. Lot Approval			
Lot ID	Lot Approval Report No:	Comments	
3. Survey			
Type of Survey Test Locations Lot Boundaries	Survey undertaken by: Geotech / Geotech /	Reference	
4. Instructions received on site			
GRADER TRIMMING UP AND GETTING READY FOR ROLLING WITH SMOOTH DRUM OVER CULVERT IN AREA(D) EXCESS MATERIAL PICKED UP AND PLACED IN (54)13) WHERE 825 COMPACTOR IS ROLLING 2x 631'S CUTTING MATERIAL FROM AREA OPPOSITE SITE CHECKS AND PLACED IN (54)13			
5. Instructions given on site			
ALSO IN THE DAM AREA WITH ANOTHER 825 PUSHING AND COMPACTING TO THE WEST DOWN BATTER 06 DOZER RIPPING FOR THE 627 SCRAPERS X10 2x GRADERS TRIMMING PASS AND HAUL ROADS FROM PREVIOUS RAIN DAYS APPROX 30MM RAIN SOME			
COMMENTS: AREAS ARE VERY WET AND HARD TO ACCESS			
Signed:		Date: 08/11/17	

GEOTECH

TESTING PTY LTD[®]

ABN 71 076 676 321




Quality
ISO 9001

SAI GLOBAL

GEOTECHNICAL INSPECTION AND TESTING AUTHORITY

Accreditation No 2734 Corporate Site No 2727


LEVEL 1 DAILY REPORT

Client:	Daracon Contractors Pty Ltd	Project No:	8599/1
Project:	Woorong Bulk Earthworks	Report No:	198
Location:	Marsden Park	Report Date:	09/11/2017
Test Methods:	AS 1289 5.1.1, 5.8.1	Technician:	Heath Wilson
Time on site: 0630			
Time off site: 1700			
1. Subgrade Approval			
Areas ID	Subgrade Approval Report No:	Comments	
APPROVED SUBGRADE	SUBGRADE 19	TEST NO'S 3828 - 3850 / 23	
DAM AREA	NO APPROVED SUBGRADE	TEST NO'S 3816 - 3827 / 12	
2. Lot Approval			
Lot ID	Lot Approval Report No:	Comments	
3. Survey			
Type of Survey	Survey undertaken by:	Reference	
Test Locations	Geotech /		
Lot Boundaries	Geotech /		
4. Instructions received on site			
08 DOZER RIPPING CUT AREA IN (S4) 19 FOR THE DIO TO PUSH 2x63t SCRAPPERS AND PLACE IN FILL AREA DESIGNATED (19) ALONG WITH 5x 627 SCRAPPERS CUTTING WHILE LINKED UP AND DIAGNOL IN FILL AREA 2x 925 COMPACTORS PUSHING ALONG MATERIAL IN APPROX 300mm LAYERS			
5. Instructions given on site			
WHILE GRADER RUNNING A BLADE OVER THE TOP FOR FASTER TURN AROUND 3x 627 SCRAPPERS STRIPPING PROPOSED FILL AREA ALL ORGANIC MATERIAL IS STOCKPILED FOR USE AT A LATER DATE			
COMMENTS:			
Signed: 			
Date: 09-11-17			

GEOTECHNICAL INSPECTION AND TESTING AUTHORITY

Accreditation No 2734 Corporate Site No 2727

LEVEL 1 DAILY REPORT

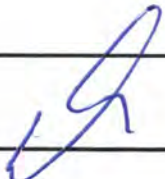Client:	Daracon Contractors Pty Ltd	Project No:	8599/1
Project:	Woorong Bulk Earthworks	Report No:	199
Location:	Marsden Park	Report Date:	10/11/2017
Test Methods:	AS 1289 5.1.1, 5.8.1	Technician:	Heath Wilson
Time on site: 0630		Time off site: 1700	
1. Subgrade Approval			
Areas ID	Subgrade Approval Report No:	Comments	
APPROVED SUBGRADE	SUBGRADE 19	TEST POINTS 3851 - 3873 / 25	
2. Lot Approval			
Lot ID	Lot Approval Report No:	Comments	
3. Survey			
Type of Survey	Survey undertaken by:	Reference	
Test Locations	Geotech /		
Lot Boundaries	Geotech /		
4. Instructions received on site			
COMMENTS: CONTROLLED MATERIAL WILL BE PLACED USING 825 IN 150MM LAPS			
Signed:			Date: 10-11-17


GEO TECHNICAL INSPECTION AND TESTING AUTHORITY

Accreditation No 2734 Corporate Site No 2727

SUBGRADE APPROVAL REPORT

Client: Daracon Contractors Pty Ltd
 Project: Woorong Bulk Earthworks
 Location: Marsden Park
 Subgrade Inspection Report

Project No: 8599/1
 Report No: S 16
 Report Date: 12.10.17
 Technician: Heath Wilson

Subgrade areas assessed		Area ID	Date	Approximate extent	Subgrade Description	Geometry Summary	Survey Reference	Approved (Yes/No)
		8599/1 - SUBGRADE 16	12.10.17	38218m ² 9444 ACRES	CLAY AND SAND EXPOSED AND ALL GEOTECH MATERIAL STRIPES AND STRIPES ARE LARGE USE	LARGE RECTANGULAR SECTION FROM STRIPES THE WEST (80Y)		Y
COMMENTS:								
Signed:  Date: 12.10.17								

GEOTECH

TESTING PTY LTD[®]

ABN 71 076 676 321




Quality
ISO 9001
SAI GLOBAL

GEOTECHNICAL INSPECTION AND TESTING AUTHORITY

Accreditation No 2734 Corporate Site No 2727

SUBGRADE APPROVAL REPORT

Client: Daracon Contractors Pty Ltd		Project No: 8599/1				
Project: Woorong Bulk Earthworks		Report No: S 17				
Location: Marsden Park		Report Date: 30/10/2017				
Subgrade Inspection Report		Technician: Heath Wilson				
Subgrade areas assessed						
Area ID	Date	Approximate extent m ²	Subgrade Description	Geometry Summary	Survey Reference	Approved (Yes/No)
SUBGRADE 17 8599/1.17	30/10/17	16578.682 4 0% slope	ALL SUBGRADES REMOVED AND EXCAVATING FOR FUTURE USE TO STURVEY EX ROAD AND REVERSE IS A (C+) CLAY AND HIGHLY OILY, MUDY CRACK	LONG RECTANGULAR STRIPS TO STURVEY EX ROAD		✓
COMMENTS:						
Signed: 						Date: 30/10/17

GEO TECH


TESTING PTY LTD[®]

ABN 71 076 676 321



Quality


ISO 9001

 

GEOTECHNICAL INSPECTION AND TESTING AUTHORITY

Accreditation No 2734 Corporate Site No 2727

SUBGRADE APPROVAL REPORT

Client: Daracon Contractors Pty Ltd		Project No: 8599/1				
Project: Woorong Bulk Earthworks		Report No: S 18				
Location: Marsden Park		Report Date: 03-11 / 2017				
Subgrade Inspection Report		Technician: Heath Wilson				
Subgrade areas assessed						
Area ID	Date	Approximate extent	Subgrade Description	Geometry Summary	Survey Reference	Approved (Yes/No)
S104 RADC 18 8599/E18	03-11-17	20142 m ² 4.977 ACRES	All TOPSOIL AND ORGANIC MATERIALS MAINTAINED (C) CLAY AND SILT ORANGE BROWN AND GRAY	RECTANGULAR SHAPE FORMING TO THE WEST SIDE OF ROAD		Y
COMMENTS:						
Signed: 						
Date: 03 11 17						

GEOTECH

TESTING PTY LTD®
ABN 71 076 676 321




Quality
ISO 9001
SA GLOBAL

GEOTECHNICAL INSPECTION AND TESTING AUTHORITY

Accreditation No 2734 Corporate Site No 2727

SUBGRADE APPROVAL REPORT

Client: Daracon Contractors Pty Ltd		Project No: 8599/1				
Project: Woorong Bulk Earthworks		Report No: S 19				
Location: Marsden Park		Report Date: 09/11/17				
Subgrade Inspection Report		Technician: Heath Wilson				
Subgrade areas assessed						
Area ID	Date	Approximate extent	Subgrade Description	Geometry Summary	Survey Reference	Approved (Yes/No)
SUBGRADE-19 8599/1-19	09/11/17	76021m ² 18795 ACR	R1) CLAY MED-DIST BROWN MED TO HIGH CHANNELS/POCK	SQUARE SHAPE BATTER TO THE EAST		Y
COMMENTS:						
Signed: 						
Date: 09/11/17						

Our Ref: 8599/1-R15
30 April 2018

Daracon Contractors Pty Ltd
P O Box 6145
SILVERWATER BC NSW 1811
Email: SimpsonW@daracon.com.au

Attention: Mr S Wong

Dear Sir

Re: **Woorong Bulk Earthworks
Marsden Park
Monthly Site Filling Certificate – April 2018**

For the production period 21 March to 19 April 2018, inclusive, we submit our Geotech Monthly Report for the above project.

During the foregoing testing period, a total of one hundred & forty nine compaction control tests (Tests 5773 to 5921, inclusive) were carried out and reported. The locations of the 218 tests are shown on the attached Drawing Nos 8599/1-96 to 8599/1-99, inclusive (4 drawings). All tests have been undertaken in accordance with the Test Methods and Specifications shown on the attached certificates. Scanned daily records and subgrade reports are also attached.

Based on the fill quantities/survey data, the frequency of field density and compaction tests was in accordance with Level 1 as defined in AS3798 "Guidelines on Earthworks for Commercial & Residential Development". We certify that all tested locations attained the density ratio shown on the test results sheets. Where failures were encountered, the areas were re-worked and re-tested to achieve the specified density ratio.

Based on site observations and testing, it is considered that the fill placed to date at the locations shown on the attached drawings is classified as "Controlled" fill and that the specified compaction level has been achieved within the tested area.

If you have any questions, please do not hesitate to contact the undersigned.

Yours faithfully
GEOTECH TESTING PTY LTD



Adrian Kench
Laboratory Manager

Attached Density Test Results Certificates Tests 5773 to 5921
Test Location Drawings 8599/1-96 to 8599/1-99
Daily Records

FIELD DENSITY RESULTS

DARACON CONTRACTORS PTY LTD
184 ADDERLEY STREET WEST
AUBURN NSW 2144

Laboratory: Penrith
Job No: 8599/1
Date: 30/04/2018

PROJECT: SITE FILL TESTING - AREA B
RESIDENTIAL DEVELOPMENT.WOORONG PARK, MARSDEN PARK

TEST NUMBER	5773	5774	5775	5776	5777	5778	5779	5780			
DATE TESTED	28/03/2018										
RESULTS											
Hilf Density Ratio	Standard	%	96	95	95.5	96.5	97	95	95	95	95.5
Moisture Variation from OMC (-Drier/+Wetter)		%	0.0	0.5	0.0	0.0	0.0	0.0	0.0	0.0	0.0
Specification	Density Ratio (Standard)	≥95%	Specification				Moisture Variance from OMC				±2%
TEST LOCATION											
Easting	295996.108	295997.311	295997.664	295994.479	295989.869	295998.226	296002.825	296005.928			
Northing	6268569.927	6268611.335	6268652.058	6268690.794	6268720.377	6268734.361	6268701.073	6268665.815			
Reduced Level	m		22.663	22.751	23.092	22.983	22.323	22.24	22.818	22.979	
Shown on Drawing No	8599/1-99				8599/1-98						
Retested by Test	-	-	-	-	-	-	-	-			
FIELD & LABORATORY DATA											
Field Wet Density	t/m ³	2.08	2.04	2.06	2.09	2.10	2.07	2.06	2.07		
Field Moisture Content	%	15.0	16.5	17.0	16.0	15.5	15.5	15.0	15.5		
Material retained on 19mm Sieve (wet)	%	<5	<5	<5	<5	<5	<5	<5	<5		
Lab Compaction result from test number		5773	5774	5775	5776	5777	5778	5779	5780		
Peak Converted Wet Density	t/m ³	2.17	2.15	2.16	2.17	2.16	2.18	2.17	2.17		
Apparent Optimum Moisture Content	%	14.5	15.5	16.5	16.0	15.5	15.5	15.0	15.5		
Number of Compaction Points		3	3	3	3	3	3	3	3		
Test Procedures - See Note Number		12	12	12	12	12	12	12	12		
Material Description - see below		2	2	2	2	2	2	2	2		
Notes											
1: Assigned Values have been obtained from our Penrith laboratory – Accreditation No 2734					10: AS 1289 1.2.1 clause 6.4 (b), 2.1.1, 5.3.1, 5.5.1, 5.6.1						
2: Assigned Values have been obtained from our Prestons laboratory – Accreditation No 14234					11: AS 1289 1.2.1 clause 6.4 (b), 2.1.1, 5.3.1, 5.7.1						
3: Results have been calculated using infinite decimal places. Therefore, calculated values may vary from those shown					12: AS 1289 1.2.1 clause 6.4 (b), 2.1.1, 5.7.1, 5.8.1						
4: AS 1289 1.2.1 clause 6.4 (b), 2.1.1, 5.1.1, 5.3.1, 5.4.1					13: RMS T111, T119, T120, T166						
5: AS 1289 1.2.1 clause 6.4 (b), 2.1.1, 5.2.1, 5.3.1, 5.4.1					14: RMS T111, T120, T166, T173						
6: AS 1289 1.2.1 clause 6.4 (b),					15: RMS T120, T119, T162						
7: AS 1289 1.2.1 clause 6.4 (b), 2.1.1, 5.2.1, 5.4.1, 5.8.1					16: RMS T120, T162, T173						
8: AS 1289 1.2.1 clause 6.4 (b), 2.1.1., 5.5.1, 5.6.1, 5.8.1					17: RMS T120, T164, T173						
9: Full details of Test Procedure 5.8.1 available on request											
Material Description											
1. CL-Clays of low plasticity, gravelly clays, sandy clays, silty clays			11. DGS40			* Cement Stabilised					
2. CI-Clay of medium plasticity, gravelly clays, sandy clays, silty clays			12. FCR20			# Lime Stabilised					
3. CH-Clays of high plasticity			13. FCR40			\$ Gypsum Stabilised					
4. SC-Clayey sands, sand-clay mixtures			14. RC - Recycled Concrete								
5. SM-Silty sands, sand-silt mixtures			15. Recycled Roadbase								
6. GC-Clayey gravels, gravel-sand-clay mixtures			16. RSB - Recycled Sub-base								
7. SP-Sand, crushed dust, filling sand, washed sand			17. CSS - Crushed Sandstone								
8. DGB20			18. RSS - Ripped Sandstone								
9. DGB40			19. Cowels Brown								
10. DGS20											

Form No R 020c Version 01 06/17 - issued by ER



Accreditation Number 2734
Corporate Site Number 2727

Accredited for compliance with
ISO/IEC 17025 - Testing.

A Kench 30/04/2018

Approved Signatory

Head Office:
34 Borec Road, Penrith NSW 2750
P O Box 880 Penrith NSW 2751
Telephone: (02) 4722 2:

Prestons Laboratory:
Unit 4, 18-20 Whyalla Place, Prestons NSW 2170
Telephone: (02) 9607 6111 Facsimile: (02) 9607 6200

FIELD DENSITY RESULTS

DARACON CONTRACTORS PTY LTD
184 ADDERLEY STREET WEST
AUBURN NSW 2144

Laboratory: Penrith
Job No: 8599/1
Date: 30/04/2018

PROJECT: SITE FILL TESTING - AREA B
RESIDENTIAL DEVELOPMENT.WOORONG PARK, MARSDEN PARK

Page 2 of 19

TEST NUMBER	5781	5782	5783	5784	5785	5786	5787	5788		
DATE TESTED	28/03/2018									
RESULTS										
Hilf Density Ratio	Standard	%	95.5	97	96.5	95.5	98	96.5	95	97
Moisture Variation from OMC (-Drier/+Wetter)		%	0.0	0.0	0.0	0.0	0.0	0.0	0.0	0.0
Specification	Density Ratio (Standard)	≥95%	Specification			Moisture Variance from OMC			±2%	
TEST LOCATION										
Easting	296007.576	296007.874	296011.528	296031.929	296030.23	296025.336	296019.038	296016.024		
Northing	6268636.257	6268599.751	6268569.555	6268578.028	6268613.169	6268645.311	6268685.921	6268720.483		
Reduced Level	m		23.177	22.984	22.942	23.175	23.279	23.097	22.935	22.535
Shown on Drawing No			8599/1-98			8599/1-98				
Retested by Test	-	-	-	-	-	-	-	-		
FIELD & LABORATORY DATA										
Field Wet Density	t/m ³	2.08	2.10	2.09	2.06	2.12	2.10	2.06	2.09	
Field Moisture Content	%	15.5	15.0	15.0	14.0	15.5	16.0	16.0	15.5	
Material retained on 19mm Sieve (wet)	%	<5	<5	<5	<5	<5	<5	<5	<5	
Lab Compaction result from test number		5781	5782	5783	5784	5785	5786	5787	5788	
Peak Converted Wet Density	t/m ³	2.18	2.16	2.17	2.16	2.16	2.18	2.17	2.16	
Apparent Optimum Moisture Content	%	15.5	15.0	15.0	14.0	15.5	16.0	16.0	15.5	
Number of Compaction Points		3	3	3	3	3	3	3	3	
Test Procedures - See Note Number		12	12	12	12	12	12	12	12	
Material Description - see below		2	2	2	2	2	2	2	2	
Notes										
1: Assigned Values have been obtained from our Penrith laboratory – Accreditation No 2734					10: AS 1289 1.2.1 clause 6.4 (b), 2.1.1, 5.3.1, 5.5.1, 5.6.1					
2: Assigned Values have been obtained from our Prestons laboratory – Accreditation No 14234					11: AS 1289 1.2.1 clause 6.4 (b), 2.1.1, 5.3.1, 5.7.1					
3: Results have been calculated using infinite decimal places. Therefore, calculated values may vary from those shown					12: AS 1289 1.2.1 clause 6.4 (b), 2.1.1, 5.7.1, 5.8.1					
4: AS 1289 1.2.1 clause 6.4 (b), 2.1.1, 5.1.1, 5.3.1, 5.4.1					13: RMS T111, T119, T120, T166					
5: AS 1289 1.2.1 clause 6.4 (b), 2.1.1, 5.2.1, 5.3.1, 5.4.1					14: RMS T111, T120, T166, T173					
6: AS 1289 1.2.1 clause 6.4 (b),					15: RMS T120, T119, T162					
7: AS 1289 1.2.1 clause 6.4 (b), 2.1.1, 5.2.1, 5.4.1, 5.8.1					16: RMS T120, T162, T173					
8: AS 1289 1.2.1 clause 6.4 (b), 2.1.1., 5.5.1, 5.6.1, 5.8.1					17: RMS T120, T164, T173					
9: Full details of Test Procedure 5.8.1 available on request										
Material Description										
1. CL-Clays of low plasticity, gravelly clays, sandy clays, silty clays			11. DGS40			* Cement Stabilised				
2. CI-Clay of medium plasticity, gravelly clays, sandy clays, silty clays			12. FCR20			# Lime Stabilised				
3. CH-Clays of high plasticity			13. FCR40			\$ Gypsum Stabilised				
4. SC-Clayey sands, sand-clay mixtures			14. RC - Recycled Concrete							
5. SM-Silty sands, sand-silt mixtures			15. Recycled Roadbase							
6. GC-Clayey gravels, gravel-sand-clay mixtures			16. RSB - Recycled Sub-base							
7. SP-Sand, crushed dust, filling sand, washed sand			17. CSS - Crushed Sandstone							
8. DGB20			18. RSS - Ripped Sandstone							
9. DGB40			19. Cowels Brown							
10. DGS20										

Form No R 020c Version 01 06/17 - issued by ER



Accreditation Number 2734
Corporate Site Number 2727

Accredited for compliance with
ISO/IEC 17025 - Testing.

A Kench 30/04/2018

Approved Signatory

Head Office:
34 Borec Road, Penrith NSW 2750
P O Box 880 Penrith NSW 2751
Telephone: (02) 4722 2:

Prestons Laboratory:
Unit 4, 18-20 Whyalla Place, Prestons NSW 2170
Telephone: (02) 9607 6111 Facsimile: (02) 9607 6200

FIELD DENSITY RESULTS

DARACON CONTRACTORS PTY LTD
184 ADDERLEY STREET WEST
AUBURN NSW 2144

Laboratory: Penrith
Job No: 8599/1
Date: 30/04/2018

PROJECT: SITE FILL TESTING - AREA B
RESIDENTIAL DEVELOPMENT.WOORONG PARK, MARSDEN PARK

Page 3 of 19

TEST NUMBER	5789	5790	5791	5792	5793	5794	5795	5796						
DATE TESTED	28/03/2018						29/03/2018							
RESULTS														
Hilf Density Ratio	Standard	%	95.5	96.5	95.5	96.5	97	96	101	98				
Moisture Variation from OMC (-Drier/+Wetter)		%	0.0	0.0	0.0	0.0	0.0	0.0	-0.5	-0.5				
Specification	Density Ratio (Standard)	≥95%	Specification				Moisture Variance from OMC			±2%				
TEST LOCATION														
Easting	296022.956	296035.792	296041.714	296046.939	296051.023	296052.824	296090.147	296089.833						
Northing	6268742.023	6268726.872	6268689.102	6268652.285	6268615.67	6268579.941	6268502.061	6268537.396						
Reduced Level	m						22.276	22.247	22.65	23.034	23.429	23.279	23.113	23.337
Shown on Drawing No	8599/1-98						8599/1-99							
Retested by Test	-	-	-	-	-	-	-	-						
FIELD & LABORATORY DATA														
Field Wet Density	t/m ³	2.07	2.08	2.08	2.09	2.10	2.09	2.09	2.07					
Field Moisture Content	%	15.0	14.0	16.0	14.0	15.5	15.5	15.5	15.0					
Material retained on 19mm Sieve (wet)	%	<5	<5	<5	<5	<5	<5	<5	<5					
Lab Compaction result from test number		5789	5790	5791	5792	5793	5794	5795	5796					
Peak Converted Wet Density	t/m ³	2.17	2.16	2.18	2.17	2.16	2.18	2.07	2.11					
Apparent Optimum Moisture Content	%	15.0	14.0	16.0	14.0	15.5	15.0	16.0	16.0					
Number of Compaction Points		3	3	3	3	3	3	3	3					
Test Procedures - See Note Number		12	12	12	12	12	12	12	12					
Material Description - see below		2	2	2	2	2	2	2	2					
Notes														
1: Assigned Values have been obtained from our Penrith laboratory – Accreditation No 2734					10: AS 1289 1.2.1 clause 6.4 (b), 2.1.1, 5.3.1, 5.5.1, 5.6.1									
2: Assigned Values have been obtained from our Prestons laboratory – Accreditation No 14234					11: AS 1289 1.2.1 clause 6.4 (b), 2.1.1, 5.3.1, 5.7.1									
3: Results have been calculated using infinite decimal places. Therefore, calculated values may vary from those shown					12: AS 1289 1.2.1 clause 6.4 (b), 2.1.1, 5.7.1, 5.8.1									
4: AS 1289 1.2.1 clause 6.4 (b), 2.1.1, 5.1.1, 5.3.1, 5.4.1					13: RMS T111, T119, T120, T166									
5: AS 1289 1.2.1 clause 6.4 (b), 2.1.1, 5.2.1, 5.3.1, 5.4.1					14: RMS T111, T120, T166, T173									
6: AS 1289 1.2.1 clause 6.4 (b),					15: RMS T120, T119, T162									
7: AS 1289 1.2.1 clause 6.4 (b), 2.1.1, 5.2.1, 5.4.1, 5.8.1					16: RMS T120, T162, T173									
8: AS 1289 1.2.1 clause 6.4 (b), 2.1.1., 5.5.1, 5.6.1, 5.8.1					17: RMS T120, T164, T173									
9: Full details of Test Procedure 5.8.1 available on request														
Material Description														
1. CL-Clays of low plasticity, gravelly clays, sandy clays, silty clays			11. DGS40			* Cement Stabilised								
2. CI-Clay of medium plasticity, gravelly clays, sandy clays, silty clays			12. FCR20			# Lime Stabilised								
3. CH-Clays of high plasticity			13. FCR40			\$ Gypsum Stabilised								
4. SC-Clayey sands, sand-clay mixtures			14. RC - Recycled Concrete											
5. SM-Silty sands, sand-silt mixtures			15. Recycled Roadbase											
6. GC-Clayey gravels, gravel-sand-clay mixtures			16. RSB - Recycled Sub-base											
7. SP-Sand, crushed dust, filling sand, washed sand			17. CSS - Crushed Sandstone											
8. DGB20			18. RSS - Ripped Sandstone											
9. DGB40			19. Cowels Brown											
10. DGS20														

Form No R 020c Version 01 06/17 - issued by ER



Accreditation Number 2734
Corporate Site Number 2727

Accredited for compliance with
ISO/IEC 17025 - Testing.

A Kench 30/04/2018

Approved Signatory

Head Office:
34 Borec Road, Penrith NSW 2750
P O Box 880 Penrith NSW 2751
Telephone: (02) 4722 2:

Prestons Laboratory:
Unit 4, 18-20 Whyalla Place, Prestons NSW 2170
Telephone: (02) 9607 6111 Facsimile: (02) 9607 6200

FIELD DENSITY RESULTS

DARACON CONTRACTORS PTY LTD
184 ADDERLEY STREET WEST
AUBURN NSW 2144

Laboratory: Penrith
Job No: 8599/1
Date: 30/04/2018

PROJECT: SITE FILL TESTING - AREA B
RESIDENTIAL DEVELOPMENT.WOORONG PARK, MARSDEN PARK

Page 4 of 19

TEST NUMBER	5797	5798	5799	5800	5801	5802	5803	5804		
DATE TESTED	29/03/2018									
RESULTS										
Hilf Density Ratio	Standard	%	99.5	98	99	99.5	98	99	101	99.5
Moisture Variation from OMC (-Drier/+Wetter)		%	-0.5	-0.5	-0.5	-0.5	-0.5	-0.5	-0.5	-0.5
Specification	Density Ratio (Standard)	≥95%	Specification				Moisture Variance from OMC			±2%
TEST LOCATION										
Easting	296089.689	296089.171	296087.395	296085.783	296082.497	296078.374	296092.619	296098.46		
Northing	6268588.519	6268611.677	6268643.735	6268672.479	6268706.017	6268738.254	6268744.924	6268704.352		
Reduced Level	m		23.07	23.561	23.441	22.935	22.596	22.095	21.921	22.461
Shown on Drawing No	m		8599/1-99		8599/1-98					
Retested by Test	-	-	-	-	-	-	-	-	-	
FIELD & LABORATORY DATA										
Field Wet Density	t/m ³	2.07	2.07	2.07	2.09	2.06	2.07	2.12	2.09	
Field Moisture Content	%	15.5	13.5	15.5	14.5	14.5	14.5	14.5	14.0	
Material retained on 19mm Sieve (wet)	%	<5	<5	<5	<5	<5	<5	<5	<5	
Lab Compaction result from test number		5797	5798	5799	5800	5801	5802	5803	5804	
Peak Converted Wet Density	t/m ³	2.08	2.11	2.09	2.10	2.10	2.09	2.10	2.10	
Apparent Optimum Moisture Content	%	16.5	14.0	16.5	15.0	15.5	15.0	15.5	14.0	
Number of Compaction Points		3	3	3	3	3	3	3	3	
Test Procedures - See Note Number		12	12	12	12	12	12	12	12	
Material Description - see below		2	2	2	2	2	2	2	2	
Notes										
1: Assigned Values have been obtained from our Penrith laboratory – Accreditation No 2734					10: AS 1289 1.2.1 clause 6.4 (b), 2.1.1, 5.3.1, 5.5.1, 5.6.1					
2: Assigned Values have been obtained from our Prestons laboratory – Accreditation No 14234					11: AS 1289 1.2.1 clause 6.4 (b), 2.1.1, 5.3.1, 5.7.1					
3: Results have been calculated using infinite decimal places. Therefore, calculated values may vary from those shown					12: AS 1289 1.2.1 clause 6.4 (b), 2.1.1, 5.7.1, 5.8.1					
4: AS 1289 1.2.1 clause 6.4 (b), 2.1.1, 5.1.1, 5.3.1, 5.4.1					13: RMS T111, T119, T120, T166					
5: AS 1289 1.2.1 clause 6.4 (b), 2.1.1, 5.2.1, 5.3.1, 5.4.1					14: RMS T111, T120, T166, T173					
6: AS 1289 1.2.1 clause 6.4 (b),					15: RMS T120, T119, T162					
7: AS 1289 1.2.1 clause 6.4 (b), 2.1.1, 5.2.1, 5.4.1, 5.8.1					16: RMS T120, T162, T173					
8: AS 1289 1.2.1 clause 6.4 (b), 2.1.1., 5.5.1, 5.6.1, 5.8.1					17: RMS T120, T164, T173					
9: Full details of Test Procedure 5.8.1 available on request										
Material Description										
1. CL-Clays of low plasticity, gravelly clays, sandy clays, silty clays			11. DGS40			* Cement Stabilised				
2. CI-Clay of medium plasticity, gravelly clays, sandy clays, silty clays			12. FCR20			# Lime Stabilised				
3. CH-Clays of high plasticity			13. FCR40			\$ Gypsum Stabilised				
4. SC-Clayey sands, sand-clay mixtures			14. RC - Recycled Concrete							
5. SM-Silty sands, sand-silt mixtures			15. Recycled Roadbase							
6. GC-Clayey gravels, gravel-sand-clay mixtures			16. RSB - Recycled Sub-base							
7. SP-Sand, crushed dust, filling sand, washed sand			17. CSS - Crushed Sandstone							
8. DGB20			18. RSS - Ripped Sandstone							
9. DGB40			19. Cowels Brown							
10. DGS20										

Form No R 020c Version 01 06/17 - issued by ER



Accreditation Number 2734
Corporate Site Number 2727

Accredited for compliance with
ISO/IEC 17025 - Testing.

A Kench 30/04/2018

Approved Signatory

Head Office:
34 Borec Road, Penrith NSW 2750
P O Box 880 Penrith NSW 2751
Telephone: (02) 4722 2

Prestons Laboratory:
Unit 4, 18-20 Whyalla Place, Prestons NSW 2170
Telephone: (02) 9607 6111 Facsimile: (02) 9607 6200

FIELD DENSITY RESULTS

DARACON CONTRACTORS PTY LTD
184 ADDERLEY STREET WEST
AUBURN NSW 2144

Laboratory: Penrith
Job No: 8599/1
Date: 30/04/2018

PROJECT: SITE FILL TESTING - AREA B
RESIDENTIAL DEVELOPMENT.WOORONG PARK, MARSDEN PARK

Page 5 of 19

TEST NUMBER	5805	5806	5807	5808	5809	5810	5811	5812		
DATE TESTED	29/03/2018									
RESULTS										
Hilf Density Ratio	Standard	%	97	96.5	97.5	96.5	96.5	95.5	97	95.5
Moisture Variation from OMC (-Drier/+Wetter)		%	0.0	-0.5	0.0	0.0	-0.5	-0.5	-0.5	-0.5
Specification	Density Ratio (Standard)	≥95%	Specification				Moisture Variance from OMC			±2%
TEST LOCATION										
Easting	296104.388	296110.285	296118.632	296134.928	296133.503	296131.801	296126.387	296120.83		
Northing	6268673.695	6268645.331	6268582.242	6268576.517	6268608.431	6268636.977	6268676.482	6268709.973		
Reduced Level	m		22.898	23.43	23.466	23.392	23.58	23.627	23.011	22.709
Shown on Drawing No			8599/1-98		8599/1-99		8599/1-98			
Retested by Test			-	-	-	-	-	-	-	
FIELD & LABORATORY DATA										
Field Wet Density	t/m ³	2.05	2.08	2.08	2.06	2.07	2.11	2.09		
Field Moisture Content	%	15.5	15.5	16.5	16.0	15.0	15.0	14.5	15.5	
Material retained on 19mm Sieve (wet)	%	<5	<5	<5	<5	<5	<5	<5	<5	
Lab Compaction result from test number		5805	5806	5807	5808	5809	5810	5811	5812	
Peak Converted Wet Density	t/m ³	2.11	2.15	2.13	2.14	2.15	2.17	2.18	2.19	
Apparent Optimum Moisture Content	%	15.5	16.0	16.5	16.0	16.0	15.5	15.5	16.0	
Number of Compaction Points		3	3	3	3	3	3	3	3	
Test Procedures - See Note Number		12	12	12	12	12	12	12	12	
Material Description - see below		2	2	2	2	2	2	2	2	
Notes										
1: Assigned Values have been obtained from our Penrith laboratory – Accreditation No 2734					10: AS 1289 1.2.1 clause 6.4 (b), 2.1.1, 5.3.1, 5.5.1, 5.6.1					
2: Assigned Values have been obtained from our Prestons laboratory – Accreditation No 14234					11: AS 1289 1.2.1 clause 6.4 (b), 2.1.1, 5.3.1, 5.7.1					
3: Results have been calculated using infinite decimal places. Therefore, calculated values may vary from those shown					12: AS 1289 1.2.1 clause 6.4 (b), 2.1.1, 5.7.1, 5.8.1					
4: AS 1289 1.2.1 clause 6.4 (b), 2.1.1, 5.1.1, 5.3.1, 5.4.1					13: RMS T111, T119, T120, T166					
5: AS 1289 1.2.1 clause 6.4 (b), 2.1.1, 5.2.1, 5.3.1, 5.4.1					14: RMS T111, T120, T166, T173					
6: AS 1289 1.2.1 clause 6.4 (b),					15: RMS T120, T119, T162					
7: AS 1289 1.2.1 clause 6.4 (b), 2.1.1, 5.2.1, 5.4.1, 5.8.1					16: RMS T120, T162, T173					
8: AS 1289 1.2.1 clause 6.4 (b), 2.1.1., 5.5.1, 5.6.1, 5.8.1					17: RMS T120, T164, T173					
9: Full details of Test Procedure 5.8.1 available on request										
Material Description										
1. CL-Clays of low plasticity, gravelly clays, sandy clays, silty clays			11. DGS40			* Cement Stabilised				
2. CI-Clay of medium plasticity, gravelly clays, sandy clays, silty clays			12. FCR20			# Lime Stabilised				
3. CH-Clays of high plasticity			13. FCR40			\$ Gypsum Stabilised				
4. SC-Clayey sands, sand-clay mixtures			14. RC - Recycled Concrete							
5. SM-Silty sands, sand-silt mixtures			15. Recycled Roadbase							
6. GC-Clayey gravels, gravel-sand-clay mixtures			16. RSB - Recycled Sub-base							
7. SP-Sand, crushed dust, filling sand, washed sand			17. CSS - Crushed Sandstone							
8. DGB20			18. RSS - Ripped Sandstone							
9. DGB40			19. Cowels Brown							
10. DGS20										

Form No R 020c Version 01 06/17 - issued by ER



Accreditation Number 2734
Corporate Site Number 2727

Accredited for compliance with
ISO/IEC 17025 - Testing.

A Kench 30/04/2018

Approved Signatory

Head Office:
34 Borec Road, Penrith NSW 2750
P O Box 880 Penrith NSW 2751
Telephone: (02) 4722 2:

Prestons Laboratory:
Unit 4, 18-20 Whyalla Place, Prestons NSW 2170
Telephone: (02) 9607 6111 Facsimile: (02) 9607 6200

FIELD DENSITY RESULTS

DARACON CONTRACTORS PTY LTD
184 ADDERLEY STREET WEST
AUBURN NSW 2144

Laboratory: Penrith
Job No: 8599/1
Date: 30/04/2018

PROJECT: SITE FILL TESTING - AREA B
RESIDENTIAL DEVELOPMENT.WOORONG PARK, MARSDEN PARK

Page 6 of 19

TEST NUMBER	5813	5814	5815	5816	5817	5818	5819	5820		
DATE TESTED	03/04/2018									
RESULTS										
Hilf Density Ratio	Standard	%	104.5	104	103	101	105	105	104.5	101
Moisture Variation from OMC (-Drier/+Wetter)		%	0.0	0.0	-0.5	0.0	-0.5	0.5	0.0	0.0
Specification	Density Ratio (Standard)	≥95%	Specification			Moisture Variance from OMC			±2%	
TEST LOCATION										
Easting	296119.522	296131.94	296134.801	296143.966	296150.117	296103.649	296103.536	296104.903		
Northing	6268756.056	6268741.608	6268710.616	6268662.589	6268621.357	6268565.432	6268542.254	6268503.98		
Reduced Level	m		21.836	22.244	22.717	23.324	23.796	23.727	23.74	23.563
Shown on Drawing No	8599/1-98						8599/1-99			
Retested by Test	-	-	-	-	-	-	-	-		
FIELD & LABORATORY DATA										
Field Wet Density	t/m ³	2.06	2.08	2.09	2.07	2.09	2.12	2.08	2.06	
Field Moisture Content	%	15.5	16.5	17.5	16.0	15.0	15.0	16.0	15.5	
Material retained on 19mm Sieve (wet)	%	<5	<5	<5	<5	<5	<5	<5	<5	
Lab Compaction result from test number		5813	5814	5815	5816	5817	5818	5819	5820	
Peak Converted Wet Density	t/m ³	1.97	2.00	2.03	2.05	1.99	2.02	1.99	2.04	
Apparent Optimum Moisture Content	%	15.0	16.5	18.0	16.0	15.5	14.5	16.0	15.5	
Number of Compaction Points		3	3	3	3	3	3	3	3	
Test Procedures - See Note Number		12	12	12	12	12	12	12	12	
Material Description - see below		2	2	2	2	2	2	2	2	
Notes										
1: Assigned Values have been obtained from our Penrith laboratory – Accreditation No 2734					10: AS 1289 1.2.1 clause 6.4 (b), 2.1.1, 5.3.1, 5.5.1, 5.6.1					
2: Assigned Values have been obtained from our Prestons laboratory – Accreditation No 14234					11: AS 1289 1.2.1 clause 6.4 (b), 2.1.1, 5.3.1, 5.7.1					
3: Results have been calculated using infinite decimal places. Therefore, calculated values may vary from those shown					12: AS 1289 1.2.1 clause 6.4 (b), 2.1.1, 5.7.1, 5.8.1					
4: AS 1289 1.2.1 clause 6.4 (b), 2.1.1, 5.1.1, 5.3.1, 5.4.1					13: RMS T111, T119, T120, T166					
5: AS 1289 1.2.1 clause 6.4 (b), 2.1.1, 5.2.1, 5.3.1, 5.4.1					14: RMS T111, T120, T166, T173					
6: AS 1289 1.2.1 clause 6.4 (b),					15: RMS T120, T119, T162					
7: AS 1289 1.2.1 clause 6.4 (b), 2.1.1, 5.2.1, 5.4.1, 5.8.1					16: RMS T120, T162, T173					
8: AS 1289 1.2.1 clause 6.4 (b), 2.1.1., 5.5.1, 5.6.1, 5.8.1					17: RMS T120, T164, T173					
9: Full details of Test Procedure 5.8.1 available on request										
Material Description										
1. CL-Clays of low plasticity, gravelly clays, sandy clays, silty clays			11. DGS40			* Cement Stabilised				
2. CI-Clay of medium plasticity, gravelly clays, sandy clays, silty clays			12. FCR20			# Lime Stabilised				
3. CH-Clays of high plasticity			13. FCR40			\$ Gypsum Stabilised				
4. SC-Clayey sands, sand-clay mixtures			14. RC - Recycled Concrete							
5. SM-Silty sands, sand-silt mixtures			15. Recycled Roadbase							
6. GC-Clayey gravels, gravel-sand-clay mixtures			16. RSB - Recycled Sub-base							
7. SP-Sand, crushed dust, filling sand, washed sand			17. CSS - Crushed Sandstone							
8. DGB20			18. RSS - Ripped Sandstone							
9. DGB40			19. Cowels Brown							
10. DGS20										

Form No R 020c Version 01 06/17 - issued by ER



Accreditation Number 2734
Corporate Site Number 2727

Accredited for compliance with
ISO/IEC 17025 - Testing.

A Kench 30/04/2018

Approved Signatory

Head Office:
34 Borec Road, Penrith NSW 2750
P O Box 880 Penrith NSW 2751
Telephone: (02) 4722 2

Prestons Laboratory:
Unit 4, 18-20 Whyalla Place, Prestons NSW 2170
Telephone: (02) 9607 6111 Facsimile: (02) 9607 6200

FIELD DENSITY RESULTS

DARACON CONTRACTORS PTY LTD
184 ADDERLEY STREET WEST
AUBURN NSW 2144

Laboratory: Penrith
Job No: 8599/1
Date: 30/04/2018

PROJECT: SITE FILL TESTING - AREA B
RESIDENTIAL DEVELOPMENT.WOORONG PARK, MARSDEN PARK

Page 7 of 19

TEST NUMBER	5821	5822	5823	5824	5825	5826	5827	5828		
DATE TESTED	06/04/2018									
RESULTS										
Hilf Density Ratio	Standard	%	100	104	101	102	103.5	104	101	101
Moisture Variation from OMC (-Drier/+Wetter)		%	0.0	-0.5	0.0	-0.5	0.0	0.0	-0.5	0.0
Specification	Density Ratio (Standard)	≥95%	Specification				Moisture Variance from OMC			±2%
TEST LOCATION										
Easting	296147.705	296144.455	296140.512	296139.393	296150.508	296156.06	296161.05	296163.948		
Northing	6268611.083	6268651.303	6268706.339	6268736.266	6268761.758	6268715.472	6268660.726	6268627.348		
Reduced Level	m									
Shown on Drawing No	8599/1-98									
Retested by Test	-	-	-	-	-	-	-	-		
FIELD & LABORATORY DATA										
Field Wet Density	t/m ³	2.06	2.08	2.05	2.08	2.06	2.10	2.09	2.03	
Field Moisture Content	%	14.5	14.5	14.5	15.0	14.0	14.5	14.5	15.0	
Material retained on 19mm Sieve (wet)	%	<5	<5	<5	<5	<5	<5	<5	<5	
Lab Compaction result from test number		5821	5822	5823	5824	5825	5826	5827	5828	
Peak Converted Wet Density	t/m ³	2.06	2.00	2.03	2.04	1.99	2.02	2.07	2.01	
Apparent Optimum Moisture Content	%	14.5	15.0	14.5	15.5	14.0	14.5	15.0	15.0	
Number of Compaction Points		3	3	3	3	3	3	3	3	
Test Procedures - See Note Number		12	12	12	12	12	12	12	12	
Material Description - see below		2	2	2	2	2	2	2	2	
Notes										
1: Assigned Values have been obtained from our Penrith laboratory – Accreditation No 2734					10: AS 1289 1.2.1 clause 6.4 (b), 2.1.1, 5.3.1, 5.5.1, 5.6.1					
2: Assigned Values have been obtained from our Prestons laboratory – Accreditation No 14234					11: AS 1289 1.2.1 clause 6.4 (b), 2.1.1, 5.3.1, 5.7.1					
3: Results have been calculated using infinite decimal places. Therefore, calculated values may vary from those shown					12: AS 1289 1.2.1 clause 6.4 (b), 2.1.1, 5.7.1, 5.8.1					
4: AS 1289 1.2.1 clause 6.4 (b), 2.1.1, 5.1.1, 5.3.1, 5.4.1					13: RMS T111, T119, T120, T166					
5: AS 1289 1.2.1 clause 6.4 (b), 2.1.1, 5.2.1, 5.3.1, 5.4.1					14: RMS T111, T120, T166, T173					
6: AS 1289 1.2.1 clause 6.4 (b),					15: RMS T120, T119, T162					
7: AS 1289 1.2.1 clause 6.4 (b), 2.1.1, 5.2.1, 5.4.1, 5.8.1					16: RMS T120, T162, T173					
8: AS 1289 1.2.1 clause 6.4 (b), 2.1.1., 5.5.1, 5.6.1, 5.8.1					17: RMS T120, T164, T173					
9: Full details of Test Procedure 5.8.1 available on request										
Material Description										
1. CL-Clays of low plasticity, gravelly clays, sandy clays, silty clays			11. DGS40			* Cement Stabilised				
2. CI-Clay of medium plasticity, gravelly clays, sandy clays, silty clays			12. FCR20			# Lime Stabilised				
3. CH-Clays of high plasticity			13. FCR40			\$ Gypsum Stabilised				
4. SC-Clayey sands, sand-clay mixtures			14. RC - Recycled Concrete							
5. SM-Silty sands, sand-silt mixtures			15. Recycled Roadbase							
6. GC-Clayey gravels, gravel-sand-clay mixtures			16. RSB - Recycled Sub-base							
7. SP-Sand, crushed dust, filling sand, washed sand			17. CSS - Crushed Sandstone							
8. DGB20			18. RSS - Ripped Sandstone							
9. DGB40			19. Cowels Brown							
10. DGS20										

Form No R 020c Version 01 06/17 - issued by ER



Accreditation Number 2734
Corporate Site Number 2727

Accredited for compliance with
ISO/IEC 17025 - Testing.

A Kench 30/04/2018

Approved Signatory

Head Office:
34 Borec Road, Penrith NSW 2750
P O Box 880 Penrith NSW 2751
Telephone: (02) 4722 2:

Prestons Laboratory:
Unit 4, 18-20 Whyalla Place, Prestons NSW 2170
Telephone: (02) 9607 6111 Facsimile: (02) 9607 6200

FIELD DENSITY RESULTS

DARACON CONTRACTORS PTY LTD
184 ADDERLEY STREET WEST
AUBURN NSW 2144

Laboratory: Penrith
Job No: 8599/1
Date: 30/04/2018

PROJECT: SITE FILL TESTING - AREA B
RESIDENTIAL DEVELOPMENT.WOORONG PARK, MARSDEN PARK

Page 8 of 19

TEST NUMBER	5829	5830	5831	5832	5833	5834	5835	5836		
DATE TESTED	06/04/2018				07/04/2018					
RESULTS										
Hilf Density Ratio	Standard	%	104	102	100	102	103	101.5	103	101
Moisture Variation from OMC (-Drier/+Wetter)		%	-0.5	0.5	0.0	0.0	-0.5	-0.5	0.5	0.5
Specification	Density Ratio (Standard)	≥95%	Specification				Moisture Variance from OMC			±2%
TEST LOCATION										
Easting	296182.098	296173.278	296168.32	296179.885	296191.426	296212.882	296205.897	296211.368		
Northing	6268629.437	6268698.228	6268744.888	6268763.816	6268721.13	6268636.547	6268652.963	6268692.203		
Reduced Level	m 23.426 23.666 23.041 22.507 23.322 23.041 23.006 23.542									
Shown on Drawing No	8599/1-98									
Retested by Test	-	-	-	-	-	-	-	-		
FIELD & LABORATORY DATA										
Field Wet Density	t/m ³	2.07	2.06	2.05	2.07	2.11	2.02	2.07	2.06	
Field Moisture Content	%	15.0	15.0	15.5	14.0	15.0	14.0	14.5	15.0	
Material retained on 19mm Sieve (wet)	%	<5	<5	<5	<5	<5	<5	<5	<5	
Lab Compaction result from test number		5829	5830	5831	5832	5833	5834	5835	5836	
Peak Converted Wet Density	t/m ³	1.99	2.02	2.05	2.03	2.05	1.99	2.01	2.04	
Apparent Optimum Moisture Content	%	15.5	14.5	15.0	13.5	15.0	15.0	14.5	14.5	
Number of Compaction Points		3	3	3	3	3	3	3	3	
Test Procedures - See Note Number		12	12	12	12	12	12	12	12	
Material Description - see below		2	2	2	2	2	2	2	2	
Notes										
1: Assigned Values have been obtained from our Penrith laboratory – Accreditation No 2734					10: AS 1289 1.2.1 clause 6.4 (b), 2.1.1, 5.3.1, 5.5.1, 5.6.1					
2: Assigned Values have been obtained from our Prestons laboratory – Accreditation No 14234					11: AS 1289 1.2.1 clause 6.4 (b), 2.1.1, 5.3.1, 5.7.1					
3: Results have been calculated using infinite decimal places. Therefore, calculated values may vary from those shown					12: AS 1289 1.2.1 clause 6.4 (b), 2.1.1, 5.7.1, 5.8.1					
4: AS 1289 1.2.1 clause 6.4 (b), 2.1.1, 5.1.1, 5.3.1, 5.4.1					13: RMS T111, T119, T120, T166					
5: AS 1289 1.2.1 clause 6.4 (b), 2.1.1, 5.2.1, 5.3.1, 5.4.1					14: RMS T111, T120, T166, T173					
6: AS 1289 1.2.1 clause 6.4 (b),					15: RMS T120, T119, T162					
7: AS 1289 1.2.1 clause 6.4 (b), 2.1.1, 5.2.1, 5.4.1, 5.8.1					16: RMS T120, T162, T173					
8: AS 1289 1.2.1 clause 6.4 (b), 2.1.1., 5.5.1, 5.6.1, 5.8.1					17: RMS T120, T164, T173					
9: Full details of Test Procedure 5.8.1 available on request										
Material Description										
1. CL-Clays of low plasticity, gravelly clays, sandy clays, silty clays			11. DGS40			* Cement Stabilised				
2. CI-Clay of medium plasticity, gravelly clays, sandy clays, silty clays			12. FCR20			# Lime Stabilised				
3. CH-Clays of high plasticity			13. FCR40			\$ Gypsum Stabilised				
4. SC-Clayey sands, sand-clay mixtures			14. RC - Recycled Concrete							
5. SM-Silty sands, sand-silt mixtures			15. Recycled Roadbase							
6. GC-Clayey gravels, gravel-sand-clay mixtures			16. RSB - Recycled Sub-base							
7. SP-Sand, crushed dust, filling sand, washed sand			17. CSS - Crushed Sandstone							
8. DGB20			18. RSS - Ripped Sandstone							
9. DGB40			19. Cowels Brown							
10. DGS20										

Form No R 020c Version 01 06/17 - issued by ER



Accreditation Number 2734
Corporate Site Number 2727

Accredited for compliance with
ISO/IEC 17025 - Testing.

A Kench 30/04/2018

Approved Signatory

Head Office:
34 Borec Road, Penrith NSW 2750
P O Box 880 Penrith NSW 2751
Telephone: (02) 4722 2:

Prestons Laboratory:
Unit 4, 18-20 Whyalla Place, Prestons NSW 2170
Telephone: (02) 9607 6111 Facsimile: (02) 9607 6200

FIELD DENSITY RESULTS

DARACON CONTRACTORS PTY LTD
184 ADDERLEY STREET WEST
AUBURN NSW 2144

Laboratory: Penrith
Job No: 8599/1
Date: 30/04/2018

PROJECT: SITE FILL TESTING - AREA B
RESIDENTIAL DEVELOPMENT.WOORONG PARK, MARSDEN PARK

Page 9 of 19

TEST NUMBER	5837	5838	5839	5840	5841	5842	5843	5844		
DATE TESTED	07/04/2018			09/04/2018						
RESULTS										
Hilf Density Ratio	Standard	%	104.5	104	104	103.5	104.5	99.5	100.5	99.5
Moisture Variation from OMC (-Drier/+Wetter)		%	-0.5	0.0	0.0	-1.0	-1.0	0.0	0.0	0.5
Specification	Density Ratio (Standard)	≥95%	Specification			Moisture Variance from OMC			±2%	
TEST LOCATION										
Easting	296207.141	296206.396	296201.909	296027.702	296028.145	296012.204	296001.582	295970.441		
Northing	6268709.886	6268669.718	6268639.13	6268577.804	6268542.12	6268521.811	6268558.905	6268550.284		
Reduced Level	m		23.104	23.403	23.327	23.735	23.121	22.696	23.292	23.022
Shown on Drawing No	8599/1-98				8599/1-99					
Retested by Test	-	-	-	-	-	-	-	-		
FIELD & LABORATORY DATA										
Field Wet Density	t/m ³	2.07	2.06	2.07	2.07	2.06	2.09	2.08	2.00	
Field Moisture Content	%	15.0	13.5	14.5	14.5	14.0	14.5	14.5	14.0	
Material retained on 19mm Sieve (wet)	%	<5	<5	<5	<5	<5	<5	<5	<5	
Lab Compaction result from test number		5837	5838	5839	5840	5841	5842	5843	5844	
Peak Converted Wet Density	t/m ³	1.98	1.98	1.99	2.00	1.97	2.10	2.07	2.01	
Apparent Optimum Moisture Content	%	15.5	13.5	14.5	15.0	15.0	15.0	15.0	14.0	
Number of Compaction Points		3	3	3	3	3	3	3	3	
Test Procedures - See Note Number		12	12	12	12	12	12	12	12	
Material Description - see below		2	1-2	2	2	2	2	2	2	
Notes										
1: Assigned Values have been obtained from our Penrith laboratory – Accreditation No 2734					10: AS 1289 1.2.1 clause 6.4 (b), 2.1.1, 5.3.1, 5.5.1, 5.6.1					
2: Assigned Values have been obtained from our Prestons laboratory – Accreditation No 14234					11: AS 1289 1.2.1 clause 6.4 (b), 2.1.1, 5.3.1, 5.7.1					
3: Results have been calculated using infinite decimal places. Therefore, calculated values may vary from those shown					12: AS 1289 1.2.1 clause 6.4 (b), 2.1.1, 5.7.1, 5.8.1					
4: AS 1289 1.2.1 clause 6.4 (b), 2.1.1, 5.1.1, 5.3.1, 5.4.1					13: RMS T111, T119, T120, T166					
5: AS 1289 1.2.1 clause 6.4 (b), 2.1.1, 5.2.1, 5.3.1, 5.4.1					14: RMS T111, T120, T166, T173					
6: AS 1289 1.2.1 clause 6.4 (b),					15: RMS T120, T119, T162					
7: AS 1289 1.2.1 clause 6.4 (b), 2.1.1, 5.2.1, 5.4.1, 5.8.1					16: RMS T120, T162, T173					
8: AS 1289 1.2.1 clause 6.4 (b), 2.1.1., 5.5.1, 5.6.1, 5.8.1					17: RMS T120, T164, T173					
9: Full details of Test Procedure 5.8.1 available on request										
Material Description										
1. CL-Clays of low plasticity, gravelly clays, sandy clays, silty clays			11. DGS40			* Cement Stabilised				
2. CI-Clay of medium plasticity, gravelly clays, sandy clays, silty clays			12. FCR20			# Lime Stabilised				
3. CH-Clays of high plasticity			13. FCR40			\$ Gypsum Stabilised				
4. SC-Clayey sands, sand-clay mixtures			14. RC - Recycled Concrete							
5. SM-Silty sands, sand-silt mixtures			15. Recycled Roadbase							
6. GC-Clayey gravels, gravel-sand-clay mixtures			16. RSB - Recycled Sub-base							
7. SP-Sand, crushed dust, filling sand, washed sand			17. CSS - Crushed Sandstone							
8. DGB20			18. RSS - Ripped Sandstone							
9. DGB40			19. Cowels Brown							
10. DGS20										

Form No R 020c Version 01 06/17 - issued by ER



Accreditation Number 2734
Corporate Site Number 2727

Accredited for compliance with
ISO/IEC 17025 - Testing.

A Kench 30/04/2018

Approved Signatory

Head Office:
34 Borec Road, Penrith NSW 2750
P O Box 880 Penrith NSW 2751
Telephone: (02) 4722 2

Prestons Laboratory:
Unit 4, 18-20 Whyalla Place, Prestons NSW 2170
Telephone: (02) 9607 6111 Facsimile: (02) 9607 6200

FIELD DENSITY RESULTS

DARACON CONTRACTORS PTY LTD
184 ADDERLEY STREET WEST
AUBURN NSW 2144

Laboratory: Penrith
Job No: 8599/1
Date: 30/04/2018

PROJECT: SITE FILL TESTING - AREA B
RESIDENTIAL DEVELOPMENT.WOORONG PARK, MARSDEN PARK

TEST NUMBER	5845	5846	5847	5848	5849	5850	5851	5852		
DATE TESTED	09/04/2018						10/04/2018			
RESULTS										
Hilf Density Ratio	Standard	%	99.5	101.5	102.5	102.5	100	102.5	103.5	101
Moisture Variation from OMC (-Drier/+Wetter)		%	0.0	0.0	-0.5	0.0	0.0	0.0	-0.5	0.0
Specification	Density Ratio (Standard)	≥95%	Specification			Moisture Variance from OMC			±2%	
TEST LOCATION										
Easting	295944.175	296218.296	296218.778	296236.395	296228.435	296241.353	296225.726	296229.914		
Northing	6268547.177	6268606.504	6268555.558	6268540.164	6268568.727	6268580.655	6268571.202	6268538.221		
Reduced Level	m 22.766 23.539 23.811 23.949 23.712 23.718 23.592 23.984									
Shown on Drawing No	8599/1-99									
Retested by Test	-	-	-	-	-	-	-	-		
FIELD & LABORATORY DATA										
Field Wet Density	t/m ³	2.07	2.05	2.04	2.09	2.08	2.10	2.07	2.06	
Field Moisture Content	%	14.5	15.0	15.0	13.5	14.0	14.0	14.5	15.0	
Material retained on 19mm Sieve (wet)	%	<5	<5	<5	<5	<5	<5	<5	<5	
Lab Compaction result from test number		5845	5846	5847	5848	5849	5850	5851	5852	
Peak Converted Wet Density	t/m ³	2.08	2.02	1.99	2.04	2.08	2.05	2.00	2.04	
Apparent Optimum Moisture Content	%	14.5	14.5	15.5	13.5	14.0	14.0	15.0	15.0	
Number of Compaction Points		3	3	3	3	3	3	3	3	
Test Procedures - See Note Number		12	12	12	12	12	12	12	12	
Material Description - see below		2	2	2	1-2	2	2	2	2	
Notes										
1: Assigned Values have been obtained from our Penrith laboratory – Accreditation No 2734					10: AS 1289 1.2.1 clause 6.4 (b), 2.1.1, 5.3.1, 5.5.1, 5.6.1					
2: Assigned Values have been obtained from our Prestons laboratory – Accreditation No 14234					11: AS 1289 1.2.1 clause 6.4 (b), 2.1.1, 5.3.1, 5.7.1					
3: Results have been calculated using infinite decimal places. Therefore, calculated values may vary from those shown					12: AS 1289 1.2.1 clause 6.4 (b), 2.1.1, 5.7.1, 5.8.1					
4: AS 1289 1.2.1 clause 6.4 (b), 2.1.1, 5.1.1, 5.3.1, 5.4.1					13: RMS T111, T119, T120, T166					
5: AS 1289 1.2.1 clause 6.4 (b), 2.1.1, 5.2.1, 5.3.1, 5.4.1					14: RMS T111, T120, T166, T173					
6: AS 1289 1.2.1 clause 6.4 (b),					15: RMS T120, T119, T162					
7: AS 1289 1.2.1 clause 6.4 (b), 2.1.1, 5.2.1, 5.4.1, 5.8.1					16: RMS T120, T162, T173					
8: AS 1289 1.2.1 clause 6.4 (b), 2.1.1., 5.5.1, 5.6.1, 5.8.1					17: RMS T120, T164, T173					
9: Full details of Test Procedure 5.8.1 available on request										
Material Description										
1. CL-Clays of low plasticity, gravelly clays, sandy clays, silty clays			11. DGS40			* Cement Stabilised				
2. CI-Clay of medium plasticity, gravelly clays, sandy clays, silty clays			12. FCR20			# Lime Stabilised				
3. CH-Clays of high plasticity			13. FCR40			\$ Gypsum Stabilised				
4. SC-Clayey sands, sand-clay mixtures			14. RC - Recycled Concrete							
5. SM-Silty sands, sand-silt mixtures			15. Recycled Roadbase							
6. GC-Clayey gravels, gravel-sand-clay mixtures			16. RSB - Recycled Sub-base							
7. SP-Sand, crushed dust, filling sand, washed sand			17. CSS - Crushed Sandstone							
8. DGB20			18. RSS - Ripped Sandstone							
9. DGB40			19. Cowels Brown							
10. DGS20										

Form No R 020c Version 01 06/17 - issued by ER



Accreditation Number 2734
Corporate Site Number 2727

Accredited for compliance with
ISO/IEC 17025 - Testing.

A Kench 30/04/2018

Approved Signatory

Head Office:
34 Borec Road, Penrith NSW 2750
P O Box 880 Penrith NSW 2751
Telephone: (02) 4722 2:

Prestons Laboratory:
Unit 4, 18-20 Whyalla Place, Prestons NSW 2170
Telephone: (02) 9607 6111 Facsimile: (02) 9607 6200

FIELD DENSITY RESULTS

DARACON CONTRACTORS PTY LTD
184 ADDERLEY STREET WEST
AUBURN NSW 2144

Laboratory: Penrith
Job No: 8599/1
Date: 30/04/2018

PROJECT: SITE FILL TESTING - AREA B
RESIDENTIAL DEVELOPMENT.WOORONG PARK, MARSDEN PARK

Page 11 of 19

TEST NUMBER	5853	5854	5855	5856	5857	5858	5859	5860		
DATE TESTED	10/04/2018									
RESULTS										
Hilf Density Ratio	Standard	%	100.5	102	101.5	100	100.5	102	103.5	99.5
Moisture Variation from OMC (-Drier/+Wetter)		%	0.5	-0.5	0.0	1.0	-0.5	-0.5	-1.0	-0.5
Specification	Density Ratio (Standard)	≥95%	Specification			Moisture Variance from OMC			±2%	
TEST LOCATION										
Easting	296258.669	296279.974	295960.477	296003.91	295992.348	295959.725	296016.84	295972.991		
Northing	6268536.326	6268565.459	6268677.006	6268683.223	6268698.638	6268703.489	6268722.077	6268475.765		
Reduced Level	m		24.036	23.548	24.159	24.096	23.635	23.376	23.153	22.22
Shown on Drawing No	8599/1-99			8599/1-98			8599/1-99			
Retested by Test	-	-	-	-	-	-	-	-		
FIELD & LABORATORY DATA										
Field Wet Density	t/m ³	2.08	2.09	2.08	2.09	2.10	2.11	2.12	2.07	
Field Moisture Content	%	14.5	14.5	14.5	14.5	14.5	15.0	14.0	14.0	
Material retained on 19mm Sieve (wet)	%	<5	<5	<5	<5	<5	<5	<5	<5	
Lab Compaction result from test number		5853	5854	5855	5856	5857	5858	5859	5860	
Peak Converted Wet Density	t/m ³	2.07	2.05	2.05	2.09	2.09	2.07	2.05	2.08	
Apparent Optimum Moisture Content	%	14.0	15.0	14.5	13.5	14.5	15.5	15.0	15.0	
Number of Compaction Points		3	3	3	3	3	3	3	3	
Test Procedures - See Note Number		12	12	12	12	12	12	12	12	
Material Description - see below		2	2	2	1-2	2	2	2	2	
Notes										
1: Assigned Values have been obtained from our Penrith laboratory – Accreditation No 2734					10: AS 1289 1.2.1 clause 6.4 (b), 2.1.1, 5.3.1, 5.5.1, 5.6.1					
2: Assigned Values have been obtained from our Prestons laboratory – Accreditation No 14234					11: AS 1289 1.2.1 clause 6.4 (b), 2.1.1, 5.3.1, 5.7.1					
3: Results have been calculated using infinite decimal places. Therefore, calculated values may vary from those shown					12: AS 1289 1.2.1 clause 6.4 (b), 2.1.1, 5.7.1, 5.8.1					
4: AS 1289 1.2.1 clause 6.4 (b), 2.1.1, 5.1.1, 5.3.1, 5.4.1					13: RMS T111, T119, T120, T166					
5: AS 1289 1.2.1 clause 6.4 (b), 2.1.1, 5.2.1, 5.3.1, 5.4.1					14: RMS T111, T120, T166, T173					
6: AS 1289 1.2.1 clause 6.4 (b),					15: RMS T120, T119, T162					
7: AS 1289 1.2.1 clause 6.4 (b), 2.1.1, 5.2.1, 5.4.1, 5.8.1					16: RMS T120, T162, T173					
8: AS 1289 1.2.1 clause 6.4 (b), 2.1.1., 5.5.1, 5.6.1, 5.8.1					17: RMS T120, T164, T173					
9: Full details of Test Procedure 5.8.1 available on request										
Material Description										
1. CL-Clays of low plasticity, gravelly clays, sandy clays, silty clays			11. DGS40			* Cement Stabilised				
2. CI-Clay of medium plasticity, gravelly clays, sandy clays, silty clays			12. FCR20			# Lime Stabilised				
3. CH-Clays of high plasticity			13. FCR40			\$ Gypsum Stabilised				
4. SC-Clayey sands, sand-clay mixtures			14. RC - Recycled Concrete							
5. SM-Silty sands, sand-silt mixtures			15. Recycled Roadbase							
6. GC-Clayey gravels, gravel-sand-clay mixtures			16. RSB - Recycled Sub-base							
7. SP-Sand, crushed dust, filling sand, washed sand			17. CSS - Crushed Sandstone							
8. DGB20			18. RSS - Ripped Sandstone							
9. DGB40			19. Cowels Brown							
10. DGS20										

Form No R 020c Version 01 06/17 - issued by ER



Accreditation Number 2734
Corporate Site Number 2727

Accredited for compliance with
ISO/IEC 17025 - Testing.

A Kench 30/04/2018

Approved Signatory

Head Office:
34 Borec Road, Penrith NSW 2750
P O Box 880 Penrith NSW 2751
Telephone: (02) 4722 2:

Prestons Laboratory:
Unit 4, 18-20 Whyalla Place, Prestons NSW 2170
Telephone: (02) 9607 6111 Facsimile: (02) 9607 6200

FIELD DENSITY RESULTS

DARACON CONTRACTORS PTY LTD
184 ADDERLEY STREET WEST
AUBURN NSW 2144

Laboratory: Penrith
Job No: 8599/1
Date: 30/04/2018

PROJECT: SITE FILL TESTING - AREA B
RESIDENTIAL DEVELOPMENT.WOORONG PARK, MARSDEN PARK

TEST NUMBER	5861	5862	5863	5864	5865	5866	5867	5868		
DATE TESTED	10/04/2018		11/04/2018							
RESULTS										
Hilf Density Ratio	Standard	%	101.5	99.5	96.5	97	98.5	99.5	97	100.5
Moisture Variation from OMC (-Drier/+Wetter)		%	0.0	-0.5	0.5	-0.5	0.5	0.5	0.5	0.0
Specification	Density Ratio (Standard)	≥95%	Specification Moisture Variance from OMC				±2%			
TEST LOCATION										
Easting	295970.529	295945.879	296103.146	296099.765	296108.532	296117.671	296140.379	296140.806		
Northing	6268445.807	6268459.349	6268690.574	6268723.484	6268741.978	6268706.325	6268694.808	6268736.807		
Reduced Level	m		22.075	21.987	24.09	23.739	23.417	24.004	24.403	23.889
Shown on Drawing No	8599/1-99				8599/1-98					
Retested by Test	-	-	-	-	-	-	-	-		
FIELD & LABORATORY DATA										
Field Wet Density	t/m ³	2.08	2.08	2.07	2.09	2.10	2.11	2.08	2.10	
Field Moisture Content	%	14.0	15.0	15.5	14.5	16.5	16.5	17.0	17.5	
Material retained on 19mm Sieve (wet)	%	<5	<5	<5	<5	<5	<5	<5	<5	
Lab Compaction result from test number		5861	5862	5863	5864	5865	5866	5867	5868	
Peak Converted Wet Density	t/m ³	2.05	2.09	2.14	2.15	2.13	2.12	2.14	2.09	
Apparent Optimum Moisture Content	%	14.5	15.5	15.5	15.0	16.0	16.0	16.5	17.0	
Number of Compaction Points		3	3	3	3	3	3	3	3	
Test Procedures - See Note Number		12	12	12	12	12	12	12	12	
Material Description - see below		2	2	2	2	2	2	2	2	
Notes										
1: Assigned Values have been obtained from our Penrith laboratory – Accreditation No 2734					10: AS 1289 1.2.1 clause 6.4 (b), 2.1.1, 5.3.1, 5.5.1, 5.6.1					
2: Assigned Values have been obtained from our Prestons laboratory – Accreditation No 14234					11: AS 1289 1.2.1 clause 6.4 (b), 2.1.1, 5.3.1, 5.7.1					
3: Results have been calculated using infinite decimal places. Therefore, calculated values may vary from those shown					12: AS 1289 1.2.1 clause 6.4 (b), 2.1.1, 5.7.1, 5.8.1					
4: AS 1289 1.2.1 clause 6.4 (b), 2.1.1, 5.1.1, 5.3.1, 5.4.1					13: RMS T111, T119, T120, T166					
5: AS 1289 1.2.1 clause 6.4 (b), 2.1.1, 5.2.1, 5.3.1, 5.4.1					14: RMS T111, T120, T166, T173					
6: AS 1289 1.2.1 clause 6.4 (b),					15: RMS T120, T119, T162					
7: AS 1289 1.2.1 clause 6.4 (b), 2.1.1, 5.2.1, 5.4.1, 5.8.1					16: RMS T120, T162, T173					
8: AS 1289 1.2.1 clause 6.4 (b), 2.1.1., 5.5.1, 5.6.1, 5.8.1					17: RMS T120, T164, T173					
9: Full details of Test Procedure 5.8.1 available on request										
Material Description										
1. CL-Clays of low plasticity, gravelly clays, sandy clays, silty clays			11. DGS40			* Cement Stabilised				
2. CI-Clay of medium plasticity, gravelly clays, sandy clays, silty clays			12. FCR20			# Lime Stabilised				
3. CH-Clays of high plasticity			13. FCR40			\$ Gypsum Stabilised				
4. SC-Clayey sands, sand-clay mixtures			14. RC - Recycled Concrete							
5. SM-Silty sands, sand-silt mixtures			15. Recycled Roadbase							
6. GC-Clayey gravels, gravel-sand-clay mixtures			16. RSB - Recycled Sub-base							
7. SP-Sand, crushed dust, filling sand, washed sand			17. CSS - Crushed Sandstone							
8. DGB20			18. RSS - Ripped Sandstone							
9. DGB40			19. Cowels Brown							
10. DGS20										

Form No R 020c Version 01 06/17 - issued by ER



Accreditation Number 2734
Corporate Site Number 2727

Accredited for compliance with
ISO/IEC 17025 - Testing.

A Kench 30/04/2018

Approved Signatory

Head Office:
34 Borec Road, Penrith NSW 2750
P O Box 880 Penrith NSW 2751
Telephone: (02) 4722 2:

Prestons Laboratory:
Unit 4, 18-20 Whyalla Place, Prestons NSW 2170
Telephone: (02) 9607 6111 Facsimile: (02) 9607 6200

FIELD DENSITY RESULTS

DARACON CONTRACTORS PTY LTD
184 ADDERLEY STREET WEST
AUBURN NSW 2144

Laboratory: Penrith
Job No: 8599/1
Date: 30/04/2018

PROJECT: SITE FILL TESTING - AREA B
RESIDENTIAL DEVELOPMENT.WOORONG PARK, MARSDEN PARK

Page 13 of 19

TEST NUMBER	5869	5870	5871	5872	5873	5874	5875	5876		
DATE TESTED	11/04/2018				13/04/2018					
RESULTS										
Hilf Density Ratio	Standard	%	100	96	100.5	98	98.5	98.5	96	98.5
Moisture Variation from OMC (-Drier/+Wetter)		%	0.0	-0.5	0.5	0.5	0.5	0.5	0.5	-0.5
Specification	Density Ratio (Standard)	≥95%	Specification				Moisture Variance from OMC			±2%
TEST LOCATION										
Easting	295994.402	295996.235	296021.901	296023.042	296145.993	296138.237	296132.504	296162.872		
Northing	6268637.454	6268607.989	6268608.511	6268641.194	6268624.786	6268687.781	6268745.436	6268693.314		
Reduced Level	m 23.969 23.856 23.939 24.149 24.699 24.775 23.302 24.468									
Shown on Drawing No	8599/1-98									
Retested by Test	-	-	-	-	-	-	-	-		
FIELD & LABORATORY DATA										
Field Wet Density	t/m ³	2.11	2.06	2.12	2.09	2.09	2.11	2.05	2.09	
Field Moisture Content	%	18.0	15.5	17.0	18.0	17.5	20.0	16.0	17.5	
Material retained on 19mm Sieve (wet)	%	<5	<5	<5	<5	<5	<5	<5	<5	
Lab Compaction result from test number		5869	5870	5871	5872	5873	5874	5875	5876	
Peak Converted Wet Density	t/m ³	2.11	2.15	2.11	2.13	2.12	2.14	2.13	2.12	
Apparent Optimum Moisture Content	%	18.0	15.5	16.5	17.5	17.0	19.5	16.0	18.0	
Number of Compaction Points		3	3	3	3	3	3	3	3	
Test Procedures - See Note Number		12	12	12	12	12	12	12	12	
Material Description - see below		2	2	2	2	2	2	2	2	
Notes										
1: Assigned Values have been obtained from our Penrith laboratory – Accreditation No 2734					10: AS 1289 1.2.1 clause 6.4 (b), 2.1.1, 5.3.1, 5.5.1, 5.6.1					
2: Assigned Values have been obtained from our Prestons laboratory – Accreditation No 14234					11: AS 1289 1.2.1 clause 6.4 (b), 2.1.1, 5.3.1, 5.7.1					
3: Results have been calculated using infinite decimal places. Therefore, calculated values may vary from those shown					12: AS 1289 1.2.1 clause 6.4 (b), 2.1.1, 5.7.1, 5.8.1					
4: AS 1289 1.2.1 clause 6.4 (b), 2.1.1, 5.1.1, 5.3.1, 5.4.1					13: RMS T111, T119, T120, T166					
5: AS 1289 1.2.1 clause 6.4 (b), 2.1.1, 5.2.1, 5.3.1, 5.4.1					14: RMS T111, T120, T166, T173					
6: AS 1289 1.2.1 clause 6.4 (b),					15: RMS T120, T119, T162					
7: AS 1289 1.2.1 clause 6.4 (b), 2.1.1, 5.2.1, 5.4.1, 5.8.1					16: RMS T120, T162, T173					
8: AS 1289 1.2.1 clause 6.4 (b), 2.1.1., 5.5.1, 5.6.1, 5.8.1					17: RMS T120, T164, T173					
9: Full details of Test Procedure 5.8.1 available on request										
Material Description										
1. CL-Clays of low plasticity, gravelly clays, sandy clays, silty clays			11. DGS40			* Cement Stabilised				
2. CI-Clay of medium plasticity, gravelly clays, sandy clays, silty clays			12. FCR20			# Lime Stabilised				
3. CH-Clays of high plasticity			13. FCR40			\$ Gypsum Stabilised				
4. SC-Clayey sands, sand-clay mixtures			14. RC - Recycled Concrete							
5. SM-Silty sands, sand-silt mixtures			15. Recycled Roadbase							
6. GC-Clayey gravels, gravel-sand-clay mixtures			16. RSB - Recycled Sub-base							
7. SP-Sand, crushed dust, filling sand, washed sand			17. CSS - Crushed Sandstone							
8. DGB20			18. RSS - Ripped Sandstone							
9. DGB40			19. Cowels Brown							
10. DGS20										

Form No R 020c Version 01 06/17 - issued by ER



Accreditation Number 2734
Corporate Site Number 2727

Accredited for compliance with
ISO/IEC 17025 - Testing.

A Kench 30/04/2018

Approved Signatory

Head Office:
34 Borec Road, Penrith NSW 2750
P O Box 880 Penrith NSW 2751
Telephone: (02) 4722 2:

Prestons Laboratory:
Unit 4, 18-20 Whyalla Place, Prestons NSW 2170
Telephone: (02) 9607 6111 Facsimile: (02) 9607 6200

FIELD DENSITY RESULTS

DARACON CONTRACTORS PTY LTD
184 ADDERLEY STREET WEST
AUBURN NSW 2144

Laboratory: Penrith
Job No: 8599/1
Date: 30/04/2018

PROJECT: SITE FILL TESTING - AREA B
RESIDENTIAL DEVELOPMENT.WOORONG PARK, MARSDEN PARK

Page 14 of 19

TEST NUMBER	5877	5878	5879	5880	5881	5882	5883	5884				
DATE TESTED	13/04/2018				17/04/2018							
RESULTS												
Hilf Density Ratio	Standard	%	96.5	97.5	96.5	96.5	97.5	97	97	96.5		
Moisture Variation from OMC (-Drier/+Wetter)		%	0.5	0.0	0.0	0.5	0.0	0.5	0.0	0.5		
Specification	Density Ratio (Standard)	≥95%	Specification			Moisture Variance from OMC			±2%			
TEST LOCATION												
Easting	296182.966	296187.349	296186.114	296210.629	294810.136	294769.051	294803.169	294793.445				
Northing	6268629.294	6268686.986	6268751.359	6268711.759	6268708.492	6268718.008	6268730.049	6268751.866				
Reduced Level	m 24.407				23.336		23.803		16.869	16.43	16.339	16.278
Shown on Drawing No	8599/1-98				8599/1-97							
Retested by Test	-	-	-	-	-	-	-	-				
FIELD & LABORATORY DATA												
Field Wet Density	t/m ³	2.07	2.08	2.08	2.06	2.08	2.07	2.06	2.06			
Field Moisture Content	%	17.0	16.0	15.5	15.5	15.5	19.5	17.5	16.5			
Material retained on 19mm Sieve (wet)	%	<5	<5	<5	<5	<5	<5	<5	<5			
Lab Compaction result from test number		5877	5878	5879	5880	5881	5882	5883	5884			
Peak Converted Wet Density	t/m ³	2.14	2.13	2.15	2.14	2.13	2.13	2.12	2.13			
Apparent Optimum Moisture Content	%	16.5	16.0	15.5	15.0	16.0	19.0	17.0	16.5			
Number of Compaction Points		3	3	3	3	3	3	3	3			
Test Procedures - See Note Number		12	12	12	12	12	12	12	12			
Material Description - see below		2	2	2	2	2	2	2	2			
Notes												
1: Assigned Values have been obtained from our Penrith laboratory – Accreditation No 2734					10: AS 1289 1.2.1 clause 6.4 (b), 2.1.1, 5.3.1, 5.5.1, 5.6.1							
2: Assigned Values have been obtained from our Prestons laboratory – Accreditation No 14234					11: AS 1289 1.2.1 clause 6.4 (b), 2.1.1, 5.3.1, 5.7.1							
3: Results have been calculated using infinite decimal places. Therefore, calculated values may vary from those shown					12: AS 1289 1.2.1 clause 6.4 (b), 2.1.1, 5.7.1, 5.8.1							
4: AS 1289 1.2.1 clause 6.4 (b), 2.1.1, 5.1.1, 5.3.1, 5.4.1					13: RMS T111, T119, T120, T166							
5: AS 1289 1.2.1 clause 6.4 (b), 2.1.1, 5.2.1, 5.3.1, 5.4.1					14: RMS T111, T120, T166, T173							
6: AS 1289 1.2.1 clause 6.4 (b),					15: RMS T120, T119, T162							
7: AS 1289 1.2.1 clause 6.4 (b), 2.1.1, 5.2.1, 5.4.1, 5.8.1					16: RMS T120, T162, T173							
8: AS 1289 1.2.1 clause 6.4 (b), 2.1.1., 5.5.1, 5.6.1, 5.8.1					17: RMS T120, T164, T173							
9: Full details of Test Procedure 5.8.1 available on request												
Material Description												
1. CL-Clays of low plasticity, gravelly clays, sandy clays, silty clays			11. DGS40			* Cement Stabilised						
2. CI-Clay of medium plasticity, gravelly clays, sandy clays, silty clays			12. FCR20			# Lime Stabilised						
3. CH-Clays of high plasticity			13. FCR40			\$ Gypsum Stabilised						
4. SC-Clayey sands, sand-clay mixtures			14. RC - Recycled Concrete									
5. SM-Silty sands, sand-silt mixtures			15. Recycled Roadbase									
6. GC-Clayey gravels, gravel-sand-clay mixtures			16. RSB - Recycled Sub-base									
7. SP-Sand, crushed dust, filling sand, washed sand			17. CSS - Crushed Sandstone									
8. DGB20			18. RSS - Ripped Sandstone									
9. DGB40			19. Cowels Brown									
10. DGS20												

Form No R 020c Version 01 06/17 - issued by ER



Accreditation Number 2734
Corporate Site Number 2727

Accredited for compliance with
ISO/IEC 17025 - Testing.

A Kench 30/04/2018

Approved Signatory

Head Office:
34 Borec Road, Penrith NSW 2750
P O Box 880 Penrith NSW 2751
Telephone: (02) 4722 2:

Prestons Laboratory:
Unit 4, 18-20 Whyalla Place, Prestons NSW 2170
Telephone: (02) 9607 6111 Facsimile: (02) 9607 6200

FIELD DENSITY RESULTS

DARACON CONTRACTORS PTY LTD
184 ADDERLEY STREET WEST
AUBURN NSW 2144

Laboratory: Penrith
Job No: 8599/1
Date: 30/04/2018

PROJECT: SITE FILL TESTING - AREA B
RESIDENTIAL DEVELOPMENT.WOORONG PARK, MARSDEN PARK

TEST NUMBER	5885	5886	5887	5888	5889	5890	5891	5892			
DATE TESTED	17/04/2018										
RESULTS											
Hilf Density Ratio	Standard	%	99	97	97	98	97	96.5	97	98	
Moisture Variation from OMC (-Drier/+Wetter)		%	0.5	0.5	0.0	0.0	0.5	0.5	0.0	0.5	
Specification	Density Ratio (Standard)	≥95%	Specification				Moisture Variance from OMC				±2%
TEST LOCATION											
Easting	294759.576	294783.895	294815.367	294802.464	294766.47	294803.249	294826.429	294777.298			
Northing	6268762.643	6268778.125	6268785.68	6268815.335	6268826.885	6268841.643	6268861.446	6268875.181			
Reduced Level	m										
Shown on Drawing No	16.313	16.171	16.098	16.025	16.027	15.665	15.263	15.563			
Retested by Test	8599/1-97						8599/1-96				
	-	-	-	-	-	-	-	-			
FIELD & LABORATORY DATA											
Field Wet Density	t/m ³	2.11	2.09	2.08	2.06	2.06	2.07	2.09	2.09		
Field Moisture Content	%	15.5	16.5	16.5	18.0	16.0	17.0	17.0	17.0		
Material retained on 19mm Sieve (wet)	%	<5	<5	<5	<5	<5	<5	<5	<5		
Lab Compaction result from test number		5885	5886	5887	5888	5889	5890	5891	5892		
Peak Converted Wet Density	t/m ³	2.13	2.15	2.14	2.10	2.12	2.14	2.16	2.13		
Apparent Optimum Moisture Content	%	15.0	16.0	16.0	17.5	15.5	16.5	17.0	16.0		
Number of Compaction Points		3	3	3	3	3	3	3	3		
Test Procedures - See Note Number		12	12	12	12	12	12	12	12		
Material Description - see below		2	2	2	2	2	2	2	2		
Notes											
1: Assigned Values have been obtained from our Penrith laboratory – Accreditation No 2734					10: AS 1289 1.2.1 clause 6.4 (b), 2.1.1, 5.3.1, 5.5.1, 5.6.1						
2: Assigned Values have been obtained from our Prestons laboratory – Accreditation No 14234					11: AS 1289 1.2.1 clause 6.4 (b), 2.1.1, 5.3.1, 5.7.1						
3: Results have been calculated using infinite decimal places. Therefore, calculated values may vary from those shown					12: AS 1289 1.2.1 clause 6.4 (b), 2.1.1, 5.7.1, 5.8.1						
4: AS 1289 1.2.1 clause 6.4 (b), 2.1.1, 5.1.1, 5.3.1, 5.4.1					13: RMS T111, T119, T120, T166						
5: AS 1289 1.2.1 clause 6.4 (b), 2.1.1, 5.2.1, 5.3.1, 5.4.1					14: RMS T111, T120, T166, T173						
6: AS 1289 1.2.1 clause 6.4 (b),					15: RMS T120, T119, T162						
7: AS 1289 1.2.1 clause 6.4 (b), 2.1.1, 5.2.1, 5.4.1, 5.8.1					16: RMS T120, T162, T173						
8: AS 1289 1.2.1 clause 6.4 (b), 2.1.1., 5.5.1, 5.6.1, 5.8.1					17: RMS T120, T164, T173						
9: Full details of Test Procedure 5.8.1 available on request											
Material Description											
1. CL-Clays of low plasticity, gravelly clays, sandy clays, silty clays			11. DGS40			* Cement Stabilised					
2. CI-Clay of medium plasticity, gravelly clays, sandy clays, silty clays			12. FCR20			# Lime Stabilised					
3. CH-Clays of high plasticity			13. FCR40			\$ Gypsum Stabilised					
4. SC-Clayey sands, sand-clay mixtures			14. RC - Recycled Concrete								
5. SM-Silty sands, sand-silt mixtures			15. Recycled Roadbase								
6. GC-Clayey gravels, gravel-sand-clay mixtures			16. RSB - Recycled Sub-base								
7. SP-Sand, crushed dust, filling sand, washed sand			17. CSS - Crushed Sandstone								
8. DGB20			18. RSS - Ripped Sandstone								
9. DGB40			19. Cowels Brown								
10. DGS20											

Form No R 020c Version 01 06/17 - issued by ER



Accreditation Number 2734
Corporate Site Number 2727

Accredited for compliance with
ISO/IEC 17025 - Testing.

A Kench 30/04/2018

Approved Signatory

Head Office:
34 Borec Road, Penrith NSW 2750
P O Box 880 Penrith NSW 2751
Telephone: (02) 4722 2:

Prestons Laboratory:
Unit 4, 18-20 Whyalla Place, Prestons NSW 2170
Telephone: (02) 9607 6111 Facsimile: (02) 9607 6200

FIELD DENSITY RESULTS

DARACON CONTRACTORS PTY LTD
184 ADDERLEY STREET WEST
AUBURN NSW 2144

Laboratory: Penrith
Job No: 8599/1
Date: 30/04/2018

PROJECT: SITE FILL TESTING - AREA B
RESIDENTIAL DEVELOPMENT.WOORONG PARK, MARSDEN PARK

TEST NUMBER	5893	5894	5895	5896	5897	5898	5899	5900		
DATE TESTED	17/04/2018					18/04/2018				
RESULTS										
Hilf Density Ratio	Standard	%	97.5	96.5	98.5	95.5	98	98.5	98.5	99.5
Moisture Variation from OMC (-Drier/+Wetter)		%	0.5	0.5	0.5	0.0	0.5	0.0	0.5	0.0
Specification	Density Ratio (Standard)	≥95%	Specification			Moisture Variance from OMC			±2%	
TEST LOCATION										
Easting	294809.081	294828.651	294794.408	294773.964	294829.722	294833.478	294794.787	294787.058		
Northing	6268876.308	6268893.764	6268900.547	6268919.496	6268914.955	6268919.558	6268920.447	6268945.007		
Reduced Level	m 15.404 15.131 15.403 15.219 15.045 14.897 15.356 15.11									
Shown on Drawing No	8599/1-96									
Retested by Test	-	-	-	-	-	-	-	-		
FIELD & LABORATORY DATA										
Field Wet Density	t/m ³	2.06	2.07	2.10	2.06	2.10	2.11	2.10	2.08	
Field Moisture Content	%	18.0	19.0	16.0	16.5	13.5	17.0	19.5	19.5	
Material retained on 19mm Sieve (wet)	%	<5	<5	<5	<5	<5	<5	<5	<5	
Lab Compaction result from test number		5893	5894	5895	5896	5897	5898	5899	5900	
Peak Converted Wet Density	t/m ³	2.11	2.14	2.13	2.16	2.14	2.14	2.13	2.09	
Apparent Optimum Moisture Content	%	17.5	19.0	16.0	16.0	13.0	17.0	19.0	19.5	
Number of Compaction Points		3	3	3	3	3	3	3	3	
Test Procedures - See Note Number		12	12	12	12	12	12	12	12	
Material Description - see below		2	2	2	2	1	2	2	2-3	
Notes										
1: Assigned Values have been obtained from our Penrith laboratory – Accreditation No 2734					10: AS 1289 1.2.1 clause 6.4 (b), 2.1.1, 5.3.1, 5.5.1, 5.6.1					
2: Assigned Values have been obtained from our Prestons laboratory – Accreditation No 14234					11: AS 1289 1.2.1 clause 6.4 (b), 2.1.1, 5.3.1, 5.7.1					
3: Results have been calculated using infinite decimal places. Therefore, calculated values may vary from those shown					12: AS 1289 1.2.1 clause 6.4 (b), 2.1.1, 5.7.1, 5.8.1					
4: AS 1289 1.2.1 clause 6.4 (b), 2.1.1, 5.1.1, 5.3.1, 5.4.1					13: RMS T111, T119, T120, T166					
5: AS 1289 1.2.1 clause 6.4 (b), 2.1.1, 5.2.1, 5.3.1, 5.4.1					14: RMS T111, T120, T166, T173					
6: AS 1289 1.2.1 clause 6.4 (b),					15: RMS T120, T119, T162					
7: AS 1289 1.2.1 clause 6.4 (b), 2.1.1, 5.2.1, 5.4.1, 5.8.1					16: RMS T120, T162, T173					
8: AS 1289 1.2.1 clause 6.4 (b), 2.1.1., 5.5.1, 5.6.1, 5.8.1					17: RMS T120, T164, T173					
9: Full details of Test Procedure 5.8.1 available on request										
Material Description										
1. CL-Clays of low plasticity, gravelly clays, sandy clays, silty clays			11. DGS40			* Cement Stabilised				
2. CI-Clay of medium plasticity, gravelly clays, sandy clays, silty clays			12. FCR20			# Lime Stabilised				
3. CH-Clays of high plasticity			13. FCR40			\$ Gypsum Stabilised				
4. SC-Clayey sands, sand-clay mixtures			14. RC - Recycled Concrete							
5. SM-Silty sands, sand-silt mixtures			15. Recycled Roadbase							
6. GC-Clayey gravels, gravel-sand-clay mixtures			16. RSB - Recycled Sub-base							
7. SP-Sand, crushed dust, filling sand, washed sand			17. CSS - Crushed Sandstone							
8. DGB20			18. RSS - Ripped Sandstone							
9. DGB40			19. Cowels Brown							
10. DGS20										

Form No R 020c Version 01 06/17 - issued by ER



Accreditation Number 2734
Corporate Site Number 2727

Accredited for compliance with
ISO/IEC 17025 - Testing.

A Kench 30/04/2018

Approved Signatory

Head Office:
34 Borec Road, Penrith NSW 2750
P O Box 880 Penrith NSW 2751
Telephone: (02) 4722 2:

Prestons Laboratory:
Unit 4, 18-20 Whyalla Place, Prestons NSW 2170
Telephone: (02) 9607 6111 Facsimile: (02) 9607 6200

FIELD DENSITY RESULTS

DARACON CONTRACTORS PTY LTD
184 ADDERLEY STREET WEST
AUBURN NSW 2144

Laboratory: Penrith
Job No: 8599/1
Date: 30/04/2018

PROJECT: SITE FILL TESTING - AREA B
RESIDENTIAL DEVELOPMENT.WOORONG PARK, MARSDEN PARK

TEST NUMBER	5901	5902	5903	5904	5905	5906	5907	5908		
DATE TESTED	18/04/2018									
RESULTS										
Hilf Density Ratio	Standard	%	98.5	96	98	98	98	97	97.5	98.5
Moisture Variation from OMC (-Drier/+Wetter)		%	0.0	0.5	0.5	0.5	0.0	0.5	0.5	0.5
Specification	Density Ratio (Standard)	≥95%	Specification			Moisture Variance from OMC			±2%	
TEST LOCATION										
Easting	294840.294	294825.379	294781.847	294796.217	294835.485	294803.919	294818.919	294864.635		
Northing	6268935.983	6268955.665	6268966.632	6268992.477	6268989.494	6269012.289	6269024.269	6269019.62		
Reduced Level	m 14.792 14.954 15.167 15.107 14.912 14.907 14.78 14.009									
Shown on Drawing No	8599/1-96									
Retested by Test	-	-	-	-	-	-	-	-		
FIELD & LABORATORY DATA										
Field Wet Density	t/m ³	2.08	2.07	2.10	2.12	2.09	2.08	2.10	2.09	
Field Moisture Content	%	18.0	17.5	17.5	19.5	18.0	19.0	17.0	20.5	
Material retained on 19mm Sieve (wet)	%	<5	<5	<5	<5	<5	<5	<5	<5	
Lab Compaction result from test number		5901	5902	5903	5904	5905	5906	5907	5908	
Peak Converted Wet Density	t/m ³	2.11	2.16	2.14	2.16	2.13	2.14	2.15	2.12	
Apparent Optimum Moisture Content	%	18.0	17.0	17.0	19.0	17.5	18.5	17.0	20.0	
Number of Compaction Points		3	3	3	3	3	3	3	3	
Test Procedures - See Note Number		12	12	12	12	12	12	12	12	
Material Description - see below		2	2	2	2	2	2	2	2-3	
Notes										
1: Assigned Values have been obtained from our Penrith laboratory – Accreditation No 2734					10: AS 1289 1.2.1 clause 6.4 (b), 2.1.1, 5.3.1, 5.5.1, 5.6.1					
2: Assigned Values have been obtained from our Prestons laboratory – Accreditation No 14234					11: AS 1289 1.2.1 clause 6.4 (b), 2.1.1, 5.3.1, 5.7.1					
3: Results have been calculated using infinite decimal places. Therefore, calculated values may vary from those shown					12: AS 1289 1.2.1 clause 6.4 (b), 2.1.1, 5.7.1, 5.8.1					
4: AS 1289 1.2.1 clause 6.4 (b), 2.1.1, 5.1.1, 5.3.1, 5.4.1					13: RMS T111, T119, T120, T166					
5: AS 1289 1.2.1 clause 6.4 (b), 2.1.1, 5.2.1, 5.3.1, 5.4.1					14: RMS T111, T120, T166, T173					
6: AS 1289 1.2.1 clause 6.4 (b),					15: RMS T120, T119, T162					
7: AS 1289 1.2.1 clause 6.4 (b), 2.1.1, 5.2.1, 5.4.1, 5.8.1					16: RMS T120, T162, T173					
8: AS 1289 1.2.1 clause 6.4 (b), 2.1.1., 5.5.1, 5.6.1, 5.8.1					17: RMS T120, T164, T173					
9: Full details of Test Procedure 5.8.1 available on request										
Material Description										
1. CL-Clays of low plasticity, gravelly clays, sandy clays, silty clays			11. DGS40			* Cement Stabilised				
2. CI-Clay of medium plasticity, gravelly clays, sandy clays, silty clays			12. FCR20			# Lime Stabilised				
3. CH-Clays of high plasticity			13. FCR40			\$ Gypsum Stabilised				
4. SC-Clayey sands, sand-clay mixtures			14. RC - Recycled Concrete							
5. SM-Silty sands, sand-silt mixtures			15. Recycled Roadbase							
6. GC-Clayey gravels, gravel-sand-clay mixtures			16. RSB - Recycled Sub-base							
7. SP-Sand, crushed dust, filling sand, washed sand			17. CSS - Crushed Sandstone							
8. DGB20			18. RSS - Ripped Sandstone							
9. DGB40			19. Cowels Brown							
10. DGS20										

Form No R 020c Version 01 06/17 - issued by ER



Accreditation Number 2734
Corporate Site Number 2727

Accredited for compliance with
ISO/IEC 17025 - Testing.

A Kench 30/04/2018

Approved Signatory

Head Office:
34 Borec Road, Penrith NSW 2750
P O Box 880 Penrith NSW 2751
Telephone: (02) 4722 2:

Prestons Laboratory:
Unit 4, 18-20 Whyalla Place, Prestons NSW 2170
Telephone: (02) 9607 6111 Facsimile: (02) 9607 6200

FIELD DENSITY RESULTS

DARACON CONTRACTORS PTY LTD
184 ADDERLEY STREET WEST
AUBURN NSW 2144

Laboratory: Penrith
Job No: 8599/1
Date: 30/04/2018

PROJECT: SITE FILL TESTING - AREA B
RESIDENTIAL DEVELOPMENT.WOORONG PARK, MARSDEN PARK

Page 18 of 19

TEST NUMBER	5909	5910	5911	5912	5913	5914	5915	5916		
DATE TESTED	19/04/2018									
RESULTS										
Hilf Density Ratio	Standard	%	101	100.5	100	98.5	100	98.5	102	99
Moisture Variation from OMC (-Drier/+Wetter)		%	-0.5	-0.5	-0.5	-0.5	-1.0	-0.5	-0.5	0.5
Specification	Density Ratio (Standard)	≥95%	Specification			Moisture Variance from OMC			±2%	
TEST LOCATION										
Easting	294826.539	294826.431	294816.684	294802.438	294804.026	294790.831	294796.982	294814.015		
Northing	6268969.961	6268941.423	6268894.961	6268859.773	6268817.292	6268776.359	6268726.956	6268709.904		
Reduced Level	m		15.563	15.611	15.98	16.241	16.526	17.037	17.326	17.386
Shown on Drawing No	8599/1-96				8599/1-97					
Retested by Test	-	-	-	-	-	-	-	-		
FIELD & LABORATORY DATA										
Field Wet Density	t/m ³	2.08	2.08	2.09	2.07	2.11	2.08	2.07	2.07	
Field Moisture Content	%	15.5	16.0	17.5	16.5	18.5	20.0	17.5	16.5	
Material retained on 19mm Sieve (wet)	%	<5	<5	<5	<5	<5	<5	<5	<5	
Lab Compaction result from test number		5909	5910	5911	5912	5913	5914	5915	5916	
Peak Converted Wet Density	t/m ³	2.06	2.07	2.09	2.10	2.11	2.11	2.03	2.09	
Apparent Optimum Moisture Content	%	16.5	16.5	18.5	17.5	19.5	21.0	18.5	16.0	
Number of Compaction Points		3	3	3	3	3	3	3	3	
Test Procedures - See Note Number		12	12	12	12	12	12	12	12	
Material Description - see below		2	2	2	2	2-3	2-3	2	2	
Notes										
1: Assigned Values have been obtained from our Penrith laboratory – Accreditation No 2734					10: AS 1289 1.2.1 clause 6.4 (b), 2.1.1, 5.3.1, 5.5.1, 5.6.1					
2: Assigned Values have been obtained from our Prestons laboratory – Accreditation No 14234					11: AS 1289 1.2.1 clause 6.4 (b), 2.1.1, 5.3.1, 5.7.1					
3: Results have been calculated using infinite decimal places. Therefore, calculated values may vary from those shown					12: AS 1289 1.2.1 clause 6.4 (b), 2.1.1, 5.7.1, 5.8.1					
4: AS 1289 1.2.1 clause 6.4 (b), 2.1.1, 5.1.1, 5.3.1, 5.4.1					13: RMS T111, T119, T120, T166					
5: AS 1289 1.2.1 clause 6.4 (b), 2.1.1, 5.2.1, 5.3.1, 5.4.1					14: RMS T111, T120, T166, T173					
6: AS 1289 1.2.1 clause 6.4 (b),					15: RMS T120, T119, T162					
7: AS 1289 1.2.1 clause 6.4 (b), 2.1.1, 5.2.1, 5.4.1, 5.8.1					16: RMS T120, T162, T173					
8: AS 1289 1.2.1 clause 6.4 (b), 2.1.1., 5.5.1, 5.6.1, 5.8.1					17: RMS T120, T164, T173					
9: Full details of Test Procedure 5.8.1 available on request										
Material Description										
1. CL-Clays of low plasticity, gravelly clays, sandy clays, silty clays			11. DGS40			* Cement Stabilised				
2. CI-Clay of medium plasticity, gravelly clays, sandy clays, silty clays			12. FCR20			# Lime Stabilised				
3. CH-Clays of high plasticity			13. FCR40			\$ Gypsum Stabilised				
4. SC-Clayey sands, sand-clay mixtures			14. RC - Recycled Concrete							
5. SM-Silty sands, sand-silt mixtures			15. Recycled Roadbase							
6. GC-Clayey gravels, gravel-sand-clay mixtures			16. RSB - Recycled Sub-base							
7. SP-Sand, crushed dust, filling sand, washed sand			17. CSS - Crushed Sandstone							
8. DGB20			18. RSS - Ripped Sandstone							
9. DGB40			19. Cowels Brown							
10. DGS20										

Form No R 020c Version 01 06/17 - issued by ER



Accreditation Number 2734
Corporate Site Number 2727

Accredited for compliance with
ISO/IEC 17025 - Testing.

A Kench 30/04/2018

Approved Signatory

Head Office:
34 Borec Road, Penrith NSW 2750
P O Box 880 Penrith NSW 2751
Telephone: (02) 4722 2:

Prestons Laboratory:
Unit 4, 18-20 Whyalla Place, Prestons NSW 2170
Telephone: (02) 9607 6111 Facsimile: (02) 9607 6200

FIELD DENSITY RESULTS

DARACON CONTRACTORS PTY LTD
184 ADDERLEY STREET WEST
AUBURN NSW 2144

Laboratory: Penrith
Job No: 8599/1
Date: 30/04/2018

PROJECT: SITE FILL TESTING - AREA B
RESIDENTIAL DEVELOPMENT.WOORONG PARK, MARSDEN PARK

TEST NUMBER	5917	5918	5919	5920	5921				
DATE TESTED	19/04/2018								
RESULTS									
Hilf Density Ratio	Standard	%	99.5	101.5	101.5	99.5	101.5		
Moisture Variation from OMC (-Drier/+Wetter)		%	-1.0	-1.0	-0.5	-0.5	-0.5		
Specification	Density Ratio (Standard)	≥95%	Specification			Moisture Variance from OMC			±2%
TEST LOCATION									
Easting	294816.046	294831.287	294831.046	294845.159	294848.245				
Northing	6268756.884	6268808.011	6268864.978	6268910.207	6268964.759				
Reduced Level	m		16.909	16.326	15.947	15.35	14.988		
Shown on Drawing No			8599/1-97		8599/1-96				
Retested by Test	-	-	-	-	-				
FIELD & LABORATORY DATA									
Field Wet Density	t/m ³	2.07	2.09	2.09	2.07	2.11			
Field Moisture Content	%	20.0	16.5	15.5	17.5	14.5			
Material retained on 19mm Sieve (wet)	%	<5	<5	<5	<5	<5			
Lab Compaction result from test number		5917	5918	5919	5920	5921			
Peak Converted Wet Density	t/m ³	2.08	2.06	2.06	2.08	2.08			
Apparent Optimum Moisture Content	%	20.5	17.5	16.5	18.5	15.0			
Number of Compaction Points		3	3	3	3	3			
Test Procedures - See Note Number		12	12	12	12	12			
Material Description - see below		2-3	2	2	2	2			
Notes									
1: Assigned Values have been obtained from our Penrith laboratory – Accreditation No 2734			10: AS 1289 1.2.1 clause 6.4 (b), 2.1.1, 5.3.1, 5.5.1, 5.6.1						
2: Assigned Values have been obtained from our Prestons laboratory – Accreditation No 14234			11: AS 1289 1.2.1 clause 6.4 (b), 2.1.1, 5.3.1, 5.7.1						
3: Results have been calculated using infinite decimal places. Therefore, calculated values may vary from those shown			12: AS 1289 1.2.1 clause 6.4 (b), 2.1.1, 5.7.1, 5.8.1						
4: AS 1289 1.2.1 clause 6.4 (b), 2.1.1, 5.1.1, 5.3.1, 5.4.1			13: RMS T111, T119, T120, T166						
5: AS 1289 1.2.1 clause 6.4 (b), 2.1.1, 5.2.1, 5.3.1, 5.4.1			14: RMS T111, T120, T166, T173						
6: AS 1289 1.2.1 clause 6.4 (b),			15: RMS T120, T119, T162						
7: AS 1289 1.2.1 clause 6.4 (b), 2.1.1, 5.2.1, 5.4.1, 5.8.1			16: RMS T120, T162, T173						
8: AS 1289 1.2.1 clause 6.4 (b), 2.1.1., 5.5.1, 5.6.1, 5.8.1			17: RMS T120, T164, T173						
9: Full details of Test Procedure 5.8.1 available on request									
Material Description									
1. CL-Clays of low plasticity, gravelly clays, sandy clays, silty clays			11. DGS40			* Cement Stabilised			
2. CI-Clay of medium plasticity, gravelly clays, sandy clays, silty clays			12. FCR20			# Lime Stabilised			
3. CH-Clays of high plasticity			13. FCR40			\$ Gypsum Stabilised			
4. SC-Clayey sands, sand-clay mixtures			14. RC - Recycled Concrete						
5. SM-Silty sands, sand-silt mixtures			15. Recycled Roadbase						
6. GC-Clayey gravels, gravel-sand-clay mixtures			16. RSB - Recycled Sub-base						
7. SP-Sand, crushed dust, filling sand, washed sand			17. CSS - Crushed Sandstone						
8. DGB20			18. RSS - Ripped Sandstone						
9. DGB40			19. Cowels Brown						
10. DGS20									

Form No R 020c Version 01 06/17 - issued by ER



Accreditation Number 2734
Corporate Site Number 2727


Accredited for compliance with
ISO/IEC 17025 - Testing.

A Kench 30/04/2018

Approved Signatory

Head Office:
34 Borec Road, Penrith NSW 2750
P O Box 880 Penrith NSW 2751
Telephone: (02) 4722 21

Prestons Laboratory:
Unit 4, 18-20 Whyalla Place, Prestons NSW 2170
Telephone: (02) 9607 6111 Facsimile: (02) 9607 6200

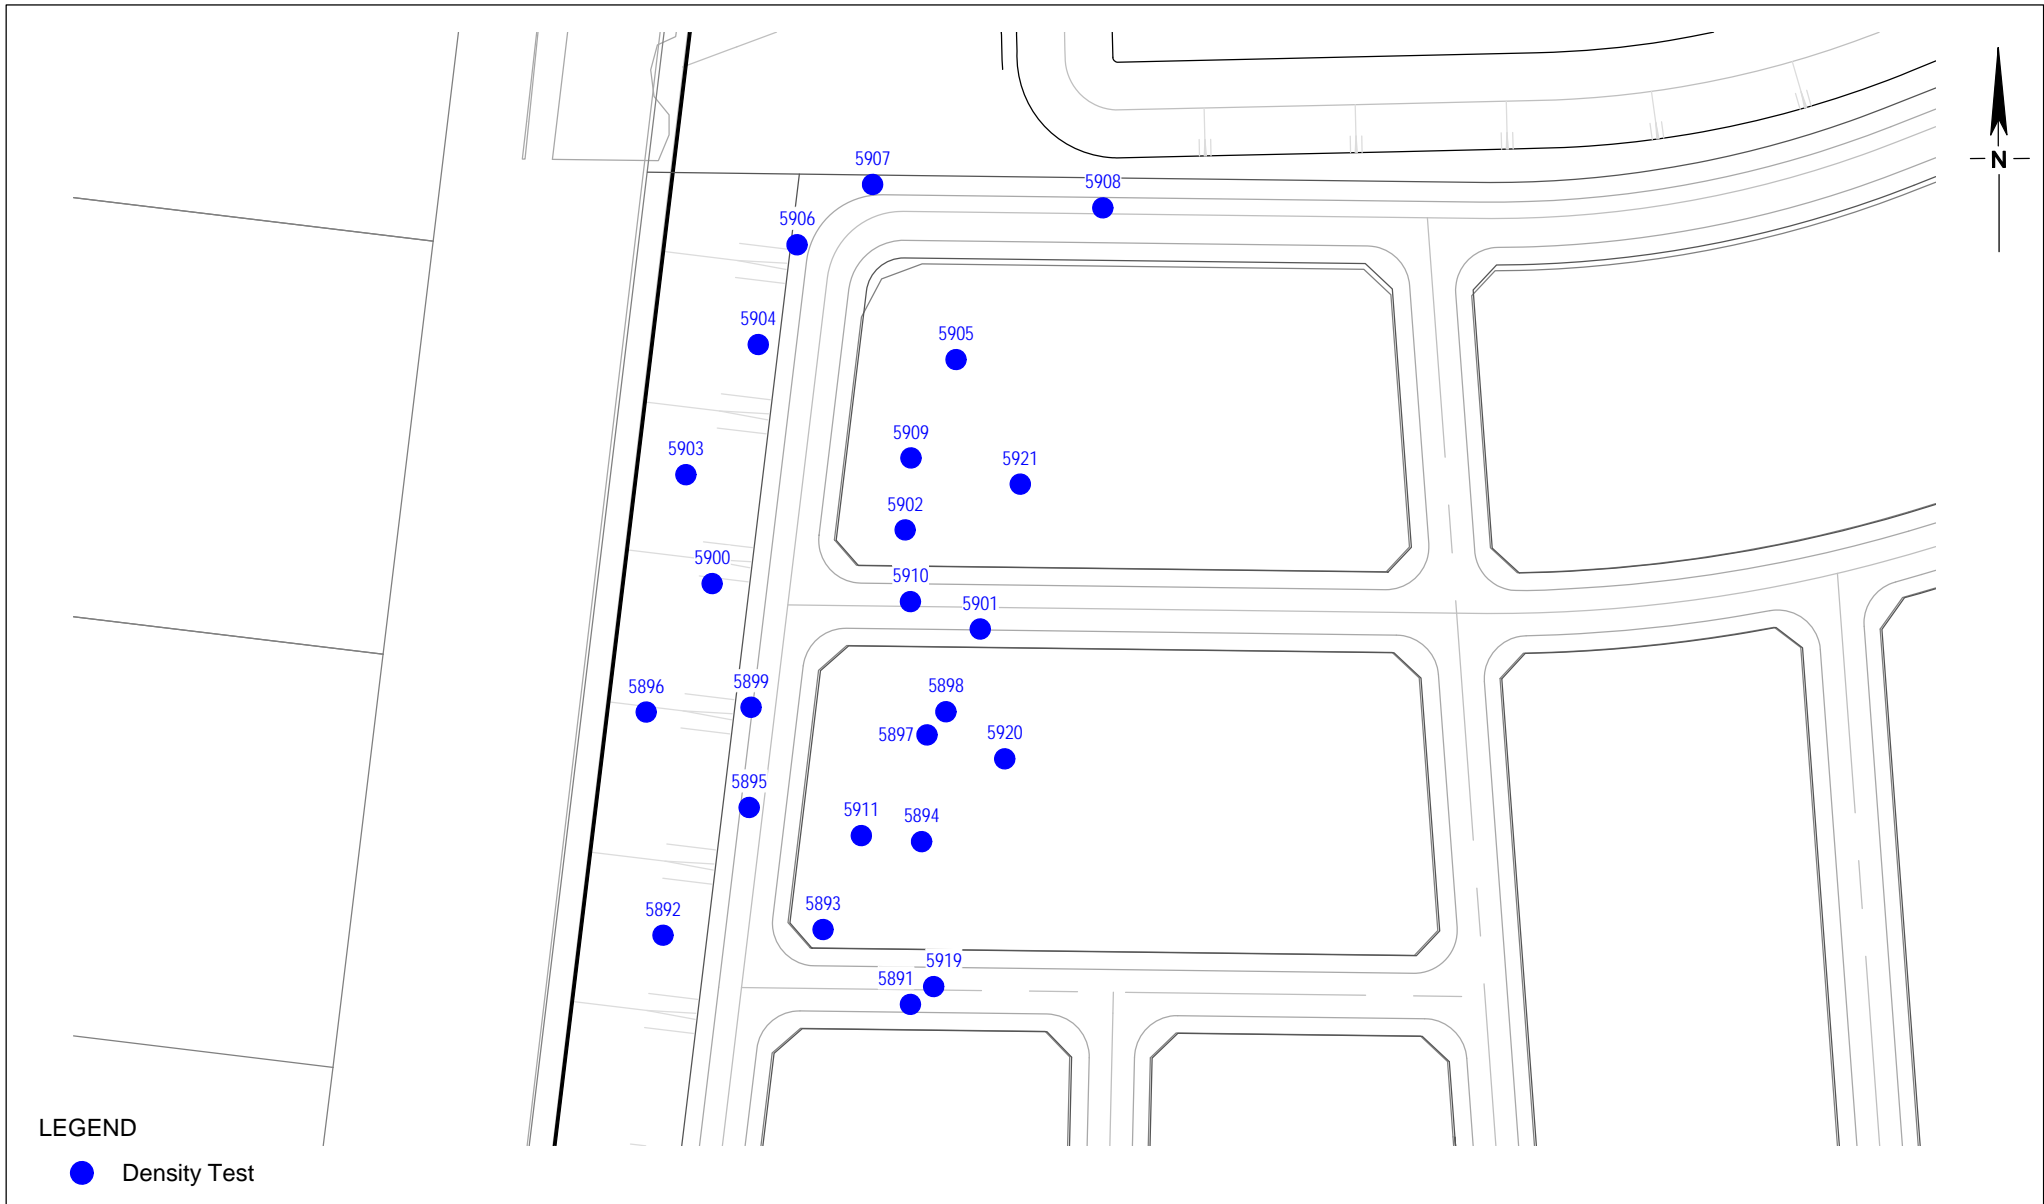

GEOTECH
TESTING PTY LTD®

34 Borec Road
 Penrith
 NSW 2750
 ABN 71 076 676 321

Ph: 02 4722 2744
 Fx: 02 4722 2777
 www.geotech.com.au
 e-mail: info@geotech.com.au

NOTES


1. Site features are indicative and are not to scale.
2. This drawing has been produced using a base plan provided by others to which additional information e.g test pits, borehole locations or notes have been added. Some or all of the plan may not be relevant at the time of producing this drawing

Daracon Contractors Pty Ltd
 Residential Development
 Woorong Park - Area B
 Marsden Park

Location of Field Density Tests

Drawing No: 8599/1-96
 Job No: 8599/1
 Drawn By: MH
 Date: 27 April 2018
 Checked By: AK

File No: 8599-1
 Layers: 0, Lay96

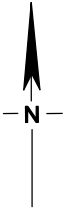

LEGEND

● Density Test



34 Borec Road
Penrith
NSW 2750
ABN 71 076 676 321

Ph: 02 4722 2744
Fx: 02 4722 2777
www.geotech.com.au
e-mail: info@geotech.com.au

NOTES

1. Site features are indicative and are not to scale.
2. This drawing has been produced using a base plan provided by others to which additional information e.g test pits, borehole locations or notes have been added. Some or all of the plan may not be relevant at the time of producing this drawing

Daracon Contractors Pty Ltd
Residential Development
Woorong Park - Area B
Marsden Park

Location of Field Density Tests

Drawing No: 8599/1-97
Job No: 8599/1
Drawn By: MH
Date: 27 April 2018
Checked By: AK

File No: 8599-1
Layers: 0, Lay97



34 Borec Road
 Penrith
 NSW 2750
 ABN 71 076 676 321

Ph: 02 4722 2744
 Fx: 02 4722 2777
 www.geotech.com.au
 e-mail: info@geotech.com.au

NOTES


1. Site features are indicative and are not to scale.
2. This drawing has been produced using a base plan provided by others to which additional information e.g test pits, borehole locations or notes have been added. Some or all of the plan may not be relevant at the time of producing this drawing

Daracon Contractors Pty Ltd
 Residential Development
 Woorong Park - Area B
 Marsden Park

Location of Field Density Tests

Drawing No: 8599/1-98
 Job No: 8599/1
 Drawn By: MH
 Date: 27 April 2018
 Checked By: AK

File No: 8599-1
 Layers: 0, Lay98

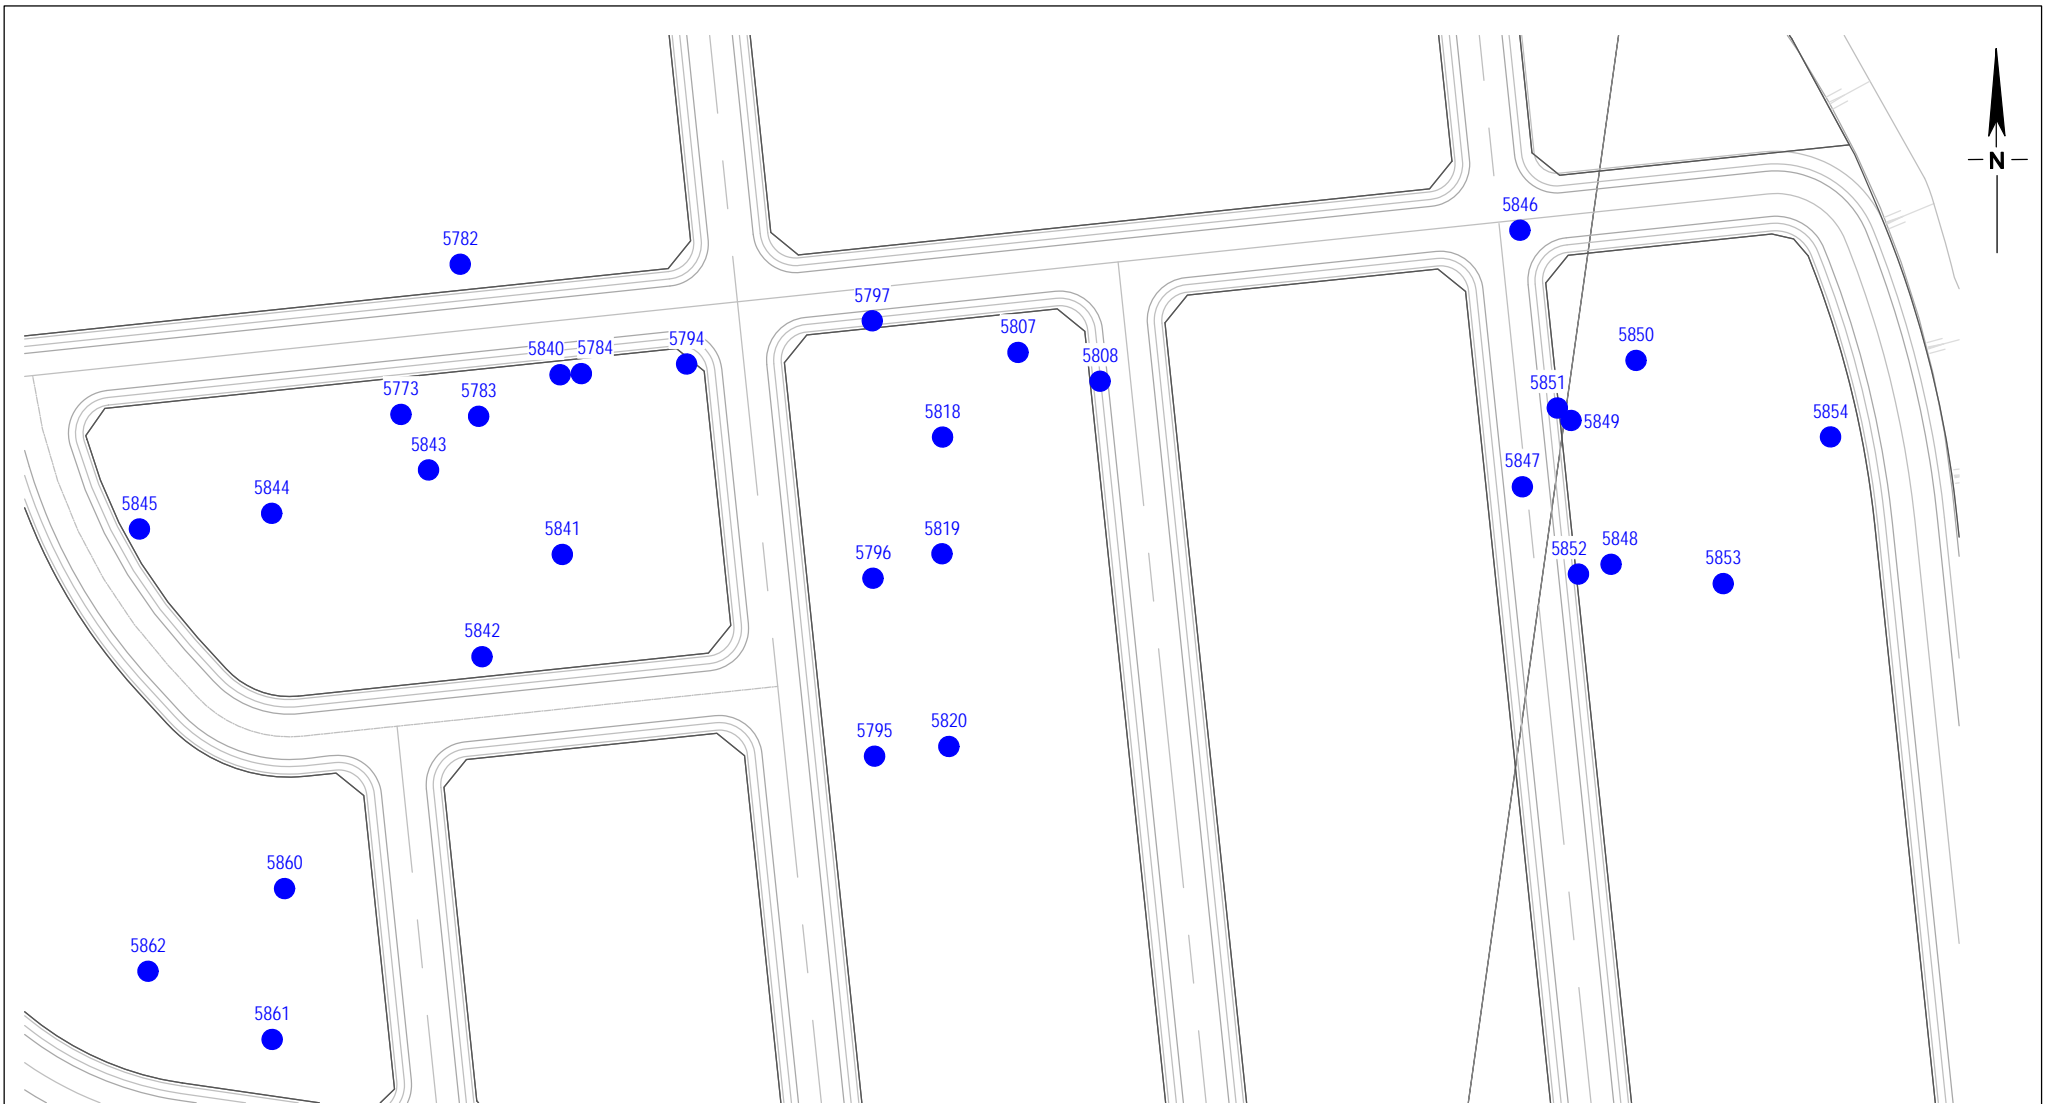

LEGEND

● Density Test



34 Borec Road
Penrith
NSW 2750
ABN 71 076 676 321

Ph: 02 4722 2744
Fx: 02 4722 2777
www.geotech.com.au
e-mail: info@geotech.com.au

NOTES

1. Site features are indicative and are not to scale.
2. This drawing has been produced using a base plan provided by others to which additional information e.g test pits, borehole locations or notes have been added. Some or all of the plan may not be relevant at the time of producing this drawing

Daracon Contractors Pty Ltd
Residential Development
Woorong Park - Area B
Marsden Park

Location of Field Density Tests

Drawing No: 8599/1-99
Job No: 8599/1
Drawn By: MH
Date: 27 April 2018
Checked By: AK

File No: 8599-1
Layers: 0, Lay99

GEOTECH

TESTING PTY LTD[®]

ABN 71 076 676 321



Quality
ISO 9001

SAI GLOBAL

GEOTECHNICAL INSPECTION AND TESTING AUTHORITY

Accreditation No 2734 Corporate Site No 2727

LEVEL 1 DAILY REPORT

Client:	Daracon Contractors Pty Ltd	Project No:	8599/1
Project:	Woorong Bulk Earthworks	Report No:	265
Location:	Marsden Park	Report Date:	21/03/2018
Test Methods:	AS 1289 5.1.1, 5.8.1	Technician:	Heath Wilson
Time on site:			
Time off site:			
1. Subgrade Approval			
Areas ID	Subgrade Approval Report No:	Comments	
APPROVED SUBGRADE	SUBGRADE /	TEST NO'S /	
APPROVED SUBGRADE	SUBGRADE /	TEST NO'S /	
2. Lot Approval			
Lot ID	Lot Approval Report No:	Comments	
3. Survey			
Type of Survey Test Locations Lot Boundaries	Survey undertaken by: Geotech / Geotech /	Reference	
4. Instructions received on site			
5. Instructions given on site			
COMMENTS:	DUE TO RAIN SITE IS UNSUITABLE FOR TYRED VEHICLES. GRADER WILL TRIM HAUL ROADS FOR ACCESS IN THE FOLLOWING DAYS		
Signed:			Date: 21-03-18

GEOTECH

TESTING PTY LTD[®]

ABN 71 076 676 321



Quality
ISO 9001

SAI GLOBAL

GEOTECHNICAL INSPECTION AND TESTING AUTHORITY

Accreditation No 2734 Corporate Site No 2727


LEVEL 1 DAILY REPORT

Client:	Daracon Contractors Pty Ltd	Project No:	8599/1
Project:	Woorong Bulk Earthworks	Report No:	266
Location:	Marsden Park	Report Date:	22/03/2018
Test Methods:	AS 1289 5.1.1, 5.8.1	Technician:	Heath Wilson
Time on site:			
Time off site:			
1. Subgrade Approval			
Areas ID	Subgrade Approval Report No:	Comments	
APPROVED SUBGRADE	SUBGRADE /	TEST NO'S /	
APPROVED SUBGRADE	SUBGRADE /	TEST NO'S /	
2. Lot Approval			
Lot ID	Lot Approval Report No:	Comments	
3. Survey			
Type of Survey Test Locations Lot Boundaries	Survey undertaken by: Geotech / Geotech /	Reference	
4. Instructions received on site			
5. Instructions given on site			
COMMENTS:	DUE TO RAIN SITE IS UNSUITABLE FOR TYRED VEHICLES. GRADER WILL TRIM HAUL ROADS FOR ACCESS IN THE FOLLOWING DAYS		
Signed:			Date: 22-03-18

GEOTECHNICAL INSPECTION AND TESTING AUTHORITY

Accreditation No 2734 Corporate Site No 2727

LEVEL 1 DAILY REPORT

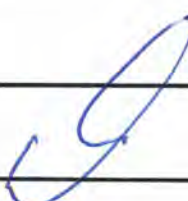Client:	Daracon Contractors Pty Ltd	Project No:	8599/1
Project:	Woorong Bulk Earthworks	Report No:	267
Location:	Marsden Park	Report Date:	23 / 09 / 2018
Test Methods:	AS 1289 5.1.1, 5.8.1	Technician:	Heath Wilson
Time on site:			
Time off site:			
1. Subgrade Approval			
Areas ID	Subgrade Approval Report No:	Comments	
APPROVED SUBGRADE	SUBGRADE /	TEST NO'S /	
APPROVED SUBGRADE	SUBGRADE /	TEST NO'S /	
2. Lot Approval			
Lot ID	Lot Approval Report No:	Comments	
3. Survey			
Type of Survey Test Locations Lot Boundaries	Survey undertaken by: Geotech / Geotech /	Reference	
4. Instructions received on site			
5. Instructions given on site			
COMMENTS:	DUE TO RAIN SITE IS UNSUITABLE FOR TYRED VEHICLES. GRADER WILL TRIM HAUL ROADS FOR ACCESS IN THE FOLLOWING DAYS		
Signed:			Date: 23-09-18

GEOTECH

TESTING PTY LTD[®]

ABN 71 076 676 321



Quality
ISO 9001

SAI GLOBAL

GEOTECHNICAL INSPECTION AND TESTING AUTHORITY

Accreditation No 2734 Corporate Site No 2727

LEVEL 1 DAILY REPORT

Client:	Daracon Contractors Pty Ltd	Project No:	8599/1
Project:	Woorong Bulk Earthworks	Report No:	268
Location:	Marsden Park	Report Date:	26/09/2018
Test Methods:	AS 1289 5.1.1, 5.8.1	Technician:	Heath Wilson
Time on site:			
Time off site:			
1. Subgrade Approval			
Areas ID	Subgrade Approval Report No:	Comments	
APPROVED SUBGRADE	SUBGRADE /	TEST NO'S /	
APPROVED SUBGRADE	SUBGRADE /	TEST NO'S /	
2. Lot Approval			
Lot ID	Lot Approval Report No:	Comments	
3. Survey			
Type of Survey Test Locations Lot Boundaries	Survey undertaken by: Geotech / Geotech /	Reference	
4. Instructions received on site			
5. Instructions given on site			
COMMENTS:	DUE TO RAIN SITE IS UNSUITABLE FOR TYRED VEHICLES. GRADER WILL TRIM HAUL ROADS FOR ACCESS IN THE FOLLOWING DAYS		
Signed:			Date: 26.09.18

GEOTECH

TESTING PTY LTD[®]

ABN 71 076 676 321



Quality
ISO 9001

SAI GLOBAL

GEOTECHNICAL INSPECTION AND TESTING AUTHORITY

Accreditation No 2734 Corporate Site No 2727

LEVEL 1 DAILY REPORT

Client:	Daracon Contractors Pty Ltd	Project No:	8599/8'
Project:	Woorong Bulk Earthworks	Report No:	269
Location:	Marsden Park, Precinct 2	Report Date:	28/03/2018
Test Methods:	AS 1289 5.1.1, 5.8.1	Technician:	Heath Wilson
Time on site: 0630			
Time off site: 5:00			
1. Subgrade Approval			
Areas ID	Subgrade Approval Report No:	Comments	
APPROVED SUBGRADE	SUBGRADE 12	TEST NO'S 5773-5794/22	
2. Lot Approval			
Lot ID	Lot Approval Report No:	Comments	
3. Survey			
Type of Survey	Survey undertaken by:	Reference	
Test Locations	Geotech /		
Lot Boundaries	Geotech /		
4. Instructions received on site			
FIRST DAY BACK ROAD TRUCKS CARRYING DUE TO RAIN AND WET FILL AREA / HAUL ROAD IMMEDIATELY CARRIED TO (S4) 12 2x 825 COMPACTORS DURING MATERIAL DIALLED OF THE FACE 2x DOZERS CLEANING UP 10RS TO FSL			
5. Instructions given on site			
COMMENTS:			
Signed:		Date: 28.03.18	

265

GEOTECH

TESTING PTY LTD[®]

ABN 71 076 676 321




Quality
ISO 9001

SAI GLOBAL

GEOTECHNICAL INSPECTION AND TESTING AUTHORITY

Accreditation No 2734 Corporate Site No 2727

LEVEL 1 DAILY REPORT

Client:	Daracon Contractors Pty Ltd	Project No:	8599/1
Project:	Woorong Bulk Earthworks	Report No:	270
Location:	Marsden Park	Report Date:	29/03/2018
Test Methods:	AS 1289 5.1.1, 5.8.1	Technician:	Heath Wilson
Time on site: 0630			
Time off site: 6:00			
1. Subgrade Approval			
Areas ID	Subgrade Approval Report No:	Comments	
APPROVED SUBGRADE	SUBGRADE , 12	TEST NO'S 5812 5795-5820/18	
APPROVED SUBGRADE	SUBGRADE ,	TEST NO'S	
2. Lot Approval			
Lot ID	Lot Approval Report No:	Comments	
3. Survey			
Type of Survey Test Locations Lot Boundaries	Survey undertaken by: Geotech / Geotech /	Reference	
4. Instructions received on site			
GRADER CONTINUES TO CUT HALL ROADS FOR TRUCK ACCESS TO SANDSTONE AND FILL STOCKPILES ALSO TRIMMING FINISHED PADS READY FOR THE GRASS TRACKER TO SEND READY FOR SIGN OF			
5. Instructions given on site			
IMPORT MATERIAL PLACED IN (S4) 12 24 COMPACTORS PUSHING MATERIAL INTO THE FACE AS PAD IS STILL SOFT FROM PREVIOUS RAIN DAYS 06 DIGGER PUSHING OUT WET SPOT SOUTH SIDE BOUNDARY INTO			
COMMENTS: THIN LAYER TO DRY AND WILL BECOME FINAL LAYER			
Signed: 		Date: 29.03.18	

GEOTECH

TESTING PTY LTD[®]

ABN 71 076 676 321



Quality
ISO 9001
SAI GLOBAL

GEOTECHNICAL INSPECTION AND TESTING AUTHORITY

Accreditation No 2734 Corporate Site No 2727

LEVEL 1 DAILY REPORT

Client:	Daracon Contractors Pty Ltd	Project No:	8599/1
Project:	Woorong Bulk Earthworks	Report No:	271
Location:	Marsden Park	Report Date:	03/01/2018
Test Methods:	AS 1289 5.1.1, 5.8.1	Technician:	Heath Wilson
Time on site: 0630			
Time off site: 5.00			
1. Subgrade Approval			
Areas ID	Subgrade Approval Report No:	Comments	
APPROVED SUBGRADE	SUBGRADE ,	TEST NO'S 5813-5820/9	
APPROVED SUBGRADE	SUBGRADE ,	TEST NO'S	
2. Lot Approval			
Lot ID	Lot Approval Report No:	Comments	
3. Survey			
Type of Survey Test Locations Lot Boundaries	Survey undertaken by: Geotech / Geotech /	Reference	
4. Instructions received on site			
5. Instructions given on site			
COMPACTOR PUSHING AND COMPACTING PUSHED UP IMPACT FROM DOZER BOXING OUT ROADS IN (54)12 ZONE C GRADER TRIMMING BOXED OUT ROADS READY FOR SUBGRADE REPAIRS WITH STOCKPILED SANDSTONE FROM PREVIOUS EARLIER DATES			
COMMENTS: NO IMPACT TRUCKS COMING TODAY CLEAN UP AND SURVEY FOR BILL M3			
Signed:		Date: 03.04.18	

GEOTECH

TESTING PTY LTD[®]

ABN 71 076 676 321



Quality
ISO 9001

SAI GLOBAL

GEOTECHNICAL INSPECTION AND TESTING AUTHORITY

Accreditation No 2734 Corporate Site No 2727

LEVEL 1 DAILY REPORT

Client:	Daracon Contractors Pty Ltd	Project No:	8599/1
Project:	Woorong Bulk Earthworks	Report No:	272
Location:	Marsden Park	Report Date:	04 / 04 / 2018
Test Methods:	AS 1289 5.1.1, 5.8.1	Technician:	Heath Wilson
Time on site: 0630			
Time off site: 5:00			
1. Subgrade Approval			
Areas ID	Subgrade Approval Report No:	Comments	
APPROVED SUBGRADE	SUBGRADE ,	TEST NO'S	
APPROVED SUBGRADE	SUBGRADE ,	TEST NO'S	
2. Lot Approval			
Lot ID	Lot Approval Report No:	Comments	
3. Survey			
Type of Survey Test Locations Lot Boundaries	Survey undertaken by: Geotech / Geotech /	Reference	
4. Instructions received on site			
5. Instructions given on site			
24 DOZERS RIPPING FSL FOR ROAD BOXING TO PREPARE FOR SANDSTONE REPLACEMENT FROM PREVIOUSLY STOCKPILED MATERIAL WHILST PAD FOOT ROLLER COMPACTS AS GRADER WILL TRIM THEN SMOOTH DASH WILL SEAL WITH WATERCART			
COMMENTS: SANDSTONE SAMPLES TAKEN FROM STOCKPILE FOR ASSIGNED VALUE ON ROADS COMPACTOR ROLLING PUSHED OUT FILL FROM DOZERS MATERIAL WILL BE TESTED NEXT DAY AS LAYER BUILDS UP			
Signed:		Date: 04-04-18	

GEOTECHNICAL INSPECTION AND TESTING AUTHORITY

Accreditation No 2734 Corporate Site No 2727

LEVEL 1 DAILY REPORT

Client:	Daracon Contractors Pty Ltd	Project No:	8599/1
Project:	Woorong Bulk Earthworks	Report No:	273
Location:	Marsden Park	Report Date:	05/04/2018
Test Methods:	AS 1289 5.1.1, 5.8.1	Technician:	Heath Wilson
Time on site:	0630		
Time off site:	5:00		
1. Subgrade Approval			
Areas ID	Subgrade Approval Report No:	Comments	
APPROVED SUBGRADE	SUBGRADE ,	TEST NO'S	
APPROVED SUBGRADE	SUBGRADE ,	TEST NO'S	
2. Lot Approval			
Lot ID	Lot Approval Report No:	Comments	
3. Survey			
Type of Survey Test Locations Lot Boundaries	Survey undertaken by: Geotech / Geotech /	Reference	
4. Instructions received on site			
IMPORT TRUCKS CARTING MATERIAL TO ZONE (C) SUBGRADE (12) MATERIAL DROPPED SOUTH END ON FACE AND WORKED WEST PUSHED OF THE FACE FOR 10T (FSC) 2Y DOZERS COMMENCE BOXING OF ROADS EXCESS MATERIAL			
5. Instructions given on site			
IS PUSHED INTO FILL AREA AND USED AS FINAL LAYER FOR TOPSOIL PLACEMENT GRADER TRIMMING HIGH ROADS ENTRY AND EXIT ROADS ALSO TRUCKS WILL HEAD SEAL SUBGRADE ROADS AS THEY EXIT			
COMMENTS: SO MANY IMPORT TRUCKS TO SAFELY CARRY OUT OPERATIONS WILL TRY 06-04-18			
Signed:			Date: 05-04-18

GEOTECHNICAL INSPECTION AND TESTING AUTHORITY

Accreditation No 2734 Corporate Site No 2727

LEVEL 1 DAILY REPORT

Client:	Daracon Contractors Pty Ltd	Project No:	8599/1
Project:	Woorong Bulk Earthworks	Report No:	274
Location:	Marsden Park	Report Date:	06/04/2018
Test Methods:	AS 1289 5.1.1, 5.8.1	Technician:	Heath Wilson
Time on site: 0630			
Time off site: 5-00			
1. Subgrade Approval			
Areas ID	Subgrade Approval Report No:	Comments	
APPROVED SUBGRADE	SUBGRADE , 12	TEST NO'S 5821 - 5833/13	
APPROVED SUBGRADE	SUBGRADE ,	TEST NO'S	
2. Lot Approval			
Lot ID	Lot Approval Report No:	Comments	
3. Survey			
Type of Survey Test Locations Lot Boundaries	Survey undertaken by: Geotech / Geotech /	Reference	
4. Instructions received on site			
TRUCKS CARRYING IMPORT MATERIAL TO (S4) 12 2 x COMPACTORS PUSHING DIALED MATERIAL OF THE NORTH KALE TO REACH FSL IN AREAS GETTING READY FOR GRASS SEEDING TRACKTOR SHALLOW HOLE EXCAVATED BY DIAPER MATERIAL WAS NOT SUITABLE			
5. Instructions given on site			
TO MET FOR SUBGRADE LEVEL MATERIAL REMOVED WAS DIALED IN FILL AREA FOR USE OVER FARMED AREA TRUCKS STOCKPILING SANDSTONE IN S4 (12) ZONEC FOR ROAD USE			
COMMENTS: AREAS NEARING FSL IN ZONE(C) PROPOSED AREA WEST END OF (S4) 12 WILL HAVE IMPORT MATERIAL DIALED			
Signed:		Date: 06.04.18	

GEOTECH

TESTING PTY LTD[®]

ABN 71 076 676 321



Quality
ISO 9001

SAI GLOBAL

GEOTECHNICAL INSPECTION AND TESTING AUTHORITY

Accreditation No 2734 Corporate Site No 2727

LEVEL 1 DAILY REPORT

Client:	Daracon Contractors Pty Ltd	Project No:	8599/1
Project:	Woorong Bulk Earthworks	Report No:	275
Location:	Marsden Park	Report Date:	07/04/2018
Test Methods:	AS 1289 5.1.1, 5.8.1	Technician:	Heath Wilson
Time on site: 7:00			
Time off site: 1:00			
1. Subgrade Approval			
Areas ID	Subgrade Approval Report No:	Comments	
APPROVED SUBGRADE	SUBGRADE, 12	TEST NO'S 5834-5839/6	
APPROVED SUBGRADE	SUBGRADE,	TEST NO'S	
2. Lot Approval			
Lot ID	Lot Approval Report No:	Comments	
3. Survey			
Type of Survey	Survey undertaken by:	Reference	
Test Locations	Geotech /		
Lot Boundaries	Geotech /		
4. Instructions received on site			
5. Instructions given on site			
IMPORT MATERIAL TRUCKS CARRYING TO S4(12) 2x COMPACTORS PUSHING OF TALE TO THE NORTH			
2x DOZERS BOXING OUT ROADS ALSO WITH TRUCKS STOCKPILING SANDSTONE FOR SUBGRADE REPLACEMENT WHEN MATERIAL IS			
COMMENTS: REMOVED WITH EXCAVATOR AND DUMPTRUCKS GRADER TRIMMING PADS AND BOXED OUT ROADS ALSO WITH SMALL DOZER			
Signed:		Date: 07.04.18	

GEOTECH

TESTING PTY LTD[®]

ABN 71 076 676 321




Quality
ISO 9001

SAI GLOBAL

GEOTECHNICAL INSPECTION AND TESTING AUTHORITY

Accreditation No 2734 Corporate Site No 2727


LEVEL 1 DAILY REPORT

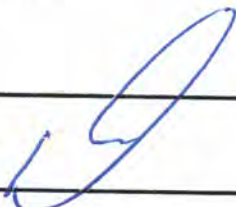Client:	Daracon Contractors Pty Ltd	Project No:	8599/1
Project:	Woorong Bulk Earthworks	Report No:	276
Location:	Marsden Park	Report Date:	09/04/2018
Test Methods:	AS 1289 5.1.1, 5.8.1	Technician:	Heath Wilson
Time on site: 0630			
Time off site: 5:00			
1. Subgrade Approval			
Areas ID	Subgrade Approval Report No:	Comments	
APPROVED SUBGRADE	SUBGRADE , 12	TEST NO'S 5840 - 5850 / 11	
APPROVED SUBGRADE	SUBGRADE ,	TEST NO'S	
2. Lot Approval			
Lot ID	Lot Approval Report No:	Comments	
3. Survey			
Type of Survey Test Locations Lot Boundaries	Survey undertaken by: Geotech / Geotech /	Reference	
4. Instructions received on site			
IMPORT TRUCKS CARTING TO SUBGRADE 12 TIPPING ON THE TOP LEVEL 2x COMPACTORS PUSHING OF THE FACE FOR FINAL LAYER WATERPUMP SPRAYING 1090S IN BETWEEN 1090S ALONG WITH GRADER ROLLING MATERIAL OVER TO MIX INTO FILL LAYER			
5. Instructions given on site			
EXCALCATOR LOADING TRUCKS WITH STOCKPILED SANDSTONE IM NOT SURE OF DESTINATION IT APPEARS TO BE GOING OFF SITE			
COMMENTS:			
Signed: 			
Date: 09.04.18			

GEOTECHNICAL INSPECTION AND TESTING AUTHORITY

Accreditation No 2734 Corporate Site No 2727

LEVEL 1 DAILY REPORT

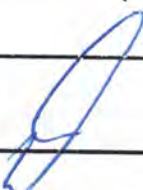Client:	Daracon Contractors Pty Ltd	Project No:	8599/1
Project:	Woorong Bulk Earthworks	Report No:	277
Location:	Marsden Park	Report Date:	10/04/2018
Test Methods:	AS 1289 5.1.1, 5.8.1	Technician:	Heath Wilson
Time on site: 0630			
Time off site: 5:00			
1. Subgrade Approval			
Areas ID	Subgrade Approval Report No:	Comments	
APPROVED SUBGRADE	SUBGRADE , 12	TEST NO'S 5851 - 5862/12	
APPROVED SUBGRADE	SUBGRADE ,	TEST NO'S	
2. Lot Approval			
Lot ID	Lot Approval Report No:	Comments	
3. Survey			
Type of Survey	Survey undertaken by:	Reference	
Test Locations	Geotech /		
Lot Boundaries	Geotech /		
4. Instructions received on site			
5. Instructions given on site			
IMPORT MATERIAL TRUCKS CARING TO SUBGRADE 12 WHERE 2x COMPACTORS WORKING NORTH ALSO 2x DOZERS GOING OUT ROADS READY FOR SUBGRADE REPAIRMENT GRADER ALSO TRIMMING ROADS TO LEVEL WHIST WATERCART SPRAYS			
COMMENTS:			
Signed: 		Date: 10-04-18	

GEOTECH

TESTING PTY LTD[®]

ABN 71 076 676 321



Quality
ISO 9001
SAI GLOBAL

GEOTECHNICAL INSPECTION AND TESTING AUTHORITY

Accreditation No 2734 Corporate Site No 2727

LEVEL 1 DAILY REPORT

Client:	Daracon Contractors Pty Ltd	Project No:	8599/31
Project:	Woorong Bulk Earthworks	Report No:	278
Location:	Marsden Park, Precinct 3	Report Date:	11/09/2017
Test Methods:	AS 1289 5.1.1, 5.8.1	Technician:	Heath Wilson
Time on site: 0630			
Time off site: 500			
1. Subgrade Approval			
Areas ID	Subgrade Approval Report No:	Comments	
APPROVED SUBGRADE	SUBGRADE 12	TEST NO'S 5863-5872/10	
2. Lot Approval			
Lot ID	Lot Approval Report No:	Comments	
3. Survey			
Type of Survey Test Locations Lot Boundaries	Survey undertaken by: Geotech / Geotech /	Reference	
4. Instructions received on site			
TRUCKS CARRYING IMPACT MATERIAL TO (S4) 12 2x COMPACTORS PUSHING NORTH ALONG FINAL LAYER 2x DZERS BOTTING OUT ROAD TO APPROX 100M BELOW SUBGRADE LEVEL PAD FOOT ROLLING MATERIAL AS ITS BOXED AND REMOVED			
5. Instructions given on site			
BACKFILLING SOUTH AND NORTH ENDS OF CULVERT FOR ROAD TO COVER SMALL VIBRATE ROLLER COMPACTING 2x 627 SCRAPERS HAVING TOPSOIL FROM STOCKPILES TO AREA RUNNING PARALLEL TO STONEY CR ROAD			
COMMENTS:			
Signed:		Date: 11.09.18	

GEOTECHNICAL INSPECTION AND TESTING AUTHORITY

Accreditation No 2734 Corporate Site No 2727


LEVEL 1 DAILY REPORT

Client:	Daracon Contractors Pty Ltd	Project No:	8599/1
Project:	Woorong Bulk Earthworks	Report No:	279
Location:	Marsden Park	Report Date:	12 / 04 / 2018
Test Methods:	AS 1289 5.1.1, 5.8.1	Technician:	Heath Wilson
Time on site: 0630			
Time off site: 5:00			
1. Subgrade Approval			
Areas ID	Subgrade Approval Report No:	Comments	
APPROVED SUBGRADE	SUBGRADE /	TEST NO'S /	
APPROVED SUBGRADE	SUBGRADE /	TEST NO'S /	
2. Lot Approval			
Lot ID	Lot Approval Report No:	Comments	
3. Survey			
Type of Survey	Survey undertaken by:	Reference	
Test Locations	Geotech /		
Lot Boundaries	Geotech /		
4. Instructions received on site			
IMPORT TRUCKS CARRYING MATERIAL TO SUBGRADE 12 FOR FINAL LAYER EASTERN END TOWARDS OF CONCRETE 2X COMPACTORS ALSO PUSHING AND COMPACTING WHITE WATERCART SPRAYS BETWEEN AND PLACED 10905			
5. Instructions given on site			
GRADER TRIMMING PADS TO GAS FSL READY FOR TOPSOILING 2X 627 SCRAPERS WITH DISC STOCKPILE STOCKPILE SCRAPERS ALSO STRIPPING LONG RECTANGULAR ALONG STONEY CREEK ROAD APPROX 1M FILL WILL BE CONTRACTED AS PLACED			
COMMENTS: EXCAVATOR REMOVING UNSUITABLE MATERIAL FROM SOUTH END OF (S4)12 AS ROAD WILL BE PROPOSED TO PASS THROUGH THERE AND REPAIRED AND CONTINUED MATERIAL			
Signed:			Date: 12-04-18

GEOTECHNICAL INSPECTION AND TESTING AUTHORITY

Accreditation No 2734 Corporate Site No 2727

LEVEL 1 DAILY REPORT

Client: Daracon Contractors Pty Ltd	Project No: 8599/1	
Project: Woorong Bulk Earthworks	Report No: 278	
Location: Marsden Park	Report Date: 13/04/2018	
Test Methods: AS 1289 5.1.1, 5.8.1	Technician: Heath Wilson	
Time on site: 0630		
Time off site: 500		
1. Subgrade Approval		
Areas ID	Subgrade Approval Report No:	Comments
APPROVED SUBGRADE	SUBGRADE / 12	TEST NO'S / 5873-5880/8
APPROVED SUBGRADE	SUBGRADE /	TEST NO'S /
2. Lot Approval		
Lot ID	Lot Approval Report No:	Comments
3. Survey		
Type of Survey	Survey undertaken by:	Reference
Test Locations	Geotech /	
Lot Boundaries	Geotech /	
4. Instructions received on site		
ROAD TRUCKS CARRYING IMPORT MATERIAL TO (54) 12 2x COMPACTORS PUSHING EAST TOWARDS CULVERT FOR FSL 2x DOZER'S BOVING OUT HALL ROADS TO BE REPAIRED WITH REPLACEMENT SUBGRADE WAHSE WATERCARE SPRAYS FOR TRIM		
5. Instructions given on site		
CULVERT BETWEEN STAGES 1930 2 MATERIAL HAS BEEN PLACED AND CONTROLLED APPROX 1.2m IN DEPTH I WILL PLACE TEST LOCATIONS ON DRAWINGS FOR (NOT) SCRAPER STILL STRIPPING AREA RUNNING PARALLEL TO STONEY CK RD		
COMMENTS:		
Signed: 		Date: 13.04.18

GEOTECH

TESTING PTY LTD[®]

ABN 71 076 676 321

5880' - 2940,000^{m³}



Quality
ISO 9001

SAI GLOBAL

GEOTECHNICAL INSPECTION AND TESTING AUTHORITY

Accreditation No 2734 Corporate Site No 2727


LEVEL 1 DAILY REPORT

Client:	Daracon Contractors Pty Ltd	Project No:	8599/1
Project:	Woorong Bulk Earthworks	Report No:	279
Location:	Marsden Park	Report Date:	16 / 04 / 2018
Test Methods:	AS 1289 5.1.1, 5.8.1	Technician:	Heath Wilson
Time on site: 0630			
Time off site: 500			
1. Subgrade Approval			
Areas ID	Subgrade Approval Report No:	Comments	
APPROVED SUBGRADE	SUBGRADE /	TEST NO'S /	
APPROVED SUBGRADE	SUBGRADE /	TEST NO'S /	
2. Lot Approval			
Lot ID	Lot Approval Report No:	Comments	
3. Survey			
Type of Survey Test Locations Lot Boundaries	Survey undertaken by: Geotech / Geotech /	Reference	
4. Instructions received on site			
SUBGRADE IS NEARLY AT FSL OF ALL AREAS EXCEPT FOR EASTERN EDGE OF KILL AREA NEEDS APPROX 200MM FOR FINAL LAYER SCRAPERS PILING SUBGRADE OVER (S4)12 FROM PREVIOUSLY STRIPPED STOCKPILED MATERIAL WHILE GRADER TRIMS TO LEVEL			
5. Instructions given on site			
NEW AREA OF KILL BEING PILED ALONG AREA PARALLEL TO STONEY CK ROAD 2x 627 SCRAPERS HAVE STRIPPED AND STOCKPILED MATERIAL. TRUCKS CARTING IMPORT TO NEW APPROVED SUBGRADE 2x COMPACTORS WORKING UP KILL TO STONEY CK			
COMMENTS: IT WILL TAKE A DAY TO GET A LAYER IN THE NEW (S6) TESTING WILL COMMENCE TOMORROW WITH SUFFICIENT VOLUME OF MATERIAL			
Signed:		Date: 16.04.18	

GEOTECH

TESTING PTY LTD[®]

ABN 71 076 676 321

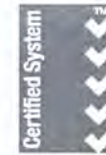

Quality
ISO 9001

SAI GLOBAL

GEOTECHNICAL INSPECTION AND TESTING AUTHORITY


Accreditation No 2734 Corporate Site No 2727

SUBGRADE APPROVAL REPORT

Client: Daracon Contractors Pty Ltd	Project No: 8599/31
Project: Woorong Bulk Earthworks	Report No: S 22
Location: Marsden Park	Report Date: 17-04-18 / 12017
Subgrade Inspection Report	Technician: Heath Wilson

Subgrade areas assessed						
Area ID	Date	Approximate extent	Subgrade Description	Geometry Summary	Survey Reference	Approved (Yes/No)
APPROVED SUBGRADE (S4)22	17.04.18	93756m ² 10.82 ACRES	FLOOR LEVEL IS (R1) CLAY MED. PLAST. BROWN SILTY MATERIAL 10W GRAVELS	RECTANGLE FLAT AREA ALONG BOTTOM OF (S4) 16 BATTER		Y

COMMENTS:

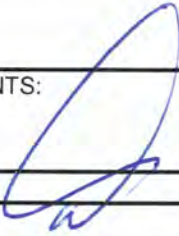Signed:  Date: 17.04.18

GEOTECH

TESTING PTY LTD[®]

ABN 71 076 676 321



Quality
ISO 9001
SAI GLOBAL

GEOTECHNICAL INSPECTION AND TESTING AUTHORITY

Accreditation No 2734 Corporate Site No 2727

LEVEL 1 DAILY REPORT

Client:	Daracon Contractors Pty Ltd	Project No:	8599/1
Project:	Woorong Bulk Earthworks	Report No:	280
Location:	Marsden Park	Report Date:	17 / 04 / 2018
Test Methods:	AS 1289 5.1.1, 5.8.1	Technician:	Heath Wilson
Time on site: 6:30			
Time off site: 5:00			
1. Subgrade Approval			
Areas ID	Subgrade Approval Report No:	Comments	
APPROVED SUBGRADE	SUBGRADE / 12 22	TEST NO'S / 5885 5897 / 17	
APPROVED SUBGRADE	SUBGRADE /	TEST NO'S /	
2. Lot Approval			
Lot ID	Lot Approval Report No:	Comments	
3. Survey			
Type of Survey Test Locations Lot Boundaries	Survey undertaken by: Geotech / Geotech /	Reference	
4. Instructions received on site			
IMPORT TRUCKS CARRYING MATERIAL TO (54)22 FIRST LIFT 2x COMPACTORS PUSHING MATERIAL OFF THE FACE TO THE NORTH WATERCART SPRAYING 1000S AS THERE PILED AND ALONG SURFACE AREA TOWARDS STONEY CK ROAD			
5. Instructions given on site			
GRADER AND SLIDER BOXING OFF ROADS 300mm BELOW SUBGRADE LEVEL FOR REPLENEMENT TO BE USED			
COMMENTS:			
Signed:		Date: 17.04.18	

GEOTECHNICAL INSPECTION AND TESTING AUTHORITY

Accreditation No 2734 Corporate Site No 2727

LEVEL 1 DAILY REPORT

Client:	Daracon Contractors Pty Ltd	Project No:	8599/1
Project:	Woorong Bulk Earthworks	Report No:	281
Location:	Marsden Park	Report Date:	18 / 04 / 2018
Test Methods:	AS 1289 5.1.1, 5.8.1	Technician:	Heath Wilson
Time on site: 0630			
Time off site: 1700			
1. Subgrade Approval			
Areas ID	Subgrade Approval Report No:	Comments	
APPROVED SUBGRADE	SUBGRADE /	TEST NO'S / 5898.5908/11	
APPROVED SUBGRADE	SUBGRADE /	TEST NO'S /	
2. Lot Approval			
Lot ID	Lot Approval Report No:	Comments	
3. Survey			
Type of Survey Test Locations Lot Boundaries	Survey undertaken by: Geotech / Geotech /	Reference	
4. Instructions received on site			
TRUCK AND COGS CONTINUE CARRYING IMPORT MATERIAL TO (S4) 22 PARALLEL TO STONEY CK ROAD 2x COMPACTORS PUSHING NORTH INTO FARMERS (B04) OF PROPERTY 08 ALSO PUSHING LOADS OUT ALONG SUBGRADE FLOOR			
5. Instructions given on site			
GRADER ALSO TRIMMING CUTTER INTO FILL AREA ALSO GRADER AND SCRAPER BOXING ROADS OUT IN SUBGRADE IS READY FOR REPLACEMENT SUBGRADE 6x DENSITY TESTS CARRIED OUT ON FILL BOTH ENDS OF			
COMMENTS: BRIDGE APPROX 2M PLACEMENT COMPACTED WITH 12TON DAD HOUR AND LITE REMOTE CONTROL ONE HOUR THE COGS BITED UP AGAINST CONCRETE, NORTH AND SOUTH ENDS			
Signed:		Date: 18.04.18	

GEOTECH

TESTING PTY LTD[®]

ABN 71 076 676 321

CBR/19



Quality
ISO 9001

SAI GLOBAL

GEOTECHNICAL INSPECTION AND TESTING AUTHORITY

Accreditation No 2734 Corporate Site No 2727

LEVEL 1 DAILY REPORT

Client:	Daracon Contractors Pty Ltd	Project No:	8599/1
Project:	Woorong Bulk Earthworks	Report No:	282
Location:	Marsden Park	Report Date:	19/04/2018
Test Methods:	AS 1289 5.1.1, 5.8.1	Technician:	Heath Wilson
Time on site: 0630			
Time off site:			
1. Subgrade Approval			
Areas ID	Subgrade Approval Report No:	Comments	
APPROVED SUBGRADE	SUBGRADE / 22	TEST NO'S / 5909 - 5921/13	
APPROVED SUBGRADE	SUBGRADE /	TEST NO'S /	
2. Lot Approval			
Lot ID	Lot Approval Report No:	Comments	
3. Survey			
Type of Survey Test Locations Lot Boundaries	Survey undertaken by: Geotech / Geotech /	Reference	
4. Instructions received on site			
IMPORT TRUCKS CARRYING MATERIAL TO SUBGRADE 22 PARALLEL TO STONEY CREEK ROAD COMPACTORS PUSHING WEST OF THE FACE ALONG WITH WATERCART ROLLING AND SPRAYING GRADER AND SCRAPER BOUNDARY OF ROADS IN (S4) 12 STOCKPILED STONE			
5. Instructions given on site			
WILL BE USED AS REPLACEMENT SUBGRADE DOZER KEYING INTO (S4) 16 BATTER AS LAYERS COME UP IN (S4) 22 WHIST COMPACTOR PUSHES IT INTO KEY AND ROLLS ALONG WITH WATERCART BATTER SPRAYING			
COMMENTS:			
Signed:		Date: 19.04.18	

Our Ref: 8599/1-R16
25 May 2018

Daracon Contractors Pty Ltd
P O Box 6145
SILVERWATER BC NSW 1811
Email: SimpsonW@daracon.com.au

Attention: Mr S Wong

Dear Sir

Re: **Woorong Bulk Earthworks
Marsden Park
Monthly Site Filling Certificate – May 2018**

For the production period 20 April to 18 May 2018, inclusive, we submit our Geotech Monthly Report for the above project.

During the foregoing testing period, a total of eighty eight compaction control tests (tests 5922 to 6009, inclusive) were carried out and reported. The locations of the 88 tests are shown on the attached Drawing Nos 8599/1-100 and 8599/1-101. All tests have been undertaken in accordance with the Test Methods and Specifications shown on the attached certificates. Scanned daily records and subgrade reports are also attached.

Based on the fill quantities/survey data, the frequency of field density and compaction tests was in accordance with Level 1 as defined in AS3798 "Guidelines on Earthworks for Commercial & Residential Development". We certify that all tested locations attained the density ratio shown on the test results sheets. Where failures were encountered, the areas were re-worked and re-tested to achieve the specified density ratio.

Based on site observations and testing, it is considered that the fill placed to date at the locations shown on the attached drawings is classified as "Controlled" fill and that the specified compaction level has been achieved within the tested area.

If you have any questions, please do not hesitate to contact the undersigned.

Yours faithfully
GEOTECH TESTING PTY LTD



Adrian Kench
Laboratory Manager

Attached Density Test Results Certificates Tests 5922 to 6009
Test Location Drawings 8599/1-100 and 8599/1-101
Daily Records

FIELD DENSITY RESULTS

DARACON CONTRACTORS PTY LTD
184 ADDERLEY STREET WEST
AUBURN NSW 2144

Laboratory: Penrith
Job No: 8599/1
Date: 23/05/2018

PROJECT: SITE FILL TESTING - AREA B
RESIDENTIAL DEVELOPMENT.WOORONG PARK, MARSDEN PARK

Page 1 of 11

TEST NUMBER	5922	5923	5924	5925	5926	5927	5928	5929		
DATE TESTED	20/04/2018									
RESULTS										
Hilf Density Ratio	Standard	%	96.5	99	99	96	96	98	99	97
Moisture Variation from OMC (-Drier/+Wetter)		%	0.0	0.0	-0.5	0.0	0.0	0.5	0.0	0.5
Specification	Density Ratio (Standard)		≥95%			Specification	Moisture Variance from OMC			±2%
TEST LOCATION										
Easting	294805.801	294753.835	294766.605	294803.542	294799.701	294759.739	294779.559	294814.934		
Northing	6268721.335	6268717.446	6268735.969	6268739.312	6268770.544	6268782.024	6268801.852	6268808.912		
Reduced Level	m									
Shown on Drawing No	8599/1-101									
Retested by Test	-	-	-	-	-	-	-	-		
FIELD & LABORATORY DATA										
Field Wet Density	t/m ³	2.08	2.10	2.09	2.07	2.06	2.08	2.10	2.06	
Field Moisture Content	%	15.5	16.0	17.5	19.5	16.5	18.5	18.0	16.0	
Material retained on 19mm Sieve (wet)	%	<5	<5	<5	<5	<5	<5	<5	<5	
Lab Compaction result from test number		5922	5923	5924	5925	5926	5927	5928	5929	
Peak Converted Wet Density	t/m ³	2.15	2.12	2.11	2.16	2.15	2.12	2.12	2.12	
Apparent Optimum Moisture Content	%	15.5	15.5	18.0	19.5	16.5	18.0	18.0	16.0	
Number of Compaction Points		3	3	3	3	3	3	3	3	
Test Procedures - See Note Number		12	12	12	12	12	12	12	12	
Material Description - see below		2	2	2	2-3	2	2	2	2	
Notes										
1: Assigned Values have been obtained from our Penrith laboratory – Accreditation No 2734					10: AS 1289 1.2.1 clause 6.4 (b), 2.1.1, 5.3.1, 5.5.1, 5.6.1					
2: Assigned Values have been obtained from our Prestons laboratory – Accreditation No 14234					11: AS 1289 1.2.1 clause 6.4 (b), 2.1.1, 5.3.1, 5.7.1					
3: Results have been calculated using infinite decimal places. Therefore, calculated values may vary from those shown					12: AS 1289 1.2.1 clause 6.4 (b), 2.1.1, 5.7.1, 5.8.1					
4: AS 1289 1.2.1 clause 6.4 (b), 2.1.1, 5.1.1, 5.3.1, 5.4.1					13: RMS T111, T119, T120, T166					
5: AS 1289 1.2.1 clause 6.4 (b), 2.1.1, 5.2.1, 5.3.1, 5.4.1					14: RMS T111, T120, T166, T173					
6: AS 1289 1.2.1 clause 6.4 (b),					15: RMS T120, T119, T162					
7: AS 1289 1.2.1 clause 6.4 (b), 2.1.1, 5.2.1, 5.4.1, 5.8.1					16: RMS T120, T162, T173					
8: AS 1289 1.2.1 clause 6.4 (b), 2.1.1., 5.5.1, 5.6.1, 5.8.1					17: RMS T120, T164, T173					
9: Full details of Test Procedure 5.8.1 available on request										
Material Description										
1. CL-Clays of low plasticity, gravelly clays, sandy clays, silty clays			11. DGS40			* Cement Stabilised				
2. CI-Clay of medium plasticity, gravelly clays, sandy clays, silty clays			12. FCR20			# Lime Stabilised				
3. CH-Clays of high plasticity			13. FCR40			\$ Gypsum Stabilised				
4. SC-Clayey sands, sand-clay mixtures			14. RC - Recycled Concrete							
5. SM-Silty sands, sand-silt mixtures			15. Recycled Roadbase							
6. GC-Clayey gravels, gravel-sand-clay mixtures			16. RSB - Recycled Sub-base							
7. SP-Sand, crushed dust, filling sand, washed sand			17. CSS - Crushed Sandstone							
8. DGB20			18. RSS - Ripped Sandstone							
9. DGB40			19. Cowels Brown							
10. DGS20										

Form No R 020c Version 01 06/17 - issued by ER



Accreditation Number 2734
Corporate Site Number 2727

Accredited for compliance with
ISO/IEC 17025 - Testing.

A Kench 23/05/2018

Approved Signatory

Head Office:
34 Borec Road, Penrith NSW 2750
P O Box 880 Penrith NSW 2751
Telephone: (02) 4722 21

Prestons Laboratory:
Unit 4, 18-20 Whyalla Place, Prestons NSW 2170
Telephone: (02) 9607 6111 Facsimile: (02) 9607 6200

FIELD DENSITY RESULTS

DARACON CONTRACTORS PTY LTD
184 ADDERLEY STREET WEST
AUBURN NSW 2144

Laboratory: Penrith
Job No: 8599/1
Date: 23/05/2018

PROJECT: SITE FILL TESTING - AREA B
RESIDENTIAL DEVELOPMENT.WOORONG PARK, MARSDEN PARK

Page 2 of 11

TEST NUMBER	5930	5931	5932	5933	5934	5935	5936	5937		
DATE TESTED	20/04/2018		23/04/2018							
RESULTS										
Hilf Density Ratio	Standard	%	99.5	97	97	96.5	97	97.5	99	98
Moisture Variation from OMC (-Drier/+Wetter)		%	0.5	0.0	0.0	0.0	0.0	0.5	0.0	-0.5
Specification	Density Ratio (Standard)	≥95%	Specification				Moisture Variance from OMC			±2%
TEST LOCATION										
Easting	294776.829	294769.306	294808.465	294815.881	294772.985	294813.923	294845.399	294805.345		
Northing	6268841.308	6268866.81	6268871.259	6268901.408	6268920.261	6268933.056	6268947.873	6268964.69		
Reduced Level	m	16.407	16.258	16.137	15.955	16.023	15.802	15.529	15.742	
Shown on Drawing No	8599/1-101				8599/1-100					
Retested by Test	-	-	-	-	-	-	-	-		
FIELD & LABORATORY DATA										
Field Wet Density	t/m ³	2.11	2.08	2.07	2.06	2.09	2.08	2.10	2.10	
Field Moisture Content	%	17.5	16.0	16.5	17.5	17.0	17.5	16.5	17.5	
Material retained on 19mm Sieve (wet)	%	<5	<5	<5	<5	<5	<5	<5	<5	
Lab Compaction result from test number		5930	5931	5932	5933	5934	5935	5936	5937	
Peak Converted Wet Density	t/m ³	2.12	2.14	2.13	2.13	2.15	2.13	2.12	2.14	
Apparent Optimum Moisture Content	%	17.0	16.0	16.0	17.5	17.0	17.0	16.5	18.0	
Number of Compaction Points		3	3	3	3	3	3	3	3	
Test Procedures - See Note Number		12	12	12	12	12	12	12	12	
Material Description - see below		2	2	2	2	2	2	2	2	
Notes										
1: Assigned Values have been obtained from our Penrith laboratory – Accreditation No 2734					10: AS 1289 1.2.1 clause 6.4 (b), 2.1.1, 5.3.1, 5.5.1, 5.6.1					
2: Assigned Values have been obtained from our Prestons laboratory – Accreditation No 14234					11: AS 1289 1.2.1 clause 6.4 (b), 2.1.1, 5.3.1, 5.7.1					
3: Results have been calculated using infinite decimal places. Therefore, calculated values may vary from those shown					12: AS 1289 1.2.1 clause 6.4 (b), 2.1.1, 5.7.1, 5.8.1					
4: AS 1289 1.2.1 clause 6.4 (b), 2.1.1, 5.1.1, 5.3.1, 5.4.1					13: RMS T111, T119, T120, T166					
5: AS 1289 1.2.1 clause 6.4 (b), 2.1.1, 5.2.1, 5.3.1, 5.4.1					14: RMS T111, T120, T166, T173					
6: AS 1289 1.2.1 clause 6.4 (b),					15: RMS T120, T119, T162					
7: AS 1289 1.2.1 clause 6.4 (b), 2.1.1, 5.2.1, 5.4.1, 5.8.1					16: RMS T120, T162, T173					
8: AS 1289 1.2.1 clause 6.4 (b), 2.1.1., 5.5.1, 5.6.1, 5.8.1					17: RMS T120, T164, T173					
9: Full details of Test Procedure 5.8.1 available on request										
Material Description										
1. CL-Clays of low plasticity, gravelly clays, sandy clays, silty clays			11. DGS40			* Cement Stabilised				
2. CI-Clay of medium plasticity, gravelly clays, sandy clays, silty clays			12. FCR20			# Lime Stabilised				
3. CH-Clays of high plasticity			13. FCR40			\$ Gypsum Stabilised				
4. SC-Clayey sands, sand-clay mixtures			14. RC - Recycled Concrete							
5. SM-Silty sands, sand-silt mixtures			15. Recycled Roadbase							
6. GC-Clayey gravels, gravel-sand-clay mixtures			16. RSB - Recycled Sub-base							
7. SP-Sand, crushed dust, filling sand, washed sand			17. CSS - Crushed Sandstone							
8. DGB20			18. RSS - Ripped Sandstone							
9. DGB40			19. Cowels Brown							
10. DGS20										

Form No R 020c Version 01 06/17 - issued by ER



Accreditation Number 2734
Corporate Site Number 2727

Accredited for compliance with
ISO/IEC 17025 - Testing.

A Kench 23/05/2018

Approved Signatory

Head Office:
34 Borec Road, Penrith NSW 2750
P O Box 880 Penrith NSW 2751
Telephone: (02) 4722 2

Prestons Laboratory:
Unit 4, 18-20 Whyalla Place, Prestons NSW 2170
Telephone: (02) 9607 6111 Facsimile: (02) 9607 6200

FIELD DENSITY RESULTS

DARACON CONTRACTORS PTY LTD
184 ADDERLEY STREET WEST
AUBURN NSW 2144

Laboratory: Penrith
Job No: 8599/1
Date: 23/05/2018

PROJECT: SITE FILL TESTING - AREA B
RESIDENTIAL DEVELOPMENT.WOORONG PARK, MARSDEN PARK

Page 3 of 11

TEST NUMBER	5938	5939	5940	5941	5942	5943	5944	5945		
DATE TESTED	23/04/2018			01/05/2018						
RESULTS										
Hilf Density Ratio	Standard	%	97	98.5	98	96.5	96.5	97	98	98.5
Moisture Variation from OMC (-Drier/+Wetter)		%	0.0	0.5	0.5	0.0	0.5	0.0	0.5	0.0
Specification	Density Ratio (Standard)	≥95%	Specification			Moisture Variance from OMC			±2%	
TEST LOCATION										
Easting	294804.835	294840.611	294793.245	294785.794	294790.08	294781.512	294791.715	294786.608		
Northing	6268994.432	6268988.229	6268919.083	6268682.024	6268705.067	6268730.697	6268758.727	6268789.418		
Reduced Level	m		15.69	15.592	16.407	18.469	18.294	18.03	17.745	17.555
Shown on Drawing No	8599/1-100				8599/1-101					
Retested by Test	-	-	-	-	-	-	-	-		
FIELD & LABORATORY DATA										
Field Wet Density	t/m ³	2.08	2.08	2.09	2.07	2.06	2.07	2.09	2.08	
Field Moisture Content	%	16.5	18.5	16.0	16.5	18.0	16.5	17.5	17.0	
Material retained on 19mm Sieve (wet)	%	<5	<5	<5	<5	<5	<5	<5	<5	
Lab Compaction result from test number		5938	5939	5940	5941	5942	5943	5944	5945	
Peak Converted Wet Density	t/m ³	2.14	2.11	2.13	2.14	2.13	2.13	2.13	2.11	
Apparent Optimum Moisture Content	%	16.5	18.5	16.0	16.0	17.5	16.5	17.0	17.5	
Number of Compaction Points		3	3	3	3	3	3	3	3	
Test Procedures - See Note Number		12	12	12	12	12	12	12	12	
Material Description - see below		2	2	2	2	2	2	2	2	
Notes										
1: Assigned Values have been obtained from our Penrith laboratory – Accreditation No 2734					10: AS 1289 1.2.1 clause 6.4 (b), 2.1.1, 5.3.1, 5.5.1, 5.6.1					
2: Assigned Values have been obtained from our Prestons laboratory – Accreditation No 14234					11: AS 1289 1.2.1 clause 6.4 (b), 2.1.1, 5.3.1, 5.7.1					
3: Results have been calculated using infinite decimal places. Therefore, calculated values may vary from those shown					12: AS 1289 1.2.1 clause 6.4 (b), 2.1.1, 5.7.1, 5.8.1					
4: AS 1289 1.2.1 clause 6.4 (b), 2.1.1, 5.1.1, 5.3.1, 5.4.1					13: RMS T111, T119, T120, T166					
5: AS 1289 1.2.1 clause 6.4 (b), 2.1.1, 5.2.1, 5.3.1, 5.4.1					14: RMS T111, T120, T166, T173					
6: AS 1289 1.2.1 clause 6.4 (b),					15: RMS T120, T119, T162					
7: AS 1289 1.2.1 clause 6.4 (b), 2.1.1, 5.2.1, 5.4.1, 5.8.1					16: RMS T120, T162, T173					
8: AS 1289 1.2.1 clause 6.4 (b), 2.1.1., 5.5.1, 5.6.1, 5.8.1					17: RMS T120, T164, T173					
9: Full details of Test Procedure 5.8.1 available on request										
Material Description										
1. CL-Clays of low plasticity, gravelly clays, sandy clays, silty clays			11. DGS40			* Cement Stabilised				
2. CI-Clay of medium plasticity, gravelly clays, sandy clays, silty clays			12. FCR20			# Lime Stabilised				
3. CH-Clays of high plasticity			13. FCR40			\$ Gypsum Stabilised				
4. SC-Clayey sands, sand-clay mixtures			14. RC - Recycled Concrete							
5. SM-Silty sands, sand-silt mixtures			15. Recycled Roadbase							
6. GC-Clayey gravels, gravel-sand-clay mixtures			16. RSB - Recycled Sub-base							
7. SP-Sand, crushed dust, filling sand, washed sand			17. CSS - Crushed Sandstone							
8. DGB20			18. RSS - Ripped Sandstone							
9. DGB40			19. Cowels Brown							
10. DGS20										

Form No R 020c Version 01 06/17 - issued by ER



Accreditation Number 2734
Corporate Site Number 2727

Accredited for compliance with
ISO/IEC 17025 - Testing.

A Kench 23/05/2018

Approved Signatory

Head Office:
34 Borec Road, Penrith NSW 2750
P O Box 880 Penrith NSW 2751
Telephone: (02) 4722 2:

Prestons Laboratory:
Unit 4, 18-20 Whyalla Place, Prestons NSW 2170
Telephone: (02) 9607 6111 Facsimile: (02) 9607 6200

FIELD DENSITY RESULTS

DARACON CONTRACTORS PTY LTD
184 ADDERLEY STREET WEST
AUBURN NSW 2144

Laboratory: Penrith
Job No: 8599/1
Date: 23/05/2018

PROJECT: SITE FILL TESTING - AREA B
RESIDENTIAL DEVELOPMENT.WOORONG PARK, MARSDEN PARK

Page 4 of 11

TEST NUMBER	5946	5947	5948	5949	5950	5951	5952	5953		
DATE TESTED	01/05/2018			02/05/2018						
RESULTS										
Hilf Density Ratio	Standard	%	97	97.5	98	98	97	96	97.5	96
Moisture Variation from OMC (-Drier/+Wetter)		%	0.5	0.0	0.0	0.0	0.5	0.5	0.0	0.0
Specification	Density Ratio (Standard)	≥95%	Specification				Moisture Variance from OMC			±2%
TEST LOCATION										
Easting	294793.921	294785.431	294791.902	294774.417	294771.292	294767.345	294763.74	294758.19		
Northing	6268817.018	6268848.819	6268892.69	6268932.7	6268900.845	6268852.381	6268807.568	6268772.448		
Reduced Level	m		17.177	16.96	16.686	16.53	16.672	16.909	17.265	17.462
Shown on Drawing No	8599/1-101			8599/1-100			8599/1-101			
Retested by Test	-	-	-	-	-	-	-	-		
FIELD & LABORATORY DATA										
Field Wet Density	t/m ³	2.07	2.06	2.11	2.09	2.08	2.07	2.06	2.05	
Field Moisture Content	%	15.5	16.0	15.5	16.0	17.5	15.5	17.0	16.0	
Material retained on 19mm Sieve (wet)	%	<5	<5	<5	<5	<5	<5	<5	<5	
Lab Compaction result from test number		5946	5947	5948	5949	5950	5951	5952	5953	
Peak Converted Wet Density	t/m ³	2.13	2.11	2.15	2.13	2.14	2.16	2.11	2.14	
Apparent Optimum Moisture Content	%	15.5	16.0	15.0	16.0	17.5	15.0	16.5	16.0	
Number of Compaction Points		3	3	3	3	3	3	3	3	
Test Procedures - See Note Number		12	12	12	12	12	12	12	12	
Material Description - see below		2	2	2	2	2	2	2	2	
Notes										
1: Assigned Values have been obtained from our Penrith laboratory – Accreditation No 2734					10: AS 1289 1.2.1 clause 6.4 (b), 2.1.1, 5.3.1, 5.5.1, 5.6.1					
2: Assigned Values have been obtained from our Prestons laboratory – Accreditation No 14234					11: AS 1289 1.2.1 clause 6.4 (b), 2.1.1, 5.3.1, 5.7.1					
3: Results have been calculated using infinite decimal places. Therefore, calculated values may vary from those shown					12: AS 1289 1.2.1 clause 6.4 (b), 2.1.1, 5.7.1, 5.8.1					
4: AS 1289 1.2.1 clause 6.4 (b), 2.1.1, 5.1.1, 5.3.1, 5.4.1					13: RMS T111, T119, T120, T166					
5: AS 1289 1.2.1 clause 6.4 (b), 2.1.1, 5.2.1, 5.3.1, 5.4.1					14: RMS T111, T120, T166, T173					
6: AS 1289 1.2.1 clause 6.4 (b),					15: RMS T120, T119, T162					
7: AS 1289 1.2.1 clause 6.4 (b), 2.1.1, 5.2.1, 5.4.1, 5.8.1					16: RMS T120, T162, T173					
8: AS 1289 1.2.1 clause 6.4 (b), 2.1.1., 5.5.1, 5.6.1, 5.8.1					17: RMS T120, T164, T173					
9: Full details of Test Procedure 5.8.1 available on request										
Material Description										
1. CL-Clays of low plasticity, gravelly clays, sandy clays, silty clays			11. DGS40			* Cement Stabilised				
2. CI-Clay of medium plasticity, gravelly clays, sandy clays, silty clays			12. FCR20			# Lime Stabilised				
3. CH-Clays of high plasticity			13. FCR40			\$ Gypsum Stabilised				
4. SC-Clayey sands, sand-clay mixtures			14. RC - Recycled Concrete							
5. SM-Silty sands, sand-silt mixtures			15. Recycled Roadbase							
6. GC-Clayey gravels, gravel-sand-clay mixtures			16. RSB - Recycled Sub-base							
7. SP-Sand, crushed dust, filling sand, washed sand			17. CSS - Crushed Sandstone							
8. DGB20			18. RSS - Ripped Sandstone							
9. DGB40			19. Cowels Brown							
10. DGS20										

Form No R 020c Version 01 06/17 - issued by ER



Accreditation Number 2734
Corporate Site Number 2727

Accredited for compliance with
ISO/IEC 17025 - Testing.

A Kench 23/05/2018

Approved Signatory

Head Office:
34 Borec Road, Penrith NSW 2750
P O Box 880 Penrith NSW 2751
Telephone: (02) 4722 2:

Prestons Laboratory:
Unit 4, 18-20 Whyalla Place, Prestons NSW 2170
Telephone: (02) 9607 6111 Facsimile: (02) 9607 6200

FIELD DENSITY RESULTS

DARACON CONTRACTORS PTY LTD
184 ADDERLEY STREET WEST
AUBURN NSW 2144

Laboratory: Penrith
Job No: 8599/1
Date: 23/05/2018

PROJECT: SITE FILL TESTING - AREA B
RESIDENTIAL DEVELOPMENT.WOORONG PARK, MARSDEN PARK

Page 5 of 11

TEST NUMBER	5954	5955	5956	5957	5958	5959	5960	5961		
DATE TESTED	02/05/2018		04/05/2018							
RESULTS										
Hilf Density Ratio	Standard	%	96.5	97.5	97.5	97	97.5	96.5	99	96.5
Moisture Variation from OMC (-Drier/+Wetter)		%	0.0	0.0	0.0	0.0	0.0	0.0	-0.5	0.5
Specification	Density Ratio (Standard)	≥95%	Specification				Moisture Variance from OMC			±2%
TEST LOCATION										
Easting	294753.413	294753.285	294856.725	294825.547	294784.509	294789.188	294819.858	294858.038		
Northing	6268740.384	6268706.659	6268944.99	6268950.158	6268958.37	6268977.027	6268977.5	6268973.152		
Reduced Level	m 17.82		17.905	16.108	16.386	16.493	16.346	16.353	16.217	
Shown on Drawing No	8599/1-101				8599/1-100					
Retested by Test	-	-	-	-	-	-	-	-		
FIELD & LABORATORY DATA										
Field Wet Density	t/m ³	2.07	2.10	2.08	2.09	2.09	2.07	2.11	2.06	
Field Moisture Content	%	16.0	16.0	16.5	16.5	17.0	16.0	16.5	17.5	
Material retained on 19mm Sieve (wet)	%	<5	<5	<5	<5	<5	<5	<5	<5	
Lab Compaction result from test number		5954	5955	5956	5957	5958	5959	5960	5961	
Peak Converted Wet Density	t/m ³	2.14	2.15	2.13	2.15	2.14	2.15	2.13	2.13	
Apparent Optimum Moisture Content	%	16.0	16.0	16.5	16.5	16.5	16.0	17.0	17.0	
Number of Compaction Points		3	3	3	3	3	3	3	3	
Test Procedures - See Note Number		12	12	12	12	12	12	12	12	
Material Description - see below		2	2	2	2	2	2	2	2	
Notes										
1: Assigned Values have been obtained from our Penrith laboratory – Accreditation No 2734					10: AS 1289 1.2.1 clause 6.4 (b), 2.1.1, 5.3.1, 5.5.1, 5.6.1					
2: Assigned Values have been obtained from our Prestons laboratory – Accreditation No 14234					11: AS 1289 1.2.1 clause 6.4 (b), 2.1.1, 5.3.1, 5.7.1					
3: Results have been calculated using infinite decimal places. Therefore, calculated values may vary from those shown					12: AS 1289 1.2.1 clause 6.4 (b), 2.1.1, 5.7.1, 5.8.1					
4: AS 1289 1.2.1 clause 6.4 (b), 2.1.1, 5.1.1, 5.3.1, 5.4.1					13: RMS T111, T119, T120, T166					
5: AS 1289 1.2.1 clause 6.4 (b), 2.1.1, 5.2.1, 5.3.1, 5.4.1					14: RMS T111, T120, T166, T173					
6: AS 1289 1.2.1 clause 6.4 (b),					15: RMS T120, T119, T162					
7: AS 1289 1.2.1 clause 6.4 (b), 2.1.1, 5.2.1, 5.4.1, 5.8.1					16: RMS T120, T162, T173					
8: AS 1289 1.2.1 clause 6.4 (b), 2.1.1., 5.5.1, 5.6.1, 5.8.1					17: RMS T120, T164, T173					
9: Full details of Test Procedure 5.8.1 available on request										
Material Description										
1. CL-Clays of low plasticity, gravelly clays, sandy clays, silty clays			11. DGS40			* Cement Stabilised				
2. CI-Clay of medium plasticity, gravelly clays, sandy clays, silty clays			12. FCR20			# Lime Stabilised				
3. CH-Clays of high plasticity			13. FCR40			\$ Gypsum Stabilised				
4. SC-Clayey sands, sand-clay mixtures			14. RC - Recycled Concrete							
5. SM-Silty sands, sand-silt mixtures			15. Recycled Roadbase							
6. GC-Clayey gravels, gravel-sand-clay mixtures			16. RSB - Recycled Sub-base							
7. SP-Sand, crushed dust, filling sand, washed sand			17. CSS - Crushed Sandstone							
8. DGB20			18. RSS - Ripped Sandstone							
9. DGB40			19. Cowels Brown							
10. DGS20										

Form No R 020c Version 01 06/17 - issued by ER



Accreditation Number 2734
Corporate Site Number 2727

Accredited for compliance with
ISO/IEC 17025 - Testing.

A Kench 23/05/2018

Approved Signatory

Head Office:
34 Borec Road, Penrith NSW 2750
P O Box 880 Penrith NSW 2751
Telephone: (02) 4722 2:

Prestons Laboratory:
Unit 4, 18-20 Whyalla Place, Prestons NSW 2170
Telephone: (02) 9607 6111 Facsimile: (02) 9607 6200

FIELD DENSITY RESULTS

DARACON CONTRACTORS PTY LTD
184 ADDERLEY STREET WEST
AUBURN NSW 2144

Laboratory: Penrith
Job No: 8599/1
Date: 23/05/2018

PROJECT: SITE FILL TESTING - AREA B
RESIDENTIAL DEVELOPMENT.WOORONG PARK, MARSDEN PARK

Page 6 of 11

TEST NUMBER	5962	5963	5964	5965	5966	5967	5968	5969		
DATE TESTED	04/05/2018				08/05/2018					
RESULTS										
Hilf Density Ratio	Standard	%	96.5	96	98	97.5	97.5	99	97	96.5
Moisture Variation from OMC (-Drier/+Wetter)		%	0.5	0.0	0.0	0.5	0.0	0.0	0.0	0.0
Specification	Density Ratio (Standard)	≥95%	Specification			Moisture Variance from OMC			±2%	
TEST LOCATION										
Easting	294858.192	294825.33	294789.892	294805.024	294855.612	294773.869	294813.271	294808.613		
Northing	6268996.36	6269003.06	6269009.885	6269028.922	6269020.389	6268689.026	6268686.995	6268710.331		
Reduced Level	m		16.156	16.323	16.168	16.131	16.053	19.074	18.854	18.766
Shown on Drawing No	8599/1-100						8599/1-101			
Retested by Test	-	-	-	-	-	-	-	-		
FIELD & LABORATORY DATA										
Field Wet Density	t/m ³	2.07	2.06	2.10	2.09	2.08	2.11	2.09	2.06	
Field Moisture Content	%	16.0	16.5	15.5	16.0	17.5	18.5	18.0	18.5	
Material retained on 19mm Sieve (wet)	%	<5	<5	<5	<5	<5	<5	<5	<5	
Lab Compaction result from test number		5962	5963	5964	5965	5966	5967	5968	5969	
Peak Converted Wet Density	t/m ³	2.14	2.15	2.14	2.14	2.13	2.13	2.15	2.14	
Apparent Optimum Moisture Content	%	15.5	16.5	15.0	16.0	17.0	18.5	17.5	18.5	
Number of Compaction Points		3	3	3	3	3	3	3	3	
Test Procedures - See Note Number		12	12	12	12	12	12	12	12	
Material Description - see below		2	2	2	2	2	2	2	2	
Notes										
1: Assigned Values have been obtained from our Penrith laboratory – Accreditation No 2734					10: AS 1289 1.2.1 clause 6.4 (b), 2.1.1, 5.3.1, 5.5.1, 5.6.1					
2: Assigned Values have been obtained from our Prestons laboratory – Accreditation No 14234					11: AS 1289 1.2.1 clause 6.4 (b), 2.1.1, 5.3.1, 5.7.1					
3: Results have been calculated using infinite decimal places. Therefore, calculated values may vary from those shown										
4: AS 1289 1.2.1 clause 6.4 (b), 2.1.1, 5.1.1, 5.3.1, 5.4.1					12: AS 1289 1.2.1 clause 6.4 (b), 2.1.1, 5.7.1, 5.8.1					
5: AS 1289 1.2.1 clause 6.4 (b), 2.1.1, 5.2.1, 5.3.1, 5.4.1					13: RMS T111, T119, T120, T166					
6: AS 1289 1.2.1 clause 6.4 (b),					14: RMS T111, T120, T166, T173					
7: AS 1289 1.2.1 clause 6.4 (b), 2.1.1, 5.2.1, 5.4.1, 5.8.1					15: RMS T120, T119, T162					
8: AS 1289 1.2.1 clause 6.4 (b), 2.1.1., 5.5.1, 5.6.1, 5.8.1					16: RMS T120, T162, T173					
9: Full details of Test Procedure 5.8.1 available on request					17: RMS T120, T164, T173					
Material Description										
1. CL-Clays of low plasticity, gravelly clays, sandy clays, silty clays			11. DGS40			* Cement Stabilised				
2. CI-Clay of medium plasticity, gravelly clays, sandy clays, silty clays			12. FCR20			# Lime Stabilised				
3. CH-Clays of high plasticity			13. FCR40			\$ Gypsum Stabilised				
4. SC-Clayey sands, sand-clay mixtures			14. RC - Recycled Concrete							
5. SM-Silty sands, sand-silt mixtures			15. Recycled Roadbase							
6. GC-Clayey gravels, gravel-sand-clay mixtures			16. RSB - Recycled Sub-base							
7. SP-Sand, crushed dust, filling sand, washed sand			17. CSS - Crushed Sandstone							
8. DGB20			18. RSS - Ripped Sandstone							
9. DGB40			19. Cowels Brown							
10. DGS20										

Form No R 020c Version 01 06/17 - issued by ER



Accreditation Number 2734
Corporate Site Number 2727

Accredited for compliance with
ISO/IEC 17025 - Testing.

A Kench 23/05/2018

Approved Signatory

Head Office:
34 Borec Road, Penrith NSW 2750
P O Box 880 Penrith NSW 2751
Telephone: (02) 4722 2:

Prestons Laboratory:
Unit 4, 18-20 Whyalla Place, Prestons NSW 2170
Telephone: (02) 9607 6111 Facsimile: (02) 9607 6200

FIELD DENSITY RESULTS

DARACON CONTRACTORS PTY LTD
184 ADDERLEY STREET WEST
AUBURN NSW 2144

Laboratory: Penrith
Job No: 8599/1
Date: 23/05/2018

PROJECT: SITE FILL TESTING - AREA B
RESIDENTIAL DEVELOPMENT.WOORONG PARK, MARSDEN PARK

Page 7 of 11

TEST NUMBER	5970	5971	5972	5973	5974	5975	5976	5977		
DATE TESTED	08/05/2018									
RESULTS										
Hilf Density Ratio	Standard	%	97	96.5	97.5	97	99	96	97.5	98
Moisture Variation from OMC (-Drier/+Wetter)		%	0.0	0.5	0.5	0.5	0.0	0.5	0.5	-0.5
Specification	Density Ratio (Standard)	≥95%	Specification				Moisture Variance from OMC			±2%
TEST LOCATION										
Easting	294764.441	294778.371	294822.991	294816.94	294764.159	294775.913	294820.683	294823.295		
Northing	6268714.739	6268733.313	6268732.904	6268761.343	6268769.151	6268791.57	6268788.965	6268810.596		
Reduced Level	m 18.589 18.405 18.367 18.273 18.351 17.967 18.14 17.921									
Shown on Drawing No	8599/1-101									
Retested by Test	-	-	-	-	-	-	-	-		
FIELD & LABORATORY DATA										
Field Wet Density	t/m ³	2.07	2.07	2.09	2.08	2.08	2.07	2.07	2.09	
Field Moisture Content	%	18.5	18.0	18.0	17.5	18.0	17.5	18.5	18.5	
Material retained on 19mm Sieve (wet)	%	<5	<5	<5	<5	<5	<5	<5	<5	
Lab Compaction result from test number		5970	5971	5972	5973	5974	5975	5976	5977	
Peak Converted Wet Density	t/m ³	2.13	2.14	2.14	2.14	2.10	2.16	2.12	2.13	
Apparent Optimum Moisture Content	%	18.0	17.5	17.5	17.0	18.5	17.0	18.5	19.0	
Number of Compaction Points		3	3	3	3	3	3	3	3	
Test Procedures - See Note Number		12	12	12	12	12	12	12	12	
Material Description - see below		2	2	2	2	2	2	2	2	
Notes										
1: Assigned Values have been obtained from our Penrith laboratory – Accreditation No 2734					10: AS 1289 1.2.1 clause 6.4 (b), 2.1.1, 5.3.1, 5.5.1, 5.6.1					
2: Assigned Values have been obtained from our Prestons laboratory – Accreditation No 14234					11: AS 1289 1.2.1 clause 6.4 (b), 2.1.1, 5.3.1, 5.7.1					
3: Results have been calculated using infinite decimal places. Therefore, calculated values may vary from those shown					12: AS 1289 1.2.1 clause 6.4 (b), 2.1.1, 5.7.1, 5.8.1					
4: AS 1289 1.2.1 clause 6.4 (b), 2.1.1, 5.1.1, 5.3.1, 5.4.1					13: RMS T111, T119, T120, T166					
5: AS 1289 1.2.1 clause 6.4 (b), 2.1.1, 5.2.1, 5.3.1, 5.4.1					14: RMS T111, T120, T166, T173					
6: AS 1289 1.2.1 clause 6.4 (b),					15: RMS T120, T119, T162					
7: AS 1289 1.2.1 clause 6.4 (b), 2.1.1, 5.2.1, 5.4.1, 5.8.1					16: RMS T120, T162, T173					
8: AS 1289 1.2.1 clause 6.4 (b), 2.1.1., 5.5.1, 5.6.1, 5.8.1					17: RMS T120, T164, T173					
9: Full details of Test Procedure 5.8.1 available on request										
Material Description										
1. CL-Clays of low plasticity, gravelly clays, sandy clays, silty clays			11. DGS40			* Cement Stabilised				
2. CI-Clay of medium plasticity, gravelly clays, sandy clays, silty clays			12. FCR20			# Lime Stabilised				
3. CH-Clays of high plasticity			13. FCR40			\$ Gypsum Stabilised				
4. SC-Clayey sands, sand-clay mixtures			14. RC - Recycled Concrete							
5. SM-Silty sands, sand-silt mixtures			15. Recycled Roadbase							
6. GC-Clayey gravels, gravel-sand-clay mixtures			16. RSB - Recycled Sub-base							
7. SP-Sand, crushed dust, filling sand, washed sand			17. CSS - Crushed Sandstone							
8. DGB20			18. RSS - Ripped Sandstone							
9. DGB40			19. Cowels Brown							
10. DGS20										

Form No R 020c Version 01 06/17 - issued by ER



Accreditation Number 2734
Corporate Site Number 2727

Accredited for compliance with
ISO/IEC 17025 - Testing.

A Kench 23/05/2018

Approved Signatory

Head Office:
34 Borec Road, Penrith NSW 2750
P O Box 880 Penrith NSW 2751
Telephone: (02) 4722 2:

Prestons Laboratory:
Unit 4, 18-20 Whyalla Place, Prestons NSW 2170
Telephone: (02) 9607 6111 Facsimile: (02) 9607 6200

FIELD DENSITY RESULTS

DARACON CONTRACTORS PTY LTD
184 ADDERLEY STREET WEST
AUBURN NSW 2144

Laboratory: Penrith
Job No: 8599/1
Date: 23/05/2018

PROJECT: SITE FILL TESTING - AREA B
RESIDENTIAL DEVELOPMENT.WOORONG PARK, MARSDEN PARK

Page 8 of 11

TEST NUMBER	5978	5979	5980	5981	5982	5983	5984	5985		
DATE TESTED	08/05/2018		10/05/2018							
RESULTS										
Hilf Density Ratio	Standard	%	98	96.5	97	97.5	96.5	96	98	99.5
Moisture Variation from OMC (-Drier/+Wetter)		%	0.0	0.0	-0.5	0.5	0.5	0.0	0.0	-0.5
Specification	Density Ratio (Standard)	≥95%	Specification				Moisture Variance from OMC			±2%
TEST LOCATION										
Easting	294781.259	294769.743	294810.889	294824.683	294783.037	294793.236	294839.252	294823.519		
Northing	6268818.842	6268834.481	6268830.154	6268851.149	6268860.767	6268875.525	6268872.948	6268903.126		
Reduced Level	m		17.751	17.698	17.733	17.501	17.542	17.327	17.202	17.245
Shown on Drawing No	8599/1-101				8599/1-100					
Retested by Test	-	-	-	-	-	-	-	-		
FIELD & LABORATORY DATA										
Field Wet Density	t/m ³	2.10	2.06	2.10	2.09	2.07	2.05	2.09	2.08	
Field Moisture Content	%	18.0	16.5	16.0	18.5	17.5	16.5	18.5	18.0	
Material retained on 19mm Sieve (wet)	%	<5	<5	<5	<5	<5	<5	<5	<5	
Lab Compaction result from test number		5978	5979	5980	5981	5982	5983	5984	5985	
Peak Converted Wet Density	t/m ³	2.14	2.14	2.17	2.14	2.14	2.14	2.13	2.09	
Apparent Optimum Moisture Content	%	17.5	16.5	16.5	18.0	17.0	16.5	18.0	18.5	
Number of Compaction Points		3	3	3	3	3	3	3	3	
Test Procedures - See Note Number		12	12	12	12	12	12	12	12	
Material Description - see below		2	2	2	2	2	2	2	2	
Notes										
1: Assigned Values have been obtained from our Penrith laboratory – Accreditation No 2734					10: AS 1289 1.2.1 clause 6.4 (b), 2.1.1, 5.3.1, 5.5.1, 5.6.1					
2: Assigned Values have been obtained from our Prestons laboratory – Accreditation No 14234					11: AS 1289 1.2.1 clause 6.4 (b), 2.1.1, 5.3.1, 5.7.1					
3: Results have been calculated using infinite decimal places. Therefore, calculated values may vary from those shown					12: AS 1289 1.2.1 clause 6.4 (b), 2.1.1, 5.7.1, 5.8.1					
4: AS 1289 1.2.1 clause 6.4 (b), 2.1.1, 5.1.1, 5.3.1, 5.4.1					13: RMS T111, T119, T120, T166					
5: AS 1289 1.2.1 clause 6.4 (b), 2.1.1, 5.2.1, 5.3.1, 5.4.1					14: RMS T111, T120, T166, T173					
6: AS 1289 1.2.1 clause 6.4 (b),					15: RMS T120, T119, T162					
7: AS 1289 1.2.1 clause 6.4 (b), 2.1.1, 5.2.1, 5.4.1, 5.8.1					16: RMS T120, T162, T173					
8: AS 1289 1.2.1 clause 6.4 (b), 2.1.1., 5.5.1, 5.6.1, 5.8.1					17: RMS T120, T164, T173					
9: Full details of Test Procedure 5.8.1 available on request										
Material Description										
1. CL-Clays of low plasticity, gravelly clays, sandy clays, silty clays			11. DGS40			* Cement Stabilised				
2. CI-Clay of medium plasticity, gravelly clays, sandy clays, silty clays			12. FCR20			# Lime Stabilised				
3. CH-Clays of high plasticity			13. FCR40			\$ Gypsum Stabilised				
4. SC-Clayey sands, sand-clay mixtures			14. RC - Recycled Concrete							
5. SM-Silty sands, sand-silt mixtures			15. Recycled Roadbase							
6. GC-Clayey gravels, gravel-sand-clay mixtures			16. RSB - Recycled Sub-base							
7. SP-Sand, crushed dust, filling sand, washed sand			17. CSS - Crushed Sandstone							
8. DGB20			18. RSS - Ripped Sandstone							
9. DGB40			19. Cowels Brown							
10. DGS20										

Form No R 020c Version 01 06/17 - issued by ER



Accreditation Number 2734
Corporate Site Number 2727

Accredited for compliance with
ISO/IEC 17025 - Testing.

A Kench 23/05/2018

Approved Signatory

Head Office:
34 Borec Road, Penrith NSW 2750
P O Box 880 Penrith NSW 2751
Telephone: (02) 4722 2:

Prestons Laboratory:
Unit 4, 18-20 Whyalla Place, Prestons NSW 2170
Telephone: (02) 9607 6111 Facsimile: (02) 9607 6200

FIELD DENSITY RESULTS

DARACON CONTRACTORS PTY LTD
184 ADDERLEY STREET WEST
AUBURN NSW 2144

Laboratory: Penrith
Job No: 8599/1
Date: 23/05/2018

PROJECT: SITE FILL TESTING - AREA B
RESIDENTIAL DEVELOPMENT.WOORONG PARK, MARSDEN PARK

Page 9 of 11

TEST NUMBER	5986	5987	5988	5989	5990	5991	5992	5993		
DATE TESTED	10/05/2018				15/05/2018					
RESULTS										
Hilf Density Ratio	Standard	%	97	97	97.5	98	98	97.5	96.5	99
Moisture Variation from OMC (-Drier/+Wetter)		%	0.0	0.5	0.0	0.5	0.5	0.0	0.0	0.0
Specification	Density Ratio (Standard)	≥95%	Specification			Moisture Variance from OMC			±2%	
TEST LOCATION										
Easting	294786.959	294786.299	294837.697	294817.456	294781.722	294773.582	294813.838	294811.973		
Northing	6268910.021	6268937.52	6268934.219	6268687.296	6268702.97	6268721.293	6268722.476	6268745.681		
Reduced Level	m		17.243	17.172	16.855	19.396	19.396	19.143	18.941	18.935
Shown on Drawing No	8599/1-100				8599/1-101					
Retested by Test	-	-	-	-	-	-	-	-		
FIELD & LABORATORY DATA										
Field Wet Density	t/m ³	2.08	2.08	2.10	2.10	2.09	2.07	2.07	2.11	
Field Moisture Content	%	18.5	17.5	17.5	17.5	18.5	18.0	18.0	16.5	
Material retained on 19mm Sieve (wet)	%	<5	<5	<5	<5	<5	<5	<5	<5	
Lab Compaction result from test number		5986	5987	5988	5989	5990	5991	5992	5993	
Peak Converted Wet Density	t/m ³	2.14	2.14	2.15	2.14	2.13	2.12	2.14	2.13	
Apparent Optimum Moisture Content	%	18.5	17.0	17.5	17.0	18.0	18.0	17.5	16.5	
Number of Compaction Points		3	3	3	3	3	3	3	3	
Test Procedures - See Note Number		12	12	12	12	12	12	12	12	
Material Description - see below		2	2	2	2	2	2	2	2	
Notes										
1: Assigned Values have been obtained from our Penrith laboratory – Accreditation No 2734					10: AS 1289 1.2.1 clause 6.4 (b), 2.1.1, 5.3.1, 5.5.1, 5.6.1					
2: Assigned Values have been obtained from our Prestons laboratory – Accreditation No 14234					11: AS 1289 1.2.1 clause 6.4 (b), 2.1.1, 5.3.1, 5.7.1					
3: Results have been calculated using infinite decimal places. Therefore, calculated values may vary from those shown					12: AS 1289 1.2.1 clause 6.4 (b), 2.1.1, 5.7.1, 5.8.1					
4: AS 1289 1.2.1 clause 6.4 (b), 2.1.1, 5.1.1, 5.3.1, 5.4.1					13: RMS T111, T119, T120, T166					
5: AS 1289 1.2.1 clause 6.4 (b), 2.1.1, 5.2.1, 5.3.1, 5.4.1					14: RMS T111, T120, T166, T173					
6: AS 1289 1.2.1 clause 6.4 (b),					15: RMS T120, T119, T162					
7: AS 1289 1.2.1 clause 6.4 (b), 2.1.1, 5.2.1, 5.4.1, 5.8.1					16: RMS T120, T162, T173					
8: AS 1289 1.2.1 clause 6.4 (b), 2.1.1., 5.5.1, 5.6.1, 5.8.1					17: RMS T120, T164, T173					
9: Full details of Test Procedure 5.8.1 available on request										
Material Description										
1. CL-Clays of low plasticity, gravelly clays, sandy clays, silty clays			11. DGS40			* Cement Stabilised				
2. CI-Clay of medium plasticity, gravelly clays, sandy clays, silty clays			12. FCR20			# Lime Stabilised				
3. CH-Clays of high plasticity			13. FCR40			\$ Gypsum Stabilised				
4. SC-Clayey sands, sand-clay mixtures			14. RC - Recycled Concrete							
5. SM-Silty sands, sand-silt mixtures			15. Recycled Roadbase							
6. GC-Clayey gravels, gravel-sand-clay mixtures			16. RSB - Recycled Sub-base							
7. SP-Sand, crushed dust, filling sand, washed sand			17. CSS - Crushed Sandstone							
8. DGB20			18. RSS - Ripped Sandstone							
9. DGB40			19. Cowels Brown							
10. DGS20										

Form No R 020c Version 01 06/17 - issued by ER



Accreditation Number 2734
Corporate Site Number 2727

Accredited for compliance with
ISO/IEC 17025 - Testing.

A Kench 23/05/2018

Approved Signatory

Head Office:
34 Borec Road, Penrith NSW 2750
P O Box 880 Penrith NSW 2751
Telephone: (02) 4722 2:

Prestons Laboratory:
Unit 4, 18-20 Whyalla Place, Prestons NSW 2170
Telephone: (02) 9607 6111 Facsimile: (02) 9607 6200

FIELD DENSITY RESULTS

DARACON CONTRACTORS PTY LTD
184 ADDERLEY STREET WEST
AUBURN NSW 2144

Laboratory: Penrith
Job No: 8599/1
Date: 23/05/2018

PROJECT: SITE FILL TESTING - AREA B
RESIDENTIAL DEVELOPMENT.WOORONG PARK, MARSDEN PARK

Page 10 of 11

TEST NUMBER	5994	5995	5996	5997	5998	5999	6000	6001							
DATE TESTED	15/05/2018							17/05/2018							
RESULTS															
Hilf Density Ratio	Standard	%	97	97.5	97.5	100.5	98	97.5	98	96.5					
Moisture Variation from OMC (-Drier/+Wetter)		%	0.0	-0.5	0.5	-0.5	-0.5	-0.5	-0.5	-0.5					
Specification	Density Ratio (Standard)	≥95%	Specification				Moisture Variance from OMC			±2%					
TEST LOCATION															
Easting	294769.777	294774.139	294818.632	294829.052	294790.619	294778.376	294823.566	294870.699							
Northing	6268753.69	6268778.653	6268780.331	6268810.489	6268819.603	6268838.132	6268848.107	6269021.118							
Reduced Level	m							18.885	18.623	18.823	18.53	18.329	18.181	18.185	17.737
Shown on Drawing No	8599/1-101							8599/1-100							
Retested by Test	-	-	-	-	-	-	-	-							
FIELD & LABORATORY DATA															
Field Wet Density	t/m ³	2.08	2.11	2.09	2.12	2.08	2.07	2.09	2.07						
Field Moisture Content	%	18.0	18.5	18.5	14.5	14.5	14.0	14.5	16.5						
Material retained on 19mm Sieve (wet)	%	<5	<5	<5	<5	<5	<5	<5	<5						
Lab Compaction result from test number		5994	5995	5996	5997	5998	5999	6000	6001						
Peak Converted Wet Density	t/m ³	2.14	2.16	2.14	2.11	2.12	2.12	2.13	2.14						
Apparent Optimum Moisture Content	%	18.0	19.0	18.0	15.0	15.5	14.5	15.0	17.5						
Number of Compaction Points		3	3	3	3	3	3	3	3						
Test Procedures - See Note Number		12	12	12	12	12	12	12	12						
Material Description - see below		2	2	2	2	2	2	2	2						
Notes															
1: Assigned Values have been obtained from our Penrith laboratory – Accreditation No 2734					10: AS 1289 1.2.1 clause 6.4 (b), 2.1.1, 5.3.1, 5.5.1, 5.6.1										
2: Assigned Values have been obtained from our Prestons laboratory – Accreditation No 14234					11: AS 1289 1.2.1 clause 6.4 (b), 2.1.1, 5.3.1, 5.7.1										
3: Results have been calculated using infinite decimal places. Therefore, calculated values may vary from those shown					12: AS 1289 1.2.1 clause 6.4 (b), 2.1.1, 5.7.1, 5.8.1										
4: AS 1289 1.2.1 clause 6.4 (b), 2.1.1, 5.1.1, 5.3.1, 5.4.1					13: RMS T111, T119, T120, T166										
5: AS 1289 1.2.1 clause 6.4 (b), 2.1.1, 5.2.1, 5.3.1, 5.4.1					14: RMS T111, T120, T166, T173										
6: AS 1289 1.2.1 clause 6.4 (b),					15: RMS T120, T119, T162										
7: AS 1289 1.2.1 clause 6.4 (b), 2.1.1, 5.2.1, 5.4.1, 5.8.1					16: RMS T120, T162, T173										
8: AS 1289 1.2.1 clause 6.4 (b), 2.1.1., 5.5.1, 5.6.1, 5.8.1					17: RMS T120, T164, T173										
9: Full details of Test Procedure 5.8.1 available on request															
Material Description															
1. CL-Clays of low plasticity, gravelly clays, sandy clays, silty clays			11. DGS40			* Cement Stabilised									
2. CI-Clay of medium plasticity, gravelly clays, sandy clays, silty clays			12. FCR20			# Lime Stabilised									
3. CH-Clays of high plasticity			13. FCR40			\$ Gypsum Stabilised									
4. SC-Clayey sands, sand-clay mixtures			14. RC - Recycled Concrete												
5. SM-Silty sands, sand-silt mixtures			15. Recycled Roadbase												
6. GC-Clayey gravels, gravel-sand-clay mixtures			16. RSB - Recycled Sub-base												
7. SP-Sand, crushed dust, filling sand, washed sand			17. CSS - Crushed Sandstone												
8. DGB20			18. RSS - Ripped Sandstone												
9. DGB40			19. Cowels Brown												
10. DGS20															

Form No R 020c Version 01 06/17 - issued by ER



Accreditation Number 2734
Corporate Site Number 2727

Accredited for compliance with
ISO/IEC 17025 - Testing.

A Kench 23/05/2018

Approved Signatory

Head Office:
34 Borec Road, Penrith NSW 2750
P O Box 880 Penrith NSW 2751
Telephone: (02) 4722 2:

Prestons Laboratory:
Unit 4, 18-20 Whyalla Place, Prestons NSW 2170
Telephone: (02) 9607 6111 Facsimile: (02) 9607 6200

FIELD DENSITY RESULTS

DARACON CONTRACTORS PTY LTD
184 ADDERLEY STREET WEST
AUBURN NSW 2144

Laboratory: Penrith
Job No: 8599/1
Date: 23/05/2018

PROJECT: SITE FILL TESTING - AREA B
RESIDENTIAL DEVELOPMENT.WOORONG PARK, MARSDEN PARK

Page 11 of 11

TEST NUMBER	6002	6003	6004	6005	6006	6007	6008	6009		
DATE TESTED	17/05/2018									
RESULTS										
Hilf Density Ratio	Standard	%	97	97.5	97	97.5	96.5	95	96.5	96
Moisture Variation from OMC (-Drier/+Wetter)		%	-0.5	0.0	0.0	0.5	0.0	0.0	-0.5	-0.5
Specification	Density Ratio (Standard)	≥95%	Specification			Moisture Variance from OMC			±2%	
TEST LOCATION										
Easting	294826.63	294801.419	294831.81	294850.606	294791.672	294829.29	294845.541	294799.049		
Northing	6269030.547	6269020.273	6269002.191	6268976.67	6268968.93	6268945.117	6268918.546	6268916.781		
Reduced Level	m 17.744 17.548 17.684 17.62 18.186 17.772 17.912 18.181									
Shown on Drawing No	8599/1-100									
Retested by Test	-	-	-	-	-	-	-	-		
FIELD & LABORATORY DATA										
Field Wet Density	t/m ³	2.08	2.10	2.09	2.11	2.09	2.07	2.08	2.07	
Field Moisture Content	%	15.0	15.5	16.0	15.0	17.5	15.5	15.0	16.0	
Material retained on 19mm Sieve (wet)	%	<5	<5	<5	<5	<5	<5	<5	<5	
Lab Compaction result from test number		6002	6003	6004	6005	6006	6007	6008	6009	
Peak Converted Wet Density	t/m ³	2.14	2.15	2.16	2.16	2.17	2.18	2.16	2.16	
Apparent Optimum Moisture Content	%	15.0	15.5	16.0	15.0	18.0	16.0	15.5	16.0	
Number of Compaction Points		3	3	3	3	3	3	3	3	
Test Procedures - See Note Number		12	12	12	12	12	12	12	12	
Material Description - see below		2	2	2	2	2	2	2	2	
Notes										
1: Assigned Values have been obtained from our Penrith laboratory – Accreditation No 2734					10: AS 1289 1.2.1 clause 6.4 (b), 2.1.1, 5.3.1, 5.5.1, 5.6.1					
2: Assigned Values have been obtained from our Prestons laboratory – Accreditation No 14234					11: AS 1289 1.2.1 clause 6.4 (b), 2.1.1, 5.3.1, 5.7.1					
3: Results have been calculated using infinite decimal places. Therefore, calculated values may vary from those shown					12: AS 1289 1.2.1 clause 6.4 (b), 2.1.1, 5.7.1, 5.8.1					
4: AS 1289 1.2.1 clause 6.4 (b), 2.1.1, 5.1.1, 5.3.1, 5.4.1					13: RMS T111, T119, T120, T166					
5: AS 1289 1.2.1 clause 6.4 (b), 2.1.1, 5.2.1, 5.3.1, 5.4.1					14: RMS T111, T120, T166, T173					
6: AS 1289 1.2.1 clause 6.4 (b),					15: RMS T120, T119, T162					
7: AS 1289 1.2.1 clause 6.4 (b), 2.1.1, 5.2.1, 5.4.1, 5.8.1					16: RMS T120, T162, T173					
8: AS 1289 1.2.1 clause 6.4 (b), 2.1.1., 5.5.1, 5.6.1, 5.8.1					17: RMS T120, T164, T173					
9: Full details of Test Procedure 5.8.1 available on request										
Material Description										
1. CL-Clays of low plasticity, gravelly clays, sandy clays, silty clays			11. DGS40			* Cement Stabilised				
2. CI-Clay of medium plasticity, gravelly clays, sandy clays, silty clays			12. FCR20			# Lime Stabilised				
3. CH-Clays of high plasticity			13. FCR40			\$ Gypsum Stabilised				
4. SC-Clayey sands, sand-clay mixtures			14. RC - Recycled Concrete							
5. SM-Silty sands, sand-silt mixtures			15. Recycled Roadbase							
6. GC-Clayey gravels, gravel-sand-clay mixtures			16. RSB - Recycled Sub-base							
7. SP-Sand, crushed dust, filling sand, washed sand			17. CSS - Crushed Sandstone							
8. DGB20			18. RSS - Ripped Sandstone							
9. DGB40			19. Cowels Brown							
10. DGS20										

Form No R 020c Version 01 06/17 - issued by ER



Accreditation Number 2734
Corporate Site Number 2727


Accredited for compliance with
ISO/IEC 17025 - Testing.

A Kench 23/05/2018

Approved Signatory

Head Office:
34 Borec Road, Penrith NSW 2750
P O Box 880 Penrith NSW 2751
Telephone: (02) 4722 21

Prestons Laboratory:
Unit 4, 18-20 Whyalla Place, Prestons NSW 2170
Telephone: (02) 9607 6111 Facsimile: (02) 9607 6200

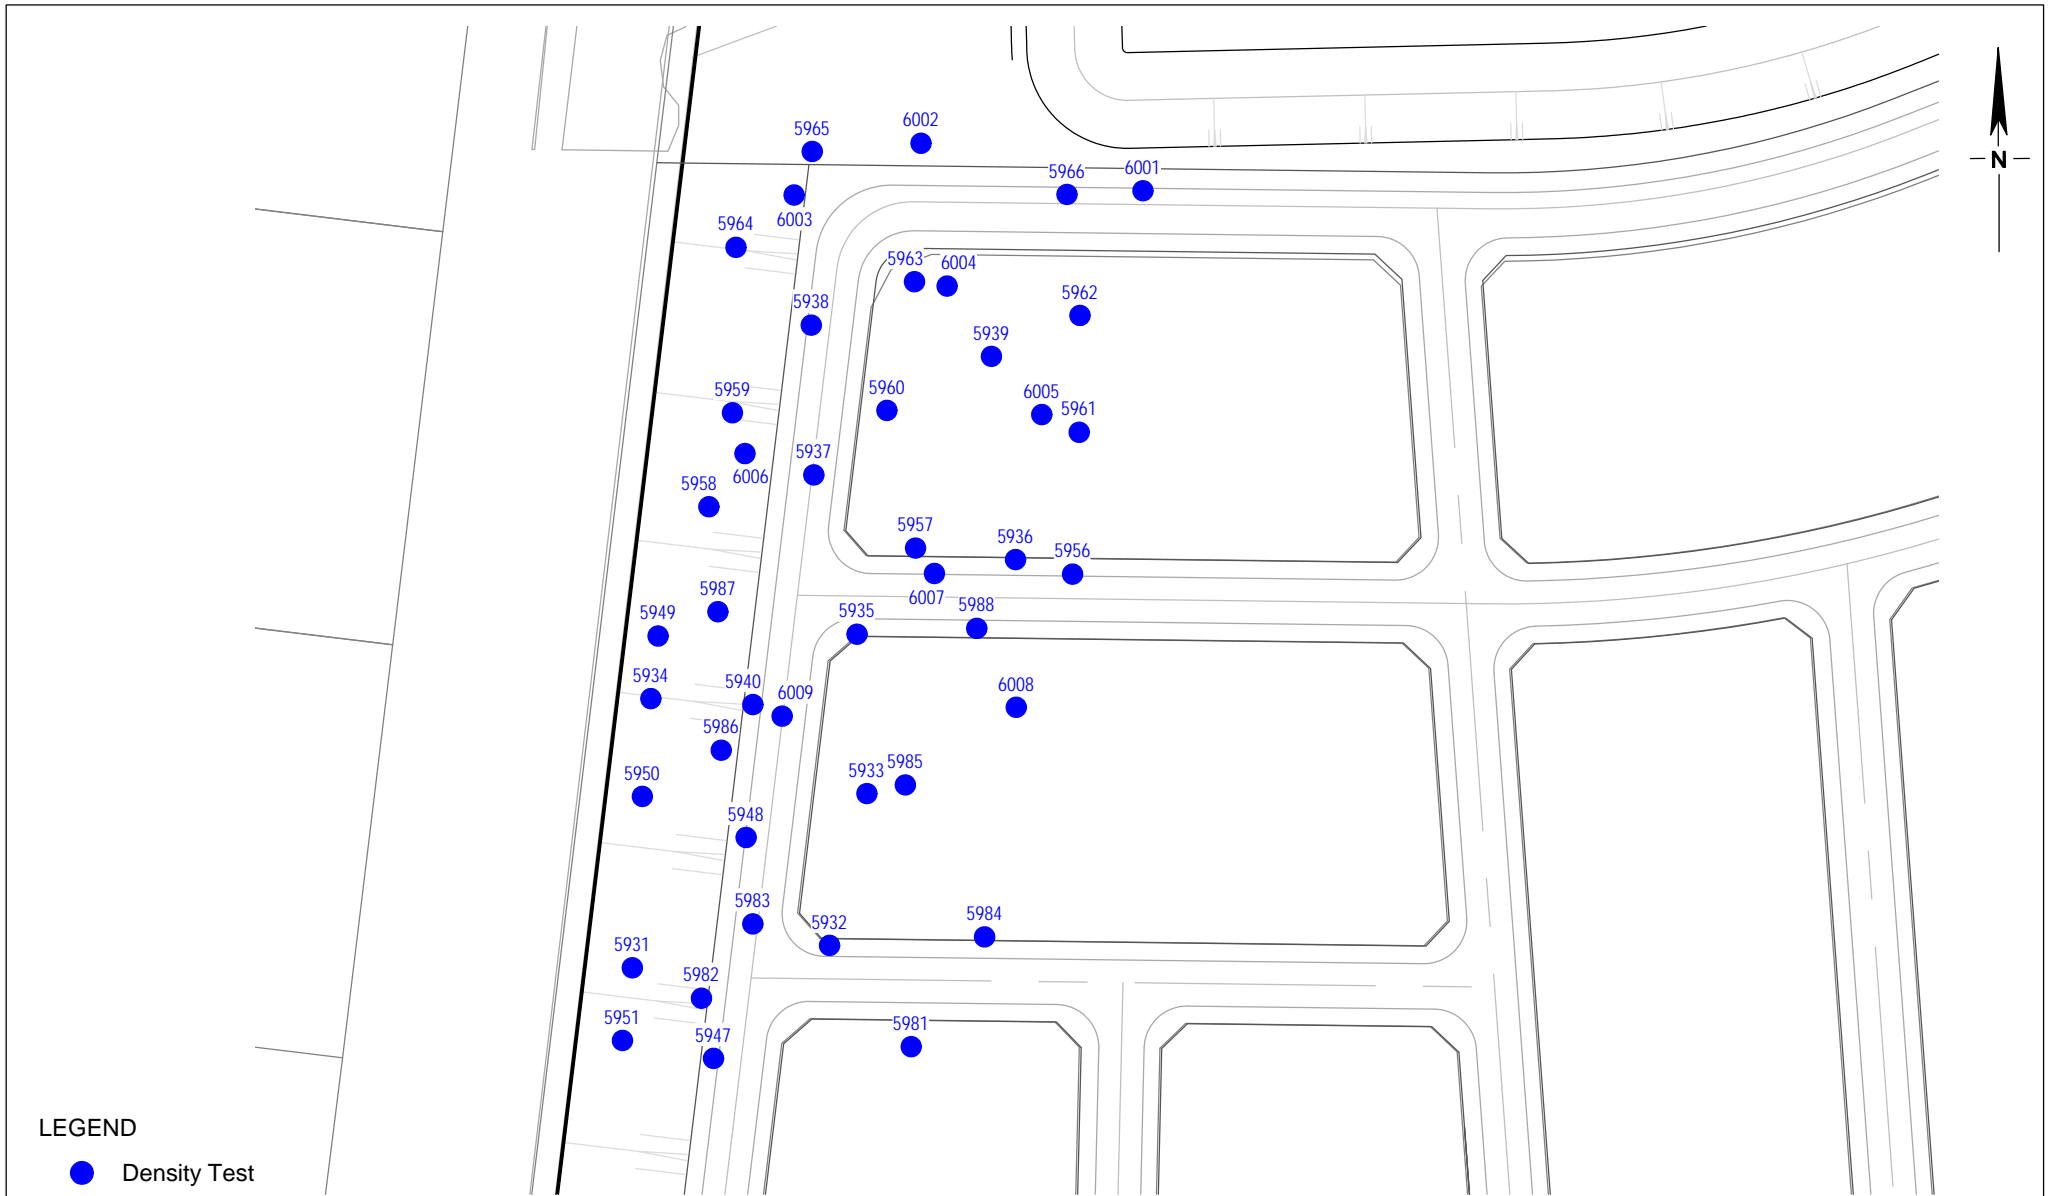

34 Borec Road
 Penrith
 NSW 2750
 ABN 71 076 676 321

Ph: 02 4722 2744
 Fx: 02 4722 2777
 www.geotech.com.au
 e-mail: info@geotech.com.au

NOTES



1. Site features are indicative and are not to scale.
2. This drawing has been produced using a base plan provided by others to which additional information e.g test pits, borehole locations or notes have been added. Some or all of the plan may not be relevant at the time of producing this drawing

Daracon Contractors Pty Ltd
 Residential Development
 Woorong Park - Area B
 Marsden Park

Location of Field Density Tests

Drawing No: 8599/1-100
 Job No: 8599/1
 Drawn By: MH
 Date: 22 May 2018
 Checked By: AK

File No: 8599-1
 Layers: 0, Lay100

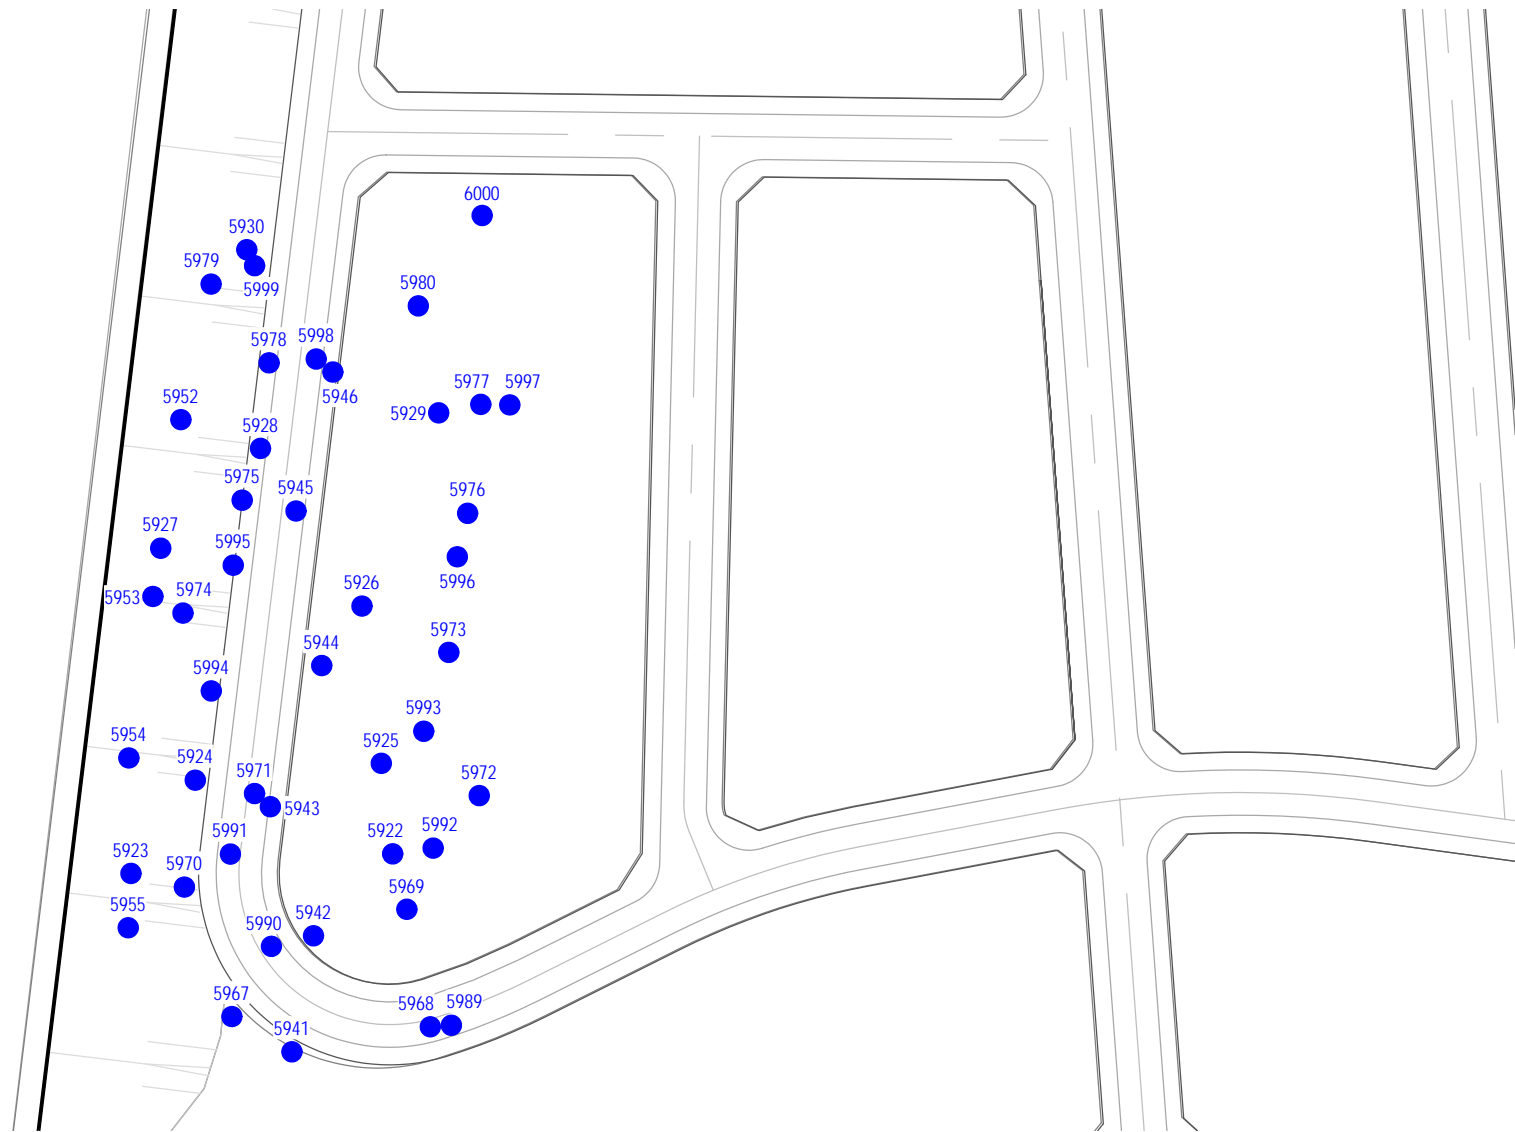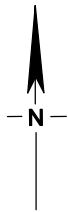

LEGEND

● Density Test



34 Borec Road
Penrith
NSW 2750
ABN 71 076 676 321

Ph: 02 4722 2744
Fx: 02 4722 2777
www.geotech.com.au
e-mail: info@geotech.com.au

NOTES

1. Site features are indicative and are not to scale.
2. This drawing has been produced using a base plan provided by others to which additional information e.g test pits, borehole locations or notes have been added. Some or all of the plan may not be relevant at the time of producing this drawing

Daracon Contractors Pty Ltd
Residential Development
Woorong Park - Area B
Marsden Park

Location of Field Density Tests

Drawing No: 8599/1-101
Job No: 8599/1
Drawn By: MH
Date: 22 May 2018
Checked By: AK

File No: 8599-1
Layers: 0, Lay101

GEOTECH

TESTING PTY LTD[®]

ABN 71 076 676 321



Quality
ISO 9001

SAI GLOBAL

GEOTECHNICAL INSPECTION AND TESTING AUTHORITY

Accreditation No 2734 Corporate Site No 2727

LEVEL 1 DAILY REPORT

Client:	Daracon Contractors Pty Ltd	Project No:	8599/1
Project:	Woorong Bulk Earthworks	Report No:	283
Location:	Marsden Park	Report Date:	20/04/2018
Test Methods:	AS 1289 5.1.1, 5.8.1	Technician:	Heath Wilson
Time on site: 6.30			
Time off site: 5.00			
1. Subgrade Approval			
Areas ID	Subgrade Approval Report No:	Comments	
APPROVED SUBGRADE	SUBGRADE / 22	TEST NO'S / 5922-5938/10	
APPROVED SUBGRADE	SUBGRADE /	TEST NO'S /	
2. Lot Approval			
Lot ID	Lot Approval Report No:	Comments	
3. Survey			
Type of Survey Test Locations Lot Boundaries	Survey undertaken by: Geotech / Geotech /	Reference	
4. Instructions received on site			
5. Instructions given on site			
TRUCKS CARRYING IMPORT MATERIAL TO APPROVED SUBGRADE 22 STONEY CREEK ROAD BITER 2x COMPACTORS PUSHING WEST TO CREATE THE SAME LEVEL SURFACE ALL THE WAY ACROSS			
COMMENTS: GRADER TRIMMING HALL ROADS FROM RICHMOND ROAD TO FILL AREA GRADER ALSO TRIMMING SANDSTONE IN PRECINCT 4 READY FOR BASE LAYER			
Signed:		Date: 20-04-18	

GEOTECH

TESTING PTY LTD[®]

ABN 71 076 676 321



Quality
ISO 9001

SAI GLOBAL

GEOTECHNICAL INSPECTION AND TESTING AUTHORITY

Accreditation No 2734 Corporate Site No 2727

LEVEL 1 DAILY REPORT

Client:	Daracon Contractors Pty Ltd	Project No:	8599/1
Project:	Woorong Bulk Earthworks	Report No:	284
Location:	Marsden Park	Report Date:	23 / 04 / 2018
Test Methods:	AS 1289 5.1.1, 5.8.1	Technician:	Heath Wilson
Time on site: 0630			
Time off site: 5:00			
1. Subgrade Approval			
Areas ID	Subgrade Approval Report No:	Comments	
APPROVED SUBGRADE	SUBGRADE / 22	TEST NO'S / 5932 - 5939 / 8	
APPROVED SUBGRADE	SUBGRADE /	TEST NO'S /	
2. Lot Approval			
Lot ID	Lot Approval Report No:	Comments	
3. Survey			
Type of Survey	Survey undertaken by:	Reference	
Test Locations	Geotech /		
Lot Boundaries	Geotech /		
4. Instructions received on site			
GRADER SPREADING OUMPED ROADBASE IN PREC 4 FOR BASE LAYERS THROUGHOUT ALL FSL LEVELS TRUCKS CARRYING IMPACT MATERIAL TO APPROVED SUBGRADE 22 2x COMPACTORS WORKING OF THE FACE TOWARDS THE EAST			
5. Instructions given on site			
DB HELPING WITH THE LARGE AMOUNTS OF FILL TO BE PUSHED WHILE TRUCKS KEEP CARRYING PAD FOOT ROLLER CONTINUES TO COMPACT THOSE AREAS THAT SQUARE UP TO BATTERS			
COMMENTS:			
Signed:		Date: 23.04.18	

GEOTECH

TESTING PTY LTD[®]

ABN 71 076 676 321




Quality
ISO 9001

SAI GLOBAL

GEOTECHNICAL INSPECTION AND TESTING AUTHORITY

Accreditation No 2734 Corporate Site No 2727

LEVEL 1 DAILY REPORT

Client:	Daracon Contractors Pty Ltd	Project No:	8599/1
Project:	Woorong Bulk Earthworks	Report No:	285
Location:	Marsden Park	Report Date:	01/05/2018
Test Methods:	AS 1289 5.1.1, 5.8.1	Technician:	Heath Wilson
Time on site: 0630			
Time off site: 500			
1. Subgrade Approval			
Areas ID	Subgrade Approval Report No:	Comments	
APPROVED SUBGRADE	SUBGRADE / 22	TEST NO'S / 5940-5948/9	
APPROVED SUBGRADE	SUBGRADE /	TEST NO'S /	
2. Lot Approval			
Lot ID	Lot Approval Report No:	Comments	
3. Survey			
Type of Survey Test Locations Lot Boundaries	Survey undertaken by: Geotech / Geotech /	Reference	
4. Instructions received on site			
2x 627 SCRAPERS TOPSOILING SUBGRADE 12 WITH PREVIOUSLY STOCKPILED MATERIAL GRADER PUSHING AND TRIMMING TO APPROX 150MM AT A LATER STAGE THE SEEDING TRACTOR WILL SPREAD GRASSING SEEDS AND WATERCART WILL BAITER SIDE SPRAY FROM MAIN ROADS			
5. Instructions given on site			
TRUCKS CARRYING IMPORT MATERIAL TO (154)22 PARALLEL TO STUNNY CR ROAD 2x COMPACTORS PUSHING LEFT WAIVER D8 KEYS INTO BAITER 16 CUTTING NORTH FOR NEXT LIFT GRADER ALSO TRIMMING FINISHED AREAS FOR COMPLETION			
COMMENTS:			
Signed: 		Date: 01.05.18	

GEOTECH

TESTING PTY LTD[®]

ABN 71 076 676 321




Quality
ISO 9001
SAI GLOBAL

GEOTECHNICAL INSPECTION AND TESTING AUTHORITY

Accreditation No 2734 Corporate Site No 2727

LEVEL 1 DAILY REPORT

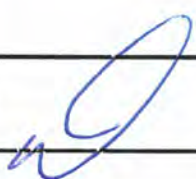Client:	Daracon Contractors Pty Ltd	Project No:	8599/1
Project:	Woorong Bulk Earthworks	Report No:	286
Location:	Marsden Park	Report Date:	02/05/2018
Test Methods:	AS 1289 5.1.1, 5.8.1	Technician:	Heath Wilson
Time on site: 0630			
Time off site: 500			
1. Subgrade Approval			
Areas ID	Subgrade Approval Report No:	Comments	
APPROVED SUBGRADE	SUBGRADE / 22	5949 TEST NO'S / 5999 5958/67	
APPROVED SUBGRADE	SUBGRADE /	TEST NO'S /	
2. Lot Approval			
Lot ID	Lot Approval Report No:	Comments	
3. Survey			
Type of Survey	Survey undertaken by:	Reference	
Test Locations	Geotech /		
Lot Boundaries	Geotech /		
4. Instructions received on site			
TRUCKS CARRYING IMPORT MATERIAL TO APPROVED SUBGRADE 22 ALONG NORTH END PARALLEL TO STONEY CREEK ROAD 2x COMPACTORS PUSHING OF THE TOP FACE FOR FINAL LIFT WHilst DOZER FINISHED KEYING (S4) 16 BATTER			
5. Instructions given on site			
2x SCRAPERS ARE STILL TOPSOILING (S4) 12 WHILST GRADER TRIMS TO LEVEL HALL ROADS ARE BEING BOXED OUT AND REPAIRED WITH SANDSTONE FOR 2ND LAYER (S4) ALSO			
COMMENTS: WATERCART SPRAYING 10AOS AS DUMPED INTO MILL AREA			
Signed: 		Date: 02.05.18	

GEOTECHNICAL INSPECTION AND TESTING AUTHORITY

Accreditation No 2734 Corporate Site No 2727

LEVEL 1 DAILY REPORT

Client:	Daracon Contractors Pty Ltd	Project No:	8599/1
Project:	Woorong Bulk Earthworks	Report No:	287
Location:	Marsden Park	Report Date:	03/05/2018
Test Methods:	AS 1289 5.1.1, 5.8.1	Technician:	Heath Wilson
Time on site: 0630			
Time off site: 5:00			
1. Subgrade Approval			
Areas ID	Subgrade Approval Report No:	Comments	
APPROVED SUBGRADE	SUBGRADE /	TEST NO'S /	
APPROVED SUBGRADE	SUBGRADE /	TEST NO'S /	
2. Lot Approval			
Lot ID	Lot Approval Report No:	Comments	
3. Survey			
Type of Survey Test Locations Lot Boundaries	Survey undertaken by: Geotech / Geotech /	Reference	
4. Instructions received on site			
TRUCKS CARRYING IMPORT MATERIAL TO SUBGRADE 22 PLACING IMPORT ON THE TOP AND PUSHING NORTH OF THE FACE WITH 2X COMPACTORS ALSO DOZER DIGGING WHILST KEYING INTO BATTER FOR FURTHER HIT AS REQUIRED			
5. Instructions given on site			
2X SCRAPERS PLACING TOPSOIL OVER (SG) 12 WITH PREVIOUSLY STOCKPILED MATERIAL GRADER TRIMMING TO ESE FIVE 50 GRASS SEEDING TRACTOR CAN DO HIS JOB CULVERT BUTMENT HAS MORE KILL BIASED WHIL 12 PAD 1500F			
COMMENTS: ROLLS AND REMOVE 21 TO COMPACT UP AGAINST CONCRETE FORM ROAD BASE PLACED ON ROAD C102 WITH MOISTURE ADJUSTMENT FOR TRIAL FROM QUARRY			
Signed:			Date: 03.05.18

GEOTECH

TESTING PTY LTD[®]

ABN 71 076 676 321




Quality
ISO 9001
SAI GLOBAL

GEOTECHNICAL INSPECTION AND TESTING AUTHORITY

Accreditation No 2734 Corporate Site No 2727

LEVEL 1 DAILY REPORT

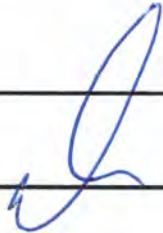Client:	Daracon Contractors Pty Ltd	Project No:	8599/1
Project:	Woorong Bulk Earthworks	Report No:	288
Location:	Marsden Park	Report Date:	04/05/2018
Test Methods:	AS 1289 5.1.1, 5.8.1	Technician:	Heath Wilson
Time on site: 0630			
Time off site: 5:00			
1. Subgrade Approval			
Areas ID	Subgrade Approval Report No:	Comments	
APPROVED SUBGRADE	SUBGRADE / 22	TEST NO'S / 5956-5966/11	
APPROVED SUBGRADE	SUBGRADE /	TEST NO'S /	
2. Lot Approval			
Lot ID	Lot Approval Report No:	Comments	
3. Survey			
Type of Survey	Survey undertaken by:	Reference	
Test Locations	Geotech /		
Lot Boundaries	Geotech /		
4. Instructions received on site			
ROAD TRUCKS CARRYING IMPURE MATERIAL TO APPROVED SUBGRADE 22 RUNNING PARALLEL TO STONEY CR ROAD 2X COMPACTORS PUSHING PALEO OF THE FACE TO THE NORTH OR OVER ALSO PUSHING MATERIAL WHILST WATERCART SPRAYS			
5. Instructions given on site			
GRADER TRIMMING REFINEMENT SUBGRADE IN (S6) 12 EXCAVATOR LOADING OLMOTRUCK AND PLACING IN APPROVED AREAS PAD FOOT ROLLER COMPACTING ALONG WITH WATERCART TYRE ROLLING AFTER SANDSTONE WET UP			
COMMENTS:			
			
Signed:		Date: 04.05.18	

GEOTECH

TESTING PTY LTD[®]

ABN 71 076 676 321




Quality
ISO 9001

SAI GLOBAL

GEOTECHNICAL INSPECTION AND TESTING AUTHORITY

Accreditation No 2734 Corporate Site No 2727

LEVEL 1 DAILY REPORT

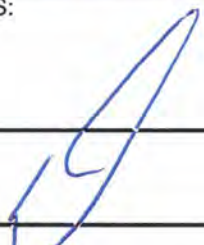Client:	Daracon Contractors Pty Ltd	Project No:	8599/1
Project:	Woorong Bulk Earthworks	Report No:	289
Location:	Marsden Park	Report Date:	07/05/2018
Test Methods:	AS 1289 5.1.1, 5.8.1	Technician:	Heath Wilson
Time on site: 0630			
Time off site: 5:00			
1. Subgrade Approval			
Areas ID	Subgrade Approval Report No:	Comments	
APPROVED SUBGRADE	SUBGRADE /	TEST NO'S /	
APPROVED SUBGRADE	SUBGRADE /	TEST NO'S /	
2. Lot Approval			
Lot ID	Lot Approval Report No:	Comments	
3. Survey			
Type of Survey Test Locations Lot Boundaries	Survey undertaken by: Geotech / Geotech /	Reference	
4. Instructions received on site			
TRUCKS CARRYING IMPORT MATERIAL TO SUBGRADE 22 MATERIAL DUMPED ON TOP AND PUSHED OFF THE FAIR PUSHING WEST TOWARDS STONEY CREEK ROAD WATERBURY ALSO SPRAYING PUSHED MATERIAL AND TIRE ROLLING			
5. Instructions given on site			
EXCAVATOR LOADING DUMPTRUCK AND PLACING STOCKPILED SANDSTONE IN BOXED OUT ROAD SUBGRADE 12 GRADER PUSHING IN SUBGRADE REPLACEMENT LAYER 100 FOOT ROLLER COMPACTING AS WATERBURY SPRAYS			
COMMENTS:			
Signed: 			
			Date: 07.05.18

GEOTECH

TESTING PTY LTD[®]

ABN 71 076 676 321



Quality
ISO 9001

SAI GLOBAL

GEOTECHNICAL INSPECTION AND TESTING AUTHORITY

Accreditation No 2734 Corporate Site No 2727

LEVEL 1 DAILY REPORT

Client:	Daracon Contractors Pty Ltd	Project No:	8599/1
Project:	Woorong Bulk Earthworks	Report No:	288 290
Location:	Marsden Park	Report Date:	08 / 05 / 2018
Test Methods:	AS 1289 5.1.1, 5.8.1	Technician:	Heath Wilson
Time on site: 0630			
Time off site: 5.00			
1. Subgrade Approval			
Areas ID	Subgrade Approval Report No:	Comments	
APPROVED SUBGRADE	SUBGRADE / 22	TEST NO'S / 5967-5977/7	
APPROVED SUBGRADE	SUBGRADE / 22	TEST NO'S / 5974-5978/5	
2. Lot Approval			
Lot ID	Lot Approval Report No:	Comments	
3. Survey			
Type of Survey Test Locations Lot Boundaries	Survey undertaken by: Geotech / Geotech /	Reference	
4. Instructions received on site			
BELIEVE IF OR NOT TRUCKS CARRYING IMPORT MATERIAL TO FILL AREA SUBGRADE 22 2x COMPACTORS PUSHING NORTH PARALLEL TO STONEY CREEK ROAD OR FORMING BATER INTO 10% WATER RUNOFF AREA WATERCART ALSO SPRAYING AND TYRE ROLLING			
5. Instructions given on site			
SHALE IMPORT IS BEYOND A USABLE SIZE SOME PIECES APPROX SIZE OF COMPACTOR WHEEL MATERIAL IS BEIN REMOVED FROM WORK AND WILL BE TAKEN OF SITE AS AREA IS WITHIN 1M FSL			
COMMENTS: SANDSTONE IS CONTINUING IN (54) IS AS SUBGRADE REQUIRMENT DUMP TRUCK SPREADING WITH GRADER SPREADS AND 900 FOOT BINS FOR FSL			
Signed:	Date: 08.05.18		

GEOTECH

TESTING PTY LTD[®]

ABN 71 076 676 321




Quality
ISO 9001

SAI GLOBAL

GEOTECHNICAL INSPECTION AND TESTING AUTHORITY

Accreditation No 2734 Corporate Site No 2727

LEVEL 1 DAILY REPORT

Client:	Daracon Contractors Pty Ltd	Project No:	8599/1
Project:	Woorong Bulk Earthworks	Report No:	289 291
Location:	Marsden Park	Report Date:	09 / 05 / 2018
Test Methods:	AS 1289 5.1.1, 5.8.1	Technician:	Heath Wilson
Time on site: 0630			
Time off site: 5.00			
1. Subgrade Approval			
Areas ID	Subgrade Approval Report No:	Comments	
APPROVED SUBGRADE	SUBGRADE /	TEST NO'S /	
APPROVED SUBGRADE	SUBGRADE /	TEST NO'S /	
2. Lot Approval			
Lot ID	Lot Approval Report No:	Comments	
3. Survey			
Type of Survey Test Locations Lot Boundaries	Survey undertaken by: Geotech / Geotech /	Reference	
4. Instructions received on site			
TRUCK AND DOGS CARRYING IMPORT MATERIAL TO APPROVED SUBGRADE 22 WHERE 2x COMPACTORS PUSHING NORTH INTO A DESIGNED DAM 08 HAS FORMED WITH THE IMPORT AND COMPACTORS HAVE TIGHTEND UP FOR SEALMENT			
5. Instructions given on site			
WATERCART SPRAYING PLACED LOADS WITH SHALE AND TYRE ROLLING UP AGAINST BATTER THAT DOZER HAS KEYED OUT FOR NEAR FINAL LIFT GRADER TRIMMING WALL ROADS IN (54) 12 ALSO REPLACEMENT			
COMMENTS: SUBGRADE FSL TOTS WITH TOPSOIL ARE ALSO HAVING TOPS TRIMED FOR GRASS TRAITOR TO SEED AT A LATER STAGE			
Signed: 		Date: 09.05.18	

GEOTECH

TESTING PTY LTD[®]

ABN 71 076 676 321



Quality
ISO 9001

SAI GLOBAL

GEOTECHNICAL INSPECTION AND TESTING AUTHORITY

Accreditation No 2734 Corporate Site No 2727

LEVEL 1 DAILY REPORT

Client:	Daracon Contractors Pty Ltd	Project No:	8599/31
Project:	Woorong Bulk Earthworks	Report No:	290 292
Location:	Marsden Park, Precinct 2	Report Date:	10 / 05 / 2018
Test Methods:	AS 1289 5.1.1, 5.8.1	Technician:	Heath Wilson
Time on site: 0630			
Time off site: 500			
1. Subgrade Approval			
Areas ID	Subgrade Approval Report No:	Comments	
APPROVED SUBGRADE	SUBGRADE 22	TEST NO'S 5979-5988/10	
2. Lot Approval			
Lot ID	Lot Approval Report No:	Comments	
3. Survey			
Type of Survey	Survey undertaken by:	Reference	
Test Locations	Geotech /		
Lot Boundaries	Geotech /		
4. Instructions received on site			
BASE COURSE WORKED INTO ROAD C102 MATERIAL FROM CONCRETE RECYCLERS GRADER TRIMMING TO FINISHED LEVEL TYPED ROLLER ROLLING UP AFTER WATERBART STURYS FOR THE FINISHED PRODUCT			
5. Instructions given on site			
3x DEP'S CARP OUT IN PROPOSED RETAINING WALL FOOTING KRA 150 300MM FOOTING WILL BE POURED WITH BLOCK WALL ON SURFACE TRUCK AND DOGS CARTRIDGE IMPACT FILL MATERIAL TO (56) 22 2x COMPACTORS PUSHING NORTH AGAINST STONEY CR ROAD			
COMMENTS: ORDER FORMING TOP LEVEL SALVAGE ALONG STONEY CR ROAD SIDE TOP OF FILL AREA TO MARRY FINAL LAYER INTO			
Signed:		Date: 10.05.18	

GEOTECH

TESTING PTY LTD[®]

ABN 71 076 676 321




Quality
ISO 9001

SAI GLOBAL

GEOTECHNICAL INSPECTION AND TESTING AUTHORITY

Accreditation No 2734 Corporate Site No 2727

LEVEL 1 DAILY REPORT

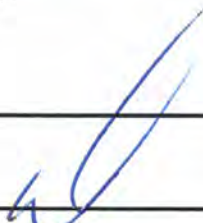Client:	Daracon Contractors Pty Ltd	Project No:	8599/01
Project:	Woorong Bulk Earthworks	Report No:	297293
Location:	Marsden Park, Precinct 2	Report Date:	14/05/2018
Test Methods:	AS 1289 5.1.1, 5.8.1	Technician:	Heath Wilson
Time on site: 0630			
Time off site: 5:00			
1. Subgrade Approval			
Areas ID	Subgrade Approval Report No:	Comments	
APPROVED SUBGRADE	SUBGRADE 22	TEST NO'S 5989-	
2. Lot Approval			
Lot ID	Lot Approval Report No:	Comments	
3. Survey			
Type of Survey	Survey undertaken by:	Reference	
Test Locations	Geotech /		
Lot Boundaries	Geotech /		
4. Instructions received on site			
TRUCKS CARRYING IMPORT FILL MATERIAL TO APPROVED SUBGRADE 22 WHERE 2x COMPACTORS PUSHING MATERIAL WEST ALONG STONEY CREEK ROAD ONTO FACE OF SUBGRADE WHILE WATERCART SPRAYS AND TYRE ROLLERS			
5. Instructions given on site			
ROAD BASE DRAINED ON ROAD C102 GRADER TRIMMING TO LEVEL MULTI TYRED ROLLER ON ROAD WATERCART SPRAYS IT IS FOR BASE LAYER APPROX 80% OF ROAD COMPLETE			
COMMENTS:			
			
Signed:			Date: 14.05.18

GEOTECHNICAL INSPECTION AND TESTING AUTHORITY

Accreditation No 2734 Corporate Site No 2727

LEVEL 1 DAILY REPORT

Client:	Daracon Contractors Pty Ltd	Project No:	8599/1
Project:	Woorong Bulk Earthworks	Report No:	294
Location:	Marsden Park	Report Date:	15 / 05 / 2018
Test Methods:	AS 1289 5.1.1, 5.8.1	Technician:	Heath Wilson
Time on site: 0630			
Time off site: 5:00			
1. Subgrade Approval			
Areas ID	Subgrade Approval Report No:	Comments	
APPROVED SUBGRADE	SUBGRADE / 22	TEST NO'S / 5989-6000 / 12	
APPROVED SUBGRADE	SUBGRADE /	TEST NO'S /	
2. Lot Approval			
Lot ID	Lot Approval Report No:	Comments	
3. Survey			
Type of Survey	Survey undertaken by:	Reference	
Test Locations	Geotech /		
Lot Boundaries	Geotech /		
4. Instructions received on site			
24 COMPACTORS PUSHING IMPORT MATERIAL FROM TRUCKS CARRYING FROM AROUND SYDNEY SITES PLACEMENT OF FILL IS PLACED ON THE TOP OF FACE AND PUSHED OF TOWARDS THE WEST TO STONEY CREEK ROAD			
5. Instructions given on site			
08 PUSHING IN WATER WHILST WATERCART WETS MATERIAL AND TYRE ROLLS IN TO CREATE A SEALED LAYER ROADBASE BEING PLACED IN ROAD C102 GRADER TRIMMING TO LEVEL AND SMOOTH DRUM ROLLS UP AFTER WATER HAS BEEN SPRAYED			
COMMENTS:			
Signed:		Date: 15-05-18	

GEOTECH

TESTING PTY LTD[®]

ABN 71 076 676 321




Quality
ISO 9001

SAI GLOBAL

GEOTECHNICAL INSPECTION AND TESTING AUTHORITY

Accreditation No 2734 Corporate Site No 2727

LEVEL 1 DAILY REPORT

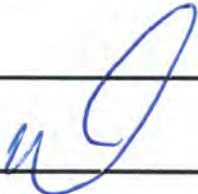Client:	Daracon Contractors Pty Ltd	Project No:	8599/1
Project:	Woorong Bulk Earthworks	Report No:	295
Location:	Marsden Park	Report Date:	16 / 05 / 2018
Test Methods:	AS 1289 5.1.1, 5.8.1	Technician:	Heath Wilson
Time on site: 0630			
Time off site: 5:00			
1. Subgrade Approval			
Areas ID	Subgrade Approval Report No:	Comments	
APPROVED SUBGRADE	SUBGRADE /	TEST NO'S /	
APPROVED SUBGRADE	SUBGRADE /	TEST NO'S /	
2. Lot Approval			
Lot ID	Lot Approval Report No:	Comments	
3. Survey			
Type of Survey Test Locations Lot Boundaries	Survey undertaken by: Geotech / Geotech /	Reference	
4. Instructions received on site			
TRUCKS CARRYING IMPORT MATERIAL TO APPROVED SUBGRADE 22 RUNNING ALONG SIDE STONEY CREEK ROAD 2x DOZERS PUSHING MATERIAL OFF THE FACE ALONG WITH 825 COMPACTOR ALSO DID FOOT ROLLER ROLLING BITERS OFF FACE			
5. Instructions given on site			
GRADER TRIMMING PADDOCKS IN PRECINCT 3 SO TOPSOIL IS READY FOR THE SEEDING TRACTOR (CBA) SAMPLES CARRIED OUT IN PRECINCT 4 12 ALL UP FOR PAVEMENT DESIGN AS PROPOSED INSTEAD OF THE SUBGRADE REPLACEMENT			
COMMENTS:			
Signed: 			
Date: 16 05 18			

GEOTECHNICAL INSPECTION AND TESTING AUTHORITY

Accreditation No 2734 Corporate Site No 2727

LEVEL 1 DAILY REPORT

Client:	Daracon Contractors Pty Ltd	Project No:	8599/1
Project:	Woorong Bulk Earthworks	Report No:	296
Location:	Marsden Park	Report Date:	17/05/2018
Test Methods:	AS 1289 5.1.1, 5.8.1	Technician:	Heath Wilson
Time on site: 0630			
Time off site: 5:00			
1. Subgrade Approval			
Areas ID	Subgrade Approval Report No:	Comments	
APPROVED SUBGRADE	SUBGRADE / 22	TEST NO'S / 6001 - 6009 / 9	
APPROVED SUBGRADE	SUBGRADE /	TEST NO'S /	
2. Lot Approval			
Lot ID	Lot Approval Report No:	Comments	
3. Survey			
Type of Survey Test Locations Lot Boundaries	Survey undertaken by: Geotech / Geotech /	Reference	
4. Instructions received on site			
TRUCKS CARRYING IMPORT FILL MATERIAL TO SUBGRADE (22) RUNNING DARRAELL TO STONEY CREEK ROAD FSL LAYER IS APPROX 30% COMPLETE PUSHING MATERIAL WEST OF THE FACE MORRYING INTO SUBGRADE BATTER (16)			
5. Instructions given on site			
GRADER TRIMMING FSL IN SUBGRADE 22 LOWER AREA TOWARDS FARM HOUSE WHERE DAM CREATED TRUCKS WILL CONTINUE TO CART IMPORT UNTIL LEVEL TO MINIMIZE WATER RUNOFF			
COMMENTS: TRUCKS CARRYING NOW TO SUBGRADE 12 TO FILL LOW AREA AND GIVE COMPACTOR AND DOZER TO FINISH UP STONEY CREEK SIDE			
Signed:	Date: 17.05.18		

GEOTECH

TESTING PTY LTD[®]

ABN 71 076 676 321



Quality
ISO 9001

SAI GLOBAL

GEOTECHNICAL INSPECTION AND TESTING AUTHORITY

Accreditation No 2734 Corporate Site No 2727

LEVEL 1 DAILY REPORT

Client:	Daracon Contractors Pty Ltd	Project No:	8599/1
Project:	Woorong Bulk Earthworks	Report No:	295297
Location:	Marsden Park	Report Date:	18 / 05 / 2018
Test Methods:	AS 1289 5.1.1, 5.8.1	Technician:	Heath Wilson
Time on site: 0630			
Time off site: 5:00			
1. Subgrade Approval			
Areas ID	Subgrade Approval Report No:	Comments	
APPROVED SUBGRADE	SUBGRADE /	TEST NO'S /	
APPROVED SUBGRADE	SUBGRADE /	TEST NO'S /	
2. Lot Approval			
Lot ID	Lot Approval Report No:	Comments	
3. Survey			
Type of Survey Test Locations Lot Boundaries	Survey undertaken by: Geotech / Geotech /	Reference	
4. Instructions received on site			
D8 PUSHING 1090S OVER IN 89)12 TO LIFT FINAL MEN TO LEVEL WATERLARI SPRAYING WAIST TYRE ROLLING THE LAST DAY FOR BULK EARTHWORKS PAVEMENT TESTING WILL CONTINUE IN PRECINCT 4			
5. Instructions given on site			
COMMENTS:			
Signed:		Date: 18.05.18	

FIELD DENSITY RESULTS

DARACON CONTRACTORS PTY LTD
184 ADDERLEY STREET WEST
AUBURN NSW 2144

Laboratory: Penrith
Job No: 8599/84

PROJECT: SITE FILL TESTING
RESIDENTIAL DEVELOPMENT WOORONG PARK MARSDEN PARK PRECINCT, NEWPARK PRECINCT 7 STAGE 7F

Page 1 of 2

TEST NUMBER	1	2	3	4	5	6	7	8		
DATE TESTED & SAMPLED	03/05/2022				04/05/2022					
RESULTS										
Hilf Density Ratio	Standard	%	96	97	96.5	97	100.5	98.5	100.5	99.5
Moisture Variation from OMC (-Drier/+Wetter)		%	-0.5	-0.5	-0.5	-0.5	0.0	0.0	0.0	0.0
Specification	Density Ratio (Standard)	≥95%	Specification				Moisture Variance from OMC	±2%		
TEST LOCATION										
Chainage (Carriageway L/R)	m	-	-	-	-	-	-	-		
Shown on Drawing No		8599/84-1								
Retested by Test		-	-	-	-	-	-	-		
Layer Thickness	mm	150	150	150	150	150	150	150		
Reduced Level	m	17.7	17.84	17.91	18.14	18.22	18.29	18.78	18.68	
FIELD & LABORATORY DATA										
Field Wet Density	t/m ³	2.18	2.17	2.10	2.12	2.11	2.10	2.12	2.11	
Field Moisture Content	%	11.0	12.5	17.0	17.0	19.0	18.0	18.5	17.5	
Material retained on 19mm Sieve (wet)	%	18	16	<5	<5	<5	<5	<5	<5	
Lab Compaction result from test number		1	2	3	4	5	6	7	8	
Lab Compaction Date Tested		12/05/2022	12/05/2022	12/05/2022	12/05/2022	23/06/2022	23/06/2022	23/06/2022	23/06/2022	
Peak Converted Wet Density	t/m ³	2.27	2.24	2.18	2.19	2.10	2.13	2.11	2.12	
Apparent Optimum Moisture Content	%	11.0	13.0	17.5	17.5	19.0	18.0	18.5	17.0	
Number of Compaction Points		3	3	3	3	3	3	3	3	
Test Procedures - See Note Number		12	12	12	12	12	12	12	12	
Material Description - see below		1	1	2	2	2	2	2	2	
Notes										
1: Assigned Values have been obtained from our Penrith laboratory – Accreditation No 2734					10: AS 1289 1.2.1 clause 6.4 (b), 2.1.1, 5.3.1, 5.5.1, 5.6.1					
2: Assigned Values have been obtained from our Prestons laboratory – Accreditation No 14234					11: AS 1289 1.2.1 clause 6.4 (b), 2.1.1, 5.3.1, 5.7.1					
3: Results have been calculated using infinite decimal places. Therefore, calculated values may vary from those shown										
4: AS 1289 1.2.1 clause 6.4 (b), 2.1.1, 5.1.1, 5.3.1, 5.4.1					12: AS 1289 1.2.1 clause 6.4 (b), 2.1.1, 5.7.1, 5.8.1					
5: AS 1289 1.2.1 clause 6.4 (b), 2.1.1, 5.2.1, 5.3.1, 5.4.1					13: RMS T111, T119, T120, T166					
6: AS 1289 1.2.1 clause 6.4					14: RMS T111, T120, T166, T173					
7: AS 1289 1.2.1 clause 6.4 (b), 2.1.1, 5.2.1, 5.4.1, 5.8.1					15: RMS T120, T119, T162					
8: AS 1289 1.2.1 clause 6.4 (b), 2.1.1, 5.5.1, 5.6.1, 5.8.1					16: RMS T120, T162, T173					
9: Full details of Test Procedure 5.8.1 available on request					17: RMS T120, T164, T173					
Material Description										
1. CL-Clays of low plasticity, gravelly clays, sandy clays, silty clays			11. DGS40			* Cement Stabilised				
2. CI-Clay of medium plasticity, gravelly clays, sandy clays, silty clays			12. FCR20			# Lime Stabilised				
3. CH-Clays of high plasticity			13. FCR40			\$ Gypsum Stabilised				
4. SC-Clayey sands, sand-clay mixtures			14. RC - Recycled Concrete							
5. SM-Silty sands, sand-silt mixtures			15. Recycled Roadbase							
6. GC-Clayey gravels, gravel-sand-clay mixtures			16. RSB - Recycled Sub-base							
7. SP-Sand, crushed dust, filling sand, washed sand			17. CSS - Crushed Sandstone							
8. DGB20			18. RSS - Ripped Sandstone							
9. DGB40			19. Cowels Brown							
10. DGS20										

Form No R 020 Version 12 05/22 - issued by ER

Report Date



Accreditation Number 2734
Corporate Site Number 2727

Accredited for compliance with
ISO/IEC 17025 - Testing.

A Kench

26/07/2022

Approved Signatory

34 Borec Road, Penrith NSW 2750
Telephone: (02) 4722 2744

Unit 4, 18-20 Whyalla Place, Prestons NSW 2170
Telephone: (02) 9607 6111

email: info@geotech.com.au www.geotech.com.au

FIELD DENSITY RESULTS

DARACON CONTRACTORS PTY LTD
184 ADDERLEY STREET WEST
AUBURN NSW 2144

Laboratory: Penrith
Job No: 8599/84

PROJECT: SITE FILL TESTING
RESIDENTIAL DEVELOPMENT WOORONG PARK MARSDEN PARK PRECINCT, NEWPARK PRECINCT 7 STAGE 7F

Page 2 of 2

TEST NUMBER								
DATE TESTED & SAMPLED	9	10	11	12				
	10/06/2022							
RESULTS								
Hiif Density Ratio	Standard	%	102	102	101.5	101.5		
Moisture Variation from OMC (-Drier/+Wetter)		%	0.0	0.0	0.0	0.0		
Specification	Density Ratio (Standard)	≥95%	Specification		Moisture Variance from OMC			±2%
TEST LOCATION								
Chainage (Carriageway L/R)	m	-	-	-	-			
Shown on Drawing No		8599/84-1						
Retested by Test		-	-	-	-			
Layer Thickness	mm	150	150	150	150			
Reduced Level	m	18.90	18.96	19.02	19.16			
FIELD & LABORATORY DATA								
Field Wet Density	t/m ³	2.14	2.12	2.13	2.12			
Field Moisture Content	%	15.5	14.5	16.0	15.5			
Material retained on 19mm Sieve (wet)	%	<5	<5	<5	<5			
Lab Compaction result from test number		9	10	11	12			
Lab Compaction Date Tested		27/06/2022	27/06/2022	27/06/2022	27/06/2022			
Peak Converted Wet Density	t/m ³	2.10	2.08	2.10	2.09			
Apparent Optimum Moisture Content	%	15.0	15.0	16.0	15.5			
Number of Compaction Points		3	3	3	3			
Test Procedures - See Note Number		12	12	12	12			
Material Description - see below		2	2	2	2			
Notes								
1: Assigned Values have been obtained from our Penrith laboratory – Accreditation No 2734				10: AS 1289 1.2.1 clause 6.4 (b), 2.1.1, 5.3.1, 5.5.1, 5.6.1				
2: Assigned Values have been obtained from our Prestons laboratory – Accreditation No 14234				11: AS 1289 1.2.1 clause 6.4 (b), 2.1.1, 5.3.1, 5.7.1				
3: Results have been calculated using infinite decimal places. Therefore, calculated values may vary from those shown								
4: AS 1289 1.2.1 clause 6.4 (b), 2.1.1, 5.1.1, 5.3.1, 5.4.1				12: AS 1289 1.2.1 clause 6.4 (b), 2.1.1, 5.7.1, 5.8.1				
5: AS 1289 1.2.1 clause 6.4 (b), 2.1.1, 5.2.1, 5.3.1, 5.4.1				13: RMS T111, T119, T120, T166				
6: AS 1289 1.2.1 clause 6.4				14: RMS T111, T120, T166, T173				
7: AS 1289 1.2.1 clause 6.4 (b), 2.1.1, 5.2.1, 5.4.1, 5.8.1				15: RMS T120, T119, T162				
8: AS 1289 1.2.1 clause 6.4 (b), 2.1.1, 5.5.1, 5.6.1, 5.8.1				16: RMS T120, T162, T173				
9: Full details of Test Procedure 5.8.1 available on request				17: RMS T120, T164, T173				
Material Description								
1. CL-Clays of low plasticity, gravelly clays, sandy clays, silty clays		11. DGS40		* Cement Stabilised				
2. CI-Clay of medium plasticity, gravelly clays, sandy clays, silty clays		12. FCR20		# Lime Stabilised				
3. CH-Clays of high plasticity		13. FCR40		\$ Gypsum Stabilised				
4. SC-Clayey sands, sand-clay mixtures		14. RC - Recycled Concrete						
5. SM-Silty sands, sand-silt mixtures		15. Recycled Roadbase						
6. GC-Clayey gravels, gravel-sand-clay mixtures		16. RSB - Recycled Sub-base						
7. SP-Sand, crushed dust, filling sand, washed sand		17. CSS - Crushed Sandstone						
8. DGB20		18. RSS - Ripped Sandstone						
9. DGB40		19. Cowels Brown						
10. DGS20								

Form No R 020 Version 12 05/22 - issued by ER

Report Date



Accreditation Number 2734
Corporate Site Number 2727

Accredited for compliance with
ISO/IEC 17025 - Testing.

A Kench


26/07/2022

Approved Signatory

34 Borec Road, Penrith NSW 2750
Telephone: (02) 4722 2744

Unit 4, 18-20 Whyalla Place, Prestons NSW 2170
Telephone: (02) 9607 6111

email: info@geotech.com.au www.geotech.com.au

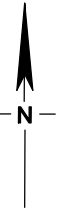

LEGEND

● Density Test



34 Borec Road
Penrith
NSW 2750
ABN 71 076 676 321

Ph: 02 4722 2744
Fx: 02 4722 2777
www.geotech.com.au
e-mail: info@geotech.com.au

NOTES

1. Site features are indicative and are not to scale.
2. This drawing has been produced using a base plan provided by others to which additional information e.g test pits, borehole locations or notes have been added. Some or all of the plan may not be relevant at the time of producing this drawing

Daracon Contractors Pty Ltd
Residential Development
Woorong Park
Newpark Precinct 7 Stage 7F

Location of Field Density Tests

Drawing No: 8599/84-1
Job No: 8599/84
Drawn By: MH
Date: 27 July 2022
Checked By: BN

File No: 8599-84
Layers: 0, Lay1

FIELD DENSITY RESULTS

DARACON CONTRACTORS PTY LTD
184 ADDERLEY STREET WEST
AUBURN NSW 2144

Laboratory: Penrith
Job No: 8599/84

PROJECT: SITE FILL TESTING
RESIDENTIAL DEVELOPMENT WOORONG PARK MARSDEN PARK PRECINCT, NEWPARK PRECINCT 7 STAGE 7F

Page 1 of 1

TEST NUMBER	13	14	15	16			
DATE TESTED & SAMPLED	09/11/2022						
RESULTS							
Hilf Density Ratio	Standard	%	98	98	98.5	98	
Moisture Variation from OMC (-Drier/+Wetter)		%	0.0	0.0	0.0	0.0	
Specification	Density Ratio (Standard)	≥95%	Specification Moisture Variance from OMC		±2%		
TEST LOCATION							
Chainage (Carriageway L/R)	m	-	-	-	-		
Shown on Drawing No		8599/84-2					
Retested by Test		-	-	-	-		
Layer Thickness	mm	150	150	150	150		
Reduced Level	m	22.51	22.72	22.48	21.95		
FIELD & LABORATORY DATA							
Field Wet Density	t/m ³	2.08	2.09	2.11	2.12		
Field Moisture Content	%	17.5	18.0	18.0	17.0		
Material retained on 19mm Sieve (wet)	%	<5	<5	<5	<5		
Lab Compaction result from test number		13	14	15	16		
Lab Compaction Date Tested		14/11/2022	14/11/2022	14/11/2022	14/11/2022		
Peak Converted Wet Density	t/m ³	2.12	2.13	2.14	2.16		
Apparent Optimum Moisture Content	%	17.5	18.0	18.0	17.0		
Number of Compaction Points		3	3	3	3		
Test Procedures - See Note Number		12	12	12	12		
Material Description - see below		2	2	2	2		
Notes							
1: Assigned Values have been obtained from our Penrith laboratory – Accreditation No 2734				10: AS 1289 1.2.1 clause 6.4 (b), 2.1.1, 5.3.1, 5.5.1, 5.6.1			
2: Assigned Values have been obtained from our Prestons laboratory – Accreditation No 14234				11: AS 1289 1.2.1 clause 6.4 (b), 2.1.1, 5.3.1, 5.7.1			
3: Results have been calculated using infinite decimal places. Therefore, calculated values may vary from those shown				12: AS 1289 1.2.1 clause 6.4 (b), 2.1.1, 5.7.1, 5.8.1			
4: AS 1289 1.2.1 clause 6.4 (b), 2.1.1, 5.1.1, 5.3.1, 5.4.1				13: RMS T111, T119, T120, T166			
5: AS 1289 1.2.1 clause 6.4 (b), 2.1.1, 5.2.1, 5.3.1, 5.4.1				14: RMS T111, T120, T166, T173			
6: AS 1289 1.2.1 clause 6.4				15: RMS T120, T119, T162			
7: AS 1289 1.2.1 clause 6.4 (b), 2.1.1, 5.2.1, 5.4.1, 5.8.1				16: RMS T120, T162, T173			
8: AS 1289 1.2.1 clause 6.4 (b), 2.1.1, 5.5.1, 5.6.1, 5.8.1				17: RMS T120, T164, T173			
9: Full details of Test Procedure 5.8.1 available on request							
Material Description							
1. CL-Clays of low plasticity, gravelly clays, sandy clays, silty clays		11. DGS40		* Cement Stabilised			
2. CI-Clay of medium plasticity, gravelly clays, sandy clays, silty clays		12. FCR20		# Lime Stabilised			
3. CH-Clays of high plasticity		13. FCR40		\$ Gypsum Stabilised			
4. SC-Clayey sands, sand-clay mixtures		14. RC - Recycled Concrete					
5. SM-Silty sands, sand-silt mixtures		15. Recycled Roadbase					
6. GC-Clayey gravels, gravel-sand-clay mixtures		16. RSB - Recycled Sub-base					
7. SP-Sand, crushed dust, filling sand, washed sand		17. CSS - Crushed Sandstone					
8. DGB20		18. RSS - Ripped Sandstone					
9. DGB40		19. Cowels Brown					
10. DGS20							

Form No R 020 Version 12 05/22 - issued by ER

Report Date
30/11/2022



Accreditation Number 2734
Corporate Site Number 2727

Accredited for compliance with
ISO/IEC 17025 - Testing.

A Kench

Approved Signatory

34 Borec Road, Penrith NSW 2750
Telephone: (02) 4722 2744

Unit 4, 18-20 Whyalla Place, Prestons NSW 2170
Telephone: (02) 9607 6111

email: info@geotech.com.au www.geotech.com.au



LEGEND

● Density Test



34 Borec Road
Penrith
NSW 2750
ABN 71 076 676 321

Ph: 02 4722 2744
Fx: 02 4722 2777
www.geotech.com.au
e-mail: info@geotech.com.au

NOTES

1. Site features are indicative and are not to scale.
2. This drawing has been produced using a base plan provided by others to which additional information e.g test pits, borehole locations or notes have been added. Some or all of the plan may not be relevant at the time of producing this drawing

Daracon Contractors Pty Ltd
Residential Development
Woorong Park
Newpark Precinct 7 Stage 7F

Location of Field Density Tests

Drawing No: 8599/84-2
Job No: 8599/84
Drawn By: MH
Date: 24 November 2022
Checked By: BN

File No: 8599-84
Layers: 0, Lay2

FIELD DENSITY RESULTS

DARACON CONTRACTORS PTY LTD
184 ADDERLEY STREET WEST
AUBURN NSW 2144

Laboratory: Penrith
Job No: 8599/84

PROJECT: SITE FILL TESTING
RESIDENTIAL DEVELOPMENT WOORONG PARK MARSDEN PARK PRECINCT, NEWPARK PRECINCT 7 STAGE 7F

Page 1 of 1

TEST NUMBER	17	18	19	20	21	22	23	24		
DATE TESTED & SAMPLED	27/11/2022				28/11/2022					
RESULTS										
Hilf Density Ratio	Standard	%	98.5	98	97.5	99	98.5	98	98.5	98.5
Moisture Variation from OMC (-Drier/+Wetter)	%	%	0.0	0.0	0.0	0.0	0.0	0.0	0.0	0.0
Specification	Density Ratio (Standard)	≥95%	Specification				Moisture Variance from OMC	±2%		
TEST LOCATION										
Chainage	(Carriageway L/R)	m	-	-	-	-	-	-	-	
Shown on Drawing No	8599/84-3									
Retested by Test	-	-	-	-	-	-	-	-	-	
Layer Thickness	mm	mm	150	150	150	150	150	150	150	150
Reduced Level	m	m	21.55	21.22	20.52	20.56	19.40	19.06	19.70	19.77
FIELD & LABORATORY DATA										
Field Wet Density	t/m ³	t/m ³	2.12	2.13	2.13	2.12	2.12	2.14	2.12	2.16
Field Moisture Content	%	%	17.5	17.5	15.5	17.0	16.0	17.0	16.0	16.0
Material retained on 19mm Sieve (wet)	%	%	<5	<5	<5	<5	<5	<5	<5	<5
Lab Compaction result from test number	17	18	19	20	21	22	23	24		
Lab Compaction Date Tested	03/12/2022	03/12/2022	03/12/2022	03/12/2022	03/12/2022	03/12/2022	03/12/2022	03/12/2022	03/12/2022	03/12/2022
Peak Converted Wet Density	t/m ³	t/m ³	2.15	2.17	2.18	2.14	2.15	2.17	2.15	2.19
Apparent Optimum Moisture Content	%	%	17.5	17.0	15.5	17.0	16.0	16.5	16.0	16.0
Number of Compaction Points	3	3	3	3	3	3	3	3	3	3
Test Procedures - See Note Number	12	12	12	12	12	12	12	12	12	12
Material Description - see below	2	2	2	2	2	2	2	2	2	2
Notes										
1: Assigned Values have been obtained from our Penrith laboratory – Accreditation No 2734			10: AS 1289 1.2.1 clause 6.4 (b), 2.1.1, 5.3.1, 5.5.1, 5.6.1							
2: Assigned Values have been obtained from our Prestons laboratory – Accreditation No 14234			11: AS 1289 1.2.1 clause 6.4 (b), 2.1.1, 5.3.1, 5.7.1							
3: Results have been calculated using infinite decimal places. Therefore, calculated values may vary from those shown			12: AS 1289 1.2.1 clause 6.4 (b), 2.1.1, 5.7.1, 5.8.1							
4: AS 1289 1.2.1 clause 6.4 (b), 2.1.1, 5.1.1, 5.3.1, 5.4.1			13: RMS T111, T119, T120, T166							
5: AS 1289 1.2.1 clause 6.4 (b), 2.1.1, 5.2.1, 5.3.1, 5.4.1			14: RMS T111, T120, T166, T173							
6: AS 1289 1.2.1 clause 6.4			15: RMS T120, T119, T162							
7: AS 1289 1.2.1 clause 6.4 (b), 2.1.1, 5.2.1, 5.4.1, 5.8.1			16: RMS T120, T162, T173							
8: AS 1289 1.2.1 clause 6.4 (b), 2.1.1., 5.5.1, 5.6.1, 5.8.1			17: RMS T120, T164, T173							
9: Full details of Test Procedure 5.8.1 available on request										
Material Description										
1. CL-Clays of low plasticity, gravelly clays, sandy clays, silty clays			11. DGS40			* Cement Stabilised				
2. CI-Clay of medium plasticity, gravelly clays, sandy clays, silty clays			12. FCR20			# Lime Stabilised				
3. CH-Clays of high plasticity			13. FCR40			\$ Gypsum Stabilised				
4. SC-Clayey sands, sand-clay mixtures			14. RC - Recycled Concrete							
5. SM-Silty sands, sand-silt mixtures			15. Recycled Roadbase							
6. GC-Clayey gravels, gravel-sand-clay mixtures			16. RSB - Recycled Sub-base							
7. SP-Sand, crushed dust, filling sand, washed sand			17. CSS - Crushed Sandstone							
8. DGB20			18. RSS - Ripped Sandstone							
9. DGB40			19. Cowels Brown							
10. DGS20										

Form No R 020 Version 12/05/22 - issued by ER



Accreditation Number 2734
Corporate Site Number 2727

Accredited for compliance with
ISO/IEC 17025 - Testing.

A Kench


Report Date
08/12/2022

Approved Signatory

34 Borec Road, Penrith NSW 2750
Telephone: (02) 4722 2744

Unit 4, 18-20 Whyalla Place, Prestons NSW 2170
Telephone: (02) 9607 6111

email: info@geotech.com.au www.geotech.com.au

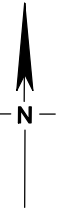

LEGEND

● Density Test



34 Borec Road
Penrith
NSW 2750
ABN 71 076 676 321

Ph: 02 4722 2744
Fx: 02 4722 2777
www.geotech.com.au
e-mail: info@geotech.com.au

NOTES

1. Site features are indicative and are not to scale.
2. This drawing has been produced using a base plan provided by others to which additional information e.g test pits, borehole locations or notes have been added. Some or all of the plan may not be relevant at the time of producing this drawing

Daracon Contractors Pty Ltd
Residential Development
Woorong Park
Newpark Precinct 7 Stage 7F

Location of Field Density Tests

Drawing No: 8599/84-3
Job No: 8599/84
Drawn By: MH
Date: 8 December 2022
Checked By: BN

File No: 8599-84
Layers: 0, Lay3

FIELD DENSITY RESULTS

DARACON CONTRACTORS PTY LTD
184 ADDERLEY STREET WEST
AUBURN NSW 2144

Laboratory: Penrith
Job No: 8599/84

PROJECT: SITE FILL TESTING
RESIDENTIAL DEVELOPMENT WOORONG PARK MARSDEN PARK PRECINCT, NEWPARK PRECINCT 7 STAGE 7F

Page 1 of 5

TEST NUMBER	25	26	27	28	29	30	31	32		
DATE TESTED & SAMPLED	01/12/2022			14/03/2023			15/03/2023			
RESULTS										
Hilf Density Ratio	Standard	%	105.5	102	101.5	101.5	105	99.5	104.5	97.5
Moisture Variation from OMC (-Drier/+Wetter)	%		-2.0	-1.0	-0.5	-0.5	-2.0	-0.5	-1.0	0.0
Specification	Density Ratio (Standard)	≥95%	Specification Moisture Variance from OMC					±2%		
TEST LOCATION										
Chainage (Carriageway L/R)	m									
Shown on Drawing No	8599/84-4									
Retested by Test										
Layer Thickness	mm									
Reduced Level	m									
FIELD & LABORATORY DATA										
Field Wet Density	t/m ³									
Field Moisture Content	%									
Material retained on 19mm Sieve (wet)	%									
Lab Compaction result from test number										
Lab Compaction Date Tested										
Peak Converted Wet Density	t/m ³									
Apparent Optimum Moisture Content	%									
Number of Compaction Points										
Test Procedures - See Note Number										
Material Description - see below										
Notes	<p>1: Assigned Values have been obtained from our Penrith laboratory – Accreditation No 2734 2: Assigned Values have been obtained from our Prestons laboratory – Accreditation No 14234 3: Results have been calculated using infinite decimal places. Therefore, calculated values may vary from those shown 4: AS 1289 1.2.1 clause 6.4 (b), 2.1.1, 5.1.1, 5.3.1, 5.4.1 5: AS 1289 1.2.1 clause 6.4 (b), 2.1.1, 5.2.1, 5.3.1, 5.4.1 6: AS 1289 1.2.1 clause 6.4 (b) 7: AS 1289 1.2.1 clause 6.4 (b), 2.1.1, 5.2.1, 5.4.1, 5.8.1 8: AS 1289 1.2.1 clause 6.4 (b), 2.1.1, 5.5.1, 5.6.1, 5.8.1 9: Full details of Test Procedure 5.8.1 available on request 10: AS 1289 1.2.1 clause 6.4 (b), 2.1.1, 5.3.1, 5.5.1, 5.6.1 11: AS 1289 1.2.1 clause 6.4 (b), 2.1.1, 5.3.1, 5.7.1 12: AS 1289 1.2.1 clause 6.4 (b), 2.1.1, 5.7.1, 5.8.1 13: RMS T111, T119, T120, T166 14: RMS T111, T120, T166, T173 15: RMS T120, T119, T162 16: RMS T120, T162, T173 17: RMS T120, T164, T173</p>									
Material Description	<p>1. CL-Clays of low plasticity, gravelly clays, sandy clays, silty clays 2. CI-Clay of medium plasticity, gravelly clays, sandy clays, silty clays 3. CH-Clays of high plasticity 4. SC-Clayey sands, sand-clay mixtures 5. SM-Silty sands, sand-silt mixtures 6. GC-Clayey gravels, gravel-sand-clay mixtures 7. SP-Sand, crushed dust, filling sand, washed sand 8. DGB20 9. DGB40 10. DGS20 11. DGS40 12. FCR20 13. FCR40 14. RC - Recycled Concrete 15. Recycled Roadbase 16. RSB - Recycled Sub-base 17. CSS - Crushed Sandstone 18. RSS - Ripped Sandstone 19. Cowels Brown * Cement Stabilised # Lime Stabilised \$ Gypsum Stabilised</p>									

Form No R 020 Version 12/05/22 - issued by ER

Report Date
05/05/2023



Accreditation Number 2734
Corporate Site Number 2727

Accredited for compliance with
ISO/IEC 17025 - Testing.

A Kench

Approved Signatory

34 Borec Road, Penrith NSW 2750
Telephone: (02) 4722 2744

Unit 4, 18-20 Whyalla Place, Prestons NSW 2170
Telephone: (02) 9607 6111

email: info@geotech.com.au www.geotech.com.au

FIELD DENSITY RESULTS

DARACON CONTRACTORS PTY LTD
184 ADDERLEY STREET WEST
AUBURN NSW 2144

Laboratory: Penrith
Job No: 8599/84

PROJECT: SITE FILL TESTING
RESIDENTIAL DEVELOPMENT WOORONG PARK MARSDEN PARK PRECINCT, NEWPARK PRECINCT 7 STAGE 7F

Page 2 of 5

TEST NUMBER	33	34	35	36	37	38	39	40		
DATE TESTED & SAMPLED	15/03/2023		16/03/2023			17/03/2023				
RESULTS										
Hilf Density Ratio	Standard	%	104.5	101	103.5	101.5	106.5	104.5	101	105
Moisture Variation from OMC (-Drier/+Wetter)		%	-0.5	-2.0	-1.5	-1.0	0.0	-2.0	-1.0	-1.5
Specification	Density Ratio (Standard)	≥95%	Specification				Moisture Variance from OMC	±2%		
TEST LOCATION										
Chainage	(Carriageway L/R)	m	-	-	-	-	-	-	-	-
Shown on Drawing No	8599/84-4									
Retested by Test	-									
Layer Thickness		mm	150	150	150	150	150	150	150	150
Reduced Level		m	18.86	19.18	19.77	20.26	20.50	19.87	19.62	18.81
FIELD & LABORATORY DATA										
Field Wet Density		t/m ³	2.12	2.05	2.13	2.13	2.12	2.12	2.12	2.11
Field Moisture Content		%	14.0	16.0	17.5	15.0	16.0	12.5	15.5	16.5
Material retained on	19mm Sieve (wet)	%	<5	<5	<5	<5	<5	<5	<5	<5
Lab Compaction result from test number			33	34	35	36	37	38	39	40
Lab Compaction Date Tested			21/03/2023	21/03/2023	21/03/2023	21/03/2023	21/03/2023	21/03/2023	21/03/2023	21/03/2023
Peak Converted Wet Density		t/m ³	2.03	2.03	2.06	2.10	1.99	2.03	2.10	2.01
Apparent Optimum Moisture Content		%	14.5	18.0	19.0	16.0	16.0	14.5	16.5	18.0
Number of Compaction Points			3	3	3	3	3	3	3	3
Test Procedures - See Note Number			12	12	12	12	12	12	12	12
Material Description - see below			2	2	2	2	2	2	2	2
Notes										
1: Assigned Values have been obtained from our Penrith laboratory – Accreditation No 2734			10: AS 1289 1.2.1 clause 6.4 (b), 2.1.1, 5.3.1, 5.5.1, 5.6.1							
2: Assigned Values have been obtained from our Prestons laboratory – Accreditation No 14234			11: AS 1289 1.2.1 clause 6.4 (b), 2.1.1, 5.3.1, 5.7.1							
3: Results have been calculated using infinite decimal places. Therefore, calculated values may vary from those shown			12: AS 1289 1.2.1 clause 6.4 (b), 2.1.1, 5.7.1, 5.8.1							
4: AS 1289 1.2.1 clause 6.4 (b), 2.1.1, 5.1.1, 5.3.1, 5.4.1			13: RMS T111, T119, T120, T166							
5: AS 1289 1.2.1 clause 6.4 (b), 2.1.1, 5.2.1, 5.3.1, 5.4.1			14: RMS T111, T120, T166, T173							
6: AS 1289 1.2.1 clause 6.4 (b)			15: RMS T120, T119, T162							
7: AS 1289 1.2.1 clause 6.4 (b), 2.1.1, 5.2.1, 5.4.1, 5.8.1			16: RMS T120, T162, T173							
8: AS 1289 1.2.1 clause 6.4 (b), 2.1.1, 5.5.1, 5.6.1, 5.8.1			17: RMS T120, T164, T173							
9: Full details of Test Procedure 5.8.1 available on request										
Material Description										
1. CL-Clays of low plasticity, gravelly clays, sandy clays, silty clays			11. DGS40			* Cement Stabilised				
2. CI-Clay of medium plasticity, gravelly clays, sandy clays, silty clays			12. FCR20			# Lime Stabilised				
3. CH-Clays of high plasticity			13. FCR40			\$ Gypsum Stabilised				
4. SC-Clayey sands, sand-clay mixtures			14. RC - Recycled Concrete							
5. SM-Silty sands, sand-silt mixtures			15. Recycled Roadbase							
6. GC-Clayey gravels, gravel-sand-clay mixtures			16. RSB - Recycled Sub-base							
7. SP-Sand, crushed dust, filling sand, washed sand			17. CSS - Crushed Sandstone							
8. DGB20			18. RSS - Ripped Sandstone							
9. DGB40			19. Cowels Brown							
10. DGS20										

Form No R 020 Version 12/05/22 - issued by ER

Report Date
05/05/2023



Accreditation Number 2734
Corporate Site Number 2727

Accredited for compliance with
ISO/IEC 17025 - Testing.

A Kench

Approved Signatory

34 Borec Road, Penrith NSW 2750
Telephone: (02) 4722 2744

Unit 4, 18-20 Whyalla Place, Prestons NSW 2170
Telephone: (02) 9607 6111

email: info@geotech.com.au www.geotech.com.au

FIELD DENSITY RESULTS

DARACON CONTRACTORS PTY LTD
184 ADDERLEY STREET WEST
AUBURN NSW 2144

Laboratory: Penrith
Job No: 8599/84

PROJECT: SITE FILL TESTING
RESIDENTIAL DEVELOPMENT WOORONG PARK MARSDEN PARK PRECINCT, NEWPARK PRECINCT 7 STAGE 7F

Page 3 of 5

TEST NUMBER	41	42	43	44	45	46	47	48		
DATE TESTED & SAMPLED	17/03/2023	21/03/2023			22/03/2023			24/03/2023		
RESULTS										
Hilf Density Ratio	Standard	%	101.5	98	99.5	97.5	98	98	99	98
Moisture Variation from OMC (-Drier/+Wetter)	%	0.0	0.0	0.0	0.0	0.5	0.0	0.5	-0.5	
Specification	Density Ratio (Standard)	≥95%	Specification				Moisture Variance from OMC	±2%		
TEST LOCATION										
Chainage	(Carriageway L/R)	m	-	-	-	-	-	-	-	
Shown on Drawing No	8599/84-4				8599/84-5					
Retested by Test	-	-	-	-	-	-	-	-		
Layer Thickness	mm	150	150	150	150	150	150	150		
Reduced Level	m	18.07	17.57	17.06	16.94	18.00	18.32	18.63	18.97	
FIELD & LABORATORY DATA										
Field Wet Density	t/m ³	2.10	2.11	2.12	2.10	2.10	2.13	2.12	2.08	
Field Moisture Content	%	16.5	16.0	15.5	14.5	17.5	15.5	15.5	15.5	
Material retained on 19mm Sieve (wet)	%	<5	<5	<5	<5	<5	<5	<5	<5	
Lab Compaction result from test number		41	42	43	44	45	46	47	48	
Lab Compaction Date Tested		21/03/2023	31/03/2023	31/03/2023	31/03/2023	31/03/2023	31/03/2023	31/03/2023	28/03/2023	
Peak Converted Wet Density	t/m ³	2.07	2.15	2.13	2.15	2.14	2.17	2.14	2.12	
Apparent Optimum Moisture Content	%	16.5	16.0	15.0	14.5	17.0	15.5	15.0	16.0	
Number of Compaction Points		3	3	3	3	3	3	3	3	
Test Procedures - See Note Number		12	12	12	12	12	12	12	12	
Material Description - see below		2	2	2	2	2	2	2	2	
Notes										
1: Assigned Values have been obtained from our Penrith laboratory – Accreditation No 2734					10: AS 1289 1.2.1 clause 6.4 (b), 2.1.1, 5.3.1, 5.5.1, 5.6.1					
2: Assigned Values have been obtained from our Prestons laboratory – Accreditation No 14234					11: AS 1289 1.2.1 clause 6.4 (b), 2.1.1, 5.3.1, 5.7.1					
3: Results have been calculated using infinite decimal places. Therefore, calculated values may vary from those shown					12: AS 1289 1.2.1 clause 6.4 (b), 2.1.1, 5.7.1, 5.8.1					
4: AS 1289 1.2.1 clause 6.4 (b), 2.1.1, 5.1.1, 5.3.1, 5.4.1					13: RMS T111, T119, T120, T166					
5: AS 1289 1.2.1 clause 6.4 (b), 2.1.1, 5.2.1, 5.3.1, 5.4.1					14: RMS T111, T120, T166, T173					
6: AS 1289 1.2.1 clause 6.4 (b)					15: RMS T120, T119, T162					
7: AS 1289 1.2.1 clause 6.4 (b), 2.1.1, 5.2.1, 5.4.1, 5.8.1					16: RMS T120, T162, T173					
8: AS 1289 1.2.1 clause 6.4 (b), 2.1.1, 5.5.1, 5.6.1, 5.8.1					17: RMS T120, T164, T173					
9: Full details of Test Procedure 5.8.1 available on request										
Material Description										
1. CL-Clays of low plasticity, gravelly clays, sandy clays, silty clays			11. DGS40			* Cement Stabilised				
2. CI-Clay of medium plasticity, gravelly clays, sandy clays, silty clays			12. FCR20			# Lime Stabilised				
3. CH-Clays of high plasticity			13. FCR40			\$ Gypsum Stabilised				
4. SC-Clayey sands, sand-clay mixtures			14. RC - Recycled Concrete							
5. SM-Silty sands, sand-silt mixtures			15. Recycled Roadbase							
6. GC-Clayey gravels, gravel-sand-clay mixtures			16. RSB - Recycled Sub-base							
7. SP-Sand, crushed dust, filling sand, washed sand			17. CSS - Crushed Sandstone							
8. DGB20			18. RSS - Ripped Sandstone							
9. DGB40			19. Cowels Brown							
10. DGS20										

Form No R 020 Version 12/05/22 - issued by ER

Report Date
05/05/2023



Accreditation Number 2734
Corporate Site Number 2727

Accredited for compliance with
ISO/IEC 17025 - Testing.

A Kench

Approved Signatory

34 Borec Road, Penrith NSW 2750
Telephone: (02) 4722 2744

Unit 4, 18-20 Whyalla Place, Prestons NSW 2170
Telephone: (02) 9607 6111

email: info@geotech.com.au www.geotech.com.au

FIELD DENSITY RESULTS

DARACON CONTRACTORS PTY LTD
184 ADDERLEY STREET WEST
AUBURN NSW 2144

Laboratory: Penrith
Job No: 8599/84

PROJECT: SITE FILL TESTING
RESIDENTIAL DEVELOPMENT WOORONG PARK MARSDEN PARK PRECINCT, NEWPARK PRECINCT 7 STAGE 7F

Page 4 of 5

TEST NUMBER	49	50	51	52	53	54	55	56		
DATE TESTED & SAMPLED	24/03/2023		07/04/2023			11/04/2023				
RESULTS										
Hilf Density Ratio	Standard	%	96	104	97.5	97.5	98	97.5	97	97.5
Moisture Variation from OMC (-Drier/+Wetter)		%	-0.5	-0.5	0.0	0.5	0.0	0.0	0.0	0.0
Specification	Density Ratio (Standard)		≥95%				Specification Moisture Variance from OMC		±2%	
TEST LOCATION										
Chainage	(Carriageway L/R)	m	-	-	-	-	-	-	-	-
Shown on Drawing No	8599/84-5									
Retested by Test	-									
Layer Thickness		mm	150	150	150	150	150	150	150	150
Reduced Level		m	18.04	18.49	18.74	19.01	19.07	18.72	19.27	19.72
FIELD & LABORATORY DATA										
Field Wet Density		t/m ³	2.05	2.08	2.12	2.13	2.11	2.13	2.12	2.14
Field Moisture Content		%	15.0	16.5	18.0	17.0	18.5	18.0	19.5	15.0
Material retained on	19mm Sieve (wet)	%	<5	<5	<5	<5	<5	<5	<5	<5
Lab Compaction result from test number			49	50	51	52	53	54	55	56
Lab Compaction Date Tested			28/03/2023	28/03/2023	20/04/2023	20/04/2023	20/04/2023	20/04/2023	20/04/2023	20/04/2023
Peak Converted Wet Density		t/m ³	2.13	2.00	2.17	2.18	2.15	2.18	2.18	2.19
Apparent Optimum Moisture Content		%	15.5	16.5	18.0	16.5	18.5	18.0	19.5	15.0
Number of Compaction Points			3	3	3	3	3	3	3	3
Test Procedures - See Note Number			12	12	12	12	12	12	12	12
Material Description - see below			2	2	2	2	2	2	2-3	2
Notes										
1: Assigned Values have been obtained from our Penrith laboratory – Accreditation No 2734			10: AS 1289 1.2.1 clause 6.4 (b), 2.1.1, 5.3.1, 5.5.1, 5.6.1							
2: Assigned Values have been obtained from our Prestons laboratory – Accreditation No 14234			11: AS 1289 1.2.1 clause 6.4 (b), 2.1.1, 5.3.1, 5.7.1							
3: Results have been calculated using infinite decimal places. Therefore, calculated values may vary from those shown			12: AS 1289 1.2.1 clause 6.4 (b), 2.1.1, 5.7.1, 5.8.1							
4: AS 1289 1.2.1 clause 6.4 (b), 2.1.1, 5.1.1, 5.3.1, 5.4.1			13: RMS T111, T119, T120, T166							
5: AS 1289 1.2.1 clause 6.4 (b), 2.1.1, 5.2.1, 5.3.1, 5.4.1			14: RMS T111, T120, T166, T173							
6: AS 1289 1.2.1 clause 6.4 (b)			15: RMS T120, T119, T162							
7: AS 1289 1.2.1 clause 6.4 (b), 2.1.1, 5.2.1, 5.4.1, 5.8.1			16: RMS T120, T162, T173							
8: AS 1289 1.2.1 clause 6.4 (b), 2.1.1, 5.5.1, 5.6.1, 5.8.1			17: RMS T120, T164, T173							
9: Full details of Test Procedure 5.8.1 available on request										
Material Description										
1. CL-Clays of low plasticity, gravelly clays, sandy clays, silty clays			11. DGS40			* Cement Stabilised				
2. CI-Clay of medium plasticity, gravelly clays, sandy clays, silty clays			12. FCR20			# Lime Stabilised				
3. CH-Clays of high plasticity			13. FCR40			\$ Gypsum Stabilised				
4. SC-Clayey sands, sand-clay mixtures			14. RC - Recycled Concrete							
5. SM-Silty sands, sand-silt mixtures			15. Recycled Roadbase							
6. GC-Clayey gravels, gravel-sand-clay mixtures			16. RSB - Recycled Sub-base							
7. SP-Sand, crushed dust, filling sand, washed sand			17. CSS - Crushed Sandstone							
8. DGB20			18. RSS - Ripped Sandstone							
9. DGB40			19. Cowels Brown							
10. DGS20										

Form No R 020 Version 12/05/22 - issued by ER

Report Date
05/05/2023



Accreditation Number 2734
Corporate Site Number 2727

Accredited for compliance with
ISO/IEC 17025 - Testing.

A Kench

Approved Signatory

34 Borec Road, Penrith NSW 2750
Telephone: (02) 4722 2744

Unit 4, 18-20 Whyalla Place, Prestons NSW 2170
Telephone: (02) 9607 6111

email: info@geotech.com.au www.geotech.com.au

FIELD DENSITY RESULTS

DARACON CONTRACTORS PTY LTD
184 ADDERLEY STREET WEST
AUBURN NSW 2144

Laboratory: Penrith
Job No: 8599/84

PROJECT: SITE FILL TESTING
RESIDENTIAL DEVELOPMENT WOORONG PARK MARSDEN PARK PRECINCT, NEWPARK PRECINCT 7 STAGE 7F

Page 5 of 5

TEST NUMBER	57	58	59				
DATE TESTED & SAMPLED	14/04/2023						
RESULTS							
Hilf Density Ratio	Standard	%	98	97	97		
Moisture Variation from OMC (-Drier/+Wetter)		%	0.5	0.0	0.5		
Specification	Density Ratio (Standard)	≥95%	Specification Moisture Variance from OMC			±2%	
TEST LOCATION							
Chainage (Carriageway L/R)	m	-	-	-			
Shown on Drawing No		8599/84-5					
Retested by Test		-	-	-			
Layer Thickness	mm	150	150	150			
Reduced Level	m	18.64	19.54	19.42			
FIELD & LABORATORY DATA							
Field Wet Density	t/m ³	2.11	2.10	2.09			
Field Moisture Content	%	20.5	18.0	20.5			
Material retained on 19mm Sieve (wet)	%	<5	<5	<5			
Lab Compaction result from test number		57	58	59			
Lab Compaction Date Tested		20/04/2023	20/04/2023	20/04/2023			
Peak Converted Wet Density	t/m ³	2.15	2.16	2.15			
Apparent Optimum Moisture Content	%	20.0	18.0	20.0			
Number of Compaction Points		3	3	3			
Test Procedures - See Note Number		12	12	12			
Material Description - see below		2-3	2	2-3			
Notes							
1: Assigned Values have been obtained from our Penrith laboratory – Accreditation No 2734				10: AS 1289 1.2.1 clause 6.4 (b), 2.1.1, 5.3.1, 5.5.1, 5.6.1			
2: Assigned Values have been obtained from our Prestons laboratory – Accreditation No 14234				11: AS 1289 1.2.1 clause 6.4 (b), 2.1.1, 5.3.1, 5.7.1			
3: Results have been calculated using infinite decimal places. Therefore, calculated values may vary from those shown				12: AS 1289 1.2.1 clause 6.4 (b), 2.1.1, 5.7.1, 5.8.1			
4: AS 1289 1.2.1 clause 6.4 (b), 2.1.1, 5.1.1, 5.3.1, 5.4.1				13: RMS T111, T119, T120, T166			
5: AS 1289 1.2.1 clause 6.4 (b), 2.1.1, 5.2.1, 5.3.1, 5.4.1				14: RMS T111, T120, T166, T173			
6: AS 1289 1.2.1 clause 6.4 (b)				15: RMS T120, T119, T162			
7: AS 1289 1.2.1 clause 6.4 (b), 2.1.1, 5.2.1, 5.4.1, 5.8.1				16: RMS T120, T162, T173			
8: AS 1289 1.2.1 clause 6.4 (b), 2.1.1, 5.5.1, 5.6.1, 5.8.1				17: RMS T120, T164, T173			
9: Full details of Test Procedure 5.8.1 available on request							
Material Description							
1. CL-Clays of low plasticity, gravelly clays, sandy clays, silty clays		11. DGS40		* Cement Stabilised			
2. CI-Clay of medium plasticity, gravelly clays, sandy clays, silty clays		12. FCR20		# Lime Stabilised			
3. CH-Clays of high plasticity		13. FCR40		\$ Gypsum Stabilised			
4. SC-Clayey sands, sand-clay mixtures		14. RC - Recycled Concrete					
5. SM-Silty sands, sand-silt mixtures		15. Recycled Roadbase					
6. GC-Clayey gravels, gravel-sand-clay mixtures		16. RSB - Recycled Sub-base					
7. SP-Sand, crushed dust, filling sand, washed sand		17. CSS - Crushed Sandstone					
8. DGB20		18. RSS - Ripped Sandstone					
9. DGB40		19. Cowels Brown					
10. DGS20							

Form No R 020 Version 12/05/22 - issued by ER



Accreditation Number 2734
Corporate Site Number 2727

Accredited for compliance with
ISO/IEC 17025 - Testing.

A Kench


Report Date
05/05/2023

Approved Signatory

34 Borec Road, Penrith NSW 2750
Telephone: (02) 4722 2744

Unit 4, 18-20 Whyalla Place, Prestons NSW 2170
Telephone: (02) 9607 6111

email: info@geotech.com.au www.geotech.com.au

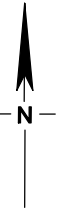

LEGEND

● Density Test



34 Borec Road
Penrith
NSW 2750
ABN 71 076 676 321

Ph: 02 4722 2744
Fx: 02 4722 2777
www.geotech.com.au
e-mail: info@geotech.com.au

NOTES


1. Site features are indicative and are not to scale.
2. This drawing has been produced using a base plan provided by others to which additional information e.g test pits, borehole locations or notes have been added. Some or all of the plan may not be relevant at the time of producing this drawing

Daracon Contractors Pty Ltd
Residential Development
Woorong Park
Newpark Precinct 7 Stage 7F

Location of Field Density Tests

Drawing No: 8599/84-4
Job No: 8599/84
Drawn By: MH
Date: 22 March 2023
Checked By: BN

File No: 8599-84
Layers: 0, Lay3

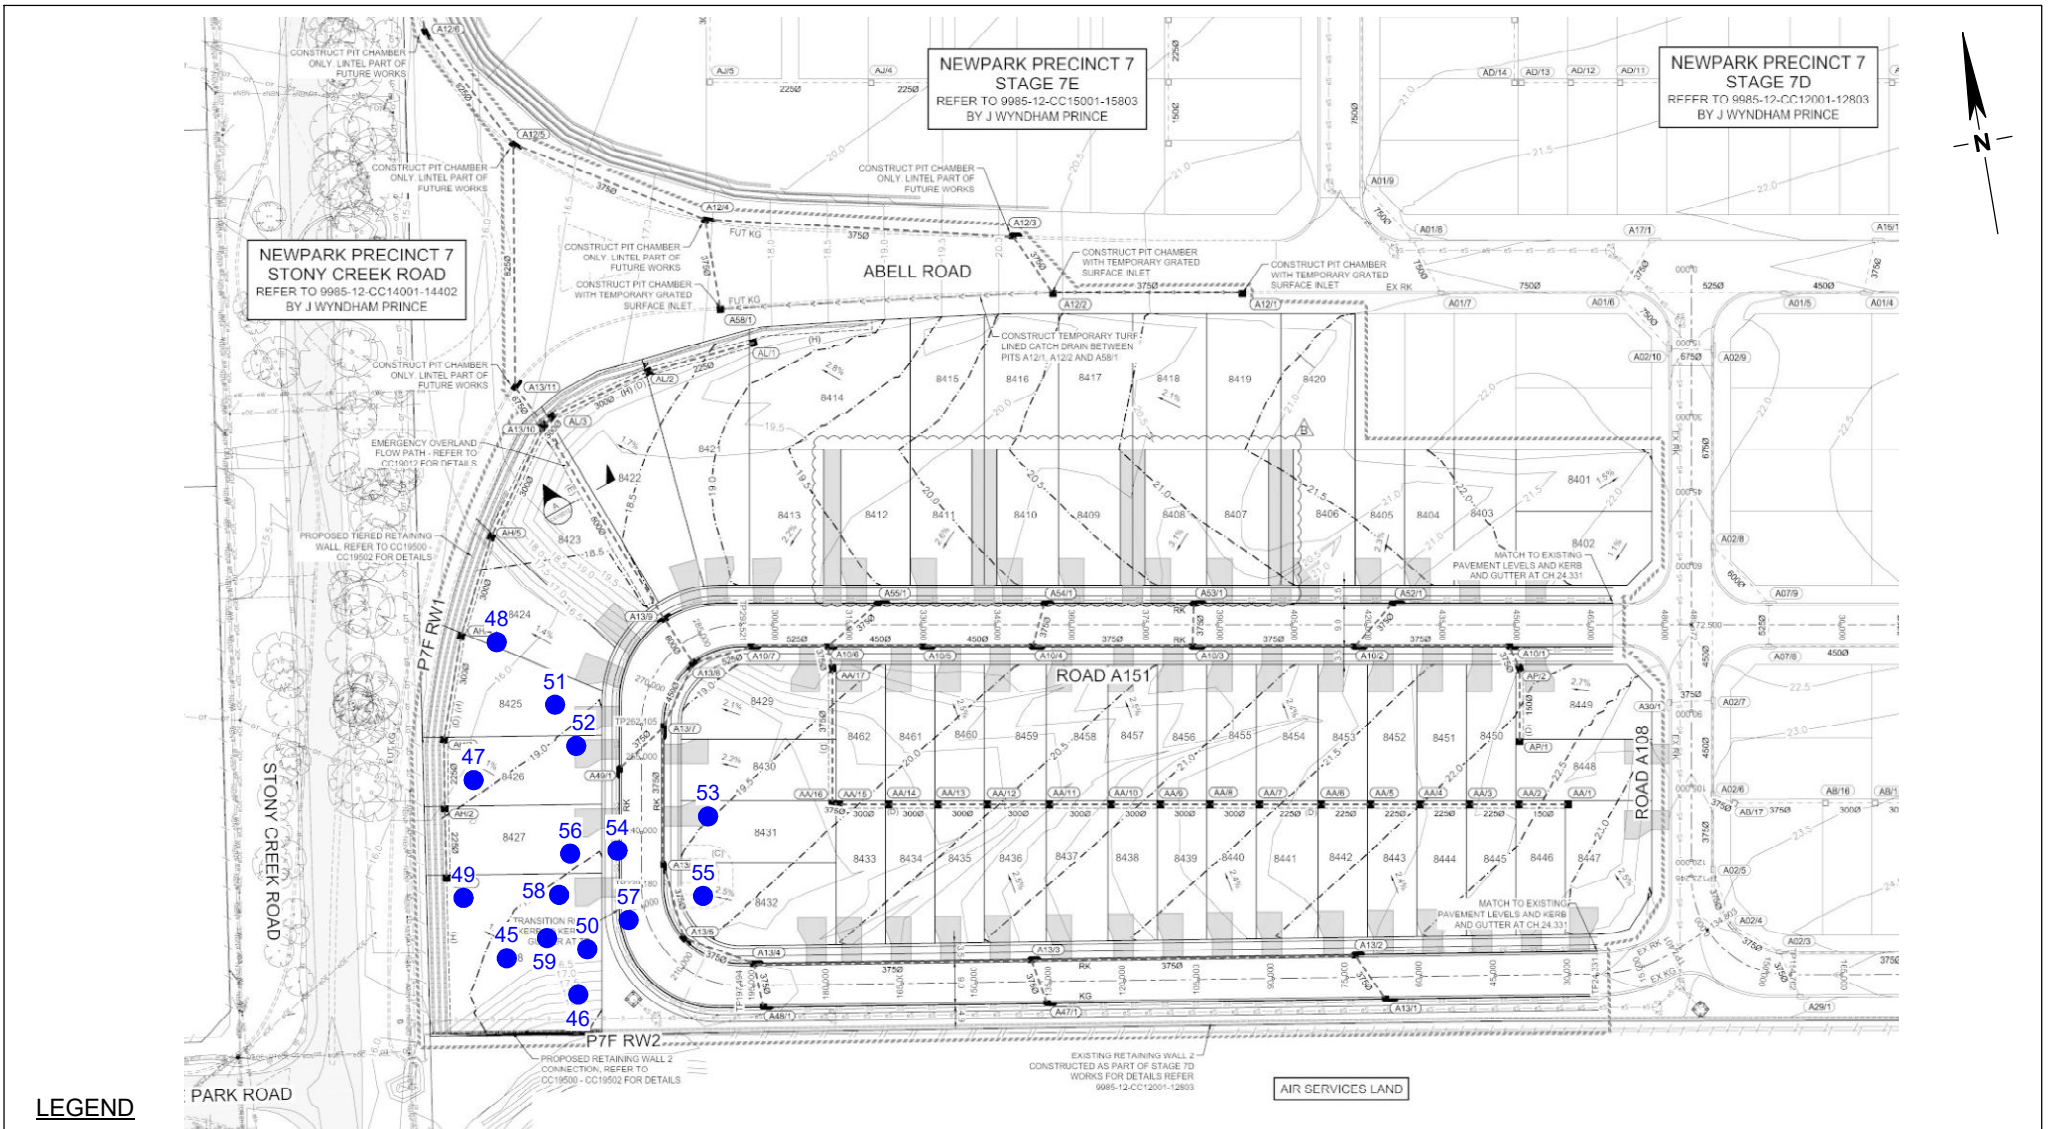

LEGEND

- Density Test



34 Borec Road
Penrith
NSW 2750
ABN 71 076 676 321

Ph: 02 4722 2744
Fx: 02 4722 2777
www.geotech.com.au
e-mail: info@geotech.com.au

NOTES

1. Site features are indicative and are not to scale.
2. This drawing has been produced using a base plan provided by others to which additional information e.g test pits, borehole locations or notes have been added. Some or all of the plan may not be relevant at the time of producing this drawing

Daracon Contractors Pty Ltd
Residential Development
Woorong Park
Newpark Precinct 7 Stage 7F

Location of Field Density Tests

Drawing No: 8599/84-5
Job No: 8599/84
Drawn By: MH
Date: 27 April 2023
Checked By: BN

File No: 8599-84
Layers: 0, Lay5

FIELD DENSITY RESULTS

DARACON CONTRACTORS PTY LTD
186 ADDERLEY STREET WEST
AUBURN NSW 2144

Laboratory: Penrith
Job No: 8599/115

PROJECT: RETAINING WALL BACKFILL TESTING
NEWPARK PRECINCT 7F, MARSDEN PARK

Page 1 of 2

TEST NUMBER	1	2	3	4	5	6	7	8		
DATE TESTED & SAMPLED	29/08/2023			31/08/2023			04/09/2023			
RESULTS										
Hilf Density Ratio	Standard	%	97.5	97	98	96	97	97.5	100	99
Moisture Variation from OMC (-Drier/+Wetter)	%	%	0.0	0.5	0.0	0.0	0.0	0.0	0.5	0.0
Specification	Density Ratio (Standard)	≥95%	Specification				Moisture Variance from OMC	±2%		
TEST LOCATION										
Chainage	(Carriageway L/R)	m	-	-	-	-	-	-		
Shown on Drawing No	8599/115-1									
Retested by Test	-	-	-	-	-	-	-	-		
Layer Thickness	mm	mm	150	150	150	150	150	150	150	150
Reduced Level	m	m	18.09	18.45	18.01	19.04	17.24	19.11	18.17	17.30
FIELD & LABORATORY DATA										
Field Wet Density	t/m ³	t/m ³	2.13	2.12	2.13	2.10	2.13	2.13	2.14	2.12
Field Moisture Content	%	%	15.0	15.0	14.5	14.0	15.0	13.5	15.0	15.5
Material retained on	19mm Sieve (wet)	%	<5	<5	<5	<5	<5	<5	<5	<5
Lab Compaction result from test number	1	2	3	4	5	6	7	8		
Lab Compaction Date Tested	11/09/2023	11/09/2023	11/09/2023	11/09/2023	11/09/2023	11/09/2023	11/09/2023	11/09/2023		
Peak Converted Wet Density	t/m ³	t/m ³	2.18	2.19	2.17	2.19	2.20	2.19	2.14	2.14
Apparent Optimum Moisture Content	%	%	15.0	14.5	14.0	13.5	14.5	13.5	14.5	15.0
Number of Compaction Points	3	3	3	3	3	3	3	3	3	3
Test Procedures - See Note Number	12	12	12	12	12	12	12	12	12	12
Material Description - see below	2	2	2	2	2	2	2	2	2	2
Notes										
1: Assigned Values have been obtained from our Penrith laboratory – Accreditation No 2734			10: AS 1289 1.2.1 clause 6.4 (b), 2.1.1, 5.3.1, 5.5.1, 5.6.1							
2: Assigned Values have been obtained from our Prestons laboratory – Accreditation No 14234			11: AS 1289 1.2.1 clause 6.4 (b), 2.1.1, 5.3.1, 5.7.1							
3: Results have been calculated using infinite decimal places. Therefore, calculated values may vary from those shown			12: AS 1289 1.2.1 clause 6.4 (b), 2.1.1, 5.7.1, 5.8.1							
4: AS 1289 1.2.1 clause 6.4 (b), 2.1.1, 5.1.1, 5.3.1, 5.4.1			13: RMS T111, T119, T120, T166							
5: AS 1289 1.2.1 clause 6.4 (b), 2.1.1, 5.2.1, 5.3.1, 5.4.1			14: RMS T111, T120, T166, T173							
6: AS 1289 1.2.1 clause 6.4			15: RMS T120, T119, T162							
7: AS 1289 1.2.1 clause 6.4 (b), 2.1.1, 5.2.1, 5.4.1, 5.8.1			16: RMS T120, T162, T173							
8: AS 1289 1.2.1 clause 6.4 (b), 2.1.1., 5.5.1, 5.6.1, 5.8.1			17: RMS T120, T164, T173							
9: Full details of Test Procedure 5.8.1 available on request										
Material Description										
1. CL-Clays of low plasticity, gravelly clays, sandy clays, silty clays			11. DGS40			* Cement Stabilised				
2. CI-Clay of medium plasticity, gravelly clays, sandy clays, silty clays			12. FCR20			# Lime Stabilised				
3. CH-Clays of high plasticity			13. FCR40			\$ Gypsum Stabilised				
4. SC-Clayey sands, sand-clay mixtures			14. RC - Recycled Concrete							
5. SM-Silty sands, sand-silt mixtures			15. Recycled Roadbase							
6. GC-Clayey gravels, gravel-sand-clay mixtures			16. RSB - Recycled Sub-base							
7. SP-Sand, crushed dust, filling sand, washed sand			17. CSS - Crushed Sandstone							
8. DGB20			18. RSS - Ripped Sandstone							
9. DGB40			19. Cowels Brown							
10. DGS20										

Form No R 020 Version 12/05/22 - issued by ER



Accreditation Number 2734
Corporate Site Number 2727

Accredited for compliance with
ISO/IEC 17025 - Testing.

A Kench

Report Date
21/09/2023

Approved Signatory

34 Borec Road, Penrith NSW 2750
Telephone: (02) 4722 2744

Unit 4, 18-20 Whyalla Place, Prestons NSW 2170
Telephone: (02) 9607 6111

email: info@geotech.com.au www.geotech.com.au

FIELD DENSITY RESULTS

DARACON CONTRACTORS PTY LTD
186 ADDERLEY STREET WEST
AUBURN NSW 2144

Laboratory: Penrith
Job No: 8599/115

PROJECT: RETAINING WALL BACKFILL TESTING
NEWPARK PRECINCT 7F, MARSDEN PARK

Page 2 of 2

TEST NUMBER		9	10	11	12				
DATE TESTED & SAMPLED		04/09/2023	06/09/2023						
RESULTS									
Hilf Density Ratio	Standard	%	98	99	97.5	99			
Moisture Variation from OMC (-Drier/+Wetter)		%	0.0	0.5	0.0	0.0			
Specification	Density Ratio (Standard)	≥95%	Specification Moisture Variance from OMC				±2%		
TEST LOCATION									
Chainage	(Carriageway L/R)	m	-	-	-	-			
Shown on Drawing No			8599/115-1						
Retested by Test		-	-	-	-				
Layer Thickness		mm	150	150	150	150			
Reduced Level		m	18.24	17.36	19.26	18.39			
FIELD & LABORATORY DATA									
Field Wet Density		t/m ³	2.12	2.13	2.11	2.12			
Field Moisture Content		%	16.0	14.0	15.5	14.0			
Material retained on 19mm Sieve (wet)		%	<5	<5	<5	<5			
Lab Compaction result from test number			9	10	11	12			
Lab Compaction Date Tested			11/09/2023	11/09/2023	11/09/2023	11/09/2023			
Peak Converted Wet Density		t/m ³	2.16	2.15	2.16	2.14			
Apparent Optimum Moisture Content		%	16.0	14.0	15.5	14.0			
Number of Compaction Points			3	3	3	3			
Test Procedures - See Note Number			12	12	12	12			
Material Description - see below			2	2	2	2			
Notes									
1: Assigned Values have been obtained from our Penrith laboratory – Accreditation No 2734			10: AS 1289 1.2.1 clause 6.4 (b), 2.1.1, 5.3.1, 5.5.1, 5.6.1						
2: Assigned Values have been obtained from our Prestons laboratory – Accreditation No 14234			11: AS 1289 1.2.1 clause 6.4 (b), 2.1.1, 5.3.1, 5.7.1						
3: Results have been calculated using infinite decimal places. Therefore, calculated values may vary from those shown			12: AS 1289 1.2.1 clause 6.4 (b), 2.1.1, 5.7.1, 5.8.1						
4: AS 1289 1.2.1 clause 6.4 (b), 2.1.1, 5.1.1, 5.3.1, 5.4.1			13: RMS T111, T119, T120, T166						
5: AS 1289 1.2.1 clause 6.4 (b), 2.1.1, 5.2.1, 5.3.1, 5.4.1			14: RMS T111, T120, T166, T173						
6: AS 1289 1.2.1 clause 6.4 (b),			15: RMS T120, T119, T162						
7: AS 1289 1.2.1 clause 6.4 (b), 2.1.1, 5.2.1, 5.4.1, 5.8.1			16: RMS T120, T162, T173						
8: AS 1289 1.2.1 clause 6.4 (b), 2.1.1., 5.5.1, 5.6.1, 5.8.1			17: RMS T120, T164, T173						
9: Full details of Test Procedure 5.8.1 available on request									
Material Description									
1. CL-Clays of low plasticity, gravelly clays, sandy clays, silty clays			11. DGS40			* Cement Stabilised			
2. CI-Clay of medium plasticity, gravelly clays, sandy clays, silty clays			12. FCR20			# Lime Stabilised			
3. CH-Clays of high plasticity			13. FCR40			\$ Gypsum Stabilised			
4. SC-Clayey sands, sand-clay mixtures			14. RC - Recycled Concrete						
5. SM-Silty sands, sand-silt mixtures			15. Recycled Roadbase						
6. GC-Clayey gravels, gravel-sand-clay mixtures			16. RSB - Recycled Sub-base						
7. SP-Sand, crushed dust, filling sand, washed sand			17. CSS - Crushed Sandstone						
8. DGB20			18. RSS - Ripped Sandstone						
9. DGB40			19. Cowels Brown						
10. DGS20									

Form No R 020 Version 12.05/22 - issued by ER

Report Date
21/09/2023



Accreditation Number 2734
Corporate Site Number 2727

Accredited for compliance with
ISO/IEC 17025 - Testing.


A Kench

Approved Signatory

34 Borec Road, Penrith NSW 2750
Telephone: (02) 4722 2744

Unit 4, 18-20 Whyalla Place, Prestons NSW 2170
Telephone: (02) 9607 6111

email: info@geotech.com.au www.geotech.com.au

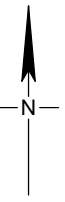

Imagery © NearMap.com

LEGEND

● Density Test



Scale 1:1000



34 Borec Road
Penrith
NSW 2750
ABN 71 076 676 321

Ph: 02 4722 2744
e-mail: info@geotech.com.au
www.geotech.com.au

Daracon Contractors Pty Ltd
Newpark Precinct 7F
Marsden Park

Drawing No: 8599/115-1
Job No: 8599/115
Drawn By: MH
Date: 25 September 2023
Checked By: BN

Field Density Test Locations

File No: 8599-115
Layers: 0, Lay1