

# BRONTE 33 (ZERO LOT)


5 2 3

AREA	SQ.	M2
LOWER LIVING	13.62	126.49 m <sup>2</sup>
UPPER LIVING	13.56	125.99 m <sup>2</sup>
GARAGE	3.63	33.74 m <sup>2</sup>
ALFRESCO	1.73	16.04 m <sup>2</sup>
PORCH	0.20	1.90 m <sup>2</sup>
<b>TOTAL</b>	<b>32.74</b>	<b>304.16 m<sup>2</sup></b>


WIDTH	-10.91m
LENGTH	-19.07m

BLUE SHADE DENOTES DISPLAY VARIATION

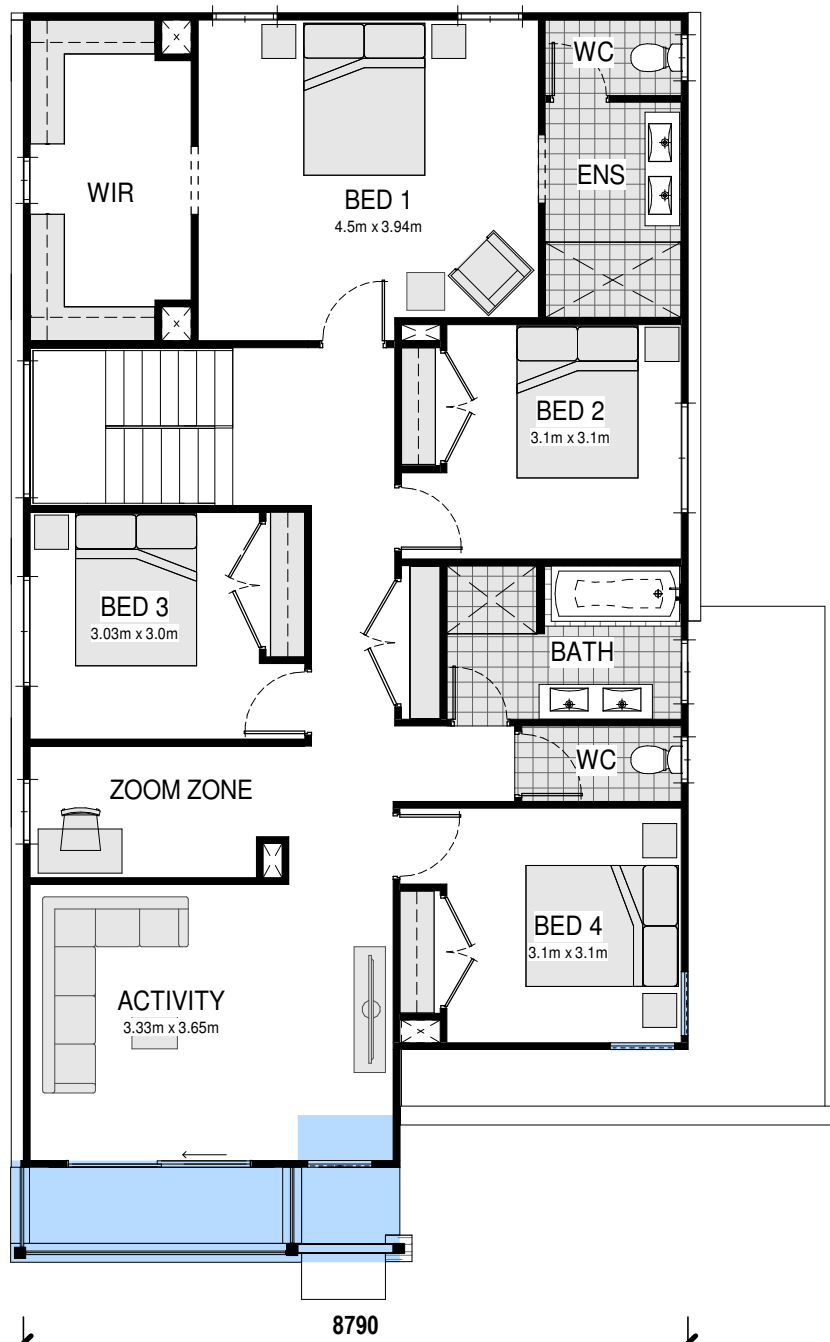

**2 UPPER FLOOR PLAN**

SCALE: 1 : 100

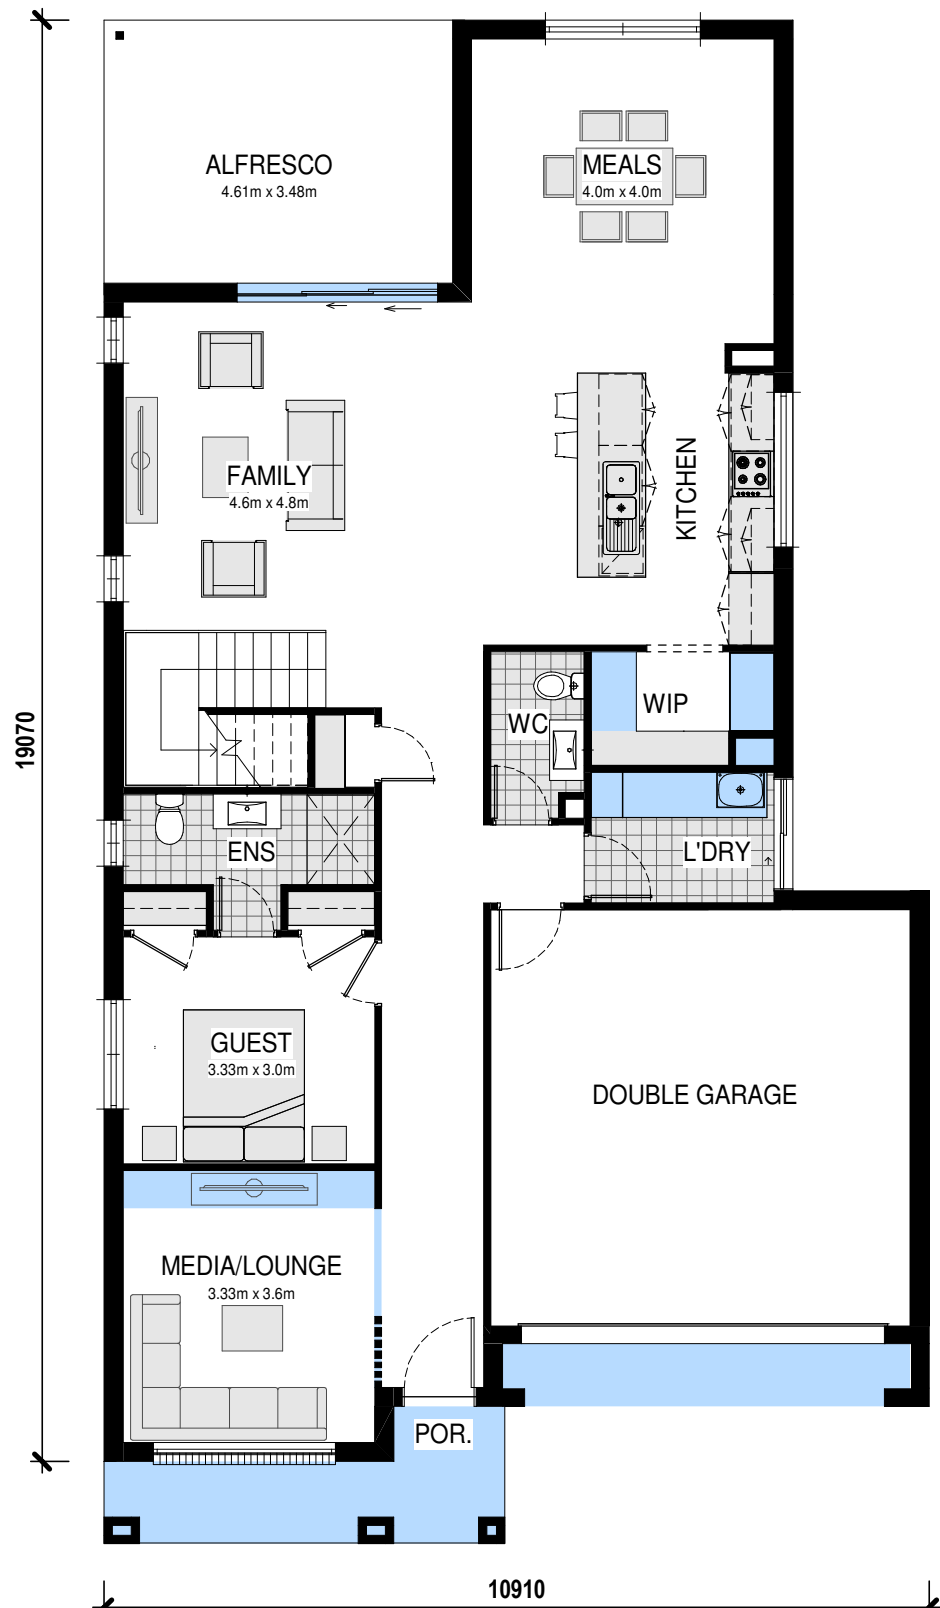

**1 LOWER FLOOR PLAN**

SCALE: 1 : 100



This plan has been prepared for sales and marketing purposes and should be used as a guide only. Plans may not be to scale. Any sizes and layouts are subject to change without notice. Sizes may vary depending on facade options. Floor plan is based on traditional facade. Minimum lot size vary depending on council and estate requirements. This plan is exclusively owned by Bell River Homes Pty Ltd and cannot be copied either wholly or in part, in any form without the prior written consent of Bell River Homes. All external measurements are external overall measurements to outside brickwork. Refer to actual working production drawings for detail.