


SCHEDULE of CURVED BOUNDARIES

No	Bearing	Chord	Arc	Radius
1	186°16'50"	5.08	5.08	389
2	185°01'40"	11.095	11.095	389
3	183°19'50"	10.725	10.725	389
4	181°28'00"	13.275	13.275	389
5	179°39'35"	9.995	9.995	389
6	178°06'30"	9.995	9.995	389
7	176°33'20"	9.995	9.995	389
8	174°57'35"	10.575	10.575	389

SCHEDULE of LINES

No	Bearing	Distance
9	219°02'05"	7.075

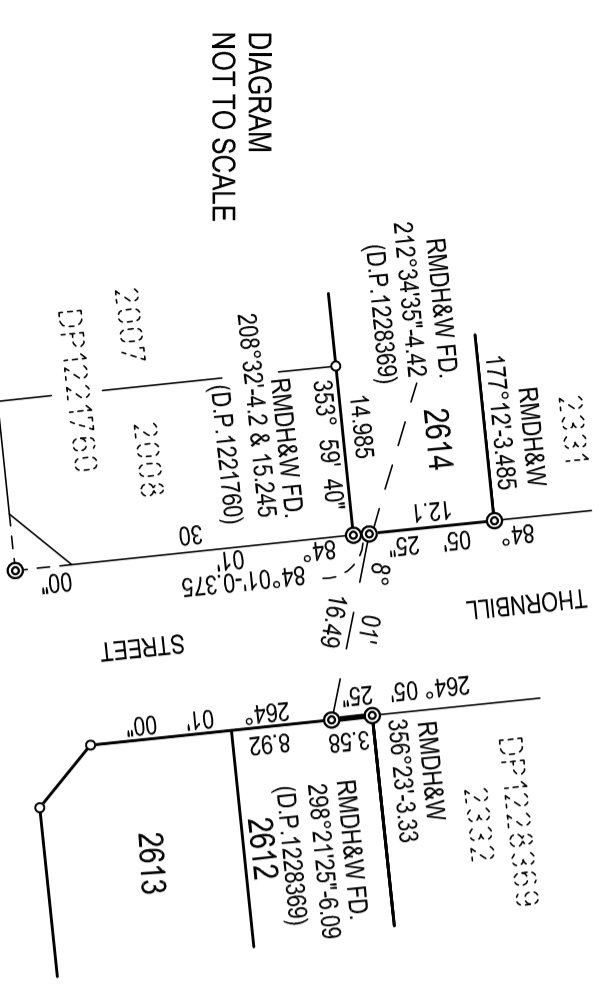


SURVEYOR
 Name: Ian Vincent Myers
 Date: 18th October, 2019.
 Reference: 20260-203

PLAN OF SUBDIVISION OF
 LOT 204 D.P.1221754, LOT 2051 D.P.1229411
 LOTS 2368 & 2360 D.P.1228369 AND
 LOTS 2430 & 2431 D.P.1238878.

L.G.A: BLACKTOWN
 Locality: MARSDEN PARK
 Reduction Ratio: 1:600
 Lengths are in metres

REGISTERED
D.P. 1251821

- "H" BENEFITED BY EASEMENT TO DRAIN WATER 1 WIDE (E1) (D.P. 1228369)
- "J" BENEFITED BY EASEMENT TO DRAIN WATER 1.5 WIDE (E2) (D.P. 1228369)
- B. RESTRICTION ON THE USE OF LAND NUMBERED 17, 19 & 21 (D.P. 1205498)
- C. POSITIVE COVENANT NUMBERED 18 & 20 (D.P. 1205498)
- K. EASEMENT TO DRAIN WATER VARIABLE WIDTH (D.P. 1205498)
- F. EASEMENT FOR ACCESS AND MAINTENANCE 0.9 WIDE (D.P. 1205498)
- (E2) EASEMENT TO DRAIN WATER 1.5 WIDE (D.P. 1228369)
- (E1) EASEMENT TO DRAIN WATER 1 WIDE (D.P. 1228369)

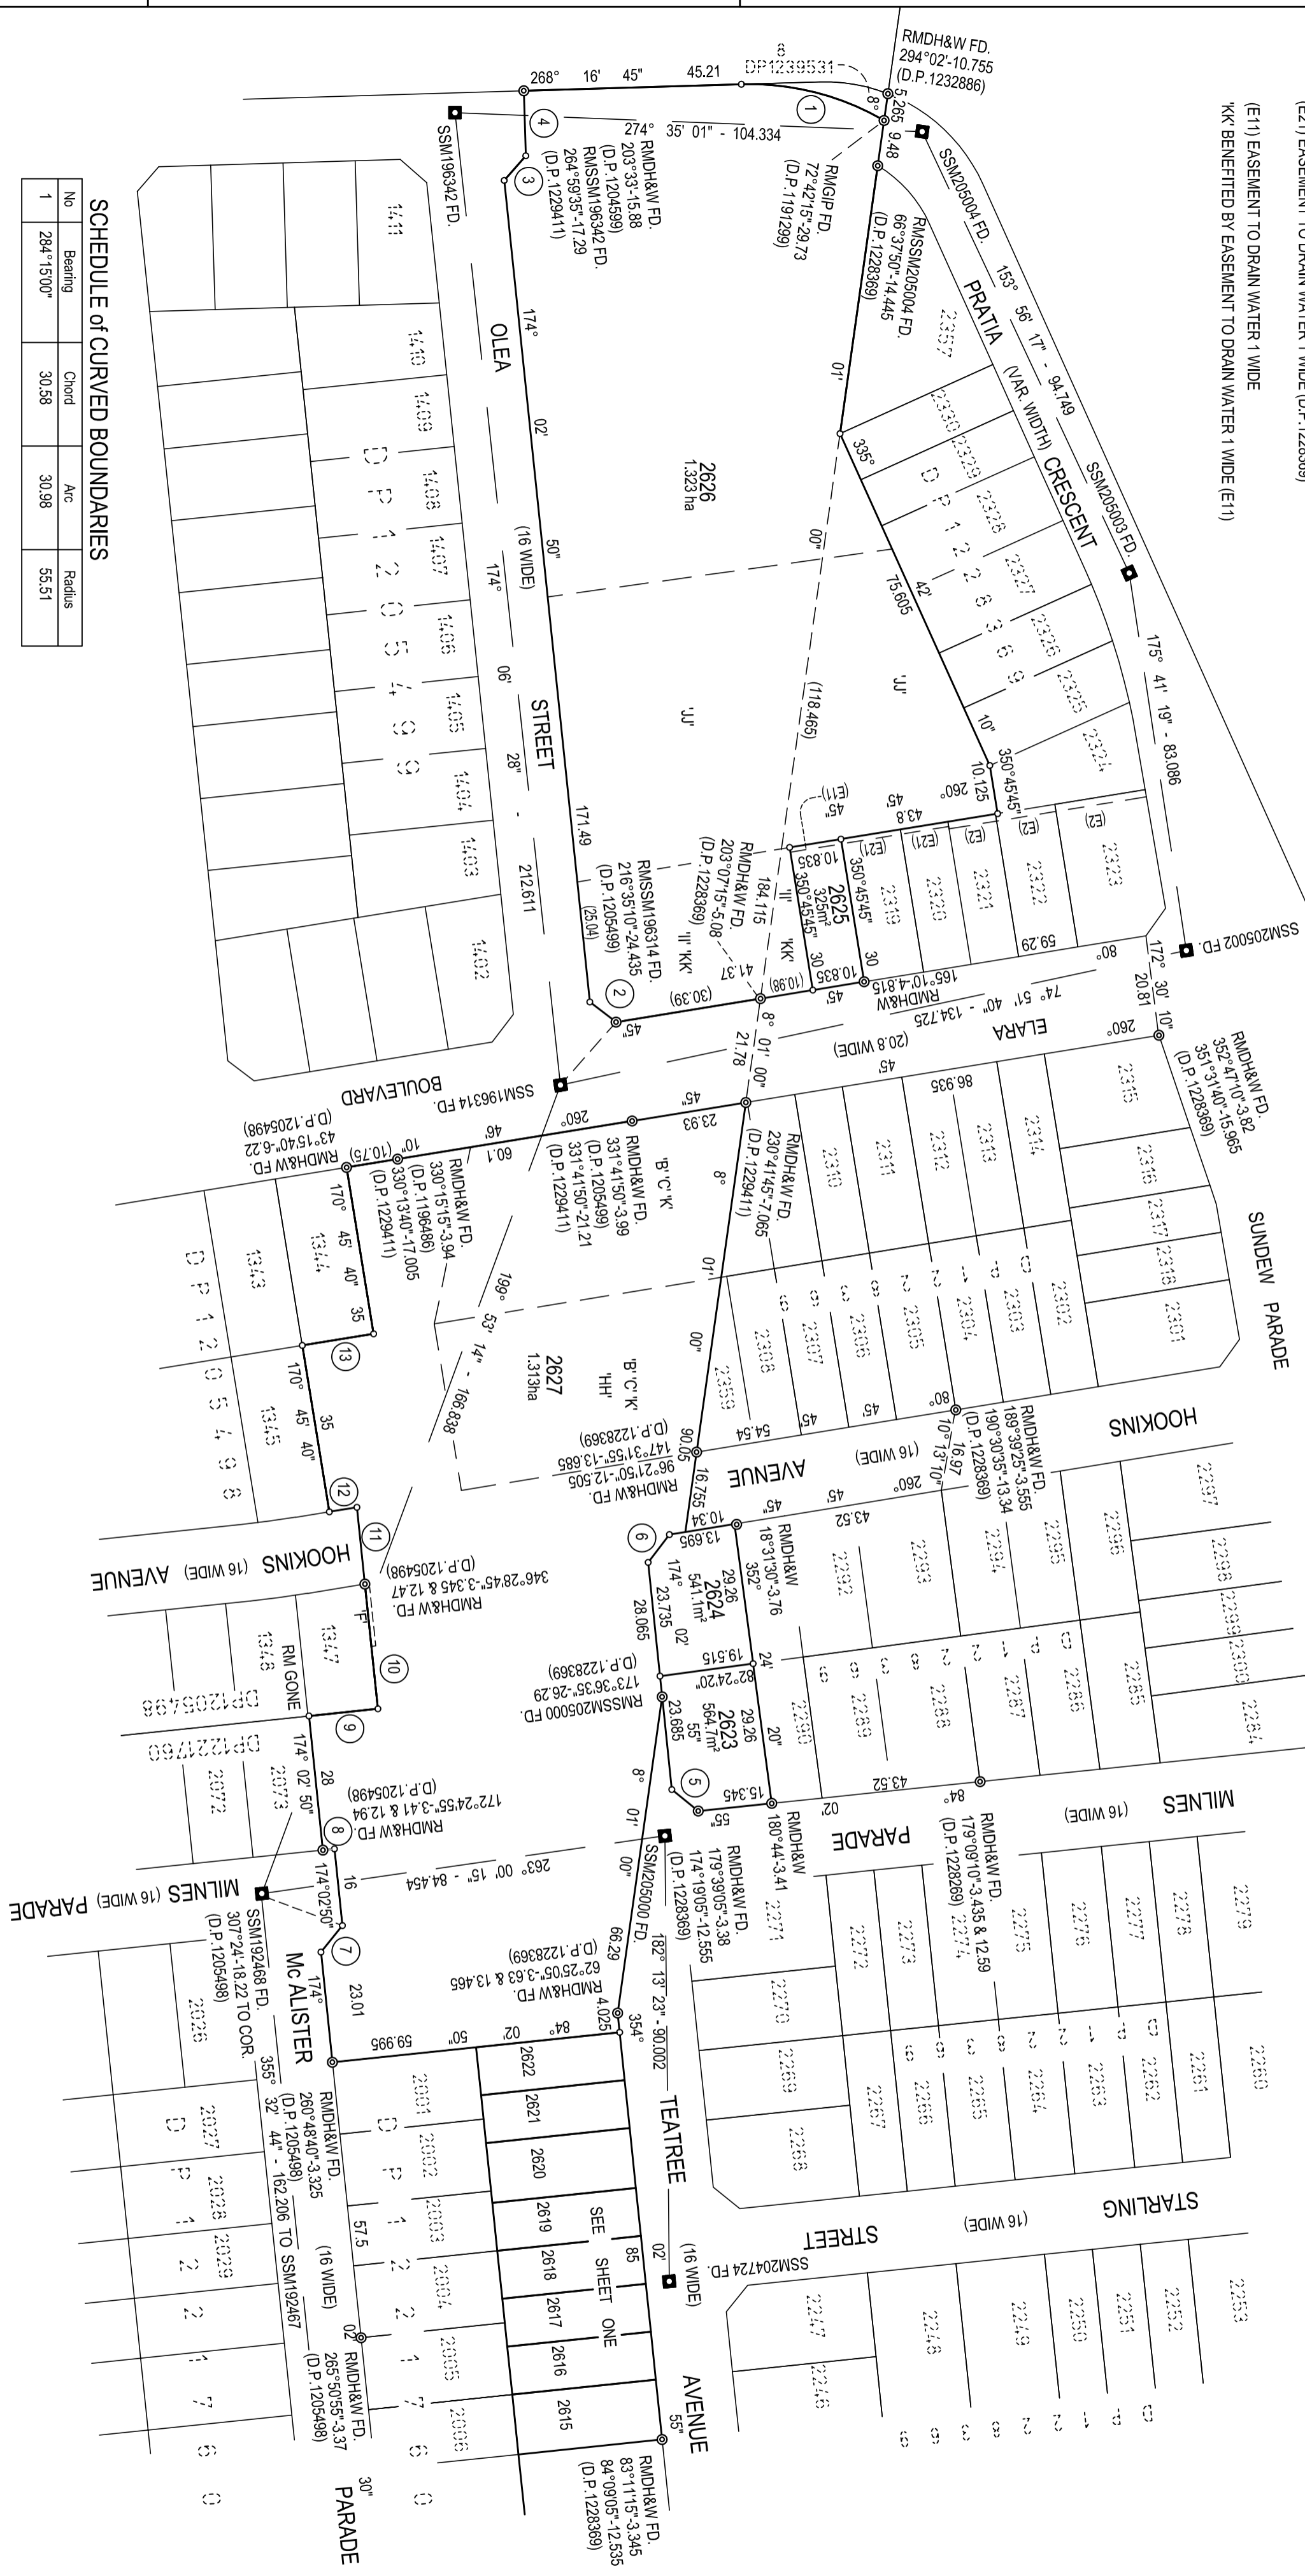

SCHEDULE of CURVED BOUNDARIES

No	Bearing	Chord	Ac	Radius
1	284°15'00"	30.88	30.98	55.51

SCHEDULE of LINES

No	Bearing	Distance
2	127°29'25"	6.885
3	221°09'50"	6.805
4	178°16'45"	13.5
5	129°02'55"	7.07
6	37°24'20"	7.27
7	219°02'50"	7.07
8	84°02'50"	2.4
9	264°02'50"	14.4
10	174°02'50"	26.03
11	174°03'10"	16.025
12	80°45'40"	5.795
13	280°45'40"	15

SURVEYOR
Name: Ian Vincent Myers
Date: 18th October, 2019.
Reference: 20260-203

PLAN OF SUBDIVISION OF
LOT 204 D.P. 1221754, LOT 2051 D.P. 1229411
LOTS 2368 & 2360 D.P. 1228369 AND
LOTS 2430 & 2431 D.P. 1238878.

L.G.A: BLACKTOWN
Locality: MARSDEN PARK
Reduction Ratio: 1:1000
Lengths are in metres

REGISTERED

D.P. 1251821